



I-55 Managed Lanes Combined Design Report

Appendix A.3 – Structures

- Structure 022-001 – Lemont Road Bridge Condition Report
- Structure 022-003 –Madison Street Bridge Condition Report
- Structure 016-0016 – IL 50 EB Bridge Condition Report
- Structure 016-0017 – IL 50 WB Bridge Condition Report
- Structure 016-0018 - BRC RR EB Bridge Condition Report
- Structure 016-0019 - BRC RR WB Bridge Condition Report
- Structures Visual Observation Technical Memo
- I-55 over RR Commitments and Flagging Estimate

Transmittal



Stantec

Stantec Consulting Services Inc.
135 South LaSalle Street
Suite 3100
Chicago, IL 60603-4139

To: Steve Schilke/Srikanth Panguluri
From: John O'Holleran

Company: Illinois Department of Transportation – Bureau of Programming
 For Your Information
 For Your Approval
 For Your Review
Address: 201 W. Center Court
Schaumburg, IL 60196
 As Requested

Phone: 847.705.4125/847.705.4073
Date: April 8, 2013
File: I-55 Managed Lane Study
Delivery: Regular Mail

Reference:

Attachment:

Copies	Doc Date	Pages	Description
1	March 26, 2013	127	I-57 over Lemont Road Bridge Condition Report
1	March 25, 2013	1	I-55 over Lemont Road Bridge Condition Report – Disposition of Comments

Transmitted please find 1 copy of the above identified BCR. As discussed, the vertical clearance information will be picked as part of the project survey effort this spring.

Stantec Consulting Services Inc.

John V. O'Holleran, PE
Principal/Project Manager
Tel: 312.262.2400
Fax: 312.262.2301
John.oholleran@stantec.com

c. Powell

One Team. Infinite Solutions.

BRIDGE CONDITION REPORT

REGION: 1

DISTRICT: 1

ROUTE: FAI 055 / I-55 EB

COUNTY: Cook

STRUCTURE NUMBER: 016-0016

LOCATION: I-55 Eastbound over Cicero Avenue



PREPARED BY:  **Stantec**

DATE PREPARED: 12/20/13

PROPOSED LETTING DATE: To Be Determined

TABLE OF CONTENTS

I. GEOGRAPHICAL & ADMINISTRATIVE DATA.....	1
II. PHYSICAL DESCRIPTION OF STRUCTURE	1
III. FIELD INSPECTION & PHYSICAL EVALUATION.....	4
IV. POTENTIAL SCOPE OF WORK DETERMINATION & ANALYSIS.....	7
V. DISCUSSION AND RECOMMENDED SCOPE OF WORK	8
VI. FINAL RECOMMENDATION.....	9
VII. TRAFFIC STAGING	10

ATTACHMENTS:

- A. Location Map
- B. IDOT Master Structure Report
- C. Bridge Inspection Report
- D. Bottom of Deck Condition Survey
- E. Condition Assessment of the Reinforced Concrete Bridge Deck
- F. Substructure Condition Surveys
- G. Opinion of Probable Costs
- H. Proposed Structure Drawings
- I. Structure Photos
- J. Proposed Plan & Profile
- K. Existing and Proposed Roadway Cross Sections
- L. Abbreviated Existing Plans

I. GEOGRAPHICAL & ADMINISTRATIVE DATA

Structure Number: 016-0016
County: Cook
Route Carried: FAI 055 / I-55
Feature Crossed: FAP 0350 / Cicero Avenue
Section: 1112-619-HB
Station: 24+20

Roadway Classification: Federal Aid Interstate
Design/Posted Speed: 70mph / 55mph
***ADT (current/design):** 86,748 (2012) / 120,186 (2040)
***ADTT (current/design):** 13% = 11,277 (2012) / 13% = 15,624 (2040)
***DHV (current/design):** 5,053 (2012) / 7,601 (2040)
Inventory Rating HS: 1.670 – rated 11/05/01
Operating Rating HS: 2.750 – rated 11/05/01
Sufficiency Rating: 80.0
HBP Eligibility: No

* Traffic data per the I-55 Managed Lane Phase I Study

Construction / Reconstruction / Repair History

The structure carrying I-55 Eastbound over Illinois Route 50 (Cicero Avenue) was originally built in 1963 as FAI Route 55 over Cicero Avenue under Project I-55-7(29) 281, Section 1112-619 HB. The original construction consisted of two parallel 3-span structures. The two structures carried I-55 eastbound and westbound traffic. The structure consisted of a 7" concrete slab with steel plate girders and wide flange beams supported by reinforced concrete abutments and piers.

As part of Contract 80059, bridge rehabilitation was performed in 1999. The rehabilitation consisted of removing the bituminous concrete overlay, performing deck repairs, removing and replacing the transverse deck joints, eliminating the longitudinal deck joint, placing a new deck concrete overlay, refurbishing the bearings and repairing the substructure and slopewall.

II. PHYSICAL DESCRIPTION OF STRUCTURE

The physical description of the structure is based on a review of the existing available plans dated December 1962 and 1999. Refer to Attachment L for select existing structure plan sheets. Individual components of the existing structure are described below:

Structure Type and Length: The bridge is a three span simply supported plate girder and wide flange beam structure. Span 1 and 3 consist of plate girders and wide flange beams

and Span 2 consists of plate girders exclusively. The fascia girders in Spans 1 and 3 are plate girders with 66" deep webs. The interior beams in Spans 1 and 3 are W30x108 beams. Span 2 consists entirely of plate girders with 66" deep webs. Each span has 10 beams lines. The bridge is approximately 206'-8 3/4" long measured back-to-back of abutments along the curve. The substructure consists of two reinforced concrete stub abutments with wingwalls and two multi-column reinforced concrete piers. The abutments and the piers are supported by concrete piles. The bridge has a 7" reinforced concrete deck plus overlay.

Number / Length of Spans: There are a total of three spans, with approximate lengths as follows (dimensioned from centerline of bearing to centerline of bearing along the curve). Spans are numbered from west to east.

Span 1: 39'-11 5/8"

Span 2: 112'-6 1/2"

Span 3: 45'-7 1/2"

Skew: 21°-40'-17" Left

Structure Width: The total width is 59'-5 1/2" measured radially out-to-out of the deck. The bridge accommodates three 12' lanes of traffic and 10' inside and outside shoulders.

Expansion Joints: W Abutment: 2" Neoprene Joint
Pier 1: 1 3/4" Preformed Joint Seal
Pier 2: 2 9/16" Neoprene Joint
E Abutment: 1 3/4" Preformed Joint Seal

Bearings: W Abutment:
Beam Line 1, 10 Expansion, Type 2
Beam Line 2 to 9 Expansion, Type 3 w/ bolster

Pier 1:
Beam Line 1, 10 Fixed, Type 1 and Type 2
Beam Line 2 to 9 Fixed, Type 1 and Type 3 w/
bolster

Pier 2:
Beam Line 1, 10 Expansion, Type 1 and Type 2
Beam Line 2 to 9 Expansion, Type 1 and Type 3
w/ Bolster

	E Abutment:
	Beam Line 1 Fixed, Type 2
	Beam Line 2 to 9 Fixed, Type 3 w/ bolster
	Beam Line 10 Fixed, Type 2
Approach Roadway Template:	The approach roadway template matches the bridge. It has three 12' lanes of traffic and 10' inside and outside shoulders.
Existing Wearing Surface:	2 3/8" Micro Silica Concrete Overlay
Existing Vertical Alignment:	The entire structure is on a +1.50% tangent slope going from west to east.
Existing Horizontal Alignment:	The structure is on a curve at a radius of 3819.72' from Station 19+41.41 to Station 32+86.83.
Existing Vertical Clearance:	15'-7 3/8" over Cicero Avenue according to the 1999 repair plans. 15'-5" according to the Master Structure Report which needs to be verified.
Existing Drainage:	There are no drains on the bridge deck or approach slabs.
Parapets and Railings:	There are 1'-8 3/4" wide exterior curb and parapets running the length of the bridge. Parapets were modified in 1999 plans to remove a 9" tall by 1'-0" wide existing handrail and replaced with a 9" tall x 1'-0" wide reinforced concrete section. Per the IDOT Bridge Inspection Report dated 12/10/12, the guardrail currently meets acceptable standards while the guardrail ends and transitions do not.
Existing Utilities Attachments:	There are no light poles attached to the bridge, but there are abandoned conduits running along the south fascia beam and the West Abutment. There is a conduit running along the outside of the South Parapet. There are light fixtures and conduits on the insides of both piers and at the midspan of Beam Lines 1, 6 and 9.
Name Plate:	No name plate was found on the structure.

III. FIELD INSPECTION & PHYSICAL EVALUATION

A field inspection beneath the structure carrying I-55 Eastbound over Cicero Avenue was performed by Stantec on August 21, 2013. The top of deck inspection was performed on September 16, 2013. The high temperature on that date was 65° F. The visual field inspection was performed on foot on the sloped wall, sidewalk and the top of deck. The following conditions were observed:

Deck

Deck

The deck was rated in satisfactory condition (NBIS Rating = 6) in the 12/10/12 NBIS inspection. The deck condition observed during this inspection was consistent with the NBIS rating. The underside of deck has multiple areas of delamination, spalling and map cracking. Based on visual inspection, approximately 2.2% of the underside of deck is delaminated or spalled.

The micro-silica concrete overlay on the top of deck has minor hairline transverse and longitudinal cracking mostly along the shoulders. One 3 square foot spall was found in the center lane in Span 2. Wiss, Janey and Elstner performed a condition assessment of the reinforced bridge deck in January 2012. This assessment included a delamination survey performed on the top of the bridge deck using infrared thermography. The infrared thermography indicated 5.6% of the top of deck area was delaminated. See Attachment E for the condition assessment of the reinforced bridge deck. See Attachment I – Photos 1 through 8.

Parapets

The parapets are in satisfactory condition with hairline vertical cracking throughout and minor delaminations and spalls on both the interior and exterior faces of the parapet. The interior face of the South Parapet has approximately 20 square feet of delaminated concrete. The interior face of the North Parapet has approximately 30 square feet of delaminated concrete. The exterior face of the South Parapet has longitudinal hairline cracking with rust staining along most of the length of the parapet. See Attachment I - Photos 9 and 10.

Joints

The preformed joint seals at the East Abutment and Pier 1 and the neoprene joints at West Abutment and Pier 2 are in satisfactory condition with debris in the joint and minor impact damage. The joint widths were measured when the temperature was approximately 65° F. The preformed joint at the East Abutment measured 1" wide. The preformed joint at the Pier 1 measured 1". The neoprene joint at the Pier 2 measured 2 1/8". The neoprene joint at the

West Abutment measured 1 11/16". See Attachment I – Photos 11 through 14.

Superstructure

Beams

The superstructure consists of three simple spans of rolled steel beams and welded plate girders. The beam lines are numbered 1 through 10, numbered from north to south. In Spans 1 and 3, Beam Lines 1 and 10 consist of plate girders with 66" deep webs and Beam Lines 2 through 9 consist of W30x108 beams. In Span 2, all of the beam lines consist of plate girders with 66" deep webs. This structure has welded cover plates on the bottom flanges of the beams in Span 3.

The superstructure was rated in fair condition (NBIS Rating = 5) in the 12/10/2012 NBIS bridge inspection due to initial section loss and minor pitting. The superstructure observed during this inspection was consistent with the NBIS rating.

The steel superstructure typically has paint starting to fail, minor rust and initial section loss and minor pitting. In both Spans 1 and 3, the steel bolsters have been welded transversely to the W30x108 beams. These welds have mostly cracked. Bolts connect the top of the bolster to the bottom flange as part of a retrofit done in 1999. In Span 3, the steel beams have welded cover plates with fatigue category E' details. The welded cover plates were visually inspected from the ground and no defects were noted on the welds. See Attachment I – Photos 15 through 19.

Bearings

The bearings are in satisfactory condition with paint starting to fail and minor rust. No excessive tilting was noted during the inspection.

Utilities

The conduits along the South Fascia Beam and South Abutment are in poor condition with heavy deterioration and open conduit covers. See Attachment I – Photos 20 and 21.

Substructure

The substructure was rated in satisfactory condition (NBIS Rating = 6) in the 12/10/2012 NBIS bridge inspection due to cracks and spalls at the abutment caps and pier columns. The substructure condition observed during this inspection was not consistent with the NBIS rating due to the condition of the piers.

Abutments

The reinforced concrete abutments are in satisfactory condition with multiple hairline vertical cracks and small areas of delaminated/spalled concrete. There is 6 square feet of spalled concrete on the West Abutment. There is 10 square feet of spalled/delaminated concrete on the East Abutment. At both abutments, a minor amount of fill appears to be leaking thru the joint in the backwall. No significant defects were noted at the wingwalls. See Attachment F for the Substructure Condition Survey. See Attachment I – Photo 22 through 26.

Piers

The reinforced concrete piers each consist of four columns with a pier cap. The piers are in fair condition with moderate to heavy delaminations and spalls on the columns and pier caps. Pier 1 has approximately 200 square feet of spalled or delaminated concrete. Pier 2 has approximately 106 square feet of spalled or delaminated concrete. See Attachment F for the Substructure Condition Surveys. See Attachment I – Photo 27 through 30.

Slope Protection

The bridge has concrete slope walls. Both slopewalls are in satisfactory condition with minor hairline cracking throughout. The curb at the East Slopewall has separated from the rest of the slopewall, allowing undermining to occur at the south end. The West Slopewall has a 4' x 4' spall on the slopewall curb and a 1/16" transverse crack that goes the full width of the bridge. See Attachment I – Photo 31 through 34.

Inspection History (NBIS Ratings)

Year	Deck	Super	Sub
2012	6	5	6
2011	6	6	6
2009	6	7	6

Geometric, Horizontal & Vertical Clearance / Hydraulic Data

Geometry

I-55 over Cicero Avenue is on a skew. According to the original plans of December 1962 and the repair plans of 1999, the skew at the intersection of the centerlines of I-55 and Cicero Avenue is 21°-40'-17" Left. The typical roadway section for I-55 consists of three 12' lanes, a 10' inside shoulder, a 10' outside shoulder, a 1'-8 3/4" wide curb and parapet on each side of the structure. The I-55 profile grade is on a tangent at +1.50% going from west to east. The structure is on a horizontal curve at a radius of 3819.72' from Station 19+41.41 to Station 32+86.83. The repair plans from 1999 show the vertical minimum clearance at 15'-7 3/8". However, the Master Structure

Report shows the minimum vertical clearance at 15'-5" under the "Key Route under Data" which needs to be verified.

The typical roadway section for Cicero Avenue consists of three lanes in each direction beneath the structure and a raised concrete median. Cicero Avenue is listed as a principal arterial route. Cicero Avenue is located on a 200-ft. long vertical crest curve with 0.36% and -0.30% slopes going from north to south.

As part of the I-55 Managed Lane Phase I Study, I-55 Eastbound at Cicero Avenue will be widened to the inside to accommodate a proposed 12' managed lane. In the eastbound direction, a 4' buffer between the managed lane with 12.5' shoulder and the general purpose traffic lanes is proposed in this 60 foot median section. This widening will be incorporated into the recommended scope of work for this structure.

Hydraulics

At the structure, the I-55 profile is on a +1.50% tangent going from west to east. The bridge deck cross-section is superelevated 3.3%. There are no deck drains on the bridge deck. Therefore, the water is allowed to flow to the deck joints as it runs off the bridge.

IV. POTENTIAL SCOPE OF WORK DETERMINATION & ANALYSIS

As part of the I-55 Managed Lane Phase I Study, In-Kind Repairs, Structure Widening and Structure Replacement alternatives will be evaluated.

Per Section 2.4.2.4 of the IDOT Bridge Manual, consideration was given to retrofit all end of cover plate locations due to average daily truck traffic. From this information, it was determined that a fatigue evaluation was required. The transverse welds at the ends of the cover plates in Span 3 were evaluated for fatigue life and it was determined that the mean service life is less than 50 years. A cover plate retrofit should be installed.

1. In-Kind Repairs

Perform partial and full depth repairs and apply Protective Coat to the existing deck. Repair areas of spalled or delaminated concrete on the existing substructure units. Perform retrofit repairs on the existing Span 3 cover plates.

2. Structure Widening

Remove and replace the deck and approach slabs and widen both approximately 18' to the north. Remove both the northeast and northwest wingwalls and build an extension onto the north side of both abutments. Build an extension onto the north side of both piers.

Install three new beam lines using W30 steel beams and plate girders that will be composite to the widened bridge deck. The new W30 beam will be larger than the existing W30 to account for the bottom flange cover plate. Perform retrofit repairs on the existing Span 3 cover plates. Repair areas of spalled or delaminated concrete on the existing substructure units.

3. Superstructure and Partial Substructure Replacement

Remove and replace the existing W30 steel beam and steel plate girder superstructure with a continuous three-span galvanized steel plate girder superstructure. Remove and replace pier caps and columns, but reuse the existing pier crash walls and footings. Build an extension onto the north side of both piers. Replace the existing abutments with integral abutments placed behind the existing abutments. Replace concrete slope walls. The deck geometry will accommodate the proposed roadway geometry from the I-55 Managed Lane Phase I Study.

4. Structure Replacement

Remove and replace the entire structure with a continuous three-span galvanized steel plate girder superstructure on integral abutments. The deck geometry will accommodate the proposed roadway geometry from the I-55 Managed Lane Phase I Study.

V. DISCUSSION AND RECOMMENDED SCOPE OF WORK

The opinion of probable costs for each of the alternatives is summarized below. See Attachment G for the opinion of probable costs breakdown.

- 1. In-Kind Repairs - \$194,400**
- 2. Structure Widening - \$2,546,200**
- 3. Superstructure and Partial Substructure Replacement - \$5,403,600**
- 4. Structure Replacement - \$6,004,700**

Per the I-55 Managed Lane Phase I Study, the managed lane is expected to be implemented in 2020. All widening and replacement alternatives below assume widening approximately 18' to the centerline of I-55 to accommodate the new managed lane. The proposed structure will provide a 9'-6" outside shoulder, three 12'-0" general purpose traffic lanes, a 4' buffer between the general purpose traffic lanes and the 12'-0" managed traffic lane and a 12'-6" inside shoulder.

Analysis of Alternative 1 – The calculated percent of deck area requiring full depth repairs is 2.2% and the partial depth repairs is 12.0%. The total deck repair percentage is within the 25% limit presented in the Bridge Condition Report Procedures and Practices Manual for bridge deck repair to be cost effective for a deck not being widened. This alternative can be used to extend the life span of the

existing superstructure in the interim prior to implementing the changes required for the Managed Lane project.

Analysis of Alternative 2 – The calculated percent of deck area requiring full depth repairs is 2.2% and partial depth repairs is 11.0%. Since this deck is 50 years old and has recommended repair area near the upper limit (15%) presented in the BCR Procedures and Practices Manual for a widened deck, it is recommended to replace the deck at the time of widening. Cover plate retrofits will be necessary. Deck joints will remain with this alternative, which will lead to continued degradation of the beams and substructure units. This alternative keeps the existing pier caps in service, which have already been repaired as a result of extensive degradation in 1999.

Analysis of Alternative 3 – This alternative replaces the existing W30 steel beam and steel plate girder superstructure with a continuous three-span galvanized steel plate girder superstructure on integral abutments. The proposed integral abutments will be placed behind the existing abutment to help avoid the existing piles. The resulting assumed span arrangement is approximately 70'/114'/70' measured between the centerline of bearings. Uplift at the abutments must be considered in the design phase given the relatively short exterior spans in the continuous structure. Reusing the existing pier crash walls and footings will simplify construction since it will minimize construction impact to Cicero Avenue.

Using galvanized steel eliminates the need to periodically repaint the beam. Providing a continuous structure will also allow for a reduced girder depth over Cicero Avenue, thereby increasing vertical clearance. The longer exterior spans provide an opportunity to relocate the sidewalks, or a multi-use path, along Cicero Avenue behind the piers. Providing new pier caps, pier columns and integral abutments places the critical portions of the substructure on the same life cycle as the superstructure. Eliminating the deck joints will also help to prevent premature degradation of these substructure elements.

Analysis of Alternative 4 – This alternative completely eliminates the 50-year old structure and replaces it with a new structure with an expected 75-year service life.

The benefits of this alternative are similar to Alternative 3, with the addition of removing and replacing the pier crash walls and pier footings. However, this alternative adds construction complications of reconstructing the piers on or near the same footprint as the existing pier footings, and increases construction impacts to Cicero Avenue. The cost is also greater than Alternative 3 due to the removal and reconstruction of the additional pier elements.

VI. FINAL RECOMMENDATION

Stantec recommends Alternative 3 – Superstructure and Partial Substructure Replacement when the I-55 Managed Lane Project occurs. The selected alternative provides a new superstructure and replaces the critical portions of the substructure. Eliminating the deck joints will help to prevent premature degradation of the


replaced substructure elements. As the I-55 Managed Lane Phase I Study is ongoing, the bridge widening to be presented in the TSL should match the final geometry as presented in the final I-55 Managed Lane Phase I Study. Future improvements to Cicero Avenue, to be determined at a later date, should also be addressed in the TSL.

VII. TRAFFIC STAGING

For Alternatives 2, 3 and 4, the existing deck is wide enough to provide two lanes of traffic in the eastbound direction during stage construction. For Alternative 1, the lanes can be temporarily closed as needed to allow for the deck repairs. The traffic staging design will need to be confirmed by IDOT traffic prior to being implemented.

ATTACHMENT A

Location Map

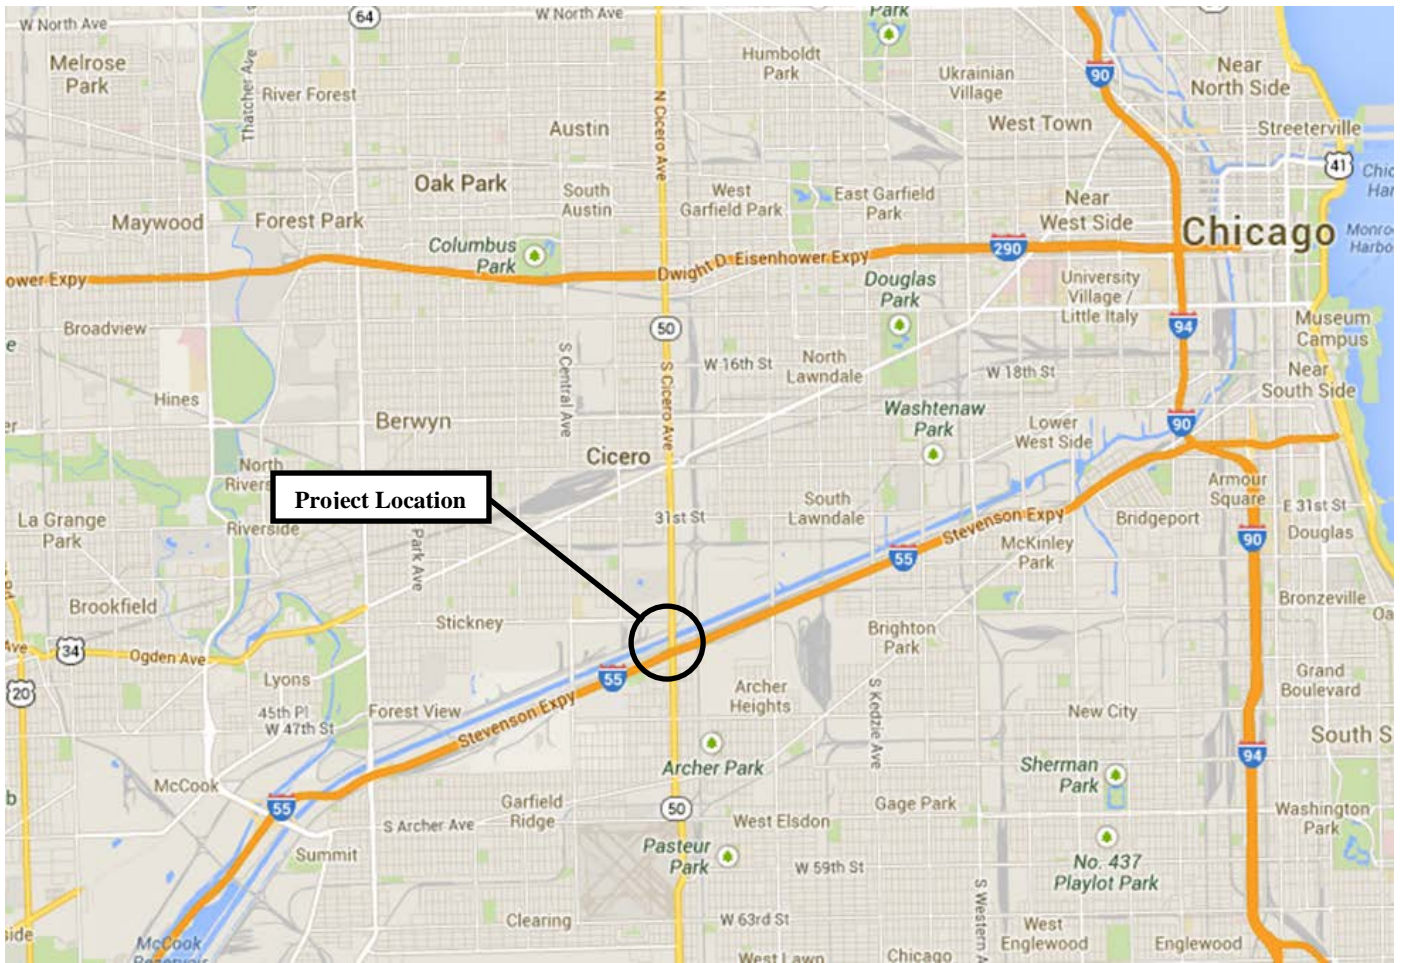


Project Location

N

Location Map

Proposed Improvement:

I-55 over Cicero Avenue (Eastbound)

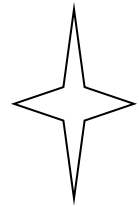

Municipality: Stickney

County: Cook

Route: FAI 055

Project No: P-91-762-10

Structure No.: 016-0016

ATTACHMENT B

IDOT Master Structure Report

**Illinois Department of Transportation
Structures Information Management System
Structure Summary Report**

Date: 10/08/2013

Page: 1

District: 1

Structure Number: 016-0016

Inventory Data

Facility Carried:	I-55 EB STEVENSON	Bridge Name:		Sufficiency Rating:	80.0	Structure Length:	206.7
Feature Crossed:	IL 50 (CICERO AVE)	Location:	5.7 M SW I94	HBP Eligible:	No	AAASHTO Bridge Length:	99.9
Bridge Remarks:		Status Date:	12/2000	Replaced By:	-	Length of Long Span:	115.0
Bridge Status:	1 OPEN - NO RESTRICT	Maint Township:	34 STICKNEY	Replaces:	03/12/2013	Bridge Roadway Width:	56.0
Status Remarks:				Last Update Date:	Right	Appr Roadway Width:	60.0
Maint County:	016 COOK			Parallel Structure:	Left	Deck Width:	59.4
Maint Responsibility:	01 I.D.O.T.			Multi-Level Structure Nbr:		Sidewalk Width Right:	0.0
Service On/Under:	5 SECOND LEVEL INTERCHANGE	1 / HIGHWAY		Skew Direction:	L	Sidewalk Width Left:	0.0
Reporting Agency:	1 I.D.O.T. - BUREAU OF MAINTENANCE			Skew Angle:	22 D 0 M 0 S	Navigation Control:	N
Main Span Matl/Type:	3 STEEL	/ 02 STRINGER/MULTI-BEAM/GIRDER		Structure Flared:	No	Navigation Horiz Clear:	0
Nbr Of Main Spans:	3	Nbr Of Approach Spans:	0	Historical Significance:	No	Navigation Vert Clear:	0
Approaches							
Near #1 Matl/Type:	/			Border Bridge State:		Culvert Fill Depth:	0.0
Near #2 Matl/Type:	/			Bdr State SN:		Number Culvert Cells:	0
Far #1 Matl/Type:	/			Bdr State % Responsibility:	0	Culvert Opening Area:	0.0
Far #2 Matl/Type:	/			Structural Steel Wt	996000	Culvert Cell Height:	0.00
Median Width/Type:	0 Ft. / 0	None		Substructure Material:		Culvert Cell Width:	0.00
Guardrail Type L/R:	0None	/ 0		Rated By:	2 IDOT	Rate Method:	1 LOAD FACTOR
Toll Facility Indicator:	0 No Toll			Load Rating Date:	11/05/2001	Load Rating Date:	11/05/2001
Latitude:	41 D 49 M 1.05 S	Longitude:	87 D 44 M 38.11 S	Design Load:	01 HS20+MOD	Crossing 1 Nbr:	
Deck Structure Type:	A	CIP CON NRMALLY FORM		Deck Structure Thickness:	7 SD: N FO: N	Crossing 1 Nbr:	
Sidewalks Under Structure:	2	Both Sides Not Separate				RR Lateral Underclear:	0 Ft 0 In

Key Route On Data

Key Route Nbr:	FEDERAL-AID INTERSTATE	Station:	0055	Segment:	10:2500
Appurtenances	Main Route				
Inventory County:	016 COOK	Linked:	Y		
Township/Road Dist	34 STICKNEY	Natl. Hwy System:	On NHS		
Municipality	5540 STICKNEY	Inventory Direction:			
Urban Area:	1051	Curr AADT Yr/Count:	2012 / 61150		
Functional Class:	1 INTERSTATE	Est Truck Percentage:	13		
** CLEARANCES **	South/East	Number Of Lanes:	3		
Max Rdwy Width:	56.0	One Or Two Way:	1 One-Way		
Horizontal:	57.5	Bypass Length:	0		
		Future AADT Yr/Cnt:	2032 / 75808		
		Designated Truck Rte:	CLASS I		
Special Systems:	Yes				

Key Route Under Data

FEDERAL-AID PRIMARY	Station:	0350	Segment:	18.7100
Main Route		00000	Linked:	Y
016			Natl. Hwy System:	On NHS
62 LAKE (CHICAGO)			Inventory Direction:	
1051 CHICAGO			Curr AADT Yr/Count:	2011 / 61600
1051			Est Truck Percentage:	12
3 OTHER PRINCIPAL ARTERIAL			Number Of Lanes:	7
South/East	North/West		One Or Two Way:	2 Two-Way
101.9	101.9		Bypass Length:	0
			Future AADT Yr/Cnt:	2032 / 63448
			Designated Truck Rte:	CLASS II
			Special Systems:	Yes

***** Marked Route On Data *****

Route #1:	1	Mainline		Kind		Number	
Route #2:	1	Mainline	1	Interstate Highway			055
Route #3:	1	Mainline					

***** Marked Route Under Data *****

Route #1:	1	Mainline		Kind		Number	
Route #2:	1	Mainline	3	State Highway			050
Route #3:	1	Mainline					

**Illinois Department of Transportation
Structures Information Management System
Structure Summary Report**

Date: 10/08/2013

Page: 2

Structure Number: 016-0016 District: 1

Data Related to Inspection Information

*** Inspection Intervals *** *** Maximum Allowable Posting Limits ***

Routine NBIS: 24 MOS Underwater: 0 MOS One Truck At A Time: 0 Combination Type 3S-1: Tons Bridge Posting Level: 5 No Posting Required
 Special: N Single Unit Vehicles: Tons Combination Type 3S-2: Tons

Inspection/Appraisal Information

Inspection Date: 12/10/2012 Inspection Temperature: 35Deg. F
 Deck: 6 SATISFACTORY CONDITION - MINOR DETERIORATION
 Superstructure: 5 FAIR CONDITION - MINOR SECTION LOSS, CRACKS
 Substructure: 6 SATISFACTORY CONDITION - MINOR DETERIORATION
 Culvert: N NOT APPLICABLE
 Channel and Protection: N NOT APPLICABLE
 Structural Evaluation: 5 BETTER THAN ADEQUATE TO BE LEFT IN PLACE
 Deck Geometry: 6 EQUAL TO PRESENT MINIMUM CRITERIA
 Underclearance-Vert/Lat.: 4 MINIMUM ADEQUACY TO BE LEFT IN PLACE
 Waterway Adequacy: N NOT APPLICABLE
 Approach Roadway Align: 8 EQUAL TO PRESENT DESIRABLE CRITERIA
 Bridge Railing Appraisal: 3 Meets Standards
 Approach Guardrail: 233 Not Acceptable Acceptable
 Pier Navig Protection: N N/A

Deck Wearing Surf: F MICRO SIL CON OVRLY Last Paint Type: U
 Deck Membrane: F NONE FLD AL EPY & ACRLC
 Deck Protection: J NONE
 Total Deck Thick: 8.9
 Last Paint Date: 10/2000

Single Unit Vehicles: Tons
 Combination Type 3S-1: Tons
 Combination Type 3S-2: Tons
 One Truck At A Time: 0

**** Actual Posted Limits ****

Underwater Inspection/Appraisal Information

Inspection Date: Inspection Category:
 Temperature: Inspection Method: Appraisal Rating:

Scour Critical Information

Rating: Evaluation Method:

Miscellaneous

Analysis Date: Microfilm Data Recorded: Yes

Construction Information

Year: 1963 Original Reconstructed
 Route: FAI-55 Sta: 24+20
 Section Nbr: 1112-619-HB
 Contract Nbr:
 Fed Aid Prf#: I 0557029281
 Built By: 1 I.D.O.T.

Waterway Information

Flood Design Frequency:
 Flood Design Q (CFS):
 Flood Design Nat H W E:
 Flood Des Open Prop:

YRS Drainage Area:
 Flood Base Q (CFS):
 Flood Base Nat H W E:

SF Flood Base Nat H W E:

ATTACHMENT C

Bridge Inspection Report



SN: 016-0016	District: 1	Spans: 3	Appr. Spans: 0	Skew: 22.00	ADT: 61150	Truck Pct: 13
ADT Un: 61600	Maint. Co: COOK	Twsp: STICKNEY		Status: OPEN - NO RESTRICT		
Facility Carried: I- 55 EB STEVENSON			Feature Crossed: IL 50 (CICERO AVE)			
Location: 5.7 M SW I94		Municipality: STICKNEY		Team/Sub Section: E26019		
Bridge Name:			Material & Type: STEEL/STRINGER/MULTI-BEAM/GIRDER			
Insp. Intervals (Mo) Routine NBIS: 24		Fracture Critical: 0		Underwater: 0		Special Feature: N/A
90 - Inspection Date: / /		90C - Temp. (°F):		90A - Program Manager:		
Is Delinquent: <input type="checkbox"/>		Reason:				
90A1 - Team Leader:			90A2 - Inspector:			

90B - Inspection Remarks:

Previous Inspection	2008) DK SOFFIT MAP CRKD & JOINTS LEAKING. STL BMS-SPAN 2 MINOR RUST @BOTT FLANGES. PIER CANTILEVERS MAP CRKD. PIER 2 COL 1 MAP CRKD. 2012) Item 59 lowered to "5" due to init sec loss/minor pitting a@ brng areas of few bm ends above P
------------------------	--

Resources

Time to Inspect (H:M): 1:0	Traffic Control: 3	Boat:	Waders:	Snooper:
Ladder: LL	Manlift:	Bucket Truck:	Other:	

Inspector's Appraisals

	Prev	New	Comments
58 - Deck Condition:	6		
59 - Superstructure Cond:	5		
60 - Substructure Cond:	6		
62 - Culvert Condition:	N		
61 - Channel Condition:	N		
71 - Waterway Adequacy:	N		
72 - Approach Rdw Align:	8		
111 - Pier Navig Protection:	N		

90B - Inspector Remarks:

Pontis

Today's Date: 04/19/2013

Structure Number: 016-0016 District: 1 (41) Bridge Status: 1 OPEN - NO RESTRICT
 (6) Feature Crossed: IL 50 (CICERO AVE) (7) Facility Carried: I- 55 EB STEVENSON
 (9) Location: 5.7 M SW 194 (7A) Bridge Name:
 Element Inspection Date: 12/10/2012 Inspectors: SEDLACEKJL

Element Description												
Elem	Env	% 1	Qty 1	% 2	Qty 2	% 3	Qty 3	% 4	Qty 4	% 5	Qty 5	Tot Qty
Concrete Deck Protected w/ Rigid Overlay												
22	4	22	2,725	43	5,262	35	4,250	0	0	0	0	12,237
			No deficiencies.	Repaired areas exist	Map cracked areas.	Spalls/delaminations	Full depth failures.					
Remarks: Lt transverse crking; Small Isol spalls, HP & map crking; PD patch Ln 2 E Jnt (Span 2 Bay 3 & Span 3 Bay 1)												
Lead Painted Steel Open Girder												
107	4	100	28,530	0	0	0	0	0	0	0	0	28,530
			No corrosion	Paint distress	Rust formation	Section loss	Section failure					
Remarks: Span 2-Bott flanges freckle rust												
Non-Lead Painted Steel Closed Web/Box Girder and O												
173	4	100	60	0	0	0	0	0	0	0	0	60
			No corrosion	Paint distress	Rust formation	Section loss	Section failure					
Remarks: Lt pitting (Non-Active) @ Btm Flange South Fascia @ Pier 2 Span 3												
Reinforced Conc Column or Pile Extension												
205	4	100	970	0	0	0	0	0	0	0	0	970
			No deterioration	Minor cracks/spalls	Delams/spalls	Analysis warranted						
Remarks: Pier 2 Col#1 HL map crks												
Reinforced Conc Pier Wall												
210	4	100	942	0	0	0	0	0	0	0	0	942
			No deterioration	Minor cracks/spalls	Delams/spalls	Analysis warranted						
Remarks: Lt vert crking; Pier 1 Wall HL-med vert leach crks												
Reinforced Conc Abutment												
215	4	98	1,902	2	30	0	0	0	0	0	0	1,932
			No deterioration	Minor cracks/spalls	Delams/spalls	Analysis warranted						
Remarks: Lt vert crking in FCR @ W Abut												
Reinforced Conc Pier or Abutment Cap												
234	4	88	224	12	30	0	0	0	0	0	0	254
			No deterioration	Minor cracks/spalls	Delams/spalls	Analysis warranted						
Remarks: Cantilever Pier 1 north & south ends. Pier 2 South Cantilever End has map crking and delams. East Abut- Med horiz crks @ Brg #4.												
Preformed Joint Seal												
302	4	90	56	10	6	0	0	0	0	0	0	62
			No deterioration	Minor deterioration	Major deterioration							
Remarks: Leaking @ East Abut & Pier 1												
Neoprene Expansion Joint												
307	4	97	180	3	6	0	0	0	0	0	0	186
			The element shows mi	The seal maybe punct	The seal maybe heavi	Major deterioration						
Remarks: Leaking @ West Abut & Pier 2												

Movable Discontinuous Brg.												
311	4	100	30	0	0	0	0	0	0	0	0	30
		No deterioration	Minor deterioration	Advanced corrosion								

Remarks:

Fixed Bearing												
313	4	100	30	0	0	0	0	0	0	0	0	30
		No deterioration	Minor deterioration	Advanced corrosion								

Remarks:

Approach Pavement												
323	4	100	2	0	0	0	0	0	0	0	0	2
		No deterioration	Cracks/spalls	Major cracks/spalls		Broken/Unstable						

Remarks:

Concrete Bridge Railing												
331	4	99	410	1	3	0	0	0	0	0	0	413
		No deterioration	Minor cracks/spalls	Analysis warranted								

Remarks:

Steel Open Girder												
406	4	100	6	0	0	0	0	0	0	0	0	6
		Minor fatigue, out-o	Moderate fatigue, ou	Severe fatigue, out-								

Remarks:

Element Description												
Elem	Env	% 1	Qty 1	% 2	Qty 2	% 3	Qty 3	% 4	Qty 4	% 5	Qty 5	Tot Qty
Concrete Deck Protected w/ Rigid Overlay												
22	4	22	2,725	43	5,262	35	4,250	0	0	0	0	12,237
		No deficiencies.	Repaired areas exist	Map cracked areas.		Spalls/delaminations		Full depth failures.				

Remarks:

Lead Painted Steel Open Girder												
107	4	100	28,530	0	0	0	0	0	0	0	0	28,530
		No corrosion	Paint distress	Rust formation		Section loss		Section failure				

Remarks:

Non-Lead Painted Steel Closed Web/Box Girder and O												
173	4	100	60	0	0	0	0	0	0	0	0	60
		No corrosion	Paint distress	Rust formation		Section loss		Section failure				

Remarks:

Reinforced Conc Column or Pile Extension												
205	4	100	970	0	0	0	0	0	0	0	0	970
		No deterioration	Minor cracks/spalls	Delams/spalls		Analysis warranted						

Remarks:

Reinforced Conc Pier Wall												
210	4	100	942	0	0	0	0	0	0	0	0	942
		No deterioration	Minor cracks/spalls	Delams/spalls		Analysis warranted						

Remarks:

Reinforced Conc Abutment												
215	4	98	1,902	2	30	0	0	0	0	0	0	1,932
		No deterioration	Minor cracks/spalls	Delams/spalls		Analysis warranted						

Remarks: Lt vert crking in FCR @ W Abut

Reinforced Conc Pier or Abutment Cap												
234	4	88	224	12	30	0	0	0	0	0	0	254
		No deterioration	Minor cracks/spalls	Delams/spalls		Analysis warranted						

Remarks: Cantilever Pier 1 north & south ends. Pier 2 South Cantilever End has map crking and delams. East Abut- Med horiz crks @ Brg #4.

Preformed Joint Seal												
302	4	90	56	10	6	0	0	0	0	0	0	62
		No deterioration	Minor deterioration	Major deterioration								

Remarks: Leaking @ East Abut & Pier 1

Neoprene Expansion Joint												
307	4	97	180	3	6	0	0	0	0	0	0	186
		The element shows mi	The seal maybe punct	The seal maybe heavi		Major deterioration						

Remarks: Leaking @ West Abut & Pier 2

Movable Discontinuous Brg.												
311	4	100	30	0	0	0	0	0	0	0	0	30
		No deterioration	Minor deterioration	Advanced corrosion								

Remarks:

Fixed Bearing												
313	4	100	30	0	0	0	0	0	0	0	0	30
		No deterioration	Minor deterioration	Advanced corrosion								

Remarks:

Approach Pavement												
323	4	100	2	0	0	0	0	0	0	0	0	2
		No deterioration	Cracks/spalls	Major cracks/spalls		Broken/Unstable						

Remarks: West Aprch- Silicone Relief Jnt missing 80%

Concrete Bridge Railing												
331	4	99	410	1	3	0	0	0	0	0	0	413
		No deterioration	Minor cracks/spalls	Analysis warranted								

Remarks: Lt vert crking; Lt spalls plow damage; Parapet spalled @ Pier 2 Joint

Element Description												
Elem	Env	% 1	Qty 1	% 2	Qty 2	% 3	Qty 3	% 4	Qty 4	% 5	Qty 5	Tot Qty

Concrete Deck Protected w/ Rigid Overlay												
22	4	23	2,855	43	5,262	34	4,120	0	0	0	0	12,237
		No deficiencies.	Repaired areas exist	Map cracked areas.		Spalls/delaminations		Full depth failures.				

Remarks: Lt transverse crking; Small Isol spalls, HP & map crking; PD patch Ln 2 E Jnt (Span 2 Bay 3 & Span 3 Bay 1)

Lead Painted Steel Open Girder												
107	4	100	28,530	0	0	0	0	0	0	0	0	28,530
		No corrosion	Paint distress	Rust formation		Section loss		Section failure				

Remarks: Span 2-Bott flanges freckle rust

Non-Lead Painted Steel Closed Web/Box Girder and O

173	4	100	60	0	0	0	0	0	0	0	0	60
		No corrosion	Paint distress	Rust formation	Section loss	Section failure						

Remarks: Lt pitting (Non-Active) @ Bttm Flange South Fascia @ Pier 2 Span 3

Reinforced Conc Column or Pile Extension

205	4	100	970	0	0	0	0	0	0	0	0	970
		No deterioration	Minor cracks/spalls	Delams/spalls	Analysis warranted							

Remarks: Pier 2 Col#1 HL map crks

Reinforced Conc Pier Wall

210	4	100	942	0	0	0	0	0	0	0	0	942
		No deterioration	Minor cracks/spalls	Delams/spalls	Analysis warranted							

Remarks: Lt vert crking; Pier 1 Wall HL-med vert leach crks

Reinforced Conc Abutment

215	4	98	1,902	2	30	0	0	0	0	0	0	1,932
		No deterioration	Minor cracks/spalls	Delams/spalls	Analysis warranted							

Remarks: Lt vert crking in FCR @ W Abut

Reinforced Conc Pier or Abutment Cap

234	4	89	226	11	28	0	0	0	0	0	0	254
		No deterioration	Minor cracks/spalls	Delams/spalls	Analysis warranted							

Remarks: Cantilever Pier 1 north & south ends. Pier 2 South Cantilever End has map crking and delams. East Abut- Med horiz crks @ Brg #4.

Preformed Joint Seal

302	4	90	56	10	6	0	0	0	0	0	0	62
		No deterioration	Minor deterioration	Major deterioration								

Remarks: Leaking @ East Abut & Pier 1

Neoprene Expansion Joint

307	4	97	180	3	6	0	0	0	0	0	0	186
		The element shows mi	The seal maybe punct	The seal maybe heavi	Major deterioration							

Remarks: Leaking @ West Abut & Pier 2

Movable Discontinuous Brg.

311	4	100	30	0	0	0	0	0	0	0	0	30
		No deterioration	Minor deterioration	Advanced corrosion								

Remarks:

Fixed Bearing

313	4	100	30	0	0	0	0	0	0	0	0	30
		No deterioration	Minor deterioration	Advanced corrosion								

Remarks:

Approach Pavement

323	4	100	2	0	0	0	0	0	0	0	0	2
		No deterioration	Cracks/spalls	Major cracks/spalls		Broken/Unstable						

Remarks: West Apprch- Silicone Relief Jnt missing 80%

Concrete Bridge Railing

331	4	99	410	1	3	0	0	0	0	0	0	413
		No deterioration	Minor cracks/spalls	Analysis warranted								

Remarks: Lt vert crking; Lt spalls plow damage; Parapet spalled @ Pier 2 Joint

Element Description

Elem	Env	% 1	Qty 1	% 2	Qty 2	% 3	Qty 3	% 4	Qty 4	% 5	Qty 5	Tot Qty
Concrete Deck Protected w/ Rigid Overlay												
22	4	23	2,855	43	5,262	34	4,120	0	0	0	0	12,237
		No deficiencies.	Repaired areas exist	Map cracked areas.	Spalls/delaminations	Full depth failures.						
Remarks: Lt transverse crking; Small Isol spalls, HP & map crking; PD patch Ln 2 E Jnt (, Span 2 Bay#3& Span 3 Bay#1)												
Lead Painted Steel Open Girder												
107	4	100	28,530	0	0	0	0	0	0	0	0	28,530
		No corrosion	Paint distress	Rust formation	Section loss	Section failure						
Remarks: Span 2-Bott flanges freckle rust												
Non-Lead Painted Steel Closed Web/Box Girder and O												
173	4	100	60	0	0	0	0	0	0	0	0	60
		No corrosion	Paint distress	Rust formation	Section loss	Section failure						
Remarks:												
Reinforced Conc Column or Pile Extension												
205	4	100	970	0	0	0	0	0	0	0	0	970
		No deterioration	Minor cracks/spalls	Delams/spalls	Analysis warranted							
Remarks: Pier 2 Col#1 HL map crks												
Reinforced Conc Pier Wall												
210	4	100	942	0	0	0	0	0	0	0	0	942
		No deterioration	Minor cracks/spalls	Delams/spalls	Analysis warranted							
Remarks: Lt vert crking; Pier 1 Wall HL-med vert leach crks												
Reinforced Conc Abutment												
215	4	98	1,902	2	30	0	0	0	0	0	0	1,932
		No deterioration	Minor cracks/spalls	Delams/spalls	Analysis warranted							
Remarks: Lt vert crking in FCR @ W Abut												
Reinforced Conc Pier or Abutment Cap												
234	4	92	234	8	20	0	0	0	0	0	0	254
		No deterioration	Minor cracks/spalls	Delams/spalls	Analysis warranted							
Remarks: Cantilever Pier 1 north & south ends. East Abut- Med horiz crks @ Brg #4.												
Preformed Joint Seal												
302	4	90	56	10	6	0	0	0	0	0	0	62
		No deterioration	Minor deterioration	Major deterioration								
Remarks: Leaking @ East Abut & Pier 1												
Neoprene Expansion Joint												
307	4	97	180	3	6	0	0	0	0	0	0	186
		The element shows mi	The seal maybe punct	The seal maybe heavi	Major deterioration							
Remarks: Leaking @ West Abut & Pier 2												
Movable Discontinuous Brg.												
311	4	100	30	0	0	0	0	0	0	0	0	30
		No deterioration	Minor deterioration	Advanced corrosion								
Remarks:												
Fixed Bearing												
313	4	100	30	0	0	0	0	0	0	0	0	30
		No deterioration	Minor deterioration	Advanced corrosion								

Remarks:

Approach Pavement

323	4	100	2	0	0	0	0	0	0	0	0	2
			No deterioration	Cracks/spalls	Major cracks/spalls	Broken/Unstable						

Remarks:

Concrete Bridge Railing

331	4	99	410	1	3	0	0	0	0	0	0	413
			No deterioration	Minor cracks/spalls	Analysis warranted							

Remarks:

Element Description

Elem	Env	% 1	Qty 1	% 2	Qty 2	% 3	Qty 3	% 4	Qty 4	% 5	Qty 5	Tot Qty
Concrete Deck Protected w/ Rigid Overlay												
22	4	23	2,855	43	5,262	34	4,120	0	0	0	0	12,237
			No deficiencies.	Repaired areas exist	Map cracked areas.	Spalls/delaminations	Full depth failures.					

Remarks:

Lead Painted Steel Open Girder

107	4	100	28,530	0	0	0	0	0	0	0	0	28,530
			No corrosion	Paint distress	Rust formation	Section loss	Section failure					

Remarks:

Non-Lead Painted Steel Closed Web/Box Girder and O

173	4	100	60	0	0	0	0	0	0	0	0	60
			No corrosion	Paint distress	Rust formation	Section loss	Section failure					

Remarks:

Reinforced Conc Column or Pile Extension

205	4	100	970	0	0	0	0	0	0	0	0	970
			No deterioration	Minor cracks/spalls	Delams/spalls	Analysis warranted						

Remarks:

Reinforced Conc Pier Wall

210	4	100	942	0	0	0	0	0	0	0	0	942
			No deterioration	Minor cracks/spalls	Delams/spalls	Analysis warranted						

Remarks:

Reinforced Conc Abutment

215	4	98	1,902	2	30	0	0	0	0	0	0	1,932
			No deterioration	Minor cracks/spalls	Delams/spalls	Analysis warranted						

Remarks:

Reinforced Conc Pier or Abutment Cap

234	4	92	234	8	20	0	0	0	0	0	0	254
			No deterioration	Minor cracks/spalls	Delams/spalls	Analysis warranted						

Remarks:

Preformed Joint Seal

302	4	90	56	10	6	0	0	0	0	0	0	62
			No deterioration	Minor deterioration	Major deterioration							

Remarks:

Neoprene Expansion Joint

307	4	97	180	3	6	0	0	0	0	0	0	186
-----	---	----	-----	---	---	---	---	---	---	---	---	-----

The element shows mi The seal maybe punct The seal maybe heavi Major deterioration

Remarks:

Movable Discontinuous Brg.

311	4	100	30	0	0	0	0	0	0	0	0	30
-----	---	-----	----	---	---	---	---	---	---	---	---	----

No deterioration Minor deterioration Advanced corrosion

Remarks:

Fixed Bearing

313	4	100	30	0	0	0	0	0	0	0	0	30
-----	---	-----	----	---	---	---	---	---	---	---	---	----

No deterioration Minor deterioration Advanced corrosion

Remarks:

Approach Pavement

323	4	100	2	0	0	0	0	0	0	0	0	2
-----	---	-----	---	---	---	---	---	---	---	---	---	---

No deterioration Cracks/spalls Major cracks/spalls Broken/Unstable

Remarks:

Concrete Bridge Railing

331	4	100	413	0	0	0	0	0	0	0	0	413
-----	---	-----	-----	---	---	---	---	---	---	---	---	-----

No deterioration Minor cracks/spalls Analysis warranted

Remarks:

Element Description

Elem	Env	% 1	Qty 1	% 2	Qty 2	% 3	Qty 3	% 4	Qty 4	% 5	Qty 5	Tot Qty
------	-----	-----	-------	-----	-------	-----	-------	-----	-------	-----	-------	---------

Concrete Deck Protected w/ Rigid Overlay

22	4	23	2,855	43	5,262	34	4,120	0	0	0	0	12,237
----	---	----	-------	----	-------	----	-------	---	---	---	---	--------

No deficiencies. Repaired areas exist Map cracked areas. Spalls/delaminations Full depth failures.

Remarks:

Lead Painted Steel Open Girder

107	4	100	28,530	0	0	0	0	0	0	0	0	28,530
-----	---	-----	--------	---	---	---	---	---	---	---	---	--------

No corrosion Paint distress Rust formation Section loss Section failure

Remarks:

Non-Lead Painted Steel Closed Web/Box Girder and O

173	4	100	60	0	0	0	0	0	0	0	0	60
-----	---	-----	----	---	---	---	---	---	---	---	---	----

No corrosion Paint distress Rust formation Section loss Section failure

Remarks:

Reinforced Conc Column or Pile Extension

205	4	100	970	0	0	0	0	0	0	0	0	970
-----	---	-----	-----	---	---	---	---	---	---	---	---	-----

No deterioration Minor cracks/spalls Delams/spalls Analysis warranted

Remarks:

Reinforced Conc Pier Wall

210	4	100	942	0	0	0	0	0	0	0	0	942
-----	---	-----	-----	---	---	---	---	---	---	---	---	-----

No deterioration Minor cracks/spalls Delams/spalls Analysis warranted

Remarks:

Reinforced Conc Abutment

215	4	100	1,932	0	0	0	0	0	0	0	0	1,932
		No deterioration	Minor cracks/spalls	Delams/spalls	Analysis warranted							

Remarks:

Reinforced Conc Pier or Abutment Cap

234	4	92	234	8	20	0	0	0	0	0	0	254
		No deterioration	Minor cracks/spalls	Delams/spalls	Analysis warranted							

Remarks:

Preformed Joint Seal

302	4	90	56	10	6	0	0	0	0	0	0	62
		No deterioration	Minor deterioration	Major deterioration								

Remarks:

Neoprene Expansion Joint

307	4	97	180	3	6	0	0	0	0	0	0	186
		The element shows mi	The seal maybe punct	The seal maybe heavi		Major deterioration						

Remarks:

Movable Discontinuous Brg.

311	4	100	30	0	0	0	0	0	0	0	0	30
		No deterioration	Minor deterioration	Advanced corrosion								

Remarks:

Fixed Bearing

313	4	100	30	0	0	0	0	0	0	0	0	30
		No deterioration	Minor deterioration	Advanced corrosion								

Remarks:

Approach Pavement

323	4	100	2	0	0	0	0	0	0	0	0	2
		No deterioration	Cracks/spalls	Major cracks/spalls		Broken/Unstable						

Remarks:

Concrete Bridge Railing

331	4	100	413	0	0	0	0	0	0	0	0	413
		No deterioration	Minor cracks/spalls	Analysis warranted								

Remarks:

Element Description

Elem	Env	% 1	Qty 1	% 2	Qty 2	% 3	Qty 3	% 4	Qty 4	% 5	Qty 5	Tot Qty
Concrete Deck Protected w/ Rigid Overlay												
22	4	23	2,855	43	5,262	34	4,120	0	0	0	0	12,237
		No deficiencies.	Repaired areas exist	Map cracked areas.		Spalls/delaminations		Full depth failures.				

Remarks:

Lead Painted Steel Open Girder

107	4	100	28,530	0	0	0	0	0	0	0	0	28,530
		No corrosion	Paint distress	Rust formation		Section loss		Section failure				

Remarks:

Non-Lead Painted Steel Closed Web/Box Girder and O

173	4	100	60	0	0	0	0	0	0	0	0	60
		No corrosion	Paint distress	Rust formation	Section loss	Section failure						

Remarks:

Reinforced Conc Column or Pile Extension

205	4	100	970	0	0	0	0	0	0	0	0	970
		No deterioration	Minor cracks/spalls	Delams/spalls	Analysis warranted							

Remarks:

Reinforced Conc Pier Wall

210	4	100	942	0	0	0	0	0	0	0	0	942
		No deterioration	Minor cracks/spalls	Delams/spalls	Analysis warranted							

Remarks:

Reinforced Conc Abutment

215	4	100	1,932	0	0	0	0	0	0	0	0	1,932
		No deterioration	Minor cracks/spalls	Delams/spalls	Analysis warranted							

Remarks:

Reinforced Conc Pier or Abutment Cap

234	4	92	234	8	20	0	0	0	0	0	0	254
		No deterioration	Minor cracks/spalls	Delams/spalls	Analysis warranted							

Remarks:

Preformed Joint Seal

302	4	90	56	10	6	0	0	0	0	0	0	62
		No deterioration	Minor deterioration	Major deterioration								

Remarks:

Neoprene Expansion Joint

307	4	97	180	3	6	0	0	0	0	0	0	186
		The element shows mi	The seal maybe punct	The seal maybe heavi	Major deterioration							

Remarks:

Movable Discontinuous Brg.

311	4	100	30	0	0	0	0	0	0	0	0	30
		No deterioration	Minor deterioration	Advanced corrosion								

Remarks:

Fixed Bearing

313	4	100	30	0	0	0	0	0	0	0	0	30
		No deterioration	Minor deterioration	Advanced corrosion								

Remarks:

Approach Pavement

323	4	100	2	0	0	0	0	0	0	0	0	2
		No deterioration	Cracks/spalls	Major cracks/spalls		Broken/Unstable						

Remarks:

Concrete Bridge Railing

331	4	100	413	0	0	0	0	0	0	0	0	413
		No deterioration	Minor cracks/spalls	Analysis warranted								

Remarks:

Element Description

Elem	Env	% 1	Qty 1	% 2	Qty 2	% 3	Qty 3	% 4	Qty 4	% 5	Qty 5	Tot Qty
Concrete Deck Protected w/ Rigid Overlay												
22	4	23	2,855	43	5,262	34	4,120	0	0	0	0	12,237
		No deficiencies.	Repaired areas exist		Map cracked areas.		Spalls/delaminations		Full depth failures.			
Remarks: <input type="text"/>												
Lead Painted Steel Open Girder												
107	4	100	28,530	0	0	0	0	0	0	0	0	28,530
		No corrosion	Paint distress		Rust formation		Section loss		Section failure			
Remarks: <input type="text"/>												
Non-Lead Painted Steel Closed Web/Box Girder and O												
173	4	100	60	0	0	0	0	0	0	0	0	60
		No corrosion	Paint distress		Rust formation		Section loss		Section failure			
Remarks: <input type="text"/>												
Reinforced Conc Column or Pile Extension												
205	4	100	970	0	0	0	0	0	0	0	0	970
		No deterioration	Minor cracks/spalls		Delams/spalls		Analysis warranted					
Remarks: <input type="text"/>												
Reinforced Conc Pier Wall												
210	4	100	942	0	0	0	0	0	0	0	0	942
		No deterioration	Minor cracks/spalls		Delams/spalls		Analysis warranted					
Remarks: <input type="text"/>												
Reinforced Conc Abutment												
215	4	100	1,932	0	0	0	0	0	0	0	0	1,932
		No deterioration	Minor cracks/spalls		Delams/spalls		Analysis warranted					
Remarks: <input type="text"/>												
Reinforced Conc Pier or Abutment Cap												
234	4	92	234	8	20	0	0	0	0	0	0	254
		No deterioration	Minor cracks/spalls		Delams/spalls		Analysis warranted					
Remarks: <input type="text"/>												
Preformed Joint Seal												
302	4	100	62	0	0	0	0	0	0	0	0	62
		No deterioration	Minor deterioration		Major deterioration							
Remarks: <input type="text"/>												
Neoprene Expansion Joint												
307	4	100	186	0	0	0	0	0	0	0	0	186
		The element shows mi	The seal maybe punct		The seal maybe heavi		Major deterioration					
Remarks: <input type="text"/>												
Movable Discontinuous Brg.												
311	4	100	30	0	0	0	0	0	0	0	0	30
		No deterioration	Minor deterioration		Advanced corrosion							
Remarks: <input type="text"/>												
Fixed Bearing												
313	4	100	30	0	0	0	0	0	0	0	0	30
		No deterioration	Minor deterioration		Advanced corrosion							

Remarks:

Approach Pavement

323	4	100	2	0	0	0	0	0	0	0	0	2
		No deterioration	Cracks/spalls	Major cracks/spalls	Broken/Unstable							

Remarks:

Concrete Bridge Railing

331	4	100	413	0	0	0	0	0	0	0	0	413
		No deterioration	Minor cracks/spalls	Analysis warranted								

Remarks:

Element Description												
Elem	Env	% 1	Qty 1	% 2	Qty 2	% 3	Qty 3	% 4	Qty 4	% 5	Qty 5	Tot Qty
Concrete Deck Protected w/ AC Overlay												
14	4	75	9,218	0	0	25	3,073	0	0	0	0	12,290
		No deficiencies.	Repaired areas.	Map cracked areas.	Spalls/delam exist.	Full depth failures.						
Remarks: <input type="text"/>												
Lead Painted Steel Open Girder												
107	4	93	26,533	7	1,997	0	0	0	0	0	0	28,530
		No corrosion	Paint distress	Rust formation	Section loss	Section failure						
Remarks: <input type="text"/>												
Lead Painted Steel Closed Web/Box Girder and Open												
172	4	100	50	0	0	0	0	0	0	0	0	50
		No corrosion	Paint distress	Rust formation	Section loss	Section failure						
Remarks: <input type="text"/>												
Reinforced Conc Column or Pile Extension												
205	4	82	795	10	97	8	78	0	0	0	0	970
		No deterioration	Minor cracks/spalls	Delams/spalls	Analysis warranted							
Remarks: <input type="text"/>												
Reinforced Conc Pier Wall												
210	4	100	942	0	0	0	0	0	0	0	0	942
		No deterioration	Minor cracks/spalls	Delams/spalls	Analysis warranted							
Remarks: <input type="text"/>												
Reinforced Conc Abutment												
215	4	100	1,932	0	0	0	0	0	0	0	0	1,932
		No deterioration	Minor cracks/spalls	Delams/spalls	Analysis warranted							
Remarks: <input type="text"/>												
Reinforced Conc Pier or Abutment Cap												
234	4	86	218	8	20	6	15	0	0	0	0	254
		No deterioration	Minor cracks/spalls	Delams/spalls	Analysis warranted							
Remarks: <input type="text"/>												
Neoprene Expansion Joint												
307	4	52	207	45	180	3	12	0	0	0	0	399
		The element shows mi	The seal maybe punct	The seal maybe heavi	Major deterioration							
Remarks: <input type="text"/>												

Movable Discontinuous Brg.

311	4	67	20	33	10	0	0	0	0	0	0	30
		No deterioration	Minor deterioration	Advanced corrosion								

Remarks:

Fixed Bearing

313	4	87	26	13	4	0	0	0	0	0	0	30
		No deterioration	Minor deterioration	Advanced corrosion								

Remarks:

Approach Pavement

323	4	0	0	100	2	0	0	0	0	0	0	2
		No deterioration	Cracks/spalls	Major cracks/spalls		Broken/Unstable						

Remarks:

Concrete Bridge Railing



331	4	47	194	29	120	24	99	0	0	0	0	413
		No deterioration	Minor cracks/spalls	Analysis warranted								

Remarks:

Download Date: 04/18/2013


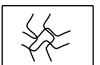
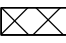
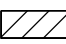
ATTACHMENT D

Bottom of Deck Condition Survey

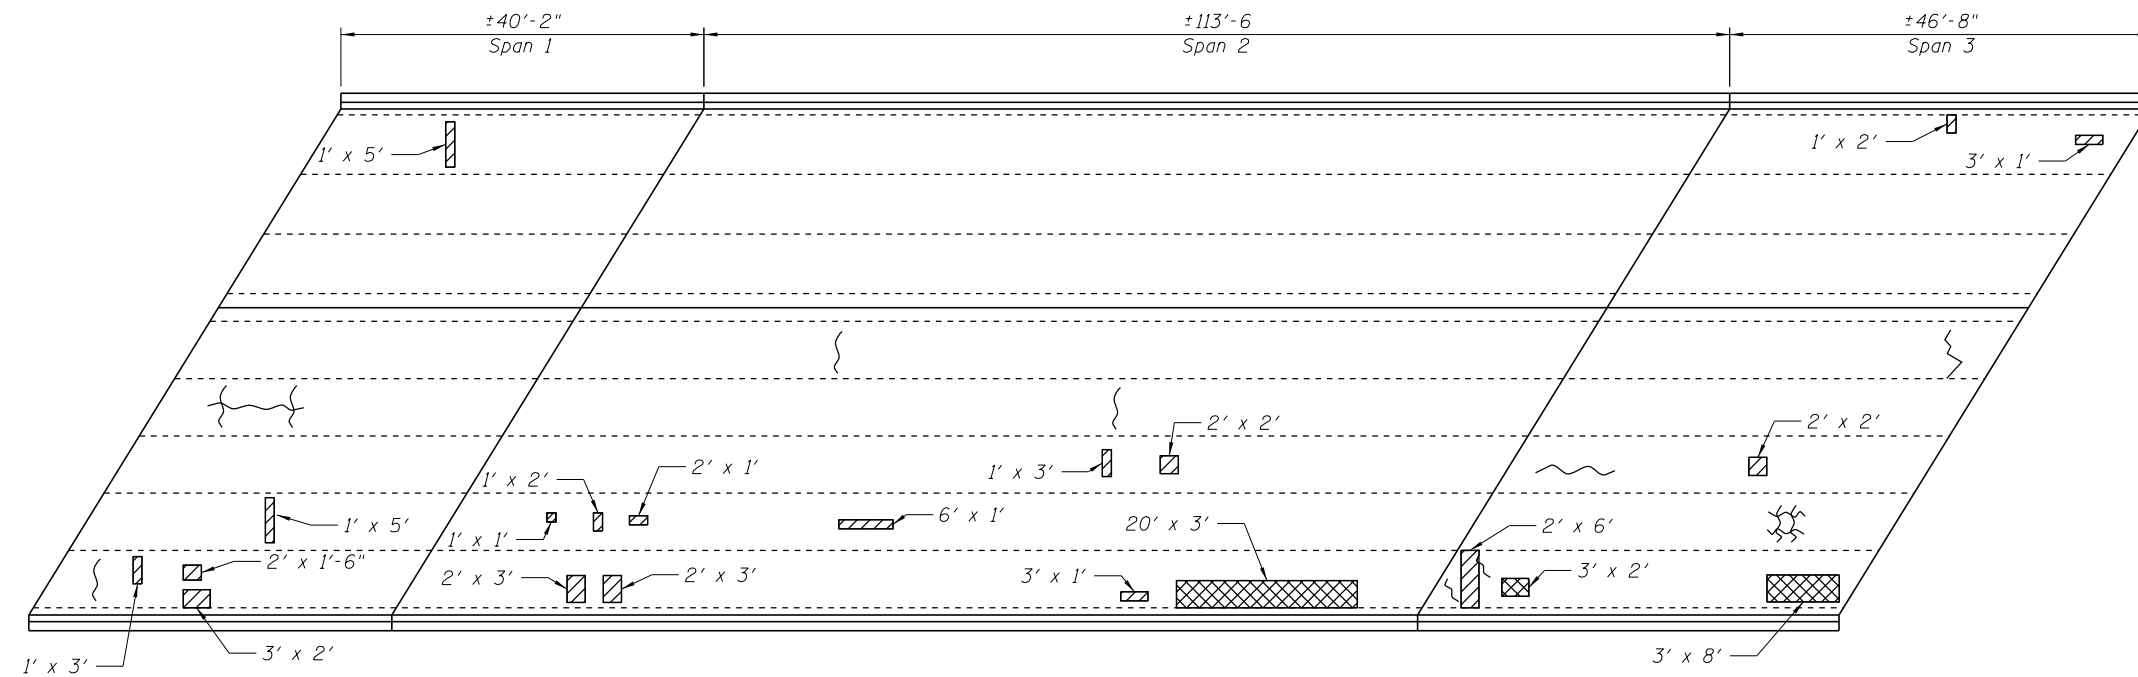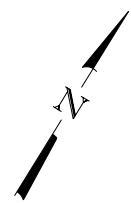

UNDERSIDE OF DECK
(Eastbound Bridge)

LEGEND

-  - CRACKED CONCRETE
-  - MAP CRACKING
-  - SPALLED CONCRETE
-  - DELAMINATED CONCRETE

FILE NAME = V:\1786\active\178600037_IDOT_1-95\structural\drawing\shd\deg_Cicero.Avenue.Underside_of_Deck.dgn



USER NAME = jerojas	DESIGNED - JSR	REVISED -
	CHECKED - BPS	REVISED -
PLOT SCALE = N/A	DRAWN - JSR	REVISED -
PLOT DATE = 10/9/2013	CHECKED - BPS	REVISED -

STATE OF ILLINOIS
DEPARTMENT OF TRANSPORTATION

ATTACHMENT D - BOTTOM OF DECK CONDITION SURVEY
STRUCTURE NO. 016-0016

SHEET NO. 1 OF 1 SHEETS

F.A.I. RTE.	SECTION	COUNTY	TOTAL SHEETS	SHEET NO.
55	1112-619-HB	COOK		
CONTRACT NO.				
FED. ROAD DIST. NO. 1 ILLINOIS FED. AID PROJECT				

ATTACHMENT E

**Condition Assessment of the Reinforced
Concrete Bridge Deck**

January 6, 2012

Ms. Diane M. O'Keefe
Deputy Director of Highways
District One Engineer
Illinois Department of Transportation
201 West Center Court
Schaumburg, Illinois 60196-1096
Attn: Ms. Sarah Wilson (Maintenance Bridge Engineer)

Re: Condition Assessment of Bridge Deck
I-55 Eastbound over IL-50 (Cicero Avenue)
Structure No. 016-0016
District One
Work Order 10
PTB No. 153-18
WJE No. 2009.3645.10

Dear Ms. O'Keefe:

At your request, Wiss, Janney, Elstner Associates, Inc. (WJE) completed a condition assessment of the reinforced concrete bridge deck for Structure No. 016-0016. This work included a visual assessment of concrete deterioration from below the structure. Also included was a delamination survey performed on the top of the bridge deck, based on an infrared thermography (IR) survey. Reinforcing bar cover depth determination was also performed using ground penetrating radar (GPR). These inspection tasks began in July and were completed in September.

Structure Description

The I-55 Eastbound Bridge over Cicero Avenue, IL-50 carries three lanes of traffic and two shoulders. This three span structure is comprised of steel beam and concrete deck construction. Each of the 10 girder lines is connected using steel diaphragms or cross frames. All deck and substructure components are comprised of cast-in-place reinforced concrete construction. Reportedly the bridge structure was originally constructed in 1963 and the current overlay was installed in 2000.

The spans have approximate lengths of 40 ft-7 in, 113 ft-11 in, and 46 ft-3 in., from west-to-east, for a total structure length of 206ft-8 in., back-to-back of abutments. The total deck width out-to-out is 59 ft-5 in. and the deck width to the inside faces of the parapet walls is 56 ft. The total resulting bridge deck area is approximately 10,900 sq. ft. A partial elevation view of the structure looking north is included as Figure 1.

Inspection Methods

The condition of the reinforced concrete bridge deck was assessed using several methods. These methods can be broken down into two major categories: Bottom of Deck Inspection Methods and Top of Deck Inspection Methods.

Bottom of Deck Inspection Methods

The condition of the bottom of the reinforced concrete deck was assessed from grade below the structure in September 2011. All accessible areas of the bottom of the deck were assessed visually. This inspection was completed from the ground beneath the bridge outside of active traffic lanes. Binoculars and/or zoom lenses were used to magnify the view of distant surfaces. Plan drawings of the structure including the structural framing were used to record field notes.

Top of Deck Inspection Methods

The condition of the top of the reinforced concrete deck was assessed using IR equipment to map areas of spalls, patches, and delaminations. This work was subcontracted to Infrasense, Inc. and was performed in July, 2011. Rolling lane closures were utilized during data collection periods to allow the IR data collection vehicle to assess the entire bridge deck surface while moving at approximately 3 mph. Impact Echo (IE) and sounding techniques were used to confirm the presence of delaminations at select locations on each bridge deck. All IR data was analyzed and summarized on bridge deck drawing sheets that show the located defects to scale.

GPR equipment was used to identify the cover depth of the top mat of reinforcing steel from the top surface of the deck. The GPR equipment was mounted to an inspection vehicle and scans were completed at normal operating speeds.

Assessment Results

The reinforced concrete bridge deck was found to be in satisfactory condition overall. Results for each assessment category are included below.

Bottom of Deck

Visual inspection from grade below the bridge was used to assess the bottom of the bridge deck. All areas of spalls or delaminations that could be identified visually were documented. In addition, all areas of previously repaired concrete were noted. Table 1 includes a summary of the visual inspection, including total deck soffit area, the area of spalled concrete, the area of delaminated concrete and the area of previous repairs. Figures 2 and 3 show the typical condition of the deck soffit. The results of the bottom of deck survey are shown on Sheet S-3 of Appendix A.

Table 1. Bottom of Deck Deterioration Summary

Soffit Area (sq. ft)	Spalled Area (sq. ft)	Total Area (%)	Delaminated Area (sq. ft)	Total Area (%)	Previously Repaired Area (sq.ft)
10,900	50	0.5	180	1.7	1575

Top of Deck

The top of the bridge deck was assessed using both IR and GPR equipment. The IR survey equipment was able to identify delaminations and spalls present in the bridge deck. Figure 4 is an overall view of the top deck surface looking northeast.

Table 2 includes a summary of the total bridge deck area, the total bridge deck area spalled, the total bridge deck area delaminated, the total bridge deck area that should be programmed for repair work and the rebar cover from the top surface of the deck. Sheet S-1 of Appendix A is a scaled bridge deck plan drawing showing the locations of the delaminated or spalled areas. Sheet S-2 of Appendix A is a scaled bridge deck plan drawing showing an image of the IR scan of the bridge. Sheet S-4 of Appendix A is a scaled bridge deck plan drawing showing the location of suggested partial and full depth concrete repairs using conventional patching techniques. Note that repair area boundaries were selected by expanding the boundaries of each delaminated or spalled area by 6 inches to account for saw cutting outside of the delamination and further deterioration prior to the actual start of any repair work. In addition, repair areas were joined when adjacent repairs were spaced at approximately 2 ft. or less. Full depth repair boundaries were determined based on locations where top and bottom surface defects overlapped. No bottom surface repairs were identified based on recommendations from IDOT.

Table 2. Top of Deck Deterioration Summary

Bridge Deck Area (sq. ft)	Spalled Area (sq. ft)	Total Area (%)	Delaminated Area (sq. ft)	Total Area (%)	Repair Area (sq. ft)	Total Area (%)	Rebar Cover (in.)
10,900	0	0	615	5.6	1382	12.7	3.9

Recommendations and Conclusions

WJE performed a condition assessment of the reinforced concrete bridge deck of the I-55 Eastbound Bridge over IL-50, Cicero Avenue. This condition assessment included: a visual survey of the bottom of the deck and an IR survey of the top of the deck. This information was used to produce repair drawings indicating the size and location of anticipated repair areas.


The repair work should, at a minimum, include partial depth repairs at all locations indicated on Sheet S-4 in Appendix A. If this option is selected, a detailed delamination assessment should be completed by the contractor at the time of the repair work to ensure that all areas of deteriorated concrete are identified. In addition, all re-entrant corners of repair areas should be detailed to include a 4 inch chamfer to reduce the potential for concrete-shrinkage related cracking.

The bridge deck was found to currently be in satisfactory condition, but corrosion-related damage has become apparent and should be repaired.


We would be happy to answer any questions or provide additional information.

Sincerely,

WISS, JANNEY, ELSTNER ASSOCIATES, INC.

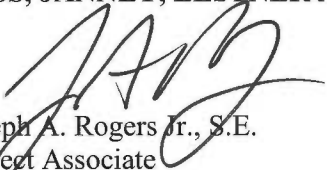

Joseph A. Rogers Jr., S.E.
Project Associate

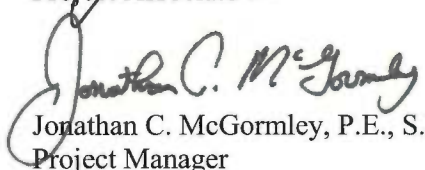

Jonathan C. McGormley, P.E., S.E.
Project Manager

Figures



Figure 1. Elevation view, looking north. Photo from Google Streetview



Figure 2. Typical view, deck soffit, southeast corner.

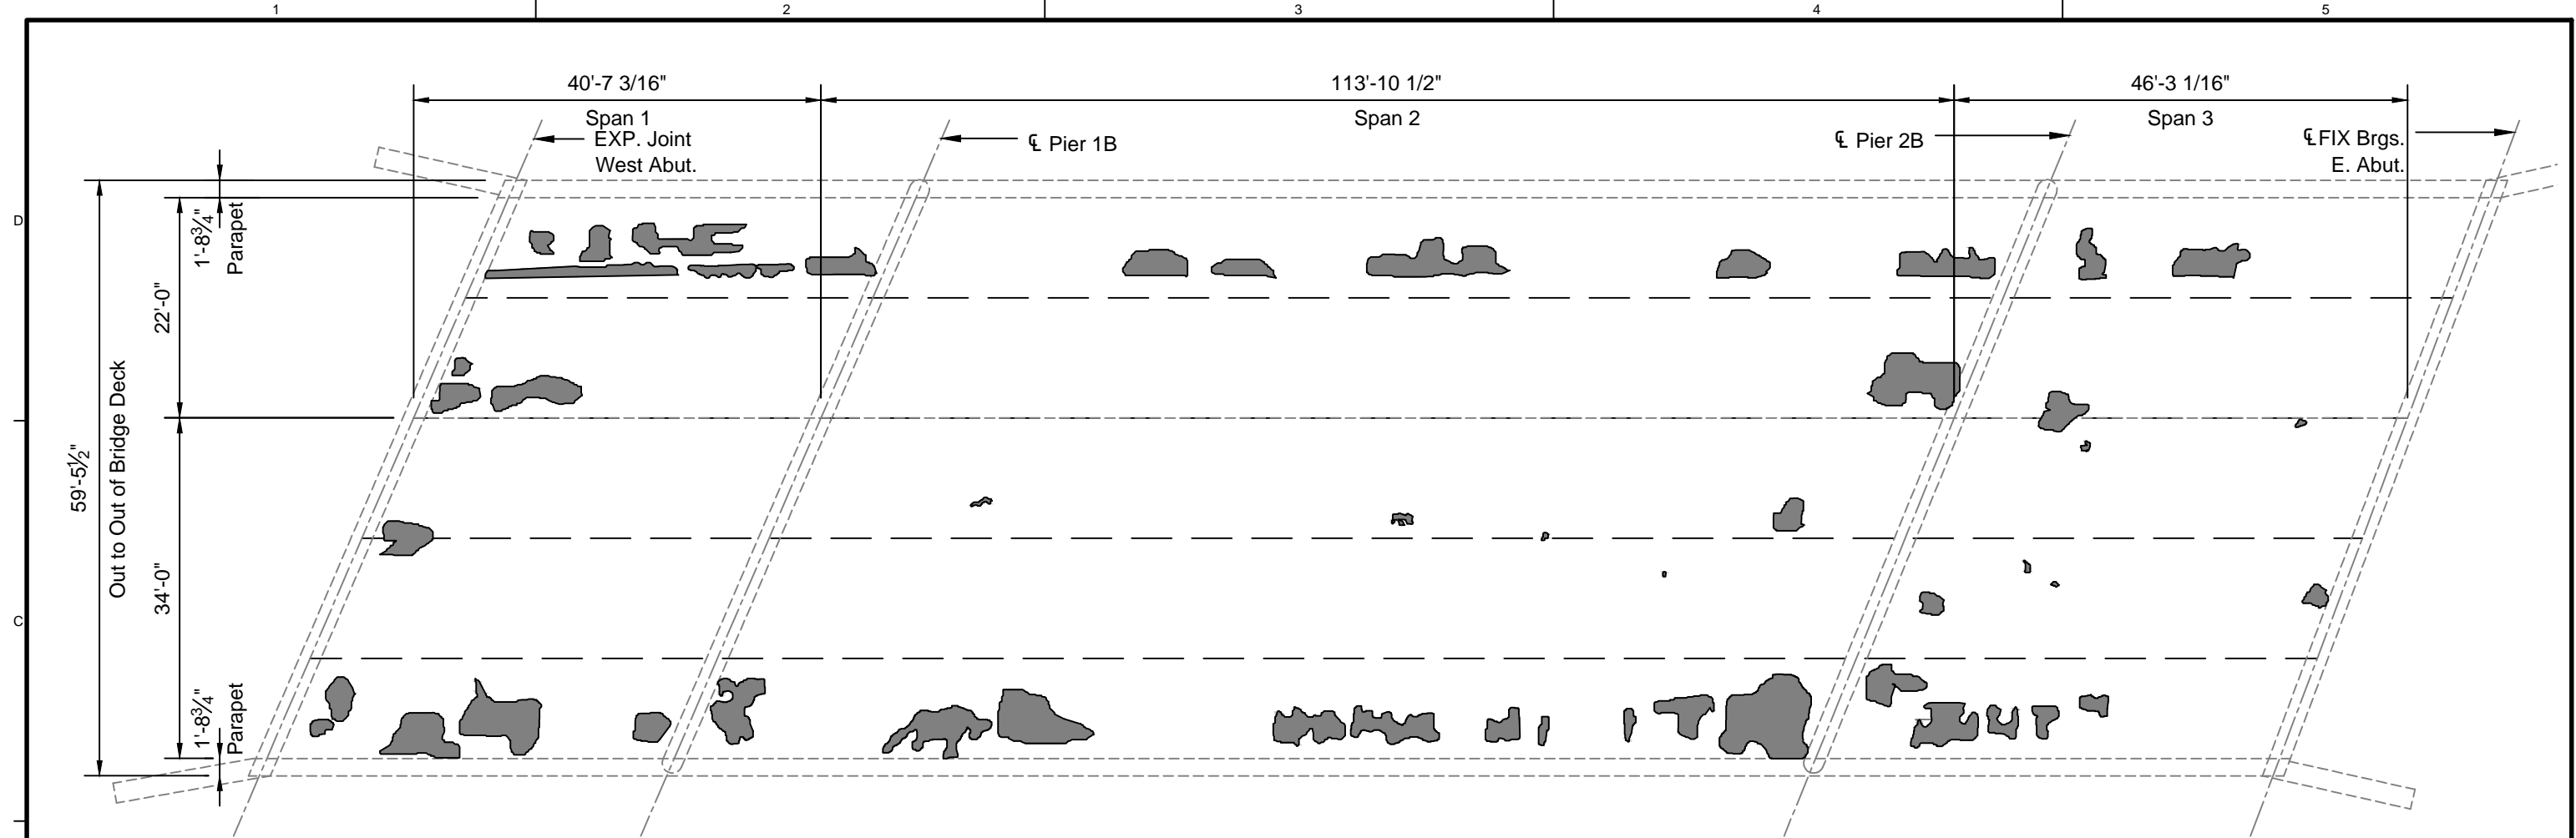


Figure 3. Typical view, deck soffit, west end.

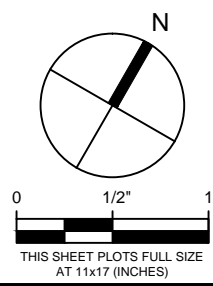


Figure 4. Typical view, deck top surface, looking northeast

Appendix A - Bridge Deck Condition Assessment Drawings



FIELD OBSERVATION SUMMARY		STRUCTURE # 016-0016		LEGEND	
ITEM	UNIT	QUANT.	%	DELAMINATION	
TOTAL AREA	Ac	10,900	100	SPALL	
DELAMINATION	Ac	615	5.6	CRACK	
SPALL	Ac	0	0		
CRACKS	ft	-	-		





WJE ENGINEERS ARCHITECTS MATERIALS SCIENTISTS
 Wiss, Janney, Elstner Associates, Inc.
 330 Pfingsten Road
 Northbrook, Illinois 60062
 847.272.7400 tel | 847.291.4813 fax
 www.wje.com

Client
 Illinois Department of Transportation
 District One
 201 West Center Court
 Schaumburg, Illinois 60196

Project
 Bridge 016-0016
 EASTBOUND I-55 OVER CICERO AVENUE
 Sheet Title
 IR Result - Top Surface

Proj. No. 2009.3645.10
 Date November 19 2011
 Drawn JJZ
 Checked JAR
 Scale 1/16" = 1'-0"

Sheet No. **S1**

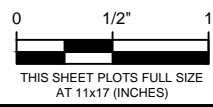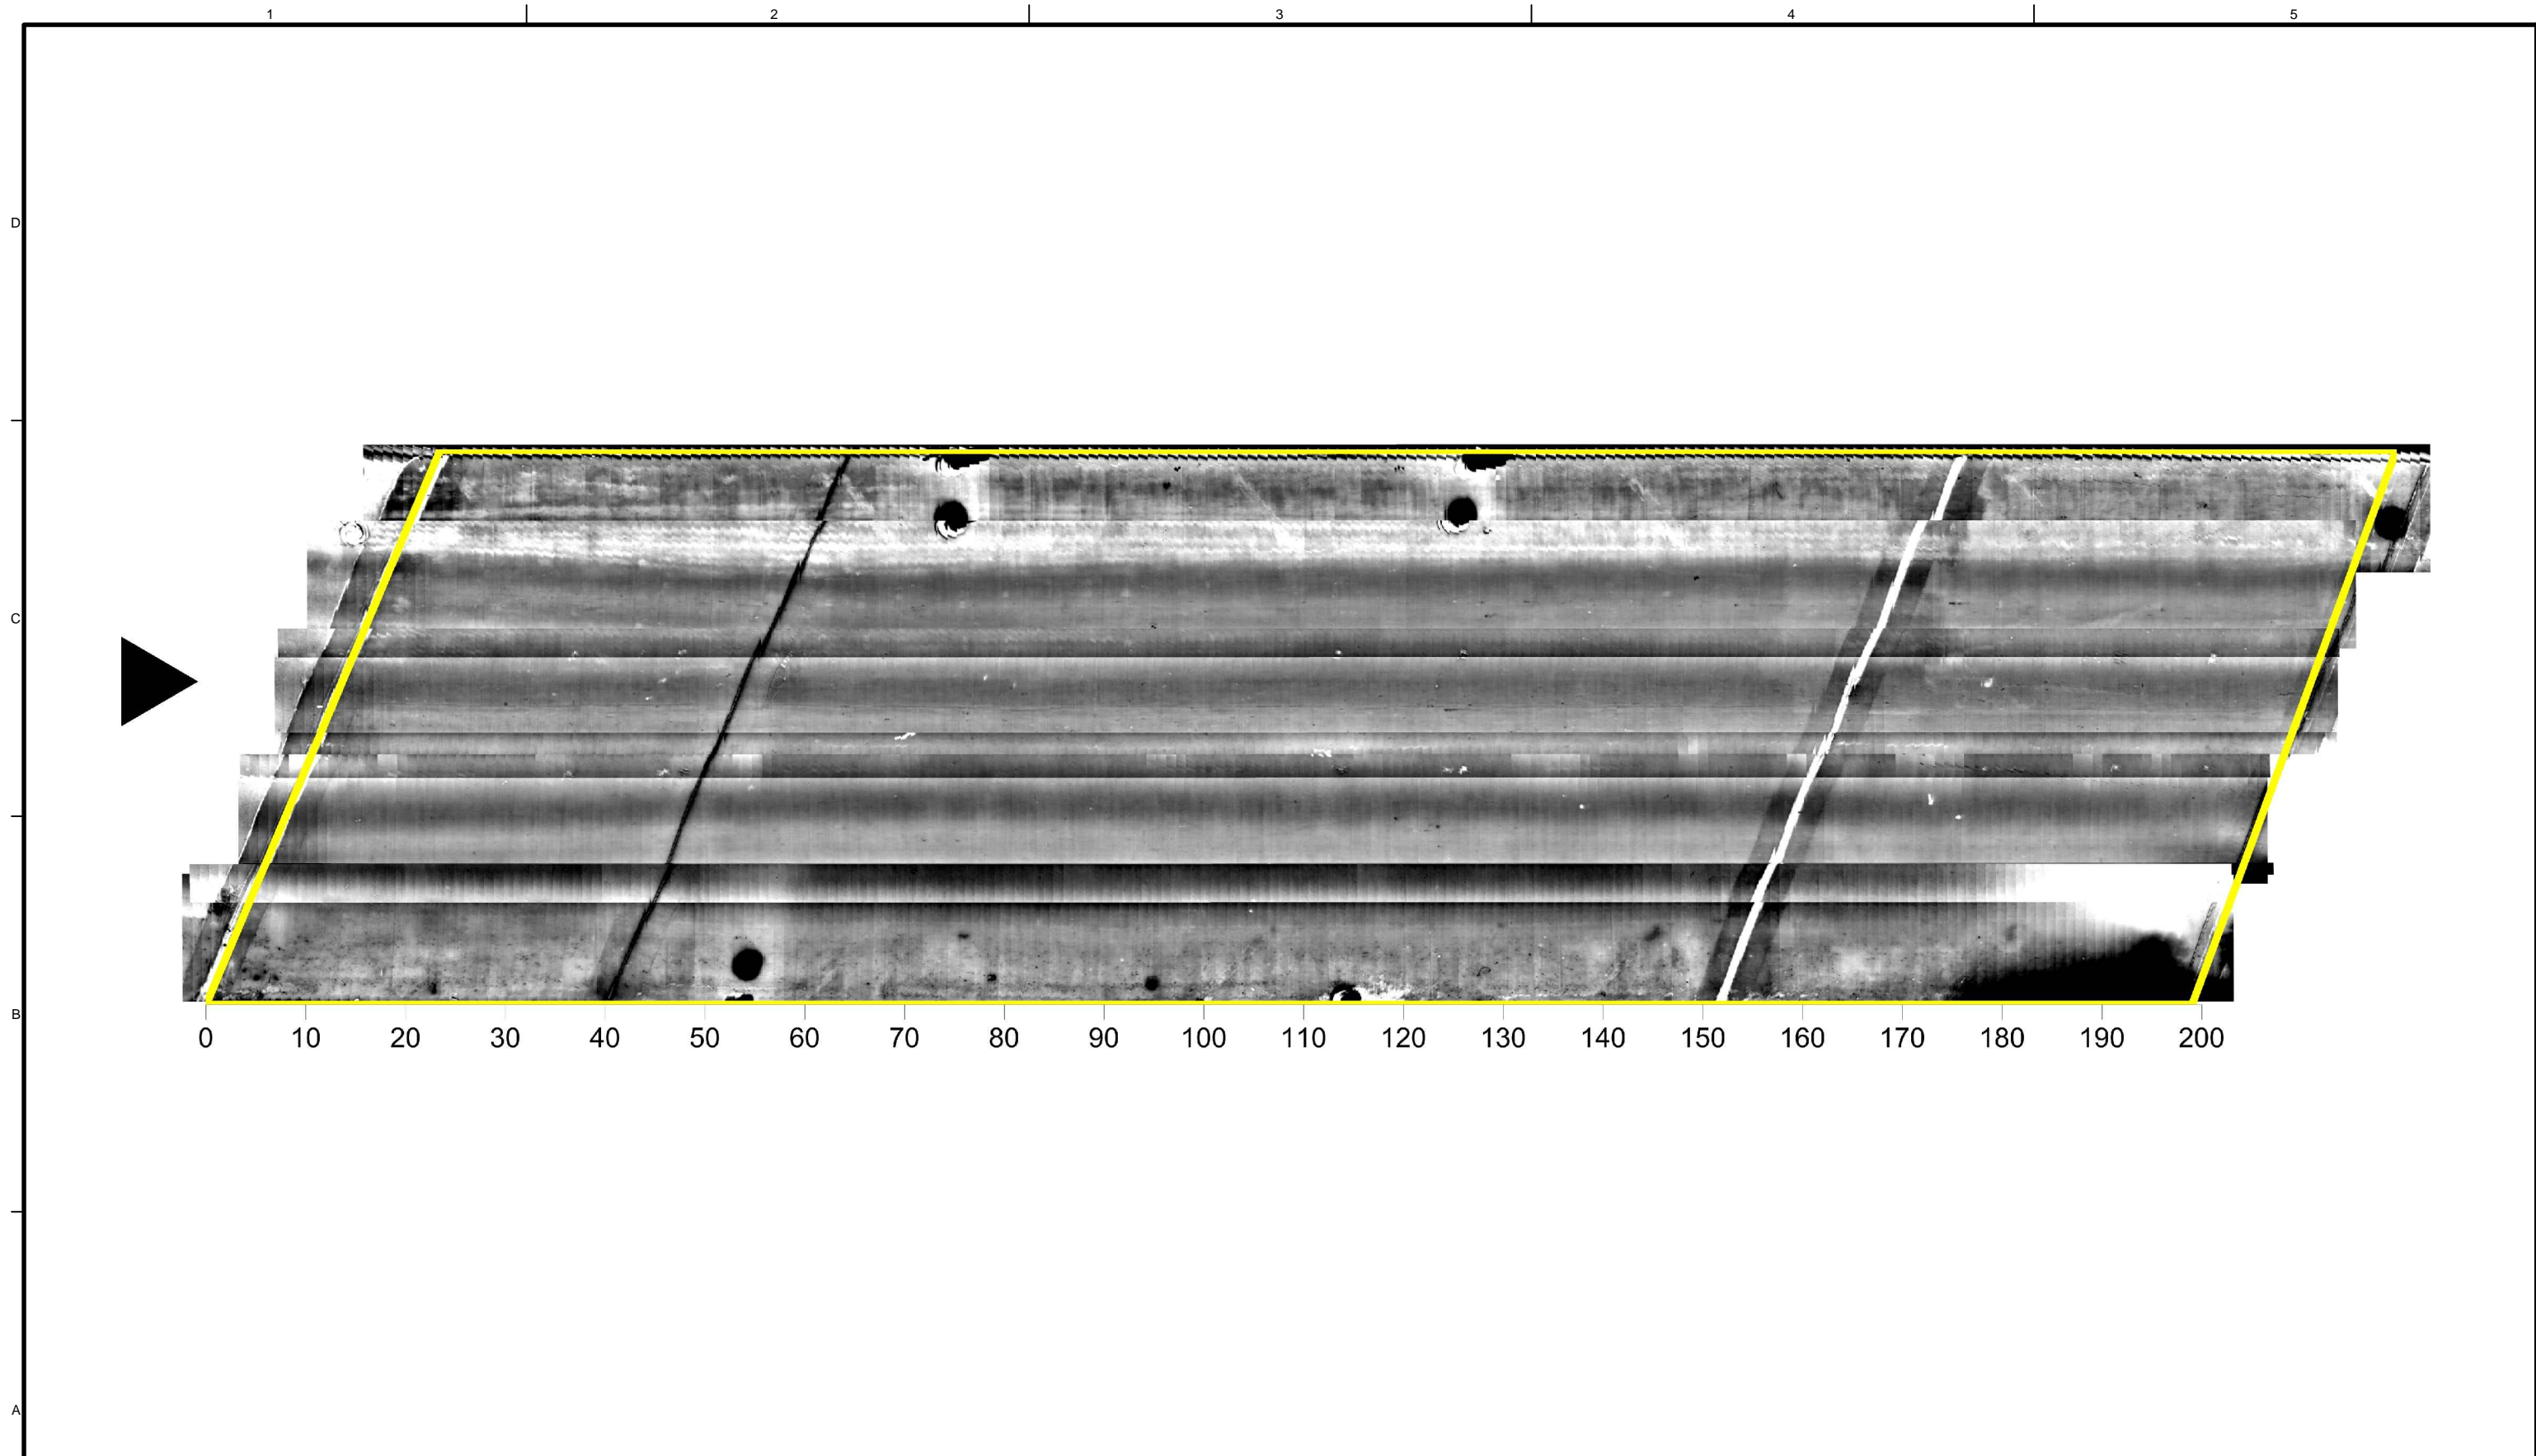


WJE ENGINEERS
ARCHITECTS
MATERIALS SCIENTISTS
Wiss, Janney, Elstner Associates, Inc.
330 Pfingsten Road
Northbrook, Illinois 60062
847.272.7400 tel | 847.291.4813 fax
www.wje.com

Client
Illinois Department of Transportation
District One
201 West Center Court
Schaumburg, Illinois 60196


Project
Bridge 016-0016
EASTBOUND I-55 OVER CICERO AVENUE
Sheet Title
IR Image - Top Surface

Proj. No.	2009.3645.10
Date	November 19 2011
Drawn	JJZ
Checked	JAR
Scale	1/16" = 1'-0"

Sheet No. **S2**

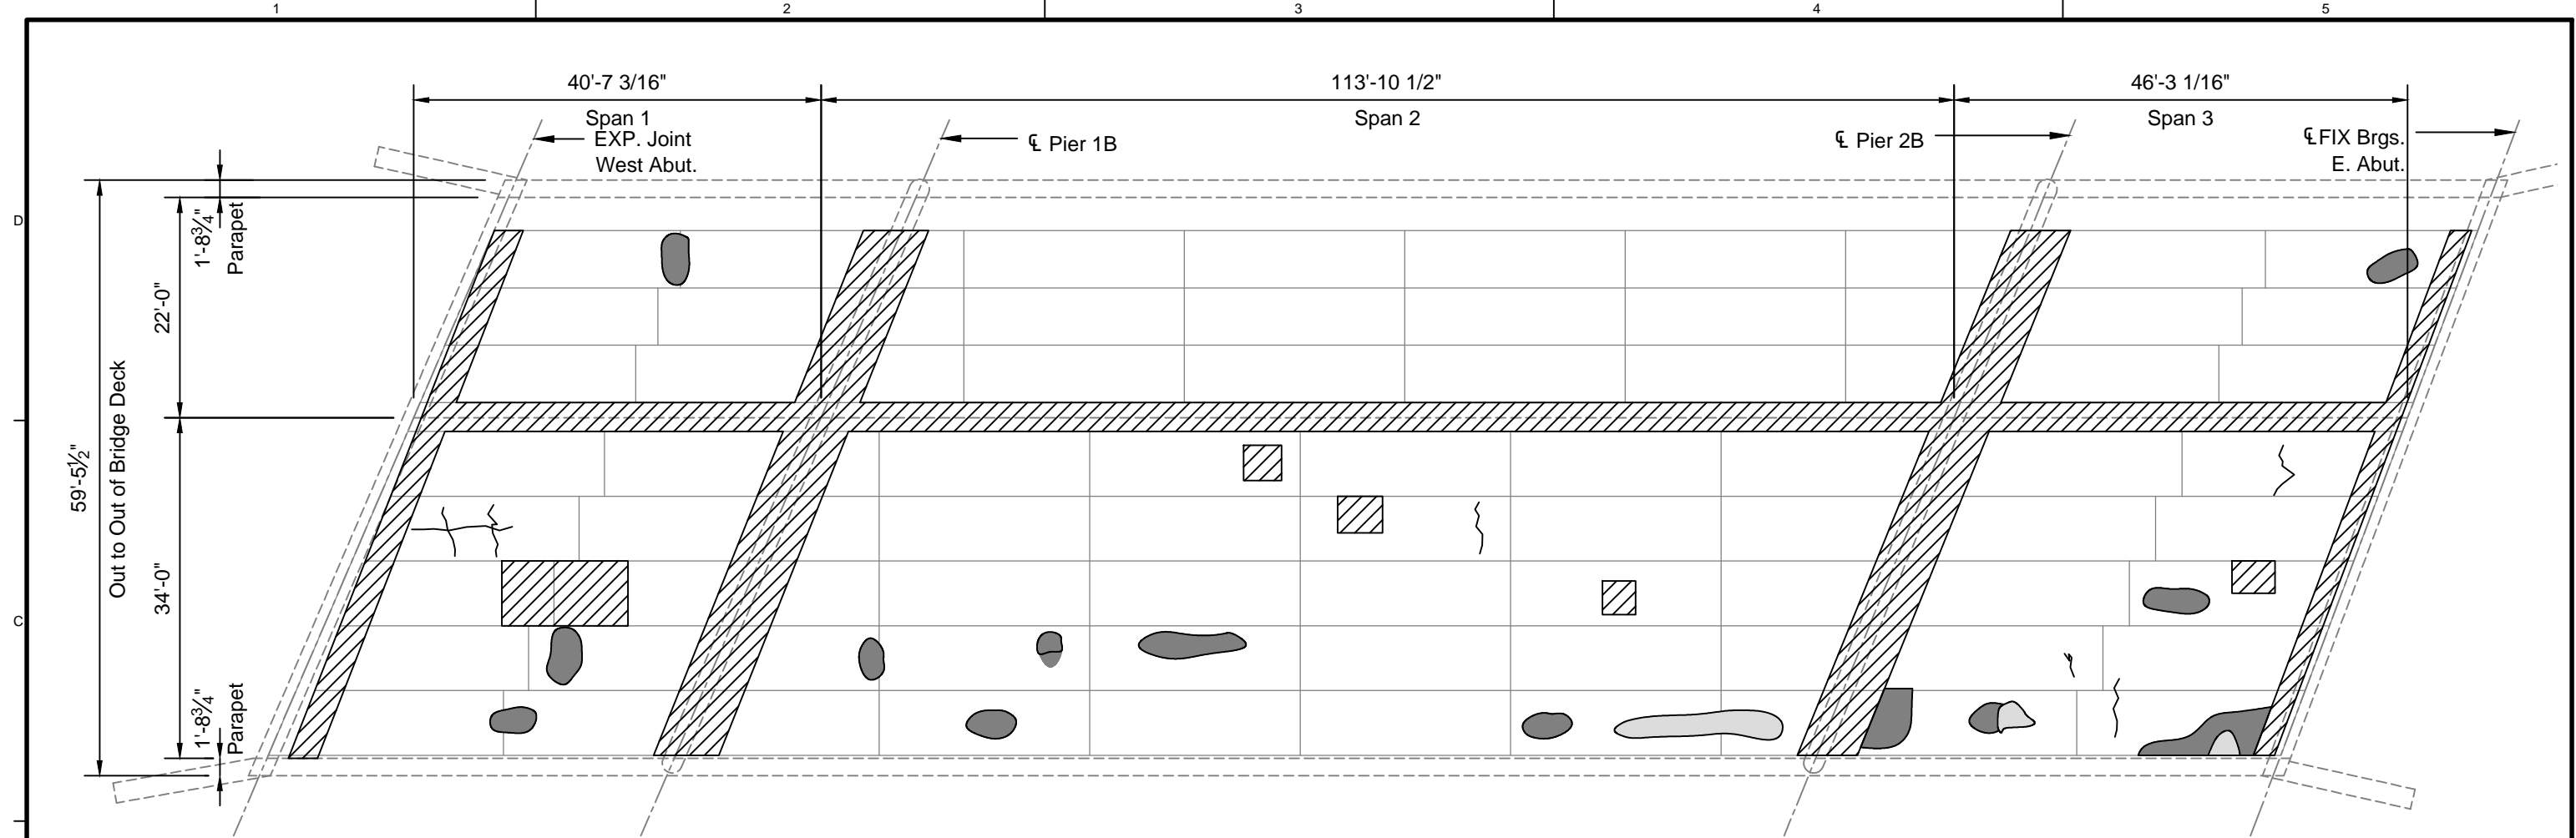

FIELD OBSERVATION SUMMARY		STRUCTURE # 016-0016		LEGEND	
ITEM	UNIT	QUANT.	%		
TOTAL AREA	Ac	10900	100	DELAMINATION	
DELAMINATION	Ac	180	1.7	SPALL	
SPALL	Ac	50	0.5	PREV. REPAIR	
PREVIOUS REPAIRS	Ac	1575	14.4	CRACK	
CRACKS	ft	-	-		

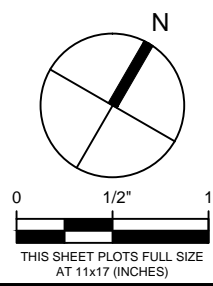


WJE ENGINEERS
ARCHITECTS
MATERIALS SCIENTISTS
Wiss, Janney, Elstner Associates, Inc.
330 Pfingsten Road
Northbrook, Illinois 60062
847.272.7400 tel | 847.291.4813 fax
www.wje.com

Client
Illinois Department of Transportation
District One
201 West Center Court
Schaumburg, Illinois 60196


Project
Bridge 016-0016
EASTBOUND I-55 OVER CICERO AVENUE
Sheet Title
Underside Deterioration

Proj. No. 2009.3645.10
Date November 19 2011
Drawn JJZ
Checked JAR
Scale 1/16" = 1'-0"

S3

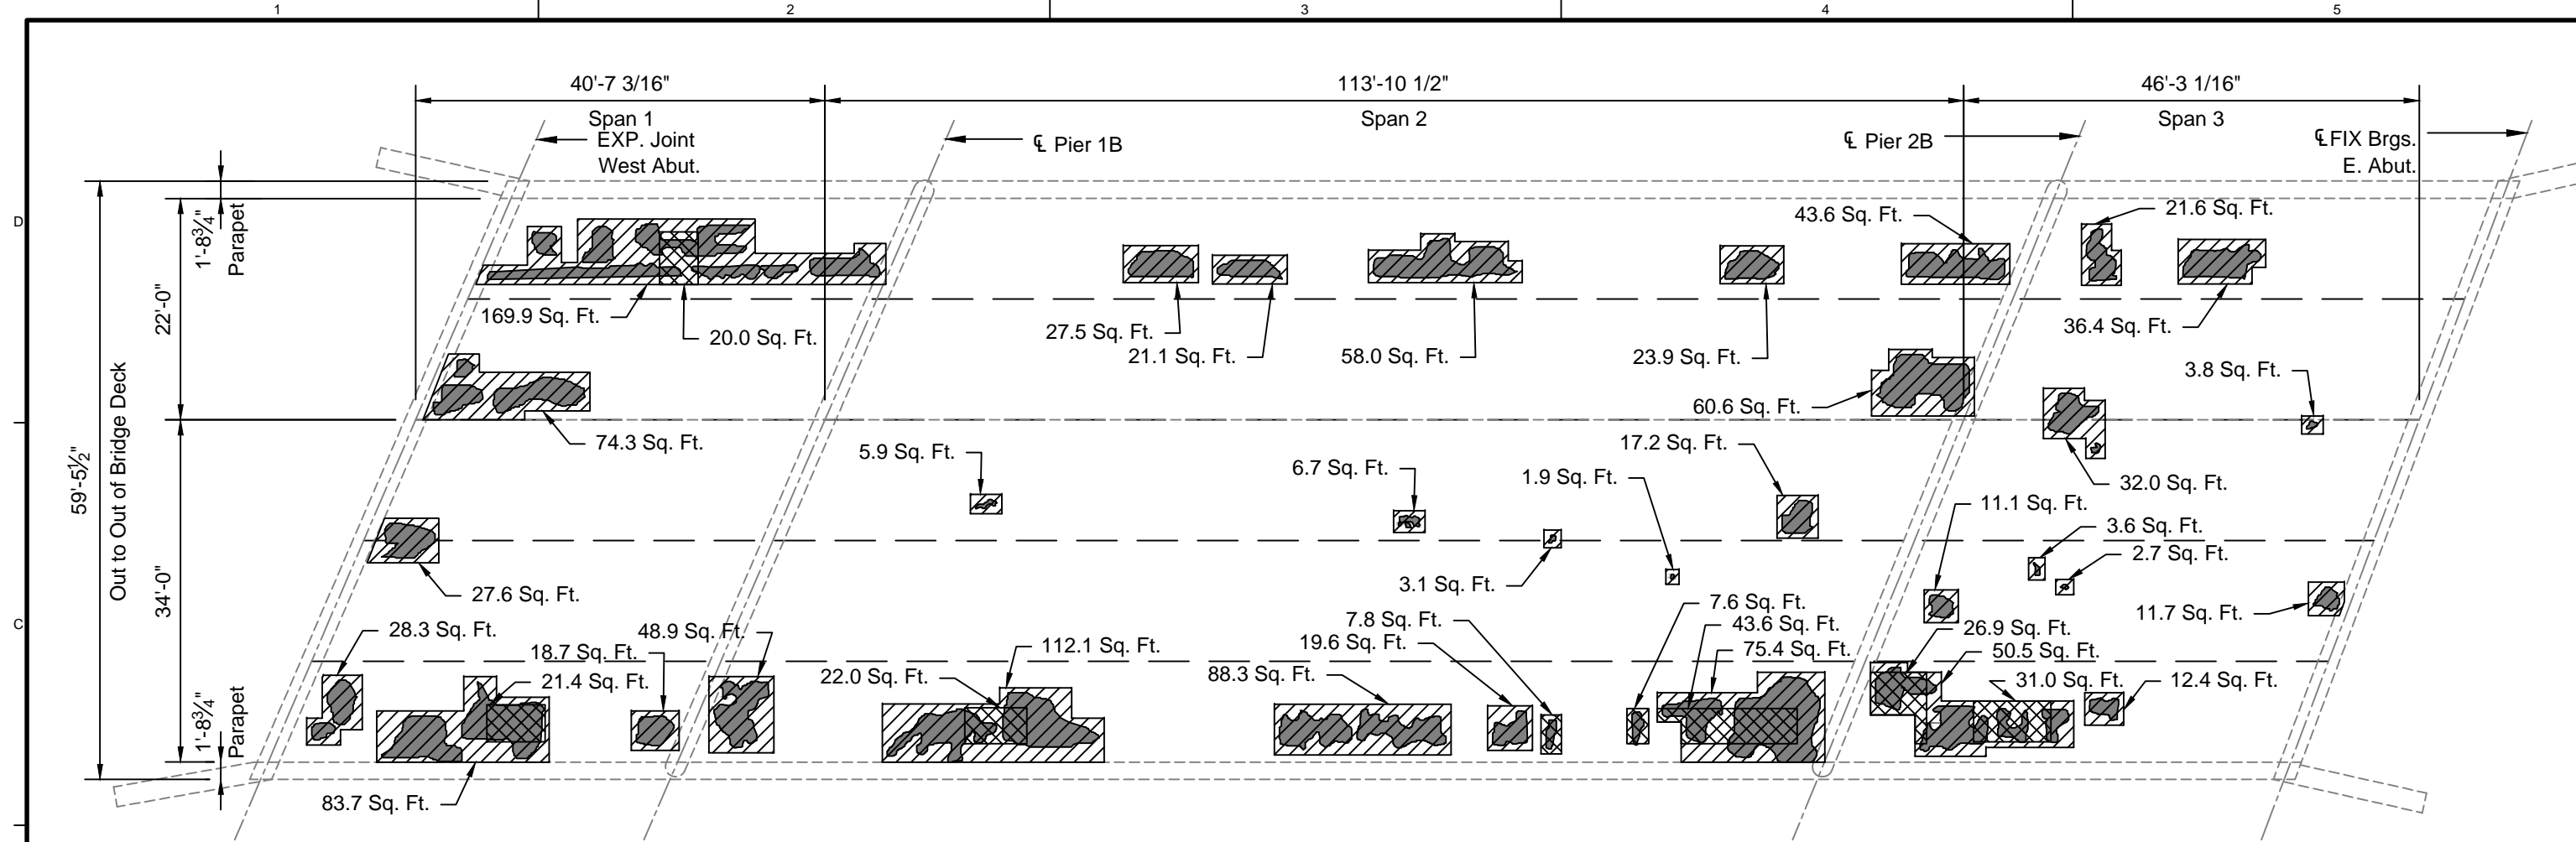

FIELD OBSERVATION SUMMARY		STRUCTURE # 016-0016		LEGEND	
ITEM	UNIT	QUANT.	%		
TOTAL AREA	Ac	10900	100	PARTIAL DEPTH REPAIR	
PARTIAL DEPTH REPAIR	Ac	1202	11.0	FULL DEPTH REPAIR	
FULL DEPTH REPAIR	Ac	180	1.7	DELAMINATION	
DELAMINATION	Ac	615	5.6	SPALL	
SPALL	Ac	0	0	CRACK	
CRACKS	ft	-	-		

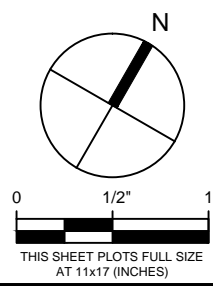

WJE ENGINEERS ARCHITECTS MATERIALS SCIENTISTS
 Wiss, Janney, Elstner Associates, Inc.
 330 Pfingsten Road
 Northbrook, Illinois 60062
 847.272.7400 tel | 847.291.4813 fax
 www.wje.com

Client
 Illinois Department of Transportation
 District One
 201 West Center Court
 Schaumburg, Illinois 60196


Project
 Bridge 016-0016
 EASTBOUND I-55 OVER CICERO AVENUE
 Sheet Title
 Proposed Repairs

Proj. No. 2009.3645.10
 Date November 19 2011
 Drawn JJZ
 Checked JAR
 Scale 1/16" = 1'-0"


Sheet No. **S4**

ATTACHMENT F

Substructure Condition Surveys

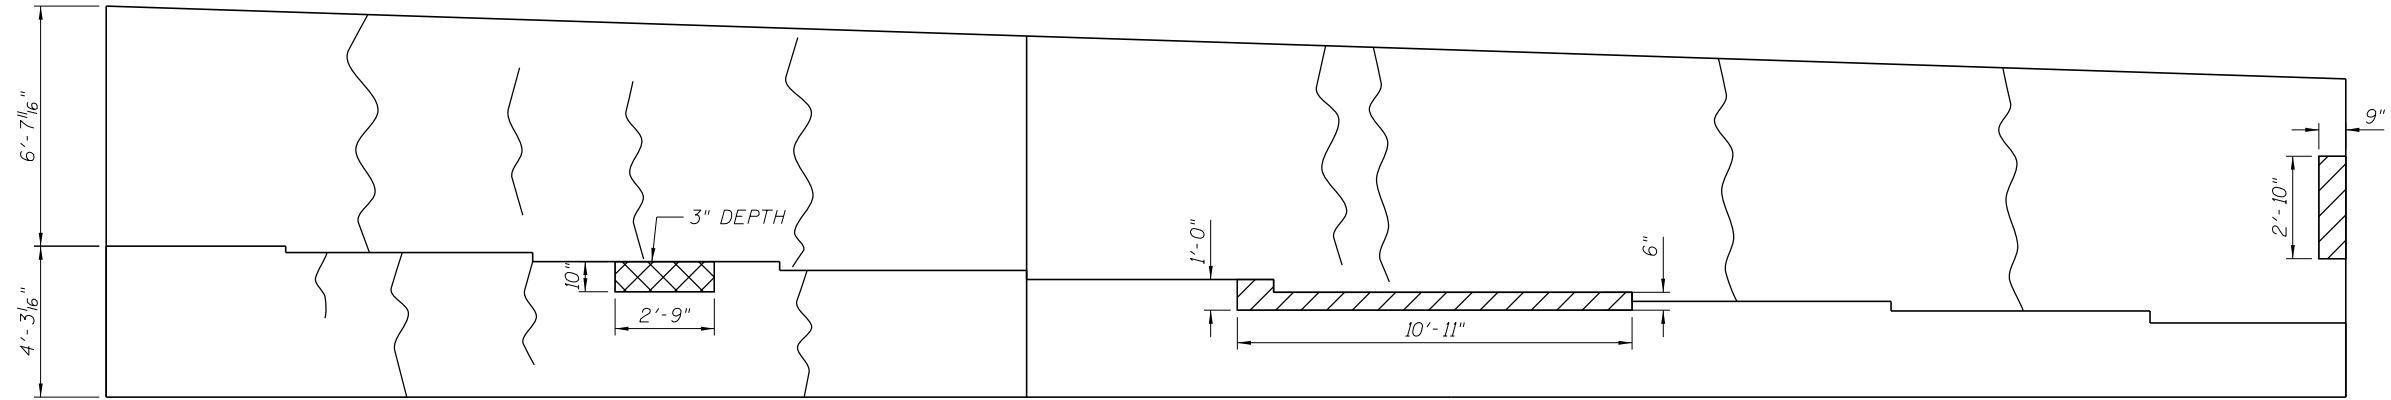

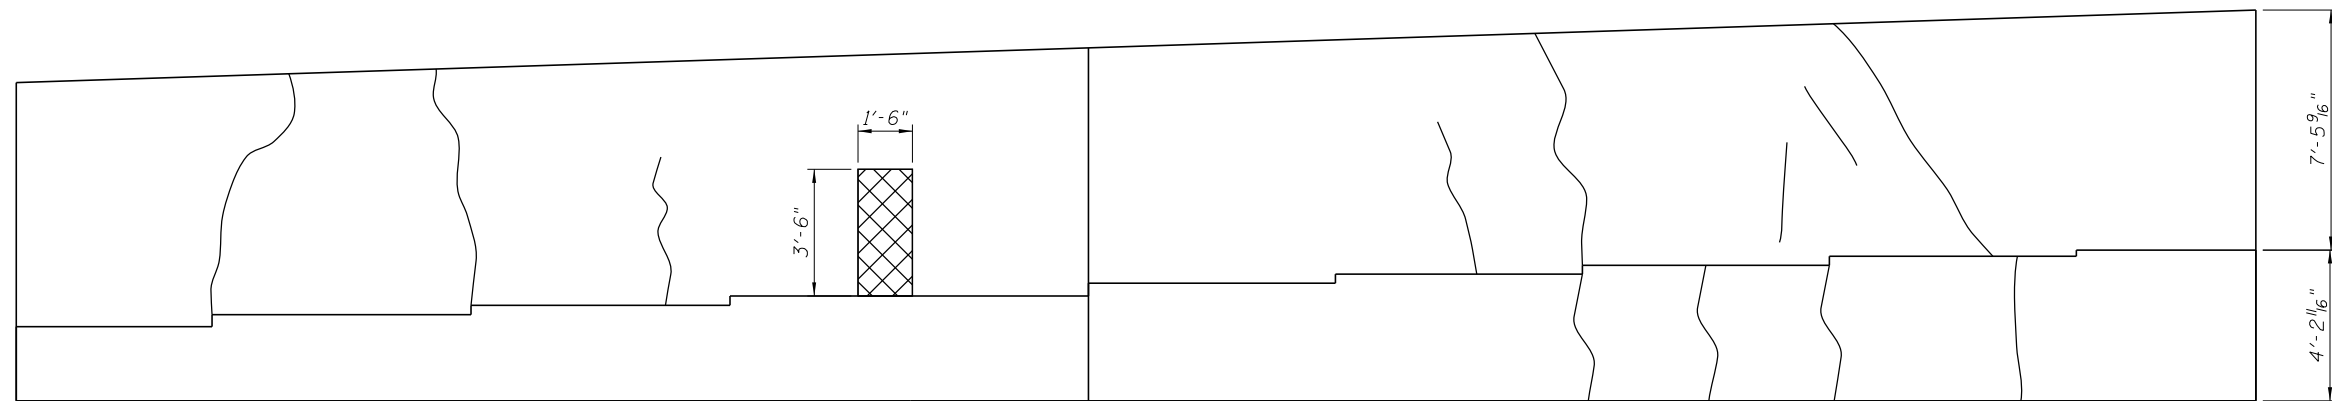


EAST ABUTMENT
LOOKING EAST



WEST ABUTMENT
LOOKING WEST

LEGEND

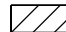-  - HAIRLINE CRACK (UNLESS OTHERWISE NOTED)
-  - SPALLED CONCRETE
-  - DELAMINATED CONCRETE

FILE NAME = V:\1786\active\178600037_IDOT_155\structural\drawing\shd\deg_Cicero.Avenue.Abutment.Elevation.dgn




USER NAME = jerojas	DESIGNED - JSR	REVISED -
	CHECKED - BPS	REVISED -
PLOT SCALE = N/A	DRAWN - JSR	REVISED -
PLOT DATE = 10/7/2013	CHECKED - BPS	REVISED -

STATE OF ILLINOIS
DEPARTMENT OF TRANSPORTATION


ATTACHMENT F - SUBSTRUCTURE CONDITION SURVEY
STRUCTURE NO. 016-0016

SHEET NO. 1 OF 3 SHEETS

F.A.I. RTE.	SECTION	COUNTY	TOTAL SHEETS	SHEET NO.
55	1112-619-HB	COOK		
CONTRACT NO.				
FED. ROAD DIST. NO. 1 ILLINOIS FED. AID PROJECT				

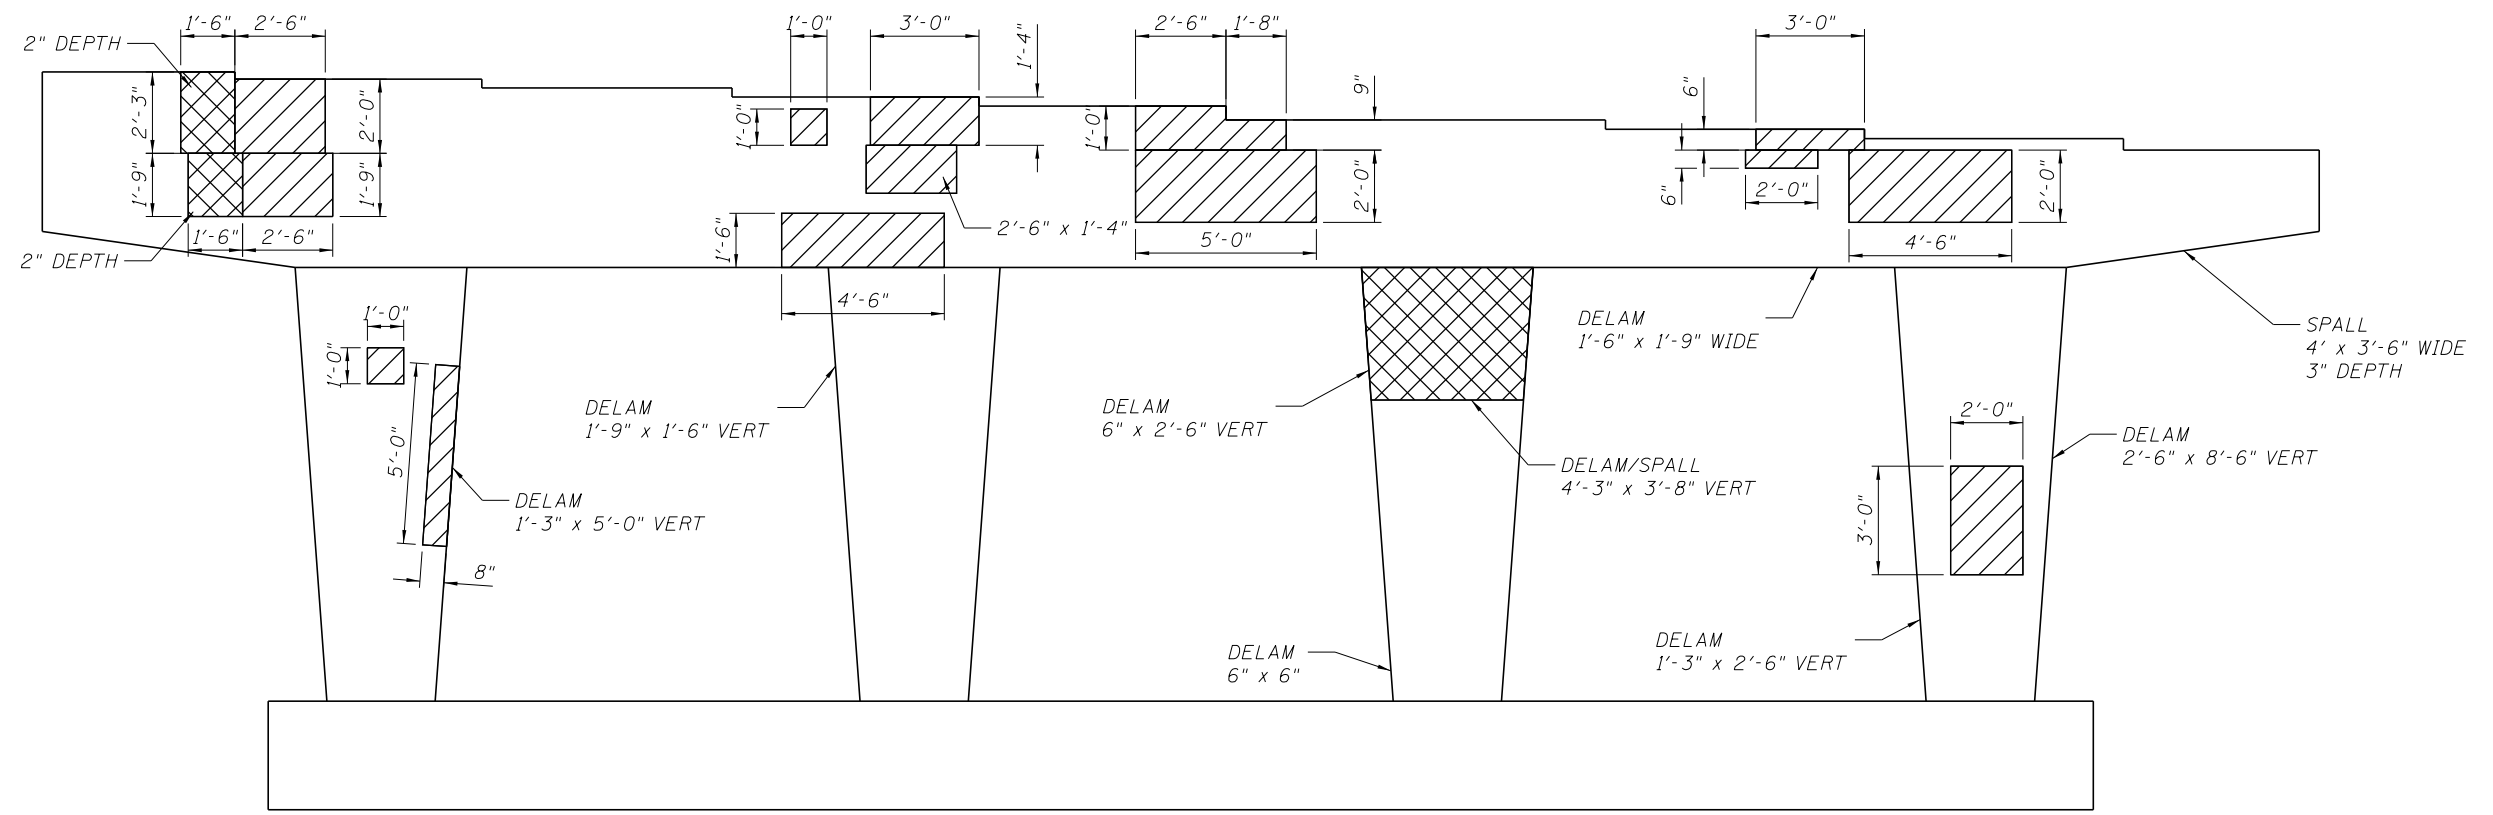

PIER 1
LOOKING EAST

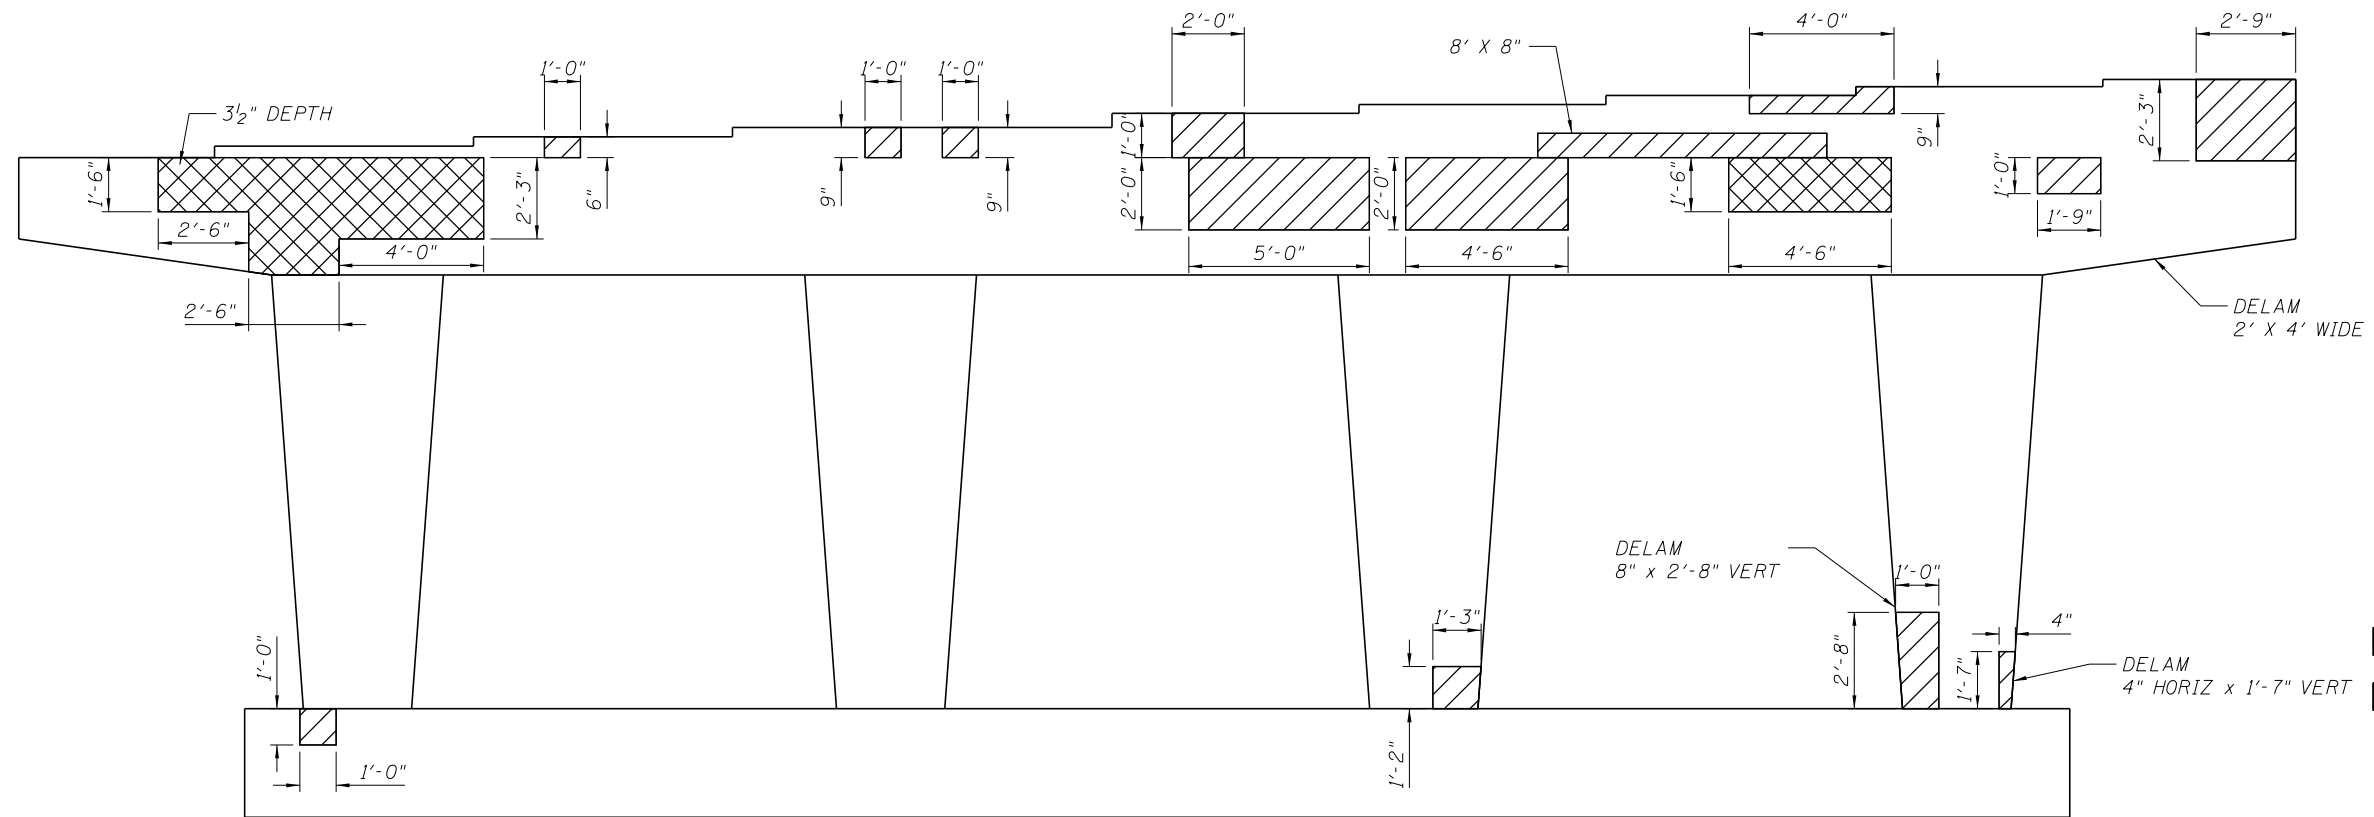

PIER 1
LOOKING WEST

LEGEND

- SPALLED CONCRETE
- DELAMINATED CONCRETE

FILE NAME = W:\1786 active\178600037_IDOT_155 structural\drawing\shd\dwg_Cicero.Avenue.Pier.Elevation.dgn




USER NAME = jerojas	DESIGNED - JSR	REVISED -
	CHECKED - BPS	REVISED -
PLOT SCALE = N/A	DRAWN - JSR	REVISED -
PLOT DATE = 10/7/2013	CHECKED - BPS	REVISED -

STATE OF ILLINOIS
DEPARTMENT OF TRANSPORTATION


ATTACHMENT F - SUBSTRUCTURE CONDITION SURVEY
STRUCTURE NO. 016-0016

SHEET NO. 2 OF 3 SHEETS

F.A.I. RTE. 55	SECTION 1112-619-HB	COUNTY COOK	TOTAL SHEETS	SHEET NO.
CONTRACT NO.				
FED. ROAD DIST. NO. 1 ILLINOIS FED. AID PROJECT				

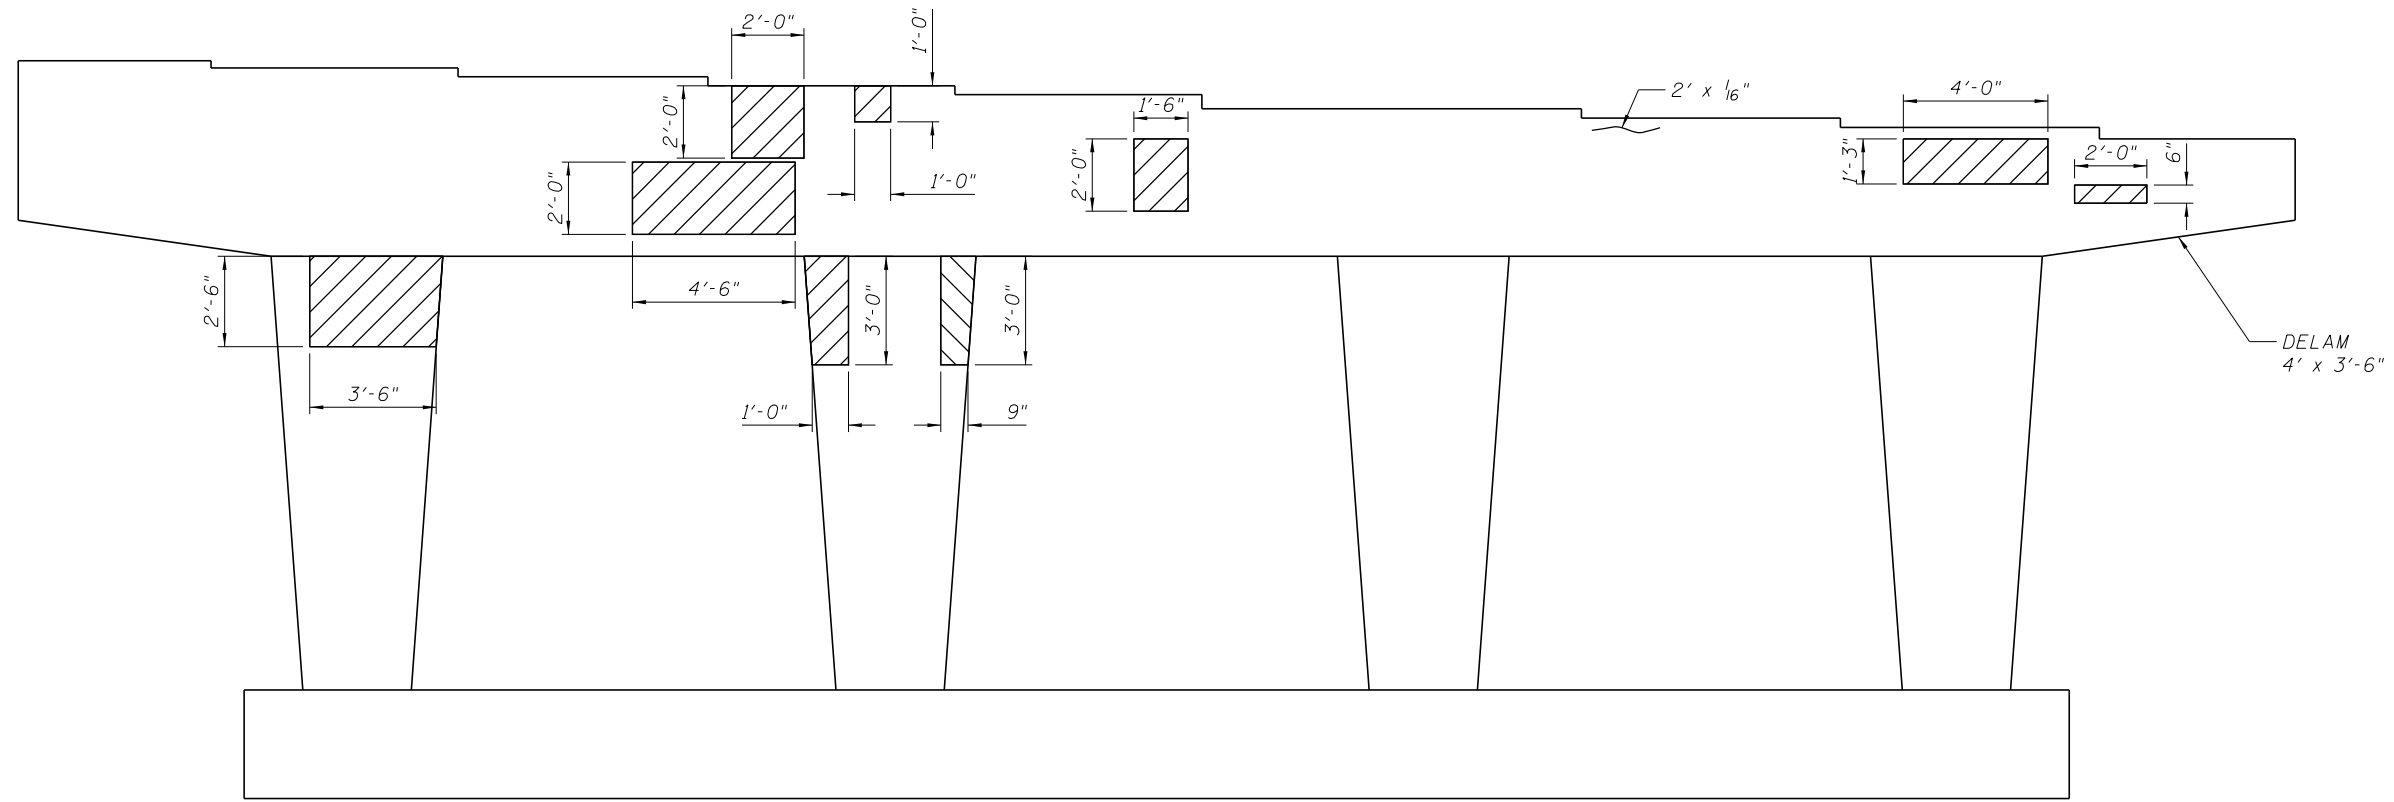
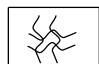
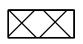
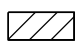


PIER 2
LOOKING EAST

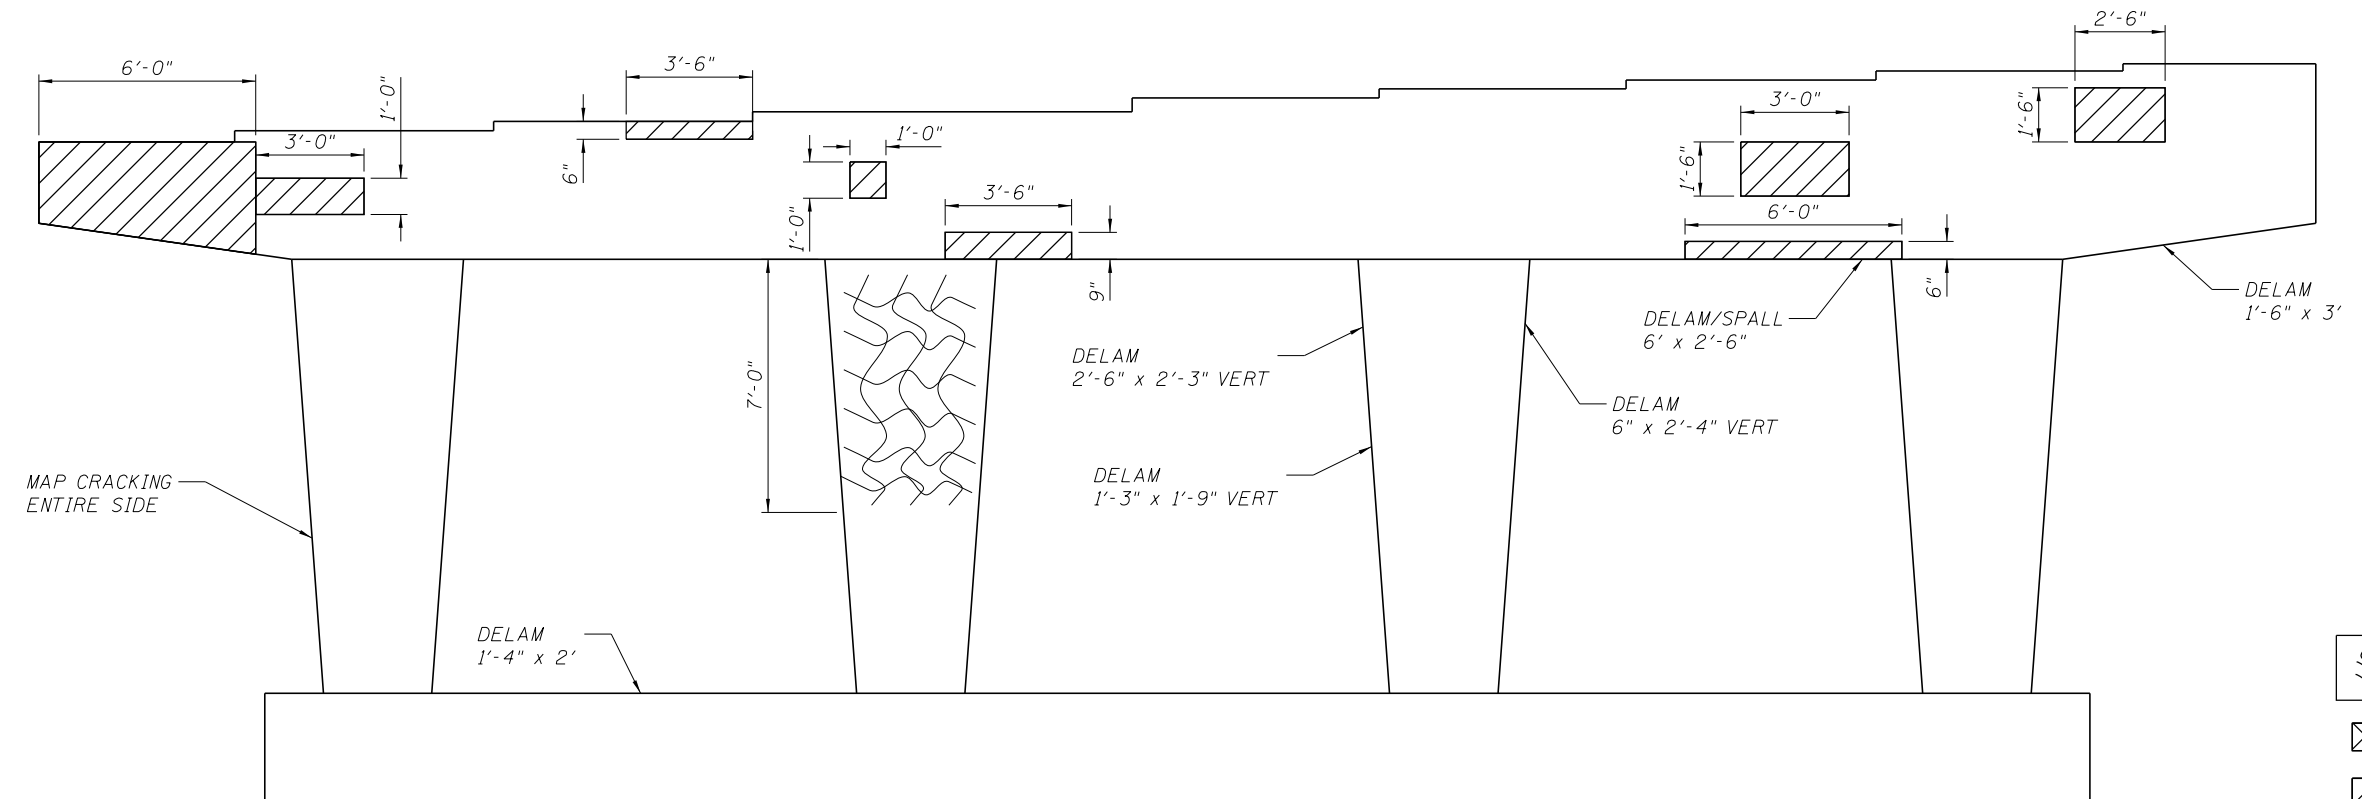

PIER 2
LOOKING WEST

LEGEND

-  - CRACKED CONCRETE
-  - MAP CRACKING
-  - SPALLED CONCRETE
-  - DELAMINATED CONCRETE

FILE NAME = V:\1786\active\178600037_IDOT_1-95\structural\drawing\shd\deg_Cicero_Avenue_Pier_Elevation.dgn



USER NAME = jerojas	DESIGNED - JSR	REVISED -
	CHECKED - BPS	REVISED -
PLOT SCALE = N/A	DRAWN - JSR	REVISED -
PLOT DATE = 10/7/2013	CHECKED - BPS	REVISED -

STATE OF ILLINOIS
DEPARTMENT OF TRANSPORTATION

ATTACHMENT F - SUBSTRUCTURE CONDITION SURVEY
STRUCTURE NO. 016-0016

SHEET NO. 3 OF 3 SHEETS

F.A.I. RTE. 55	SECTION 1112-619-HB	COUNTY COOK	TOTAL SHEETS	SHEET NO.
CONTRACT NO.				
FED. ROAD DIST. NO. 1 ILLINOIS FED. AID PROJECT				

ATTACHMENT G

Opinion of Probable Costs

Sheet: _____ of _____
 Calc By: JSR Date: 10/9/13
 Check By: BHS Date: 12/19/13
 Project Number: 178600037
 Subject: OPINION OF PROBABLE COSTS
I-55 EB over Cicero (016-0016)

ALTERNATIVE 1 - IN-KIND REPAIRS

QUANTITY CODE	QUANTITY DESCRIPTION	QUANTITY	UNIT COST	TOTAL COST
50300300	Protective Coat	1529 sy	\$2.00	\$3,060
50500105	Furnishing and Erecting Structural Steel	2230 lb	\$5.00	\$11,150
Z0012754	Struct Repair of Concrete (Depth = < 5 Inches)	372 sf	\$175	\$65,100
Z0016001	Deck Slab Repair (Full Depth)	18 sy	\$750	\$13,500
Z0016200	Deck Slab Repair (Partial Depth)	141 sy	\$400	\$56,400
SUB TOTAL =				\$149,210
MOBILIZATION (10%) =				\$14,921
CONTINGENCY (20%) =				\$29,842
TOTAL =				\$194,000

ALTERNATIVE 2 - STRUCTURE WIDENING

QUANTITY CODE	QUANTITY DESCRIPTION	QUANTITY	UNIT COST	TOTAL COST
50102400	Concrete Removal	25 cy	\$600	\$15,000
50104720	Removal Existing Concrete Deck	1 LS	\$154,500	\$154,500
50200100	Structure Excavation	281 cy	\$35.00	\$9,840
50300225	Concrete Structures	202 cy	\$700	\$141,400
50300255	Concrete Superstructure	726 cy	\$800	\$580,800
50300260	Bridge Deck Grooving	2189 sy	\$7.00	\$15,320
50300300	Protective Coat	1915 sy	\$2.00	\$3,830
50500105	Furnishing and Erecting Structural Steel	1 LS	\$339,330	\$339,330
50500505	Stud Shear Connectors	1242 each	\$3.00	\$3,730
50800205	Reinforcement Bars, Epoxy Coated	221900 lbs	\$1.75	\$388,330
51201400	Fur Stl Pile HP10x42	2,800 ft	\$45.00	\$126,000
51203400	Test Pile Stl HP10x42	4 each	\$2,000	\$8,000
52000110	Preformed Joint Strip Seal	349 ft	\$175	\$61,080
52100010	Elastomeric Bearing Assembly, Type I	3 each	\$800	\$2,400
59100100	Geocomposite Wall Drain	46 sy	\$25.00	\$1,150
X2070304	Porous Granular Embankment, Special	62 cy	\$50.00	\$3,100
Z0004552	Approach Slab Removal	160 sy	\$35.00	\$5,600
Z0012754	Struct Repair of Concrete (Depth = < 5 Inches)	372 sf	\$175	\$65,100
Z0026407	Temporary Sheet Piling	1108 sf	\$30.00	\$33,230
Z0046304	Pipe Underdrains for Structures 4"	40 ft	\$20.00	\$800
SUB TOTAL =				\$1,958,540
MOBILIZATION (10%) =				\$195,854
CONTINGENCY (20%) =				\$391,708
TOTAL =				\$2,546,200

Sheet: _____ of _____
 Calc By: JSR Date: 10/9/13
 Check By: BHS Date: 12/19/13
 Project Number: 178600037
 Subject: OPINION OF PROBABLE COSTS
I-55 EB over Cicero (016-0016)

ALTERNATIVE 3 - SUPERSTRUCTURE AND PARTIAL SUBSTRUCTURE REPLACEMENT


CODE	QUANTITY DESCRIPTION	QUANTITY	UNIT COST	TOTAL COST
50101500	Removal of Existing Superstructures	1 LS	\$185,400	\$185,400
50102400	Concrete Removal	332 cy	\$600	\$199,200
50104650	Slope Wall Removal	719 sy	\$7.00	\$5,030
50200100	Structure Excavation	724 cy	\$35.00	\$25,340
50300225	Concrete Structures	348 cy	\$700	\$243,600
50300255	Concrete Superstructure	962 cy	\$800	\$769,600
50300260	Bridge Deck Grooving	2604 sy	\$7.00	\$18,230
50300300	Protective Coat	2435 sy	\$2.00	\$4,870
50500105	Furnishing and Erecting Structural Steel	1 LS	\$1,834,200	\$1,834,200
50500505	Stud Shear Connectors	9144 each	\$3.00	\$27,430
50800205	Reinforcement Bars, Epoxy Coated	310100 lbs	\$1.75	\$542,680
51100100	Slope Wall 4 Inch	602 sy	\$100	\$60,200
51201400	Fur Stl Pile HP10x42	3240 ft	\$45.00	\$145,800
51203400	Test Pile Stl HP10x42	4 each	\$2,000	\$8,000
52100010	Elastomeric Bearing Assembly, Type I	12 each	\$800	\$9,600
59100100	Geocomposite Wall Drain	172 sy	\$25.00	\$4,300
X2070304	Porous Granular Embankment, Special	352 cy	\$50.00	\$17,600
Z0004552	Approach Slab Removal	160 sy	\$35.00	\$5,600
Z0012754	Structural Repair of Concrete (< 5 Inches)	1 sf	\$350	\$350
Z0026407	Temporary Sheet Piling	1527 sf	\$30.00	\$45,800
Z0046304	Pipe Underdrains for Structures 4"	187 ft	\$20.00	\$3,740
SUB TOTAL =				\$4,156,570
MOBILIZATION (10%) =				\$415,657
CONTINGENCY (20%) =				\$831,314
TOTAL =				\$5,403,600

ALTERNATIVE 4 - STRUCTURE REPLACEMENT


QUANTITY CODE	QUANTITY DESCRIPTION	QUANTITY	UNIT COST	TOTAL COST
50100100	Removal of Existing Structures	1 LS	\$468,000	\$468,000
50104650	Slope Wall Removal	719 sy	\$7.00	\$5,030
50200100	Structure Excavation	1023 cy	\$35.00	\$35,810
50300225	Concrete Structures	585 cy	\$700	\$409,500
50300255	Concrete Superstructure	962 cy	\$800	\$769,600
50300260	Bridge Deck Grooving	2604 sy	\$7.00	\$18,230
50300300	Protective Coat	2435 sy	\$2.00	\$4,870
50500105	Furnishing and Erecting Structural Steel	1 LS	\$1,834,200	\$1,834,200
50500505	Stud Shear Connectors	9144 each	\$3.00	\$27,430
50800205	Reinforcement Bars, Epoxy Coated	357500 lbs	\$1.75	\$625,630
51100100	Slope Wall 4 Inch	602 sy	\$100	\$60,200
51201400	Fur Stl Pile HP10x42	6,120 ft	\$45.00	\$275,400
51203400	Test Pile Stl HP10x42	4 each	\$2,000	\$8,000
59100100	Geocomposite Wall Drain	172 sy	\$25.00	\$4,300
X2070304	Porous Granular Embankment, Special	352 cy	\$50.00	\$17,600
Z0004552	Approach Slab Removal	160 sy	\$35.00	\$5,600
Z0026407	Temporary Sheet Piling	1527 sf	\$30.00	\$45,800
Z0046304	Pipe Underdrains for Structures 4"	187 ft	\$20.00	\$3,740
SUB TOTAL =				\$4,618,940
MOBILIZATION (10%) =				\$461,894
CONTINGENCY (20%) =				\$923,788
TOTAL =				\$6,004,700

ATTACHMENT H

Proposed Structure Drawings

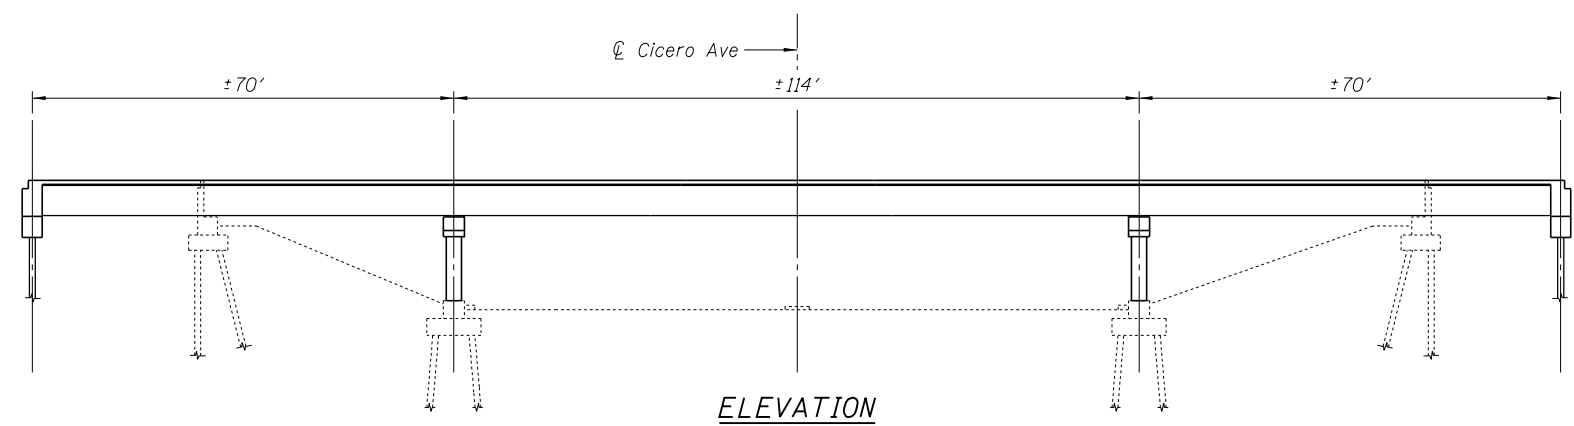

ELEVATION

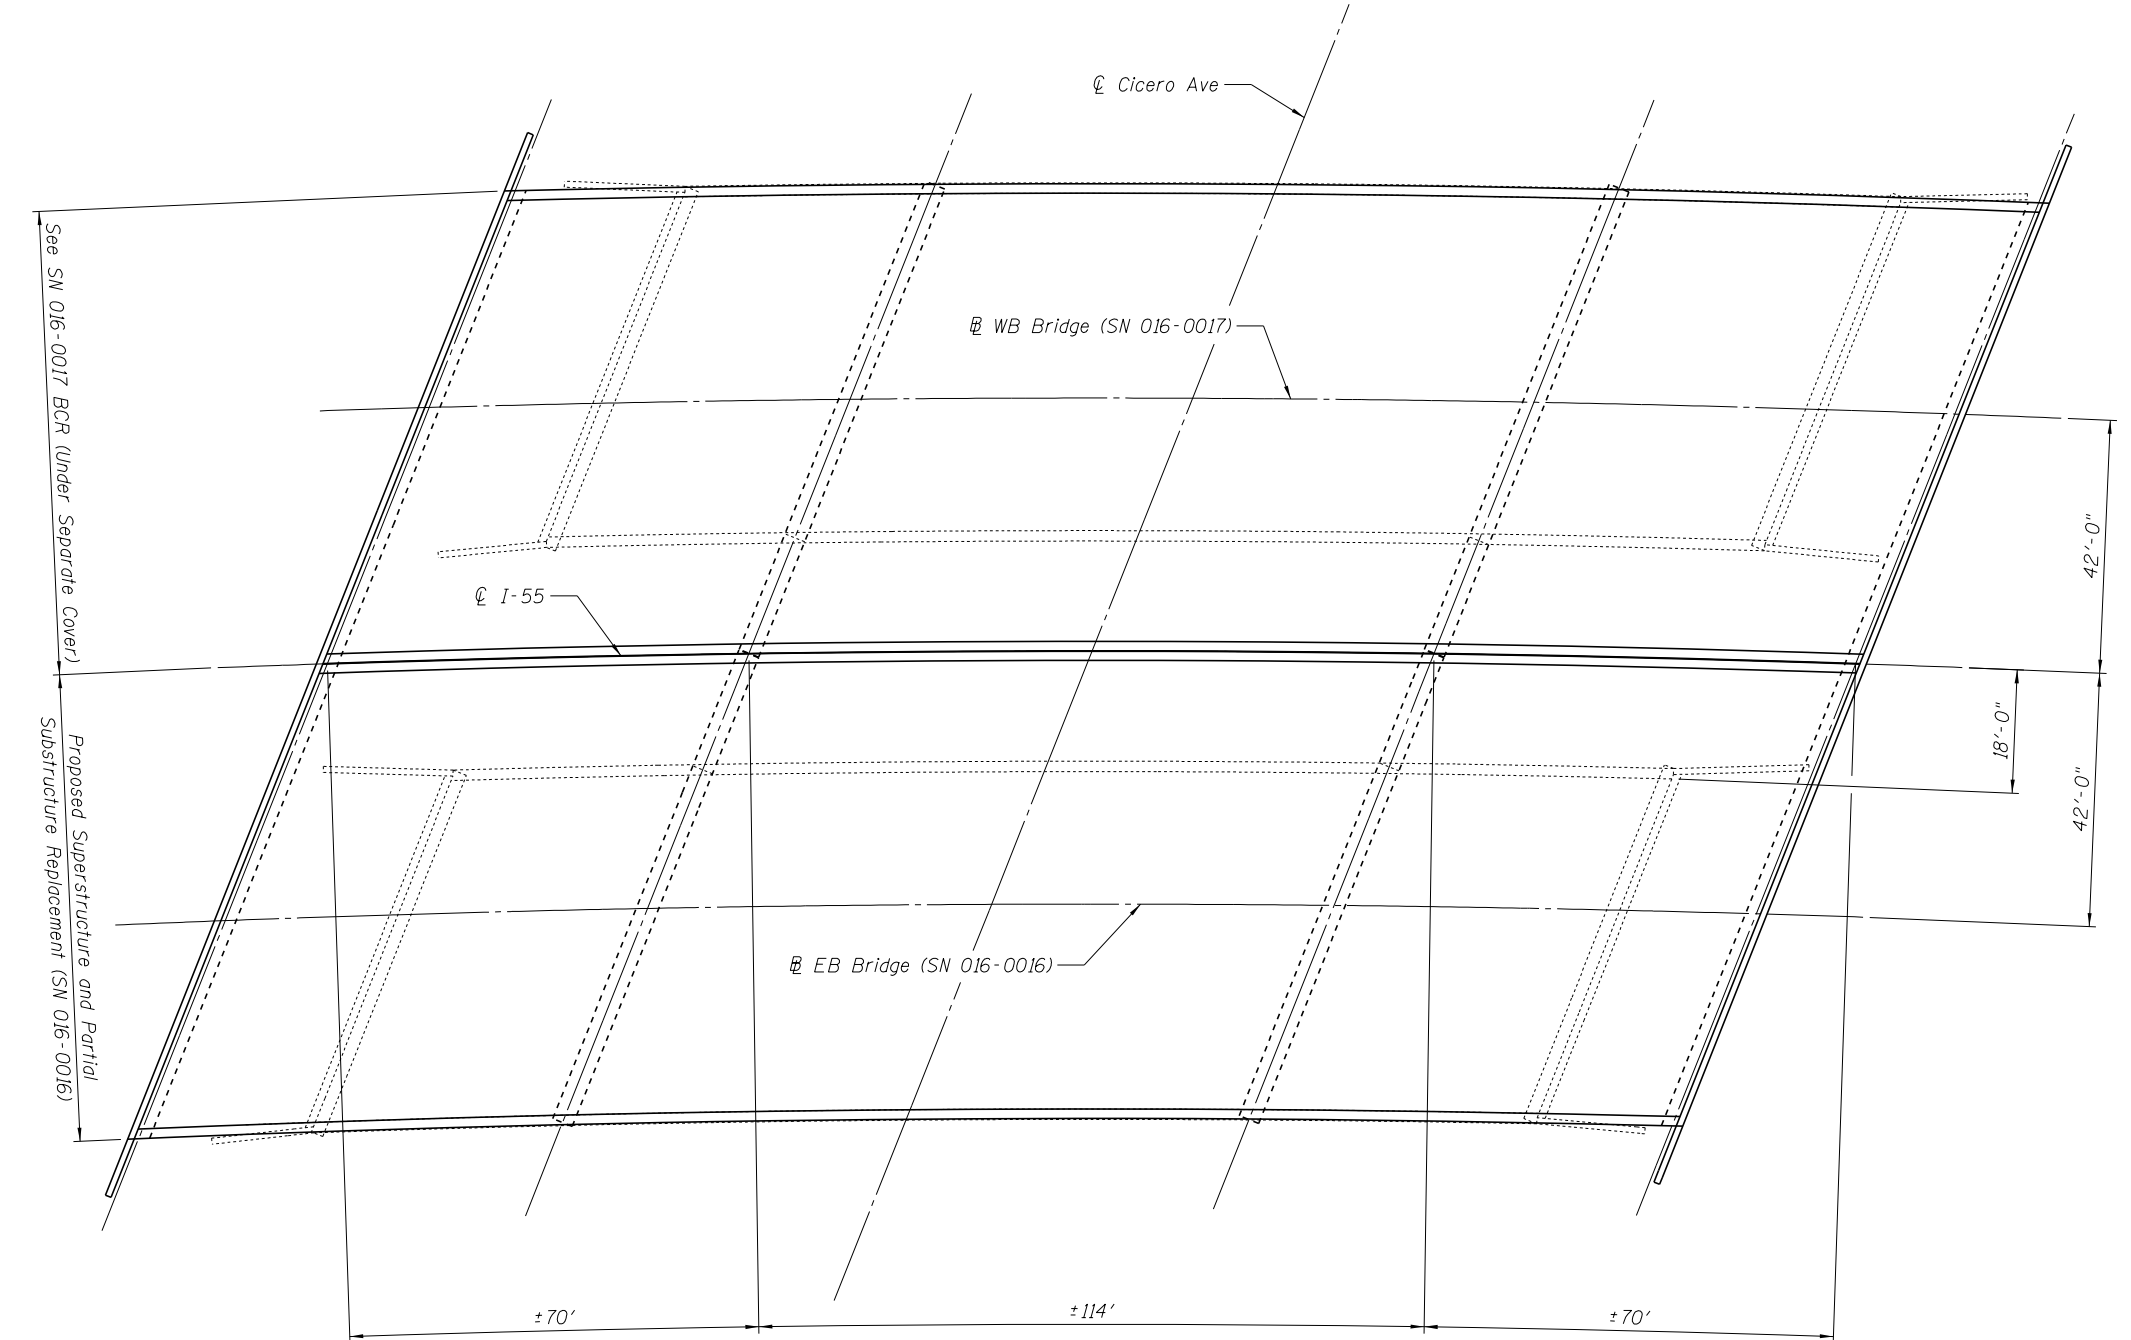

PROPOSED PLAN

Notes:
 The number and location of substructure units, the profile grade, skew angle, and the bridge length and width are subject to refinement in the TSL phase.
 Superstructure type, beam spacing, and rail type to be determined during the TSL phase.

FILE NAME = V:\1786\active\178600037_IDOT_I-55\structural\drawing\shd\dwg_Cicero.Avenue.Deck_Plan.dgn



USER NAME = bsogers	DESIGNED - JSR	REVISED -
	CHECKED - BPS	REVISED -
PLOT SCALE = N/A	DRAWN - JSR	REVISED -
PLOT DATE = 12/19/2013	CHECKED - BPS	REVISED -

**STATE OF ILLINOIS
 DEPARTMENT OF TRANSPORTATION**

**ATTACHMENT H – PROPOSED STRUCTURE DRAWING
 STRUCTURE NO. 016-0016**

SHEET NO. 1 OF 1 SHEETS

F.A.I. RTE. 55	SECTION 1112-619-HB	COUNTY COOK	TOTAL SHEETS	SHEET NO.
FED. ROAD DIST. NO. 1			ILLINOIS FED. AID PROJECT	

ATTACHMENT I

Structure Photos



Photo 1 - Spalls on underside of deck in Span 3 between Beams 9-10 from north, east end, looking east



Photo 2 - Spalls on underside of deck in Span 2 between Beams 9-10 from north, east end, looking west



Photo 3 - Underside of Span 2, south end, looking east



Photo 4 - Underside of deck, Span 1, south end, looking west



Photo 5 – Span 1, looking northeast



Photo 6 – Span 2, looking northeast



Photo 7 - Cracking in shoulder, Span 3, looking east



Photo 8 Span 3, looking northwest



Photo 9 - Outside of South Parapet with minor rust stains, cracking, and minor spalling, looking northeast



Photo 10 - Outside of North Parapet with minor rust stains and cracking, looking southeast



Photo 11 - West Abutment joint, looking north



Photo 12 - Pier 1 joint, looking north



Photo 13 - Pier 2 joint, looking north



Photo 14 - East Abutment joint, looking north



Photo 15 - Typical superstructure in Span 2, looking southwest



Photo 16 - Typical cracked weld between bottom flange of beam in east span and built up steel bolster, looking northeast (Beam 2 from north at East Abutment)



Photo 17 - Typical cover plates on bottom on beams in east span, looking southwest (Beam 3 from north, Span 3)



Photo 18 - South Fascia Beam, looking west



Photo 19 - North Fascia Beam, looking east



Photo 20 - Broken conduit along South Fascia Beam, Span 3, 8' from East Abutment, looking west



Photo 21 - Broken conduit in Span 2 along south fascia beam, 6' from West Pier, looking southeast



Photo 22 - Spall on East Abutment seat between beams 2-3, looking east



Photo 23 - East Abutment, looking east



Photo 24 - West Abutment, looking southwest



Photo 25 - Northwest wingwall, looking southwest



Photo 26 – Southeast wingwall, looking northeast



Photo 27 - East Pier, looking southwest



Photo 28 - Underside of East Pier cap between columns 1-2 from north, looking east

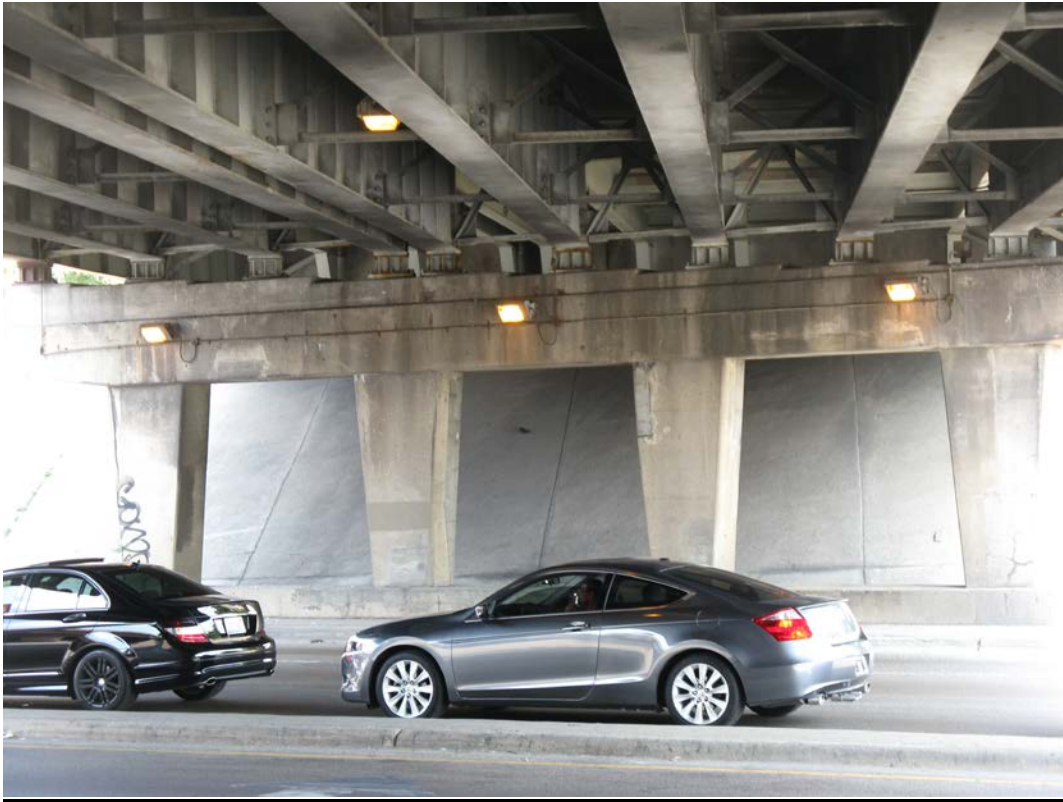


Photo 29 - West Pier, looking east



Photo 30 - Spall on underside of West Pier cap, south end, looking north



Photo 31 - Undermining of east sloped wall at south end, looking east



Photo 32 - Undermining of east sloped wall at south end, looking east



Photo 33 – East slopewall, north half, looking northeast


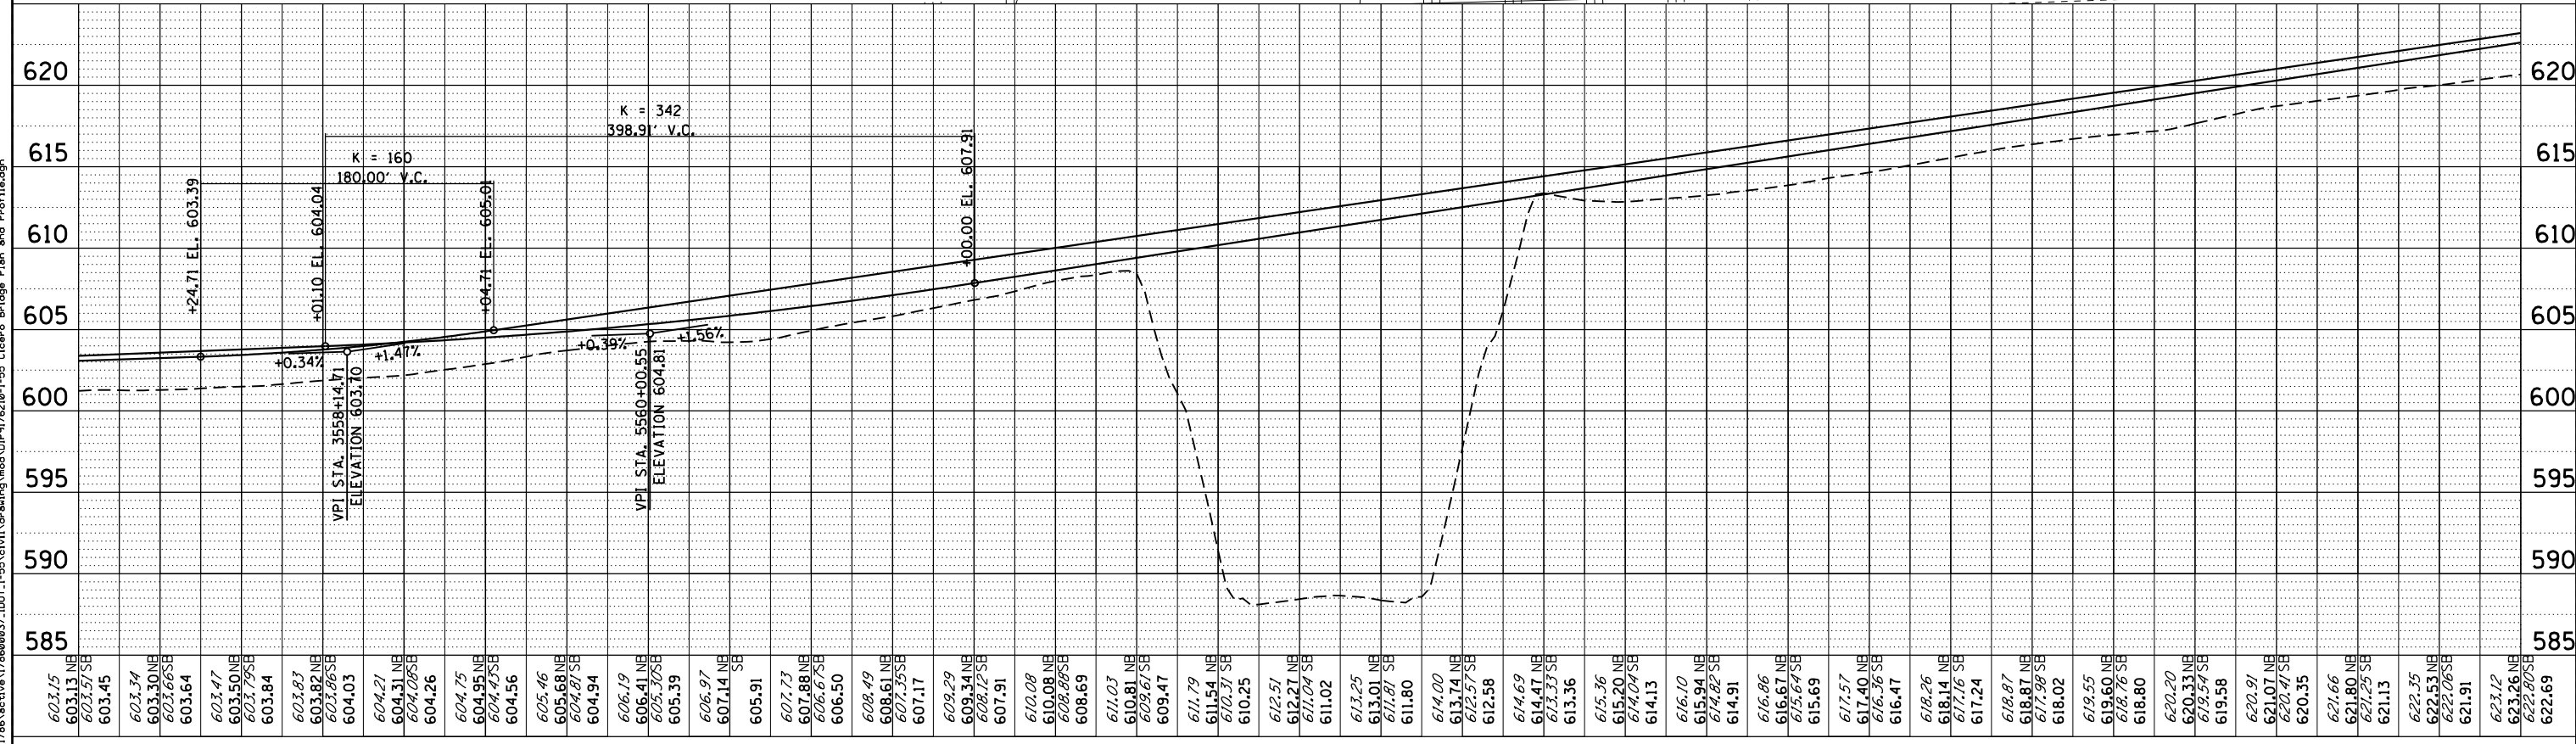


Photo 34 - Broken section of west slopewall curb with vegetation growing in it, approx half way up, looking west

ATTACHMENT J

Proposed Plan & Profile

FILE NAME = V:\1786\active\178600037_1DOT_I-55\civil\drawing\mod\178600037_1DOT_I-55\civil\drawing\mod\178600037_1DOT_I-55\Cicero Bridge Plan and Profile.dgn

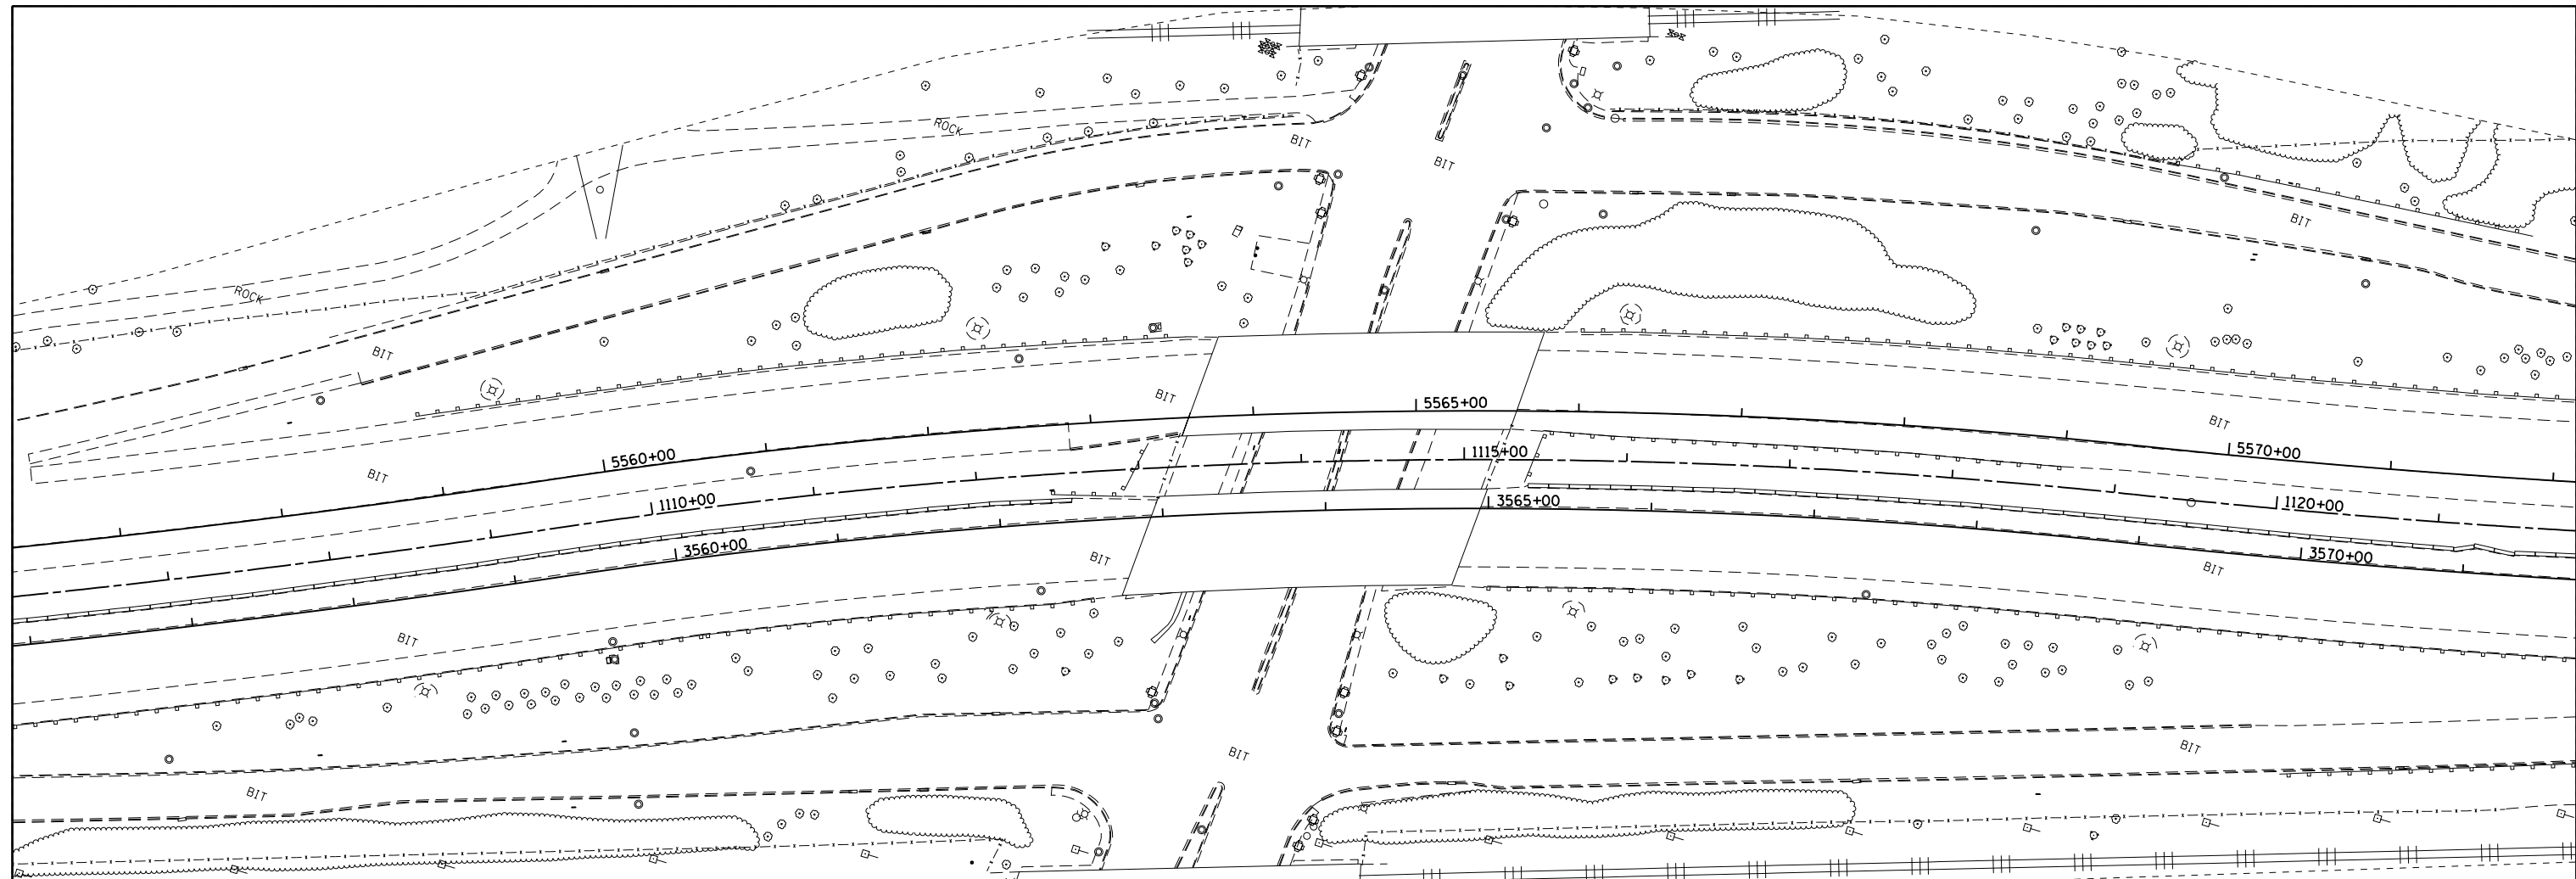

603.15	603.13 NE	603.57 SB	603.45	603.34	603.30 NE	603.65 SB	603.64	603.47	603.50 NE	603.79 SB	603.84	603.83	603.82 NE	603.95 SB	604.03	604.21	604.31 NE	604.09 SB	604.26	604.75	604.95 NE	604.49 SB	604.56	605.46	605.68 NE	604.87 SB	604.94	606.19	606.41 NE	605.35 SB	605.39	606.97	607.14 NE	607.14 SB	605.91	607.73	607.88 NE	606.87 SB	606.50	608.49	608.61 NE	607.35 SB	607.17	609.29	609.34 NE	608.12 SB	607.91	610.08	610.08 NE	608.89 SB	608.69	611.03	611.03 NE	609.67 SB	609.47	611.79	611.54 NE	610.37 SB	610.25	612.51	612.21 NE	611.04 SB	611.02	613.25	613.01 NE	611.81 SB	611.80	614.00	613.74 NE	612.57 SB	612.58	614.69	614.41 NE	613.33 SB	613.36	615.36	615.20 NE	614.04 SB	614.13	616.10	615.94 NE	614.82 SB	614.91	616.86	616.67 NE	615.64 SB	615.69	617.57	617.40 NE	616.36 SB	616.41	618.26	618.14 NE	617.16 SB	617.24	618.87	618.87 NE	617.98 SB	618.02	619.55	619.60 NE	618.76 SB	618.80	620.20	620.33 NE	619.54 SB	619.58	620.91	621.07 NE	620.47 SB	620.35	621.66	621.80 NE	621.29 SB	621.13	622.35	622.53 NE	622.06 SB	621.91	623.12	623.26 NE	622.80 SB	622.69
--------	-----------	-----------	--------	--------	-----------	-----------	--------	



USER NAME = m.j.verheyen	DESIGNED - MJV	REVISED -
PLOT SCALE = 100.0000' / 1in.	DRAWN - STANTEC	REVISED -
PLOT DATE = 10/4/2013	CHECKED -	REVISED -
	DATE - 10/04/2013	REVISED -


STATE OF ILLINOIS
DEPARTMENT OF TRANSPORTATION

ATTACHMENT J	
I-55 OVER CICERO AVE PROPOSED PLAN & PROFILE	
SCALE: 1"=100'	SHEET ___ OF ___ SHEETS STA. _____ TO STA. _____


F.A.I. RTE. 55	SECTION	COUNTY COOK	TOTAL SHEETS	SHEET NO.
CONTRACT NO.				
ILLINOIS FED. AID PROJECT				

ATTACHMENT K

**Existing and Proposed Roadway Cross
Sections**

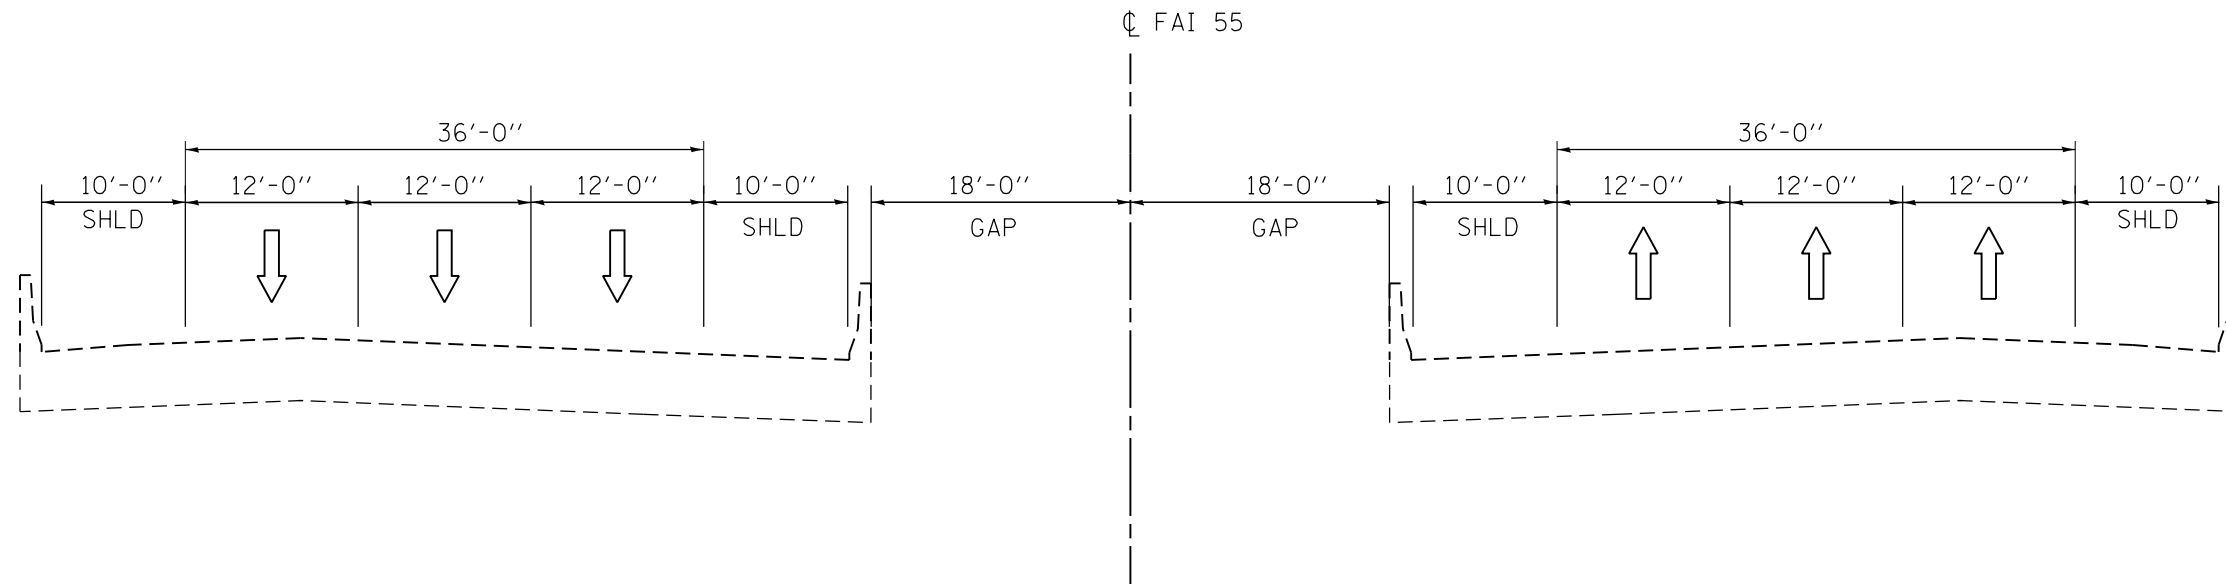

EXISTING I-55 OVER CICERO AVE TYPICAL SECTION

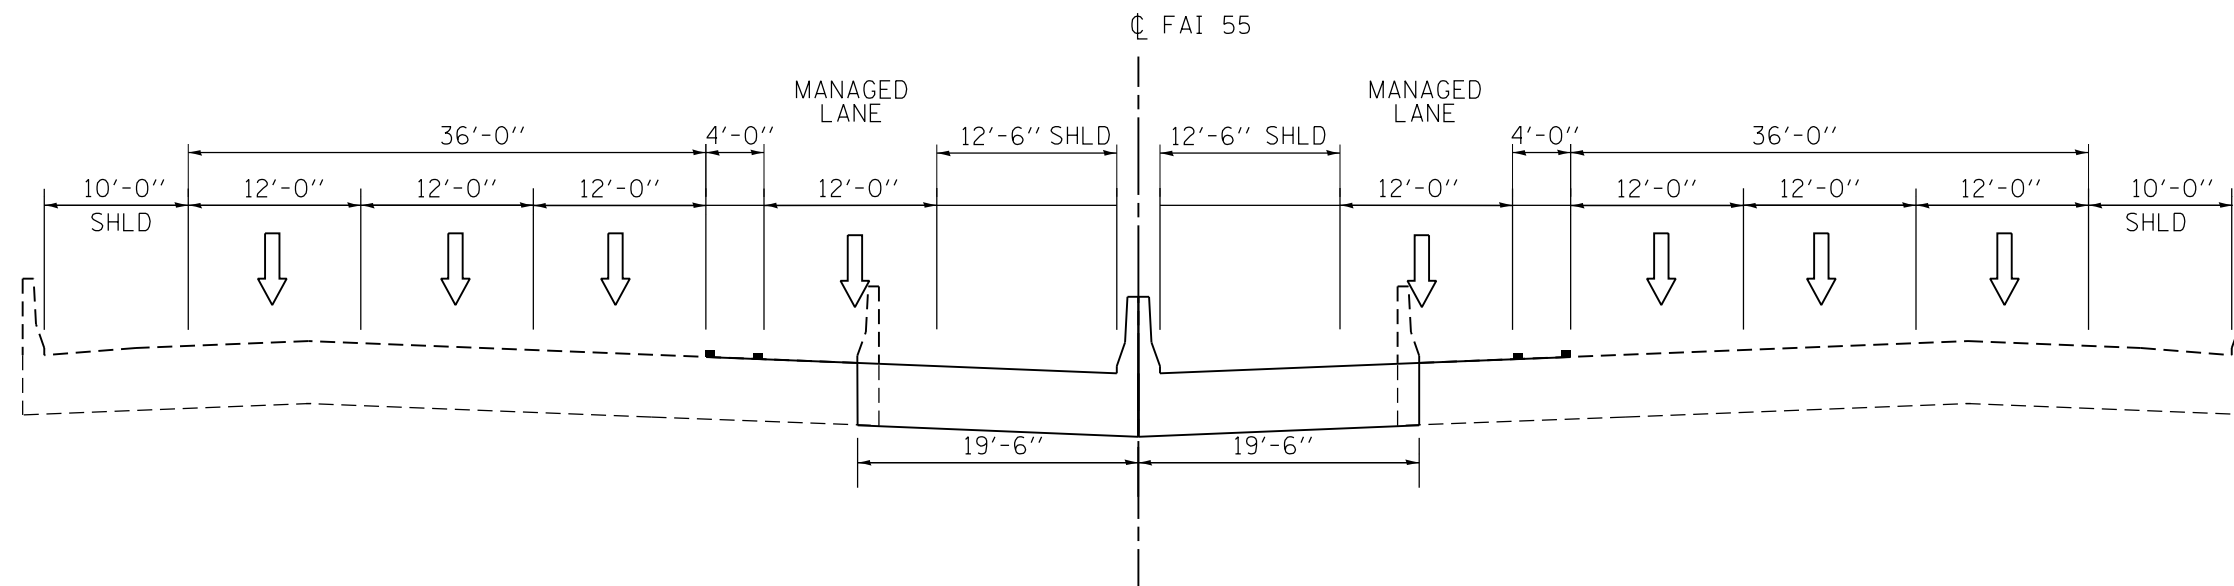

PROPOSED I-55 OVER CICERO AVE TYPICAL SECTION

FILE NAME = V:\7865\active\786500037_IDOT_I-55\civ1\drawing\mod\IP176210-typical-sections\Cicero Ave and RR Structure.dgn



USER NAME = mjverheyen	DESIGNED - MJV	REVISED -
	DRAWN - STANTEC	REVISED -
PLOT SCALE = 13.3343' / 1in.	CHECKED -	REVISED -
PLOT DATE = 10/7/2013	DATE - 10/7/2013	REVISED -

STATE OF ILLINOIS
DEPARTMENT OF TRANSPORTATION



ATTACHMENT K TYPICAL SECTIONS	
SCALE:	SHEET 1 OF 2 SHEETS STA. TO STA.

F.A.I. RTE.	SECTION	COUNTY	TOTAL SHEETS	SHEET NO.
55		COOK		
CONTRACT NO.				
ILLINOIS FED. AID PROJECT				


ATTACHMENT L

Abbreviated Existing Plans

F.A.I. RITE	SECTION	EXPRESSWAY	TOTAL SHEETS	SHEET NO.
55	1112-619-MB	SOUTHWEST	32	2C
STA. 23+02.91		TO STA. 25+40.38		
FED. ROAD DIST. NO. 7		ILLINOIS FED. AID PROJECT 1-65-7(29)-281		

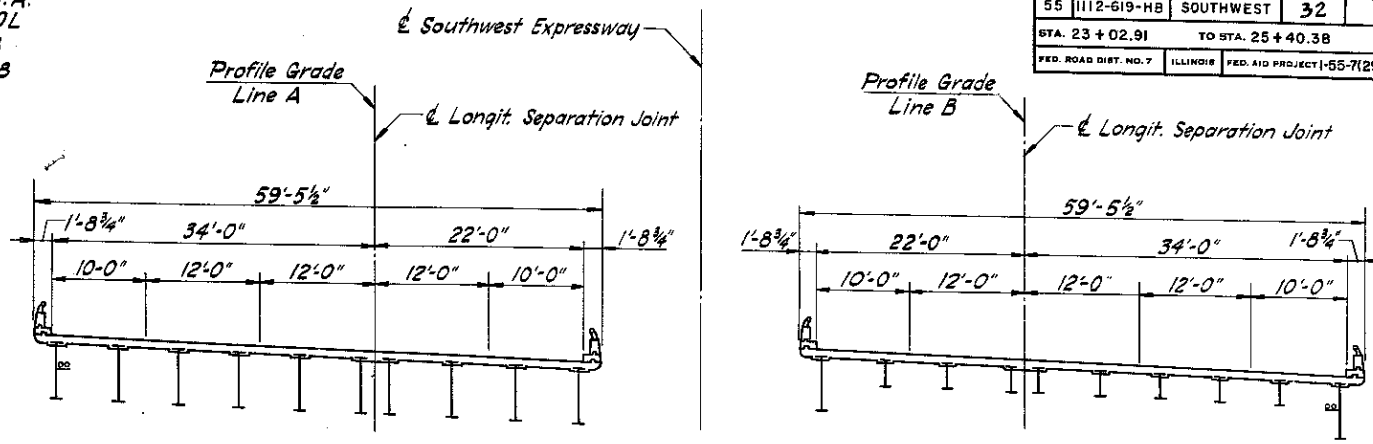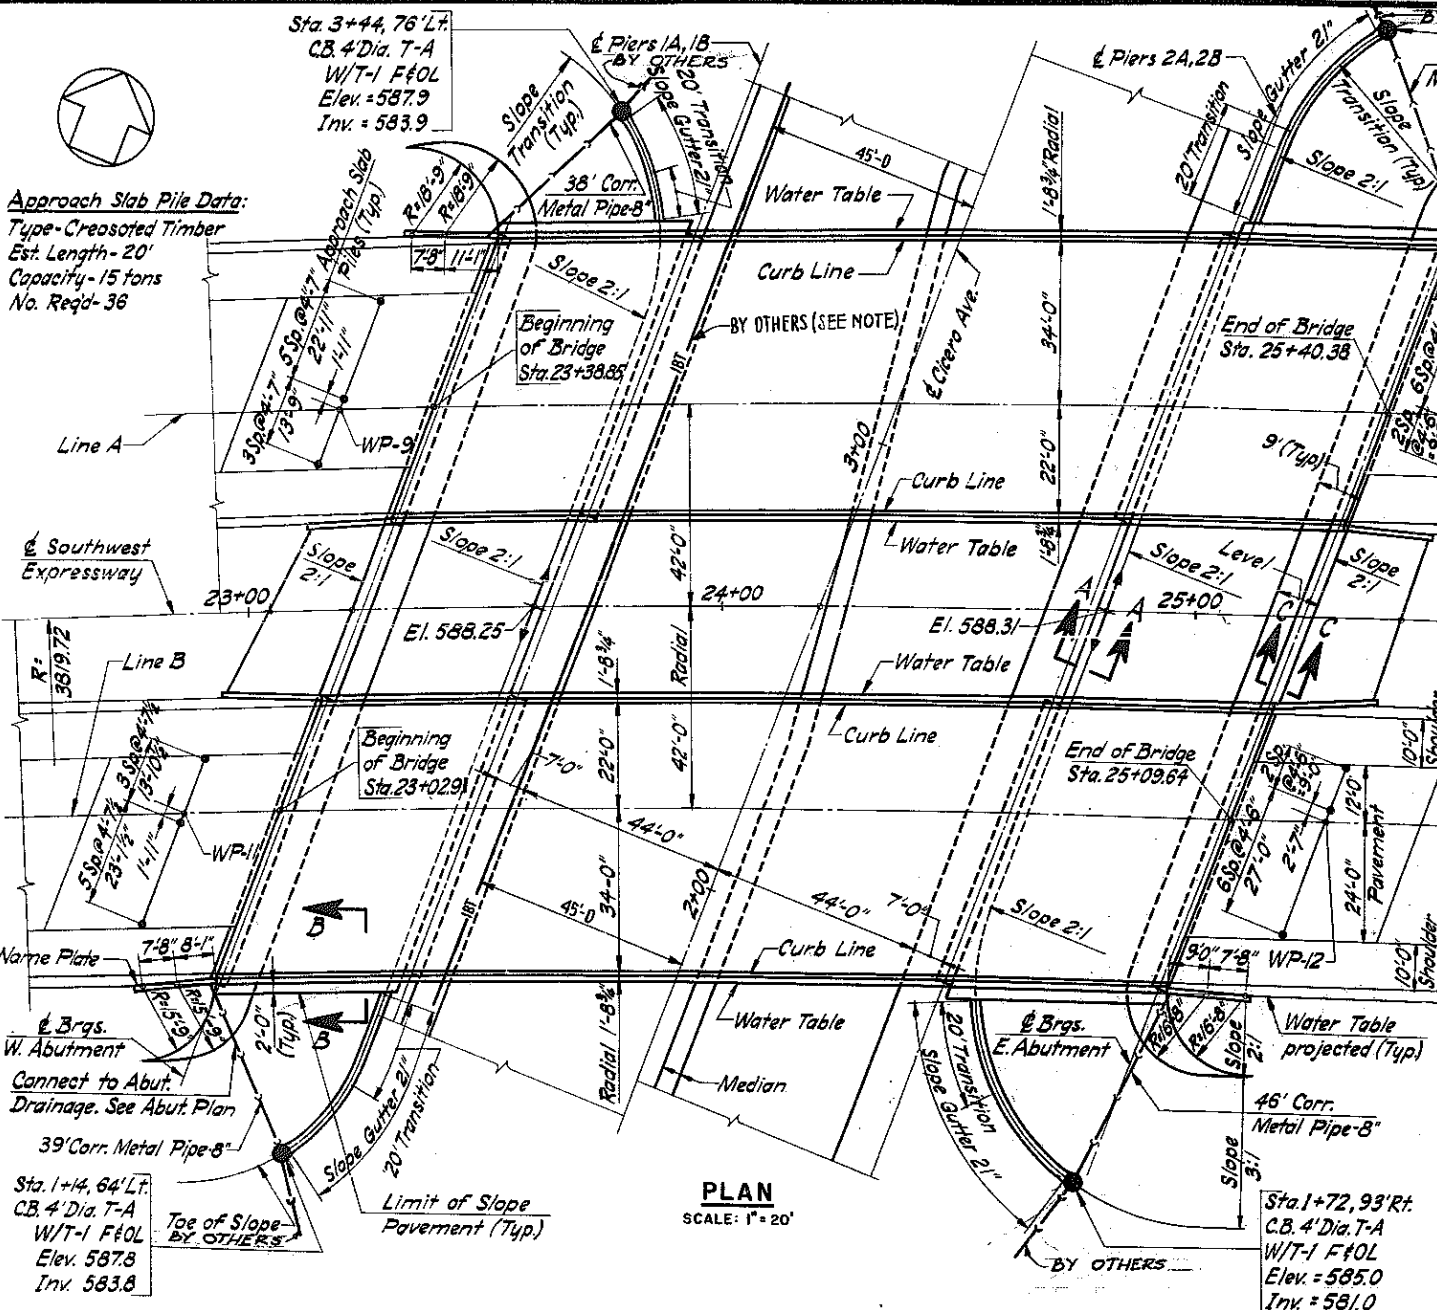

CODE NUMBER	ITEM	UNIT	QUANTITY				
			BRIDGE A		BRIDGE B		TOTAL for 2 Bridges
			Sub.	Super.	Sub.	Super.	
016001	Embankment	Cu. Yds.	14620	—	18,260	—	32,880
019001	Porous Granular Embankment	Cu. Yds.	636	—	618	—	1,254
050001	Class "A" Excavation for Structures	Cu. Yds.	256	—	256	—	512
052003	Class "X" Concrete	Cu. Yds.	470.5	3080	471.2	3090	1,558.7
052021	Protective Coat	Sq. Yds.	—	1449	—	1,454	2,903
054001	Furn. & Erect Struct. Steel	Lbs.	—	496,970	—	498,710	995,680
059001	Reinforcement Bars	Lbs.	62380	78,510	64,470	78,510	283,870
060004	Furnishing Creosoted Piles (up to 20')	Lin. Ft.	360	—	360	—	720
060008	Driving Timber Piles	Lin. Ft.	360	—	360	—	720
060043	Driving Concrete Piles	Lin. Ft.	4335	—	4,425	—	8,760
060044	Furnishing Concrete Piles	Lin. Ft.	4,335	—	4,425	—	8,760
060047	Test Pile Concrete	Ea.	2	—	2	—	4
061001	Name Plates	Ea.	—	1	—	1	2
063001	Corrugated Metal Pipe, 8"	Lin. Ft.	85	—	85	—	170
063020	Perforated Corrugated Metal Pipe, 6"	Lin. Ft.	165	—	165	—	330
075015	C.B. T.A. 4' Dia. T.F. & Open Lid	Ea.	2	—	2	—	4
083002	Slope Wall 4 inch	Sq. Yds.	813	—	719	—	1,532
L02710	Rigid Steel Conduit, 2" Dia.	Lin. Ft.	—	440	—	440	880
L02738	Rigid Steel Conduit, 2 1/2" Dia.	Lin. Ft.	40	—	30	—	70
L02766	Rigid Steel Conduit, 1 1/2" Dia.	Lin. Ft.	—	10	—	20	30
Z08008	Aluminum Handrail	Lin. Ft.	76	403	76	404	959

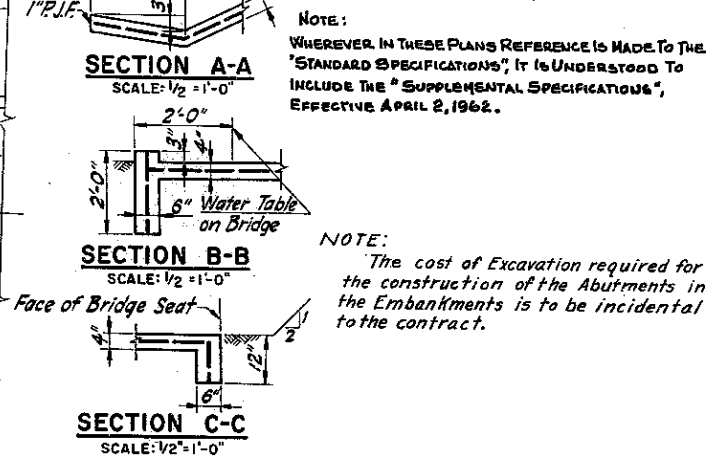

GENERAL NOTES

CONCRETE:

- Coarse aggregate to be used in parapet handrails and end posts must be absolutely free of chert, flint, limonite, lignite and soft sandstone.
- The concrete floor slab shall be finished in accordance with article 51.19 of the standard specifications.
- Sloped wall shall be reinforced with welded wire fabric 6"x6" mesh weighing 58 #/per 100 sq. ft.
- All reinforcement bars shall be lapped 20 diameter: unless otherwise shown.
- Permanent forms will not be permitted in forming the concrete floor.
- Class X concrete shall be used throughout.

STRUCTURAL STEEL:

- Rivets 3/4" φ open holes 5/8" φ unless otherwise noted.
- Anchor bolts shall be set before riveting diaphragms over supports.
- Roadway expansion guards shall be assembled in the shop in proper position with the ends in place and shall be left assembled for shop inspection.
- The following surfaces of the expansion guard shall be given two shop coats of red lead paint: the outside vertical 4" legs of the Ls 6x4x1/4.
- Expansion guards are included in the quantity of structural steel estimated weight 16,560 lbs. Bridge A and 16,610 lbs. Bridge B.
- Except as otherwise provided all structural steel shall receive one shop coat of red lead paint and two field coats of aluminum paint. See article 56.1 to 56.5 inclusive of the standard specifications and the special provisions.
- Structural carbon steel shall conform to specifications for carbon steel A.S.T.M. designation A-36.

SUBSTRUCTURE:

- The contractor shall drive 4 concrete test piles in a permanent location shown on the pier and abutment footing plans as directed by the engineer before ordering the remainder of the piles.
- Concrete piles at abutments shall be driven in holes precored through the embankment.

This work shall be done in accordance with article 60.9(c) of the standard specifications.

TWO SIGNS CONFORMING TO STD. 2160-1 SHALL BE ERRECTED AT LOCATIONS SHOWN ON THE PLANS (SHEET 2B)

UTILITIES:


1. The proposed Illinois Bell Telephone Co. line will be in place prior to beginning bridge construction.

DESIGN LOADS AND STRESSES

Specifications: A. A. S. H. O., 1961
Design Load: H20-S16-44 & alternate
25 psf Future wearing surface

Design Stresses: Structural Steel: F = 20,000 psi
Reinforcement Steel: F = 20,000 psi
Concrete: Fc = 3,500 psi
Ft = 1,400 psi
Fv = 1,000 psi (with earth pressure)
Fv = 75 psi (Footings)
n = 10

Piling: Concrete = 30 ton capacity
Creosoted Timber = 15 ton capacity

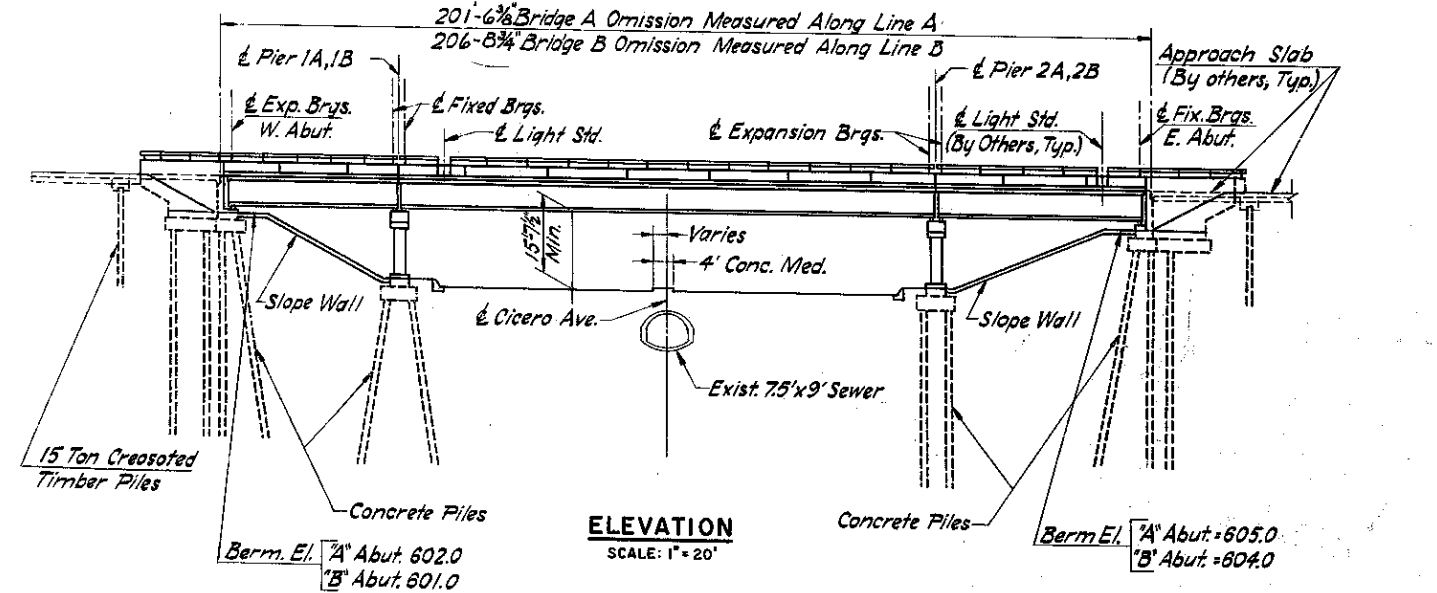

REVISIONS	
NAME	DATE


ILLINOIS DIVISION OF HIGHWAYS
SOUTHWEST EXPRESSWAY
EXPRESSWAY OVER CICERO AVE.

GENERAL PLAN


SCALE: HORIZ. AS NOTED VERT. AS NOTED
DATE: DEC., 1962
DRAWN BY M. Casone
CHECKED BY S. Rouse

Rev. Removed 200 cu yd Special Excav. Rev. C17A Excav. 1080 to 572 cu yd - Added Metal Handrail Type E - 859 lbs. 3-25-63 Rev. Wt. for E & E.S.S. 433 2903 lbs. 4/1/63

STATE	SECTION	EXPRESSWAY	TOTAL SHEETS	SHEET NO.
55	1112-619-HB	SOUTHWEST	52	13
STA. 23+02.91		TO STA. 25+40.38		
FED. ROAD DIST. NO. 7		ILLINOIS		FED. AID PROJECT

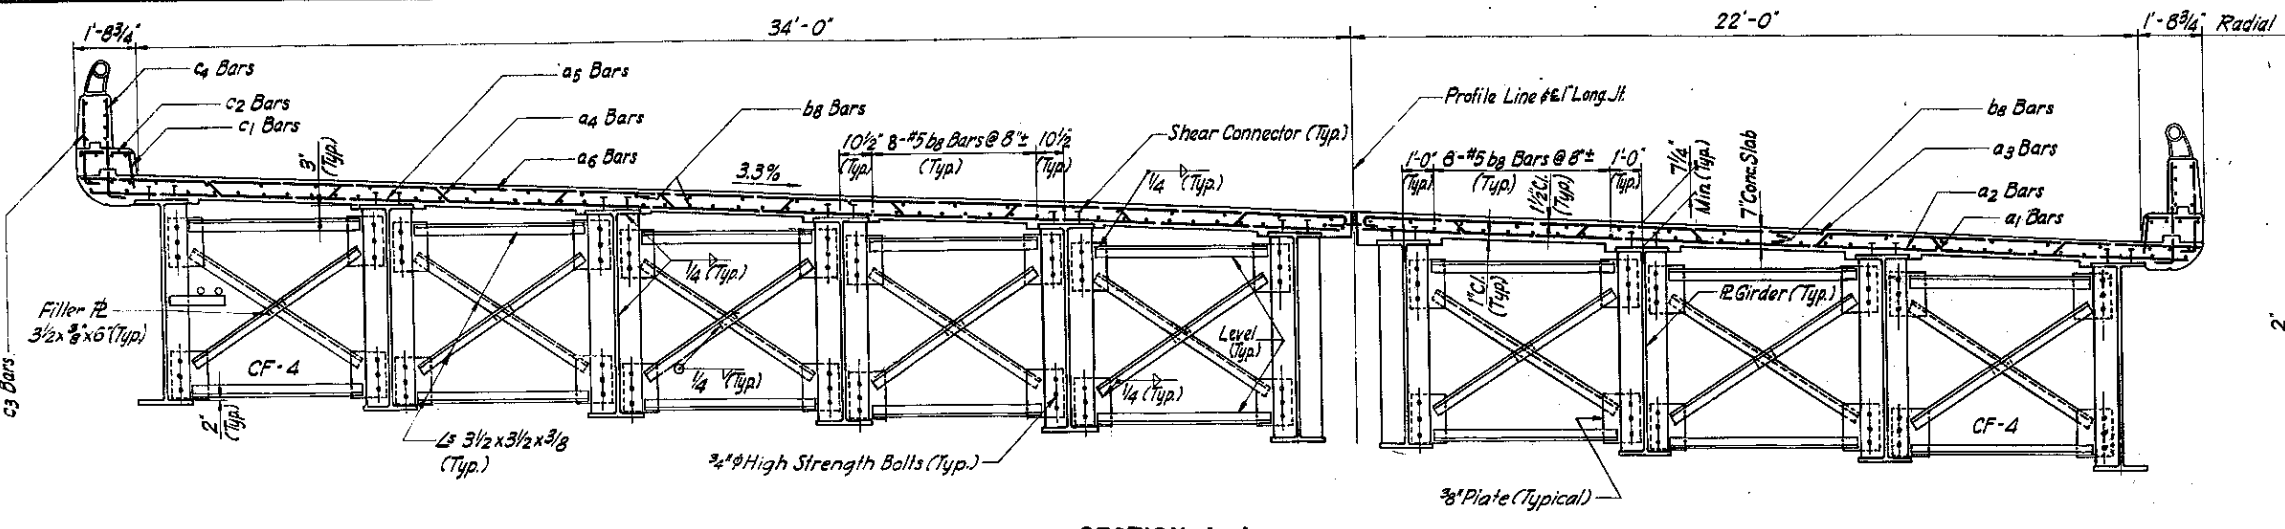


SECTION A-A
SCALE: 3/8" = 1'-0"

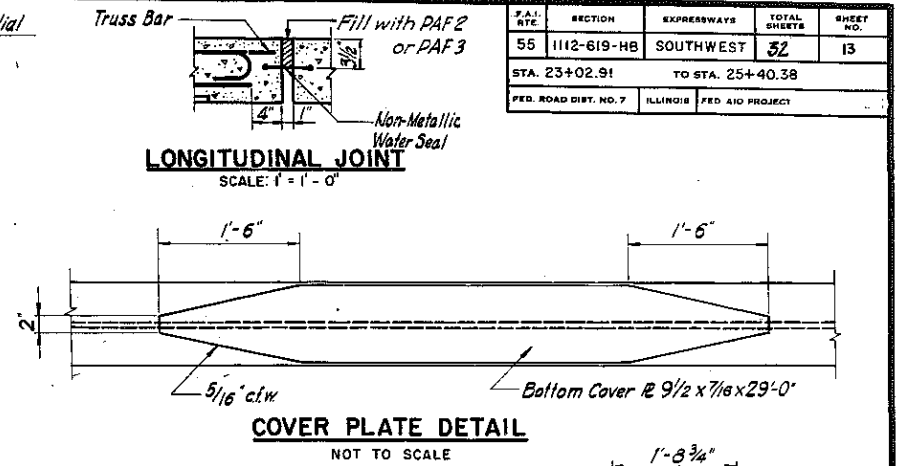


COVER PLATE DETAIL
NOT TO SCALE


FASCIA DETAILS
SCALE: 3/4" = 1'-0"

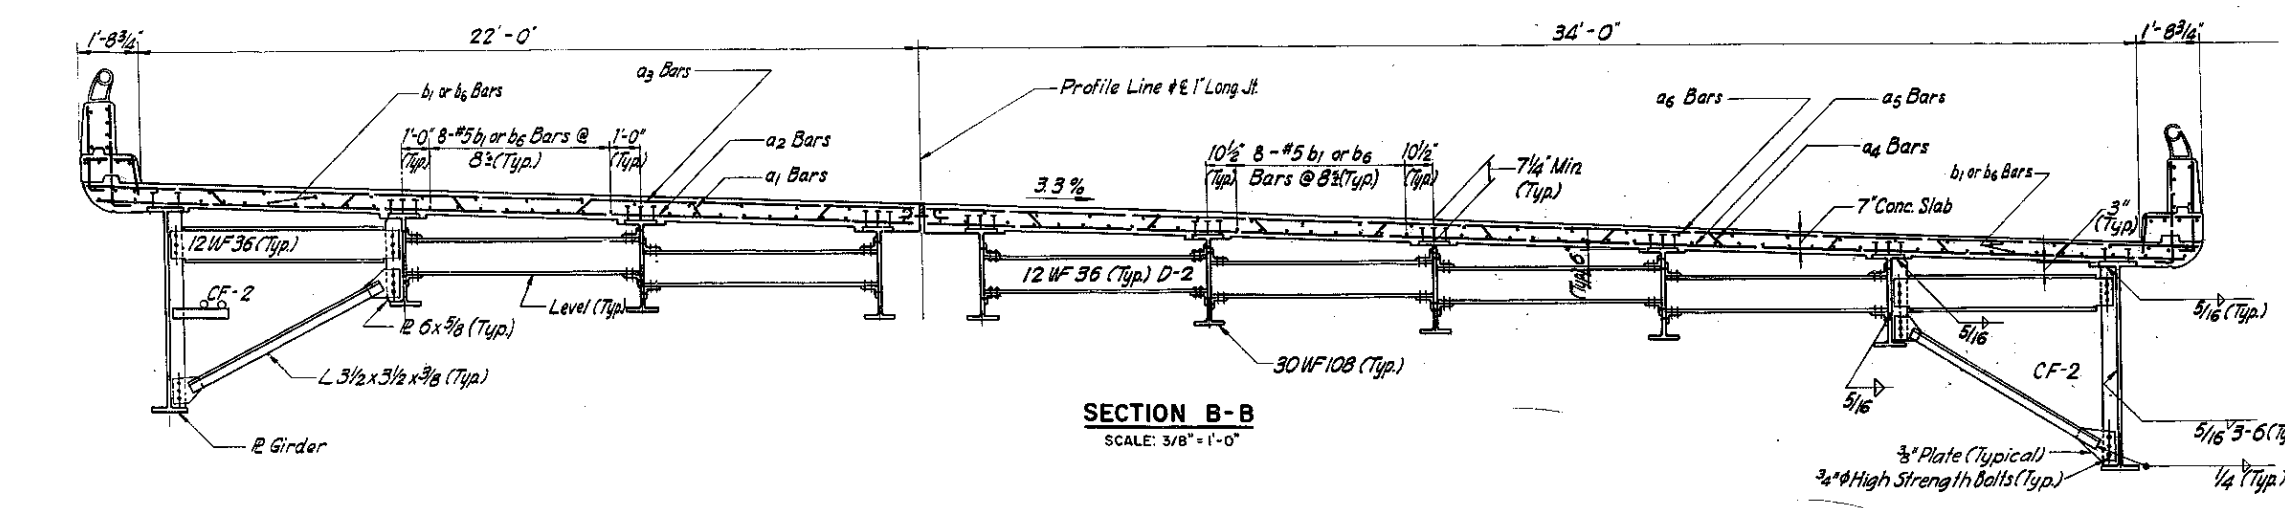


SECTION B-B
SCALE: 3/8" = 1'-0"

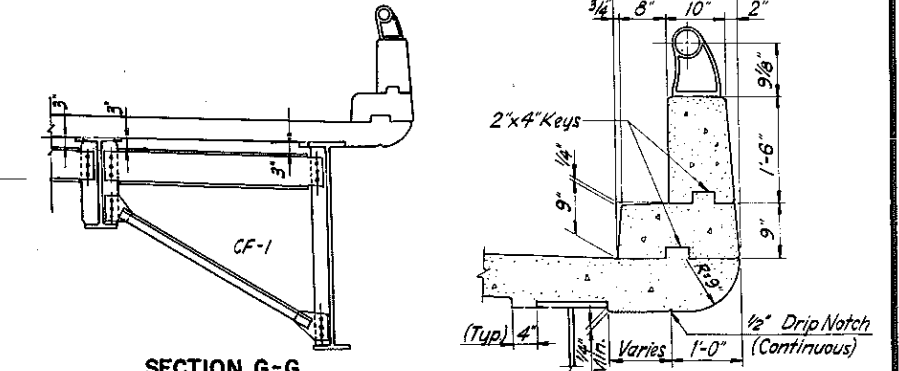


SECTION G-G
SCALE: 3/8" = 1'-0"

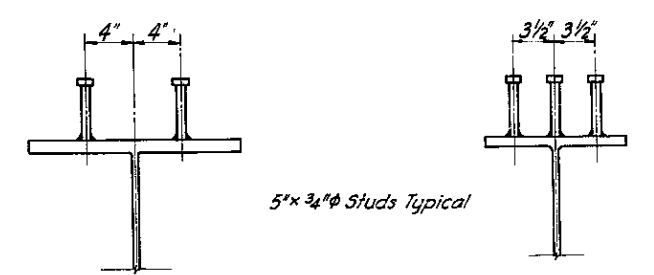


SHEAR CONNECTOR DETAILS
SCALE: 1 1/2" = 1'-0"
(Weight of studs included in Structural Steel Quant.)

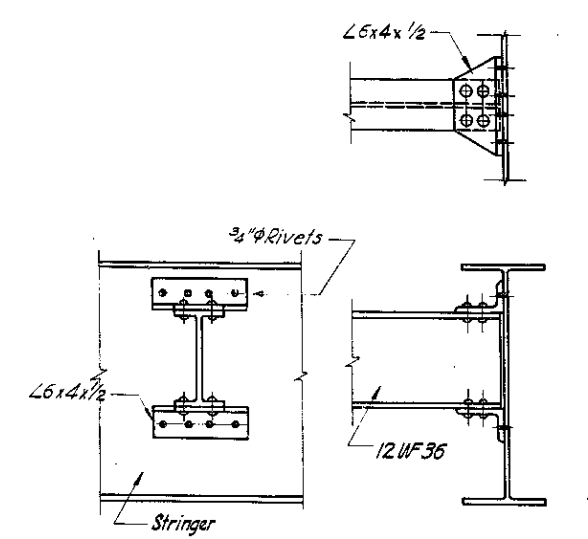


DIAPHRAGM D-2 CONNECTION DETAIL
SCALE: 1" = 1'-0"

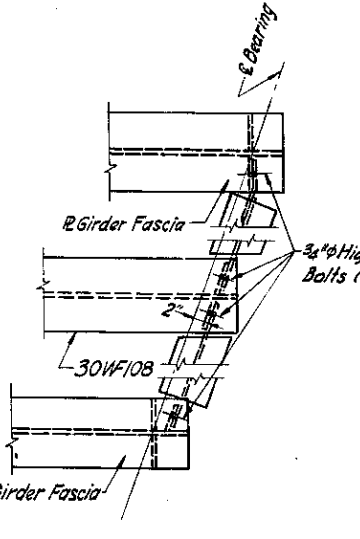


END DIAPHRAGM DETAILS AT ABUTMENT
SCALE: 3/4" = 1'-0"

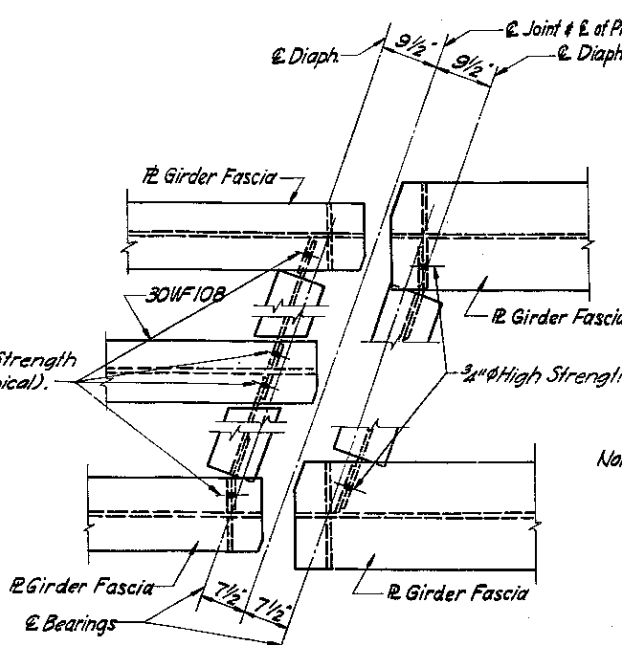

END DIAPHRAGM DETAIL AT PIERS
SCALE: 3/4" = 1'-0"

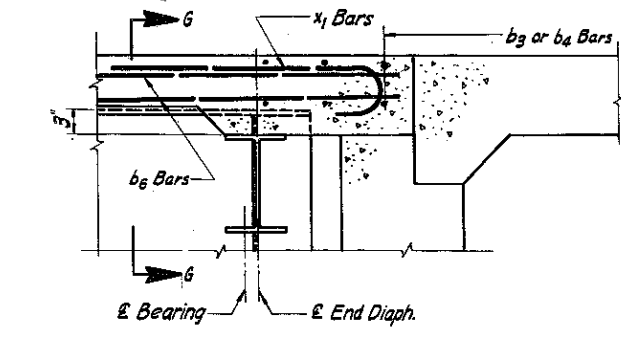

SECTION AT EAST ABUTMENT
SCALE: 1" = 1'-0"

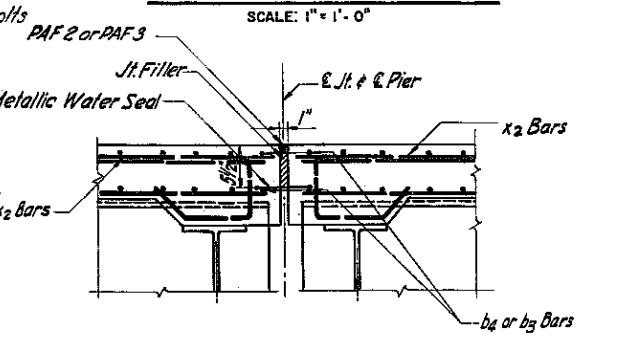

SECTION AT FIXED JOINT
SCALE: 1" = 1'-0"

- NOTES:**
1. For location of sections A-A & B-B, see sheet 12.
 2. Section A-A shown for Bridge A, Bridge B similar except for stringer layout and spacing.
 3. Section B-B shown for Bridge B, Bridge A similar except for stringer layout and spacing.
 4. Use 3/4" rivets, except as otherwise noted.

REVISIONS	
NAME	DATE

ILLINOIS DIVISION OF HIGHWAYS
SOUTHWEST EXPRESSWAY
EXPRESSWAY OVER CICERO AVE.
**SUPERSTRUCTURE
DETAILS**

SCALE: HORIZ. AS NOTED
VERT. AS NOTED
DATE: DEC, 1962

DRAWN BY J. White
CHECKED BY G. Harris

BRIDGE CONDITION REPORT

REGION: 1

DISTRICT: 1

ROUTE: FAI 055 / I-55 WB

COUNTY: Cook

STRUCTURE NUMBER: 016-0017

LOCATION: I-55 Westbound over Cicero Avenue



PREPARED BY:  **Stantec**

DATE PREPARED: 12/20/13

PROPOSED LETTING DATE: To Be Determined

TABLE OF CONTENTS

I. GEOGRAPHICAL & ADMINISTRATIVE DATA.....	1
II. PHYSICAL DESCRIPTION OF STRUCTURE	1
III. FIELD INSPECTION & PHYSICAL EVALUATION.....	4
IV. POTENTIAL SCOPE OF WORK DETERMINATION & ANALYSIS.....	7
V. DISCUSSION AND RECOMMENDED SCOPE OF WORK	8
VI. FINAL RECOMMENDATION.....	9
VII. TRAFFIC STAGING	10

ATTACHMENTS:

- A. Location Map
- B. IDOT Master Structure Report
- C. Bridge Inspection Report
- D. Bottom of Deck Condition Survey
- E. Condition Assessment of the Reinforced Concrete Bridge Deck
- F. Substructure Condition Surveys
- G. Opinion of Probable Costs
- H. Proposed Structure Drawings
- I. Structure Photos
- J. Proposed Plan & Profile
- K. Existing and Proposed Roadway Cross Sections
- L. Abbreviated Existing Plans

I. GEOGRAPHICAL & ADMINISTRATIVE DATA

Structure Number: 016-0017
County: Cook
Route Carried: FAI 055 / I-55
Feature Crossed: FAP 0350 / Cicero Avenue
Section: 1112-619-HB
Station: 24+20

Roadway Classification: Federal Aid Interstate
Design/Posted Speed: 70mph / 55mph
***ADT (current/design):** 80,502 (2012) / 114,556 (2040)
***ADTT (current/design):** 13% = 10,465 (2012) / 13% = 14,892 (2040)
***DHV (current/design):** 5,492 (2012) / 7,963 (2040)
Inventory Rating HS: 1.670 – rated 11/05/01
Operating Rating HS: 2.750 – rated 11/05/01
Sufficiency Rating: 80.0
HBP Eligibility: No

*Traffic data per the I-55 Managed Lane Phase I Study

Construction / Reconstruction / Repair History

The structure carrying I-55 Westbound over Illinois Route 50 (Cicero Avenue) was originally built in 1963 as FAI Route 55 over Cicero Avenue under Project I-55-7(29) 281, Section 1112-619 HB. The original construction consisted of parallel 3-span structures. The two structures carried I-55 eastbound and westbound traffic. The structure consisted of a 7" concrete slab with steel plate girders and wide flange beams supported by reinforced concrete abutments and piers.

As part of Contract 80059, bridge rehabilitation was performed in 1999 on the westbound structure. The rehabilitation consisted of removing the bituminous concrete overlay, performing deck repairs, removing and replacing the transverse deck joints, eliminating the longitudinal deck joint, placing a new deck concrete overlay, refurbishing the bearings, cleaning and painting the existing steel bridge and repairing the substructure and slopewall.

II. PHYSICAL DESCRIPTION OF STRUCTURE

The physical description of the structure is based on a review of the existing available plans dated December 1962 and 1999. Refer to Attachment J for select existing structure plan sheets. Individual components of the existing structure are described below:

Structure Type and Length: The bridge is a three span simply supported plate girder and wide flange beam structure. Span 1 and

3 consists of plate girders and wide flange beams and Span 2 consists of plate girders exclusively. The fascia beams in Spans 1 and 3 are plate girders with 66" deep webs. The interior beams in Spans 1 and 3 are W30x108 beams. Span 2 consists entirely of plate girders with 66" deep webs. Each span has 10 beams. The bridge is approximately 201'-6 3/8" long measured back-to-back of abutments along the curve. The substructure consists of two reinforced concrete stub abutments with wingwalls and two multi-column reinforced concrete piers. The abutments and the piers are supported by concrete piles. The bridge has a 7" reinforced concrete deck plus overlay.

Number / Length of Spans: There are a total of three spans, with approximate lengths as follows (dimensioned from centerline of bearing to centerline of bearing along the curve). Spans are numbered from west to east.

Span 1: 40'-2 1/16"
Span 2: 111'-10 1/8"
Span 3: 45'-5 1/2"

Skew: 21°-40'-17" Left.

Structure Width: The total width is 59'-5 1/2" measured radially out-to-out of the deck. The bridge accommodates three 12' lanes of traffic and 10' inside and outside shoulders.

Expansion Joints:
W Abutment: 2" Neoprene Joint
Pier 1: 1 3/4" Preformed Joint Seal
Pier 2: 2 9/16" Neoprene Joint
E Abutment: 1 3/4" Preformed Joint Seal

Bearings:
W Abutment:
Beam Line 1, 10 Expansion, Type 2
Beam Line 2 to 9 Expansion, Type 3 w/ bolster

Pier 1:
Beam Line 1, 10 Fixed, Type 1 and Type 2
Beam Line 2 to 9 Fixed, Type 1 and Type 3 w/
bolster

Pier 2:
Beam Line 1, 10 Expansion, Type 1 and Type 2
Beam Line 2 to 9 Expansion, Type 1 and

E Abutment: Fixed, Type 2

Beam Line 1, 10 Fixed, Type 3 w/ bolster
Beam Line 2 to 9

- Approach Roadway Template: The approach roadway template matches the bridge with three 12' lanes of traffic and 10' inside and outside shoulders.
- Existing Wearing Surface: 2 3/8" Micro Silica Concrete Overlay
- Existing Vertical Alignment: The entire structure is on a +1.50% tangent slope going from west to east.
- Existing Horizontal Alignment: The structure is on a curve at a radius of 3819.72' from Station 19+41.41 to Station 32+86.83.
- Existing Vertical Clearance: 15'-7 3/8" minimum beneath both structures over Cicero Avenue according to the 1999 repair plans. 16'-5" according to the Master Structure Report which needs to be verified.
- Existing Drainage: There are no drains on the bridge deck or approach slabs.
- Parapets and Railings: There are 1'-8 3/4" wide exterior curb and parapets running the length of the bridge. Parapets were modified in 1999 plans to remove a 9" tall by 1'-0" wide existing handrail and replaced with a 9" tall x 1'-0" wide reinforced concrete section. Per the IDOT Bridge Inspection Report dated 12/10/12, the guardrail currently meets acceptable standards while the guardrail ends and transitions do not.
- Existing Utilities Attachments: There are no light poles attached to the bridge, but there are abandoned conduits running along the both fascia beams and the West Abutment. There is a conduit running along the outside of the North Parapet. There are light fixtures and conduits on the insides of both piers and at the midspan of Beam Lines 2, 5 and 9.
- Name Plate: The name plate is located in the northeast corner of the bridge.

III. FIELD INSPECTION & PHYSICAL EVALUATION

A field inspection beneath the structure carrying I-55 Westbound over Cicero Avenue was performed by Stantec on August 21, 2013. The top of deck inspection was performed on September 16, 2013. The high temperature on that date was 65° F. The visual field inspection was performed on foot on the sloped wall, sidewalk and the top of deck. The following conditions were observed:

Deck

Deck

The deck was rated in satisfactory condition (NBIS Rating = 6) in the 12/10/12 NBIS inspection. The deck condition observed during this inspection was consistent with the NBIS rating. The underside of deck has multiple areas of delamination, spalling and map cracking. Based on visual inspection, approximately 3.2% of the underside of deck is delaminated or spalled.

The micro-silica concrete overlay on the top of deck has minor hairline transverse and longitudinal cracking mostly along the shoulders. Wiss, Janey and Elstner performed a condition assessment of the reinforced bridge deck in January 2012. This assessment included a delamination survey performed on the top of the bridge deck using infrared thermography. The infrared thermography indicated 3.9% of the top of deck area was delaminated. See Attachment E for the condition assessment of the reinforced bridge deck. See Attachment I – Photos 1 through 7.

Parapets

The parapets are in satisfactory condition with hairline vertical cracking throughout and minor delaminations and spalls on both the interior and exterior faces of the parapet. The interior faces of both parapets have approximately 10 square feet of delaminated concrete each. The exterior face of the South Parapet has longitudinal hairline cracking with rust staining along most of the length of the parapet.

Joints

The preformed joint seals at the East Abutment and Pier 1 and the neoprene joints at West Abutment and Pier 2 are in satisfactory to fair condition with debris in the joint and minor impact damage. The joint at Pier 2 is missing an approximately 6' long piece of neoprene in the center lane. The width of the joints was measured when the temperature was approximately 65° F. The preformed joint at the East Abutment measured 7/8" wide. The preformed joint at the Pier 1 measured 7/8". The neoprene joint at the Pier 2 measured 2 1/8". The neoprene joint at the West Abutment measured 1 7/16". See Attachment I – Photos 8 through 11.

Superstructure

Beams

The superstructure consists of three simple spans of rolled steel beams and welded plate girders. The beam lines are numbered 1 through 10, numbered from north to south. In Spans 1 and 3, Beam Lines 1 and 10 consist of plate girders with 66" deep webs and Beam Lines 2 through 9 consist of W30x108 beams. In Span 2, all of the beam lines consist of plate girders with 66" deep webs. This structure has welded cover plates on the bottom flanges of the beams in Span 3.

The superstructure was rated in fair condition (NBIS Rating = 5) in the 12/10/2012 NBIS bridge inspection due to initial section loss and minor pitting. The superstructure observed during this inspection was consistent with the NBIS rating.

The steel superstructure typically has paint starting to fail, minor rust and initial section loss and minor pitting. In both Spans 1 and 3, the steel bolsters have been welded to the W30x108 beams. These welds have mostly cracked. Bolts connect the top of the bolster to the bottom flange as part of a retrofit done in 1999. In Span 3, the steel beams have welded cover plates with fatigue category E' details. The welded cover plates were visually inspected from the ground and no defects were noted on the welds. At Beam Line 9, the bolster under the W30 at Pier 1 appears to have a crack at the weld connecting the bolster top plate and the angled side plate. See Attachment I – Photos 12 through 18.

Bearings

The bearings are in satisfactory condition with paint starting to fail and minor rust. No excessive tilting was noted during the inspection. See Attachment I – Photo 21.

Utilities

The conduits along the South Fascia Beam and South Abutment are in poor condition with heavy deterioration and open conduit covers. See Attachment I – Photos 19, 20, 24, 25 and 27.

Substructure

The substructure was rated in satisfactory condition (NBIS Rating = 6) in the 12/10/2012 NBIS bridge inspection due to cracks and spalls at the abutment caps and pier columns. The substructure condition observed during this inspection was not consistent with the NBIS rating due to the condition of the piers.

Abutments

The reinforced concrete abutments are in satisfactory condition with multiple hairline vertical cracks and small areas of delaminated/spalled concrete. There is 9 square feet of spalled/delaminated concrete on the West Abutment. There is 1 square foot of spalled concrete on the East Abutment. At both abutments, a minor amount of fill appears to be leaking thru the joint in the backwall. No significant defects were found on the wingwalls. See Attachment F for the Substructure Condition Survey. See Attachment I – Photo 22, 23, 26, 28 through 31.

Piers

The reinforced concrete piers each consist of four columns with a pier cap. The piers are in fair condition with moderate to heavy delaminations and spalls on the columns and pier caps. Pier 1 has approximately 184 square feet of spalled or delaminated concrete. Pier 2 has approximately 150 square feet of spalled or delaminated concrete. See Attachment F for the Substructure Condition Surveys. See Attachment I – Photo 32 through 37.

Slope Protection

The bridge has concrete slope walls. Both slopewalls are in satisfactory condition with minor hairline cracking throughout. The West Slopewall has a 6 square foot spall with exposed reinforcement. See Attachment I – Photo 38 through 40.

Inspection History (NBIS Ratings)

Year	Deck	Super	Sub
2012	6	5	6
2011	6	7	6
2009	6	7	6

Geometric, Horizontal & Vertical Clearance / Hydraulic Data

Geometry

I-55 over Cicero Avenue is on a skew. According to the original plans of December 1962 and the repair plans of 1999, the skew at the intersection of the centerlines of I-55 and Cicero Avenue is 21°-40'-17" Left. The typical roadway section for I-55 consists of three 12' lanes, a 10' inside shoulder, a 10' outside shoulder, a 1'-8 3/4" wide curb and parapet on each side of the structure. The I-55 profile grade is on a tangent at +1.50% going from west to east. The structure is on a horizontal curve at a radius of 3819.72' from Station 19+41.41 to Station 32+86.83. The repair plans from 1999 show the vertical minimum clearance at 15'-7 3/8" beneath both structures. However, the Master Structure Report shows the minimum vertical clearance at 16'-5" under the "Key Route under Data" which needs to be verified.

The typical roadway section for Cicero Avenue beneath the structure consists of three lanes in each direction, one turning lane in the northbound direction, and a median. Cicero Avenue is listed as a principal arterial route. Cicero Avenue is located on a 200-ft. long vertical crest curve with 0.36% and -0.30% slopes going from north to south.

As part of the I-55 Managed Lane Phase I Study, I-55 Westbound at Cicero Avenue will be widened to the inside to accommodate a proposed 12' managed lane. In the westbound direction, a 4' buffer between the managed lane with 12.5' shoulder and the general purpose traffic lanes is proposed in this existing 60 foot median section. This widening will be incorporated into the recommended scope of work for this structure.

Hydraulics

At the structure, the I-55 profile is on a +1.50% tangent going from west to east. The bridge deck cross-section is superelevated 3.3%. There are no deck drains on the bridge deck. Therefore, the water is allowed to flow to the deck joints as it runs off the bridge.

IV. POTENTIAL SCOPE OF WORK DETERMINATION & ANALYSIS

As part of the I-55 Managed Lane Phase I Study, In-Kind Repairs, Structure Widening and Structure Replacement alternatives will be evaluated.

Per Section 2.4.2.4 of the IDOT Bridge Manual, consideration was given to retrofit all end of cover plate locations due to average daily truck traffic. From this information, it was determined that a fatigue evaluation was required. The transverse welds at the ends of the cover plates in Span 3 were evaluated for fatigue life and it was determined that the mean service life is less than 50 years. A cover plate retrofit should be installed.

1. In-Kind Repairs

Perform partial and full depth repairs and apply Protective Coat to the existing deck. Repair areas of spalled or delaminated concrete on the existing substructure units. Perform retrofit repairs on the existing Span 3 cover plates.

2. Structure Widening

Remove and replace the deck and approach slabs and widen both approximately 18' to the north. Remove both the southeast and southwest wingwalls and build an extension onto the south side of both abutments. Build an extension onto the south side of both piers. Install three new beam lines using W30 steel beams and plate girders that will be composite to the widened bridge deck. The new W30

beam will be larger than the existing W30 to account for the bottom flange cover plate. Perform retrofit repairs on the existing Span 3 cover plates. Repair areas of spalled or delaminated concrete on the existing substructure units.

3. Superstructure and Partial Substructure Replacement

Remove and replace the existing W30 steel beam and steel plate girder superstructure with a continuous three-span galvanized steel plate girder superstructure. Remove and replace pier caps and columns, but reuse the existing pier crash walls and footings. Build an extension onto the south side of both piers. Replace the existing abutments with integral abutments placed behind the existing abutments. Replace concrete slope walls. The deck geometry will accommodate the proposed roadway geometry from the I-55 Managed Lane Phase I Study.

4. Structure Replacement

Remove and replace the entire structure with a continuous three-span galvanized steel plate girder superstructure on integral abutments. The deck geometry will accommodate the proposed roadway geometry from the I-55 Managed Lane Phase I Study.

V. DISCUSSION AND RECOMMENDED SCOPE OF WORK

The opinion of probable costs for each of the alternatives is summarized below. See Attachment G for the opinion of probable costs breakdown.

- 1. In-Kind Repairs – \$177,100**
- 2. Structure Widening – \$2,516,700**
- 3. Superstructure and Partial Substructure Replacement – \$5,421,000**
- 4. Structure Replacement – \$6,014,900**

Per the I-55 Managed Lane Phase I Study, the managed lane is expected to be implemented in 2020. All widening and replacement alternatives below assume widening approximately 18' to the centerline of I-55 to accommodate the new managed lane. The proposed structure will provide a 9'-6" outside shoulder, three 12'-0" general purpose traffic lanes, a 4' buffer between the general purpose traffic lanes and the 12'-0" managed traffic lane and a 12'-6" inside shoulder.

Analysis of Alternative 1 – The calculated percent of deck area requiring full depth repairs is 3.2% and the partial depth repairs is 7.8%. The total deck repair percentage is within the 25% limit presented in the Bridge Condition Report Procedures and Practices Manual for bridge deck repair to be cost effective for a deck not being widened. This alternative can be used to extend the life span of the existing superstructure in the interim prior to implementing the changes required for the Managed Lane project.

Analysis of Alternative 2 – The calculated percent of deck area requiring full depth repairs is 3.2% and partial depth repairs is 7.8%. Since this deck is 50 years old and has recommended repair area approaching the upper limit (15%) presented in the BCR Procedures and Practices Manual for a widened deck, it is recommended to replace the deck at the time of widening. Cover plate retrofits will be necessary. Deck joints will remain with this alternative, which will lead to continued degradation of the beams and substructure units. This alternative keeps the existing pier caps in service, which have already been repaired as a result of extensive degradation in 1999.

Analysis of Alternative 3 – This alternative replaces the existing W30 steel beam and steel plate girder superstructure with a continuous three-span galvanized steel plate girder superstructure on integral abutments. The proposed integral abutments will be placed behind the existing abutment to help avoid the existing piles. The resulting assumed span arrangement is approximately 70'/114'/70' measured between the centerline of bearings. Uplift at the abutments must be considered in the design phase given the relatively short exterior spans in the continuous structure. Reusing the existing pier crash walls and footings will simplify construction since it will minimize construction impact to Cicero Avenue.

Using galvanized steel eliminates the need to periodically repaint the beam. Providing a continuous structure will also allow for a reduced girder depth over Cicero Avenue, thereby increasing vertical clearance. The longer exterior spans provide an opportunity to relocate the sidewalks, or a multi-use path, along Cicero Avenue behind the piers. Providing new pier caps, pier columns and integral abutments places the critical portions of the substructure on the same life cycle as the superstructure. Eliminating the deck joints will also help to prevent premature degradation of these substructure elements.

Analysis of Alternative 4 – This alternative eliminates the 50-year old structure and replaces it with a new structure with an expected 75-year service life.

The benefits of this alternative are similar to Alternative 3, with the addition of removing and replacing the pier crash walls and pier footings. However, this alternative adds construction complications of reconstructing the piers on or near the same footprint as the existing pier footings, and increases construction impacts to Cicero Avenue. The cost is also greater than Alternative 3 due to the removal and reconstruction of the additional pier elements.

VI. FINAL RECOMMENDATION

Stantec recommends Alternative 3 – Superstructure and Partial Substructure Replacement when the I-55 Managed Lane Project occurs. The selected alternative provides a new superstructure and replaces the critical portions of the substructure. Eliminating the deck joints will help to prevent premature degradation of the replaced substructure elements. As the I-55 Managed Lane Phase I Study is ongoing, the bridge widening to be presented in the TSL should match the final geometry as


presented in the final I-55 Managed Lane Phase I Study. Future improvements to Cicero Avenue, to be determined at a later date, should also be addressed in the TSL.

VII. TRAFFIC STAGING


For Alternatives 2, 3 and 4, the existing deck is wide enough to provide two lanes of traffic in the westbound direction during stage construction. For Alternative 1, the lanes can be temporarily closed as needed to allow for the deck repairs. The traffic staging design will need to be confirmed by IDOT traffic prior to being implemented.

ATTACHMENT A

Location Map

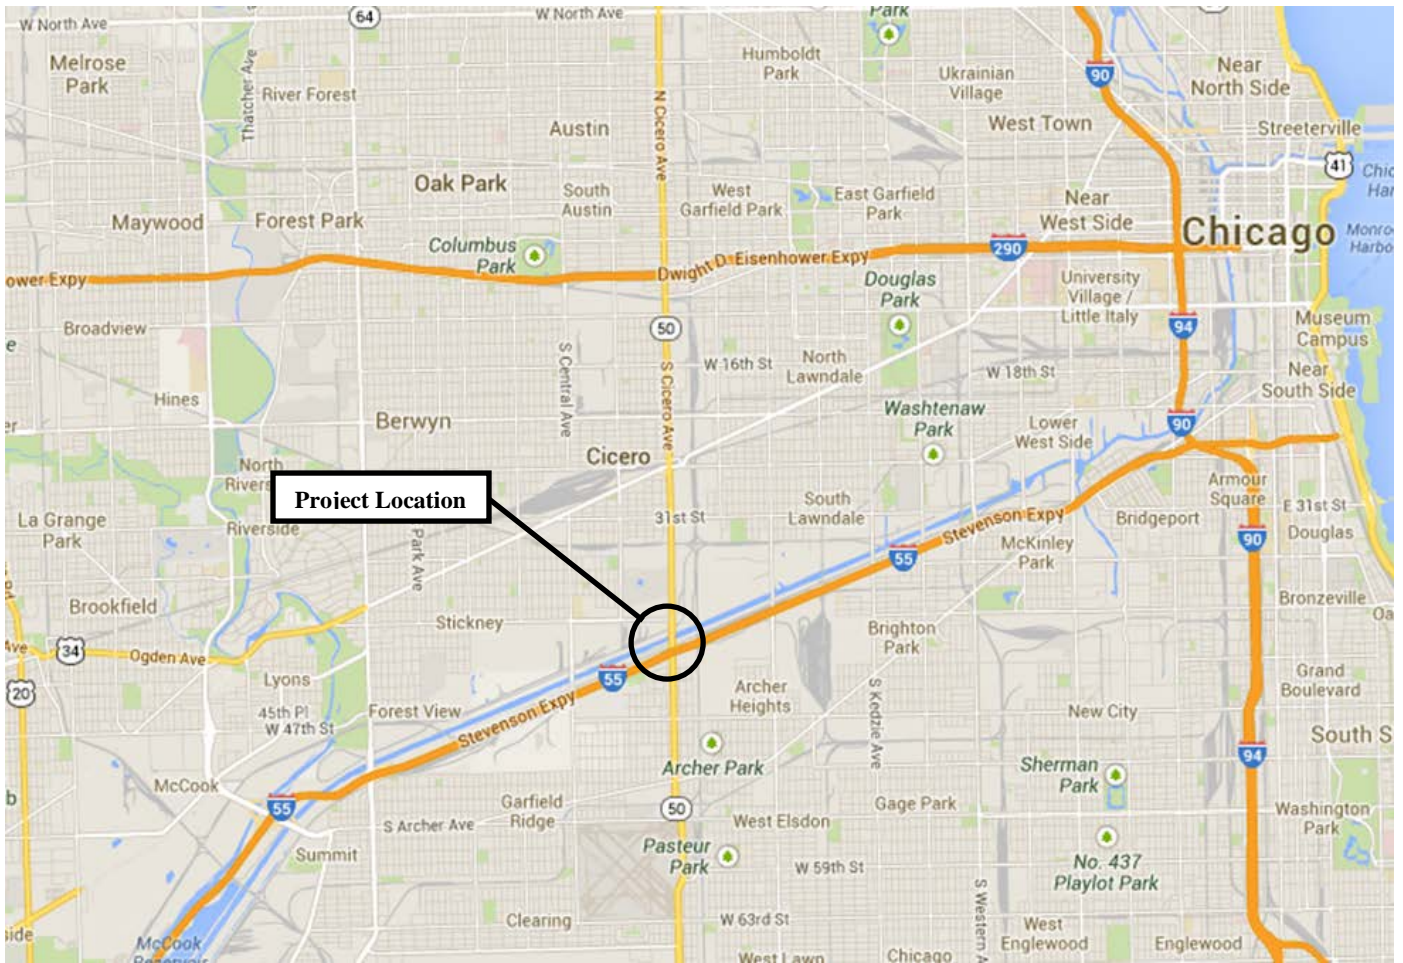

N

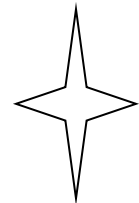

Location Map

Proposed Improvement:

I-55 over Cicero Avenue (Westbound)

Municipality: Stickney

County: Cook

Route: FAI 055

Project No: P-91-762-10

Structure No.: 016-0017

ATTACHMENT B

IDOT Master Structure Report

**Illinois Department of Transportation
Structures Information Management System
Structure Summary Report**

Date: 10/08/2013

Page: 1

Structure Number: 016-0017

District: 1

Inventory Data

Facility Carried:	I-55 WB STEVENSON	Bridge Name:		Sufficiency Rating:	80.0	Structure Length:	202.7
Feature Crossed:	IL 50 (CICERO AVE)	Location:	5.7 M SW I94	HBP Eligible:	No	AAASHTO Bridge Length:	99.9
Bridge Remarks:		Status Date:	12/2000	Replaced By:	-	Length of Long Span:	113.3
Bridge Status:	1 OPEN - NO RESTRICT	Maint Township:	62 LAKE (CHICAGO)	Replaces:	-	Bridge Roadway Width:	56.0
Status Remarks:				Last Update Date:	03/12/2013	Appr Roadway Width:	60.0
Maint County:	016 COOK			Parallel Structure:	Left	Deck Width:	59.4
Maint Responsibility:	01 I.D.O.T.			Multi-Level Structure Nbr:		Sidewalk Width Right:	0.0
Service On/Under:	5 SECOND LEVEL INTERCHANGE	1 / HIGHWAY		Skew Direction:	L	Sidewalk Width Left:	0.0
Reporting Agency:	1 I.D.O.T. - BUREAU OF MAINTENANCE			Skew Angle:	22 D 0 M 0 S	Navigation Control:	N
Main Span Matl/Type:	3 STEEL	/ 02 STRINGER/MULTI-BEAM/GIRDER		Structure Flared:	No	Navigation Horiz Clear:	0
Nbr Of Main Spans:	3	Nbr Of Approach Spans:	0	Historical Significance:	No	Navigation Vert Clear:	0.0
Approaches				Border Bridge State:		Culvert Fill Depth:	0.0
Near #1 Matl/Type:	/			Bdr State SN:		Number Culvert Cells:	0
Near #2 Matl/Type:	/			Bdr State % Responsibility:		Culvert Opening Area:	0.0
Far #1 Matl/Type:	/			Structural Steel Wt	996000	Culvert Cell Height:	0.00
Far #2 Matl/Type:	/			Substructure Material:		Culvert Cell Width:	0.00
Median Width/Type:	0 Ft. / 0	None		Rated By:	2 IDOT	Rate Method:	1 LOAD FACTOR
Guardrail Type L/R:	0None	/ 0		Load Rating Date:	11/05/2001	Railroad Crossing Info	
Toll Facility Indicator:	0 No Toll			Inventory Rating:	1.670(60)	Crossing 1 Nbr:	
Latitude:	41 D 49 M 1.4 S	Longitude:	87 D 44 M 37.16 S	Operating Rating:	2.750(99)	Crossing 1 Nbr:	
Deck Structure Type:	A CIP CON NRMALLY FORM			Design Load:	01 HS20+MOD	RR Lateral Underclear:	0.0
Sidewalks Under Structure:	2 Both Sides Not Separate			Deck Structure Thickness:	7 SD: N FO: N	RR Vertical Underclear:	0 Ft 0 In

Key Route On Data

Key Route Nbr:	FEDERAL-AID INTERSTATE	Station:	0055	Station:	10.2600
Appurtenances	Main Route	Segment:	00000	Segment:	00000
Inventory County:	016 COOK	Linked:	Y	Linked:	Y
Township/Road Dist	34 STICKNEY	Natl. Hwy System:	On NHS	Natl. Hwy System:	On NHS
Municipality	5540 STICKNEY	Inventory Direction:		Inventory Direction:	
Urban Area:	1051	Curr AADT Yr/Count:	2012 / 61150	Curr AADT Yr/Count:	2011 / 40800
Functional Class:	1 INTERSTATE	Est Truck Percentage:	13	Est Truck Percentage:	11
CLEARANCES	South/East	Number Of Lanes:	3	Number Of Lanes:	7
Max Rdwy Width:	56.0	One Or Two Way:	1 One-Way	One Or Two Way:	2 Two-Way
Horizontal:	57.5	Bypass Length:	0	Bypass Length:	0
		Future AADT Yr/Cnt:	2032 / 75808	Future AADT Yr/Cnt:	2032 / 42024
		Designated Truck Rte:	CLASS I	Designated Truck Rte:	CLASS II
		Special Systems:	Yes	Special Systems:	Yes

Key Route Under Data

FEDERAL-AID PRIMARY	Station:	0350	Station:	18.6900
Main Route	Segment:	00000	Segment:	
016	Linked:	Y	Linked:	Y
62 LAKE (CHICAGO)	Natl. Hwy System:	On NHS	Natl. Hwy System:	On NHS
1051 CHICAGO	Inventory Direction:		Inventory Direction:	
1051	Curr AADT Yr/Count:	2011 / 40800	Curr AADT Yr/Count:	2011 / 40800
3 OTHER PRINCIPAL ARTERIAL	Est Truck Percentage:	11	Est Truck Percentage:	11
South/East	Number Of Lanes:	7	Number Of Lanes:	7
101.6	One Or Two Way:	2 Two-Way	One Or Two Way:	2 Two-Way
101.6	Bypass Length:	0	Bypass Length:	0
	Future AADT Yr/Cnt:	2032 / 42024	Future AADT Yr/Cnt:	2032 / 42024
	Designated Truck Rte:	CLASS II	Designated Truck Rte:	CLASS II
	Special Systems:	Yes	Special Systems:	Yes

***** Marked Route On Data *****

Route #1:	1 Mainline	Designation		Kind		Number	
Route #2:	1 Mainline		1 Interstate Highway			055	
Route #3:	1 Mainline						

***** Marked Route Under Data *****

Route #1:	1 Mainline	Designation		Kind		Number	
Route #2:	1 Mainline		3 State Highway			050	
Route #3:	1 Mainline						

**Illinois Department of Transportation
Structures Information Management System
Structure Summary Report**

Date: 10/08/2013

Page: 2

Structure Number: 016-0017 District: 1

Data Related to Inspection Information

*** Inspection Intervals *** *** Maximum Allowable Posting Limits ***

Routine NBIS: 24 MOS Underwater: 0 MOS One Truck At A Time: 0 Combination Type 3S-1: Tons Bridge Posting Level: 5 No Posting Required
 Special: N Single Unit Vehicles: Tons Combination Type 3S-2: Tons

Inspection/Appraisal Information

Inspection Date: 12/10/2012 Inspection Temperature: 35Deg. F ** Actual Posted Limits **
 Deck: 6 SATISFACTORY CONDITION - MINOR DETERIORATION Single Unit Vehicles: Tons
 Superstructure: 5 FAIR CONDITION - MINOR SECTION LOSS, CRACKS Combination Type 3S-1: Tons
 Substructure: 6 SATISFACTORY CONDITION - MINOR DETERIORATION Combination Type 3S-2: Tons
 Culvert: N NOT APPLICABLE One Truck At A Time: 0
 Channel and Protection: N NOT APPLICABLE Deck Wearing Surf: F MICRO SIL CON OVRLY Last Paint Type: U
 Structural Evaluation: 5 BETTER THAN ADEQUATE TO BE LEFT IN PLACE Deck Membrane: F NONE FLD AL EPY & ACRLC
 Deck Geometry: 6 EQUAL TO PRESENT MINIMUM CRITERIA Deck Protection: J NONE
 Underclearance-Vert/Lat.: 4 MINIMUM ADEQUACY TO BE LEFT IN PLACE Total Deck Thick: 8.9
 Waterway Adequacy: N NOT APPLICABLE Last Paint Date: 10/2000
 Approach Roadway Align: 8 EQUAL TO PRESENT DESIRABLE CRITERIA
 Bridge Railing Appraisal: 3 Meets Standards
 Approach Guardrail: 233 Not Acceptable Acceptable
 Pier Navig Protection: N N/A

Underwater Inspection/Appraisal Information

Inspection Date: Inspection Category:
 Temperature: Inspection Method: Appraisal Rating:

Scour Critical Information

Evaluation Method:

Miscellaneous

Rating: Microfilm Data Recorded: Yes
 Analysis Date: YRS Drainage Area: Acre

Construction Information

Year: 1963 Original Reconstructed
 Route: FAI-55 Sta: 24+20 Sta:
 Section Nbr: 1112-619-HB
 Contract Nbr:
 Fed Aid Prf#: I 0557029281
 Built By: 1 I.D.O.T.

Waterway Information

Flood Design Frequency:
 Flood Design Q (CFS):
 Flood Design Nat H W E:
 Flood Des Open Prop:

ATTACHMENT C

Bridge Inspection Report



SN: 016-0017	District: 1	Spans: 3	Appr. Spans: 0	Skew: 22.00	ADT: 61150	Truck Pct: 13
ADT Un: 40800	Maint. Co: COOK	Twsp: LAKE (CHICAGO)		Status: OPEN - NO RESTRICT		
Facility Carried: I- 55 WB STEVENSON			Feature Crossed: IL 50 (CICERO AVE)			
Location: 5.7 M SW I94		Municipality: STICKNEY		Team/Sub Section: E26019		
Bridge Name:			Material & Type: STEEL/STRINGER/MULTI-BEAM/GIRDER			
Insp. Intervals (Mo) Routine NBIS: 24		Fracture Critical: 0		Underwater: 0		Special Feature: N/A
90 - Inspection Date: / /		90C - Temp. (°F):		90A - Program Manager:		
Is Delinquent: <input type="checkbox"/>		Reason:				
90A1 - Team Leader:			90A2 - Inspector:			

90B - Inspection Remarks:

Previous Inspection	2008) DK SOFFIT MAP CRKD & SPALLED W/CHLR CONTAM. JOINTS LEAKING. STL BMS-SPANN 2 MINOR RUST @ BOTT FLANGES & LAT BRCNG. PIER 1&2 WALLS SM SPALLS. PIER 2 SOUTH END CANTILEVER MAP CRKD. PIER 2 COL 1 MAP CRKD. Item 59 lowered to "5" due t
------------------------	--

Resources

Time to Inspect (H:M): 1:0	Traffic Control: 3	Boat:	Waders:	Snooper:
Ladder: LL	Manlift:	Bucket Truck:	Other:	

Inspector's Appraisals

	Prev	New	Comments
58 - Deck Condition:	6		
59 - Superstructure Cond:	5		
60 - Substructure Cond:	6		
62 - Culvert Condition:	N		
61 - Channel Condition:	N		
71 - Waterway Adequacy:	N		
72 - Approach Rdw Align:	8		
111 - Pier Navig Protection:	N		

90B - Inspector Remarks:

Routine Inspection Report

Structure Number: 0160017

Additional Inspection Data

36A – Bridge Railing Adequacy:		Prev 3	New	Rail Types:				
--------------------------------	--	-----------	-----	-------------	--	--	--	--

Approach Guardrail Adequacy:		36B – Transitions:		Prev 2	New	36C – Guardrail:		Prev 3	New	36D – Ends:		Prev 3	New
------------------------------	--	--------------------	--	-----------	-----	------------------	--	-----------	-----	-------------	--	-----------	-----

108A – Wearing Surface Type:		Prev F	New	If "L-Other" Describe:								
108B – Type of Membrane:		Prev F	New	If "E-Other" Describe:								
108C – Deck Protection:		Prev J	New	If "I-Other" Describe:								
108D – Total Deck Thickness (in):		Prev 8.9	New									

59A – Paint Date (Mo/Yr):		Prev 10/2000	New /									
59B – Paint Type:		Prev U	New	Color:		Fascia - ____:		Inter. - ____:		Railing - ____.		

59C – Utilities Attached:		Prev	New	If "B-Other" Describe:							
---------------------------	--	------	-----	------------------------	--	--	--	--	--	--	--

Weight Limit Posting:	70A2 – Single Unit Vehicles:		Prev	New	Tons
	70B2 – Combination Type 3S-1 (3 or 4 axles):				Tons
	70C2 – Combination Type 3S-2 (5 or more axles):				Tons
	70D2 – One Truck at a Time:		0		

Joint Openings (In.) _____

90B – Inspector Remarks Continued:

	Signature	Date
Inspection Team Leader:		/ /
Inspection Program Manager:		/ /

Pontis

Today's Date: 04/19/2013

Structure Number: 016-0017 District: 1 (41) Bridge Status: 1 OPEN - NO RESTRICT
 (6) Feature Crossed: IL 50 (CICERO AVE) (7) Facility Carried: I- 55 WB STEVENSON
 (9) Location: 5.7 M SW 194 (7A) Bridge Name:
 Element Inspection Date: 12/10/2012 Inspectors: SEDLACEKJL

Element Description												
Elem	Env	% 1	Qty 1	% 2	Qty 2	% 3	Qty 3	% 4	Qty 4	% 5	Qty 5	Tot Qty
Concrete Deck Protected w/ Rigid Overlay												
22	4	11	1,326	45	5,422	44	5,300	0	0	0	0	12,048
			No deficiencies.	Repaired areas exist	Map cracked areas.	Spalls/delaminations	Full depth failures.					
Remarks: (WS) HL map crking; Soffit) Isol spalls, HPs, HL-Nar leach crks & chlor contam												
Lead Painted Steel Open Girder												
107	4	100	28,224	0	0	0	0	0	0	0	0	28,224
			No corrosion	Paint distress	Rust formation	Section loss	Section failure					
Remarks: Stl Bms-Span 2 minor rust @ Bott flanges & Lat brng.												
Non-Lead Painted Steel Closed Web/Box Girder and O												
173	4	100	60	0	0	0	0	0	0	0	0	60
			No corrosion	Paint distress	Rust formation	Section loss	Section failure					
Remarks:												
Reinforced Conc Column or Pile Extension												
205	4	100	1,068	0	0	0	0	0	0	0	0	1,068
			No deterioration	Minor cracks/spalls	Delams/spalls	Analysis warranted						
Remarks: Pier 2 Col #1 FCR map crkd												
Reinforced Conc Pier Wall												
210	4	100	942	0	0	0	0	0	0	0	0	942
			No deterioration	Minor cracks/spalls	Delams/spalls	Analysis warranted						
Remarks: Pier 1 & 2- small spalls												
Reinforced Conc Abutment												
215	4	100	1,912	0	0	0	0	0	0	0	0	1,912
			No deterioration	Minor cracks/spalls	Delams/spalls	Analysis warranted						
Remarks: HL vert crks in backwall; East Abut- few hl vert crks; West Abut Bkwall -vert crks												
Reinforced Conc Pier or Abutment Cap												
234	4	98	249	2	4	0	0	0	0	0	0	253
			No deterioration	Minor cracks/spalls	Delams/spalls	Analysis warranted						
Remarks: (Abut) Crking @ steps; Pier) Crking in cantilever seat (Pier 2 South Nose)												
Preformed Joint Seal												
302	4	90	56	10	6	0	0	0	0	0	0	62
			No deterioration	Minor deterioration	Major deterioration							
Remarks: Leaking @ East Abut & Pier 1												
Neoprene Expansion Joint												
307	4	89	166	11	20	0	0	0	0	0	0	186
			The element shows mi	The seal maybe punct	The seal maybe heavi	Major deterioration						
Remarks: Leaking @ West Abut & Pier 2; Pier 2 Jnt torn @ Lane 1&2 (12ft). West Abut Jnt torn @ Lane 3 (8ft)												

Movable Discontinuous Brg.												
311	4	100	30	0	0	0	0	0	0	0	0	30
		No deterioration	Minor deterioration	Advanced corrosion								

Remarks:

Fixed Bearing												
313	4	100	30	0	0	0	0	0	0	0	0	30
		No deterioration	Minor deterioration	Advanced corrosion								

Remarks:

Approach Pavement												
323	4	100	2	0	0	0	0	0	0	0	0	2
		No deterioration	Cracks/spalls	Major cracks/spalls	Broken/Unstable							

Remarks:

Concrete Bridge Railing												
331	4	99	402	1	4	0	0	0	0	0	0	406
		No deterioration	Minor cracks/spalls	Analysis warranted								

Remarks:

Steel Open Girder												
406	4	100	6	0	0	0	0	0	0	0	0	6
		Minor fatigue, out-o	Moderate fatigue, ou	Severe fatigue, out-								

Remarks:

Element Description												
Elem	Env	% 1	Qty 1	% 2	Qty 2	% 3	Qty 3	% 4	Qty 4	% 5	Qty 5	Tot Qty

Concrete Deck Protected w/ Rigid Overlay												
22	4	11	1,326	45	5,422	44	5,300	0	0	0	0	12,048
		No deficiencies.	Repaired areas exist	Map cracked areas.	Spalls/delaminations	Full depth failures.						

Remarks:

Lead Painted Steel Open Girder												
107	4	100	28,224	0	0	0	0	0	0	0	0	28,224
		No corrosion	Paint distress	Rust formation	Section loss	Section failure						

Remarks:

Non-Lead Painted Steel Closed Web/Box Girder and O												
173	4	100	60	0	0	0	0	0	0	0	0	60
		No corrosion	Paint distress	Rust formation	Section loss	Section failure						

Remarks:

Reinforced Conc Column or Pile Extension												
205	4	100	1,068	0	0	0	0	0	0	0	0	1,068
		No deterioration	Minor cracks/spalls	Delams/spalls	Analysis warranted							

Remarks:

Reinforced Conc Pier Wall												
210	4	100	942	0	0	0	0	0	0	0	0	942
		No deterioration	Minor cracks/spalls	Delams/spalls	Analysis warranted							

Remarks:

Reinforced Conc Abutment

215	4	100	1,912	0	0	0	0	0	0	0	0	1,912
		No deterioration	Minor cracks/spalls	Delams/spalls	Analysis warranted							

Remarks: HL vert crks in backwall; East Abut- few hl vert crks; West Abut Bkwall -vert crks

Reinforced Conc Pier or Abutment Cap

234	4	98	249	2	4	0	0	0	0	0	0	253
		No deterioration	Minor cracks/spalls	Delams/spalls	Analysis warranted							

Remarks: Abut) Crking @ steps; Pier) Crking in cantilever seat (Pier 2 South Nose)

Preformed Joint Seal

302	4	90	56	10	6	0	0	0	0	0	0	62
		No deterioration	Minor deterioration	Major deterioration								

Remarks: Leaking @ East Abut & Pier 1

Neoprene Expansion Joint

307	4	89	166	11	20	0	0	0	0	0	0	186
		The element shows mi	The seal maybe punct	The seal maybe heavi	Major deterioration							

Remarks: Leaking @ West Abut & Pier 2; Pier 2 Jnt torn @ Lane 1&2 (12ft). West Abut Jnt torn @ Lane 3 (8ft)

Movable Discontinuous Brg.

311	4	100	30	0	0	0	0	0	0	0	0	30
		No deterioration	Minor deterioration	Advanced corrosion								

Remarks:

Fixed Bearing

313	4	100	30	0	0	0	0	0	0	0	0	30
		No deterioration	Minor deterioration	Advanced corrosion								

Remarks:

Approach Pavement

323	4	100	2	0	0	0	0	0	0	0	0	2
		No deterioration	Cracks/spalls	Major cracks/spalls	Broken/Unstable							

Remarks:

Concrete Bridge Railing

331	4	99	402	1	4	0	0	0	0	0	0	406
		No deterioration	Minor cracks/spalls	Analysis warranted								

Remarks: HL vert crks; Few small spalls in water table

Element Description

Elem	Env	% 1	Qty 1	% 2	Qty 2	% 3	Qty 3	% 4	Qty 4	% 5	Qty 5	Tot Qty
------	-----	-----	-------	-----	-------	-----	-------	-----	-------	-----	-------	---------

Concrete Deck Protected w/ Rigid Overlay

22	4	11	1,326	45	5,422	44	5,300	0	0	0	0	12,048
		No deficiencies.	Repaired areas exist	Map cracked areas.	Spalls/delaminations	Full depth failures.						

Remarks: WS)HL map crking; Soffit) Isol spalls, HPs, HL-Nar leach crks & chlor contam

Lead Painted Steel Open Girder

107	4	100	28,224	0	0	0	0	0	0	0	0	28,224
		No corrosion	Paint distress	Rust formation	Section loss	Section failure						

Remarks: Stl Bms-Span 2 minor rust @Bott flanges & Lat brng.

Non-Lead Painted Steel Closed Web/Box Girder and O

173	4	100	60	0	0	0	0	0	0	0	0	60
		No corrosion	Paint distress	Rust formation	Section loss	Section failure						

Remarks:

Reinforced Conc Column or Pile Extension

205	4	100	1,068	0	0	0	0	0	0	0	0	1,068
		No deterioration	Minor cracks/spalls	Delams/spalls	Analysis warranted							

Remarks:

Reinforced Conc Pier Wall

210	4	100	942	0	0	0	0	0	0	0	0	942
		No deterioration	Minor cracks/spalls	Delams/spalls	Analysis warranted							

Remarks:

Reinforced Conc Abutment

215	4	100	1,912	0	0	0	0	0	0	0	0	1,912
		No deterioration	Minor cracks/spalls	Delams/spalls	Analysis warranted							

Remarks:

Reinforced Conc Pier or Abutment Cap

234	4	98	249	2	4	0	0	0	0	0	0	253
		No deterioration	Minor cracks/spalls	Delams/spalls	Analysis warranted							

Remarks:

Preformed Joint Seal

302	4	90	56	10	6	0	0	0	0	0	0	62
		No deterioration	Minor deterioration	Major deterioration								

Remarks:

Neoprene Expansion Joint

307	4	89	166	11	20	0	0	0	0	0	0	186
		The element shows mi	The seal maybe punct	The seal maybe heavi	Major deterioration							

Remarks:

Movable Discontinuous Brg.

311	4	100	30	0	0	0	0	0	0	0	0	30
		No deterioration	Minor deterioration	Advanced corrosion								

Remarks:

Fixed Bearing

313	4	100	30	0	0	0	0	0	0	0	0	30
		No deterioration	Minor deterioration	Advanced corrosion								

Remarks:

Approach Pavement

323	4	100	2	0	0	0	0	0	0	0	0	2
		No deterioration	Cracks/spalls	Major cracks/spalls			Broken/Unstable					

Remarks:

Concrete Bridge Railing

331	4	99	402	1	4	0	0	0	0	0	0	406
		No deterioration	Minor cracks/spalls	Analysis warranted								

Remarks:

Element Description

Elem	Env	% 1	Qty 1	% 2	Qty 2	% 3	Qty 3	% 4	Qty 4	% 5	Qty 5	Tot Qty
Concrete Deck Protected w/ Rigid Overlay												
22	4	11	1,326	45	5,422	44	5,300	0	0	0	0	12,048
		No deficiencies.	Repaired areas exist	Map cracked areas.	Spalls/delaminations	Full depth failures.						
Remarks: WS)HL map crking; Soffit) Isol spalls, HPs, HL-Nar leach crks												
Lead Painted Steel Open Girder												
107	4	100	28,224	0	0	0	0	0	0	0	0	28,224
		No corrosion	Paint distress	Rust formation	Section loss	Section failure						
Remarks:												
Non-Lead Painted Steel Closed Web/Box Girder and O												
173	4	100	60	0	0	0	0	0	0	0	0	60
		No corrosion	Paint distress	Rust formation	Section loss	Section failure						
Remarks:												
Reinforced Conc Column or Pile Extension												
205	4	100	1,068	0	0	0	0	0	0	0	0	1,068
		No deterioration	Minor cracks/spalls	Delams/spalls	Analysis warranted							
Remarks:												
Reinforced Conc Pier Wall												
210	4	100	942	0	0	0	0	0	0	0	0	942
		No deterioration	Minor cracks/spalls	Delams/spalls	Analysis warranted							
Remarks:												
Reinforced Conc Abutment												
215	4	100	1,912	0	0	0	0	0	0	0	0	1,912
		No deterioration	Minor cracks/spalls	Delams/spalls	Analysis warranted							
Remarks: HL vert crks in backwall												
Reinforced Conc Pier or Abutment Cap												
234	4	98	249	2	4	0	0	0	0	0	0	253
		No deterioration	Minor cracks/spalls	Delams/spalls	Analysis warranted							
Remarks: Abut) Crking @ steps; Pier) Crking in cantilever seat												
Preformed Joint Seal												
302	4	90	56	10	6	0	0	0	0	0	0	62
		No deterioration	Minor deterioration	Major deterioration								
Remarks: Leakage @ E Abut												
Neoprene Expansion Joint												
307	4	97	180	3	6	0	0	0	0	0	0	186
		The element shows mi	The seal maybe punct	The seal maybe heavi	Major deterioration							
Remarks: Leakage @ P2												
Movable Discontinuous Brg.												
311	4	100	30	0	0	0	0	0	0	0	0	30
		No deterioration	Minor deterioration	Advanced corrosion								
Remarks:												
Fixed Bearing												
313	4	100	30	0	0	0	0	0	0	0	0	30
		No deterioration	Minor deterioration	Advanced corrosion								

Remarks:

Approach Pavement

323	4	100	2	0	0	0	0	0	0	0	0	2
			No deterioration	Cracks/spalls	Major cracks/spalls	Broken/Unstable						

Remarks:

Concrete Bridge Railing

331	4	99	402	1	4	0	0	0	0	0	0	406
			No deterioration	Minor cracks/spalls	Analysis warranted							

Remarks:

Element Description												
Elem	Env	% 1	Qty 1	% 2	Qty 2	% 3	Qty 3	% 4	Qty 4	% 5	Qty 5	Tot Qty
Concrete Deck Protected w/ Rigid Overlay												
22	4	11	1,326	45	5,422	44	5,300	0	0	0	0	12,048
			No deficiencies.	Repaired areas exist	Map cracked areas.	Spalls/delaminations	Full depth failures.					
Remarks: <input type="text"/>												
Lead Painted Steel Open Girder												
107	4	100	28,224	0	0	0	0	0	0	0	0	28,224
			No corrosion	Paint distress	Rust formation	Section loss	Section failure					
Remarks: <input type="text"/>												
Non-Lead Painted Steel Closed Web/Box Girder and O												
173	4	100	60	0	0	0	0	0	0	0	0	60
			No corrosion	Paint distress	Rust formation	Section loss	Section failure					
Remarks: <input type="text"/>												
Reinforced Conc Column or Pile Extension												
205	4	100	1,068	0	0	0	0	0	0	0	0	1,068
			No deterioration	Minor cracks/spalls	Delams/spalls	Analysis warranted						
Remarks: <input type="text"/>												
Reinforced Conc Pier Wall												
210	4	100	942	0	0	0	0	0	0	0	0	942
			No deterioration	Minor cracks/spalls	Delams/spalls	Analysis warranted						
Remarks: <input type="text"/>												
Reinforced Conc Abutment												
215	4	100	1,912	0	0	0	0	0	0	0	0	1,912
			No deterioration	Minor cracks/spalls	Delams/spalls	Analysis warranted						
Remarks: <input type="text"/>												
Reinforced Conc Pier or Abutment Cap												
234	4	98	249	2	4	0	0	0	0	0	0	253
			No deterioration	Minor cracks/spalls	Delams/spalls	Analysis warranted						
Remarks: <input type="text"/>												
Preformed Joint Seal												
302	4	90	56	10	6	0	0	0	0	0	0	62
			No deterioration	Minor deterioration	Major deterioration							
Remarks: <input type="text"/>												

Neoprene Expansion Joint

307	4	97	180	3	6	0	0	0	0	0	0	186
-----	---	----	-----	---	---	---	---	---	---	---	---	-----

The element shows mi The seal maybe punct The seal maybe heavi Major deterioration

Remarks:

Movable Discontinuous Brg.

311	4	100	30	0	0	0	0	0	0	0	0	30
-----	---	-----	----	---	---	---	---	---	---	---	---	----

No deterioration Minor deterioration Advanced corrosion

Remarks:

Fixed Bearing

313	4	100	30	0	0	0	0	0	0	0	0	30
-----	---	-----	----	---	---	---	---	---	---	---	---	----

No deterioration Minor deterioration Advanced corrosion

Remarks:

Approach Pavement

323	4	100	2	0	0	0	0	0	0	0	0	2
-----	---	-----	---	---	---	---	---	---	---	---	---	---

No deterioration Cracks/spalls Major cracks/spalls Broken/Unstable

Remarks:

Concrete Bridge Railing

331	4	100	406	0	0	0	0	0	0	0	0	406
-----	---	-----	-----	---	---	---	---	---	---	---	---	-----

No deterioration Minor cracks/spalls Analysis warranted

Remarks:

Element Description

Elem	Env	% 1	Qty 1	% 2	Qty 2	% 3	Qty 3	% 4	Qty 4	% 5	Qty 5	Tot Qty
------	-----	-----	-------	-----	-------	-----	-------	-----	-------	-----	-------	---------

Concrete Deck Protected w/ Rigid Overlay

22	4	11	1,326	45	5,422	44	5,300	0	0	0	0	12,048
----	---	----	-------	----	-------	----	-------	---	---	---	---	--------

No deficiencies. Repaired areas exist Map cracked areas. Spalls/delaminations Full depth failures.

Remarks:

Lead Painted Steel Open Girder

107	4	100	28,224	0	0	0	0	0	0	0	0	28,224
-----	---	-----	--------	---	---	---	---	---	---	---	---	--------

No corrosion Paint distress Rust formation Section loss Section failure

Remarks:

Non-Lead Painted Steel Closed Web/Box Girder and O

173	4	100	60	0	0	0	0	0	0	0	0	60
-----	---	-----	----	---	---	---	---	---	---	---	---	----

No corrosion Paint distress Rust formation Section loss Section failure

Remarks:

Reinforced Conc Column or Pile Extension

205	4	100	1,068	0	0	0	0	0	0	0	0	1,068
-----	---	-----	-------	---	---	---	---	---	---	---	---	-------

No deterioration Minor cracks/spalls Delams/spalls Analysis warranted

Remarks:

Reinforced Conc Pier Wall

210	4	100	942	0	0	0	0	0	0	0	0	942
-----	---	-----	-----	---	---	---	---	---	---	---	---	-----

No deterioration Minor cracks/spalls Delams/spalls Analysis warranted

Remarks:

Reinforced Conc Abutment

215	4	100	1,912	0	0	0	0	0	0	0	0	1,912
			No deterioration	Minor cracks/spalls	Delams/spalls	Analysis warranted						

Remarks:

Reinforced Conc Pier or Abutment Cap

234	4	98	249	2	4	0	0	0	0	0	0	253
			No deterioration	Minor cracks/spalls	Delams/spalls	Analysis warranted						

Remarks:

Preformed Joint Seal

302	4	90	56	10	6	0	0	0	0	0	0	62
			No deterioration	Minor deterioration	Major deterioration							

Remarks:

Neoprene Expansion Joint

307	4	97	180	3	6	0	0	0	0	0	0	186
			The element shows mi	The seal maybe punct	The seal maybe heavi	Major deterioration						

Remarks:

Movable Discontinuous Brg.

311	4	100	30	0	0	0	0	0	0	0	0	30
			No deterioration	Minor deterioration	Advanced corrosion							

Remarks:

Fixed Bearing

313	4	100	30	0	0	0	0	0	0	0	0	30
			No deterioration	Minor deterioration	Advanced corrosion							

Remarks:

Approach Pavement

323	4	100	2	0	0	0	0	0	0	0	0	2
			No deterioration	Cracks/spalls	Major cracks/spalls	Broken/Unstable						

Remarks:

Concrete Bridge Railing

331	4	100	406	0	0	0	0	0	0	0	0	406
			No deterioration	Minor cracks/spalls	Analysis warranted							

Remarks:

Element Description

Elem	Env	% 1	Qty 1	% 2	Qty 2	% 3	Qty 3	% 4	Qty 4	% 5	Qty 5	Tot Qty
Concrete Deck Protected w/ Rigid Overlay												
22	4	11	1,326	45	5,422	44	5,300	0	0	0	0	12,048
			No deficiencies.	Repaired areas exist	Map cracked areas.	Spalls/delaminations		Full depth failures.				

Remarks:

Lead Painted Steel Open Girder

107	4	100	28,224	0	0	0	0	0	0	0	0	28,224
			No corrosion	Paint distress	Rust formation	Section loss	Section failure					

Remarks:

Non-Lead Painted Steel Closed Web/Box Girder and O

173	4	100	60	0	0	0	0	0	0	0	0	60
		No corrosion	Paint distress	Rust formation	Section loss	Section failure						

Remarks:

Reinforced Conc Column or Pile Extension

205	4	100	1,068	0	0	0	0	0	0	0	0	1,068
		No deterioration	Minor cracks/spalls	Delams/spalls	Analysis warranted							

Remarks:

Reinforced Conc Pier Wall

210	4	100	942	0	0	0	0	0	0	0	0	942
		No deterioration	Minor cracks/spalls	Delams/spalls	Analysis warranted							

Remarks:

Reinforced Conc Abutment

215	4	100	1,912	0	0	0	0	0	0	0	0	1,912
		No deterioration	Minor cracks/spalls	Delams/spalls	Analysis warranted							

Remarks:

Reinforced Conc Pier or Abutment Cap

234	4	100	253	0	0	0	0	0	0	0	0	253
		No deterioration	Minor cracks/spalls	Delams/spalls	Analysis warranted							

Remarks:

Preformed Joint Seal

302	4	100	62	0	0	0	0	0	0	0	0	62
		No deterioration	Minor deterioration	Major deterioration								

Remarks:

Neoprene Expansion Joint

307	4	100	186	0	0	0	0	0	0	0	0	186
		The element shows mi	The seal maybe punct	The seal maybe heavi	Major deterioration							

Remarks:

Movable Discontinuous Brg.

311	4	100	30	0	0	0	0	0	0	0	0	30
		No deterioration	Minor deterioration	Advanced corrosion								

Remarks:

Fixed Bearing

313	4	100	30	0	0	0	0	0	0	0	0	30
		No deterioration	Minor deterioration	Advanced corrosion								

Remarks:

Approach Pavement

323	4	100	2	0	0	0	0	0	0	0	0	2
		No deterioration	Cracks/spalls	Major cracks/spalls		Broken/Unstable						

Remarks:

Concrete Bridge Railing

331	4	100	406	0	0	0	0	0	0	0	0	406
		No deterioration	Minor cracks/spalls	Analysis warranted								

Remarks:

Element Description

Elem	Env	% 1	Qty 1	% 2	Qty 2	% 3	Qty 3	% 4	Qty 4	% 5	Qty 5	Tot Qty
Concrete Deck Protected w/ AC Overlay												
14	4	65	7,789	0	0	35	4,194	0	0	0	0	11,983
		No deficiencies.	Repaired areas.	Map cracked areas.		Spalls/delam exist.		Full depth failures.				
Remarks:												
Lead Painted Steel Open Girder												
107	4	94	26,531	6	1,693	0	0	0	0	0	0	28,224
		No corrosion	Paint distress	Rust formation		Section loss		Section failure				
Remarks:												
Lead Painted Steel Closed Web/Box Girder and Open												
172	4	92	46	8	4	0	0	0	0	0	0	50
		No corrosion	Paint distress	Rust formation		Section loss		Section failure				
Remarks:												
Reinforced Conc Column or Pile Extension												
205	4	84	897	9	96	7	75	0	0	0	0	1,068
		No deterioration	Minor cracks/spalls	Delams/spalls		Analysis warranted						
Remarks:												
Reinforced Conc Pier Wall												
210	4	100	942	0	0	0	0	0	0	0	0	942
		No deterioration	Minor cracks/spalls	Delams/spalls		Analysis warranted						
Remarks:												
Reinforced Conc Abutment												
215	4	97	1,855	2	38	1	19	0	0	0	0	1,912
		No deterioration	Minor cracks/spalls	Delams/spalls		Analysis warranted						
Remarks:												
Reinforced Conc Pier or Abutment Cap												
234	4	69	175	24	61	7	18	0	0	0	0	253
		No deterioration	Minor cracks/spalls	Delams/spalls		Analysis warranted						
Remarks:												
Neoprene Expansion Joint												
307	4	76	299	20	79	4	16	0	0	0	0	394
		The element shows mi	The seal maybe punct	The seal maybe heavi		Major deterioration						
Remarks:												
Movable Discontinuous Brg.												
311	4	100	30	0	0	0	0	0	0	0	0	30
		No deterioration	Minor deterioration	Advanced corrosion								
Remarks:												
Fixed Bearing												
313	4	100	30	0	0	0	0	0	0	0	0	30
		No deterioration	Minor deterioration	Advanced corrosion								
Remarks:												
Approach Pavement												
323	4	100	2	0	0	0	0	0	0	0	0	2
		No deterioration	Cracks/spalls	Major cracks/spalls		Broken/Unstable						

Remarks:

Concrete Bridge Railing

331	4	58	234	25	101	17	69	0	0	0	0	403
-----	---	----	-----	----	-----	----	----	---	---	---	---	-----

No deterioration

Minor cracks/spalls



Analysis warranted

Remarks:

Download Date: 04/18/2013

ATTACHMENT D

Bottom of Deck Condition Survey

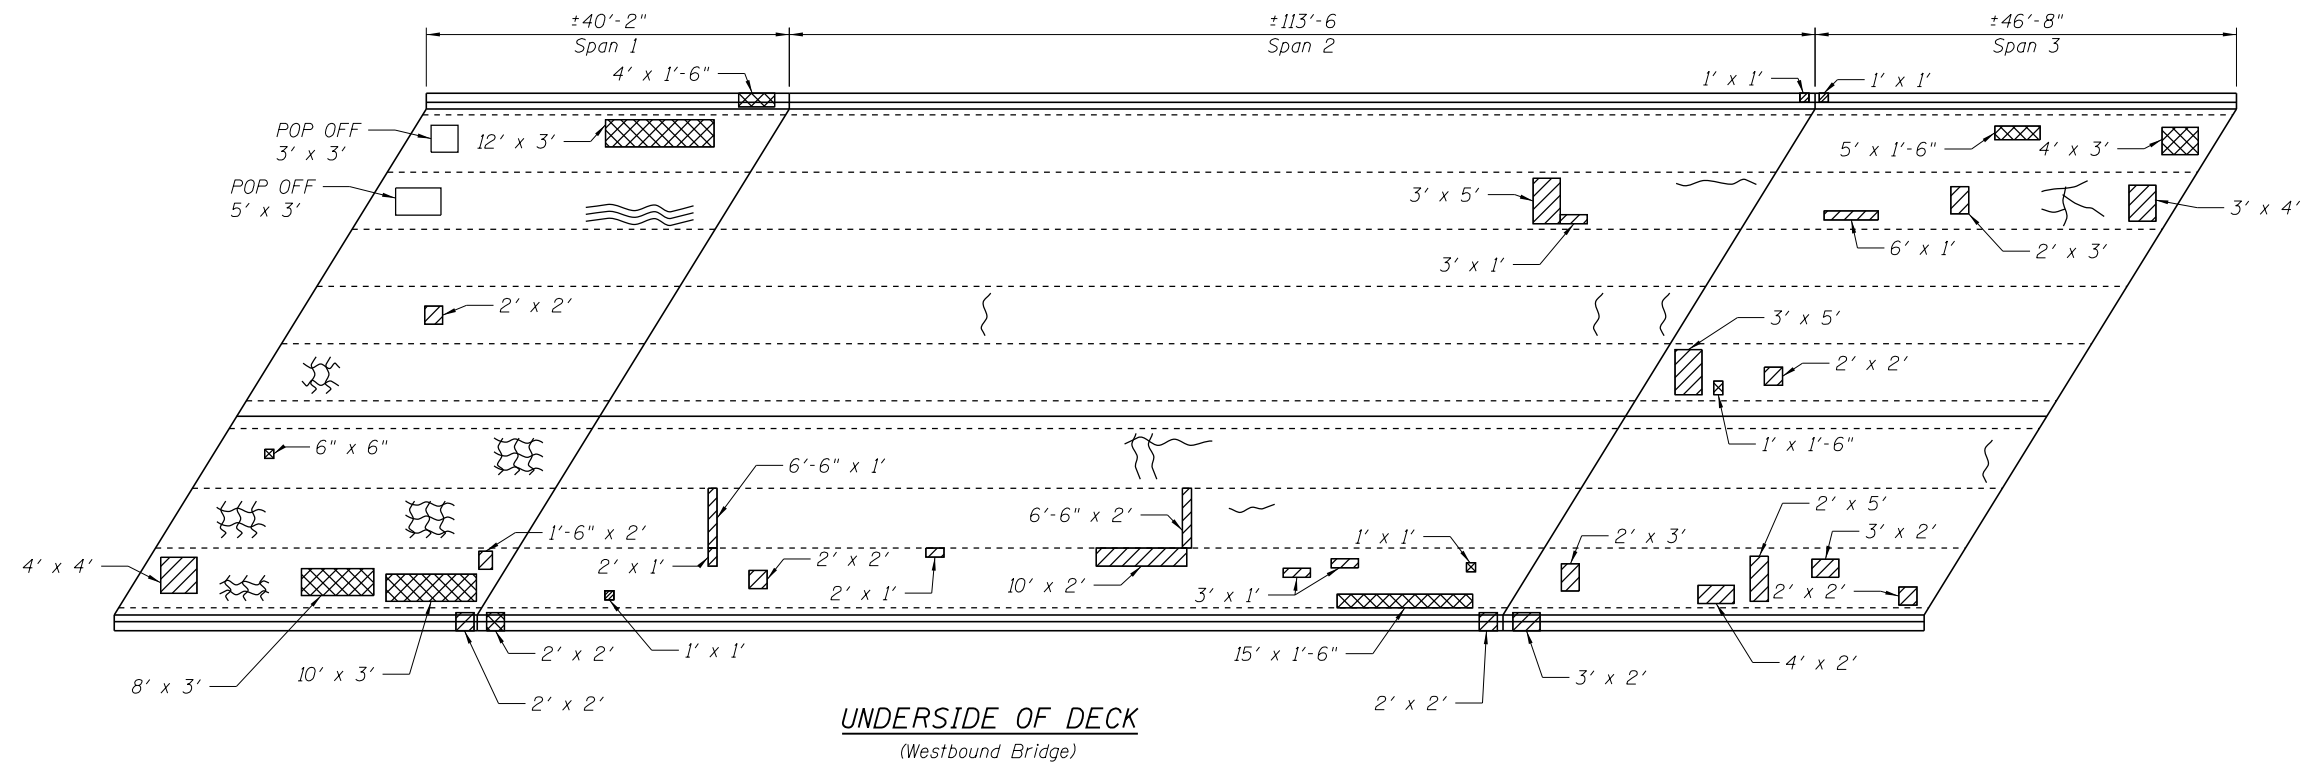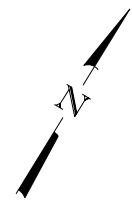

UNDERSIDE OF DECK
(Westbound Bridge)

NOTE:
① CENTER SPAN HAS SIGNIFICANT AMOUNT OF DISCOLORED CONCRETE & POP OFF IN EACH BAY

LEGEND

- CRACKED CONCRETE
- MAP CRACKING
- SPALLED CONCRETE
- DELAMINATED CONCRETE

FILE NAME = W:\1786\active\178600037_IDOT_1-95\structural\drawing\shd\dwg_Cicero.Avenue.Underside_of_Deck.dgn



USER NAME = jerojas	DESIGNED - JSR	REVISED -
	CHECKED - BPS	REVISED -
PLOT SCALE = N/A	DRAWN - JSR	REVISED -
PLOT DATE = 10/9/2013	CHECKED - BPS	REVISED -

STATE OF ILLINOIS
DEPARTMENT OF TRANSPORTATION

ATTACHMENT D - BOTTOM OF DECK CONDITION SURVEY
STRUCTURE NO. 016-0017

SHEET NO. 1 OF 1 SHEETS

F.A.I. RTE. 55	SECTION 1112-619-HB	COUNTY COOK	TOTAL SHEETS	SHEET NO.
		CONTRACT NO.		
FED. ROAD DIST. NO. 1		ILLINOIS FED. AID PROJECT		

ATTACHMENT E

**Condition Assessment of the Reinforced
Concrete Bridge Deck**

January 6, 2012

Ms. Diane M. O'Keefe
Deputy Director of Highways
District One Engineer
Illinois Department of Transportation
201 West Center Court
Schaumburg, Illinois 60196-1096
Attn: Ms. Sarah Wilson (Maintenance Bridge Engineer)

Re: Condition Assessment of Bridge Deck
I-55 Westbound over IL-50 (Cicero Avenue)
Structure No. 016-0017
District One
Work Order 10
PTB No. 153-18
WJE No. 2009.3645.10

Dear Ms. O'Keefe:

At your request, Wiss, Janney, Elstner Associates, Inc. (WJE) completed a condition assessment of the reinforced concrete bridge deck for Structure No. 016-0017. This work included a visual assessment of concrete deterioration from below the structure. Also included was a delamination survey performed on the top of the bridge deck, based on an infrared thermography (IR) survey. Reinforcing bar cover depth determination was also performed using ground penetrating radar (GPR). These inspection tasks began in July and were completed in September.

Structure Description

The I-55 Westbound Bridge over IL-50, Cicero Avenue carries three lanes of traffic and two shoulders. This three span structure is comprised of steel beam and concrete deck construction. Each of the 10 girder lines is connected using steel diaphragms or cross frames. All deck and substructure components are comprised of cast-in-place reinforced concrete construction. Reportedly the bridge structure was originally constructed in 1963 and the current overlay was installed in 2000.

The spans have approximate lengths of 42 ft-3 in, 113 ft-5 in, and 45 ft-8 in., from west-to-east, for a total structure length of 202 ft-8 in., back-to-back of abutments. The total deck width out-to-out is 59 ft-5 in. and the deck width to the inside faces of the parapet walls is 56 ft. The total resulting bridge deck area is approximately 11,055 sq. ft. A partial elevation view of the structure looking south is included as Figure 1.

Inspection Methods

The condition of the reinforced concrete bridge deck was assessed using several methods. These methods can be broken down into two major categories: Bottom of Deck Inspection Methods and Top of Deck Inspection Methods.

Bottom of Deck Inspection Methods

The condition of the bottom of the reinforced concrete deck was assessed from grade below the structure in September 2011. All accessible areas of the bottom of the deck were assessed visually. This inspection was completed from the ground beneath the bridge outside of active traffic lanes. Binoculars and/or zoom lenses were used to magnify the view of distant surfaces. Plan drawings of the structure including the structural framing were used to record field notes.

Top of Deck Inspection Methods

The condition of the top of the reinforced concrete deck was assessed using IR equipment to map areas of spalls, patches, and delaminations. This work was subcontracted to Infrasense, Inc. and was performed in July, 2011. Rolling lane closures were utilized during data collection periods to allow the IR data collection vehicle to assess the entire bridge deck surface while moving at approximately 3 mph. Impact Echo (IE) and sounding techniques were used to confirm the presence of delaminations at select locations on each bridge deck. All IR data was analyzed and summarized on bridge deck drawing sheets that show the located defects to scale.

GPR equipment was used to identify the cover depth of the top mat of reinforcing steel from the top surface of the deck. The GPR equipment was mounted to an inspection vehicle and scans were completed at normal operating speeds.

Assessment Results

The reinforced concrete bridge deck was found to be in satisfactory condition overall. Results for each assessment category are included below.

Bottom of Deck

Visual inspection from grade below the bridge was used to assess the bottom of the bridge deck. All areas of spalls or delaminations that could be identified visually were documented. In addition, all areas of previously repaired concrete were noted. Table 1 includes a summary of the visual inspection, including total deck soffit area, the area of spalled concrete, the area of delaminated concrete and the area of previous repairs. Figures 2 and 3 show the typical condition of the deck soffit. The results of the bottom of deck survey are shown on Sheet S-3 of Appendix A.

Table 1. Bottom of Deck Deterioration Summary

Soffit Area (sq. ft)	Spalled Area (sq. ft)	Total Area (%)	Delaminated Area (sq. ft)	Total Area (%)	Previously Repaired Area (sq.ft)
11,055	70	0.6	285	2.6	1705

Top of Deck

The top of the bridge deck was assessed using both IR and GPR equipment. The IR survey equipment was able to identify delaminations and spalls present in the bridge deck. Figure 4 is an overall view of the top deck surface looking southwest.

Table 2 includes a summary of the total bridge deck area, the total bridge deck area spalled, the total bridge deck area delaminated, the total bridge deck area that should be programmed for repair work and the rebar cover from the top surface of the deck. Sheet S-1 of Appendix A is a scaled bridge deck plan drawing showing the locations of the delaminated or spalled areas. Sheet S-2 of Appendix A is a scaled bridge deck plan drawing showing an image of the IR scan of the bridge. Sheet S-4 of Appendix A is a scaled bridge deck plan drawing showing the location of suggested partial and full depth concrete repairs using conventional patching techniques. Note that repair area boundaries were selected by expanding the boundaries of each delaminated or spalled area by 6 inches to account for saw cutting outside of the delamination and further deterioration prior to the actual start of any repair work. In addition, repair areas were joined when adjacent repairs were spaced at approximately 2 ft. or less. Full depth repair boundaries were determined based on locations where top and bottom surface defects overlapped. No bottom surface repairs were identified based on recommendations from IDOT.

Table 2. Top of Deck Deterioration Summary

Bridge Deck Area (sq. ft)	Spalled Area (sq. ft)	Total Area (%)	Delaminated Area (sq. ft)	Total Area (%)	Repair Area (sq. ft)	Total Area (%)	Rebar Cover (in.)
11,055	0	0	430	3.9	983	8.9	3.9

Recommendations and Conclusions

WJE performed a condition assessment of the reinforced concrete bridge deck of the I-55 Westbound Bridge over IL-50, Cicero Avenue. This condition assessment included: a visual survey of the bottom of the deck and an IR survey of the top of the deck. This information was used to produce repair drawings indicating the size and location of anticipated repair areas.


The repair work should, at a minimum, include partial depth repairs at all locations indicated on Sheet S-4 in Appendix A. If this option is selected, a detailed delamination assessment should be completed by the contractor at the time of the repair work to ensure that all areas of deteriorated concrete are identified. In addition, all re-entrant corners of repair areas should be detailed to include a 4 inch chamfer to reduce the potential for concrete-shrinkage related cracking.

The bridge deck was found to currently be in satisfactory condition, but corrosion-related damage has become apparent and should be repaired.


We would be happy to answer any questions or provide additional information.

Sincerely,

WISS, JANNEY, ELSTNER ASSOCIATES, INC.

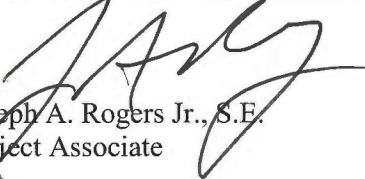

Joseph A. Rogers Jr., S.E.
Project Associate

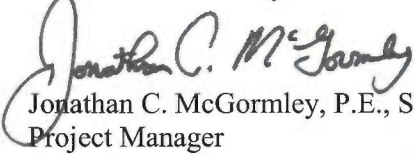

Jonathan C. McGormley, P.E., S.E.
Project Manager

Figures



Figure 1. Elevation view, looking south



Figure 2. Typical view, deck soffit, northeast corner.

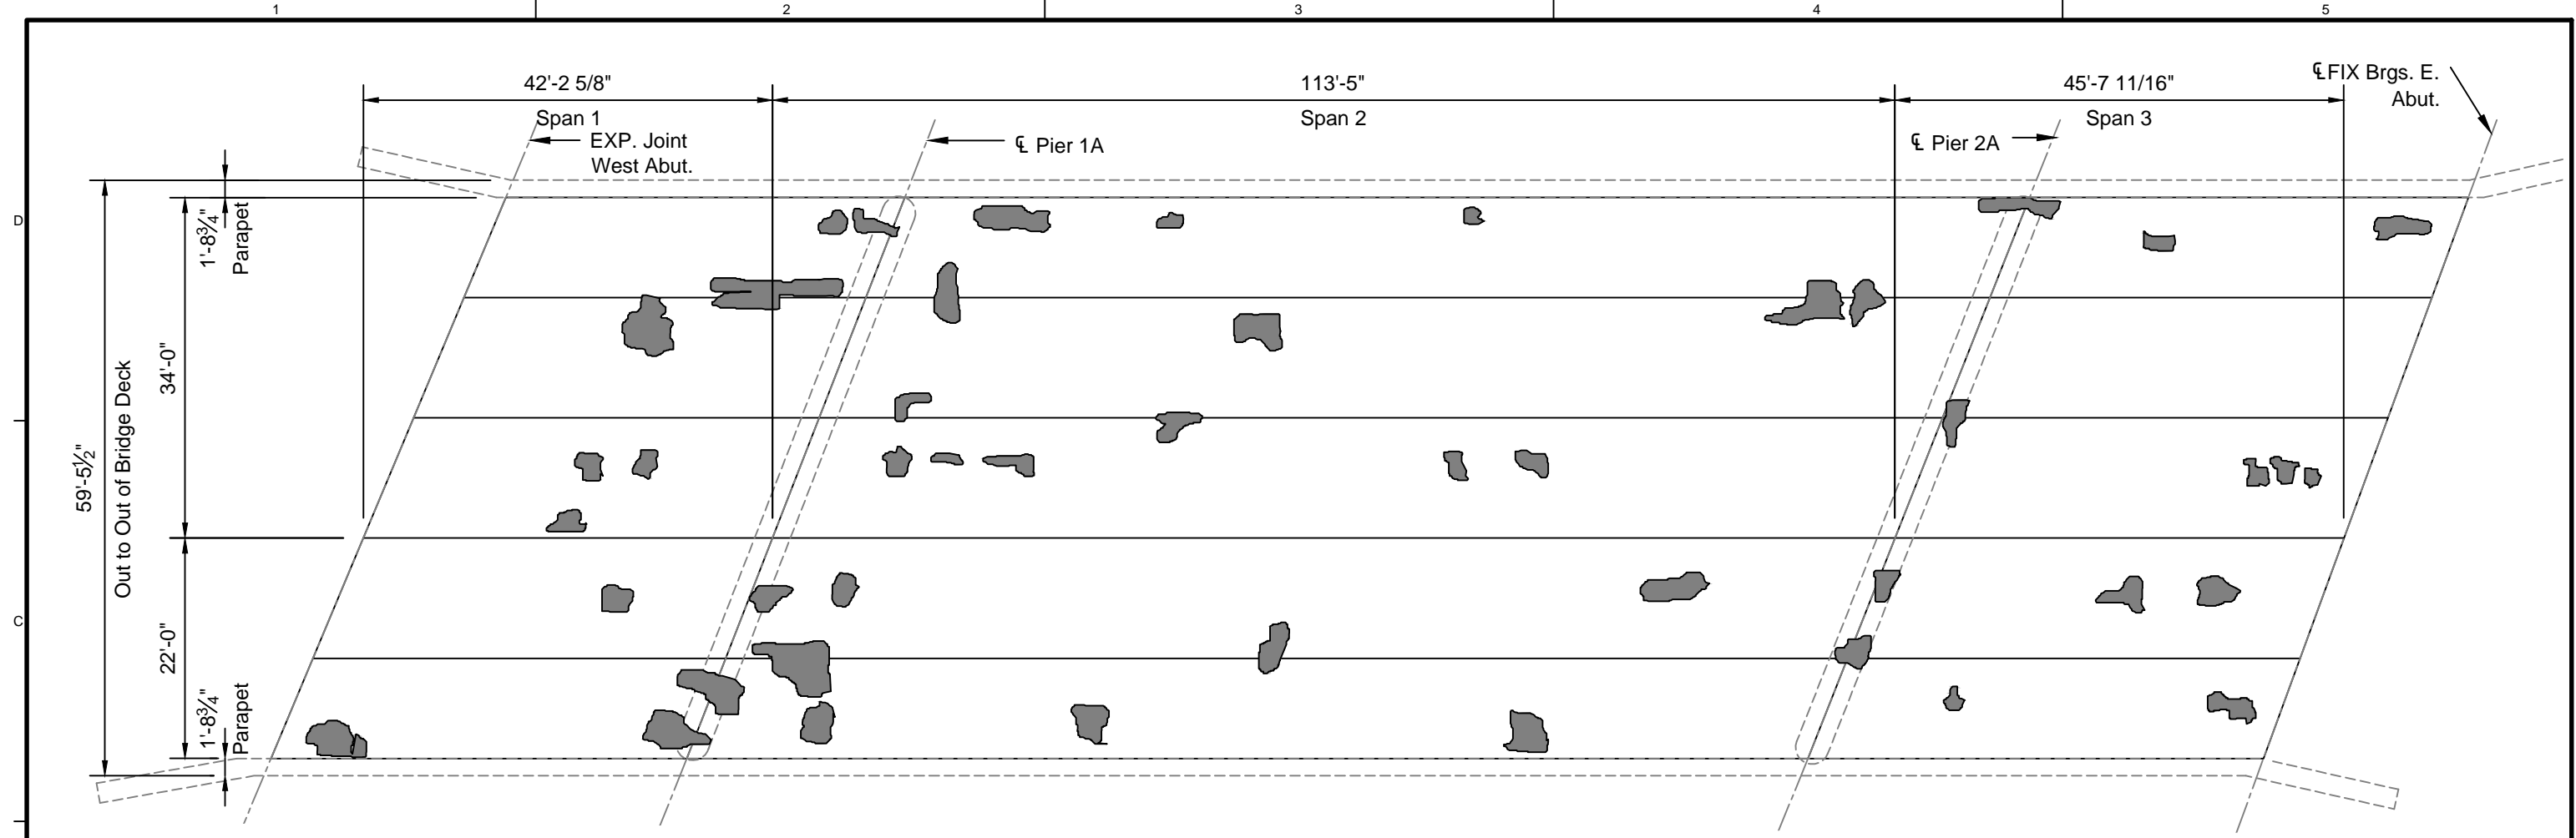


Figure 3. Typical view, deck soffit, looking west.

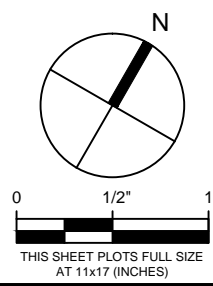


Figure 4. Typical view, deck top surface, looking southwest

Appendix A - Bridge Deck Condition Assessment Drawings



FIELD OBSERVATION SUMMARY		STRUCTURE # 016-0017		LEGEND	
ITEM	UNIT	QUANT.	%	DELAMINATION	SPALL
TOTAL AREA	Ac	11055	100		
DELAMINATION	Ac	430	3.9		
SPALL	Ac	0	0		
CRACKS	ft	-	-		



WJE ENGINEERS
ARCHITECTS
MATERIALS SCIENTISTS
Wiss, Janney, Elstner Associates, Inc.
330 Pfingsten Road
Northbrook, Illinois 60062
847.272.7400 tel | 847.291.4813 fax
www.wje.com


Client
Illinois Department of Transportation
District One
201 West Center Court
Schaumburg, Illinois 60196

Project
Bridge 016-0017
WESTBOUND I-55 OVER CICERO AVENUE
Sheet Title
IR Result - Top Surface

Proj. No. 2009.3645.10
Date November 19 2011
Drawn JJZ
Checked JAR
Scale 1/16" = 1'-0"


Sheet No.

S1

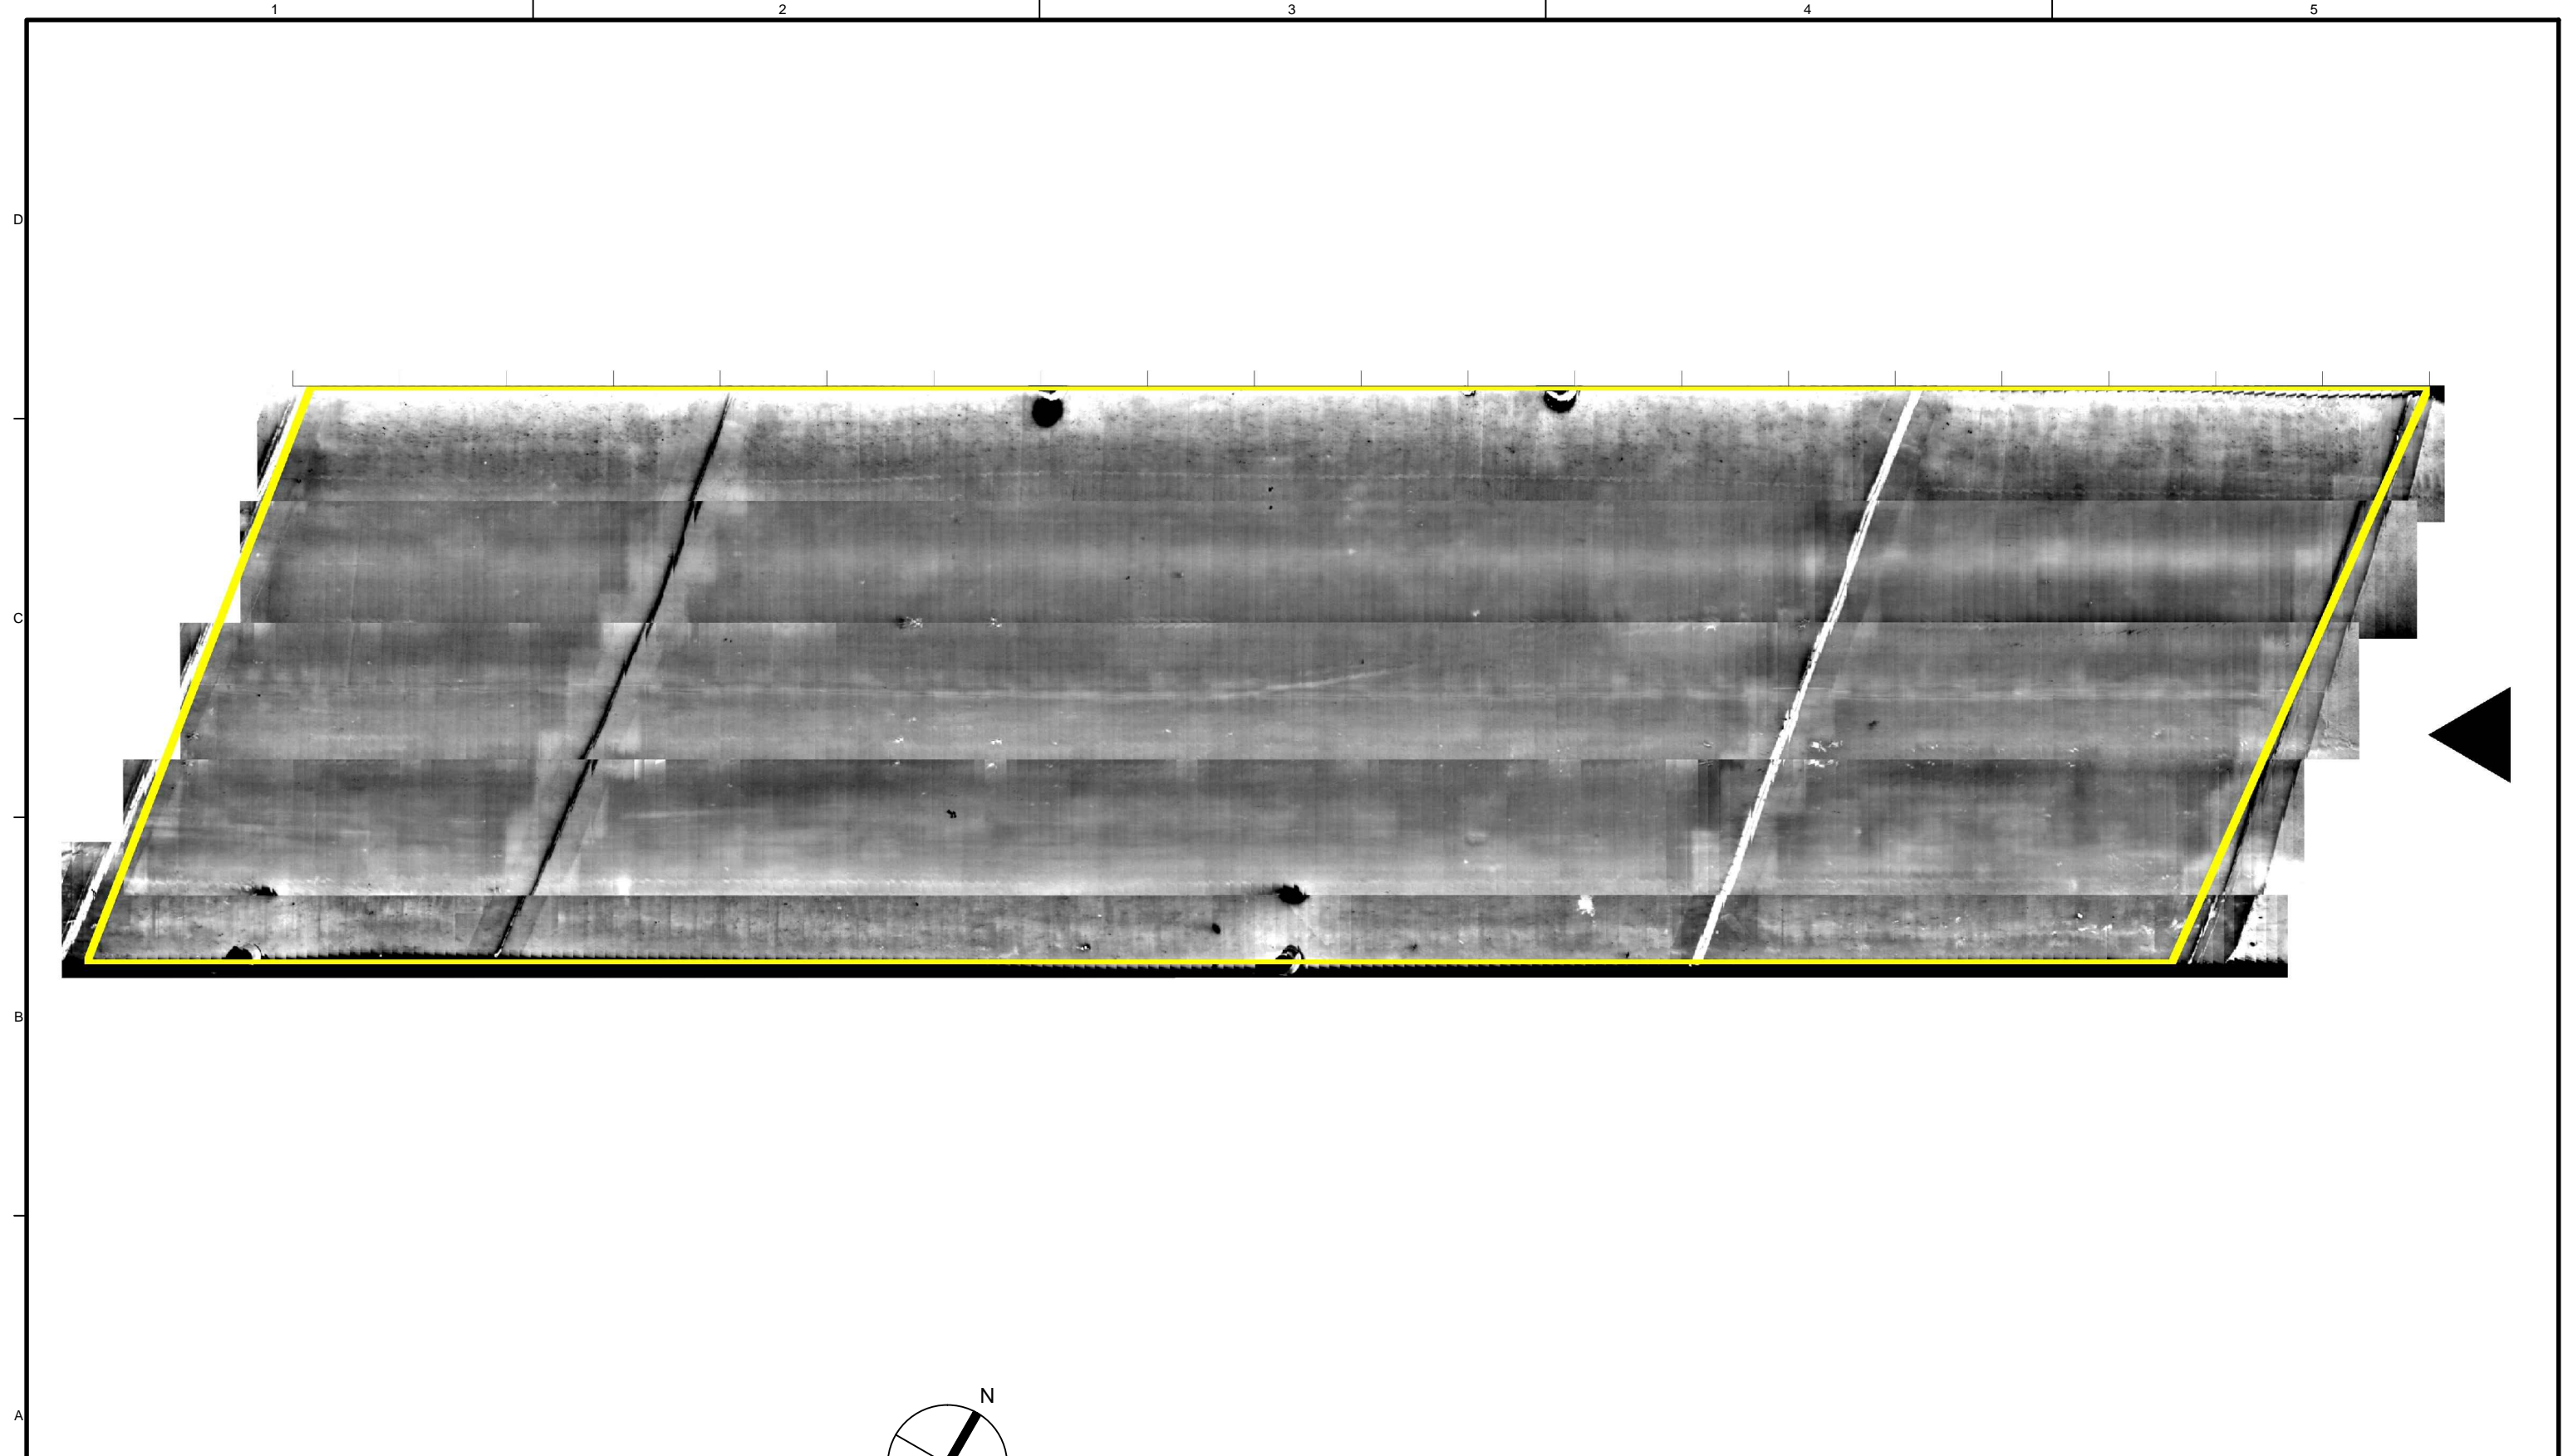

D
C
B
A

1 2 3 4 5

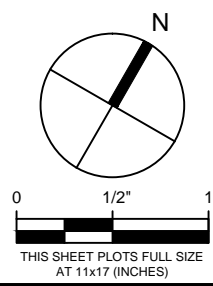


WJE ENGINEERS
ARCHITECTS
MATERIALS SCIENTISTS
Wiss, Janney, Elstner Associates, Inc.
330 Pfingsten Road
Northbrook, Illinois 60062
847.272.7400 tel | 847.291.4813 fax
www.wje.com

Client
 Illinois Department
of Transportation
District One
201 West Center Court
Schaumburg, Illinois 60196


Project
Bridge 016-0017
WESTBOUND I-55 OVER CICERO AVENUE
Sheet Title
IR Image - Top Surface

Proj. No.	2009.3645.10
Date	November 19 2011
Drawn	JJZ
Checked	JAR
Scale	1/16" = 1'

Sheet No. **S2**

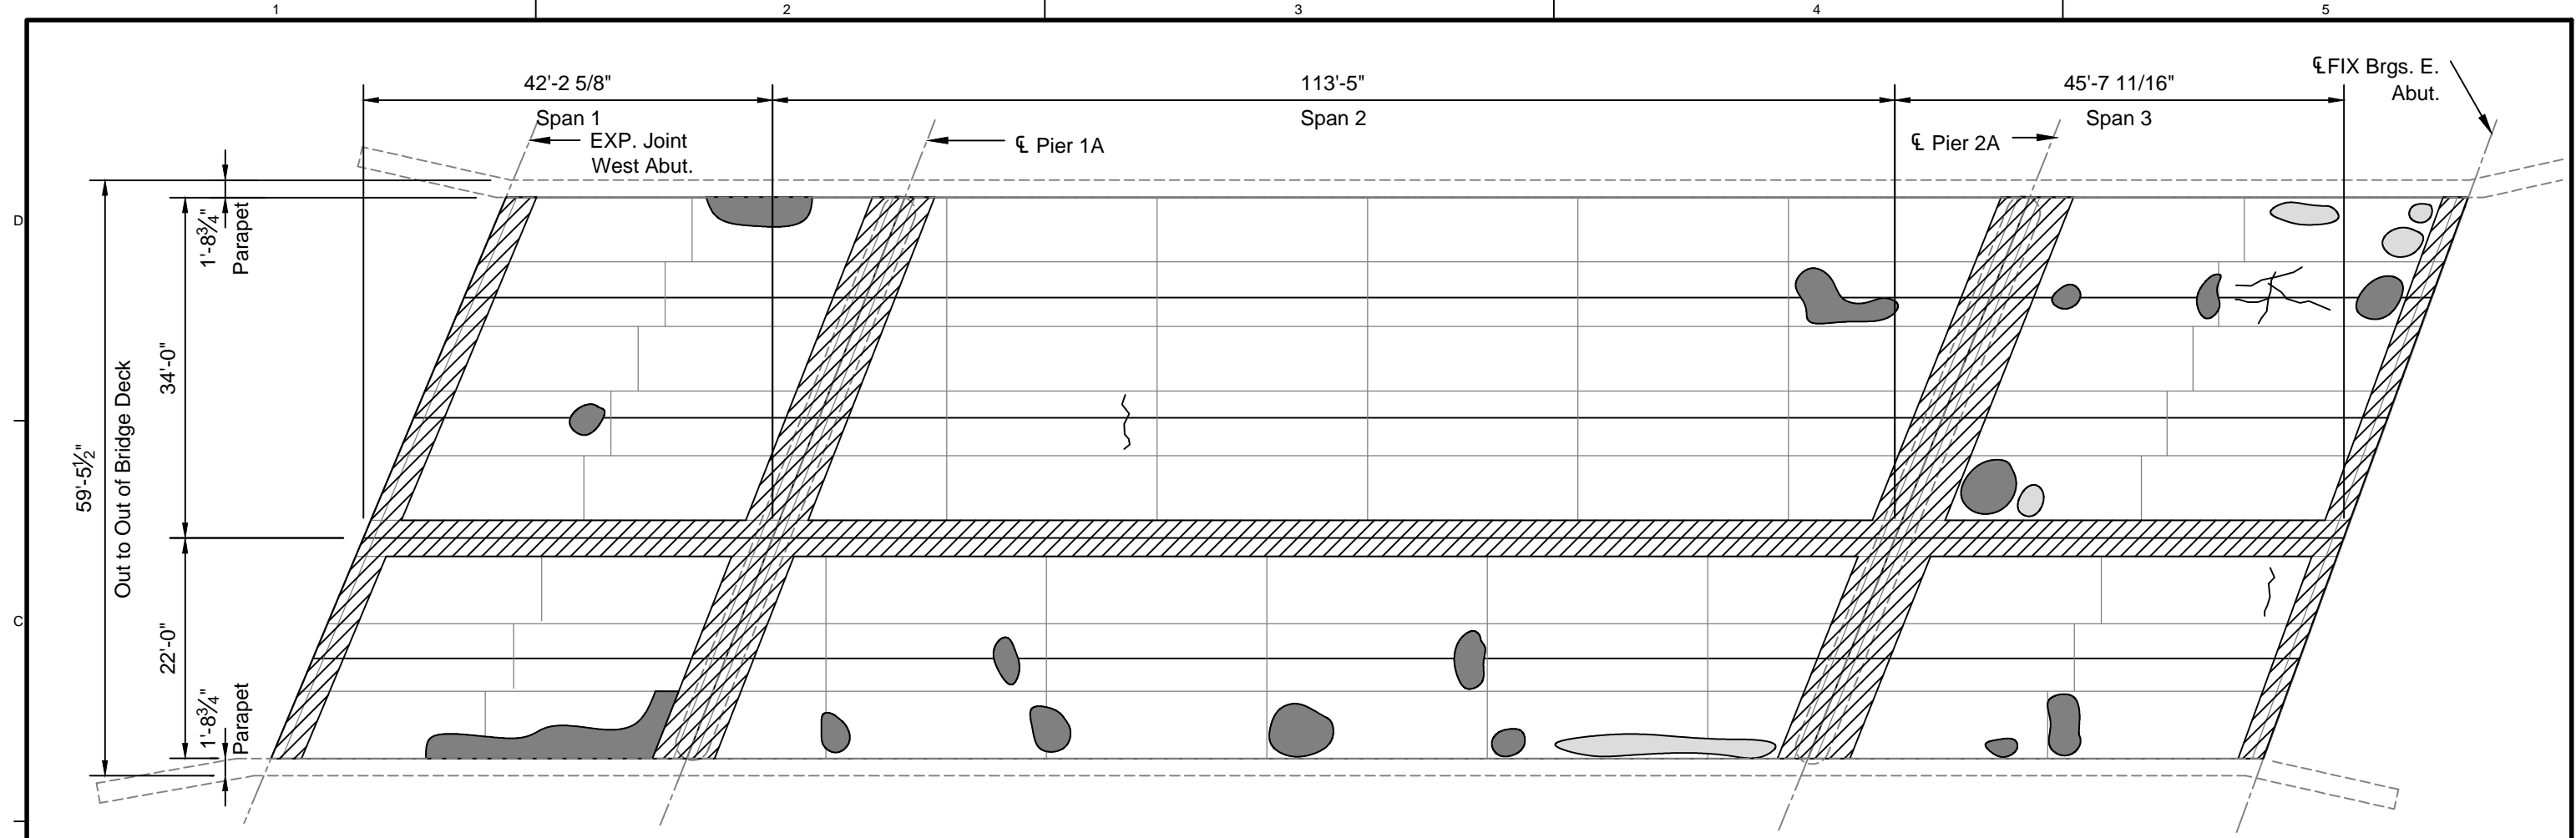

FIELD OBSERVATION SUMMARY		STRUCTURE # 016-0017		LEGEND	
ITEM	UNIT	QUANT.	%		
TOTAL AREA	Ac	11055	100	DELAMINATION	
DELAMINATION	Ac	285	2.6	SPALL	
SPALL	Ac	70	0.6	PREV. REPAIR	
PREVIOUS REPAIRS	Ac	1705	15.4	CRACK	
CRACKS	ft	-	-		

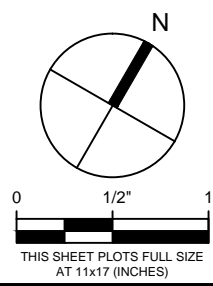

WJE ENGINEERS ARCHITECTS MATERIALS SCIENTISTS
 Wiss, Janney, Elstner Associates, Inc.
 330 Pfingsten Road
 Northbrook, Illinois 60062
 847.272.7400 tel | 847.291.4813 fax
 www.wje.com


Client

 District One
 201 West Center Court
 Schaumburg, Illinois 60196


Project
 Bridge 016-0017
 WESTBOUND I-55 OVER CICERO AVENUE
 Sheet Title
 Underside Deterioration

Proj. No. 2009.3645.10
 Date November 19 2011
 Drawn JJZ
 Checked JAR
 Scale 1/16" = 1'-0"

S3

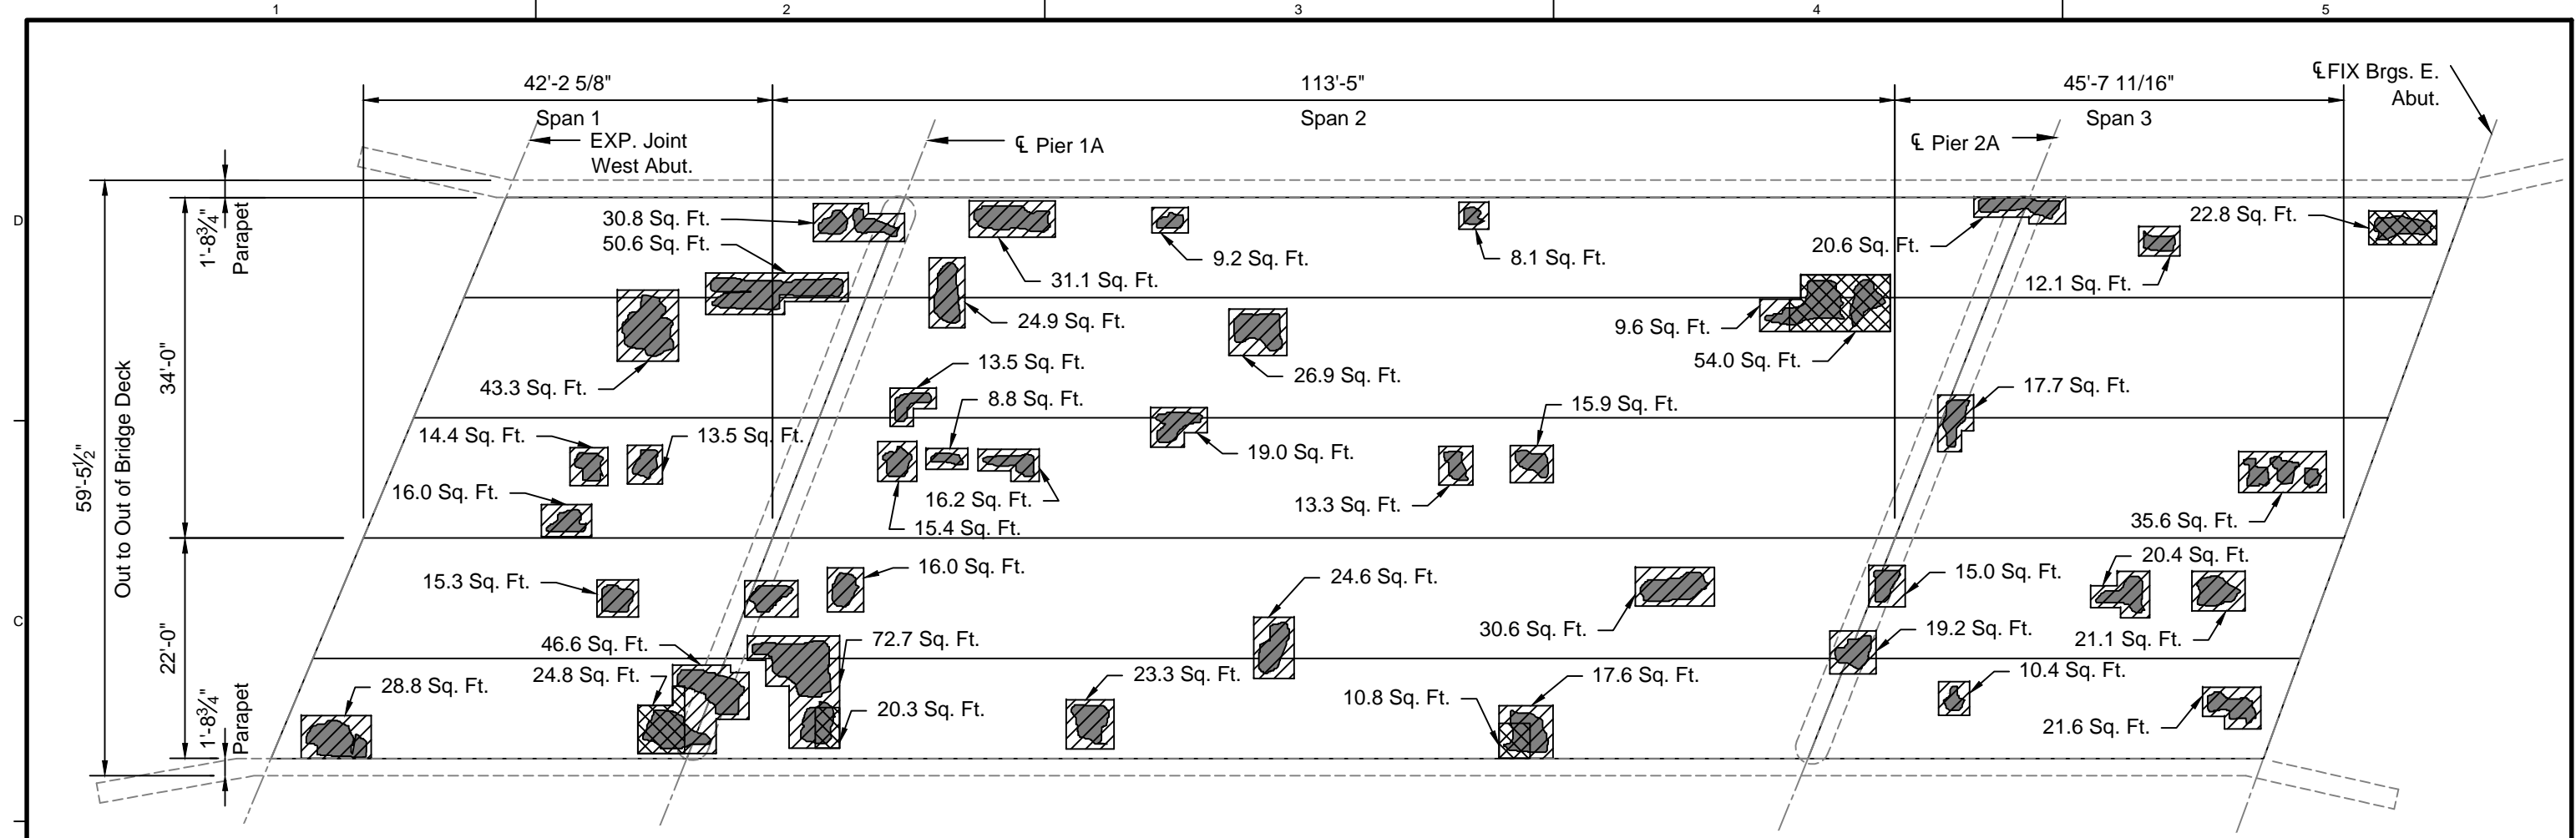

FIELD OBSERVATION SUMMARY		STRUCTURE # 016-0017		LEGEND	
ITEM	UNIT	QUANT.	%		
TOTAL AREA	Ac	11055	100	PARTIAL DEPTH REPAIR	
PARTIAL DEPTH REPAIR	Ac	861	7.8	FULL DEPTH REPAIR	
FULL DEPTH REPAIR	Ac	122	1.1	DELAMINATION	
DELAMINATION	Ac	430	3.9	SPALL	
SPALL	Ac	0	0	CRACK	
CRACKS	ft	-	-		

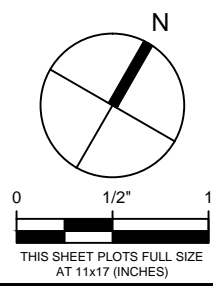

WJE ENGINEERS ARCHITECTS MATERIALS SCIENTISTS
 Wiss, Janney, Elstner Associates, Inc.
 330 Pfingsten Road
 Northbrook, Illinois 60062
 847.272.7400 tel | 847.291.4813 fax
 www.wje.com

Client
Illinois Department of Transportation
 District One
 201 West Center Court
 Schaumburg, Illinois 60196


Project
 Bridge 016-0017
 WESTBOUND I-55 OVER CICERO AVENUE
 Sheet Title
 Proposed Repairs

Proj. No. 2009.3645.10
 Date November 19 2011
 Drawn JJZ
 Checked JAR
 Scale 1/16" = 1'-0"


S4

ATTACHMENT F

Substructure Condition Surveys

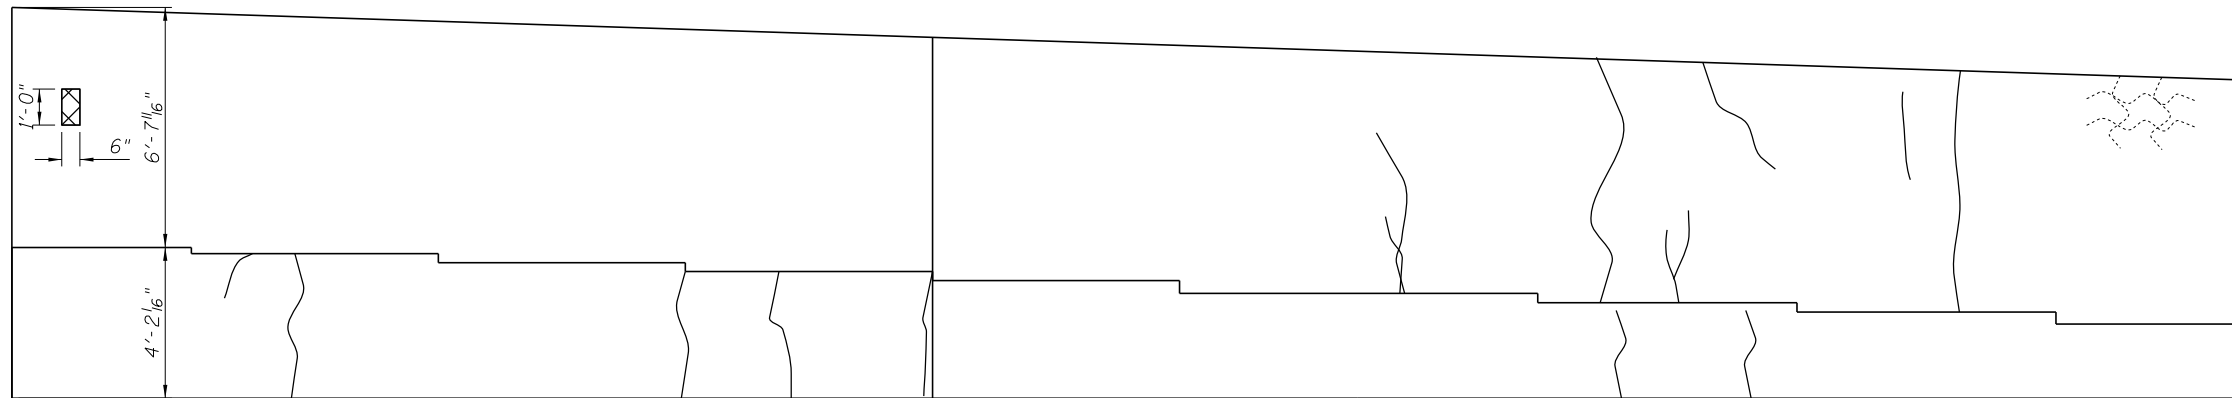




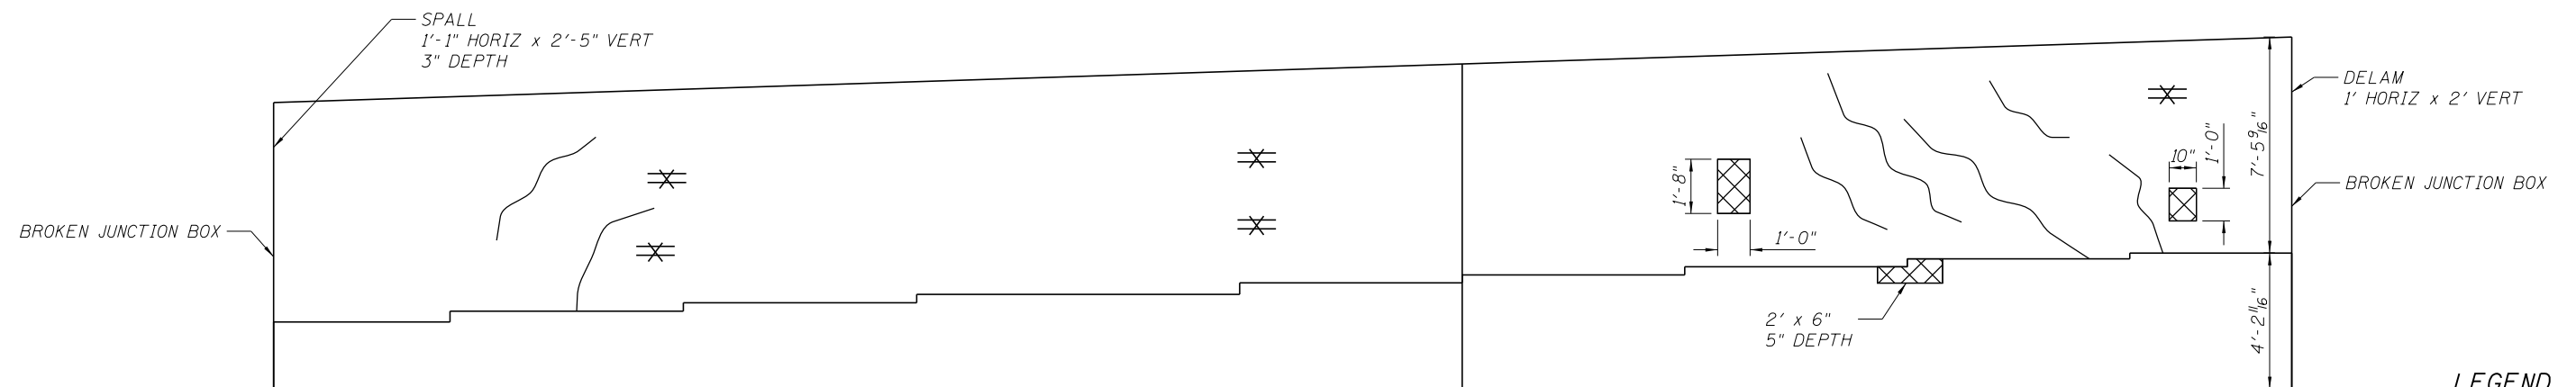

EAST ABUTMENT
LOOKING EAST

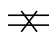

WEST ABUTMENT
LOOKING WEST

LEGEND

-  - BROKEN CONDUIT
-  - HAIRLINE CRACK UNLESS OTHERWISE NOTED
-  - LIGHT MAP CRACKING
-  - SPALLED CONCRETE
-  - DELAMINATED CONCRETE

FILE NAME = V:\1786\active\178600037_IDOT_155\structural\drawing\shd\deg_Cicero.Avenue.Abutment.Elevation.dgn




USER NAME = jerojas	DESIGNED - JSR	REVISED -
	CHECKED - BPS	REVISED -
PLOT SCALE = N/A	DRAWN - JSR	REVISED -
PLOT DATE = 10/7/2013	CHECKED - BPS	REVISED -

STATE OF ILLINOIS
DEPARTMENT OF TRANSPORTATION


ATTACHMENT F - SUBSTRUCTURE CONDITION SURVEY
STRUCTURE NO. 016-0017

SHEET NO. 1 OF 3 SHEETS

F.A.I. RTE.	SECTION	COUNTY	TOTAL SHEETS	SHEET NO.
55	1112-619-HB	COOK		
CONTRACT NO.				
FED. ROAD DIST. NO. 1 ILLINOIS FED. AID PROJECT				

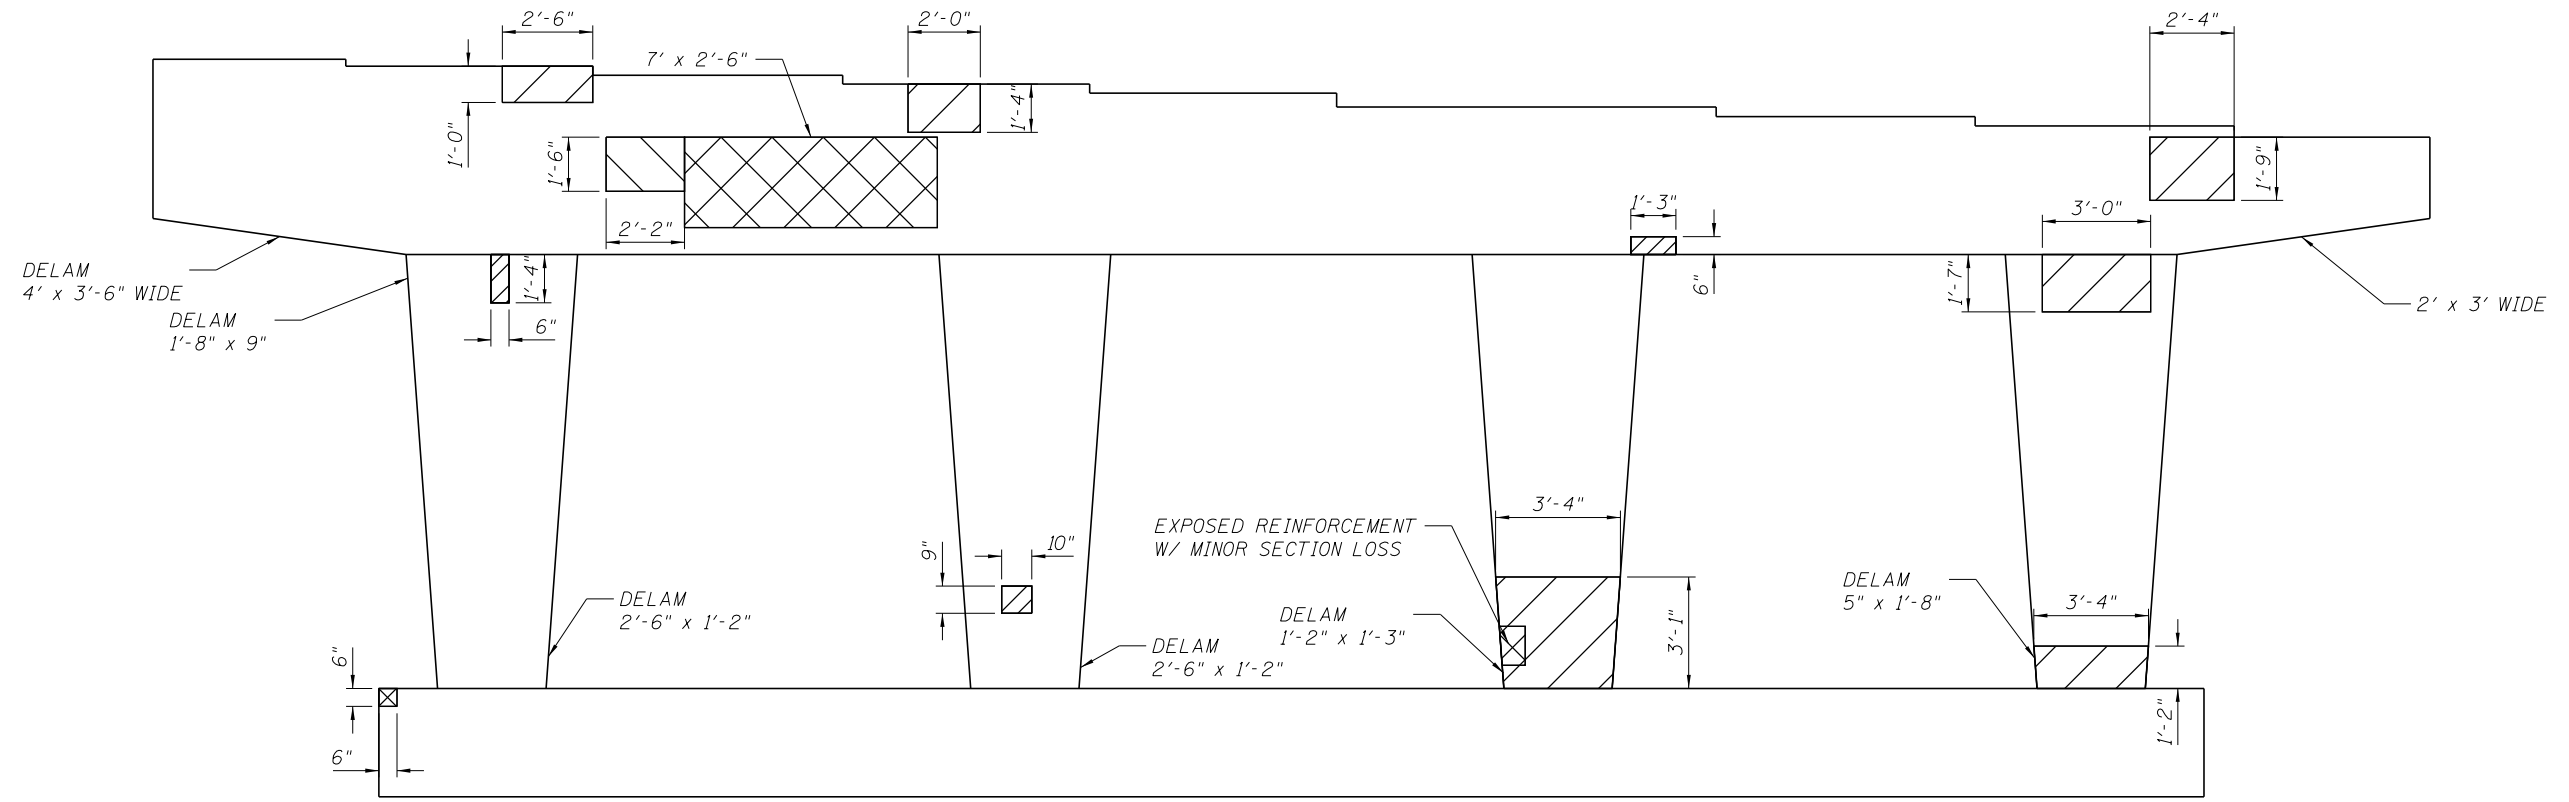

PIER 1
LOOKING EAST

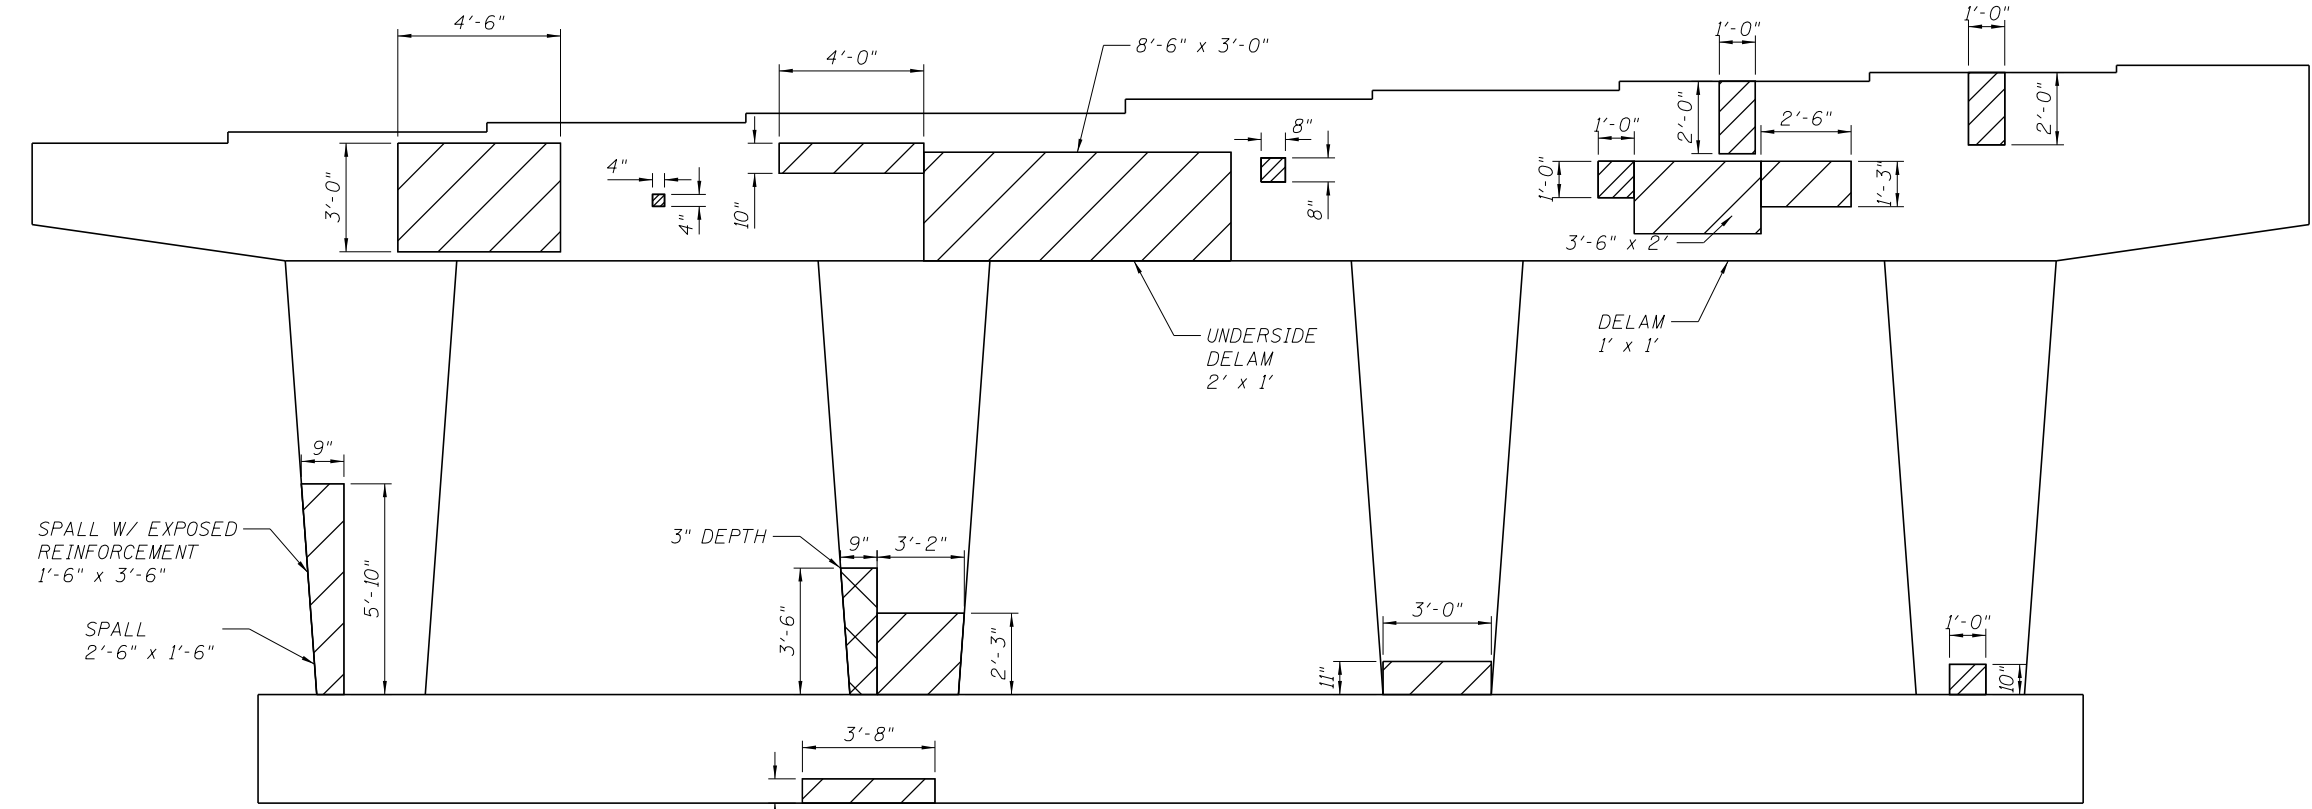

PIER 1
LOOKING WEST

LEGEND

- SPALLED CONCRETE
- DELAMINATED CONCRETE

FILE NAME = W:\1786\active\178600037_IDOT_1-95\structural\drawing\shd\dwg_Cicero.Avenue.Pier.Elevation.dgn




USER NAME = jerojas	DESIGNED - JSR	REVISED -
PLOT SCALE = N/A	CHECKED - BPS	REVISED -
PLOT DATE = 10/7/2013	DRAWN - JSR	REVISED -
	CHECKED - BPS	REVISED -

STATE OF ILLINOIS
DEPARTMENT OF TRANSPORTATION


ATTACHMENT F - SUPERSTRUCTURE CONDITION SURVEY
STRUCTURE NO. 016-0017

SHEET NO. 2 OF 3 SHEETS

F.A.I. RTE. 55	SECTION 1112-619-HB	COUNTY COOK	TOTAL SHEETS	SHEET NO.
CONTRACT NO.				
FED. ROAD DIST. NO. 1 ILLINOIS FED. AID PROJECT				

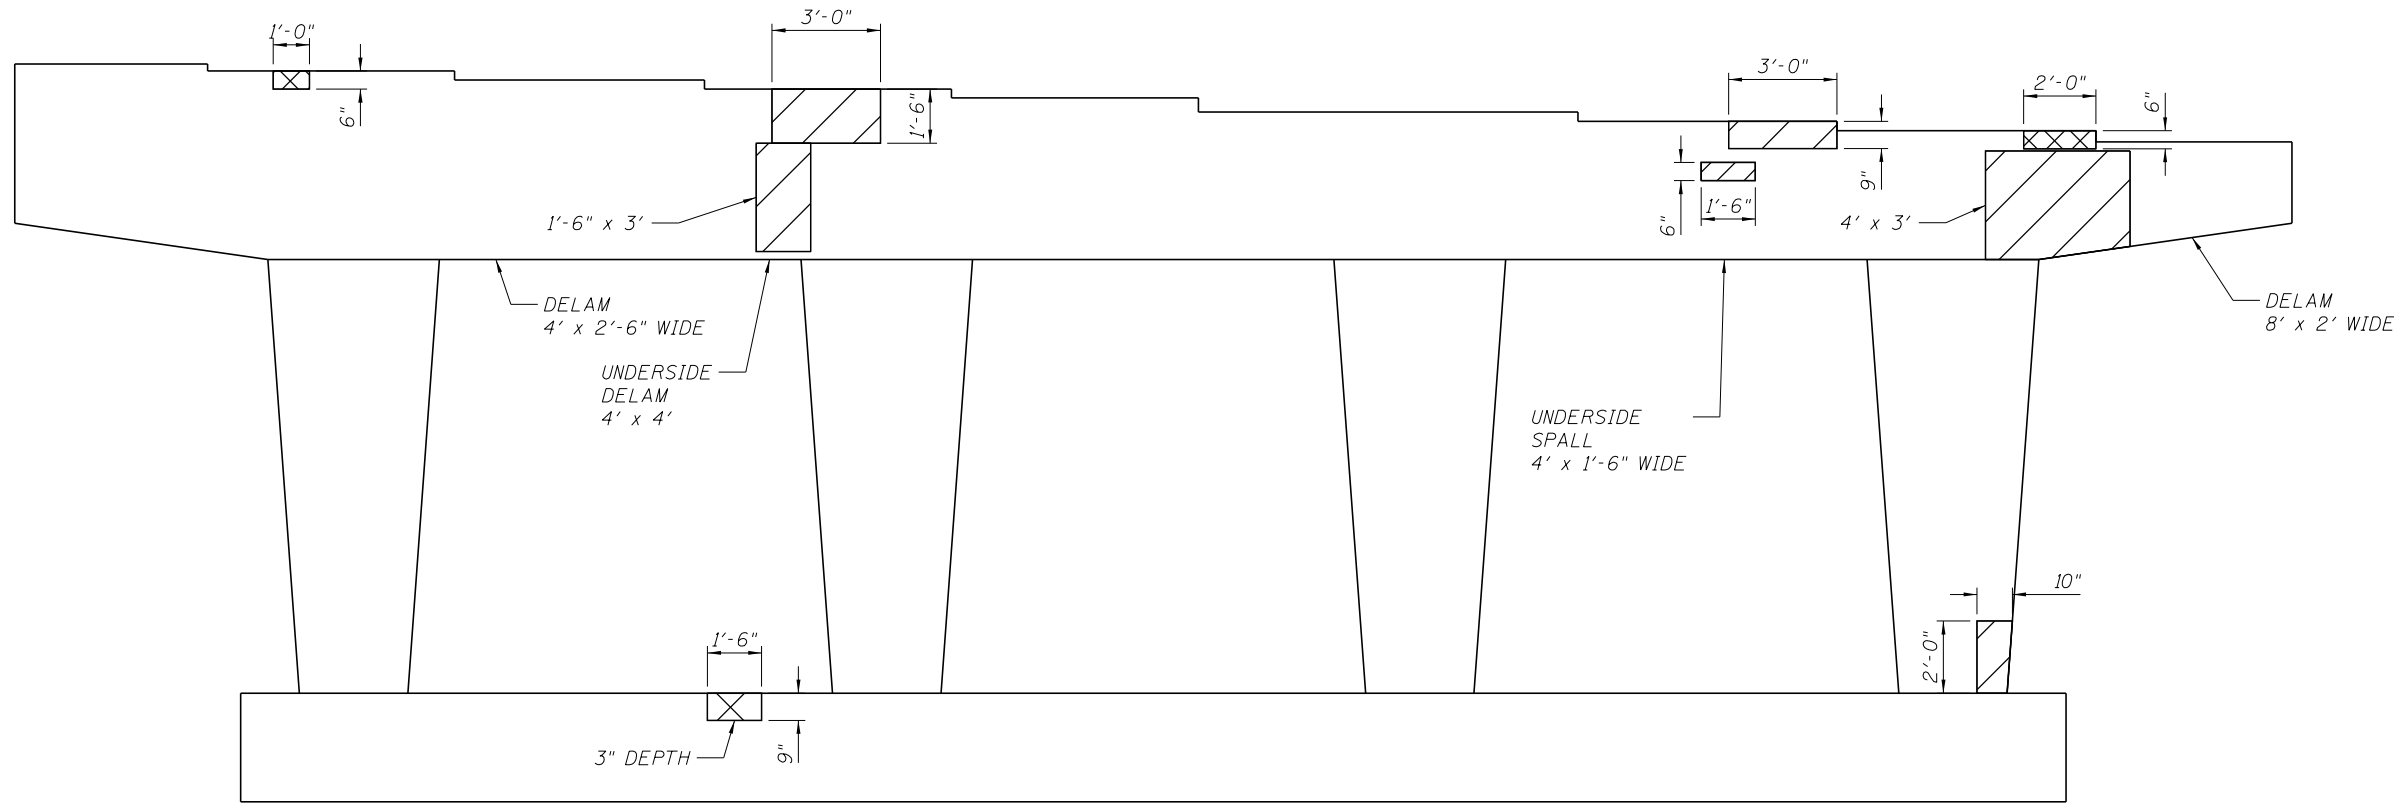

PIER 2
LOOKING EAST

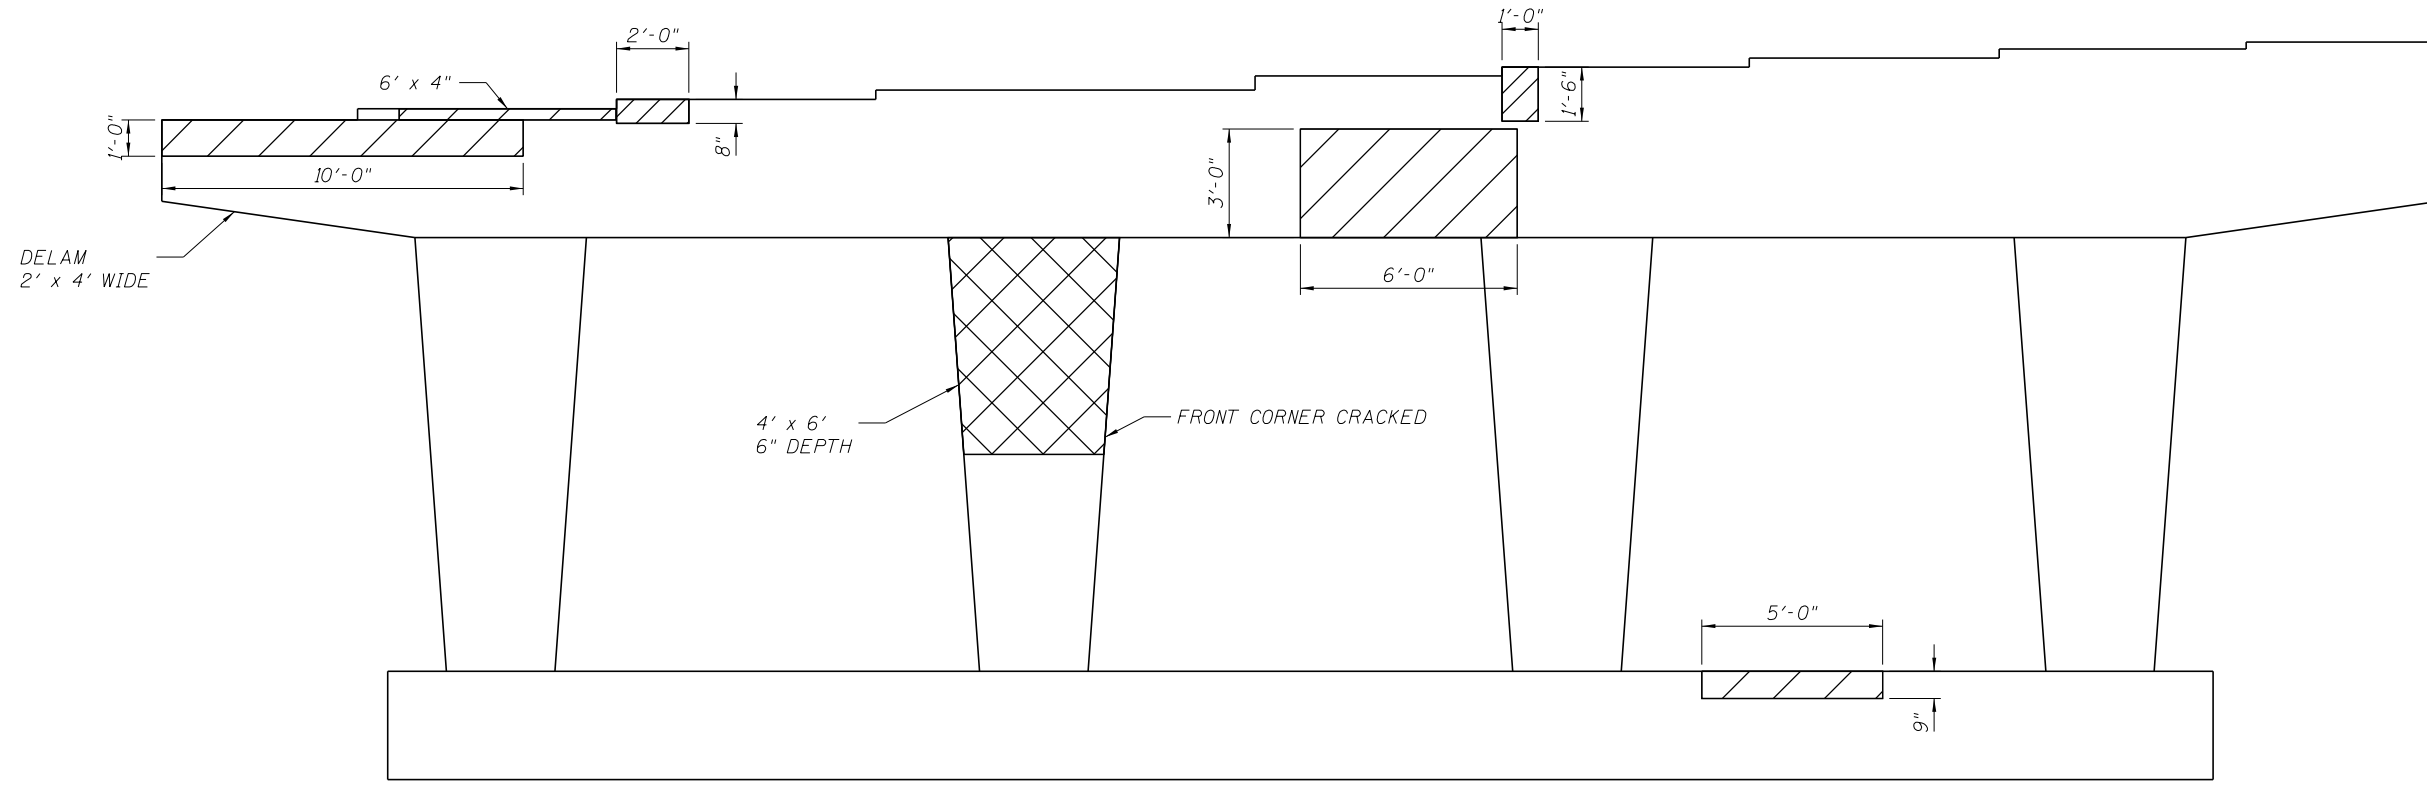

PIER 2
LOOKING WEST

LEGEND

- SPALLED CONCRETE
- DELAMINATED CONCRETE

FILE NAME = W:\1786\active\178600037_IDOT_1-95\structural\drawing\shd\dwg_Cicero.Avenue.Pier.Elevation.dgn



USER NAME = jerojas	DESIGNED - JSR	REVISED -
	CHECKED - BPS	REVISED -
PLOT SCALE = N/A	DRAWN - JSR	REVISED -
PLOT DATE = 10/7/2013	CHECKED - BPS	REVISED -

STATE OF ILLINOIS
DEPARTMENT OF TRANSPORTATION

ATTACHMENT F - SUBSTRUCTURE CONDITION SURVEY
STRUCTURE NO. 016-0017

SHEET NO. 3 OF 3 SHEETS

F.A.I. RTE.	SECTION	COUNTY	TOTAL SHEETS	SHEET NO.
55	1112-619-HB	COOK		
CONTRACT NO.				
FED. ROAD DIST. NO. 1 ILLINOIS FED. AID PROJECT				

ATTACHMENT G

Opinion of Probable Costs

Sheet: _____ of _____
 Calc By: JSR Date: 10/9/13
 Check By: BHS Date: 12/19/13
 Project Number: 178600037
 Subject: OPINION OF PROBABLE COSTS
I-55 WB over Cicero (016-0017)

ALTERNATIVE 1 - IN-KIND REPAIRS

QUANTITY CODE	QUANTITY DESCRIPTION	QUANTITY	UNIT COST	TOTAL COST
50300300	Protective Coat	1507 sy	\$2.00	\$3,010
50500105	Furnishing and Erecting Structural Steel	2230 lb	\$5.00	\$11,150
Z0012754	Struct Repair of Concrete (Depth = < 5 Inches)	326 sf	\$175	\$57,050
Z0016001	Deck Slab Repair (Full Depth)	37 sy	\$750	\$27,750
Z0016200	Deck Slab Repair (Partial Depth)	93 sy	\$400	\$37,200
SUB TOTAL =				\$136,160
MOBILIZATION (10%) =				\$13,616
CONTINGENCY (20%) =				\$27,232
TOTAL =				\$177,100

ALTERNATIVE 2 - STRUCTURE WIDENING

QUANTITY CODE	QUANTITY DESCRIPTION	QUANTITY	UNIT COST	TOTAL COST
50102400	Concrete Removal	19 cy	\$600	\$11,100
50104720	Removal Existing Concrete Deck	1 LS	\$154,000	\$154,000
50200100	Structure Excavation	269 cy	\$35.00	\$9,420
50300225	Concrete Structures	201 cy	\$700	\$140,700
50300255	Concrete Superstructure	720 cy	\$800	\$576,000
50300260	Bridge Deck Grooving	2167 sy	\$7.00	\$15,170
50300300	Protective Coat	1883 sy	\$2.00	\$3,770
50500105	Furnishing and Erecting Structural Steel	1 LS	\$337,830	\$337,830
50500505	Stud Shear Connectors	1242 each	\$3.00	\$3,730
50800205	Reinforcement Bars, Epoxy Coated	220200 lbs	\$1.75	\$385,350
51201400	Fur Stil Pile HP10x42	2,800 ft	\$45.00	\$126,000
51203400	Test Pile Stil HP10x42	4 each	\$2,000	\$8,000
52000110	Preformed Joint Strip Seal	352 ft	\$175	\$61,600
52100010	Elastomeric Bearing Assembly, Type I	3 each	\$800	\$2,400
59100100	Geocomposite Wall Drain	46 sy	\$25.00	\$1,150
X2070304	Porous Granular Embankment, Special	62 cy	\$50.00	\$3,100
Z0004552	Approach Slab Removal	160 sy	\$35.00	\$5,600
Z0012754	Struct Repair of Concrete (Depth = < 5 Inches)	326 sf	\$175	\$57,050
Z0026407	Temporary Sheet Piling	1103 sf	\$30.00	\$33,090
Z0046304	Pipe Underdrains for Structures 4"	40 ft	\$20.00	\$800
SUB TOTAL =				\$1,935,860
MOBILIZATION (10%) =				\$193,586
CONTINGENCY (20%) =				\$387,172
TOTAL =				\$2,516,700

Sheet: _____ of _____
 Calc By: JSR Date: 10/9/13
 Check By: BHS Date: 12/19/13
 Project Number: 178600037
 Subject: OPINION OF PROBABLE COSTS
I-55 WB over Cicero (016-0017)

ALTERNATIVE 3 - SUPERSTRUCTURE AND PARTIAL SUBSTRUCTURE REPLACEMENT


CODE	QUANTITY DESCRIPTION	QUANTITY	UNIT COST	TOTAL COST
50101500	Removal of Existing Superstructures	1 LS	\$184,800	\$184,800
50102400	Concrete Removal	331 cy	\$600	\$198,600
50104650	Slope Wall Removal	813 sy	\$7.00	\$5,690
50200100	Structure Excavation	690 cy	\$35.00	\$24,150
50300225	Concrete Structures	350 cy	\$700	\$245,000
50300255	Concrete Superstructure	970 cy	\$800	\$776,000
50300260	Bridge Deck Grooving	2629 sy	\$7.00	\$18,400
50300300	Protective Coat	2455 sy	\$2.00	\$4,910
50500105	Furnishing and Erecting Structural Steel	1 LS	\$1,834,200	\$1,834,200
50500505	Stud Shear Connectors	9144 each	\$3.00	\$27,430
50800205	Reinforcement Bars, Epoxy Coated	312500 lbs	\$1.75	\$546,880
51100100	Slope Wall 4 Inch	606 sy	\$100	\$60,600
51201400	Fur Stl Pile HP10x42	3240 ft	\$45.00	\$145,800
51203400	Test Pile Stl HP10x42	4 each	\$2,000	\$8,000
52100010	Elastomeric Bearing Assembly, Type I	12 each	\$800	\$9,600
59100100	Geocomposite Wall Drain	174 sy	\$25.00	\$4,350
X2070304	Porous Granular Embankment, Special	355 cy	\$50.00	\$17,750
Z0004552	Approach Slab Removal	160 sy	\$35.00	\$5,600
Z0012754	Structural Repair of Concrete (< 5 Inches)	8 sf	\$350	\$2,680
Z0026407	Temporary Sheet Piling	1527 sf	\$30.00	\$45,800
Z0046304	Pipe Underdrains for Structures 4"	188 ft	\$20.00	\$3,760
SUB TOTAL =				\$4,170,000
MOBILIZATION (10%) =				\$417,000
CONTINGENCY (20%) =				\$834,000
TOTAL =				\$5,421,000

ALTERNATIVE 4 - STRUCTURE REPLACEMENT


QUANTITY CODE	QUANTITY DESCRIPTION	QUANTITY	UNIT COST	TOTAL COST
50100100	Removal of Existing Structures	1 LS	\$467,000	\$467,000
50200100	Structure Excavation	993 cy	\$35.00	\$34,760
50300225	Concrete Structures	589 cy	\$700	\$412,300
50300255	Concrete Superstructure	970 cy	\$800	\$776,000
50300260	Bridge Deck Grooving	2629 sy	\$7.00	\$18,400
50300300	Protective Coat	2455 sy	\$2.00	\$4,910
50500105	Furnishing and Erecting Structural Steel	1 LS	\$1,834,200	\$1,834,200
50500505	Stud Shear Connectors	9144 each	\$3.00	\$27,430
50800205	Reinforcement Bars, Epoxy Coated	360300 lbs	\$1.75	\$630,530
51100100	Slope Wall 4 Inch	606 sy	\$100.00	\$60,600
51201400	Fur Stl Pile HP10x42	6,120 ft	\$45.00	\$275,400
51203400	Test Pile Stl HP10x42	4 each	\$2,000	\$8,000
59100100	Geocomposite Wall Drain	174 sy	\$25.00	\$4,350
X2070304	Porous Granular Embankment, Special	355 cy	\$50.00	\$17,750
Z0004552	Approach Slab Removal	160 sy	\$35.00	\$5,600
Z0026407	Temporary Sheet Piling	1527 sf	\$30.00	\$45,800
Z0046304	Pipe Underdrains for Structures 4"	188 ft	\$20.00	\$3,760
SUB TOTAL =				\$4,626,790
MOBILIZATION (10%) =				\$462,679
CONTINGENCY (20%) =				\$925,358
TOTAL =				\$6,014,900

ATTACHMENT H

Proposed Structure Drawings

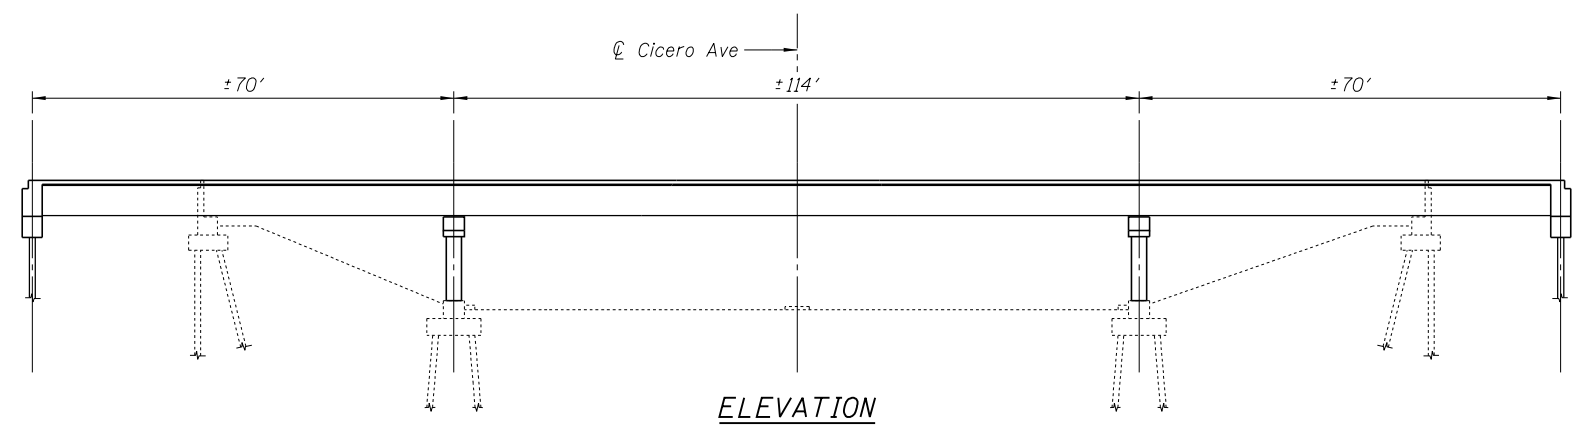

Notes:
 The number and location of substructure units, the profile grade, skew angle, and the bridge length and width are subject to refinement in the TSL phase.
 Superstructure type, beam spacing, and rail type to be determined during the TSL phase.

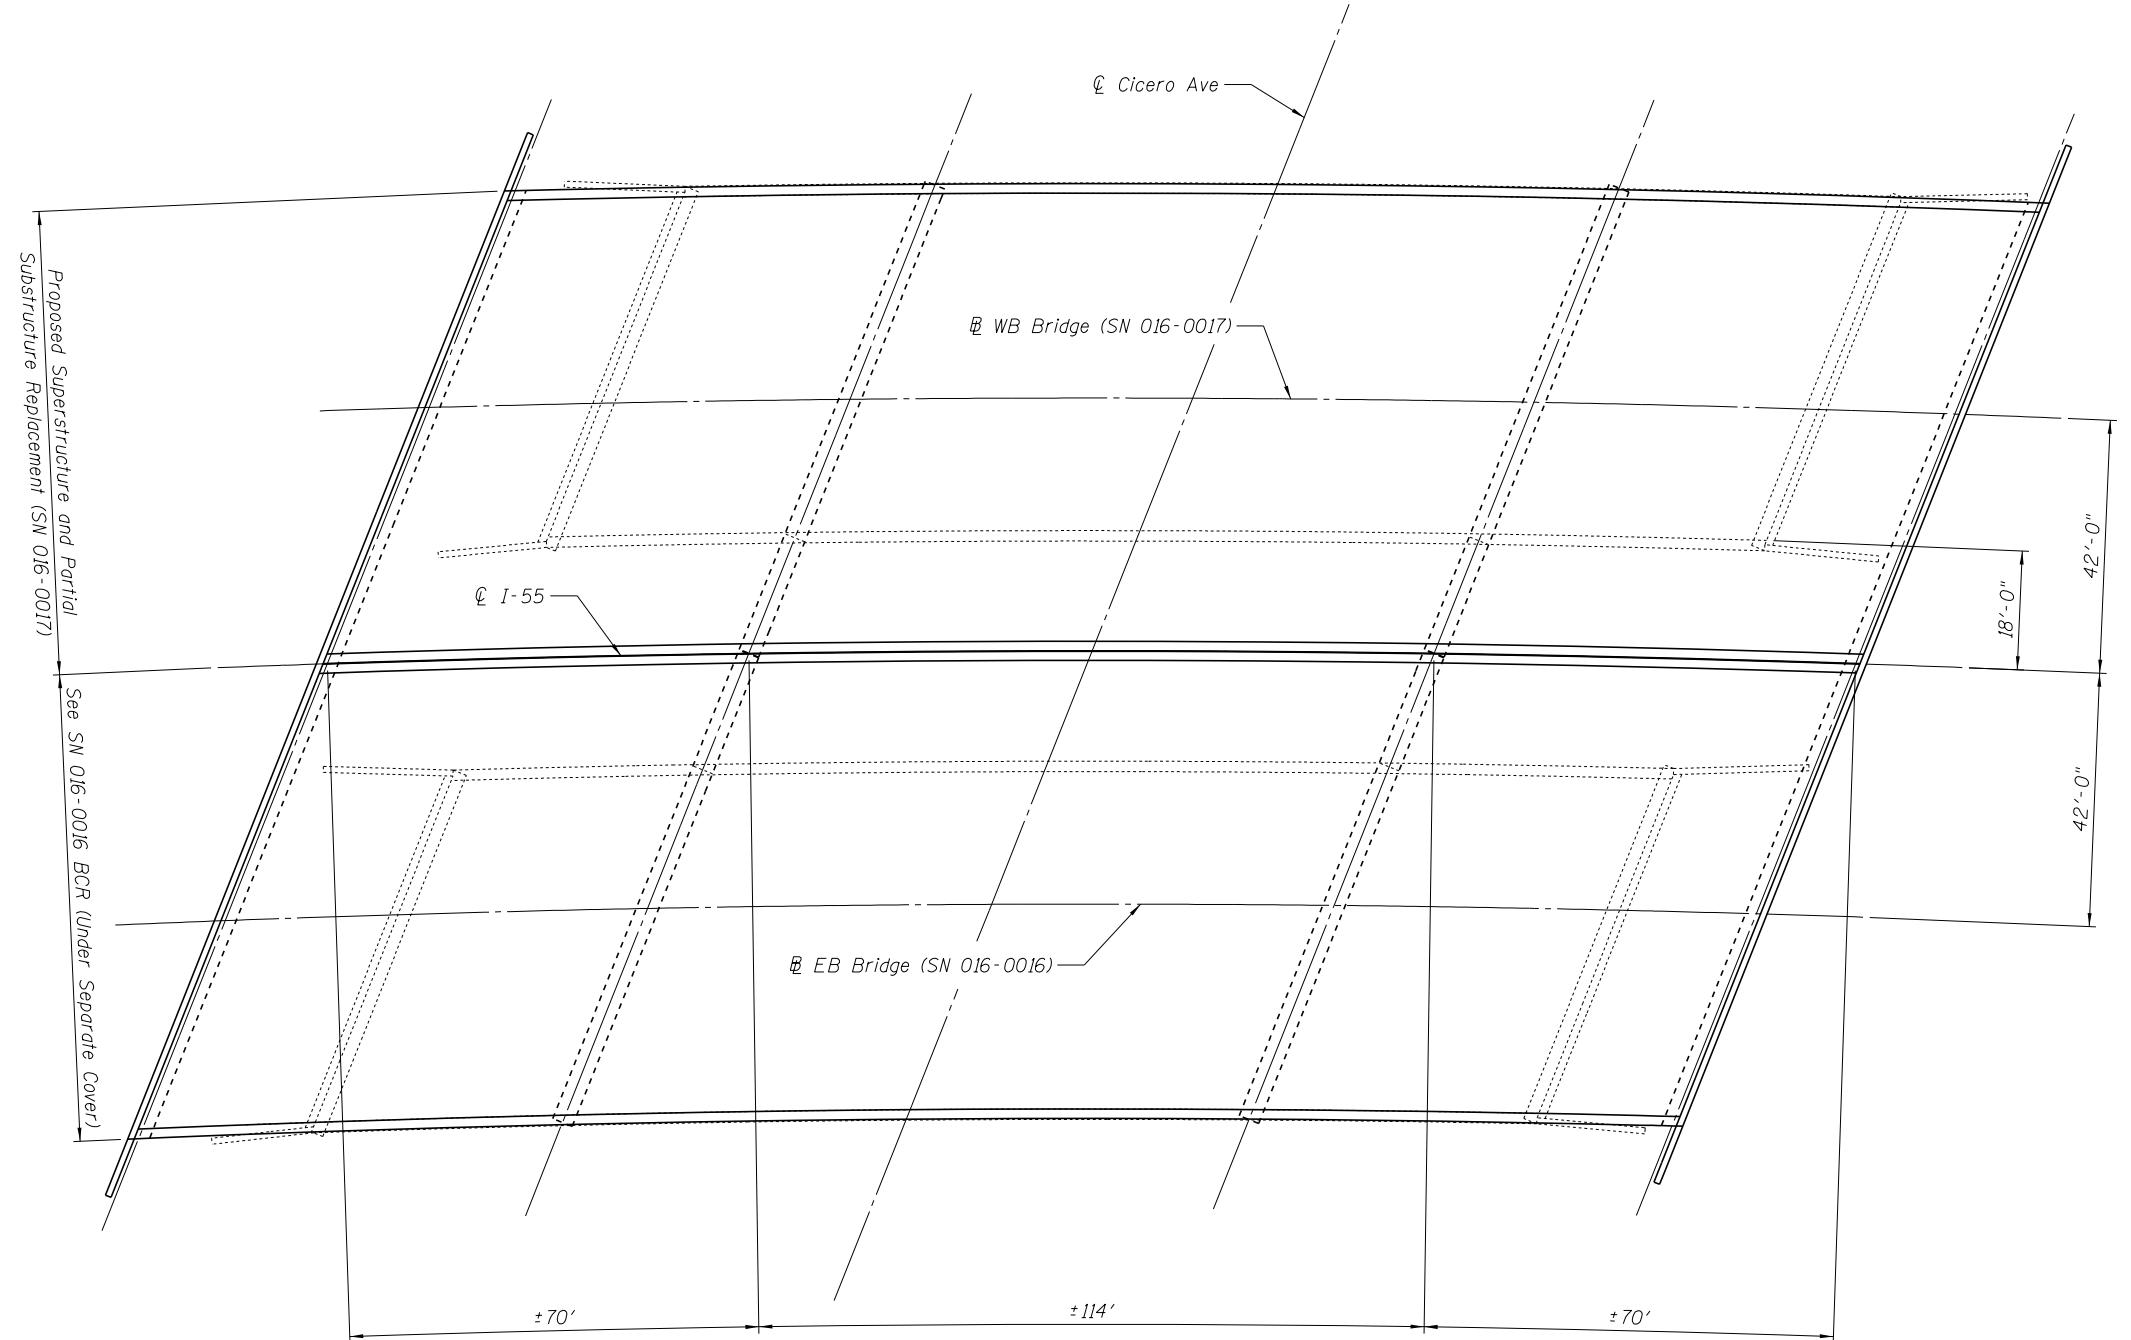

Proposed Superstructure and Partial Substructure Replacement (SN 016-0017)
 See SN 016-0016 BCR (Under Separate Cover)

FILE NAME =



USER NAME = bsogers	DESIGNED - JSR	REVISED -
	CHECKED - BPS	REVISED -
PLOT SCALE = N/A	DRAWN - JSR	REVISED -
PLOT DATE = 12/19/2013	CHECKED - BPS	REVISED -

**STATE OF ILLINOIS
 DEPARTMENT OF TRANSPORTATION**

**ATTACHMENT H – PROPOSED STRUCTURE DRAWING
 STRUCTURE NO. 016-0017**

SHEET NO. 1 OF 1 SHEETS

F.A.I. RTE. = 55	SECTION = 1112-619-HB	COUNTY = COOK	TOTAL SHEETS =	SHEET NO. =
FED. ROAD DIST. NO. 1 ILLINOIS FED. AID PROJECT			CONTRACT NO. =	

ATTACHMENT I

Structure Photos



Photo 1 - Spalling in bay 9, Span 2 , east end, looking west



Photo 2 - Spall underside of deck in Span 3, east end, between beams 1-2 from north, looking west



Photo 3 - Underside of Deck, Span 2, south end, looking east



Photo 4 - Typical discolored concrete and pop off in Span 2, looking east



Photo 5 – Span 3, looking southwest



Photo 6 – Span 2, looking southwest



Photo 7 – Span 1, looking southwest



Photo 8 - East Abutment joint, looking south



Photo 9 - East Pier joint, looking south

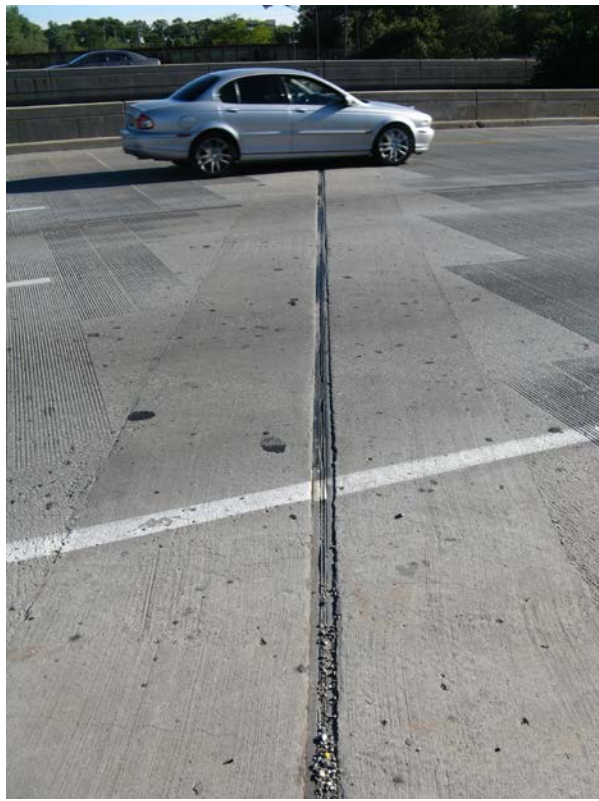


Photo 10 - West Pier joint, looking south



Photo 11 - West Abutment joint, looking south



Photo 12 - Crack in built up pedestal on beam 9 from north at West Pier, west span, looking east



Photo 13 - Close up of photo 12



Photo 14 - Typical cracked weld between bottom flange of beam and built up steel pedestal, Beam 6 at East Abutment, looking southeast



Photo 15 - Typical beam with cover plate in Span 1, Beam 4, looking southwest



Photo 16 – Paint peel on Beam 9 in Span 2, looking east



Photo 17 - South fascia beam, looking west



Photo 18 - North fascia beam, Span 2, looking west



Photo 19 - Failed conduit connections, looking southwest



Photo 20 - Broken conduit from brackets along south fascia beam in Span 1, looking southwest



Photo 21 - Typical end beam bearing, beam 1 from north, West Abutment, looking southwest



Photo 22 - East Abutment, looking east



Photo 23 - West Abutment, looking southwest



Photo 24 - Broken and open conduit on north end of West Abutment, looking south



Photo 25 - Broken conduit at West Abutment backwall in bay 1 from north, looking west



Photo 26 - Spall on West Abutment seat in bay 2 from north, looking east



Photo 27 - Spall on front face of West Abutment backwall at south end and open conduit junction box, looking north



Photo 28 - Northwest Wingwall, looking southwest

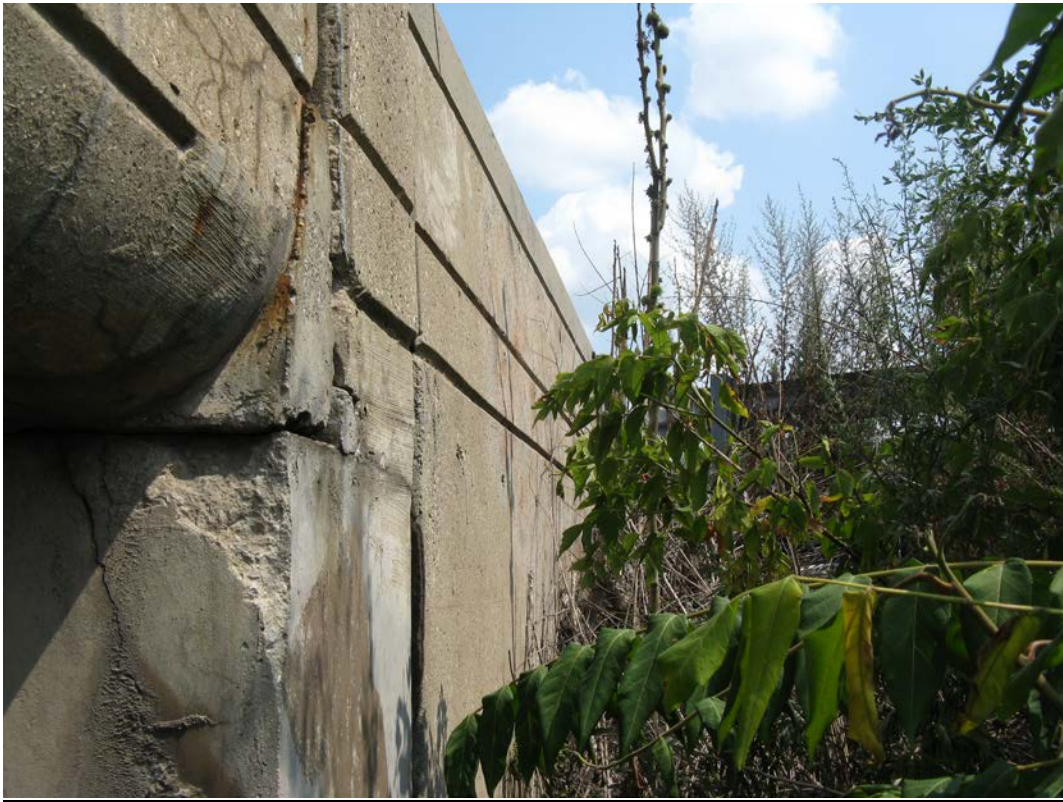


Photo 29 - Southeast Wingwall, looking east



Photo 30 – Southwest wingwall, looking west



Photo 31 – Northeast wingwall, looking southeast



Photo 32 - East Pier, west face, looking east



Photo 33 - East Pier, spall on underside of cap in between columns 3-4 from north, looking up and east



Photo 34 – East Pier, delam on northeast corner, looking southwest



Photo 35 - Spall in East Pier crashwall, north of second column from north, west face, looking southeast



Photo 36 - West Pier, west face, north end, looking northeast



Photo 37 - Spall on West Pier, south face, bottom of fourth column from north, looking north



Photo 38 - North half of east slopewall, looking northeast



Photo 39 – Cracks in north end of west sloped wall, looking southwest


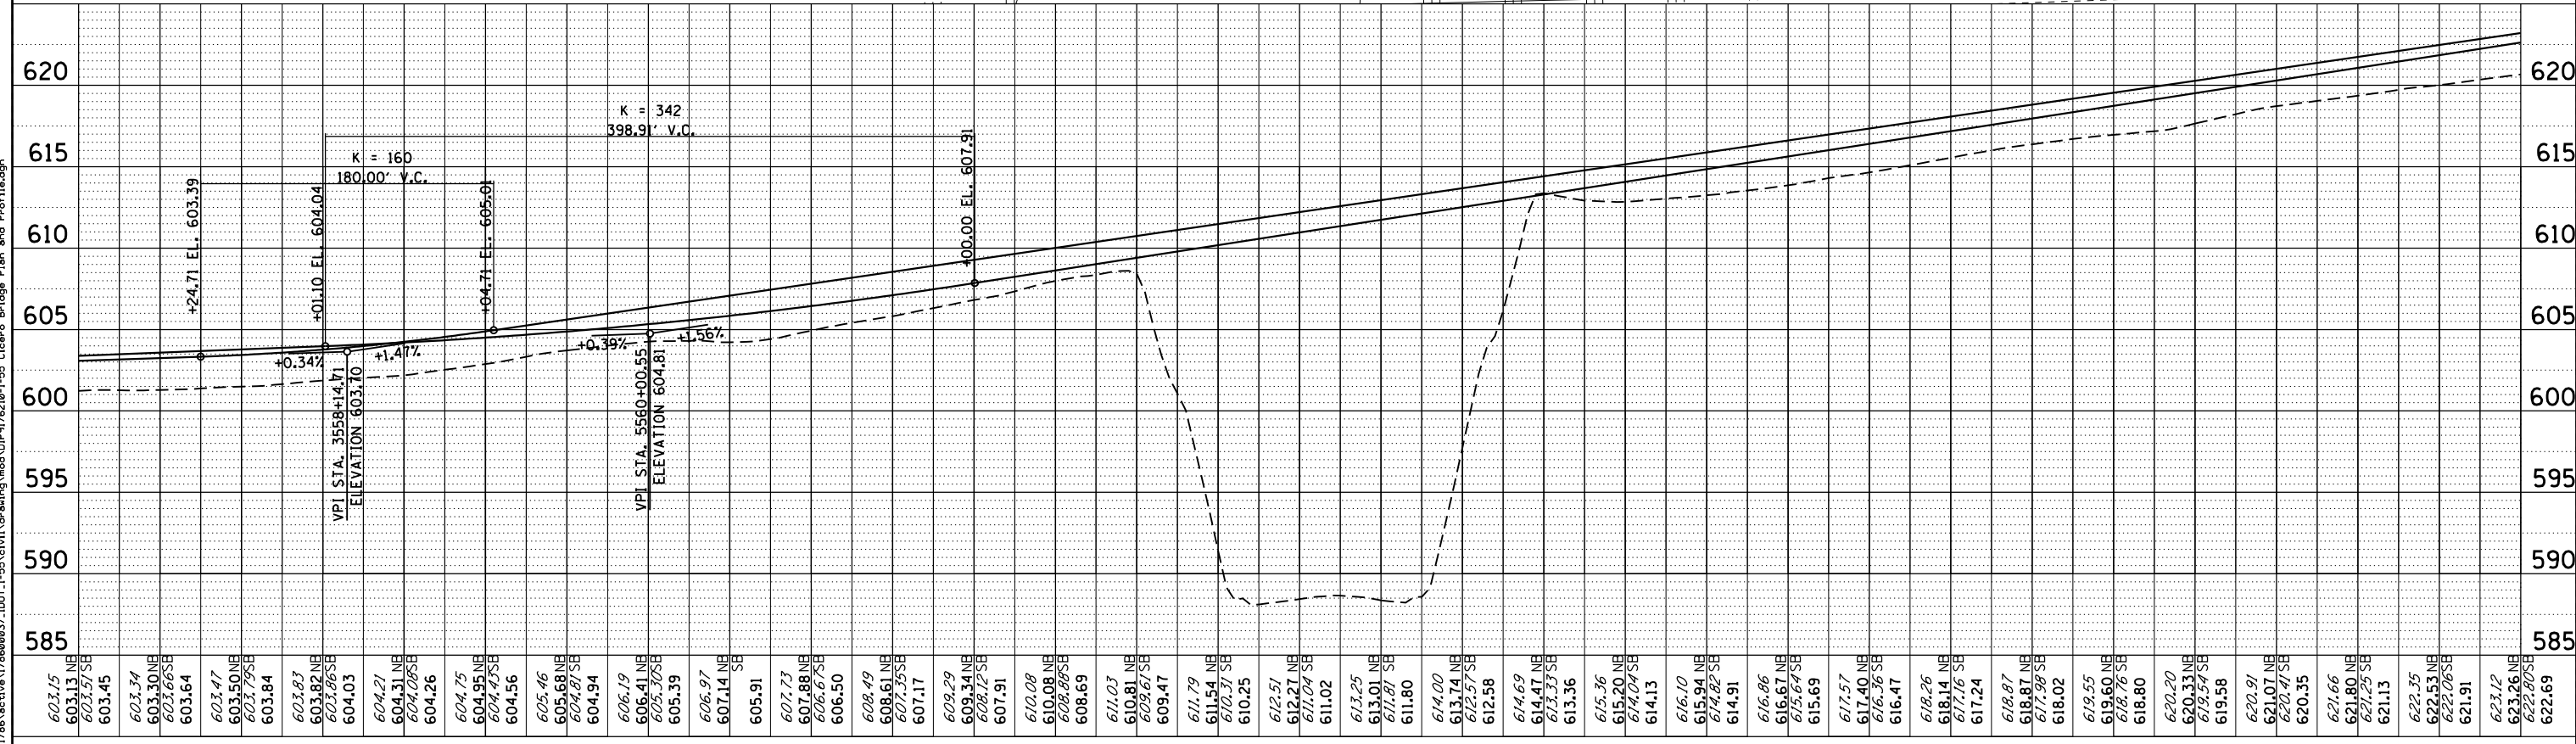


Photo 40 - Spall in west sloped wall, looking west

ATTACHMENT J

Proposed Plan & Profile

FILE NAME = V:\1786\active\178600037_1DOT_I-55\civil\drawing\mod\178600037_1DOT_I-55\civil\drawing\mod\178600037_1DOT_I-55\Cicero Bridge Plan and Profile.dgn

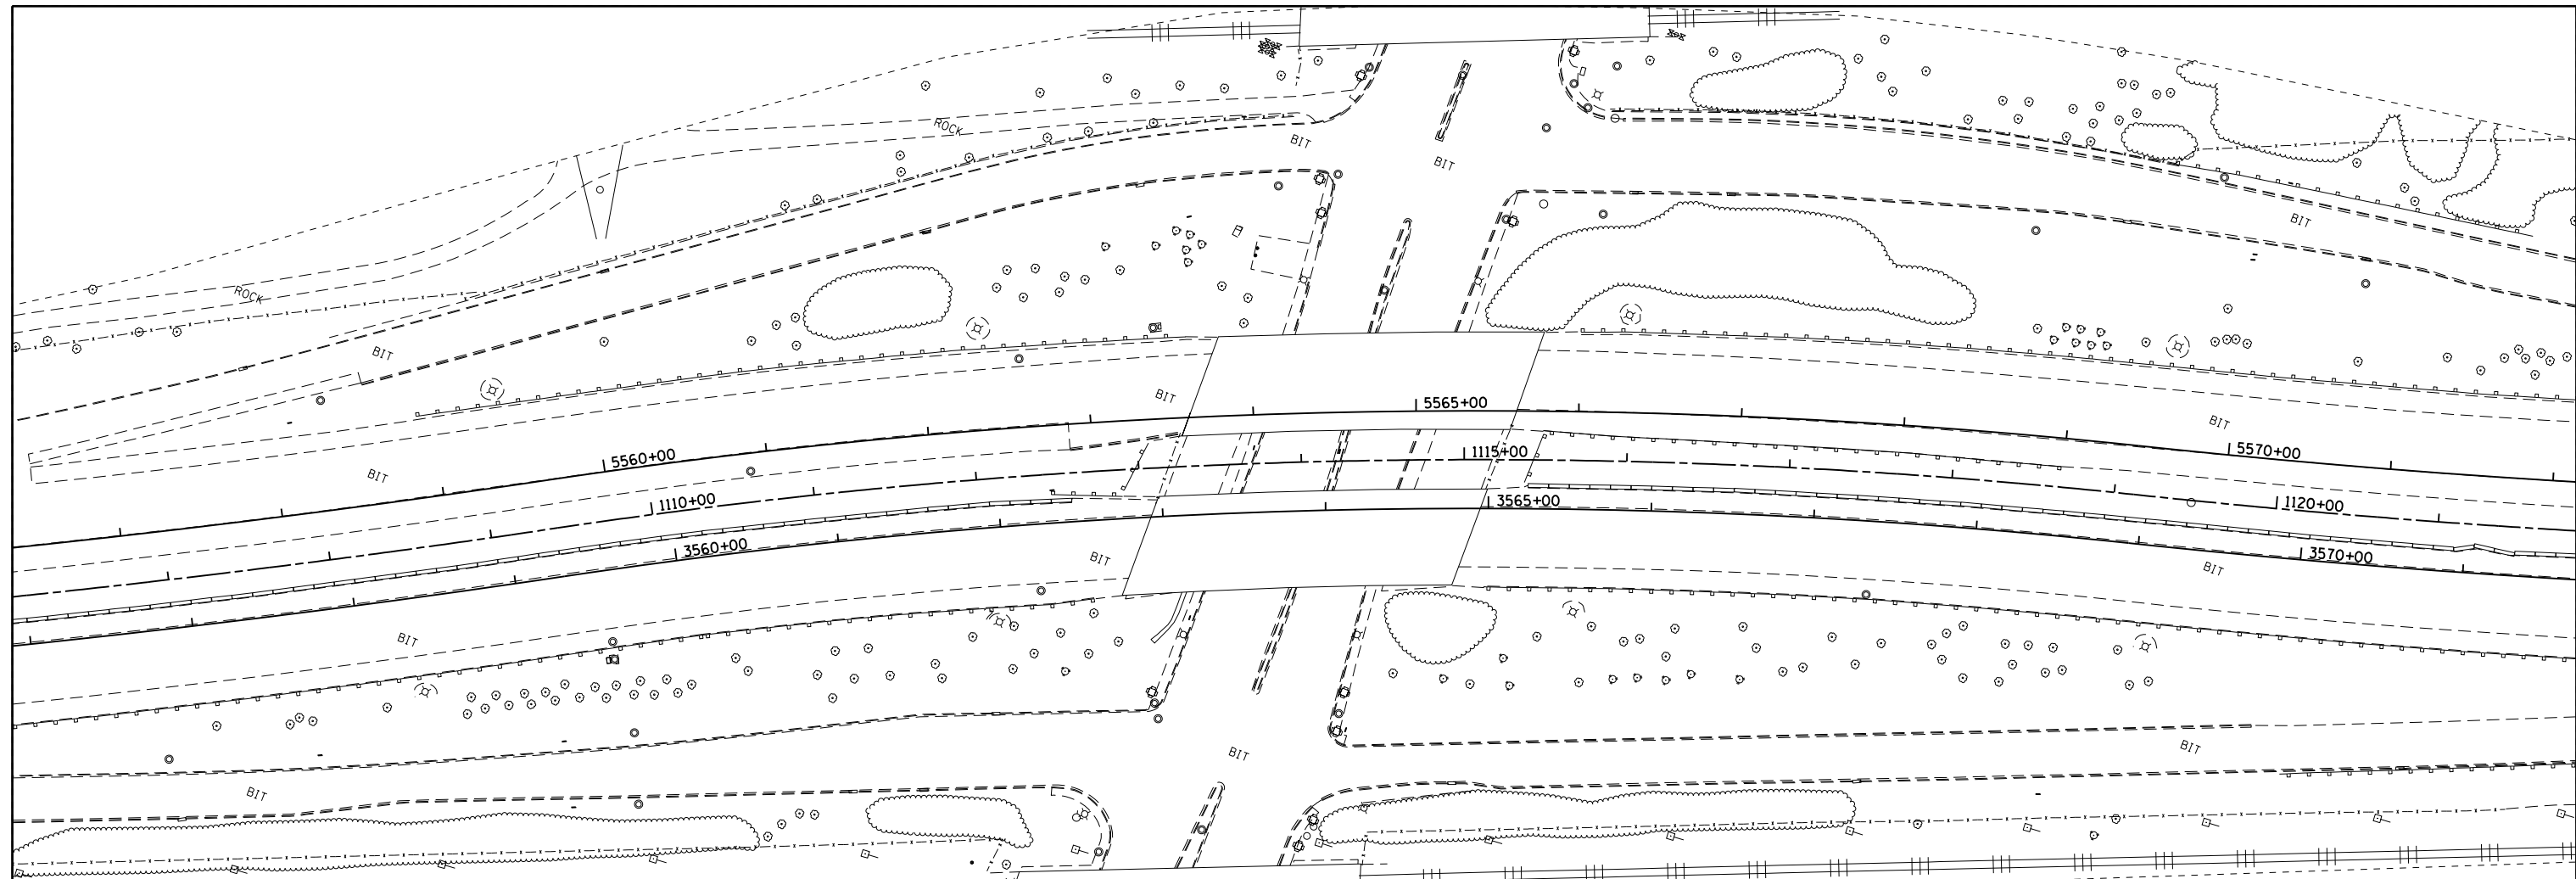

603.15	603.13 NE	603.57 SB	603.45	603.34	603.30 NE	603.65 SB	603.64	603.47	603.50 NE	603.79 SB	603.84	603.83	603.82 NE	603.95 SB	604.03	604.21	604.31 NE	604.09 SB	604.26	604.75	604.95 NE	604.49 SB	604.56	605.46	605.68 NE	604.87 SB	604.94	606.19	606.41 NE	605.37 SB	605.39	606.97	607.14 NE	607.14 SB	605.91	607.73	607.88 NE	606.87 SB	606.50	608.49	608.61 NE	607.39 SB	607.17	609.29	609.34 NE	608.12 SB	607.91	610.08	610.08 NE	608.89 SB	608.69	611.03	611.03 NE	609.67 SB	609.47	611.79	611.54 NE	610.37 SB	610.25	612.51	612.21 NE	611.04 SB	611.02	613.25	613.01 NE	611.87 SB	611.80	614.00	613.74 NE	612.57 SB	612.58	614.69	614.41 NE	613.37 SB	613.36	615.36	615.20 NE	614.04 SB	614.13	616.10	615.94 NE	614.82 SB	614.91	616.86	616.67 NE	615.64 SB	615.69	617.57	617.40 NE	616.36 SB	616.47	618.26	618.14 NE	617.16 SB	617.24	618.87	618.87 NE	617.98 SB	618.02	619.55	619.60 NE	618.76 SB	618.80	620.20	620.33 NE	619.54 SB	619.58	620.91	621.07 NE	620.47 SB	620.35	621.66	621.80 NE	621.29 SB	621.13	622.35	622.53 NE	622.06 SB	621.91	623.12	623.26 NE	622.87 SB	622.69
--------	-----------	-----------	--------	--------	-----------	-----------	--------	

USER NAME = m.j.verheyen	DESIGNED - MJV	REVISED -
PLOT SCALE = 100.0000' / 1in.	DRAWN - STANTEC	REVISED -
PLOT DATE = 10/4/2013	CHECKED -	REVISED -
	DATE - 10/04/2013	REVISED -

STATE OF ILLINOIS DEPARTMENT OF TRANSPORTATION		ATTACHMENT J I-55 OVER CICERO AVE PROPOSED PLAN & PROFILE	
SCALE: 1"=100'	SHEET ___ OF ___ SHEETS	STA. _____	TO STA. _____


F.A.I. RTE. 55	SECTION	COUNTY COOK	TOTAL SHEETS	SHEET NO.
ILLINOIS FED. AID PROJECT				




Default

ATTACHMENT K

**Existing and Proposed Roadway Cross
Sections**

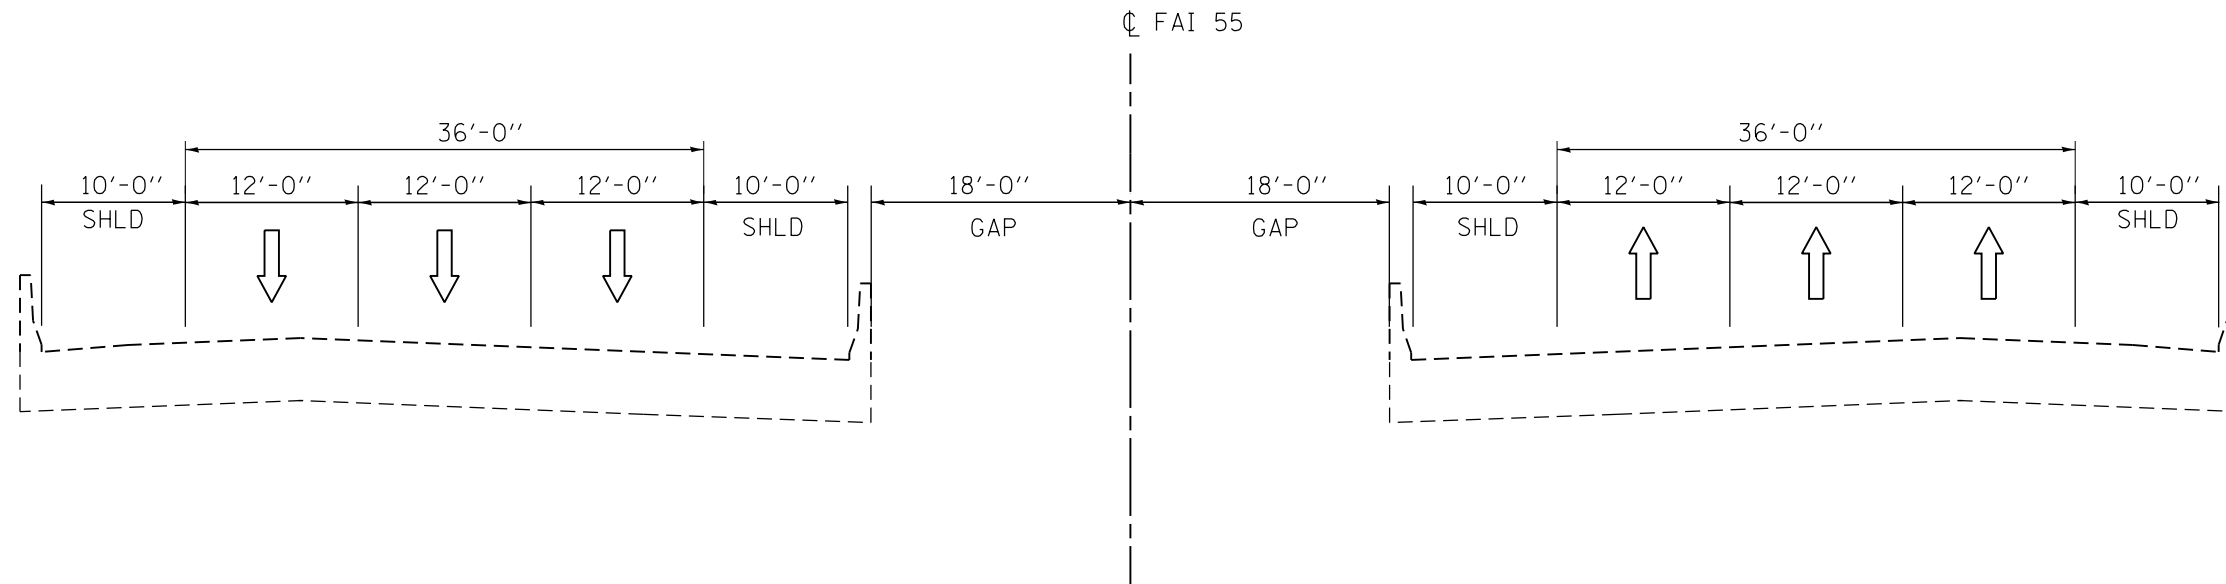

EXISTING I-55 OVER CICERO AVE TYPICAL SECTION

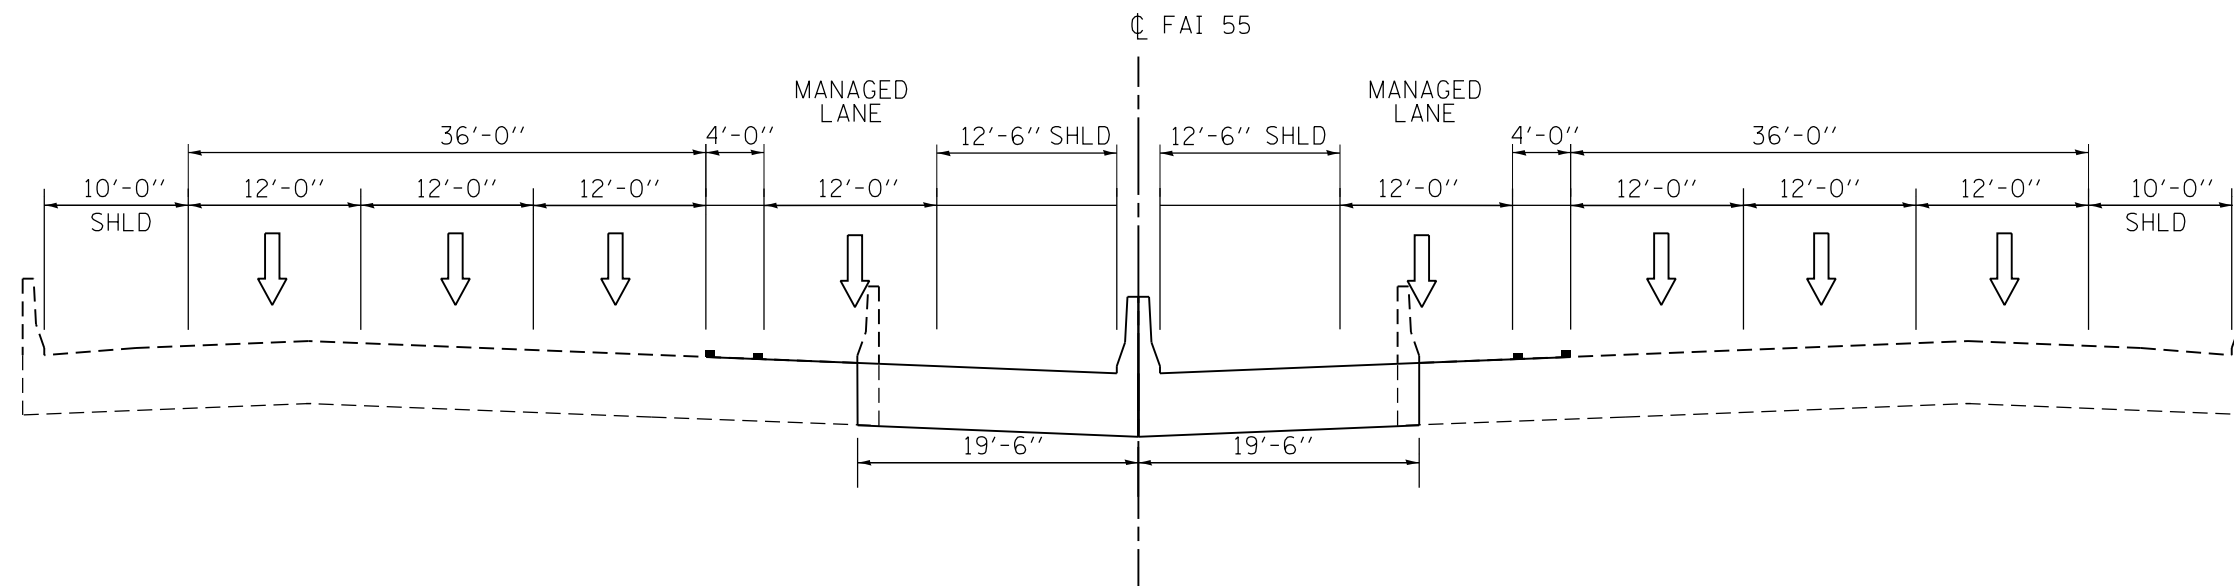

PROPOSED I-55 OVER CICERO AVE TYPICAL SECTION

FILE NAME = V:\7865\active\786500037_IDOT_I-55\civ1\drawing\mod\IP176210-typical-sections\Cicero Ave and RR Structure.dgn



USER NAME = mjverheyen	DESIGNED - MJV	REVISED -
	DRAWN - STANTEC	REVISED -
PLOT SCALE = 13.3343' / 1in.	CHECKED -	REVISED -
PLOT DATE = 10/7/2013	DATE - 10/7/2013	REVISED -

STATE OF ILLINOIS
DEPARTMENT OF TRANSPORTATION

ATTACHMENT K
TYPICAL SECTIONS



SCALE: SHEET 1 OF 2 SHEETS STA. TO STA.

F.A.I. RTE.	SECTION	COUNTY	TOTAL SHEETS	SHEET NO.
55		COOK		
CONTRACT NO.				
ILLINOIS FED. AID PROJECT				

ATTACHMENT L


Abbreviated Existing Plans

F.A.I. RITE	SECTION	EXPRESSWAY	TOTAL SHEETS	SHEET NO.
55	1112-619-MB	SOUTHWEST	32	2C
STA. 23+02.91		TO STA. 25+40.38		
FED. ROAD DIST. NO. 7		ILLINOIS FED. AID PROJECT 1-65-7(29)-281		

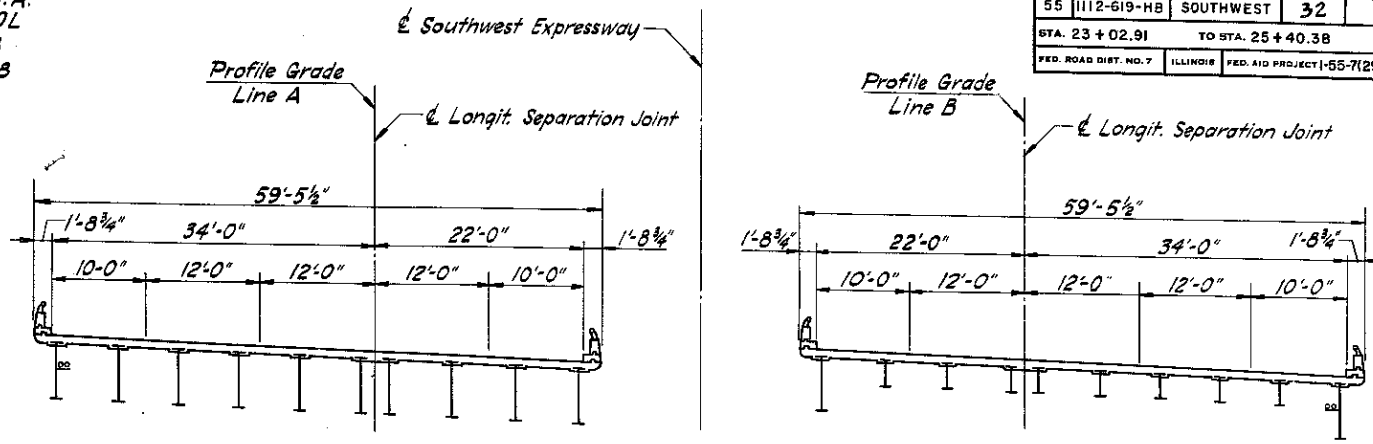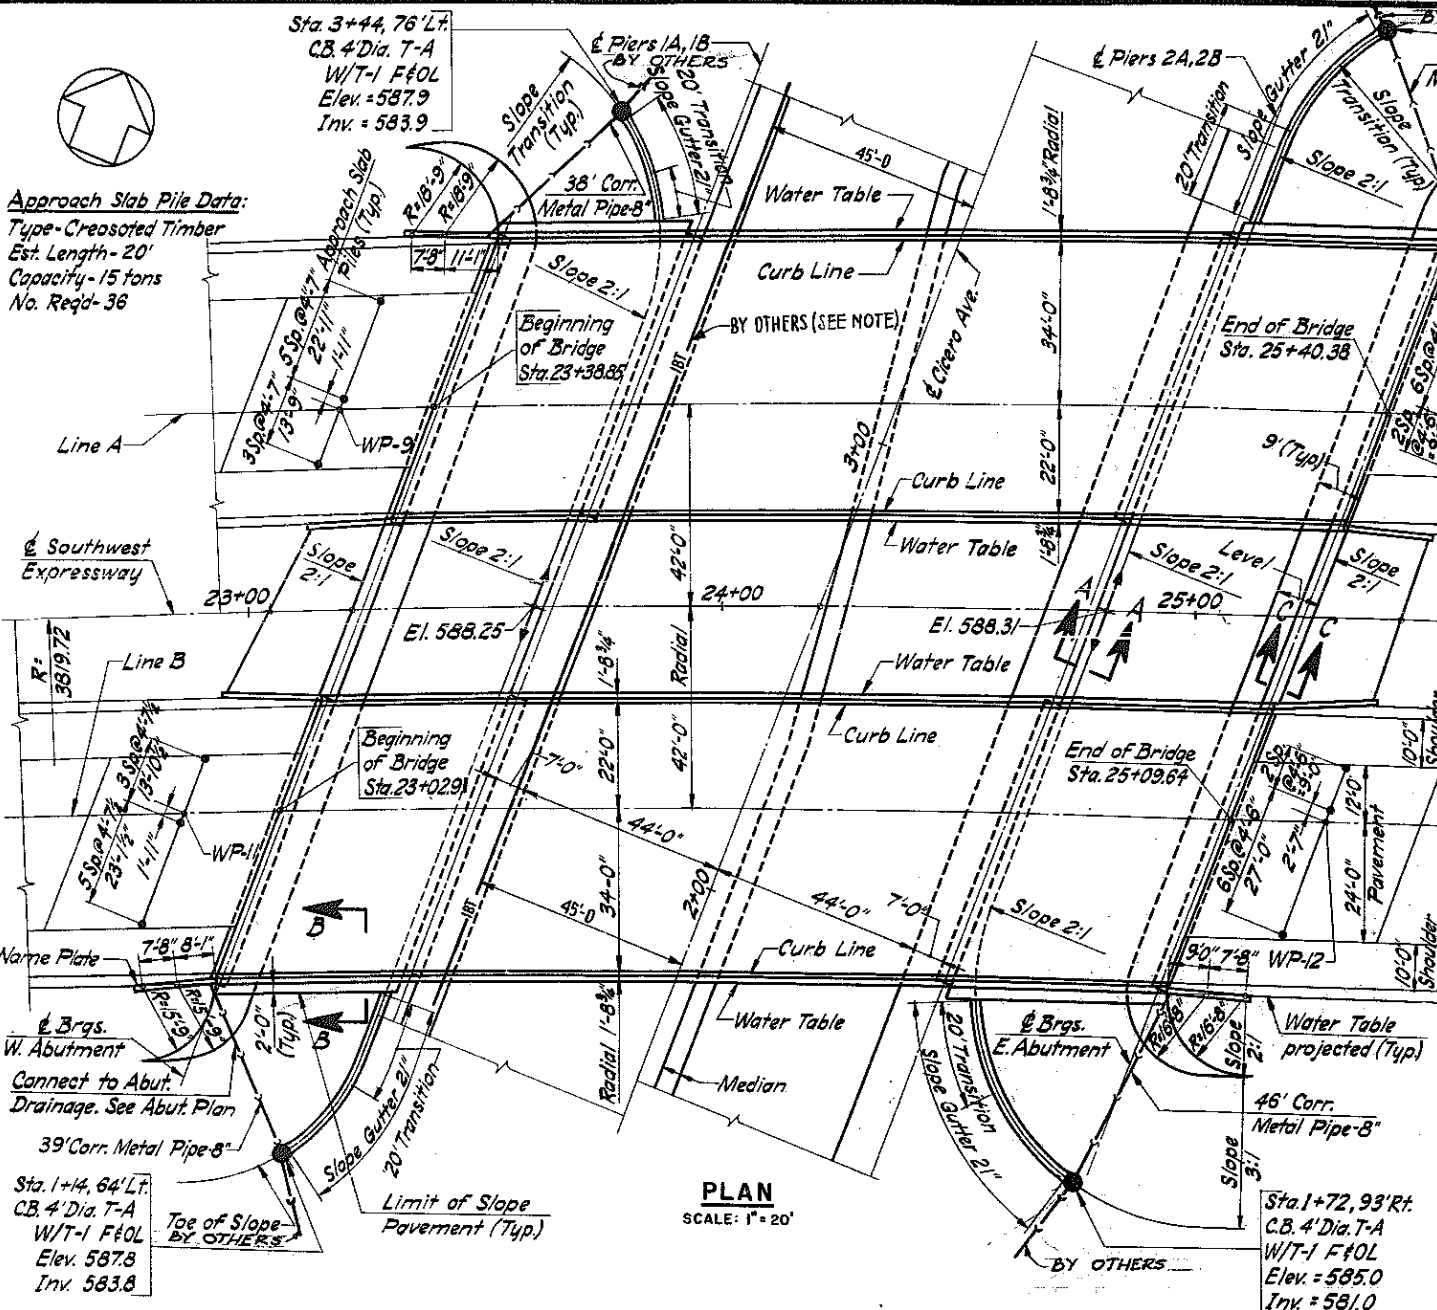

SUMMARY OF QUANTITIES

CODE NUMBER	ITEM	UNIT	QUANTITY				
			BRIDGE A Sub.	BRIDGE A Super.	BRIDGE B Sub.	BRIDGE B Super.	TOTAL for 2 Bridges
016001	Embankment	Cu. Yds.	14620	—	18,260	—	32,880
019001	Porous Granular Embankment	Cu. Yds.	636	—	618	—	1,254
050001	Class "A" Excavation for Structures	Cu. Yds.	256	—	256	—	512
052003	Class "X" Concrete	Cu. Yds.	470.5	3080	471.2	3090	1,558.7
052021	Protective Coat	Sq. Yds.	—	1449	—	1454	2,903
054001	Furn. & Erect Struct. Steel	Lbs.	—	496,970	—	498,710	995,680
059001	Reinforcement Bars	Lbs.	62380	78,510	64,470	78,510	283,870
060004	Furnishing Creosoted Piles (up to 20')	Lin. Ft.	360	—	360	—	720
060008	Driving Timber Piles	Lin. Ft.	360	—	360	—	720
080043	Driving Concrete Piles	Lin. Ft.	4335	—	4,425	—	8,760
080044	Furnishing Concrete Piles	Lin. Ft.	4,335	—	4,425	—	8,760
080047	Test Pile Concrete	Ea.	2	—	2	—	4
061001	Name Plates	Ea.	—	1	—	1	2
063001	Corrugated Metal Pipe, 8"	Lin. Ft.	85	—	85	—	170
063020	Perforated Corrugated Metal Pipe, 6"	Lin. Ft.	165	—	165	—	330
075015	C.B. T.A. 4' Dia. T.F. & Open Lid	Ea.	2	—	2	—	4
083002	Slope Wall 4 inch	Sq. Yds.	813	—	719	—	1,532
L02710	Rigid Steel Conduit, 2" Dia.	Lin. Ft.	—	440	—	440	880
L02738	Rigid Steel Conduit, 2 1/2" Dia.	Lin. Ft.	40	—	30	—	70
L02766	Rigid Steel Conduit, 1 1/2" Dia.	Lin. Ft.	—	10	—	20	30
Z08008	Aluminum Handrail	Lin. Ft.	76	403	76	404	959

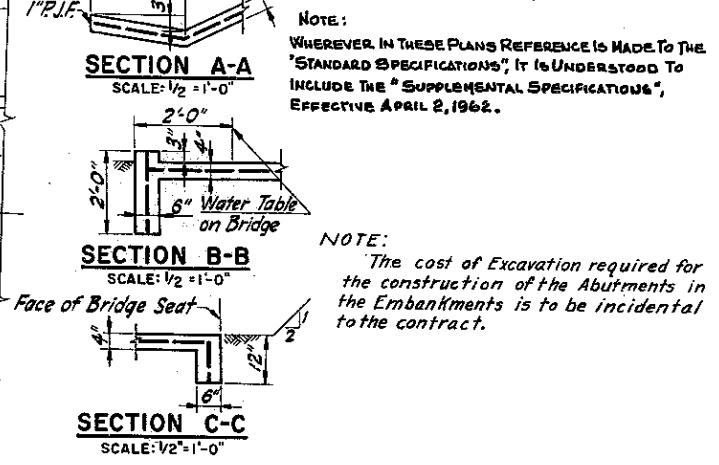

GENERAL NOTES

CONCRETE:

- Coarse aggregate to be used in parapet handrails and end posts must be absolutely free of chert, flint, limonite, lignite and soft sandstone.
- The concrete floor slab shall be finished in accordance with article 51.19 of the standard specifications.
- Sloped wall shall be reinforced with welded wire fabric 6"x6" mesh weighing 58 #/per 100 sq. ft.
- All reinforcement bars shall be lapped 20 diameter: unless otherwise shown.
- Permanent forms will not be permitted in forming the concrete floor.
- Class X concrete shall be used throughout.

STRUCTURAL STEEL:

- Rivets 3/4" φ open holes 1/2" φ unless otherwise noted.
- Anchor bolts shall be set before riveting diaphragms over supports.
- Roadway expansion guards shall be assembled in the shop in proper position with the ends in place and shall be left assembled for shop inspection.
- The following surfaces of the expansion guard shall be given two shop coats of red lead paint: the outside vertical 4" legs of the Ls 6x4x1/4.
- Expansion guards are included in the quantity of structural steel estimated weight 16,560 lbs. Bridge A and 16,610 lbs. Bridge B.
- Except as otherwise provided all structural steel shall receive one shop coat of red lead paint and two field coats of aluminum paint. See article 56.1 to 56.5 inclusive of the standard specifications and the special provisions.
- Structural carbon steel shall conform to specifications for carbon steel A.S.T.M. designation A-36.

SUBSTRUCTURE:

- The contractor shall drive 4 concrete test piles in a permanent location shown on the pier and abutment footing plans as directed by the engineer before ordering the remainder of the piles.
- Concrete piles at abutments shall be driven in holes precored through the embankment.

This work shall be done in accordance with article 60.9(c) of the standard specifications.

TWO SIGNS CONFORMING TO STD. 2160-1 SHALL BE ERRECTED AT LOCATIONS SHOWN ON THE PLANS (SHEET 2B)

UTILITIES:


1. The proposed Illinois Bell Telephone Co. line will be in place prior to beginning bridge construction.

DESIGN LOADS AND STRESSES

Specifications: A. A. S. H. O., 1961
Design Load: H20-S16-44 & alternate
25 psf Future wearing surface

Design Stresses: Structural Steel: F = 20,000 psi
Reinforcement Steel: F = 20,000 psi
Concrete: Fc = 3,500 psi
Ft = 1,400 psi
Fv = 1,000 psi (with earth pressure)
Fv = 75 psi (Footings)
n = 10

Piling: Concrete = 30 ton capacity
Creosoted Timber = 15 ton capacity

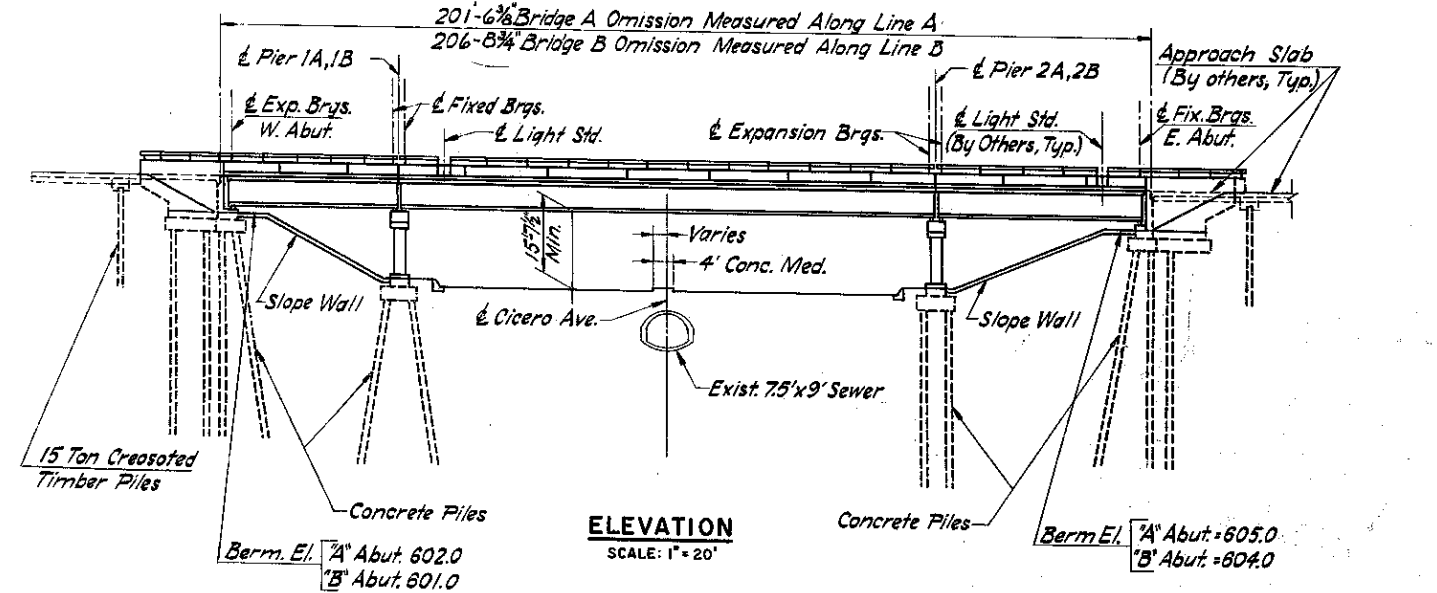

3. Concrete piles at piers shall be driven in holes precored to elevation 574.00.

ILLINOIS DIVISION OF HIGHWAYS
SOUTHWEST EXPRESSWAY
EXPRESSWAY OVER CICERO AVE.

GENERAL PLAN













SCALE: HORIZ. AS NOTED
VERT. AS NOTED
DATE: DEC., 1962

DRAWN BY M. Casone
CHECKED BY S. Rouse

REVISIONS	
NAME	DATE

Rev. Removed 200 cu yd Special Excav. Rev. C17A Excav. 1080 to 572 cu yd - Added Metal Handrail Type E - 859 lbs. 3-25-63 Rev. Wt. for E & E.S.S. 433 2903 lbs. 4/1/63

STATE	SECTION	EXPRESSWAY	TOTAL SHEETS	SHEET NO.
STA. 23+02.91		TO STA. 25+40.38		
FED. ROAD DIST. NO. 7		ILLINOIS FED. AID PROJECT		

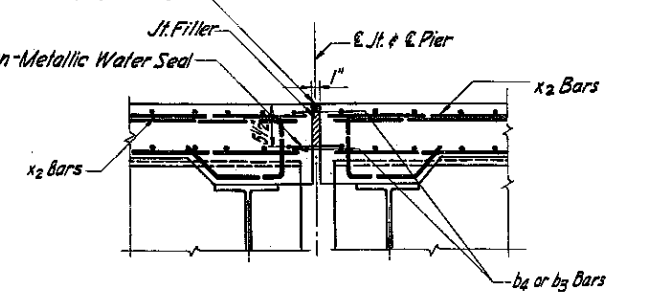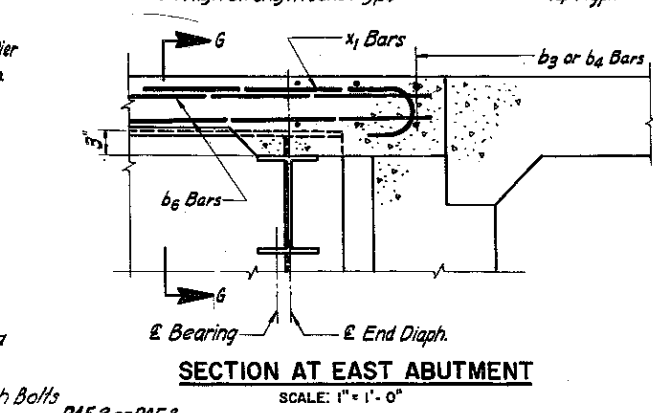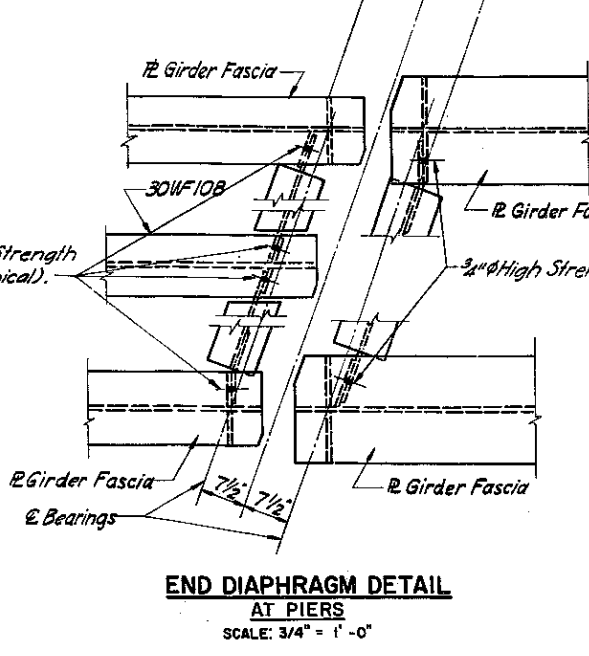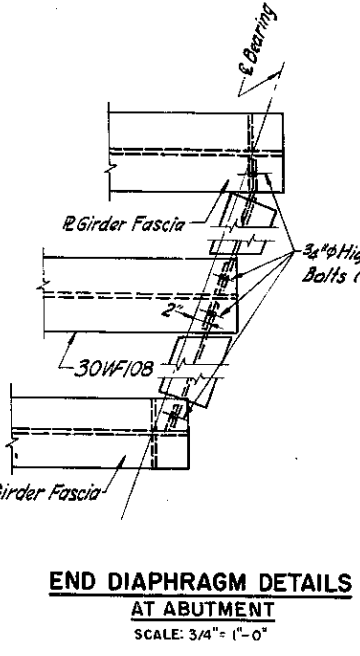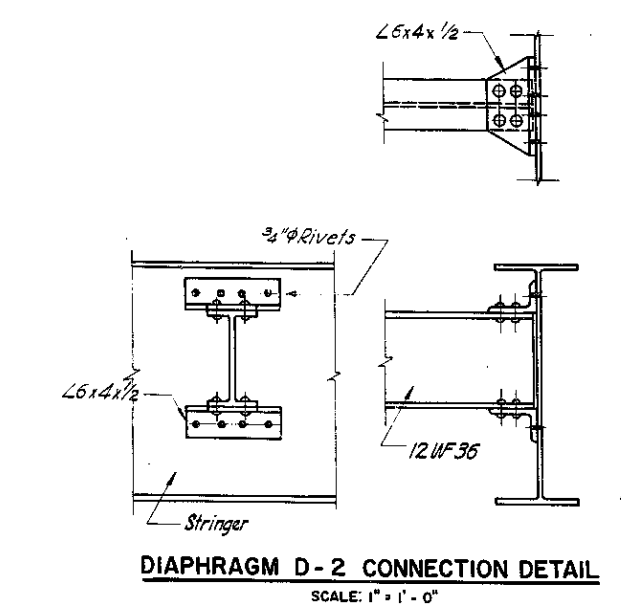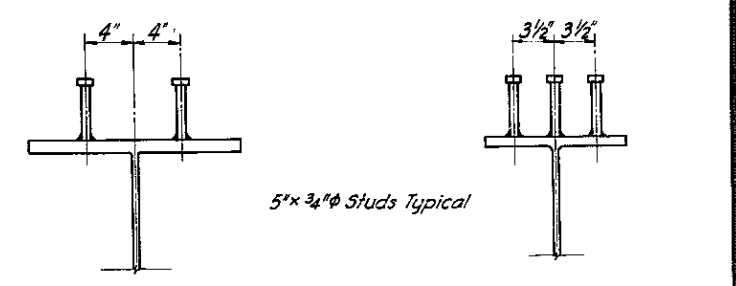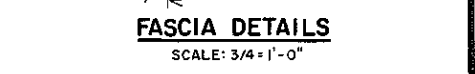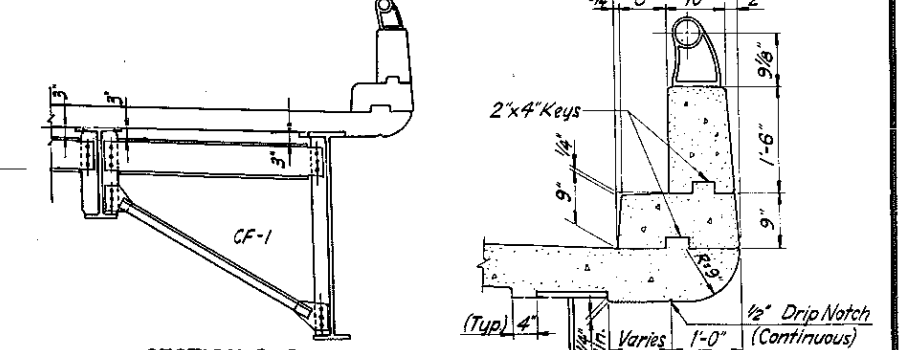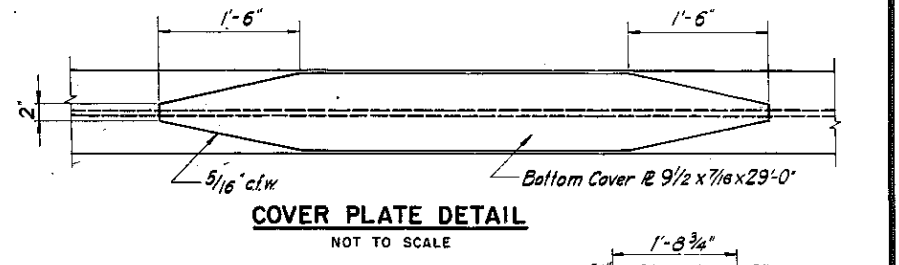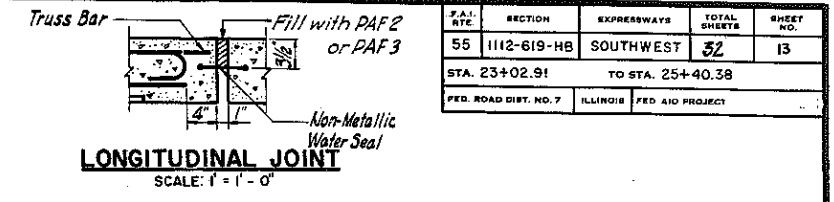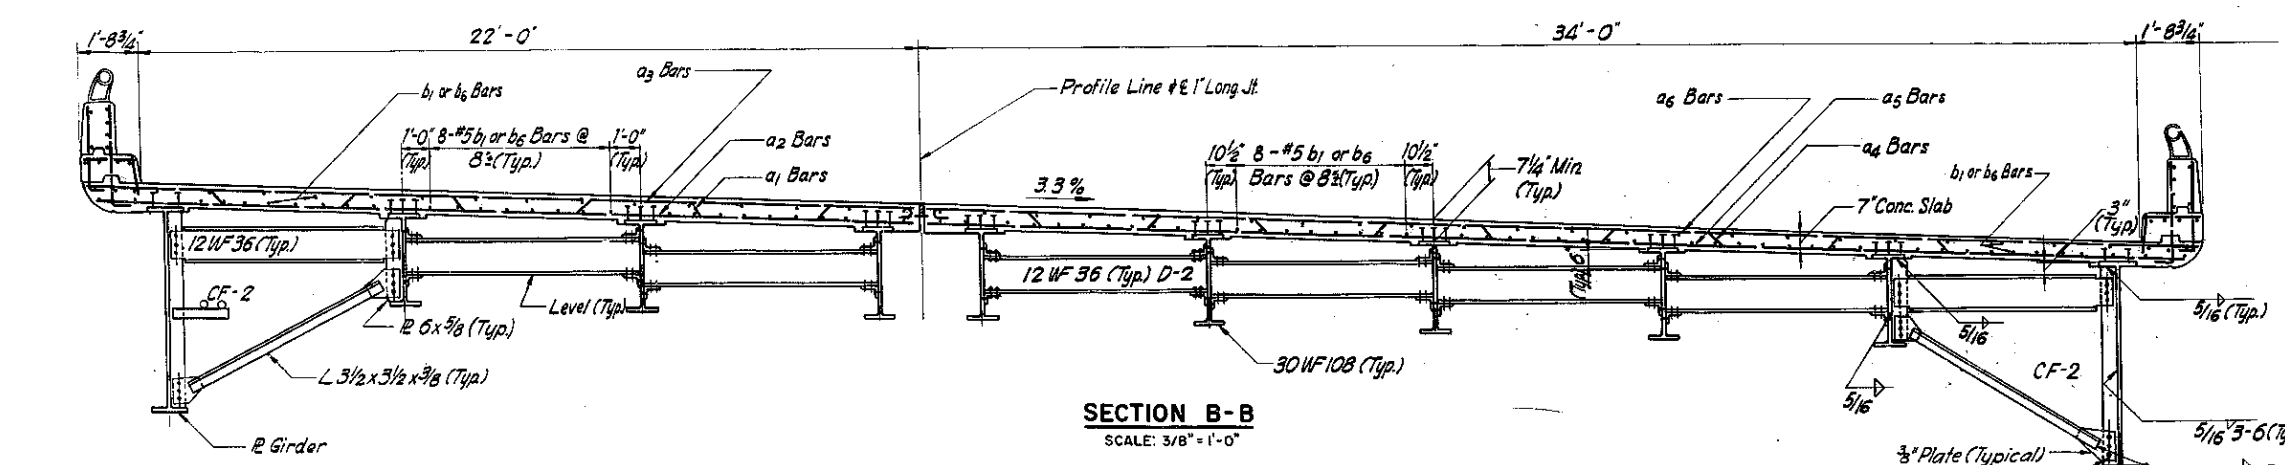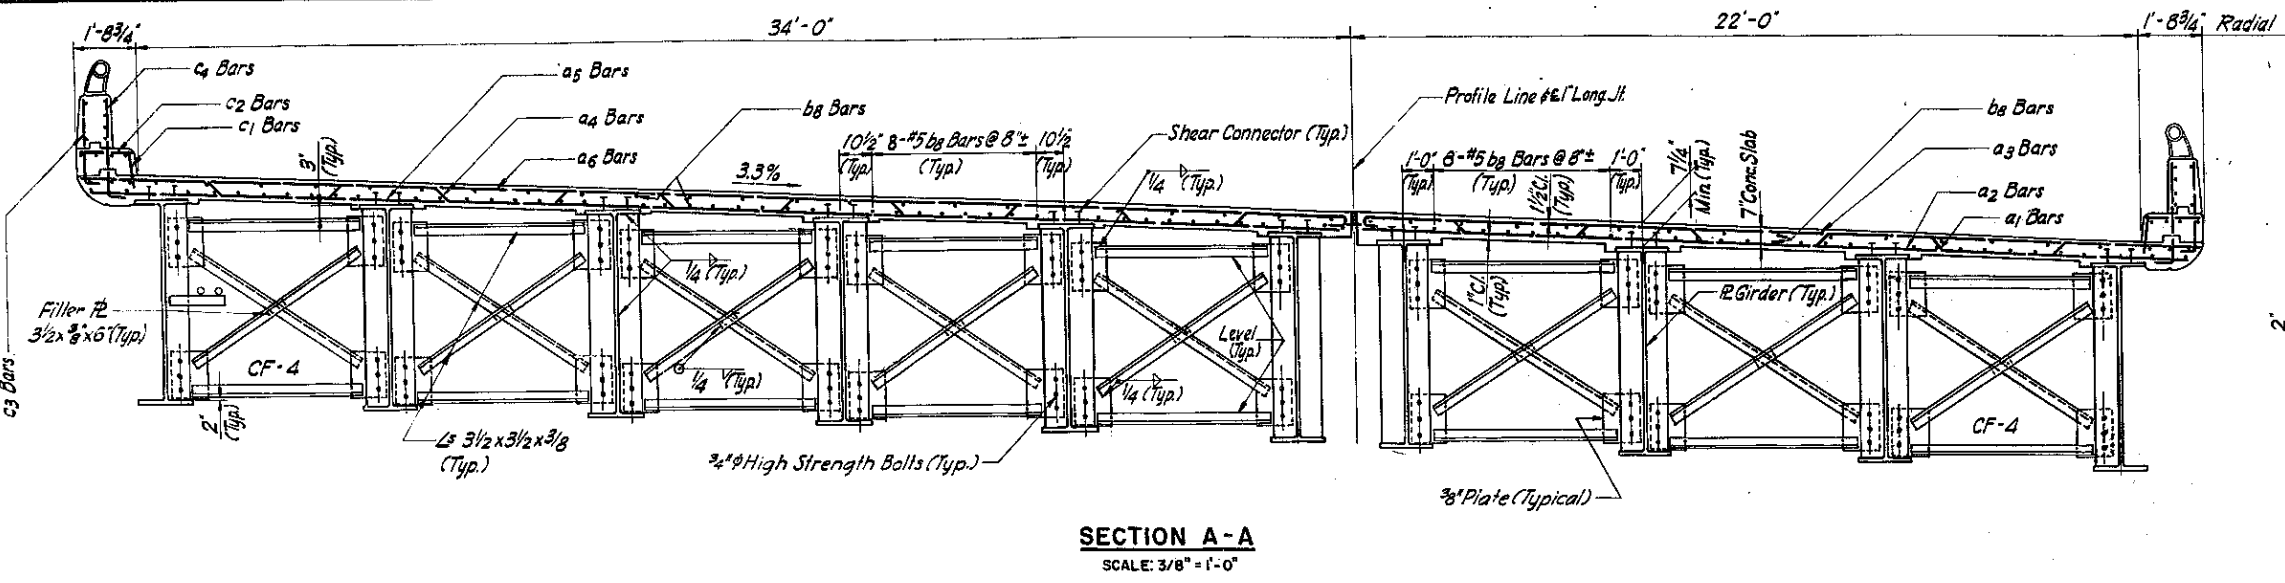

- NOTES:**
1. For location of sections A-A & B-B, see sheet 12.
 2. Section A-A shown for Bridge A, Bridge B similar except for stringer layout and spacing.
 3. Section B-B shown for Bridge B, Bridge A similar except for stringer layout and spacing.
 4. Use 3/4" rivets, except as otherwise noted.

REVISIONS	
NAME	DATE

ILLINOIS DIVISION OF HIGHWAYS
SOUTHWEST EXPRESSWAY
EXPRESSWAY OVER CICERO AVE.
SUPERSTRUCTURE DETAILS
SCALE: HORIZ. AS NOTED VERT. AS NOTED
DATE: DEC. 1962
DRAWN BY J. White
CHECKED BY B. Harris

LSES



Illinois Department of Transportation

Memorandum

To: John A. Fortmann, Dist. 1 Attn: John Baczek
From: D. Carl Puzey By: Patrik D. Claussen
Subject: Bridges and Structures
Date: September 12, 2016

A handwritten signature in blue ink, appearing to be 'Patrik D. Claussen', written over the typed name.

FAI Route 55
Section 22-1HB-1
DuPage County

P-91-762-10
SN 022-0003

I-55 over South Madison Street

We received the Bridge Condition Report (BCR) for the above-mentioned structure submitted with your email dated August 15, 2016. The report recommends the following scope of work:

- Remove and replace the expansion joints
- Install a new concrete overlay
- Repair the substructure
- Repair the beam ends
- Repair the roadway approach shoulders

We have no objection with the proposed scope of work based on the condition of the existing structure. The Bridge Condition Report is approved. Please submit the Repair plans to our Repairs Unit for review prior to placing this project on a letting.

Please contact Ally Kelley at (217) 785-7623 with any questions.

ADK/kkt0220003-20160912



To:	D. Carl Puzey
Bureau:	Bridges & Structures
Attn:	Patrik Claussen

From:	Harnet/Baczek/Schilke/Baldauf
Bureau:	Programming/Major Projects Unit
	By: Corey Smith
Subject:	BCR Submittal 022-0003 I-55
	Over Madison St 20160812

Date:	8/15/16
-------	---------

Please check appropriate box below:

- | | | |
|---|---|---------------------------------|
| <input type="checkbox"/> Take Necessary Action | <input type="checkbox"/> For Your Information | <input type="checkbox"/> Reply |
| <input checked="" type="checkbox"/> For Your Comments | <input type="checkbox"/> See Me About the Attached | <input type="checkbox"/> Return |
| <input type="checkbox"/> Per Your Request | <input type="checkbox"/> Draft (Letter)(Memo) For
My signature | <input type="checkbox"/> Route |
| <input checked="" type="checkbox"/> For Your Approval | | <input type="checkbox"/> File |

Message

We are transmitting for your review and approval a copy of the Bridge Condition Report for the above subject project. Design Approval is scheduled for 8/31/16. This structure is included as part of the I-55 Managed Lanes project which is operating under an accelerated project schedule and a priority of the Secretary and Governor. As such, we appreciate an expedited review in order to meet our scheduled Design Approval.

The proposed scope of work will consist of removing and replacing transverse expansion joints on all four approaches, scarifying concrete deck and installing concrete overlay across entire bridge, removing loose concrete and performing concrete repairs on the piers and abutments, repairing ends of prestressed concrete girders by cleaning and painting strands, repairing approach shoulders on top of deck.

For repairs to the substructure, S Madison St. will have to have traffic reduced to one lane for a 4 weekend lane closure program. Work on the top of deck which includes pouring a concrete overlay and replacing the expansion joints will also require temporary concrete barriers and will follow a similar staged schedule. (See BCR page 6.)

If you have any questions or need additional information, please contact John Baldauf, P.E., Project Manager, at 847-705-4103.

Signature

Copies to

Sarah Wilson

Ken Eng

Response

Signature

BRIDGE CONDITION REPORT

REGION: 1
DISTRICT: 1
ROUTE: I-55
COUNTY: DuPage
PROJECT NUMBER: PTB 169/014
STRUCTURE NUMBER: 022-0003



LOCATION: I-55 over S Madison St. in Burr Ridge, IL

PREPARED FOR: Illinois Department of Transportation

PREPARED BY: Ralph Otrembiak, PE SE- Bloom Companies, LLC

DATE INSPECTED: May 5th, 2016

PROPOSED LETTING DATE: N/A



Table of Contents

Item:	Page:
I. Administrative Data.....	1
II. Roadway/Structure Data.....	1
III. Structure Condition Data.....	1
IV. Evaluation.....	5
V. Recommended Scope of Work.....	6
Attachments:	
A. Location Map.....	A1
B. IDOT Master Structure Report.....	B1
C. Record Plans.....	C1
D. Field Sketches.....	D1
E. Top of Deck Survey.....	E1
F. Cost Estimates.....	F1
G. Proposed Repairs.....	G1
H. Structure Photos.....	H1

I. Administrative Data

Structure Number:	022-0003
County:	DuPage
Route Carried:	I-55
Feature Crossed:	S. Madison St.
Section:	22-1HB-1
Station:	10+00 (S. Madison St.) / 1023 + 92.08 (I-55)

II. Roadway/Structure Data:

Route Carried	
Roadway Classification:	Interstate
Design/Posted Speed:	55 MPH
ADT (current/design):	160000 / N/A
ADTT (current/design):	18600 / N/A
DHV:	
Inventory Rating (HS or HL):	1.635 (58) 07/08/1997
Operating Rating (HS or HL):	2.635 (94) 07/08/1997
Sufficiency Rating:	96.0
Route Crossed	
Roadway Classification:	Major Collector
Design/Posted Speed:	30 MPH
ADT (current/design):	2850 / N/A
ADTT (current/design):	

Construction / Reconstruction / Repair History:

- The structure was originally built in 1958 as two separate bridges.
- The two bridges were merged and widened as well as rehabilitated in 1996.
- The original design live load was HS20-S16-44 including future wearing surface. The design live load for the widening and repair was HS20-44 plus alternate military including future wearing surface.

III. Structure Condition Data:

Inspection History (NBIS Ratings):

Year:	Deck:	Super:	Sub:
2015	7	6	6
2016	7	6	5

Inspection was carried out on May 5th, 2016. Field sketches were prepared by hand and included dimensions and defects. The inspection included an overall visual inspection, defect sketching, and a delamination survey of the substructure. Photographs were also taken of all the pertinent components of the bridge.

In addition to the inspection, a top of deck condition survey was performed by AECOM on June 13th, 2016 using infrared thermography.

Deck:

The deck is in good condition overall (NBIS rating 7).

The deck is 7½” thick, sloping down toward the south at 0.015%. There is no wearing surface. The out-to-out width of each side is 102’-6” (along skew) making the full out-to-out width 205’-0”. It is conventionally reinforced and composite with the girders. The spans are numbered 1 to 3 from west to east. The bays between the girders are numbered 1 to 20 from north to south, not including the longitudinal joint bay (see structure naming convention on drawing D2 in Appendix D).

The top of the deck exhibits hairline cracking over span 2 and map cracking on the shoulder over span 2 on the north end (see Photo 51). Abrasion damage on the concrete is present on the east end of the south side due to impact of vehicles over the deteriorated joints (see Photos 49 & 50). Locations of ponding near the parapet over span 2 and near the east transverse joint are present on the south end.

The bottom of the deck is in good condition overall, showing only hairline cracks with efflorescence at approximately uniform spacing in 15 of the 20 bays (see Photo 6). Since the deck was replaced relatively recently, it shows few defects.

In addition to the visual inspection performed by Bloom, a top of deck condition survey was performed using infrared thermography. The thermograph survey shows that <0.1 % (7 SF) of the top of the deck is delaminated, <0.1% (1 SF) of the top of the deck is spalled, 0.1% (28 SF) of the top of deck is patched with epoxy, and 0.3% (66 SF) of the top of deck is patched with concrete.

Superstructure:

The superstructure is in satisfactory condition overall (NBIS rating 6).

The superstructure consists of 22 precast prestressed girders, numbered 1 to 22 from north to south. Reinforced concrete diaphragm members are present at various locations over the supports and at the midspan of each span. For the widening/repair design, four new girders were added between the two structures to merge them into a single structure and two new exterior girders were removed and replaced for the widening.

The girders exhibit spalling on their ends at 23 locations (see Photo 10) and delamination near the end on the bottom flange at 4 locations (see Photo 11). The worst cases of spalling occur on the end of girder 19 where the entire bottom row of stands are exposed and corroded (see Photo 10) and the underside of girder 6 at the west abutment (see Photo 12). Areas of spalling with exposed and corroded stirrups and areas of delamination are present on the underside of the bottom flange of girder 19 in span 3 near pier 2 (see Photo 7). The previously repaired areas on the superstructure are intact (see Photo 8). Corrosion is present on the bearing plates of most of the girders (see Photos 12 & 28).

No active defects are present on the diaphragm members. Previously repaired areas on the diaphragms are intact (see Photo 9).

Substructure:

The substructure is in fair condition overall (NBIS rating 5).

The substructure consists of two multi column piers and open abutments on the west and east. The piers are made up of 15 identical, 3'-6" diameter spiral columns. The columns are spaced 13'-0" on center with the exception of the added outer columns which are set 10'-11¼" on center and the column in the interior pier which are set 13'-2½" on center. The columns are capped with a 3'-3" deep pier cap with 3'-7" cantilevers on each end. The abutments are approximately 190'-1" long (along skew) with 13'-6" wingwalls on all four corners that run parallel with the roadway (see Photos 25 & 26).

Pier 1 is in fair condition overall. Spalling with exposed and corroded reinforcement is present on approximately 2.3% (83 SF) of the columns' surface area and approximately 4.6% (124 SF) of the pier cap's surface area (see Photos 22 - 24). The worst case of spalling on the pier cap is in bay 5 (see Photo 23) and the worst case of spalling on the columns in on the southwest side of column 10 (see Photo 22). Delamination is present on approximately 3.5 % (94 SF) of the pier cap's surface area.

Pier 2 is in fair condition overall. Spalling with exposed and corroded reinforcement is present on approximately 1% (32 SF) of the columns' surface area and approximately 11% (279 SF) of the pier cap's surface area (see Photos 17 - 21). The worst case of spalling on the pier cap is in bay 11 (see Photo 19) and the worst case of spalling on the columns in on the north east side of column 14 (see Photo 20). Delamination is present on approximately 5% (122 SF) of the pier cap's surface area.

The west abutment is in satisfactory condition, exhibiting minor spalling, delamination, cracking, efflorescence and rust and water staining. Spalling with exposed and corroded reinforcement is present on approximately 0.2% (4 SF) of the abutment surface area (see Photo 36). The backwalls of each abutment were partially razed in order to reconstruct the transverse joints. Because of this, there is a cold joint running along the entire length of the abutments (see Photo 37). Efflorescence is found along the length of this joint and water and rust staining is present on the abutment seat and back wall in bay 19. A significant build-up of sediment has been deposited on the abutment seat in bay 3 due to an opening in the transverse joint above (see Photos 39 & 40). A significant amount of Styrofoam particles from the longitudinal joint has accumulated on the abutment seat as well.

The east abutment exhibits spalling with exposed and corroded reinforcement on approximately 0.1% (2.5 SF) of its surface area (see Photo 27). A cold joint similar to the one on the west abutment is present on the east abutment as well and exhibits efflorescence, rust staining, and water staining (see Photo 33). A large sediment deposit is present on the abutment seat in bay 20 (see Photo 29).

Approaches:

The bridge utilizes standard 30'-0" approach slabs on all four corners. The approach slabs are 50'-2" wide, set on a 42 degree skew, forward on the left, similar to the superstructure. Hairline cracking is present on the north west approach slab (see Photo 51) and near the transverse joint on the south west approach slab (see Photo 49). The asphalt shoulders on all four corners of the bridge are in poor condition with potholes and severe cracking (see Photo 48).

Joints:

The transverse joints are in poor condition overall. Approximately 12.5% of the transverse joint at the west end of the east bound side is missing (see Photo 49). The bottom steel plates and anchor bolts are fully exposed at this location. Due to the dip caused by these missing joint sections, the concrete on the deck shows abrasion damage due to traffic impact.

Similar gaps in the transverse joint are present on the west end of the west bound side (see Photo 50). Approximately 4 ft of the joints is completely missing including the bottom steel plate. Similar abrasion damage to the concrete is present at this location but on the approach slab side.

The longitudinal joint most likely has perforations as evidenced by the presence of water on the abutment seats directly beneath them (see Photo 32).

Bearings:

The bearings are in satisfactory condition. They consist of elastomeric expansion bearings (assembly Type 1) which rest directly on the concrete surface at the abutments and piers (see Photo 28). Minor corrosion is present on the bearings over the abutments at 34 locations, mostly in the top plates (see Photos 10, 12, 28, & 36).

Drainage System:

The drainage system consists of 6 (six)- 6 inch diameter deck drains on the south ends of both the east bound and west bound structures, three at each end (see Photo 53). The deck drain down spouts empty directly onto the slopewalls. The drainage system is performing satisfactorily at deck level and with no defects or debris found (see Photo 54). However, the top of deck is susceptible to ponding of water at various locations (see Photo 2).

A drain trough was originally included at the base of the slope walls. On the eastside, this trough was covered up with a new sidewalk during the rehabilitation/widening project. Due to settlement and cracking of the interior slopewall panels, silt and mud from the backfill is not contained. This silt and mud is carried to the sidewalk and roadway by the drainage from the deck drain down spouts above. A local resident stated that from time to time, maintenance personnel collect this mud and place it on the southeast embankment (see Photo 44). A large amount of debris is present at the base of the west slopewall as well (see Photo 3).

Railings:

The railings consist of 32" standard slipform concrete parapets on the north and south ends. At the median, two parapets are set back to back with a 1½" expansion joint between them. On the north end of the south structure is a standard 32" concrete parapet. On the south end of the north structure is a non-standard 45" concrete parapet.

Overall, the parapets are in good condition. The only defects present are thermal expansion cracks at the base of the vertical expansion joints.

Utilities:

Overhead lines cross S. Madison St. on the north end (see Photo 42). An electrical pole is present to the south side of the bridge, on the east side of S Madison Rd (see Photo 45). Record plans show an opening for embedded conduit in the base of the 32" parapet at the longitudinal joint.

Adjacent Land Use:

A wide, unoccupied space is present to the northwest of the bridge with a warehouse on the north side of Joliet Road (see Photo 42). Overhead electrical lines and a 7-11 sign are present on the corner of this unoccupied space. The lot to the northeast of the bridge is occupied by a restaurant (see Photo 43). A large blank unoccupied space is present to the southeast of the bridge (see Photo 44). A similar space is present on the southwest corner of the bridge (see Photo 45).

Other Issues:

A timber tie-back wall is present on the northeast corner of the bridge. The wall is approximately 6'-8" tall at its highest point and 45' long (see Photo 46). The wall retains the embankment above the east sidewalk starting at the north end of the east slopewall. The wall exhibits deterioration on a few of its top members (see Photo 47) and has exposed and deteriorated deadman members behind it. This wall is considered an incidental structure to the bridge and is in fair condition overall. No tilting or bowing of the wall is currently observed.

A chain link fence surrounds the abutments on both sides of the bridge. This fence is a continuation of the chain link fence that runs along I-55 (see Photo 55). At this time there are no locks on the gates at the access points for the abutments.

Bird spikes are present on the top of the pier caps as well as the tops of the bottom flanges on every girder for the length of the sidewalk (see Photo 7).

Concrete slopewalls are present on both sides of the bridge, starting approximately 7'-6" away from each abutment and extending to the sidewalk elevation at a slope of 2:1. Repairs to the slopewalls were included in the 1996 repair work. Separation of the slopewall from the abutment, approximately 3.5" wide, is noted at the east abutment (see Photo 30). Faulting of the concrete slope wall panels is present on the west end, with a maximum offset of 4 inches (see Photo 38).

The east approach guardrail on S Madison St. shows impact damage (see Photo 55). The rail is completely detached from one of the wood posts and loosely hanging on to the wood post on the end. This is not maintained by IDOT and is the responsibility of the local municipality.

IV. Evaluation

The bridge is in fair condition overall. Bloom found the following defects on the deck, superstructure, and substructure:

- Delamination on 4 SF of the west abutment and 2.5 SF of the east abutment.
- Spalling and delamination requiring 415 SF of repair on pier 1.
- Spalling and delamination requiring 450 SF of repair on pier 2.
- Spalling and/or delamination at the ends of girders at 23 locations.

- Hairline cracking and efflorescence on the underside of the deck.
- Hairline cracking on the top of deck.
- Missing sections in the transverse expansion joints.

Other, non-structural defects were noted including the presence of large deposits of silt/debris on abutment seats and at the base of the slopewalls, minor faulting of slopewall panels, and water and rust staining.

V. Recommended Scope of Work

Evaluations of various potential scopes of work were considered based on structural deficiencies, safety to traffic and pedestrians, and site conditions. No geometric evaluation was performed. While investigating alternatives, consideration was given to cost, construction requirements, and safety.

The recommended priority repairs include the following:

- Remove and replace transverse expansion joints on all four approaches.
- Scarify concrete deck and install new concrete overlay across entire bridge.
- Remove loose concrete and perform concrete repairs on the piers and abutments.
- Repair ends of prestressed concrete girders by cleaning and painting strands.
- Repair approach shoulders on top of deck.

Since the expansion joints need to be replaced, a concrete overlay should be installed at the same time. The deterioration at the ends of the prestressed concrete girders has not progressed to the point where bearing has been substantially reduced. Bloom recommends repairing the ends of the girders by cleaning and painting the exposed strands. With the installation of new expansion joints, these areas should remain dry after repairs have been completed.

The concrete repair on the pier caps is mainly overhead so shotcrete concrete repair is recommended for those areas. Hydro-demolition is one option to remove loose concrete which will also clean the rusted rebar and remove chlorides, but standard demolition can also be performed. For smaller pockets of spalling, concrete mortar repair is recommended.

For repairs to the substructure, S Madison St. will have to have traffic reduced to one lane. Bloom recommends a 4 weekend lane closure program. Removal of concrete on the defect areas on piers 1 and 2 will be performed in weeks 1 and 2, respectively. Then shotcrete repairs will be performed on piers 1 and 2 in weeks 3 and 4, respectively. The work area should be protected using temporary concrete barriers and temporary attenuators. Work on the top of deck which includes pouring a concrete overlay and replacing the expansion joints will also require temporary concrete barriers and will follow a similar staged schedule.

These repairs would cost an estimated \$1,076,993.00

Secondary items to consider address non-structural issues. These are considered supplemental to the priority items and are as follows:

- Clean up debris at the base of the west slopewall.
- Perform epoxy crack injection for cracks $\frac{1}{8}$ " or larger on slopewall.
- Fill voids in slopewall caused by faulting of panels.

- Install drainage trough at the base of the east slopewall.
- Replace splitting wood members on the timber tie-back wall.

These secondary items would cost an estimated \$26,689.00

Attachment A: Location Map

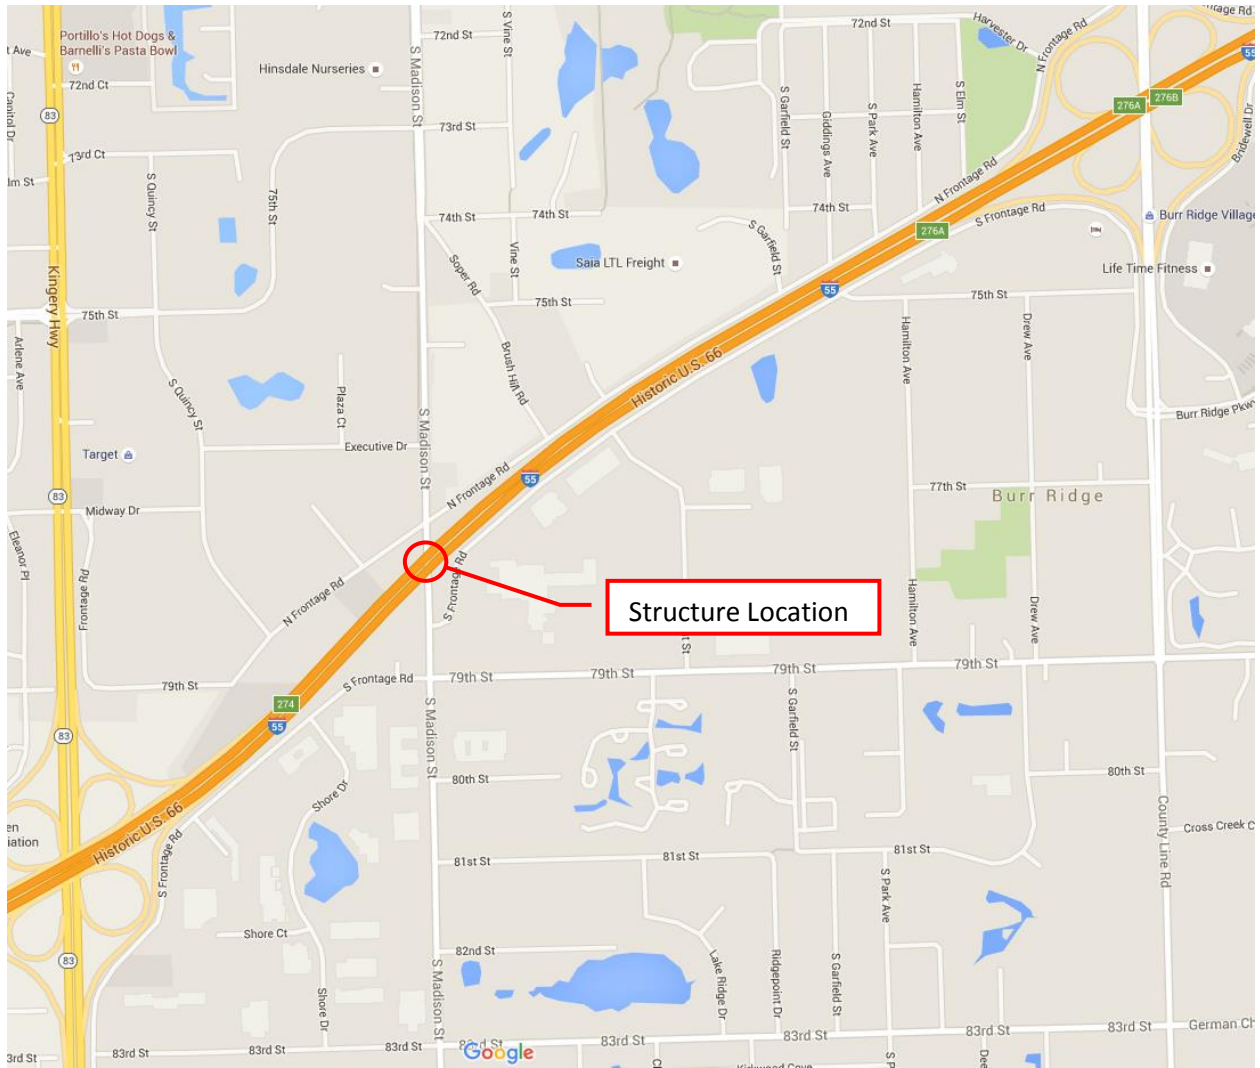


Image from Google. Map Data: ©2016 Google

Attachment B:
IDOT Master Structure Report

**Illinois Department of Transportation
Structures Information Management System
Structure Summary Report**

Date: 08/31/2015

Page: 1

Structure Number: 022-0003

District: 1

Inventory Data

Facility Carried: I- 55	Bridge Name:	Sufficiency Rating: 96.0	Structure Length: 172.0
Feature Crossed: MADISON ST	Location: 0.6 M NE OF IL 83	HBP Eligible: No	AASHTO Bridge Length: 99.9
Bridge Remarks: MAX.= 64' ORIGINALLY TWO STRUCTURES.		Replaced By: -	Length of Long Span: 57.5
Bridge Status: 1 OPEN - NO RESTRICT	Status Date: 04/1988	Replaces: -	Bridge Roadway Width: 134.0
Status Remarks:		Last Update Date: 07/05/2012	Appr Roadway Width: 134.0
Maint County: 022 DUPAGE	Maint Township: 03 DOWNERS GROVE	Parallel Structure: None	Deck Width: 140.3
Maint Responsibility: 01 I.D.O.T.		Multi-Level Structure Nbr:	Sidewalk Width Right: 0.0
Service On/Under: 1 HIGHWAY	1 / HIGHWAY	Skew Direction: L	Sidewalk Width Left: 0.0
Reporting Agency: 1 I.D.O.T. - BUREAU OF MAINTENANCE		Skew Angle: 42 D	Navigation Control: N N/A
Main Span Matl/Type: 6 PRESTRESS CONCRETE CONTINUOUS / 02 STRINGER/MULTI-BEAM/GIRDER		Structure Flared: No	Navigation Horiz Clear: 0
Nbr Of Main Spans: 3	Nbr Of Approach Spans: 0	Historical Significance: No	Navigation Vert Clear: 0
Approaches		Border Bridge State:	Culvert Fill Depth: 0.0
Near #1 Matl/Type: /		Bdr State SN:	Number Culvert Cells: 0
Near #2 Matl/Type: /		Bdr State % Responsibility: 0	Culvert Opening Area: 0.0
Far #1 Matl/Type: /		Structural Steel Wt 0	Culvert Cell Height: 0.00
Far #2 Matl/Type: /		Substructure Material:	Culvert Cell Width: 0.00
Median Width/Type: 3 Ft. / 4 Wall		Rated By: 2 IDOT	Rate Method: 6
Guardrail Type L/R: 0None / 0 None	Inventory Rating: 1.635(58)	Load Rating Date: 07/08/1997	Railroad Crossing Info
Toll Facility Indicator: 0 No Toll	Operating Rating: 2.635(94)		Crossing 1 Nbr:
Latitude: 41.74726236	S Longitude: 87.93512738	Design Load: 01 HS20+MOD	Crossing 1 Nbr:
Deck Structure Type: A CIP CON NRMLLY FORM	Deck Structure Thickness: 7.5	SD: N FO: N	RR Lateral Underclear: 0.0
Sidewalks Under Structure: 0 None			RR Vertical Underclear: 0 Ft 0 In

Key Route On Data

Key Route Nbr: FEDERAL-AID INTERSTATE 0055	Station: 5.6900
Appurtenances Main Route 00000	Segment:
Inventory County: 022 DUPAGE	Linked: Y
Township/Road Dist 03 DOWNERS GROVE	Natl. Hwy System: On NHS
Municipality 6240 WILLOWBROOK	Inventory Direction:
Urban Area: 1051 1051	Curr AADT Yr/Count: 2014 / 158400
Functional Class: 1 INTERSTATE	Est Truck Percentage: 11
** CLEARANCES ** South/East North/West	Number Of Lanes: 6
Max Rdwy Width: 67.1	One Or Two Way: 2 Two-Way
Horizontal: 68.3 68.3	Bypass Length: 0
	Future AADT Yr/Cnt: 2032 / 194950
	Designated Truck Rte: CLASS I
Lateral:	Special Systems: Yes

Key Route Under Data

Key Route Nbr: FEDERAL-AID URBAN 2674	Station: 4.8900
Appurtenances Main Route 00000	Segment:
Inventory County: 022	Linked: Y
Township/Road Dist 03 DOWNERS GROVE	Natl. Hwy System: Not on NHS
Municipality 0759 BURR RIDGE	Inventory Direction:
Urban Area: 1051 1051	Curr AADT Yr/Count: 2012 / 2850
Functional Class: 5 MAJOR COLLECTOR	Est Truck Percentage: 3
** CLEARANCES ** South/East North/West	Number Of Lanes: 2
Max Rdwy Width: 25.5	One Or Two Way: 2 Two-Way
Horizontal: 33.0 0.0	Bypass Length: 0
	Future AADT Yr/Cnt: 2032 / 2785
	Designated Truck Rte: NONE
Lateral:	Special Systems: No

***** Marked Route On Data *****

Designation	Kind	Number
Route #1: 1 Mainline	1 Interstate Highway	055
Route #2: 1 Mainline		
Route #3: 1 Mainline		

***** Marked Route Under Data *****

Designation	Kind	Number
1 Mainline	8 Other	
1 Mainline		
1 Mainline		

**Illinois Department of Transportation
Structures Information Management System
Structure Summary Report**

Date: 08/31/2015

Page: 2

Structure Number: 022-0003

District: 1

Data Related to Inspection Information

*** Inspection Intervals ***		*** Maximum Allowable Posting Limits ***				Bridge Posting Level:	
Routine NBIS:	24 MOS	Underwater:	0 MOS	One Truck At A Time:	0	Combination Type 3S-1:	Tons
		Special:	N	Single Unit Vehicles:	Tons	Combination Type 3S-2:	Tons
							5 No Posting Required

Inspection/Appraisal Information

Inspection Date:	11/21/2013	Inspection Temperature:	50Deg. F	** Actual Posted Limits **			
Deck:	7	GOOD CONDITION - SOME MINOR PROBLEMS				Single Unit Vehicles:	Tons
Superstructure:	6	SATISFACTORY CONDITION - MINOR DETERIORATION				Combination Type 3S-1:	Tons
Substructure:	6	SATISFACTORY CONDITION - MINOR DETERIORATION				Combination Type 3S-2:	Tons
Culvert:	N	NOT APPLICABLE				One Truck At A Time:	0
Channel and Protection:	N	NOT APPLICABLE				Deck Wearing Surf:	A BARE DECK NO OVRLAY
Structural Evaluation:	6	EQUAL TO PRESENT MINIMUM CRITERIA				Deck Membrane:	F NONE
Deck Geometry:	9	SUPERIOR TO PRESENT DESIRABLE CRITERIA				Deck Protection:	A EPOXY COATED REINF
Underclearance-Vert/Lat.:	4	MINIMUM ADEQUACY TO BE LEFT IN PLACE				Total Deck Thick:	7.5
Waterway Adequacy:	N	NOT APPLICABLE				Last Paint Date:	
Approach Roadway Align:	8	EQUAL TO PRESENT DESIRABLE CRITERIA					
Bridge Railing Appraisal:	3	Meets Standards					
Approach Guardrail:	233	Not Acceptable	Acceptable	Acceptable			
Pier Navig Protection:	N	N/A					

Underwater Inspection/Appraisal Information

Inspection Date:		Inspection Method:		Appraisal Rating:	
Temperature:					

Scour Critical Information

Miscellaneous

Rating:		Evaluation Method:		Microfilm Data Recorded:	Yes
Analysis Date:					

Construction Information

Year:	1959	Original	1996	Reconstructed
Route:	FAI-55	Sta: 1023+92.08	FAI-55	Sta: 1023+92.08
Section Nbr:	22-1HB-1		22-1HB-1	
Contract Nbr:			82453	
Fed Aid Pr#:	I 0036005000		NHI556(197)270	
Built By:	1 I.D.O.T.		1 I.D.O.T.	

Attachment C:

Record Plans

FWD 35

ROUTE NO.	SECTION	COUNTY	TOTAL SHEETS	SHEET NO.
F.A.I. RTE 03	22-115-1	DUPAGE	17	2
STA.	TO STA.			
100' ROADWAY NO. 7 NUMBER 1 F.A. PROJECT				



INDEX OF SHEETS

SHEET NO.	TITLE
1	TITLE SHEET
2	GENERAL PLAN AND ELEVATION
3	BORINGS, NAME PLATES, NOTES, SUMMARY OF QUANTITIES
4	BRIDGE LAYOUT AND DECK PLAN
5	DECK REINFORCEMENT PLAN
6	DECK CROSS SECTIONS
7	DETAILS OF PRECAST PRESTRESSED CONCRETE I-BEAMS
8	FRAMING PLAN, BEARING DETAILS AND EXPANSION DEVICE
9	HANDRAIL DETAILS
10	EAST AND WEST ABUTMENT AND WINGWALL DETAILS
11	EAST AND WEST ABUTMENT AND WINGWALL DETAILS
12	PIERS 1 AND 2
13	REINFORCEMENT BAR LISTS
14	ABUTMENT PILES
15	ROAD PLAN AND PROFILE
16	SPECIAL CULVERT DESIGNS STA. 1024+32, STD. 2124R
17	STANDARDS 2113, 1971S AND 1972R

NOTE:
 AT EACH ABUTMENT
 (1) DRIVE TEST FILE
 (2) CONSTRUCT EMBANKMENT AS SHOWN
 (3) DRIVE REMAINDER OF PILES THROUGH EMBANKMENT. SEE SPECIAL PROVISIONS

ELEVATIONS AT BOTTOM OF ABUTMENTS AND WINGWALLS

W. ABUTMENT	ELEV.	E. ABUTMENT	ELEV.
W. BRIDGE	72113	W. BRIDGE	72393
S. BRIDGE	72412	S. BRIDGE	72408

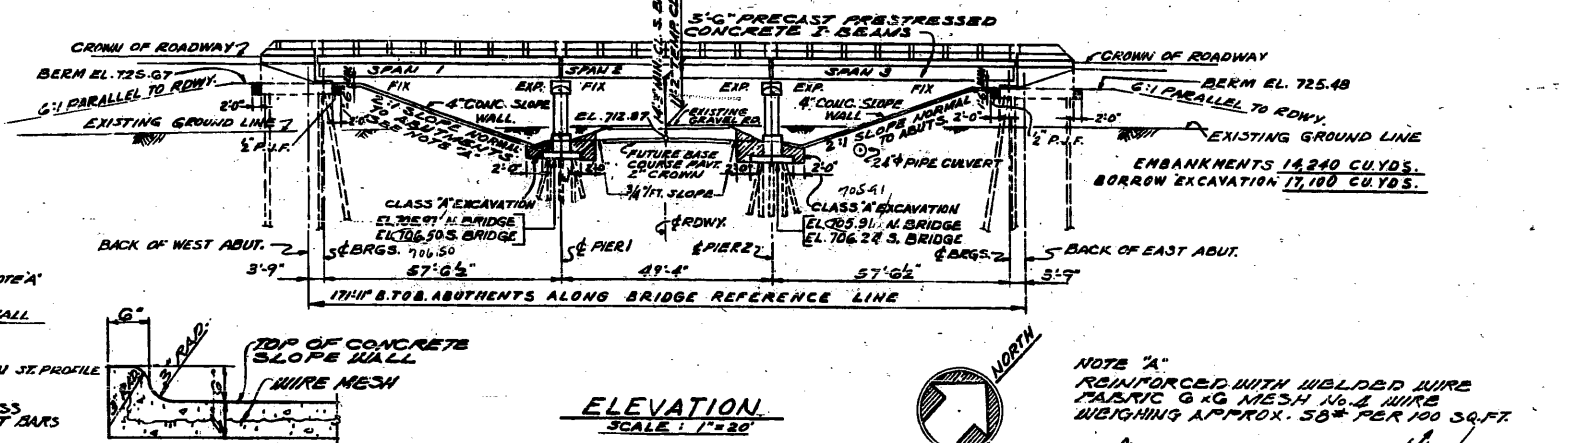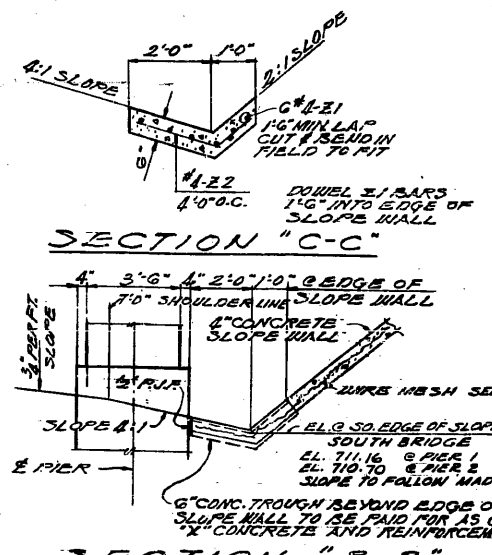


ELEVATION
SCALE: 1"=20'

BILL OF MATERIAL-CONCRETE TROUGHS

ITEM	UNIT	TOTAL
CLASS 'X' CONCRETE	CUYD.	11.0
REINFORCEMENT BARS	LBS.	960

SECTION 'A-A'
THRU EDGE OF CONCRETE SLOPE WALL

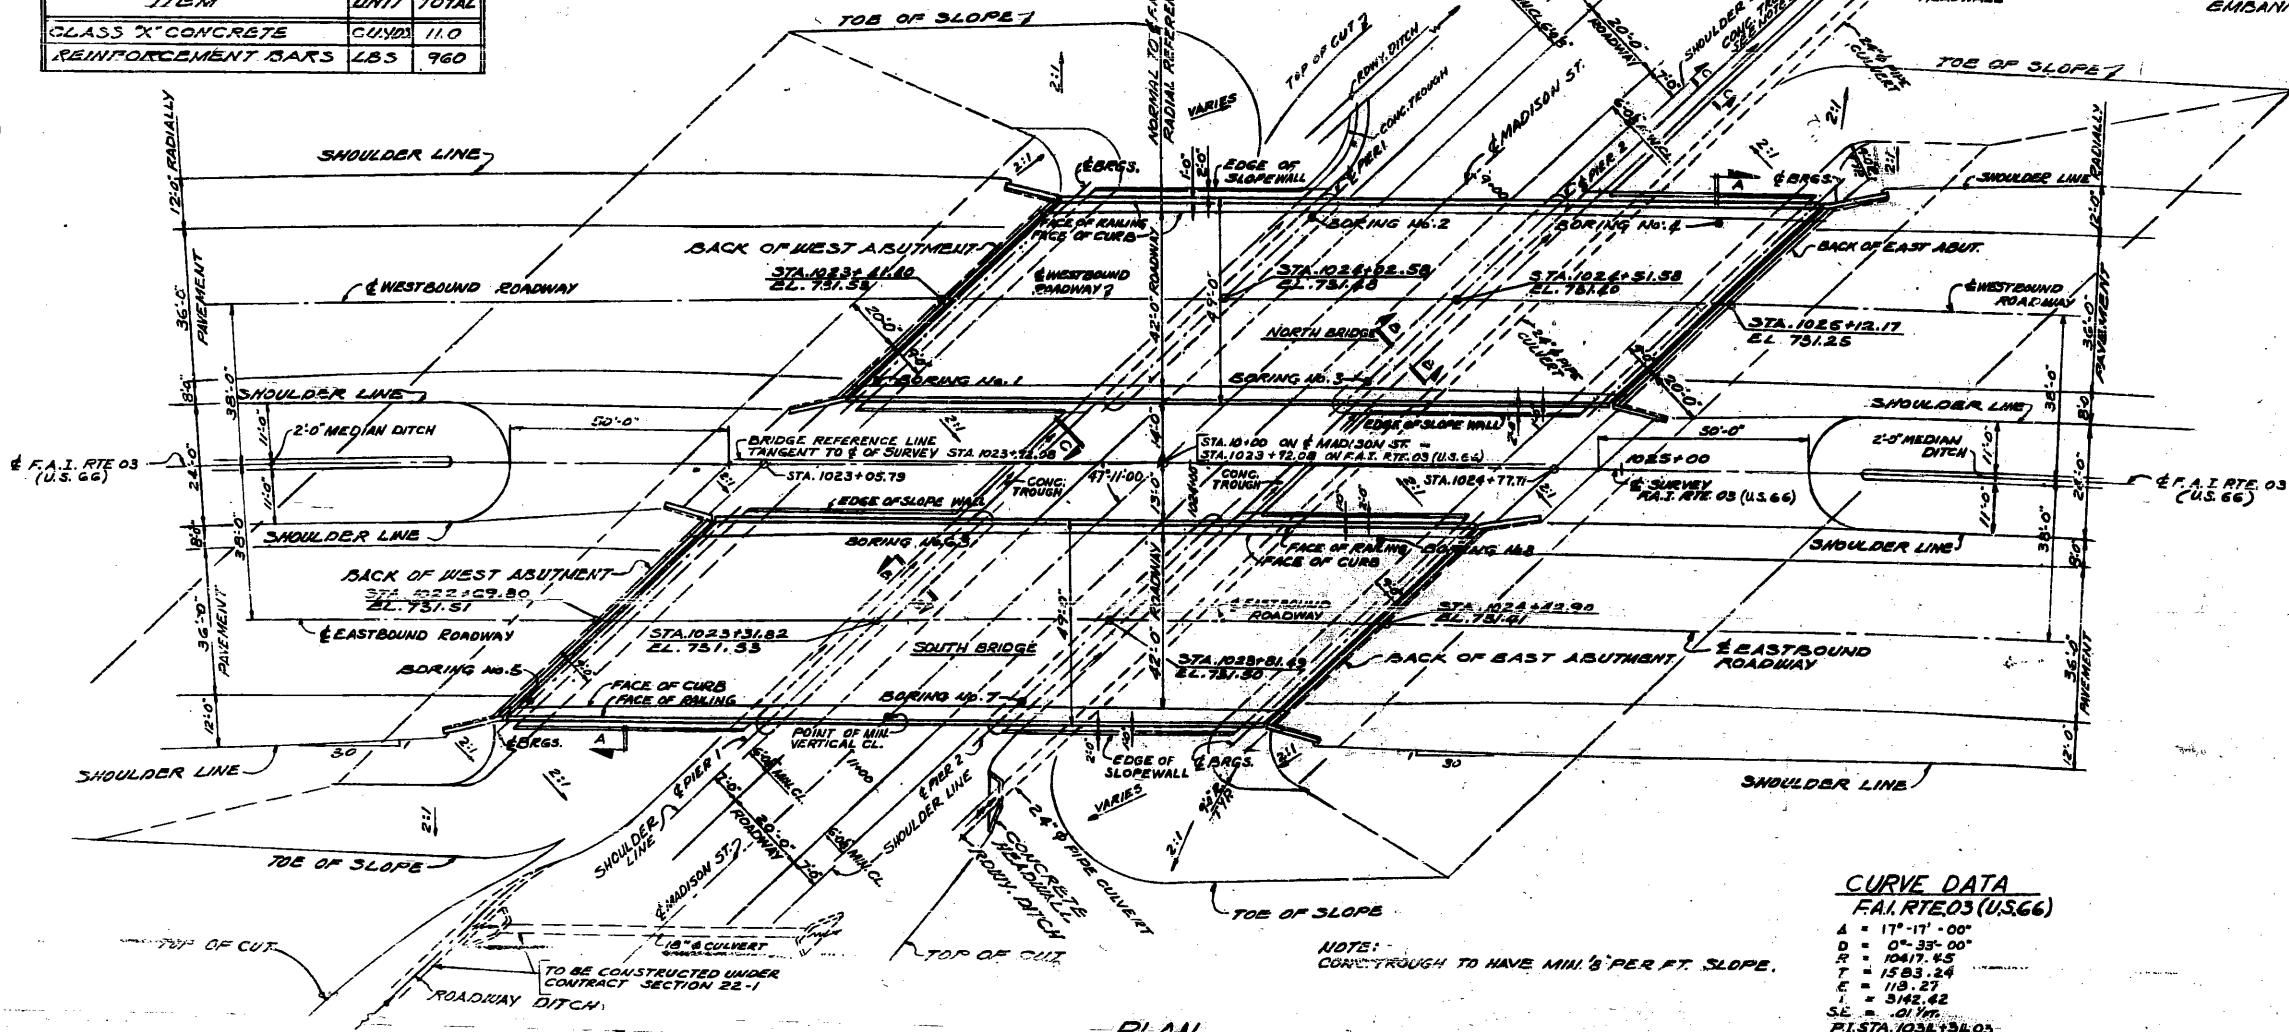

PLAN
SCALE: 1"=20'

DESIGN LOAD

- LL - H20-S16 - 44' ALTERNATE
- FUTURE O.L. - 15' BIT WEARING SURFACE
- DESIGN STRESSES**
- CONCRETE (CAST IN PLACE)**
- f_c = 3,500 LBS. PER SQ. IN.
- f_c = 1,400 LBS. PER SQ. IN.
- f_c = (WITH EARTH PRESSURE) 1,000 LBS. PER SQ. IN.
- v = (PER FOOTING) 75 LBS. PER SQ. IN.
- PRESTRESSED CONCRETE**
- f_c = 5,000 LBS. PER SQ. IN.
- f_{cs} = 4,000 LBS. PER SQ. IN.
- f_c = 2,000 LBS. PER SQ. IN.
- REINFORCING STEEL**
- f_s = 20,000 LBS. PER SQ. IN.
- PRETENSIONING STEEL**
- f_{su} = 240,000 LBS. PER SQ. IN.
- f_{st} = 175,000 LBS. PER SQ. IN.
- PILE LOADS**
- ABUTMENTS = 35 TONS (CONCRETE PILES)
- WINGWALLS = 10 TONS (TIMBER PILES)
- PIERS = 20 TONS (TIMBER PILES)
- ROAD CLASSIFICATION**
- INTERSTATE
- DESIGN SPEED**
- 70 M.P.H.


CURVE DATA
F.A.I. RTE 03 (U.S. 66)

- A = 17'-17'-00"

NOTE:
CONCRETE TROUGH TO HAVE MIN. 1/8" PER FT. SLOPE.

GENERAL PLAN & ELEVATION GRADE SEPARATION
U.S. ROUTE 66
OVER MADISON STREET
 F.A. PROJECT 1-03-G(5)
 F.A. ROUTE 03 SECTION 22-115-1
DUPAGE COUNTY
STATION 1023+92.08

ALFRED BENECH & ASSOCIATES CONSULTING ENGINEERS
 10 SOUTH WABASH AVENUE 507-2 CHICAGO, ILLINOIS

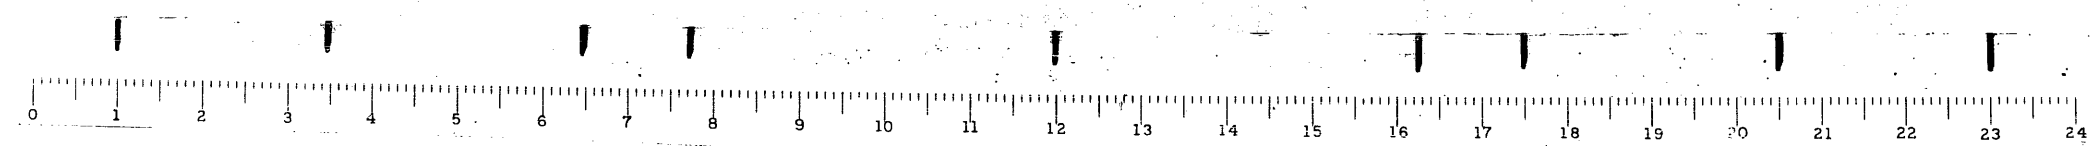


Bench Mark:
Top of existing Northeast Wingwall El. 734.38

Existing Structure: S.N. 022-0003 is a three span simple P.P.C. I-beam structure with a total length of 171'-11" and a total out to out width of 134 ft. The structure was constructed in 1959, rehabilitated and widened in 1978, under section 22.1HB-1

The road will be kept open at all times by utilizing stage construction. (See cross-section for staging and deck removal). No salvage.

STATION 1023+92.08
REBUILT 199
STATE OF ILLINOIS
F.A.I. RT. 55 SEC. 22-1HB-1
F.A. PROJECT NO.
LOADING HS20 & ALT.
STR. NO. 022-0003

NAME PLATE
See Std. 2113

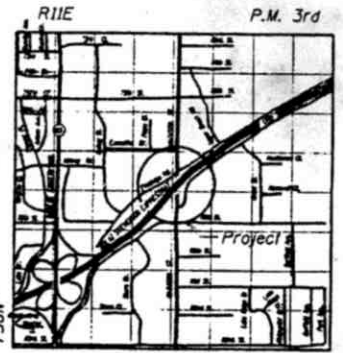

STATE OF ILLINOIS
DEPARTMENT OF TRANSPORTATION

WORK TO BE PERFORMED
The existing concrete deck is to be removed and replaced with a new concrete deck widened 3'-1" on each side. The structure is to be raised to provide 14'-6" minimum vertical clearance over Madison Street. The existing bearings are to be replaced with elastomeric type bearings and the simple span beams to be made continuous. Remove existing wing walls and replace as shown. Existing beams and diaphragms and substructure to be repaired and re-used except the beams added for the 1978 widening will be replaced. Concrete slope walls are to be repaired. Traffic to be maintained using staged construction.

DESIGN SPECIFICATIONS

1992 AASHTO, 1993 & 1994 Interims
LOADING HS20-44 & ALT.
Allow 25# / sq. ft. for future wearing surface

DESIGN STRESSES

FIELD UNITS
f'c = 3,500 psi
fy = 60,000 psi. (Reinf.)
fy = 36,000 psi. (M270 Grade 36)

EXISTING PPC UNITS

CONCRETE
f'c = 5,000 psi
f'ci = 4,000 psi

PRESTRESSING STEEL
fsu = 248,000 psi (1959 Constr.)
fsl = 173,600 psi (1959 Constr.)
Strands = 1/2" φ

NEW P.P.C. UNITS

CONCRETE
f'c = 5,000 psi
f'ci = 4,000 psi.
PRESTRESSING STEEL
f's = 270,000 psi.
f'si = 201,960 psi.
strands = 1/2" φ (Low Relaxation)

SEISMIC DATA


Seismic Performance Category (SPC) = A
Bedrock Acceleration Coefficient (A) = 0.04g
Site Coefficient (S) = 1.0

CURVE DATA

F.A.I. ROUTE 55
Δ = 17°-17'-00"
D = 0°-33'-00"
R = 10417.45'
T = 1583.24'
E = 118.27'
L = 3142.42'
SE = 0.015'/ft.
P.I. Sta. 1034+34.03

GENERAL NOTES

- All structural steel shall be shop painted with the inorganic zinc primer per AASHTO M300, Type I.
- Reinforcement bars shall conform to the requirements of AASHTO M-31, M-42 or M-53 Grade 60.
- Slope wall shall be reinforced with welded wire fabric, 6" x 6" - W4.0 x W4.0, weighing 58 lbs. per 100 sq. ft.
- Plan dimensions and details relative to existing structure have been taken from existing plans and are subject to nominal construction variations. It shall be the Contractor's responsibility to verify such dimensions and details in the field and make necessary approved adjustments prior to construction or ordering of materials. Such variations shall not be cause for additional compensation for a change in the scope of the work, however, the Contractor will be paid for the quantity actually furnished at the unit price bid for the work.
- The contractor shall drive one test pile in a permanent location of each abutment as directed by the Engineer before ordering the remainder of piles.
- Bridge Seat Sealer shall be applied to the seat area of the abutment extensions.



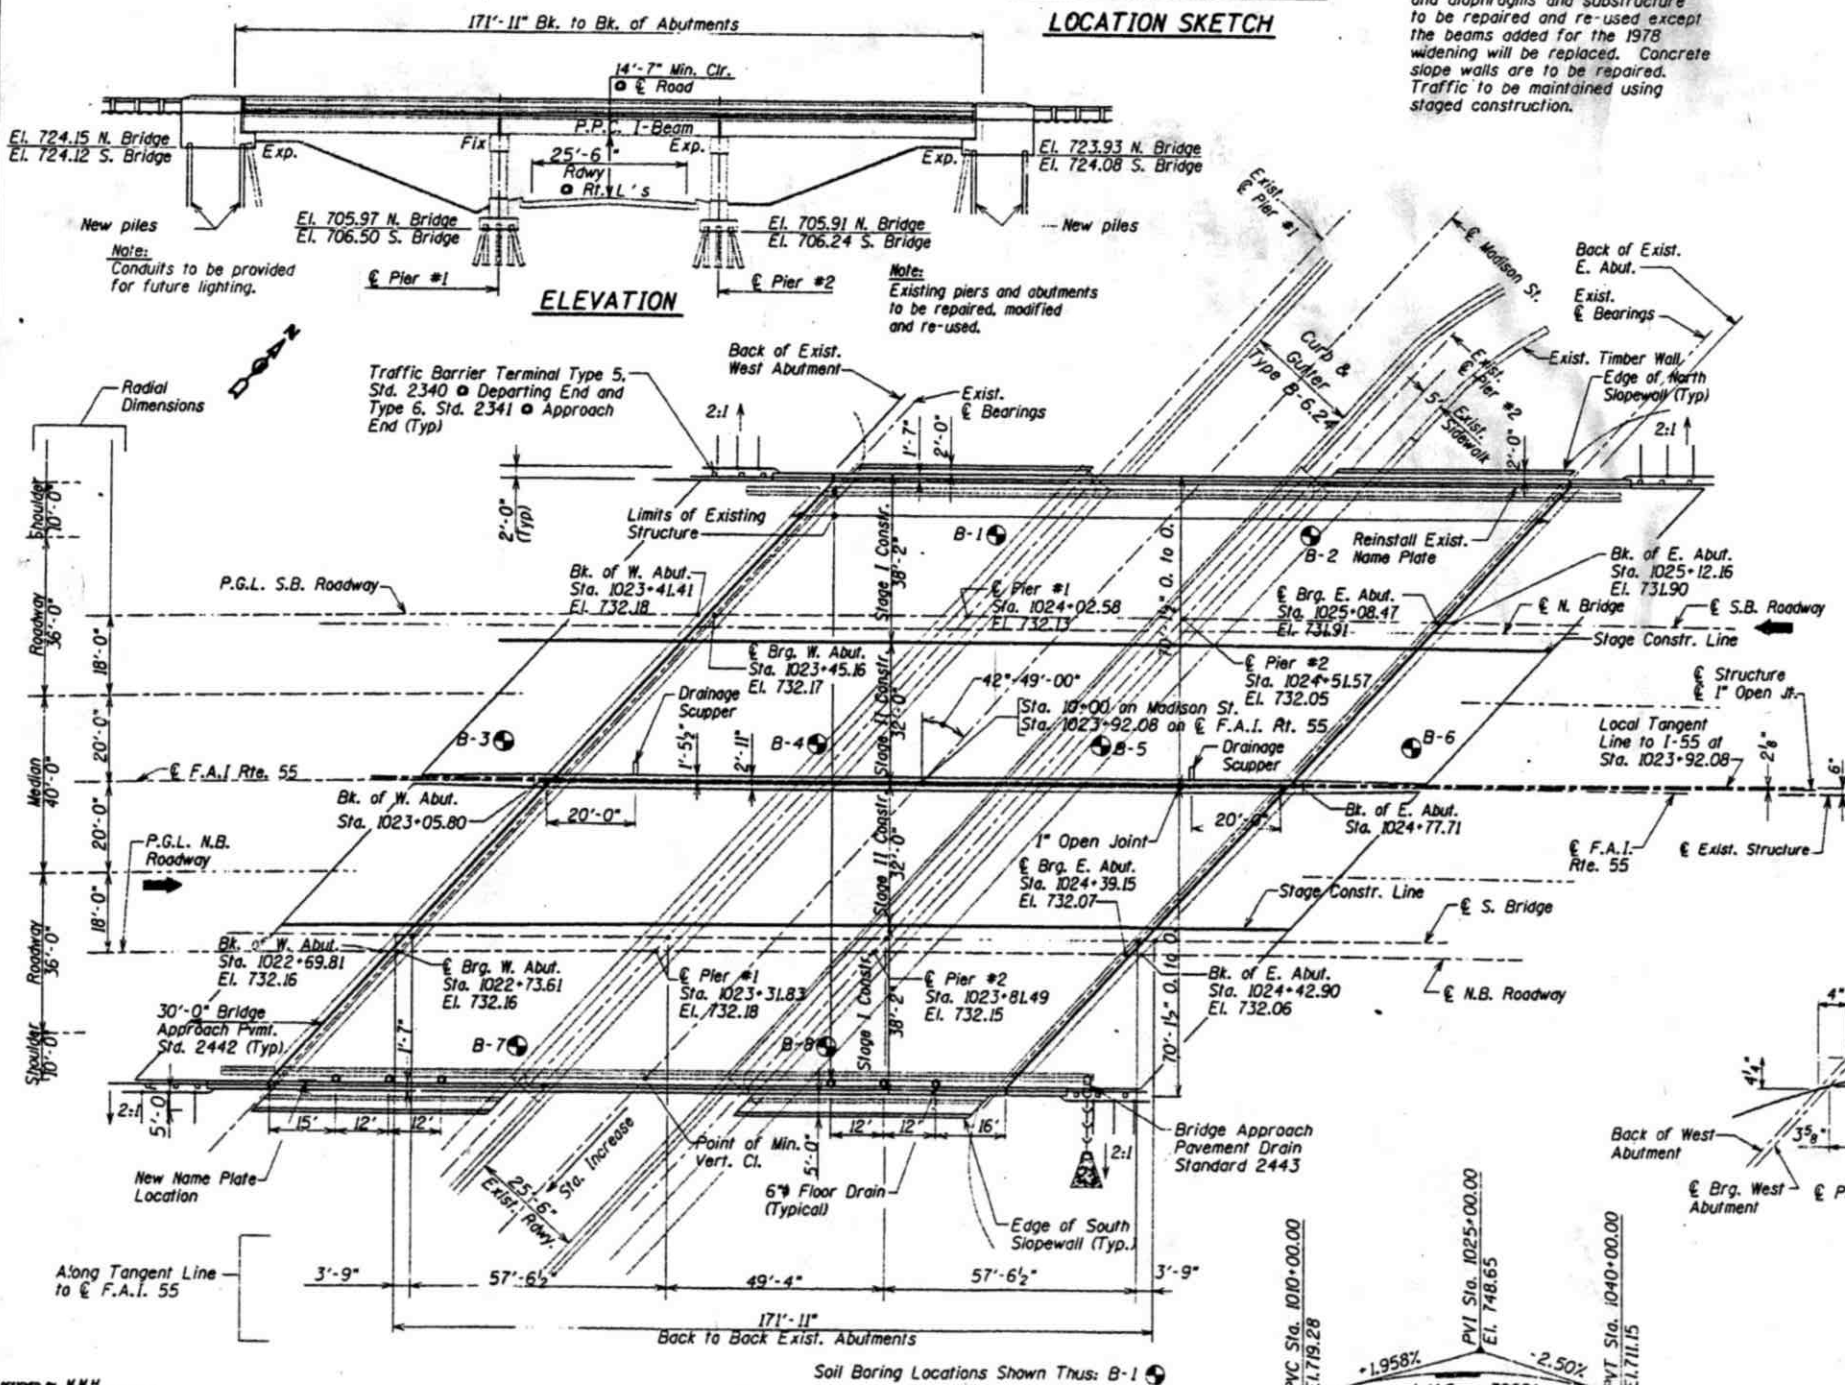


APPROVED
FOR STRUCTURAL ADEQUACY ONLY
Ralph E. Ostrom
Engineer of Bridges and Structures

10-20-95
DATE EXAMINED

11-30-96
MY LICENSE EXPIRES

Belton C. Ostrom
SIGNATURE

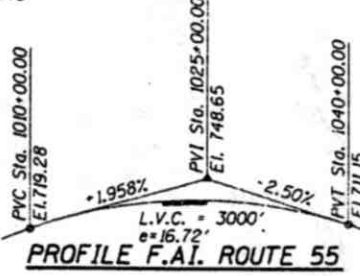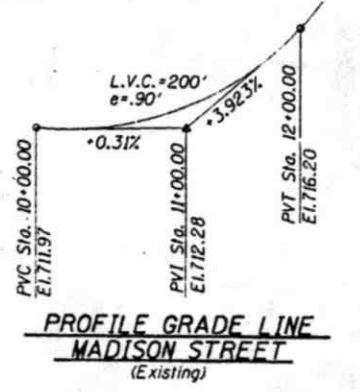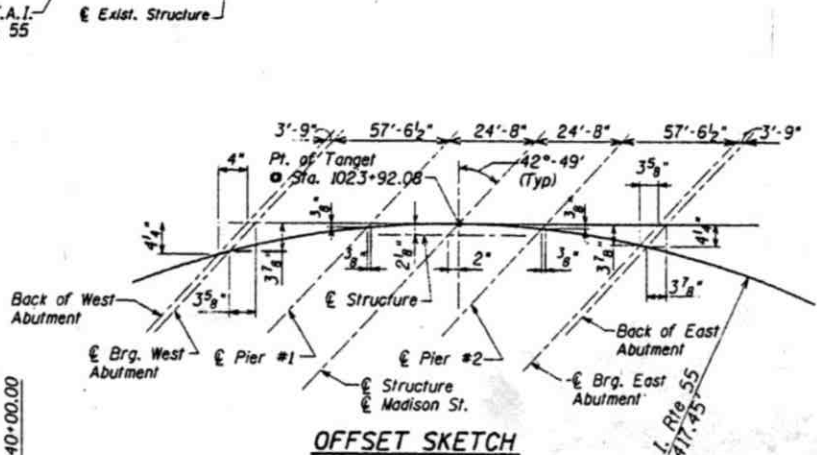

DESIGNED BY: M.M.H.
CHECKED BY: B.C.D.
DRAWN BY: J.G.S.
CHECKED BY: M.M.H.

NELSON OSTROM BASKIN BERMAN & ASSOC., INC.
CONSULTING ENGINEERS

REVISIONS	
NAME	DATE

SHEET 1 OF 32


ILLINOIS DEPARTMENT OF TRANSPORTATION
GENERAL PLAN AND ELEVATION
F.A.I. ROUTE 55 OVER MADISON STREET
DUPAGE COUNTY
F.A.I. RTE. 55 SECTION 22-1HB-1
STA. 1023+92.08 STRUCTURE NO. 022-0003

SCALE: VERT. _____
HORIZ. _____

DATE 11/20/95

Attachment D:

Field Sketches

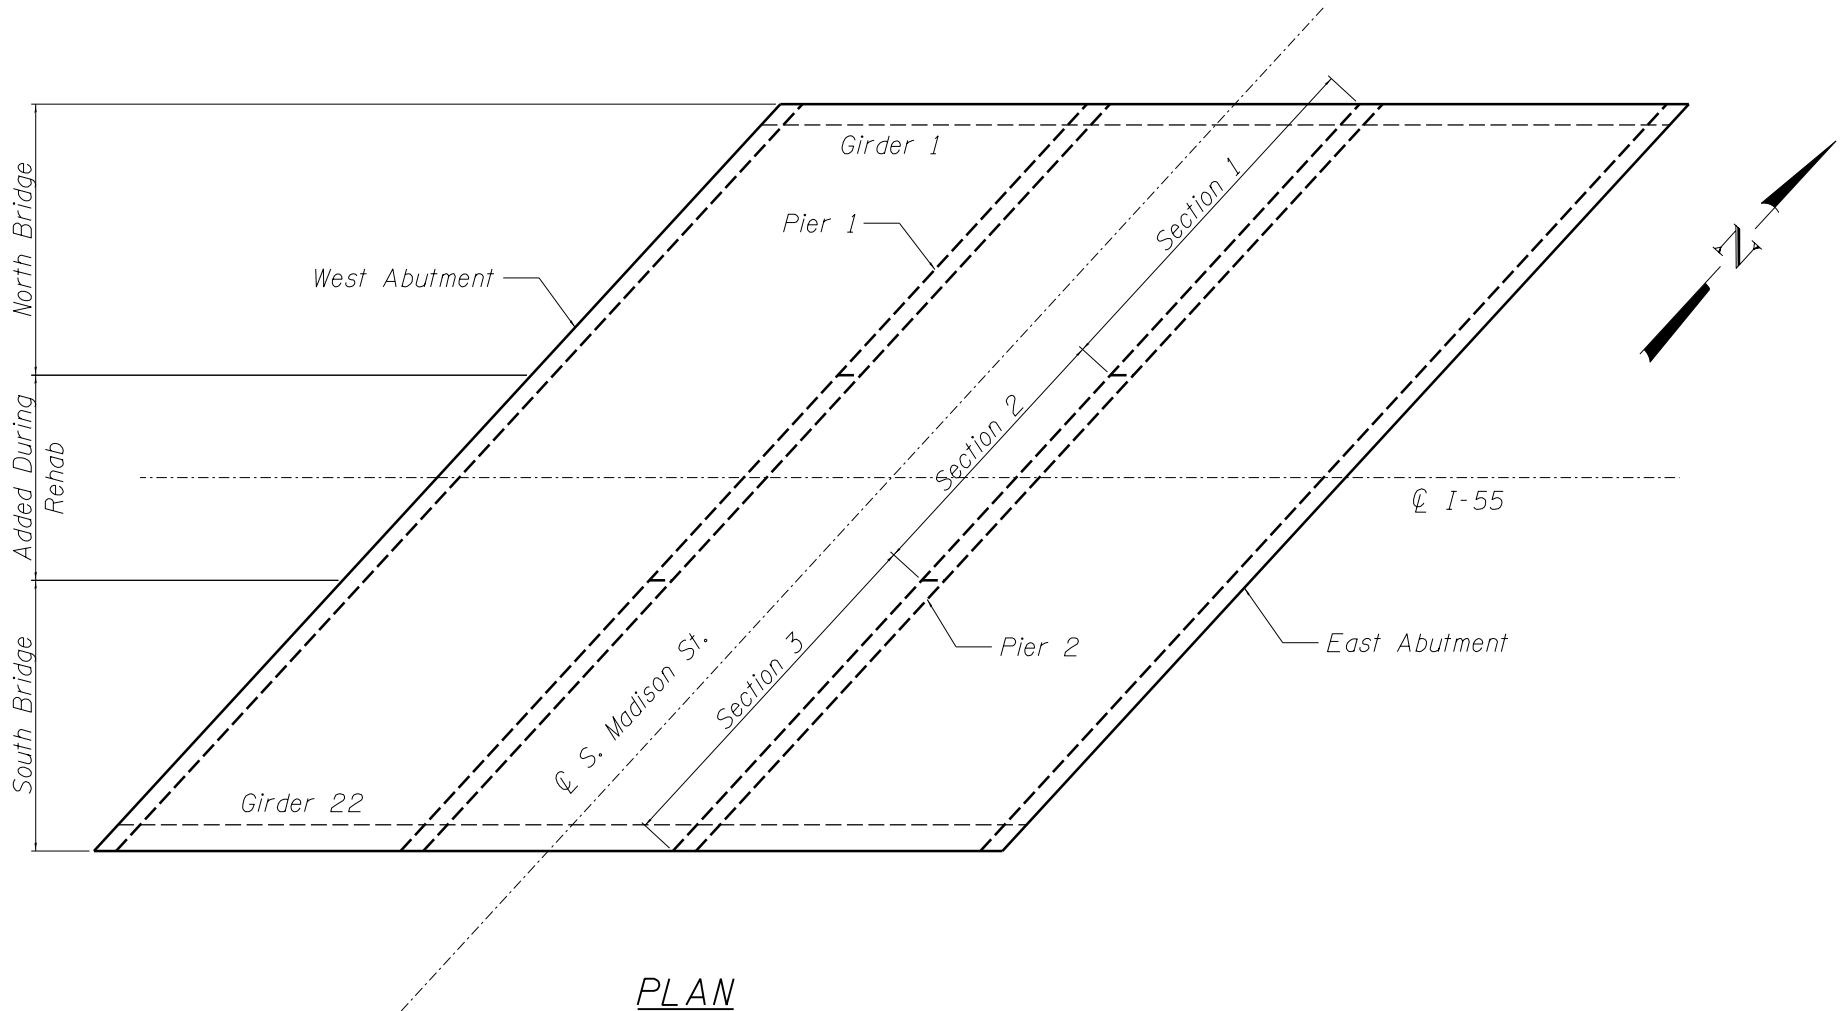


INSPECTOR	= RJO
INSPECTOR	= JA
INSPECTION DATE	= 5/5/2016

**ILLINOIS DEPARTMENT
OF TRANSPORTATION**

**I-55 OVER S MADISON ST
S.N. 022-0003
NAMING CONVENTION**

F:\3-1390_Var\EDIN\006_I55\Drawings\Exhibits\022-0003.dgn


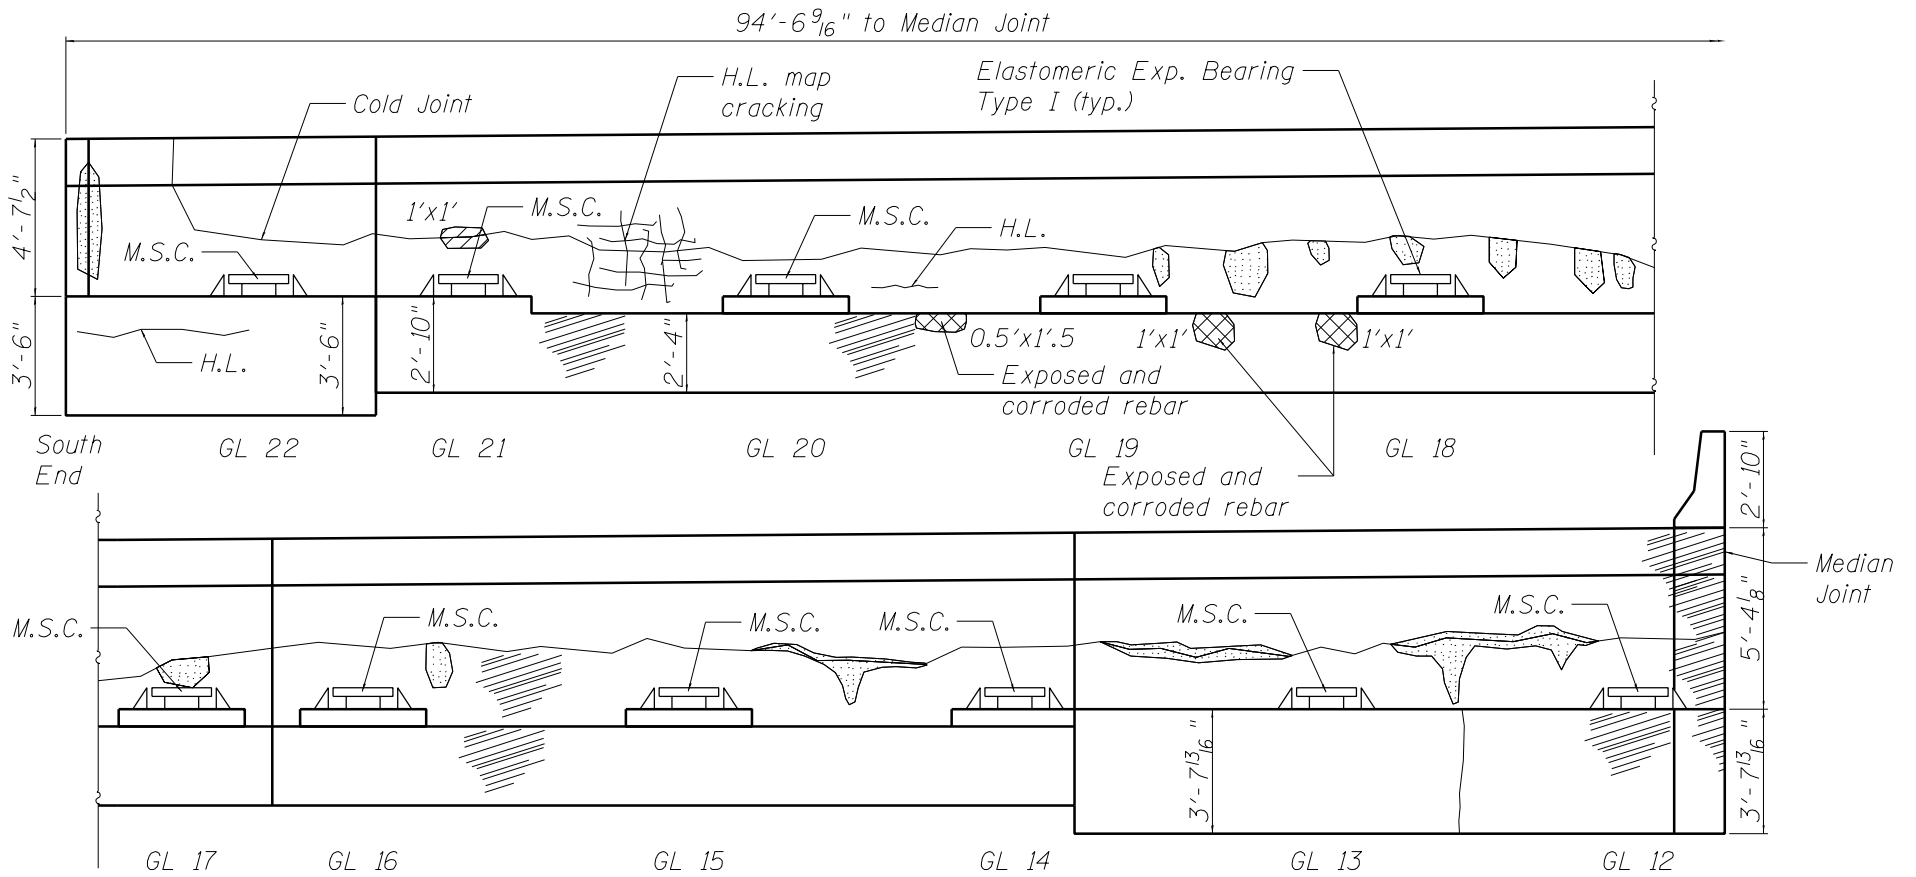


INSPECTOR = RJO
 INSPECTOR = JA
 INSPECTION DATE = 5/5/2016

**ILLINOIS DEPARTMENT
OF TRANSPORTATION**

**I-55 OVER S MADISON ST
S.N. 022-0003
WEST ABUTMENT FIELD SKETCH**

94'-6⁹/₁₆" to North End

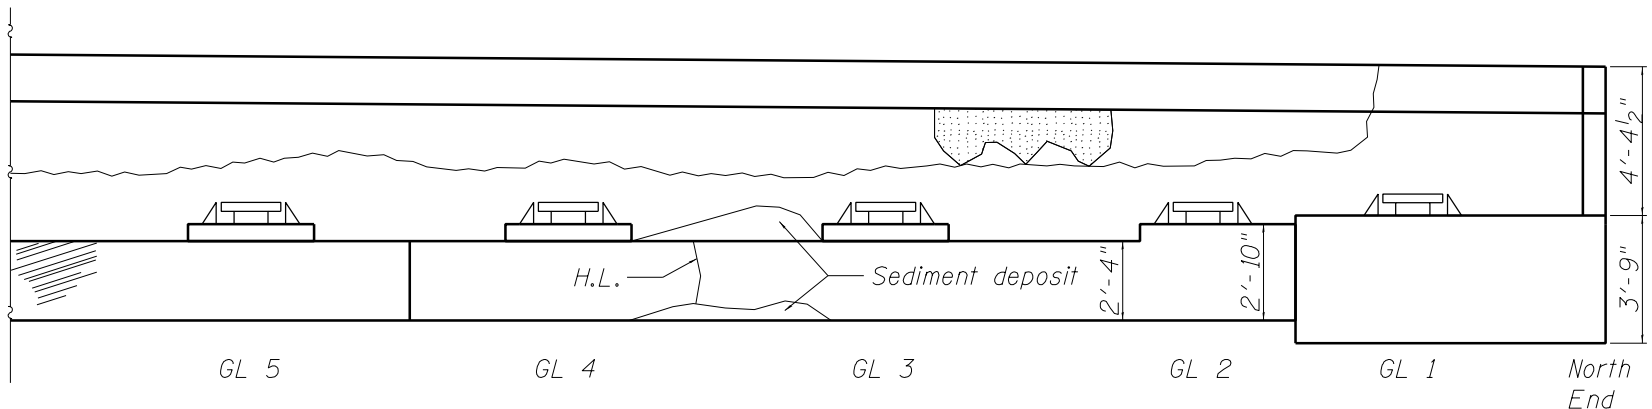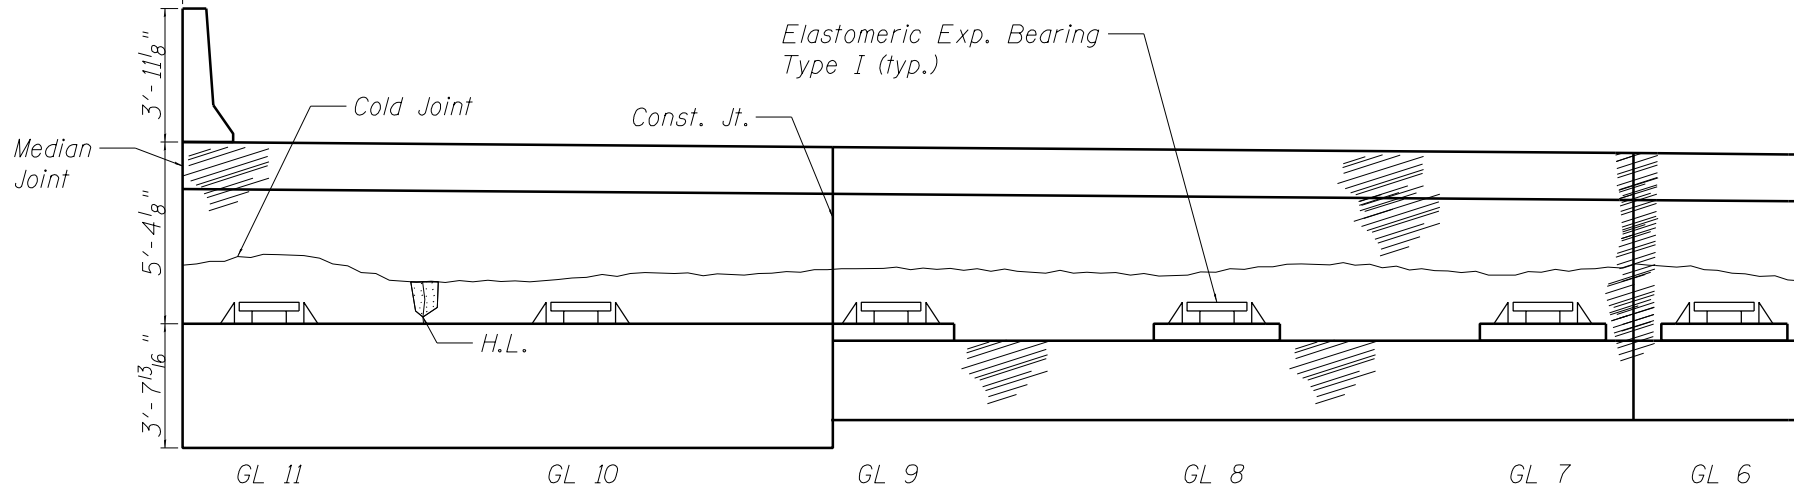

**WEST ABUTMENT
NORTH END ELEVATION**


H.L. - Hairline Crack
GL - Girder Line
M.S.C - Minor Surface Corrosion

	Spalling
	Delamination
	Efflorescence
	Water Staining

INSPECTOR	= RJO
INSPECTOR	= JA
INSPECTION DATE	= 5/5/2016

**ILLINOIS DEPARTMENT
OF TRANSPORTATION**

**I-55 OVER S MADISON ST
S.N. 022-0003
WEST ABUTMENT FIELD SKETCH**

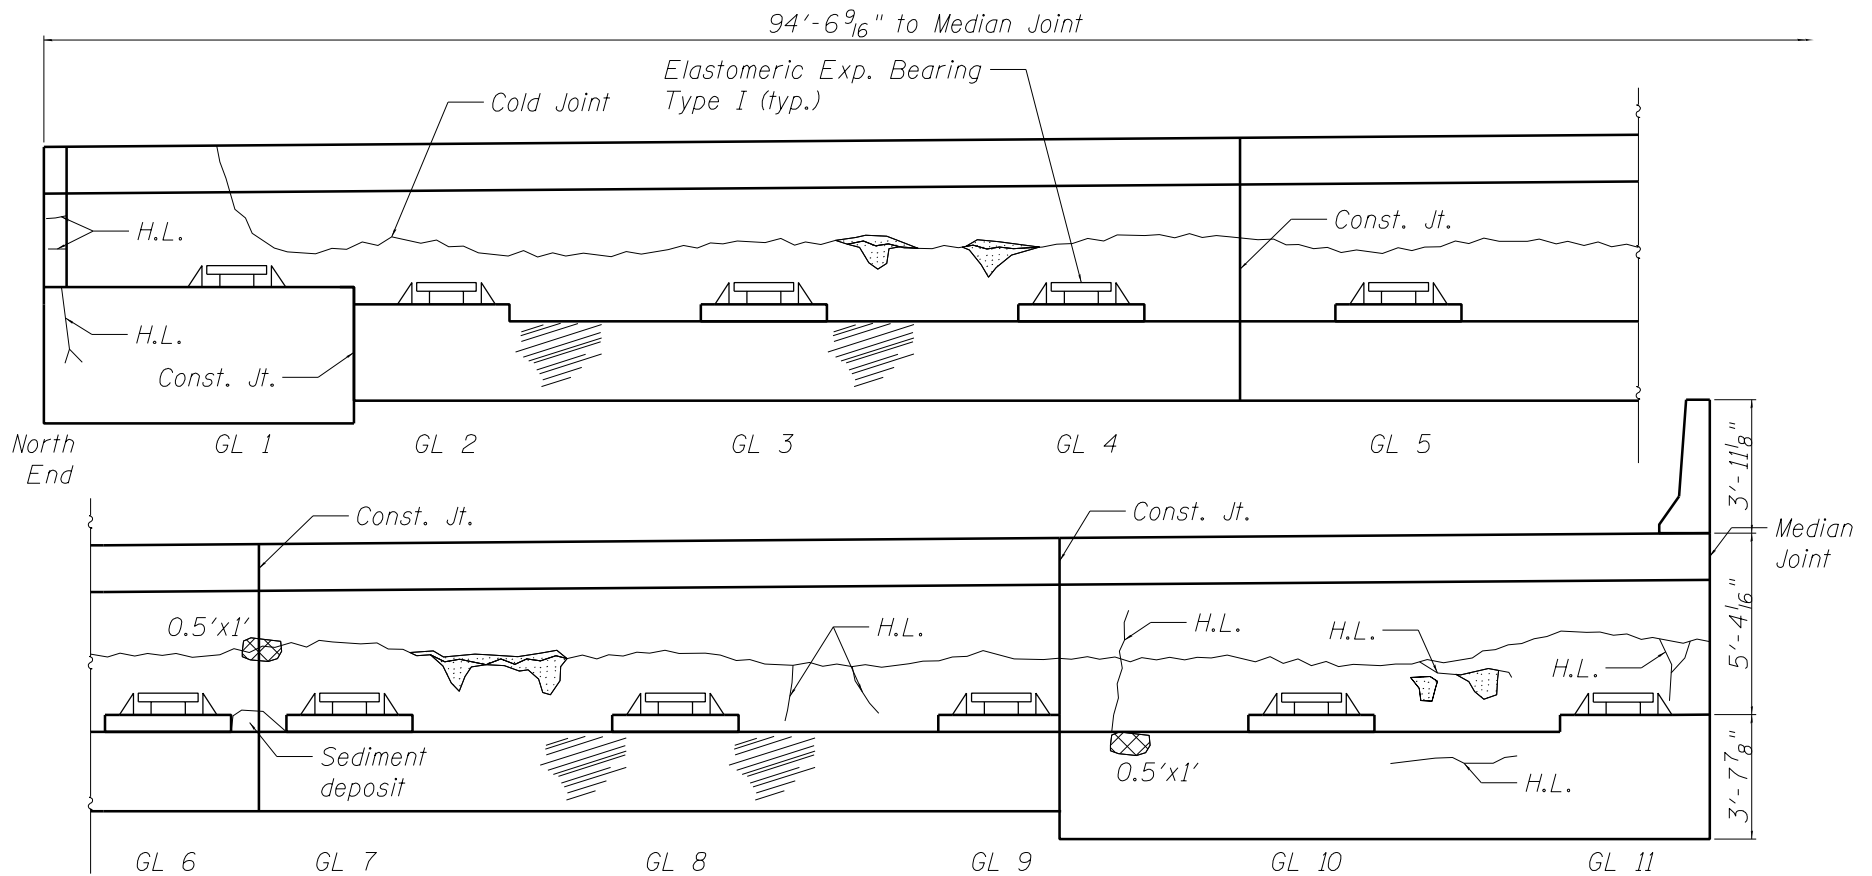

EAST ABUTMENT
NORTH END ELEVATION

H.L. - Hairline Crack
GL - Girder Line
M.S.C - Minor Surface Corrosion



	Spalling
	Delamination
	Efflorescence
	Water Staining

INSPECTOR = RJO
INSPECTOR = JA
INSPECTION DATE = 5/5/2016

**ILLINOIS DEPARTMENT
OF TRANSPORTATION**

**I-55 OVER S MADISON ST
S.N. 022-0003
EAST ABUTMENT FIELD SKETCH**

94'-6⁹/₁₆" to Median Joint

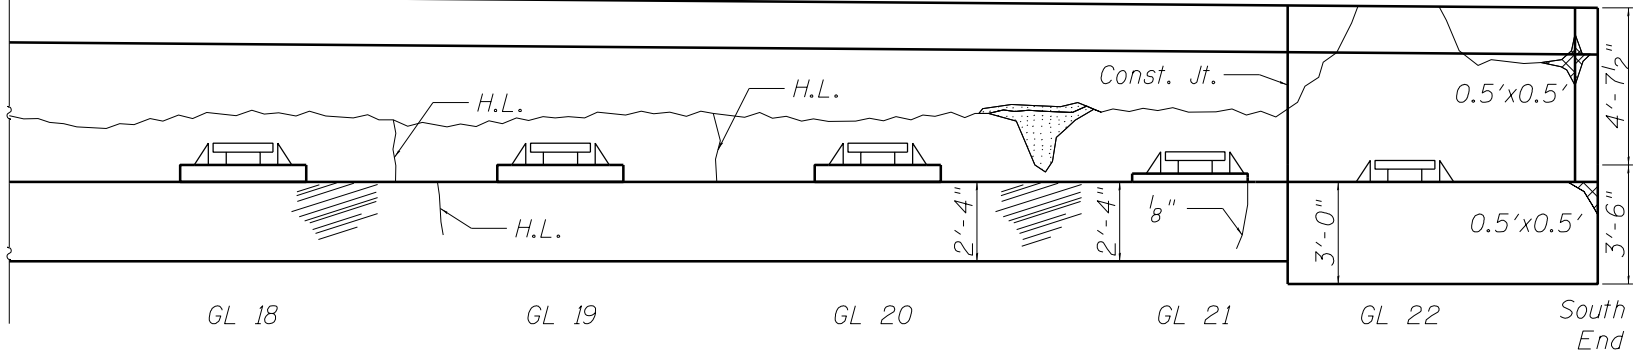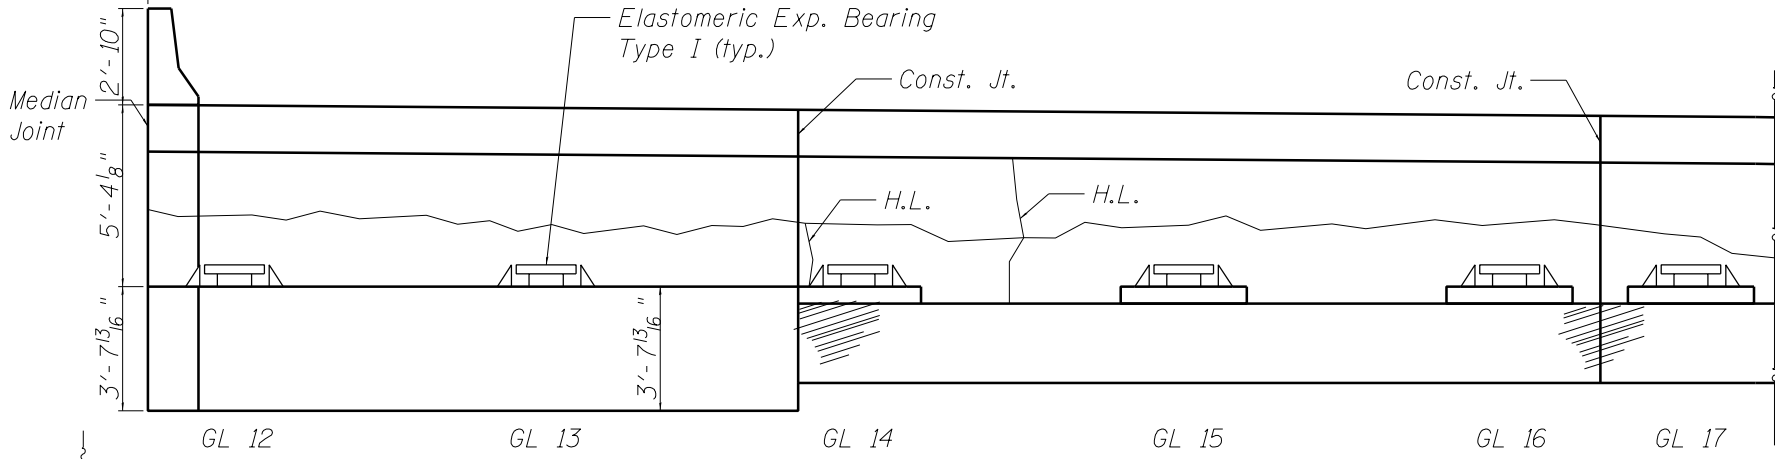

EAST ABUTMENT
SOUTH END ELEVATION

H.L. - Hairline Crack
GL - Girder Line
M.S.C - Minor Surface Corrosion


	Spalling
	Delamination
	Efflorescence
	Water Staining

INSPECTOR	= RJO
INSPECTOR	= JA
INSPECTION DATE	= 5/5/2016


**ILLINOIS DEPARTMENT
OF TRANSPORTATION**

**I-55 OVER S MADISON ST
S.N. 022-0003
EAST ABUTMENT FIELD SKETCH**


F:\3-1390_Var-ED\006_155\Drawings\Exhibits\022-0003.dgn

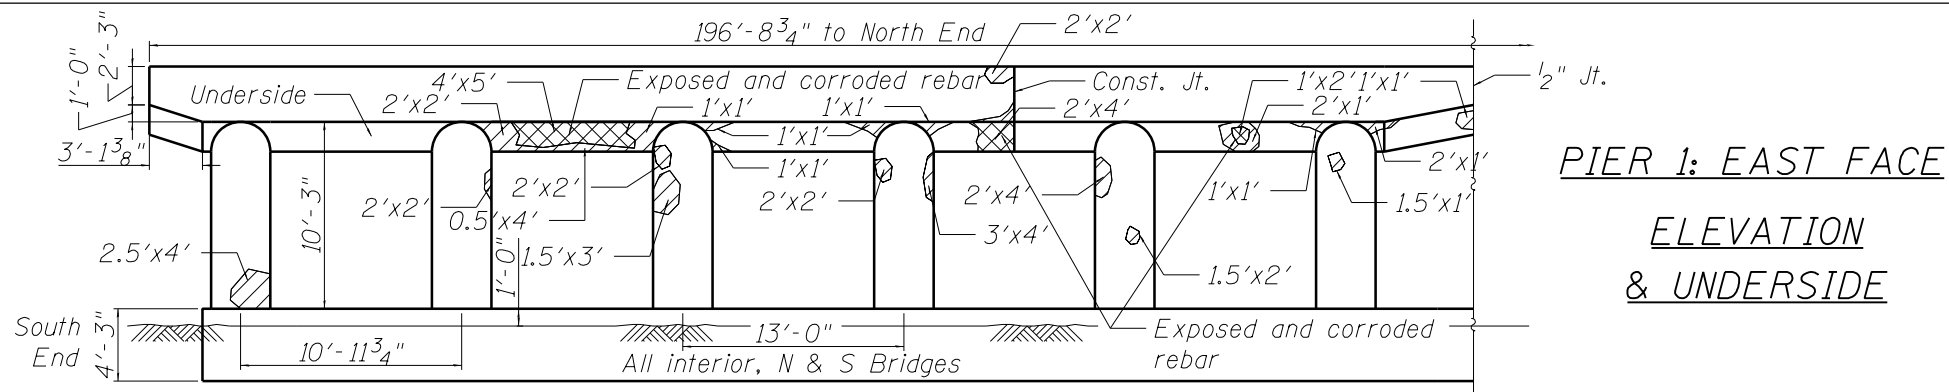


**PIER 1: EAST FACE
ELEVATION
& UNDERSIDE**

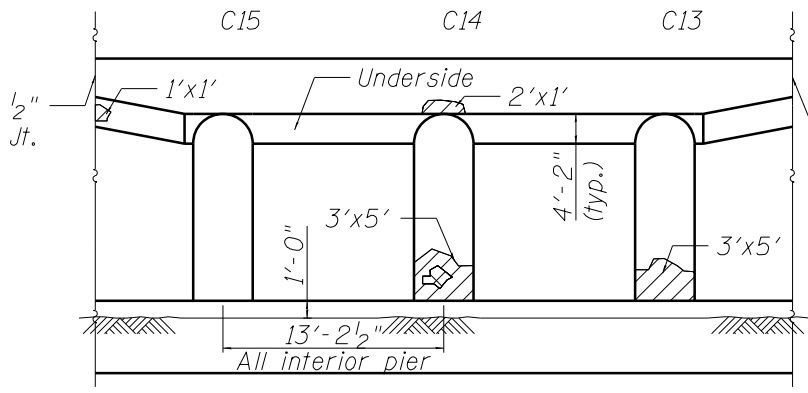


SECTION 3

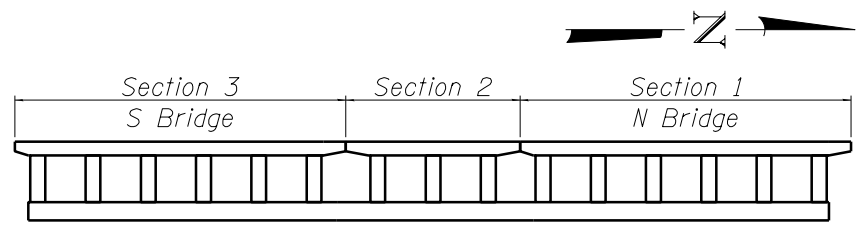

PIER OVERALL

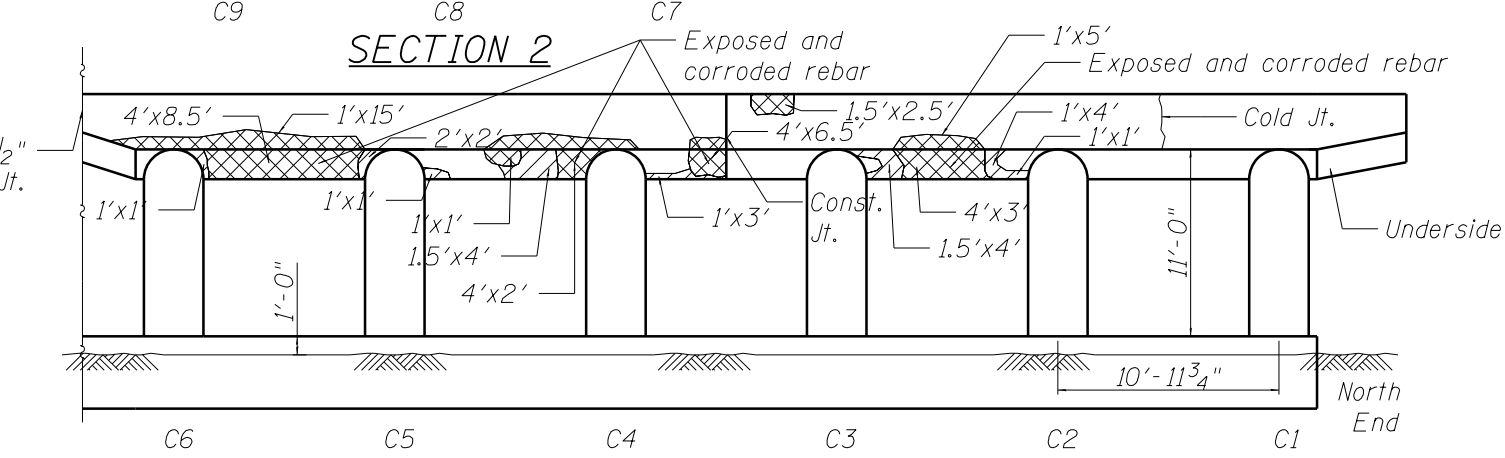

SECTION 2

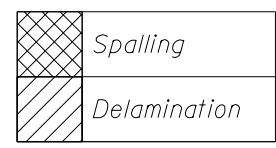


SECTION 1

INSPECTOR = RJO
 INSPECTOR = JA
 INSPECTION DATE = 5/5/2016


**ILLINOIS DEPARTMENT
OF TRANSPORTATION**

**I-55 OVER S MADISON ST
S.N. 022-0003
PIER 1 FIELD SKETCH**


F:\3-1390_Var\ED\006_155\Drawings\Exhibits\022-0003.dgn

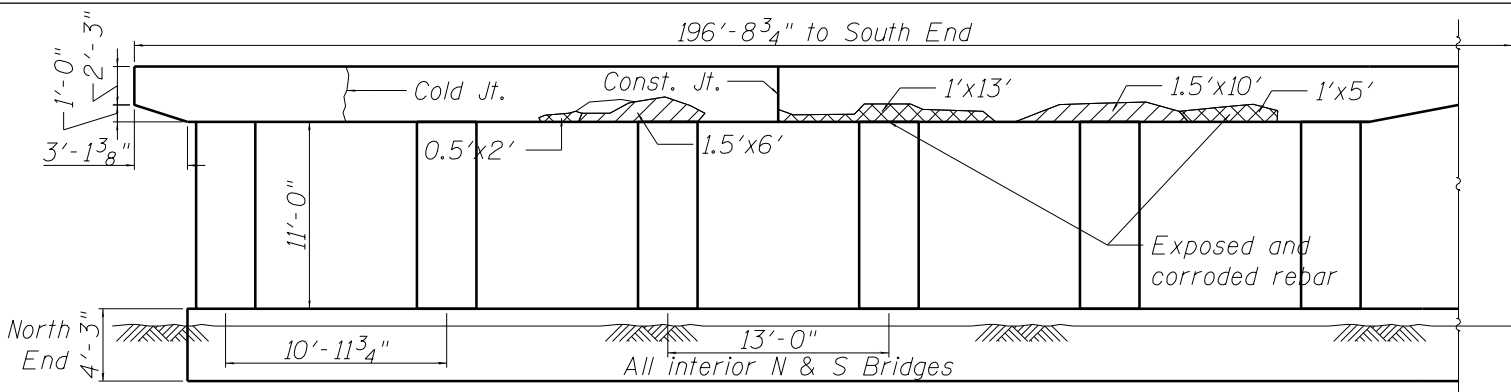


PIER 1: WEST FACE
ELEVATION

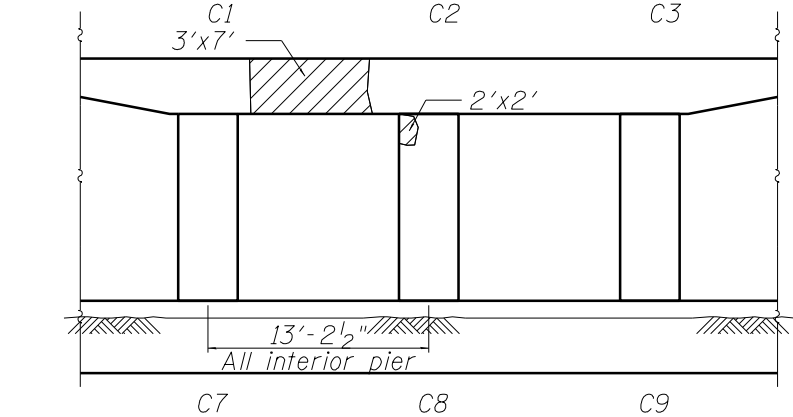


SECTION 1

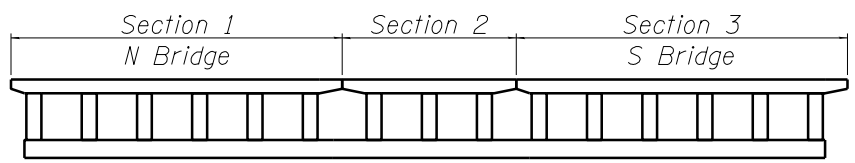


PIER OVERALL

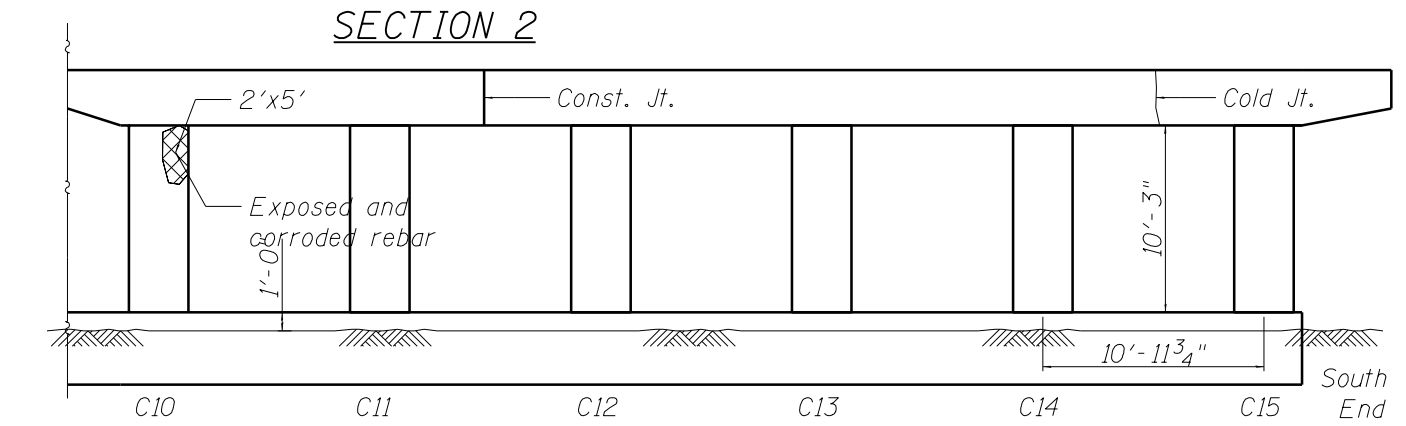

SECTION 2

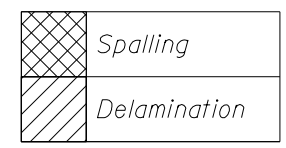

C - Column

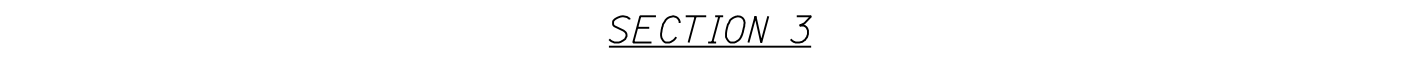


SECTION 3

INSPECTOR	= RJO
INSPECTOR	= JA
INSPECTION DATE	= 5/5/2016

**ILLINOIS DEPARTMENT
OF TRANSPORTATION**

**I-55 OVER S MADISON ST
S.N. 022-0003
PIER 1 FIELD SKETCH**

F:\3-1390_Var\EDIN\006_155\Drawings\Exhibits\022-0003.dgn

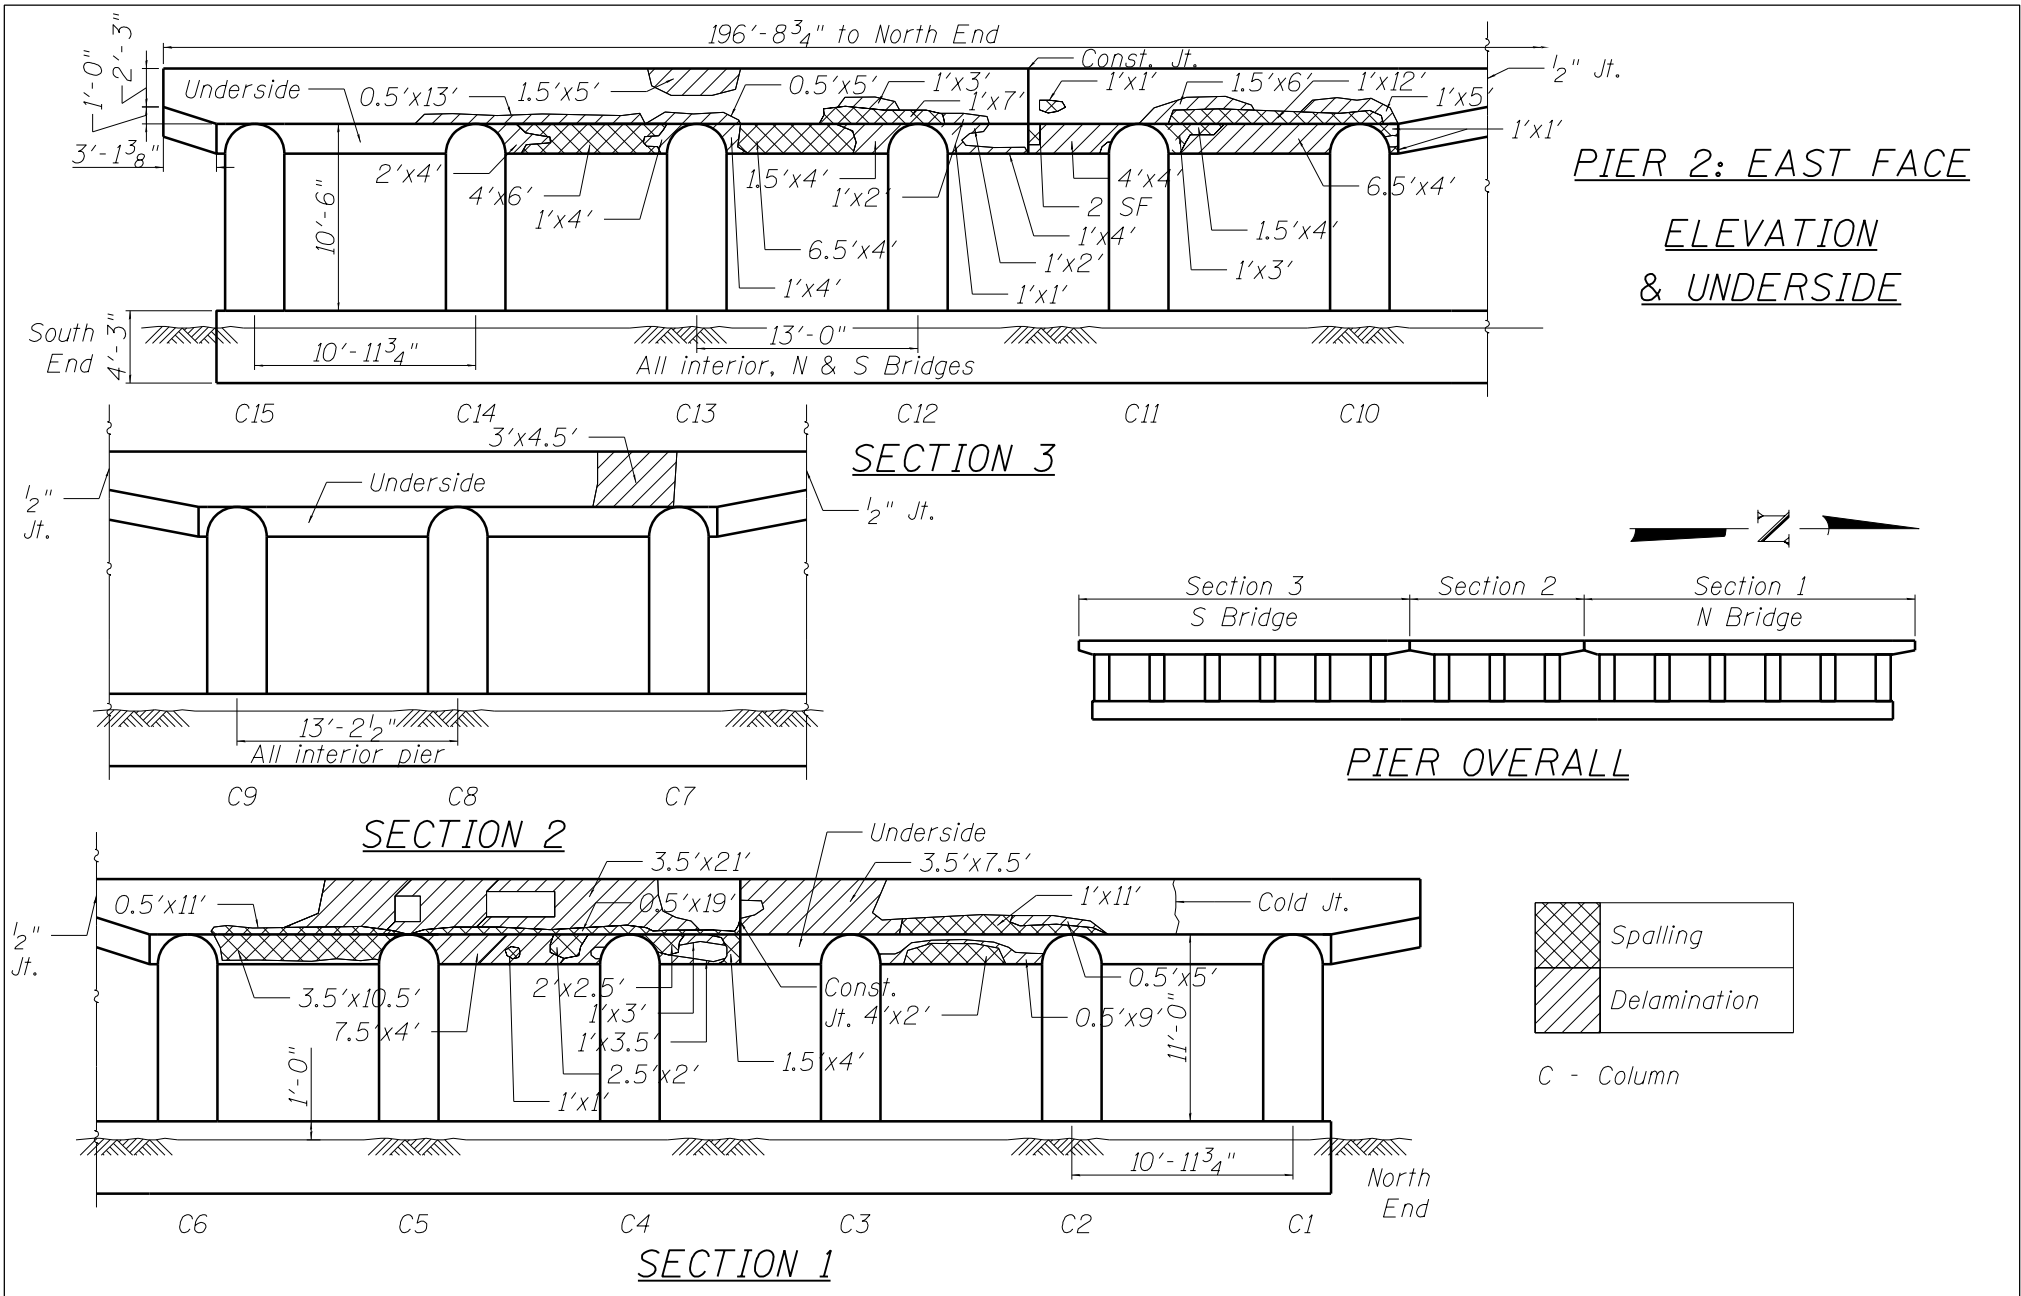


INSPECTOR = RJO
 INSPECTOR = JA
 INSPECTION DATE = 5/5/2016



**ILLINOIS DEPARTMENT
OF TRANSPORTATION**

**I-55 OVER S MADISON ST
S.N. 022-0003
PIER 2 FIELD SKETCH**



F:\3-1390_Var\EDIN\006_155\Drawings\Exhibits\022-0003.dgn

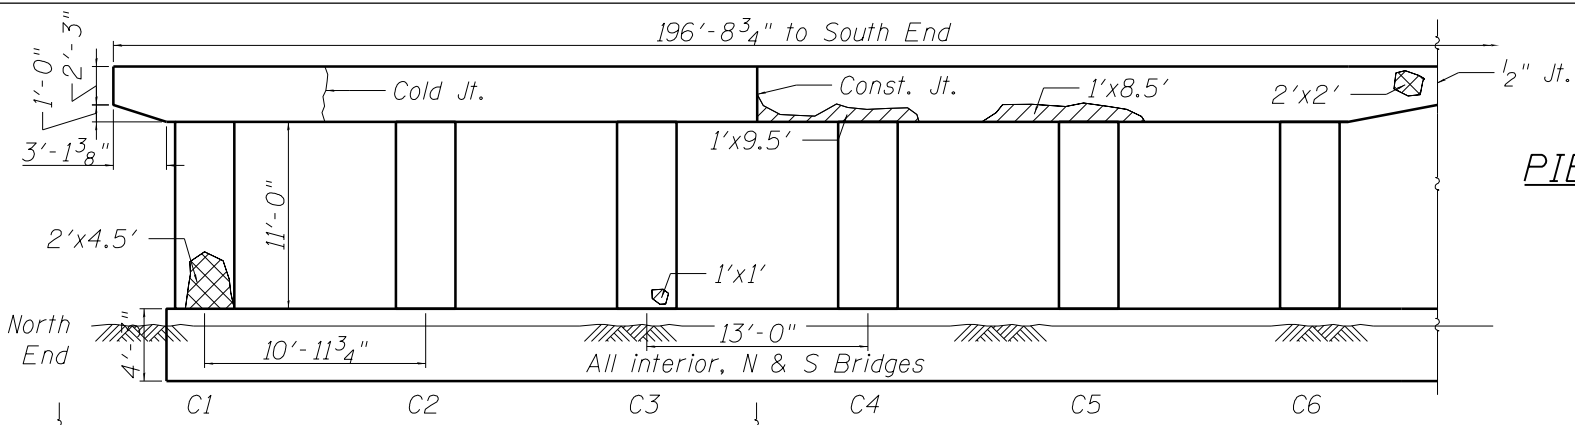

**PIER 2: WEST FACE
ELEVATION**

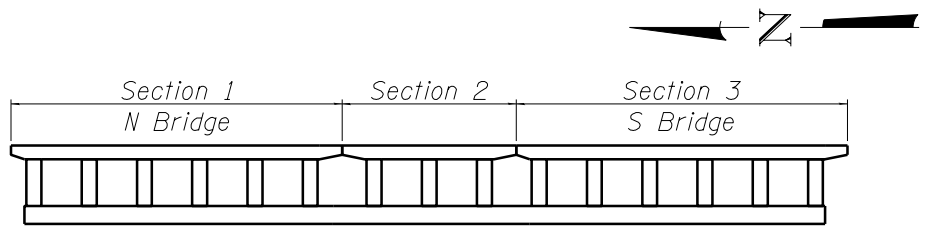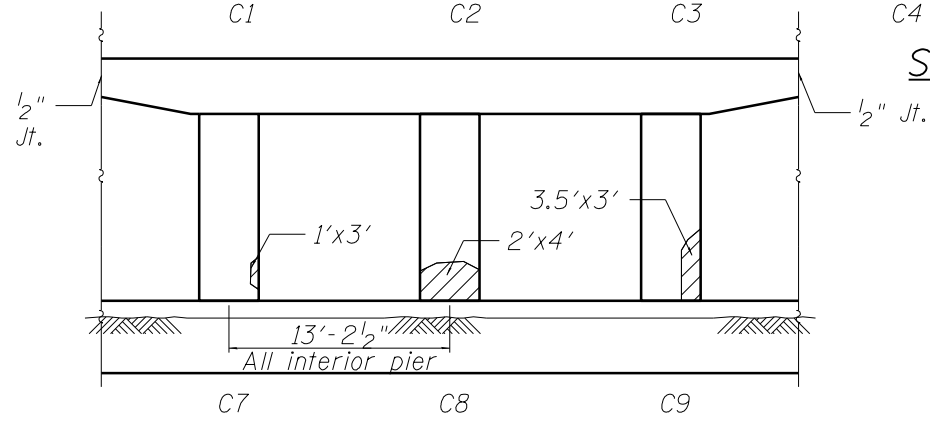

PIER OVERALL

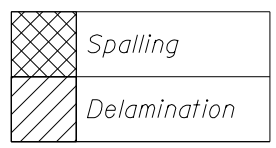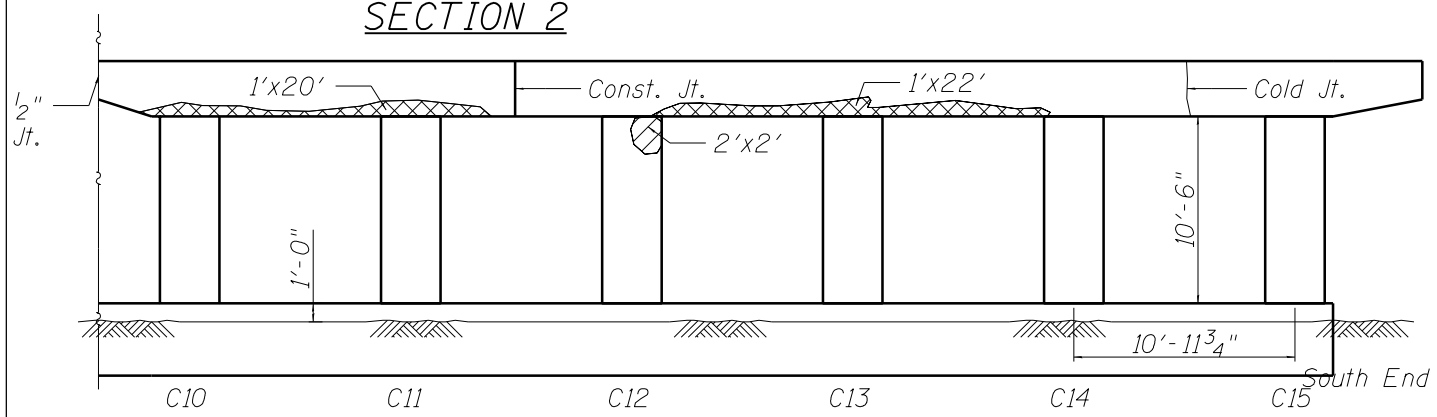

C - Column

SECTION 2

SECTION 3

INSPECTOR	= RJO
INSPECTOR	= JA
INSPECTION DATE	= 5/5/2016

**ILLINOIS DEPARTMENT
OF TRANSPORTATION**

**I-55 OVER S MADISON ST
S.N. 022-0003
PIER 2 FIELD SKETCH**

F:\3-1390_Var\EDIN\006_155\Drawings\Exhibits\022-0003.dgn

Attachment E:
Top of Deck Survey



Final Report

Infrared Thermographic Deck Survey of I-55 over Madison Street (S.N. 022-0003) in DuPage County, Illinois



Prepared for:

Bloom Companies, Inc.
600 W. Fulton
Suite 701
Chicago, IL 60661

Prepared by:

AECOM Technical Services, Inc.
1555 N. RiverCenter Drive, Suite 214
Milwaukee, WI 53212

July, 2016

AECOM Project No. 60504019



AECOM 414 944 6080 tel
1555 N. RiverCenter Drive 414 944 6081 fax
Suite 214
Milwaukee, Wisconsin 53212
www.aecom.com

July 8, 2016

Mr. Lee Austin, P.E.
Senior Associate
Bloom Companies, Inc.
600 W. Fulton, Suite 701
Chicago, IL 60661

**Subject: Thermographic Survey Report
AECOM Project No.: 60504019**

Dear Mr. Austin,

We are respectfully submitting our final report that presents the results of the infrared thermographic survey conducted on I-55 over Madison Street (Structure No. 022-0003) in DuPage County, Illinois. The report provides a discussion of equipment and procedures used during this project, followed by the results. The results include plans identifying areas of delamination.

Following your review of this report, we would be pleased to discuss the material contained herein.

Sincerely,

AECOM Technical Services, Inc.

Daniel D. Ulrikson, P.E.
Remote Sensing Department Manager

Enclosure

Table of Contents

1.0 INTRODUCTION..... 1-1

 1.1 Background 1-1

 1.2 Purpose 1-4

 1.3 Scope 1-4

 1.4 Definitions and Abbreviations 1-4

 1.5 Acknowledgements..... 1-5

2.0 INFRARED THERMOGRAPHY..... 2-1

 2.1 Introduction 2-1

 2.2 Equipment 2-1

 2.3 Procedure 2-2

 2.4 Analysis 2-5

 2.5 Results..... 2-5

3.0 SUMMARY AND CONCLUSIONS 3-1

 3.1 Infrared Thermographic Survey 3-1

 3.2 Conclusions 3-1

Figures

Figure 1 General View - Looking North.....1-2
Figure 2 General View - Looking South1-3
Figure 3 Infrared Data Collection Vehicle2-2
Figure 4 Interior of Data Collection Vehicle2-3
Figure 5 Control and Infrared Video.....2-5

Appendices

Appendix A Infrared Thermographic Deck Survey Plan Views

1.0 INTRODUCTION

1.1 Background

The Illinois Department of Transportation (IDOT) is responsible for the planning, design, construction, operation and maintenance of thousands of bridge assets within the state. IDOT Region 1/District 1 has responsibility for those assets within the 6 counties that comprise the region. Aging infrastructure and limited funds present a management challenge to the department. Accurate and timely information about the condition of bridges is required to optimize the performance and life of bridges at minimal cost. This report will provide specific bridge condition data that the department's bridge management staff can use in their evaluation of this bridge.

When concrete deteriorates in a highway bridge, repairs become necessary to assure the safety of the bridge, extend its useful life and restore the riding qualities of the deck. Deterioration types requiring repair include delamination, debonding of the overlay and patching on the bridge deck. Delaminated concrete is defined as a horizontal fracture plane, normally occurring at or above the reinforcing steel in the bridge deck. Debonding of the overlay is a separation of asphalt or concrete pavement overlay from the concrete deck which can lead to scaling or pot holes. Patching indicates a previous defect either in the overlay or the bridge deck.

AECOM Technical Services, Inc. was retained by Bloom Companies, Inc. to evaluate the present condition with respect to delaminated concrete of I-55 over Madison Street (Structure No. 022-0003) in DuPage County, Illinois, by conducting an infrared thermographic (IR) survey of the deck. This bridge has a continuously reinforced Portland cement concrete (PCC) deck. No overlay was present at the time of the inspection. The structure was built in 1959 and reconstructed in 1996. It has epoxy coated reinforcement and carries three lanes of traffic in each the northbound and southbound directions. It has a total length of approximately 172 feet and a total roadway width of approximately 134 feet. The total roadway area is approximately 22,530 square feet. Figures 1 and 2 show a general view of the bridge deck.

FIGURE 1
GENERAL VIEW - LOOKING NORTH



FIGURE 2
GENERAL VIEW - LOOKING SOUTH



The IR is capable of detecting delaminated concrete in the bridge deck because of the temperature differential that is established between solid and delaminated concrete when the bridge deck is heated by the sun. Non-destructive testing by IR is often coupled with ground truthing by visual observation or destructive testing, such as coring, to arrive at the optimal interpretation of the non-destructive testing.

1.2 Purpose

The purpose of this project was to evaluate the location and quantities of delaminated concrete in the bridge deck. This information, along with visual observations of the bridge deck and the results of additional testing, can be used to make rehabilitation recommendations.

1.3 Scope

This project scope included the use of a primary non-destructive testing system. The non-destructive method used was an IR survey of the entire bridge deck roadway to identify areas of delaminated concrete.

This report consists of two parts: the text portion and the appendix. The text presents the procedures, analyses, results and conclusions of the survey. The appendix presents the plan sheets showing the infrared survey results.

1.4 Definitions and Abbreviations

The following definitions and abbreviations appear throughout the report:

AECOM	-	AECOM Technical Services, Inc.
Delaminated concrete	-	A horizontal fracture plane occurring at or above the reinforcing steel.
IR	-	Infrared thermography
PCC	-	Portland cement concrete
IDOT	-	Illinois Department of Transportation

1.5 Acknowledgements

Bloom Companies, Inc.

Lee Austin, P.E., Senior Associate

AECOM Technical Services, Inc.

Daniel D. Ulrikson, P.E., Remote Sensing Department Manager

Timothy J. Crowley, Remote Sensing Specialist

David D. Scargall, Remote Sensing Specialist

Brady J. Seston, Remote Sensing Engineer

2.0 INFRARED THERMOGRAPHY

2.1 Introduction

Historically, delaminated concrete has been identified by acoustic methods such as hammer sounding, chain dragging or mechanical acoustic devices. The principle behind sounding is that delaminated areas produce a lower pitched or hollow sound when struck compared to that from non-delaminated areas. The air gap in the delamination causes a change in acoustic response to the imposed signal – for example, the hammer strike. Persons using sounding to identify delaminated areas need judgment and a great deal of time to test a given section of bridge deck.

The same physical condition that disrupts the acoustic response also causes a surface temperature variation. For this project, infrared thermography was used to identify delaminated concrete in the upper portion of the bridge deck. An infrared scanner was used to locate delamination by observing the surface temperature difference between delaminated areas and solid concrete which exists when the pavement or bridge deck is warmed by the sun. Trapped air in a delamination acts as an insulator, permitting the concrete above the delamination to become warmer than the surrounding, more massive pavement. Temperature differences can reach 10°F on sunny days. The technique has principle advantages of faster data collection, less operator judgment, easy documentation via deck plans, and more accurate results than traditional sounding procedures. The infrared system is considered to be a “passive system” as opposed to the sounding techniques which are considered to be “active systems”. Delaminated concrete in the lower portion of the bridge deck is not detectable from the surface because an insufficient amount of the sun’s energy penetrates to that depth during the daylight hours.

On bridge decks with flexible overlays, the infrared equipment can often differentiate between delamination in the concrete and debonding of the overlay. In general, if the deck has a flexible overlay and both debonding of the overlay and delaminated concrete exists, slightly different thermal signatures will exist for the delaminated concrete and the debonded overlay. A thermal signature from delaminated concrete is usually oval-shaped, has distinct edges, and has a relatively uniform temperature throughout the signature. The thermal signature from a debonded flexible overlay is, in general, larger in size, non-circular and has a non-uniform temperature throughout. The non-uniform temperature is caused by differing degrees of contact between the overlay and the concrete deck. When this area is viewed with an infrared scanner, these debonded areas appear as a marbled surface.

For bridges with rigid overlays, debonded areas are typically large in size and have a relatively uniform temperature throughout the anomaly. The debonding of the overlay is often the result of the bonding agent drying before the placement of the overlay. A more common rigid overlay related defect is the delaminating of the original deck concrete immediately below the interface with the overlay. This defect has a thermal signature similar in appearance to that of debonding, and can be the result of micro-fracturing of the original deck concrete surface produced through deck preparation activities such as milling or shot blasting.

2.2 Equipment

The infrared scanner used for this work is a small, light-weight, field instrument manufactured by Mikron Infrared, which is capable of detecting thermal radiation. It produces a standard video signal that allows thermal imagery to be recorded on a DVD. This scanner is capable of measuring temperature differences of 0.5°F. The scanner uses a microbolometer detector. A 45° wide-angle lens was used, which allows the operator to view a pavement width of one and one-quarter lanes. This produces some overlap of data from lane to lane for analysis. It also allows for vehicle movement from side to side during data collection.

A color video camera and DVD recorder were used to obtain control images of the pavement. The control image is used to record surface features such as patches, oil, debris or discoloration. This assures that surface features are not mistaken for delaminated concrete or other defects (debonding, etc.) during the analysis

procedure. This camera was equipped with a lens that allowed the field of view for the control image to match that of the infrared image.

2.3 Procedure

The infrared scanner and video camera were mounted on a mast attached to the front of the inspection van and raised to approximately 14 feet above the bridge deck, as shown in Figure 3. Black and white video produced by the infrared scanner and color video produced by the control camera were displayed on monitors in the van, shown in Figure 4.

FIGURE 3
INFRARED DATA COLLECTION VEHICLE



FIGURE 4
INTERIOR OF DATA COLLECTION VEHICLE



The operator continually monitors the images being recorded. For the infrared image, the temperature range that is being scanned may be adjusted occasionally to allow for slight differences in the pavement temperature. It is important to note that the relative surface temperature is analyzed, not the absolute surface temperature. The control image is monitored for brightness and contrast. The speed of the scanning van was held to approximately three miles per hour along the center of each traffic lane. A single pass was made for each travel lane and shoulder of the bridge.

A digital distance measuring device was used to reference the imagery to a known starting point. The starting point is usually a deck joint or an abutment. Distance measurements were superimposed on both the infrared and the control video images.

Once the van was in position at a reference point, the distance measuring device was zeroed. During the scanning operation, the van was stopped periodically at an area of suspected delaminated concrete to confirm the infrared data. This procedure consists of sounding the pavement to confirm the presence of delaminated concrete. The temperature difference between solid and delaminated pavement was taken directly from the infrared image for calibration purposes.

Certain environmental conditions are required for thermography to be effective. Generally clear skies, winds less than 30 miles per hour, and dry pavement produce suitable temperature differentials between solid and delaminated areas. If these conditions do not occur, an acceptable temperature differential may not be established. Cloudy skies do not allow the sun to heat the bridge deck and establish sufficient temperature differentials. In general, less sunshine is needed for decks without overlays. For overlaid bridge decks, the amount of sunshine needed to establish sufficient temperature differentials varies, based on the type and depth of the overlay. High winds have a cooling effect on the bridge deck surface and reduce the temperature variation between solid and delaminated concrete. If surface moisture is present, it does not allow sufficient temperature differentials to be established in that area. ASTM Standard D 4788 defines the test method for completing bridge deck inspections using infrared thermography.

The structure was inspected on June 13, 2016. The conditions experienced on the day of the inspection are summarized below:


DATE	AMBIENT TEMPERATURE (°F)	WEATHER CONDITIONS	WIND SPEED AND DIRECTION (MPH)	HUMIDITY (%)	PAVEMENT TEMPERATURE DIFFERENCE (°F)
6-13-16	81	Clear	3.5 SE	31	2.5

Traffic control was provided by Work Zone Safety, Inc. of Crest Hill, Illinois. This consisted of truck mounted attenuators to alert drivers to move to adjacent lanes during data collection. The survey vehicle was equipped with amber beacons and a directional arrow for additional traffic control.

2.4 Analysis

The infrared analysis procedure consists of a computer-aided interpretation of the video images produced during the field operation. The location of each thermal anomaly shown on the infrared video is plotted on a scaled plan view of the bridge deck. Anomalies show up as white, or “hot”, areas. Solid areas appear darker, or “cooler”, on the video image. The control video was simultaneously examined to make sure that an anomaly was not caused by discoloration, patching, or debris. Examples of the IR and control images are shown in Figure 5.

**FIGURE 5
 CONTROL AND INFRARED VIDEO**

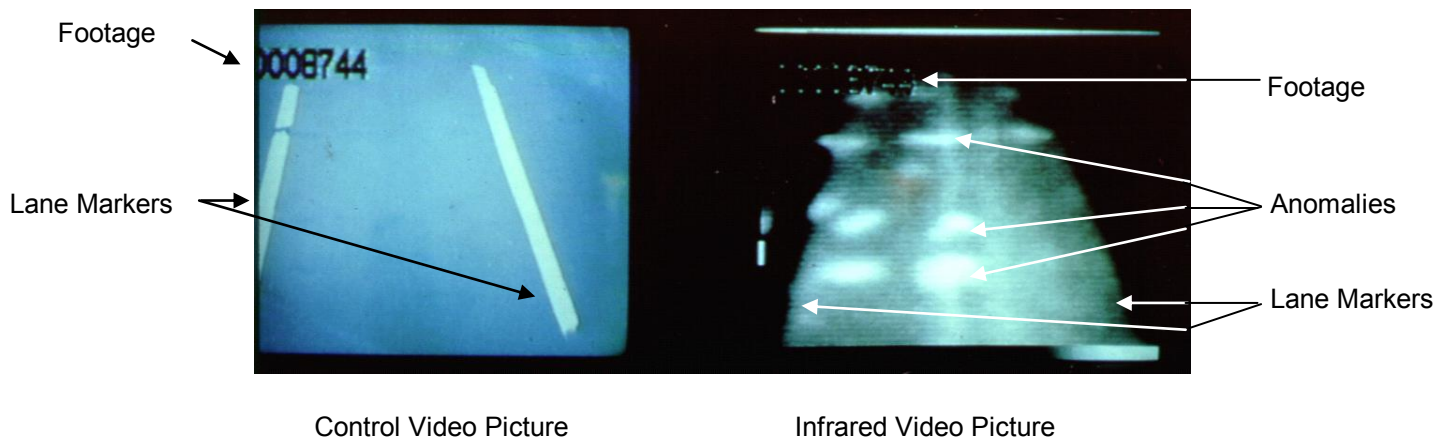

Anomalies can be separated into two basic categories; 1) delaminated concrete and 2) debonding between the overlay and the concrete deck. The separation of anomalies into these categories is accomplished by coring a representative sample of each type of anomaly detected on the bridge deck and comparing the results with the visual interpretation of the anomaly. These coring results, along with results from past projects are then used to categorize the remaining anomalies.

2.5 Results

Structure Number 022-0003 has a total roadway area of approximately 22,530 square feet. The results of the survey show that approximately 7 square feet (<0.1 percent of the area inspected) was delaminated concrete. In addition, approximately 1 square foot (<0.1 percent of the area inspected) was spalled, approximately 28 square feet (0.1 percent of the area inspected) was patched with epoxy and approximately 66 square feet (0.3 percent of the area inspected) was patched with concrete. The spall and epoxy patches on the deck were located along the lane lines and were the result of missing or removed delineators. No other defects were observed at the time of the survey.

Appendix A presents the infrared thermographic survey plan views of the bridge deck and shows the location and size of all defects observed. Defect types are quantified in the information block found on Sheet 1 of the plan views. The defect quantities are broken down by direction on the plan views.

3.0 SUMMARY AND CONCLUSIONS

As part of this project, an infrared thermographic survey of the bridge deck was performed on Structure Number 022-0003. The purpose of the infrared survey was to locate and quantify delaminations, patching and spalling that may be present in the bridge deck. This survey was performed on June 13, 2016. Survey results are summarized below, followed by conclusions pertaining to the findings.

3.1 Infrared Thermographic Survey


1. A total roadway area of approximately 22,530 square feet was surveyed.
2. Approximately 7 square feet (<0.1 percent of the area inspected) was delaminated concrete.
3. Approximately 1 square foot (<0.1 percent of the area inspected) was spalled.
4. Approximately 28 square feet (0.1 percent of the area inspected) was patched with epoxy.
5. Approximately 66 square feet (0.3 percent of the area inspected) was patched with concrete.

3.2 Conclusions

1. There are 3 delaminations located on this deck, all in Span 1 of the southbound lanes.
2. All of the epoxy patches and the spall are located along the lane markers and are a result of lane delineators that have popped out.
3. There is 1 concrete patch located in Span 2 of the northbound lanes.
4. Original deck design plans indicate the reinforcing steel in this structure is epoxy coated.





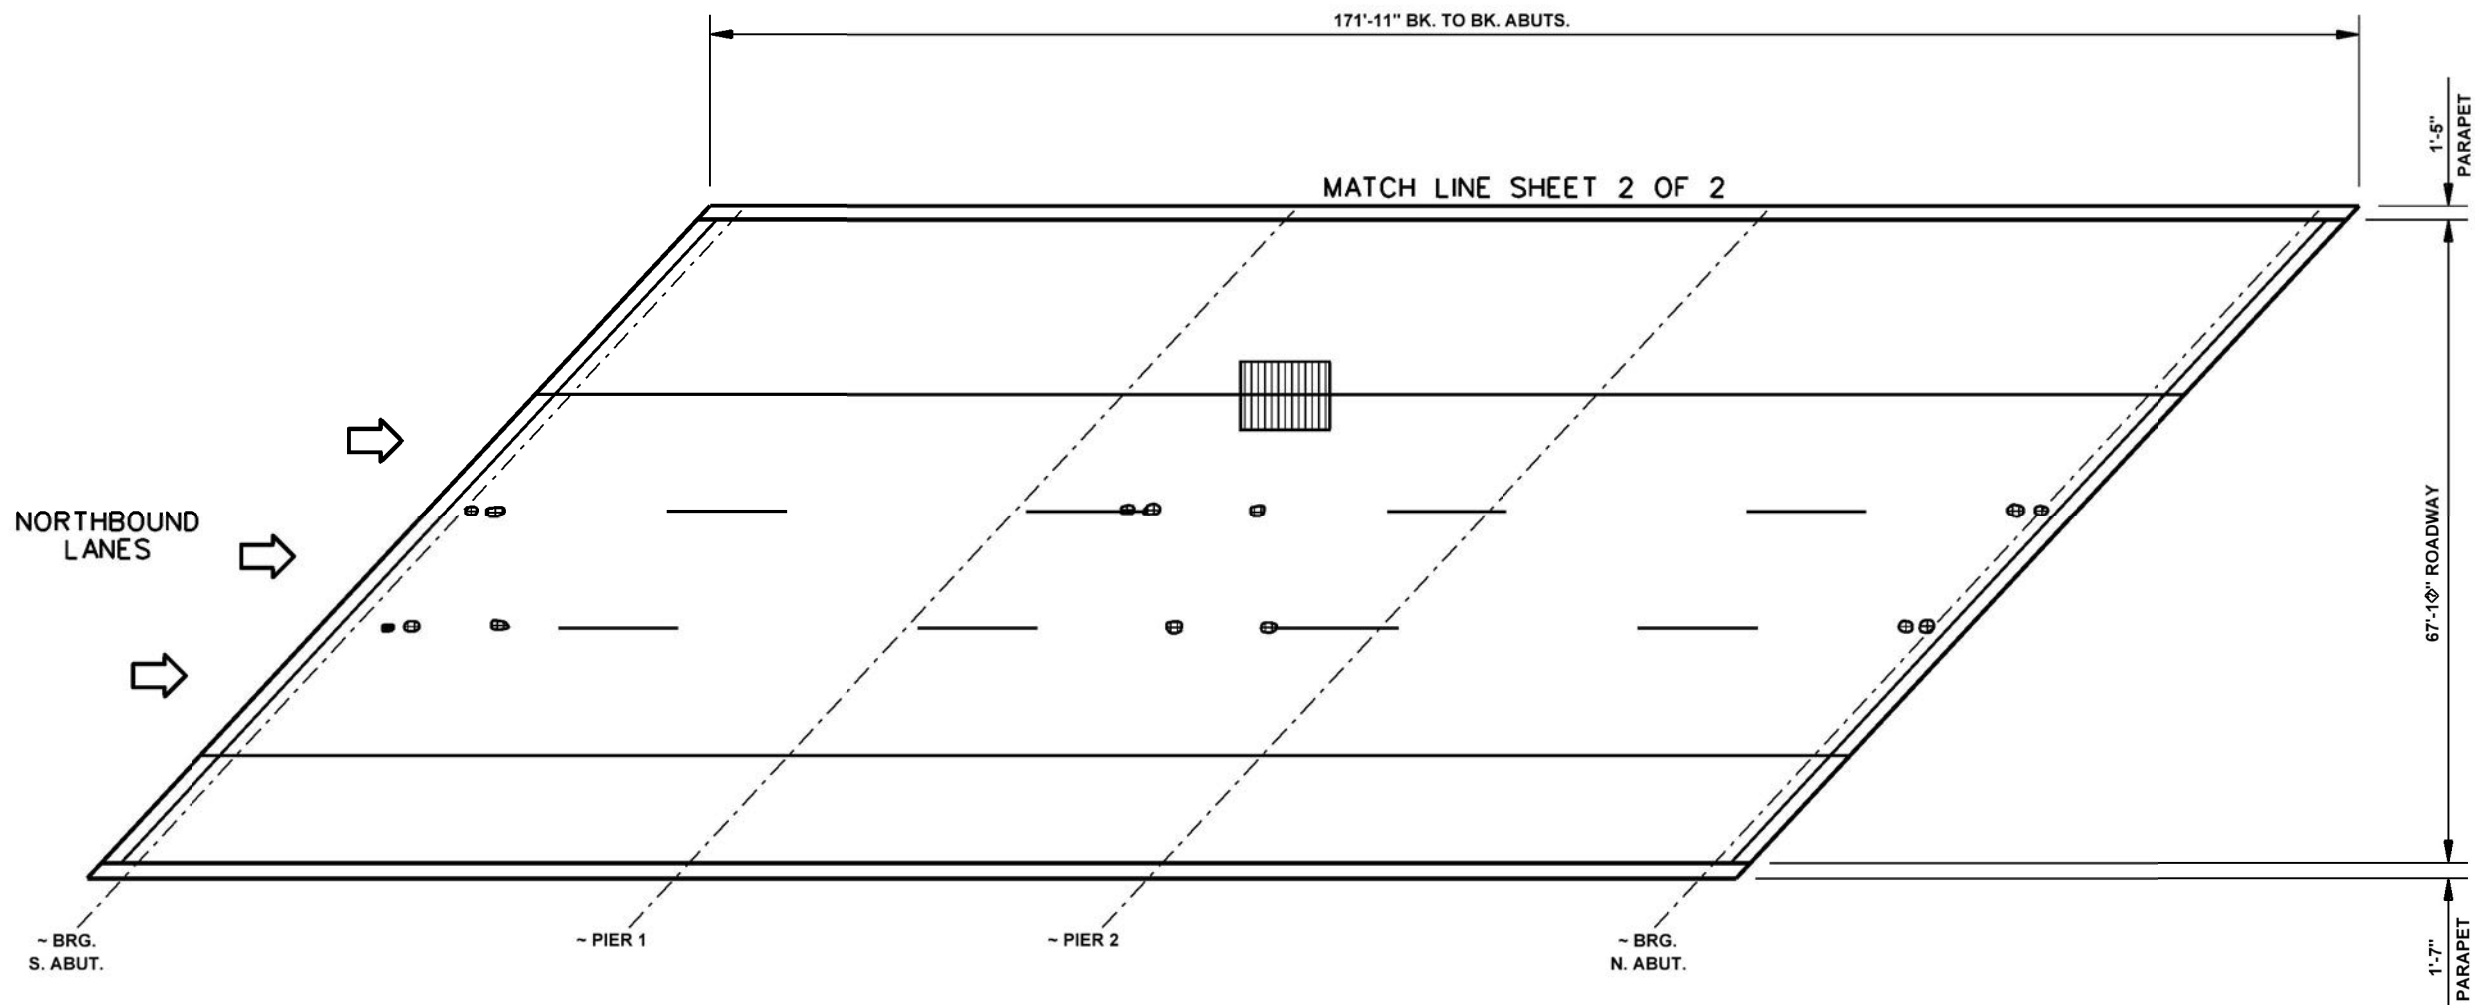

APPENDIX A

INFRARED THERMOGRAPHIC DECK SURVEY PLAN VIEWS



DECK PLAN
INFRARED INSPECTION RESULTS



FIELD OBSERVATIONS SUMMARY	UNIT	NORTHBOUND ROADWAY		SOUTHBOUND ROADWAY		TOTAL ROADWAY		LEGEND
		QUANT.	%	QUANT.	%	QUANT.	%	
TOTAL AREA	ft ²	11265		11265		22530		DELAMINATION 
SHADE/DEBRIS *	ft ²	0		0		0		SPALL 
DELAMINATION	ft ²	0	0	7	<0.1	7	<0.1	ASPHALT PATCH 
SPALL	ft ²	1	<0.1	0	0	1	<0.1	EPOXY PATCH 
ASPHALT PATCH	ft ²	0	0	0	0	0	0	CONCRETE PATCH 
EPOXY PATCH	ft ²	18	0.2	10	<0.1	28	0.1	SHADE/DEBRIS 
CONCRETE PATCH	ft ²	66	0.6	0	0	66	0.3	

* SHADE/DEBRIS AREA SUBTRACTED FROM TOTAL AREA WHEN CALCULATING DEFECT PERCENTAGES.


SURFACE TYPE: CONCRETE - NO OVERLAY
INFRARED INSPECTION DATE: 6/13/16

BRIDGE DECK TOP VIEW

**I-55
OVER
MADISON STREET
DuPAGE COUNTY
S.N. 022-0003**

INFRARED THERMOGRAPHIC INSPECTION PERFORMED BY



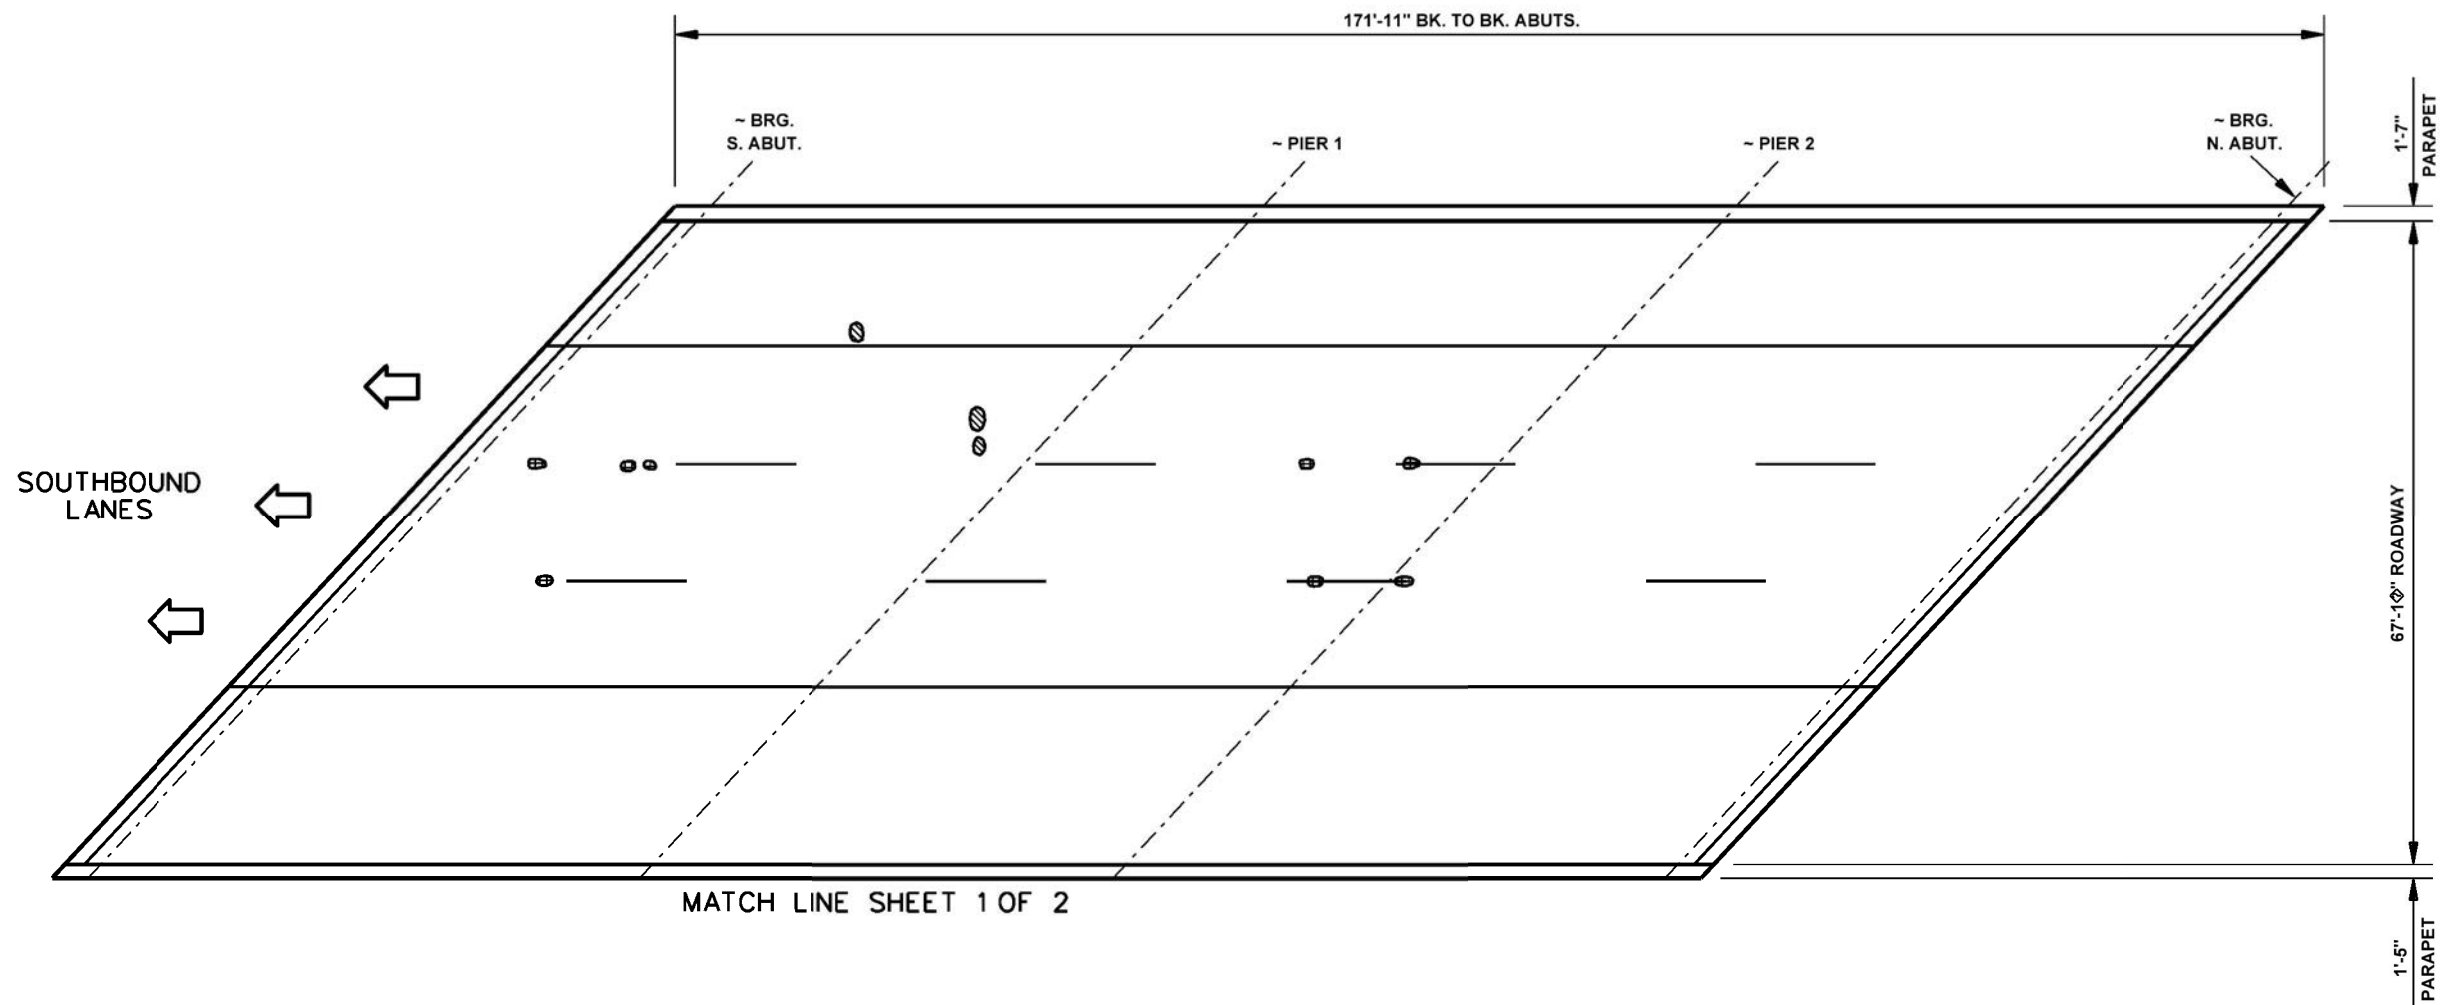

MATCH LINE SHEET 1 OF 2

DECK PLAN

INFRARED INSPECTION RESULTS

SEE SHEET 1 OF 2 FOR DEFECT QUANTITIES

LEGEND	
DELAMINATION	
SPALL	
ASPHALT PATCH	
EPOXY PATCH	
CONCRETE PATCH	
SHADE/DEBRIS	

SURFACE TYPE: CONCRETE - NO OVERLAY
 INFRARED INSPECTION DATE: 6/13/16



BRIDGE DECK TOP VIEW

**I-55
 OVER
 MADISON STREET
 DuPAGE COUNTY
 S.N. 022-0003**

INFRARED THERMOGRAPHIC INSPECTION PERFORMED BY



FILE NAME = 22-0003-IR-2.DGN	USER NAME =	DESIGNED -	REVISED -	STATE OF ILLINOIS DEPARTMENT OF TRANSPORTATION	I-55 OVER MADISON STREET INFRARED THERMOGRAPHIC DECK SURVEY	F.A. RTE.	SECTION	COUNTY	TOTAL SHEETS	SHEET NO.	
		DRAWN - DS	REVISED -			---		DuPAGE	2	2	
		CHECKED - DU	REVISED -			CONTRACT NO.					
		DATE -	REVISED -			ILLINOIS FED. AID PROJECT					

AECOM is a global provider of professional technical and management support services to a broad range of markets, including water, transportation, facilities, environmental, energy, and government. With approximately 46,000 employees around the world, AECOM is a leader in all of the key markets that it serves. AECOM provides a blend of global reach, local knowledge, innovation, and technical excellence in delivering solutions that enhance and sustain the world's built, natural, and social environments. A Fortune 500 company, AECOM serves clients in more than 100 countries and had revenue of \$6.3 billion during the 12-month period ended June 30, 2010. More information on AECOM and its services can be found at www.aecom.com.

AECOM
1555 N. RiverCenter Drive, Suite 214
Milwaukee, WI 53212
T: 414.944.6080
F: 414.944.6081
aecom.com

Attachment F:
Cost Estimates

Priority Repair Items:

ITEM NO.	DESCRIPTION	UNIT	QUANTITY	UNIT COST	COST
44000100	PAVEMENT REMOVAL	SQ YD	38	\$22.00	\$836.00
48203005	HMA SHOULDERS	SQ YD	38	\$18.00	\$684.00
50102400	CONCRETE REMOVAL	CU YD	259	\$47.00	\$12,173.00
50300266	BRIDGE DECK GROOVING	SQ YD	2335	\$8.00	\$18,680.00
50300300	PROTECTIVE COAT	SQ YD	2335	\$3.90	\$9,106.50
52000320	NEOPRENE EXPANSION JOINT 2"	FOOT	410	\$290.00	\$118,900.00
59000200	EPOXY CRACK INJECTION	FOOT	2	\$99.00	\$198.00
67000400	ENGINEER'S FIELD OFFICE, TYPE A	CAL MO	1	\$3,700.00	\$3,700.00
70400100	TEMPORARY CONCRETE BARRIER	FOOT	316	\$40.00	\$12,640.00
70400200	RELOCATE TEMPORARY CONCRETE BARRIER	FOOT	316	\$15.00	\$4,740.00
70600235	IMPACT ATTENUATORS, TEMPORARY (FULLY REDIRECTIVE), TEST LEVEL 2	EACH	2	\$13,000.00	\$26,000.00
70600320	IMPACT ATTENUATORS, RELOCATE (FULLY REDIRECTIVE), TEST LEVEL 2	EACH	2	\$2,500.00	\$5,000.00
X0322194	POLYMER MODIFIED PORTLAND CEMENT MORTAR	SQ FT	243.5	\$400.00	\$97,400.00
X0322276	CLEANING AND PAINTING EXPOSED REBAR	SQ FT	30	\$74.80	\$2,244.00
Z0006000	BRIDGE DECK CONCRETE OVERLAY	SQ YD	2,335	\$98.00	\$228,830.00
Z0006710	BRIDGE DRAINAGE SYSTEM REPAIR	EACH	1	\$810.00	\$810.00
Z0010400	CLEANING BRIDGE SEATS	SQ FT	300	\$12.00	\$3,600.00
Z0012755	STRUCTURAL REPAIR OF CONCRETE (DEPTH LESS THAN 5 INCHES)	SQ FT	673.5	\$250.00	\$168,375.00
Z0012800	CONCRETE PAVEMENT SCARIFICATION	SQ YD	2,335	\$33.00	\$77,055.00
Z0015500	DEBRIS REMOVAL	L SUM	1	\$5,000.00	\$5,000.00
Z0016001	DECK SLAB REPAIR (FD-T1)	SQ YD	1	\$1,800.00	\$1,800.00
SUBTOTAL					\$797,772.00
67100100	MOBILIZATION	L SUM	1	\$79,777.20	\$79,777.20
X7010200	TRAFFIC CONTROL AND PROTECTION, STANDARD (SPECIAL)	EACH	1	\$79,777.20	\$79,777.20

Notes:

MOBILIZATION = 10% of Construction Costs

TRAFFIC CONTROL AND PROTECTION, (SPECIAL) = 10% of Construction Costs

15%
CONTINGENCY \$119,665.80
TOTAL: \$1,076,993.00

Secondary Repair Items:


ITEM NO.	DESCRIPTION	UNIT	QUANTITY	UNIT COST	COST
59000200	EPOXY CRACK INJECTION	FOOT	10	\$99.00	\$990.00
X0322024	TRENCH DRAIN	EACH	1	\$3,600.00	\$3,600.00
X0326796	CLEAN TROUGH	EACH	1	\$3,900.00	\$3,900.00
Z0007118	UNTREATED TIMBER LAGGING	SQ FT	20	\$11.00	\$220.00
Z0015500	DEBRIS REMOVAL	L SUM	1	\$5,000.00	\$5,000.00
Z0065730	SLOPEWALL SLUR PUMPING	CU YD	22	\$310.00	\$6,820.00

SUBTOTAL: \$20,530.00

30%
CONTINGENCY: \$6,159.00

TOTAL: \$26,689.00

Attachment G:
Proposed Repairs

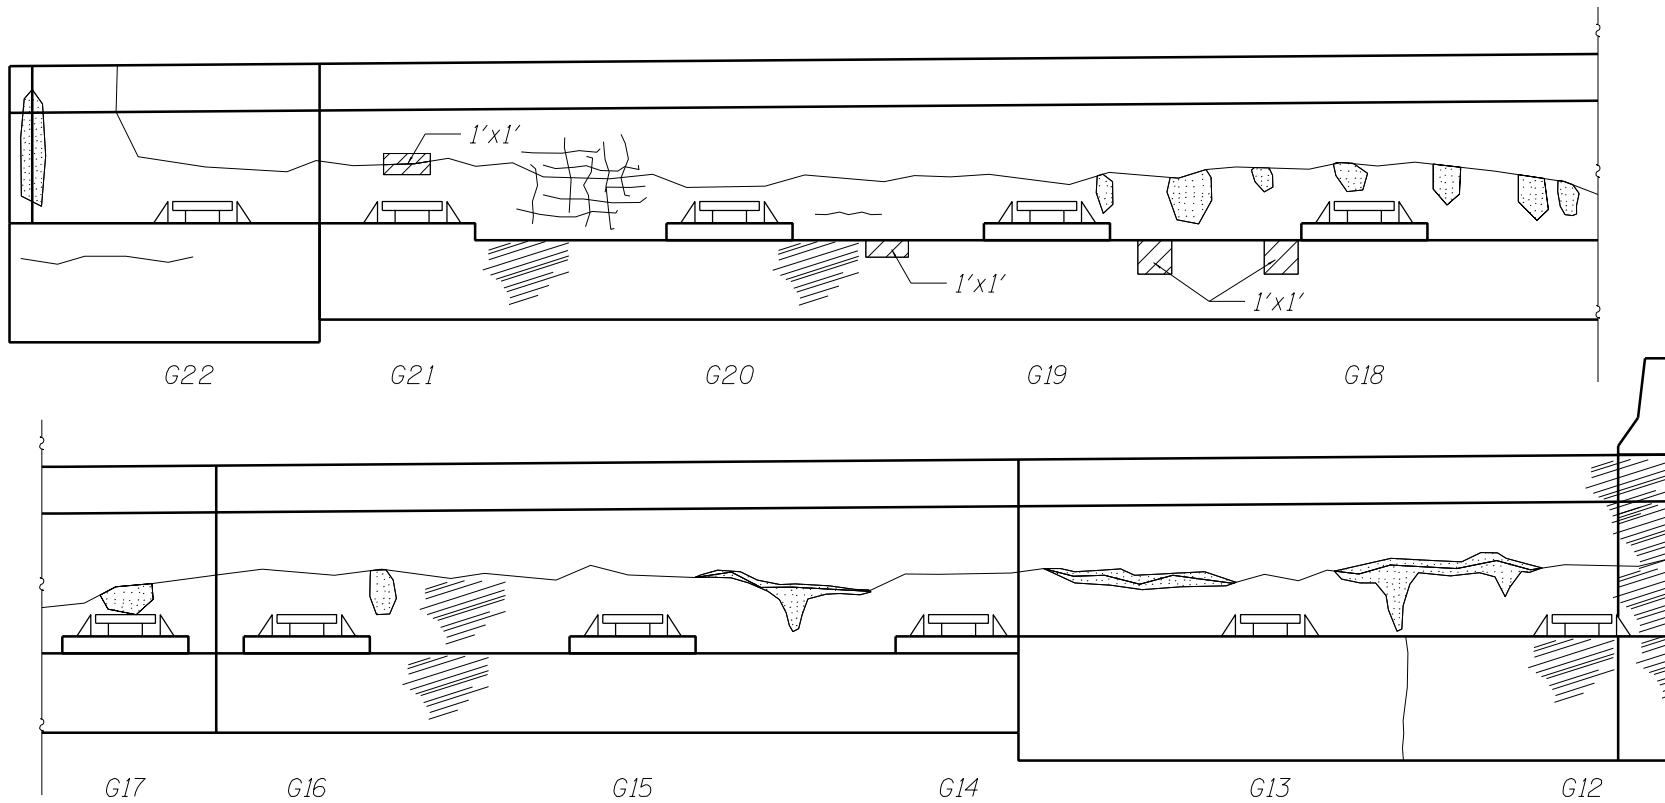


WEST ABUTMENT
SOUTH END ELEVATION

	Polymer Modified Portland Cement Mortar	4	Sq Ft.
--	--	---	--------

INSPECTOR	= RJO
INSPECTOR	= JA
INSPECTION DATE	= 5/5/2016

**ILLINOIS DEPARTMENT
OF TRANSPORTATION**

**I-55 OVER S MADISON ST
S.N. 022-0003
WEST ABUTMENT PROPOSED REPAIRS**

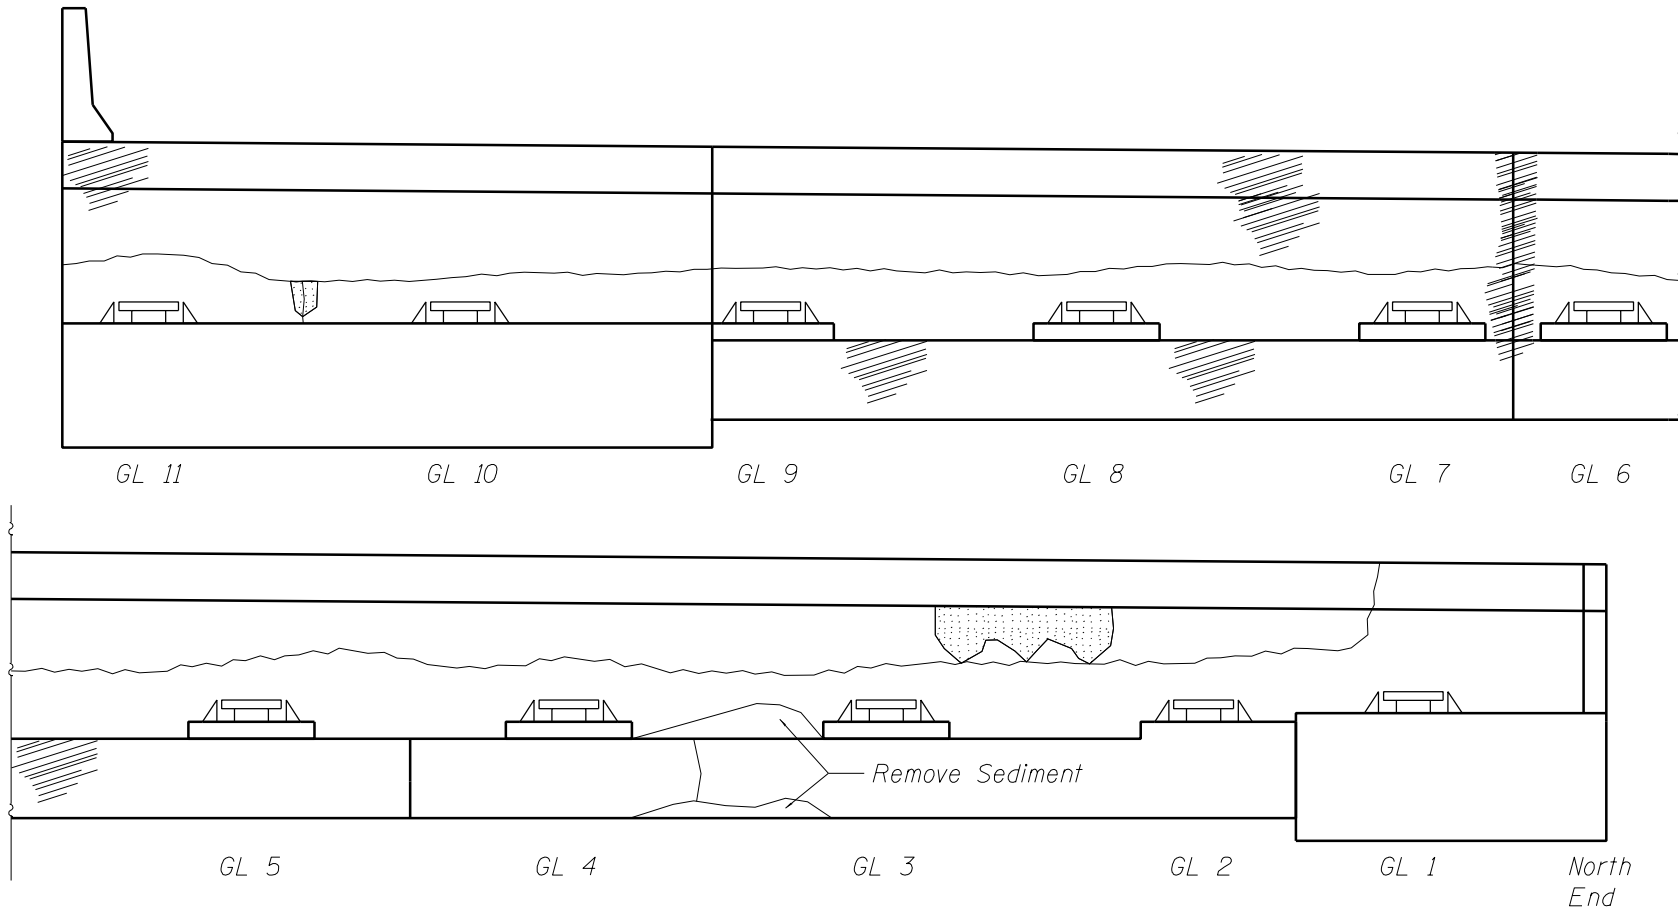


WEST ABUTMENT
NORTH END ELEVATION

INSPECTOR	= RJO
INSPECTOR	= JA
INSPECTION DATE	= 5/5/2016

**ILLINOIS DEPARTMENT
OF TRANSPORTATION**

**I-55 OVER S MADISON ST
S.N. 022-0003
WEST ABUTMENT PROPOSED REPAIRS**

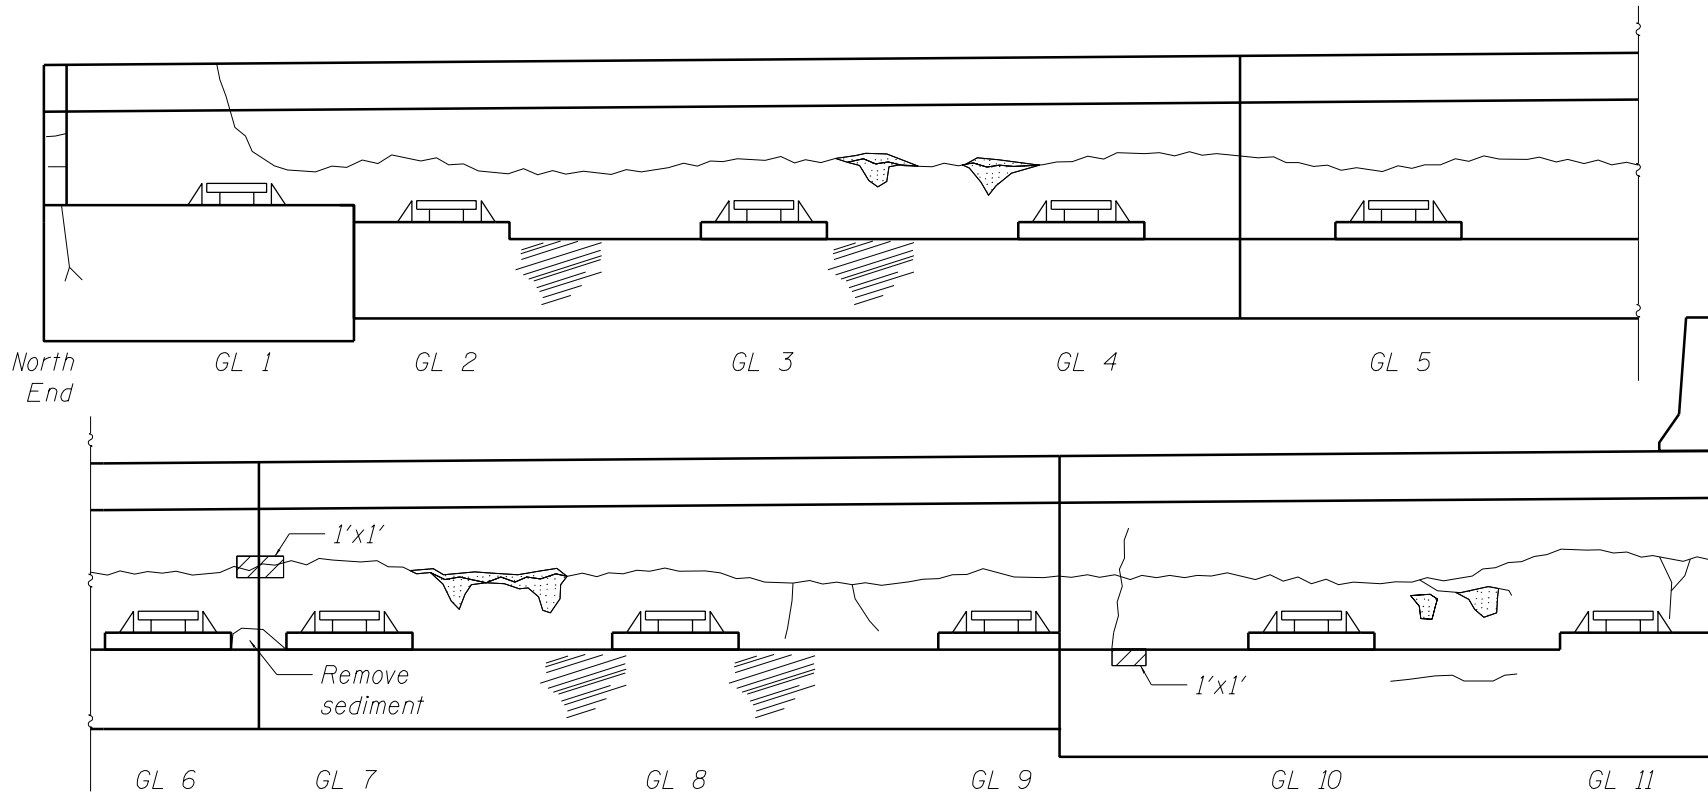


EAST ABUTMENT
NORTH END ELEVATION

	Polymer Modified Portland Cement Mortar	2	Sq Ft.
--	---	---	--------


INSPECTOR	= RJO
INSPECTOR	= JA
INSPECTION DATE	= 5/5/2016

**ILLINOIS DEPARTMENT
OF TRANSPORTATION**

**I-55 OVER S MADISON ST
S.N. 022-0003
EAST ABUTMENT PROPOSED REPAIRS**


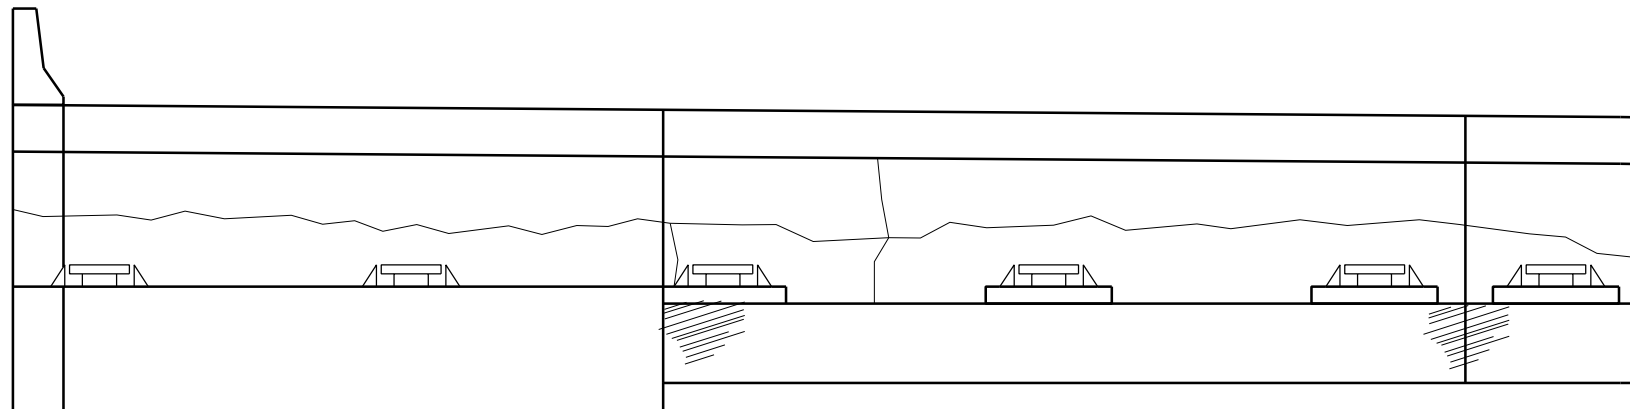


GL 12 GL 13 GL 14 GL 15 GL 16 GL 17

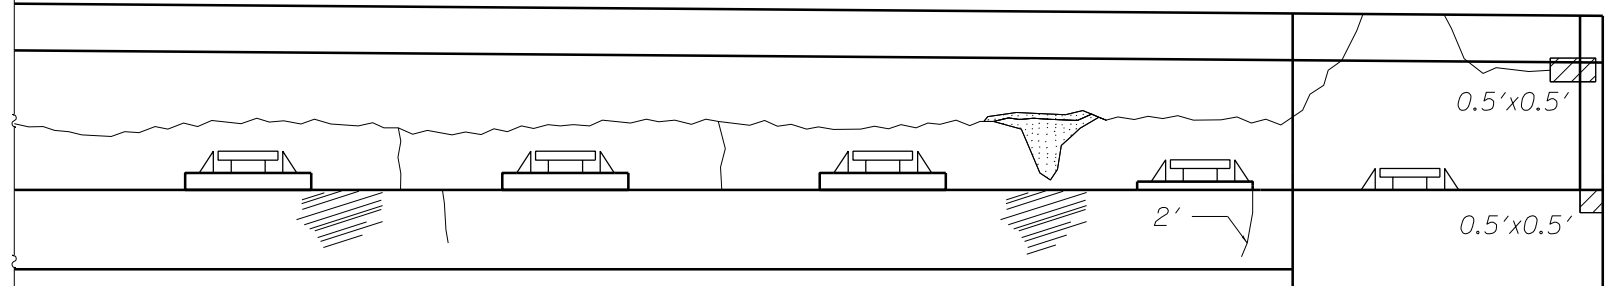

GL 18 GL 19 GL 20 GL 21 GL 22 South End

EAST ABUTMENT
SOUTH END ELEVATION

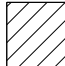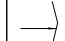
	Polymer Modified Portland Cement Mortar	0.5	Sq Ft.
	Epoxy Crack Injection	2	Ft.

INSPECTOR = RJO
INSPECTOR = JA
INSPECTION DATE = 5/5/2016


**ILLINOIS DEPARTMENT
OF TRANSPORTATION**

**I-55 OVER S MADISON ST
S.N. 022-0003
EAST ABUTMENT PROPOSED REPAIRS**


F:\3-1390_Var\EDIN\006_155\Drawings\Exhibits\022-0003.dgn

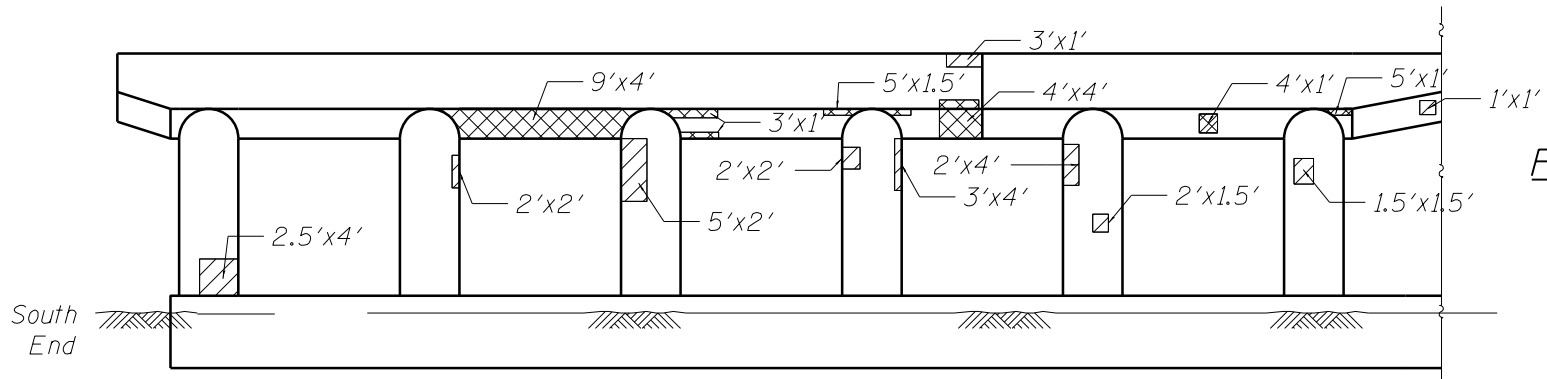


PIER 1: EAST FACE
ELEVATION
& UNDERSIDE

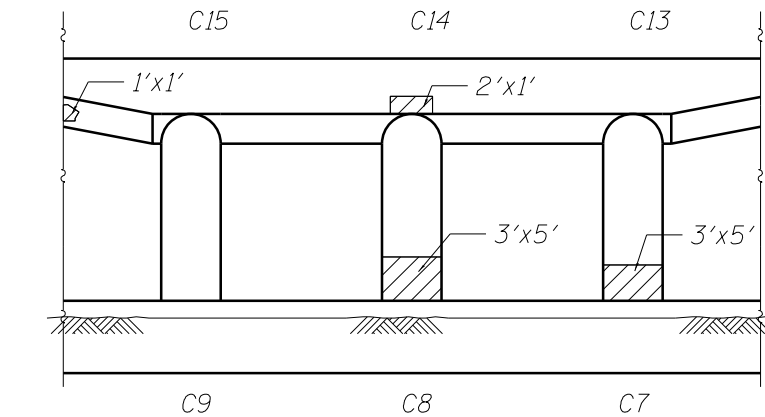

SECTION 3

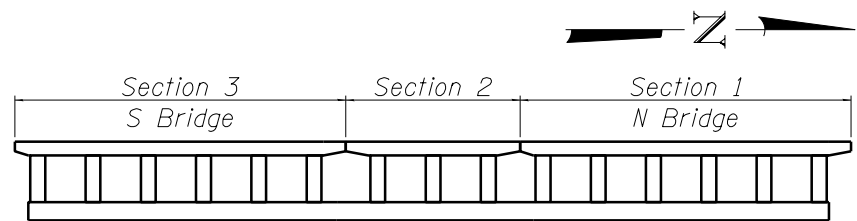

PIER OVERALL

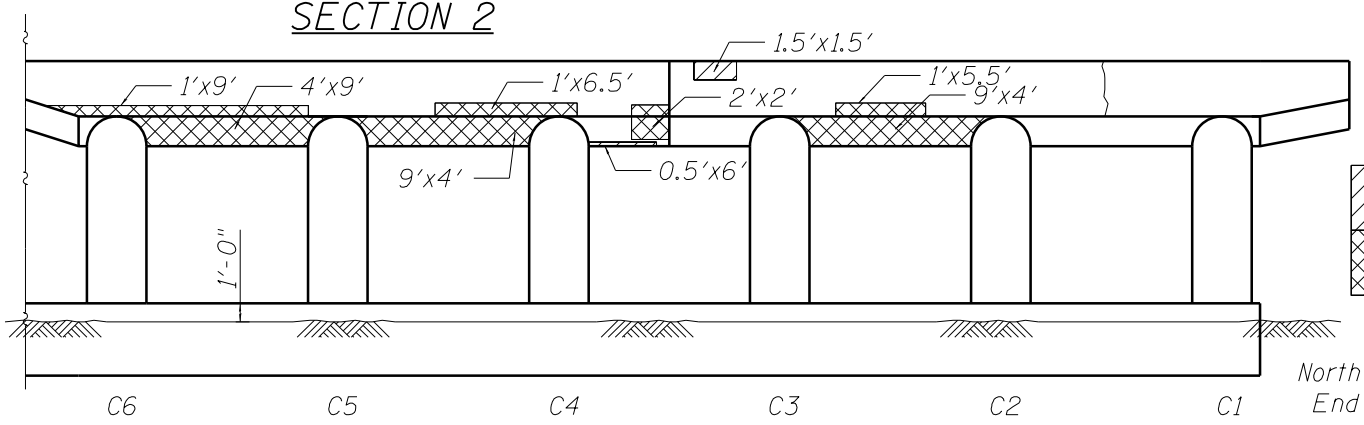

SECTION 2

SECTION 1

	Polymer Modified Portland Cement Mortar	92.5	Sq Ft.
	High Performance Shotcrete	207.5	Sq Ft.


INSPECTOR = RJO
INSPECTOR = JA
INSPECTION DATE = 5/5/2016

ILLINOIS DEPARTMENT OF TRANSPORTATION


I-55 OVER S MADISON ST
S.N. 022-0003
PIER 1 PROPOSED REPAIRS

F:\3-1390_Var\EDIN\006_155\Drawings\Exhibits\022-0003.dgn


PIER 1: WEST FACE
ELEVATION

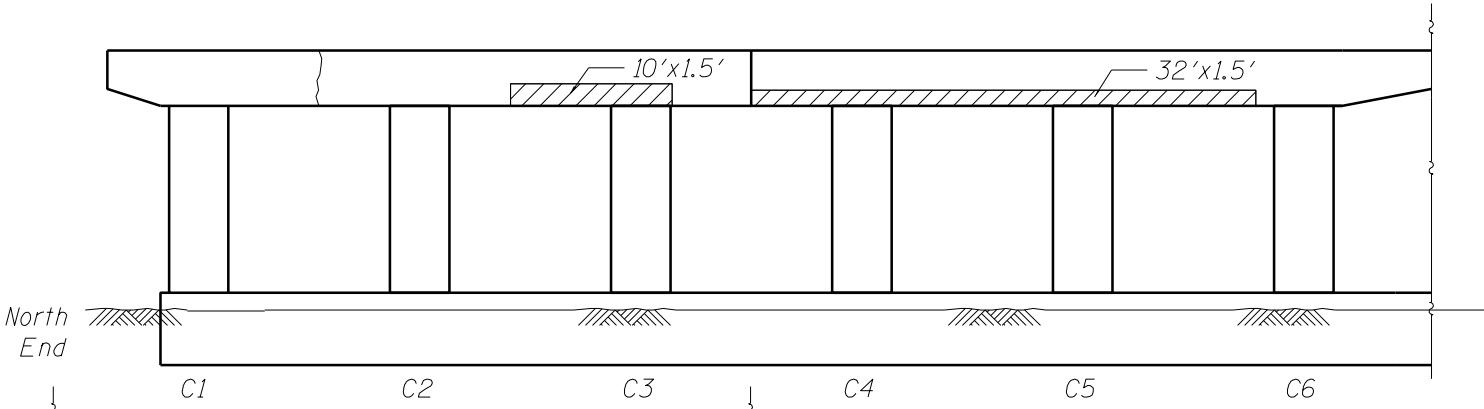


SECTION 1

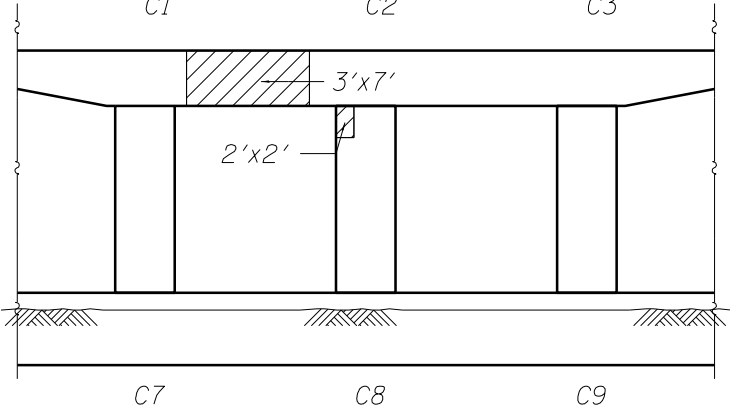

SECTION 2

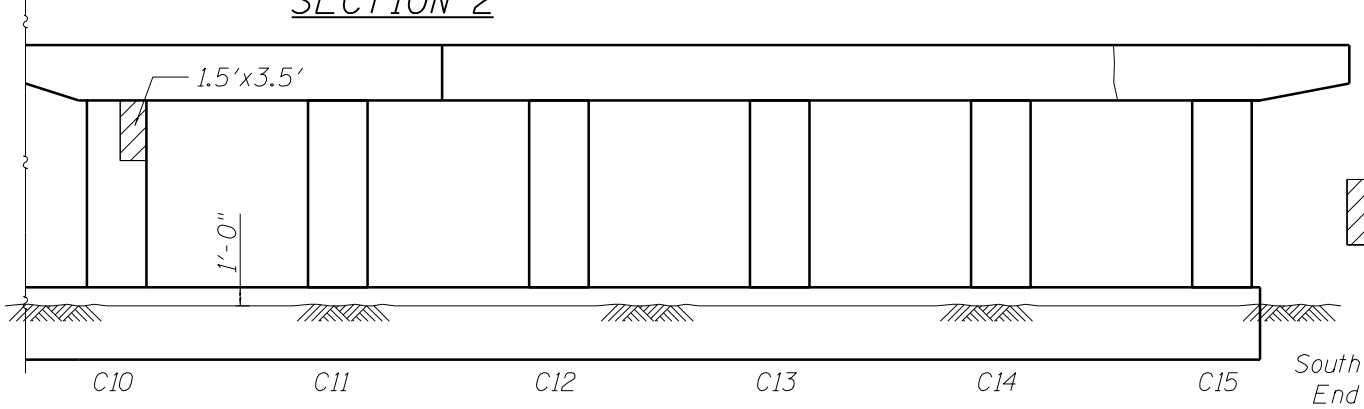

SECTION 3

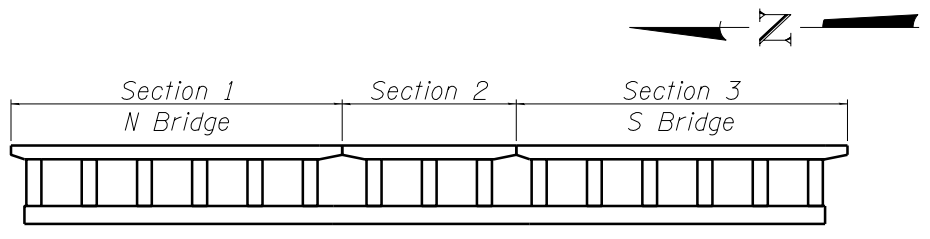

PIER OVERALL




	Polymer Modified Portland Cement Mortar	91.5	Sq Ft.
--	---	------	--------

INSPECTOR	= RJO
INSPECTOR	= JA
INSPECTION DATE	= 5/5/2016


**ILLINOIS DEPARTMENT
OF TRANSPORTATION**

**I-55 OVER S MADISON ST
S.N. 022-0003
PIER 1 PROPOSED REPAIRS**


F:\3-1390_Var\EDIN\006_155\Drawings\Exhibits\022-0003.dgn

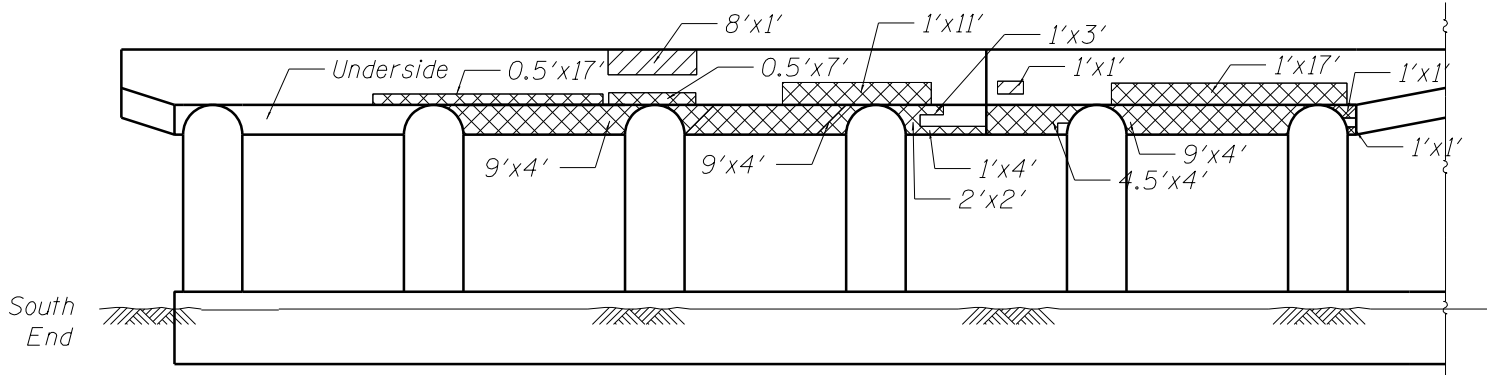


PIER 2: EAST FACE
ELEVATION
& UNDERSIDE

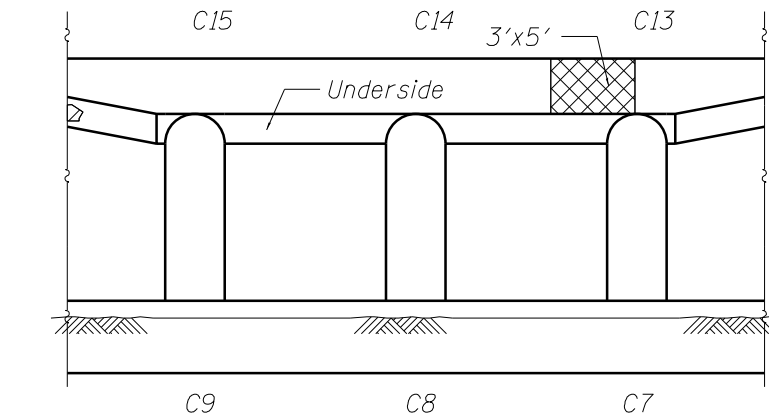

SECTION 3

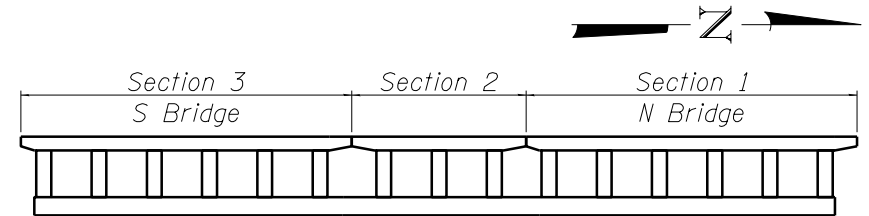

PIER OVERALL

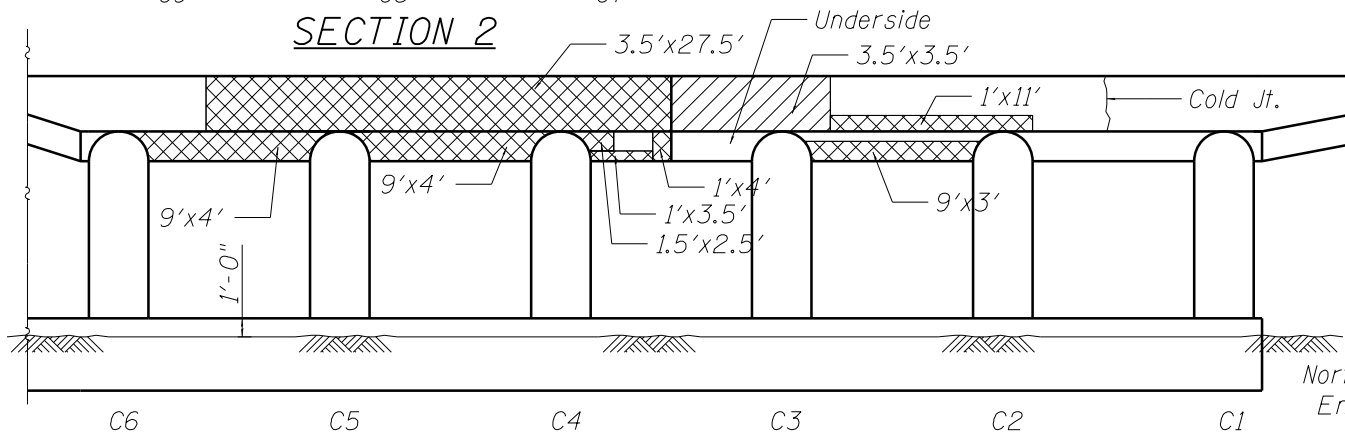

SECTION 2


SECTION 1

	Polymer Modified Portland Cement Mortar	9	Sq Ft.
	High Performance Shotcrete	408.5	Sq Ft.


INSPECTOR = RJO
INSPECTOR = JA
INSPECTION DATE = 5/5/2016

**ILLINOIS DEPARTMENT
OF TRANSPORTATION**


**I-55 OVER S MADISON ST
S.N. 022-0003
PIER 2 PROPOSED REPAIRS**

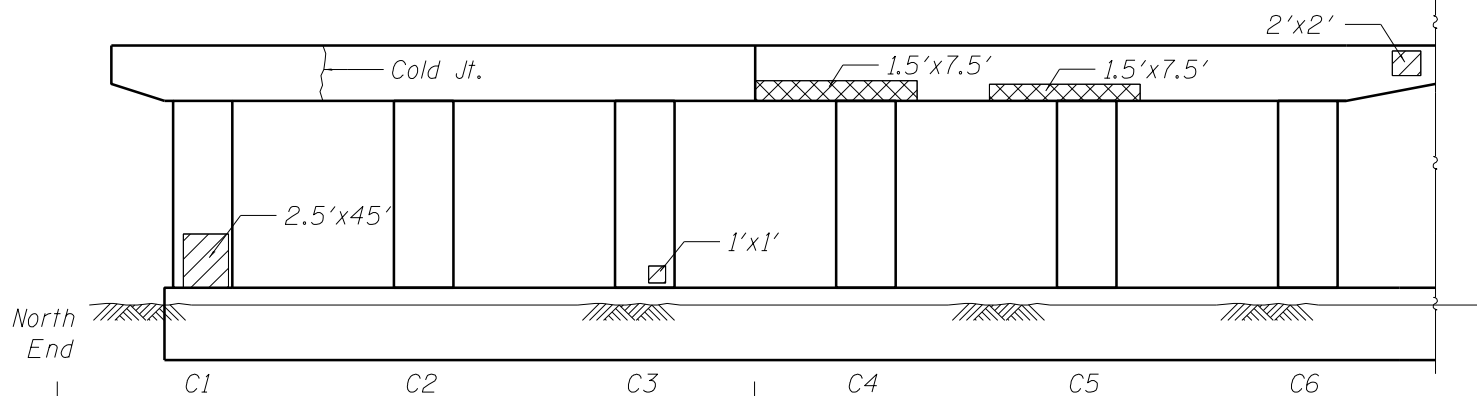


PIER 2: WEST FACE
ELEVATION

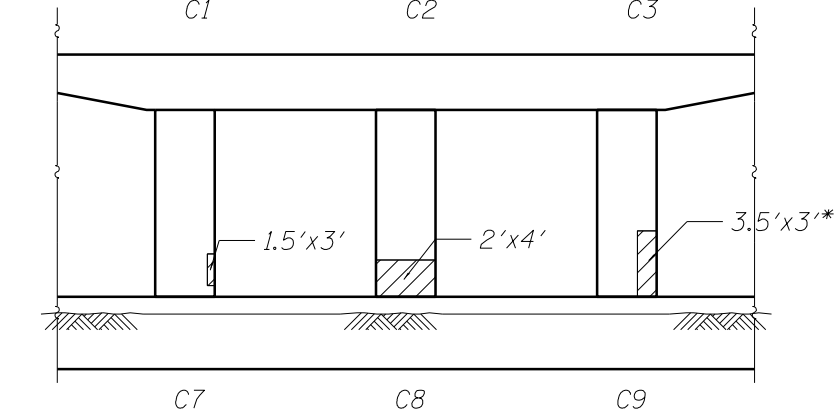

SECTION 2

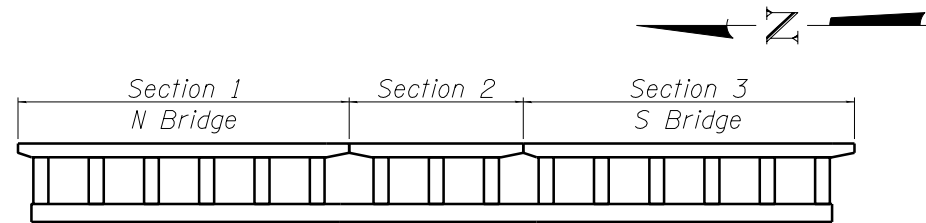

PIER OVERALL

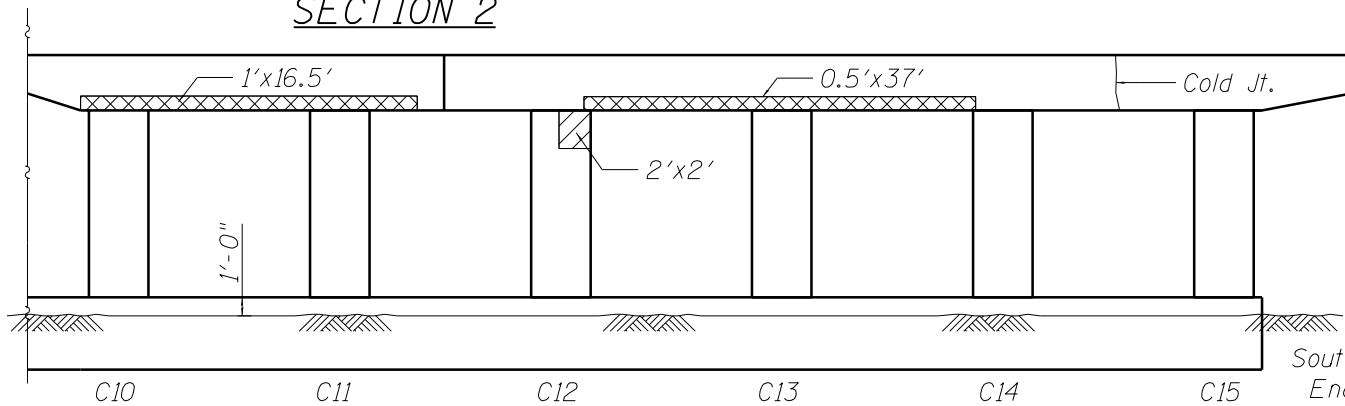

SECTION 3

	Polymer Modified Portland Cement Mortar	43.5	Sq Ft.
	High Performance Shotcrete	57.5	Sq Ft.

* - Defect wraps around column

INSPECTOR = RJO
INSPECTOR = JA
INSPECTION DATE = 5/5/2016

**ILLINOIS DEPARTMENT
OF TRANSPORTATION**

**I-55 OVER S MADISON ST
S.N. 022-0003
PIER 2 PROPOSED REPAIRS**

Attachment H:
Structure Photos



Photo 1: Structure overall, looking north east.



Photo 2: Top of deck looking east from southwest corner, ponding near midspan of south parapet.



Photo 3: Span 1 overall looking south showing debris at base of east slopewall.



Photo 4: Span 2 overall looking south.



Photo 5: Span 3 overall looking south showing fence around west abutment.

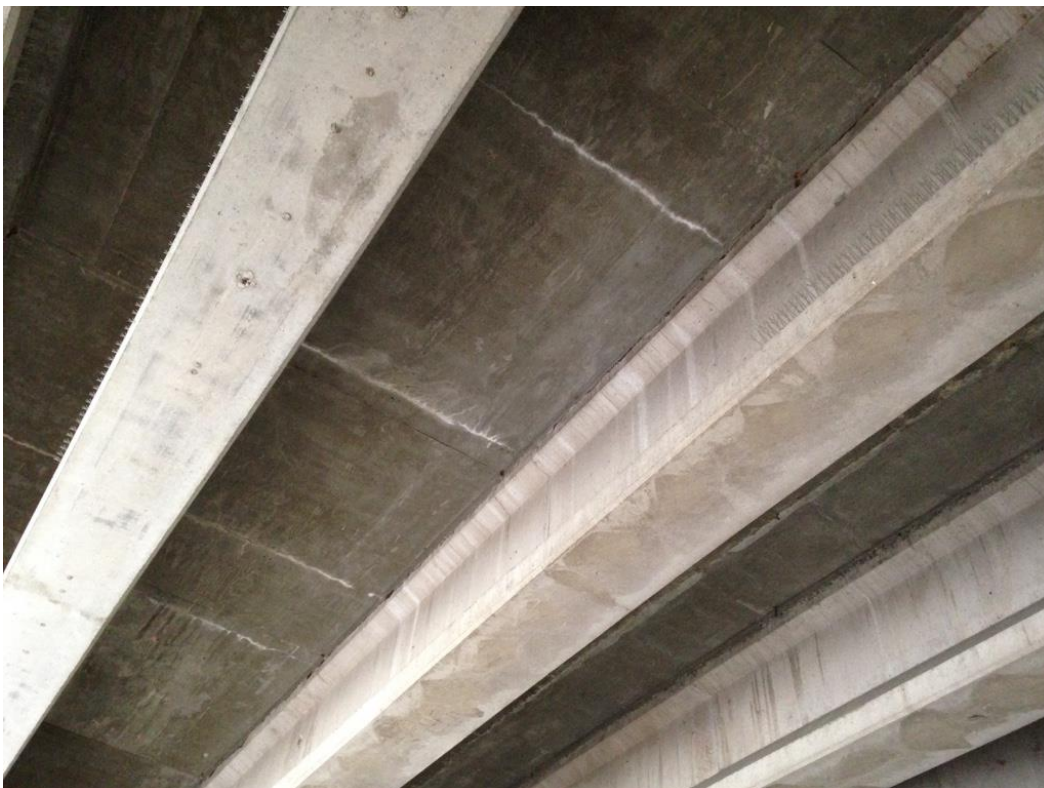


Photo 6: Span 3, bay 5 showing transverse hairline cracks with efflorescence.



Photo 7: Span 3, underside of girder 19 at pier 2 showing spalling with exposed and corroded stirrups.



Photo 8: South face of girder 16 in span 3 showing previously patched area intact.



Photo 9: Diaphragm between girders 21 and 20 at west abutment showing previously patched area intact.



Photo 10: East end of girder 19 showing spalled bottom cover with exposed and corroded bottom row of prestressing strands.



Photo 11: North face of girder 13 over east abutment showing area of delamination above bearing.



Photo 12: Underside of girder 6 over west abutment showing spalling with exposed and corroded reinforcement.



Photo13: South side of structure looking southwest along fascia showing deck drain down spouts.



Photo 14: North side of structure looking southwest along fascia.



Photo 15: Pier 2 overall looking southwest showing build-up of mud on sidewalk.



Photo 16: East face of pier 2 at south end showing addition to pier for widening.



Photo 17: Pier 2, underside of pier cap between columns 13 & 14 showing spalling with exposed and corroded reinforcement.



Photo 18; Pier 2, underside of pier cap between girders 12 & 13 showing spalling with exposed and corroded reinforcement.



Photo 19: Pier 2, underside of pier cap between columns 10 & 11 showing spalling with exposed and corroded reinforcement.



Photo 20: Pier 2, north east face of column 14 showing exposed and corroded spiral reinforcement.



Photo 21: Pier 2, underside of pier cap between columns 3 & 4 showing spalling with exposed and corroded reinforcement on both sides of joint.



Photo 22: Pier 1, southwest face of column 10 showing spalling with exposed and corroded reinforcement near the pier cap.



Photo 23: Pier 1, underside of pier cap between columns 5 & 6 showing spalling with exposed and corroded reinforcement.



Photo 24: Pier 1, underside of pier cap between columns 3 & 4 showing spalling with exposed reinforcement on underside and bottom west corner of pier cap.



Photo 25; East abutment overall looking south along abutment from north end.



Photo 26: West abutment overall looking north along abutment from median.



Photo 27: East abutment back wall south of girder 22 showing spall with loose crack seal and efflorescence.



Photo 28: East bearing under girder 22 (typ.) showing standing water near backwall and corrosion of bearing top plate.



Photo 29: East abutment between girders 19 & 20 showing sediment deposit on abutment seat and light coming through from the top of deck due to missing joint section above.



Photo 30: East abutment between girders 14 & 15 showing approximately 3.5 inch separation of slopewall from abutment seat.



Photo 31: East abutment backwall at median joint showing water staining.



Photo 32: East abutment seat at median joint showing sediment build-up.



Photo 33: East abutment between girders 7 & 8 showing cold joint with efflorescence on backwall and water staining on abutment seat.



Photo 34: West abutment between girders 22 & 21 showing start of addition to abutment for widening.



Photo 35: West abutment between girders 20 & 21 showing water staining on abutment seat.



Photo 36: West abutment between 19 & 20 showing spalling with exposed and corroded reinforcement on abutment seat.



Photo 37: West abutment between girders 14 & 15 showing cold joint with efflorescence on backwall.



Photo 38: West abutment between girders 8 & 9 showing slope wall faulting with an offset of approximately 4 inches.



Photo 39: West abutment between girders 3 & 4 showing large deposit of sediment from the top of deck.



Photo 40: West abutment between girders 3 & 4 showing deposit of sediment and light coming through from top of deck due to missing joint section above.



Photo 41: Southwest wingwall overall (typ.).



Photo 42: Lot to the north west of the bridge showing O.H. electrical lines.



Photo 43: Lot to the north east of the bridge.



Photo 44: Lot to the southeast of the bridge showing dumping location for mud which builds up on the east sidewalk.



Photo 45: Lot to the south west of the bridge showing electrical pole on the east side of S Madison St.



Photo 46: Timber tie-back retaining wall on the north east corner of the bridge starting at the base of the slope wall.



Photo 47: Splitting top members on retaining wall.



Photo 48: Top of deck looking east showing shoulder just beyond east approach slab showing significant cracking and potholes.



Photo 49: Transverse joint on the south west end of the bridge, looking north showing missing sections, exposed steel bolts, abrasion damage on bridge deck concrete and hairline cracking on approach slab.



Photo 50: Transverse joint on north west end of bridge, looking south showing missing sections, exposed steel bolts, and abrasion damage to approach slab concrete.



Photo 51: North west approach slab looking south showing hairline cracking.



Photo 52: Top of deck on north end of bridge, looking west showing hairline longitudinal and transverse cracks on shoulder.



Photo 53: South end of bridge looking west showing deck drain down spouts.



Photo 54: Top of deck showing deck drain free of debris (typ.).



Photo 55: East slopewall looking south showing fence around east abutment.



Photo 56: East approach guardrail on S Madison St. showing impact damage including detachment from first two wood posts.

BRIDGE CONDITION REPORT

REGION: 1

DISTRICT: 1

ROUTE: FAI 055 / I-55 EB

COUNTY: Cook

STRUCTURE NUMBER: 016-0016

LOCATION: I-55 Eastbound over Cicero Avenue



PREPARED BY:  **Stantec**

DATE PREPARED: 12/20/13

PROPOSED LETTING DATE: To Be Determined

TABLE OF CONTENTS

I. GEOGRAPHICAL & ADMINISTRATIVE DATA.....	1
II. PHYSICAL DESCRIPTION OF STRUCTURE	1
III. FIELD INSPECTION & PHYSICAL EVALUATION.....	4
IV. POTENTIAL SCOPE OF WORK DETERMINATION & ANALYSIS.....	7
V. DISCUSSION AND RECOMMENDED SCOPE OF WORK	8
VI. FINAL RECOMMENDATION.....	9
VII. TRAFFIC STAGING	10

ATTACHMENTS:

- A. Location Map
- B. IDOT Master Structure Report
- C. Bridge Inspection Report
- D. Bottom of Deck Condition Survey
- E. Condition Assessment of the Reinforced Concrete Bridge Deck
- F. Substructure Condition Surveys
- G. Opinion of Probable Costs
- H. Proposed Structure Drawings
- I. Structure Photos
- J. Proposed Plan & Profile
- K. Existing and Proposed Roadway Cross Sections
- L. Abbreviated Existing Plans

I. GEOGRAPHICAL & ADMINISTRATIVE DATA

Structure Number: 016-0016
County: Cook
Route Carried: FAI 055 / I-55
Feature Crossed: FAP 0350 / Cicero Avenue
Section: 1112-619-HB
Station: 24+20

Roadway Classification: Federal Aid Interstate
Design/Posted Speed: 70mph / 55mph
***ADT (current/design):** 86,748 (2012) / 120,186 (2040)
***ADTT (current/design):** 13% = 11,277 (2012) / 13% = 15,624 (2040)
***DHV (current/design):** 5,053 (2012) / 7,601 (2040)
Inventory Rating HS: 1.670 – rated 11/05/01
Operating Rating HS: 2.750 – rated 11/05/01
Sufficiency Rating: 80.0
HBP Eligibility: No

* Traffic data per the I-55 Managed Lane Phase I Study

Construction / Reconstruction / Repair History

The structure carrying I-55 Eastbound over Illinois Route 50 (Cicero Avenue) was originally built in 1963 as FAI Route 55 over Cicero Avenue under Project I-55-7(29) 281, Section 1112-619 HB. The original construction consisted of two parallel 3-span structures. The two structures carried I-55 eastbound and westbound traffic. The structure consisted of a 7” concrete slab with steel plate girders and wide flange beams supported by reinforced concrete abutments and piers.

As part of Contract 80059, bridge rehabilitation was performed in 1999. The rehabilitation consisted of removing the bituminous concrete overlay, performing deck repairs, removing and replacing the transverse deck joints, eliminating the longitudinal deck joint, placing a new deck concrete overlay, refurbishing the bearings and repairing the substructure and slopewall.

II. PHYSICAL DESCRIPTION OF STRUCTURE

The physical description of the structure is based on a review of the existing available plans dated December 1962 and 1999. Refer to Attachment L for select existing structure plan sheets. Individual components of the existing structure are described below:

Structure Type and Length: The bridge is a three span simply supported plate girder and wide flange beam structure. Span 1 and 3 consist of plate girders and wide flange beams

and Span 2 consists of plate girders exclusively. The fascia girders in Spans 1 and 3 are plate girders with 66" deep webs. The interior beams in Spans 1 and 3 are W30x108 beams. Span 2 consists entirely of plate girders with 66" deep webs. Each span has 10 beams lines. The bridge is approximately 206'-8 3/4" long measured back-to-back of abutments along the curve. The substructure consists of two reinforced concrete stub abutments with wingwalls and two multi-column reinforced concrete piers. The abutments and the piers are supported by concrete piles. The bridge has a 7" reinforced concrete deck plus overlay.

Number / Length of Spans: There are a total of three spans, with approximate lengths as follows (dimensioned from centerline of bearing to centerline of bearing along the curve). Spans are numbered from west to east.

Span 1: 39'-11 5/8"

Span 2: 112'-6 1/2"

Span 3: 45'-7 1/2"

Skew: 21°-40'-17" Left

Structure Width: The total width is 59'-5 1/2" measured radially out-to-out of the deck. The bridge accommodates three 12' lanes of traffic and 10' inside and outside shoulders.

Expansion Joints: W Abutment: 2" Neoprene Joint
Pier 1: 1 3/4" Preformed Joint Seal
Pier 2: 2 9/16" Neoprene Joint
E Abutment: 1 3/4" Preformed Joint Seal

Bearings: W Abutment:
Beam Line 1, 10 Expansion, Type 2
Beam Line 2 to 9 Expansion, Type 3 w/ bolster

Pier 1:
Beam Line 1, 10 Fixed, Type 1 and Type 2
Beam Line 2 to 9 Fixed, Type 1 and Type 3 w/
bolster

Pier 2:
Beam Line 1, 10 Expansion, Type 1 and Type 2
Beam Line 2 to 9 Expansion, Type 1 and Type 3
w/ Bolster

	E Abutment:
	Beam Line 1 Fixed, Type 2
	Beam Line 2 to 9 Fixed, Type 3 w/ bolster
	Beam Line 10 Fixed, Type 2
Approach Roadway Template:	The approach roadway template matches the bridge. It has three 12' lanes of traffic and 10' inside and outside shoulders.
Existing Wearing Surface:	2 3/8" Micro Silica Concrete Overlay
Existing Vertical Alignment:	The entire structure is on a +1.50% tangent slope going from west to east.
Existing Horizontal Alignment:	The structure is on a curve at a radius of 3819.72' from Station 19+41.41 to Station 32+86.83.
Existing Vertical Clearance:	15'-7 3/8" over Cicero Avenue according to the 1999 repair plans. 15'-5" according to the Master Structure Report which needs to be verified.
Existing Drainage:	There are no drains on the bridge deck or approach slabs.
Parapets and Railings:	There are 1'-8 3/4" wide exterior curb and parapets running the length of the bridge. Parapets were modified in 1999 plans to remove a 9" tall by 1'-0" wide existing handrail and replaced with a 9" tall x 1'-0" wide reinforced concrete section. Per the IDOT Bridge Inspection Report dated 12/10/12, the guardrail currently meets acceptable standards while the guardrail ends and transitions do not.
Existing Utilities Attachments:	There are no light poles attached to the bridge, but there are abandoned conduits running along the south fascia beam and the West Abutment. There is a conduit running along the outside of the South Parapet. There are light fixtures and conduits on the insides of both piers and at the midspan of Beam Lines 1, 6 and 9.
Name Plate:	No name plate was found on the structure.

III. FIELD INSPECTION & PHYSICAL EVALUATION

A field inspection beneath the structure carrying I-55 Eastbound over Cicero Avenue was performed by Stantec on August 21, 2013. The top of deck inspection was performed on September 16, 2013. The high temperature on that date was 65° F. The visual field inspection was performed on foot on the sloped wall, sidewalk and the top of deck. The following conditions were observed:

Deck

Deck

The deck was rated in satisfactory condition (NBIS Rating = 6) in the 12/10/12 NBIS inspection. The deck condition observed during this inspection was consistent with the NBIS rating. The underside of deck has multiple areas of delamination, spalling and map cracking. Based on visual inspection, approximately 2.2% of the underside of deck is delaminated or spalled.

The micro-silica concrete overlay on the top of deck has minor hairline transverse and longitudinal cracking mostly along the shoulders. One 3 square foot spall was found in the center lane in Span 2. Wiss, Janey and Elstner performed a condition assessment of the reinforced bridge deck in January 2012. This assessment included a delamination survey performed on the top of the bridge deck using infrared thermography. The infrared thermography indicated 5.6% of the top of deck area was delaminated. See Attachment E for the condition assessment of the reinforced bridge deck. See Attachment I – Photos 1 through 8.

Parapets

The parapets are in satisfactory condition with hairline vertical cracking throughout and minor delaminations and spalls on both the interior and exterior faces of the parapet. The interior face of the South Parapet has approximately 20 square feet of delaminated concrete. The interior face of the North Parapet has approximately 30 square feet of delaminated concrete. The exterior face of the South Parapet has longitudinal hairline cracking with rust staining along most of the length of the parapet. See Attachment I - Photos 9 and 10.

Joints

The preformed joint seals at the East Abutment and Pier 1 and the neoprene joints at West Abutment and Pier 2 are in satisfactory condition with debris in the joint and minor impact damage. The joint widths were measured when the temperature was approximately 65° F. The preformed joint at the East Abutment measured 1" wide. The preformed joint at the Pier 1 measured 1". The neoprene joint at the Pier 2 measured 2 1/8". The neoprene joint at the

West Abutment measured 1 11/16". See Attachment I – Photos 11 through 14.

Superstructure

Beams

The superstructure consists of three simple spans of rolled steel beams and welded plate girders. The beam lines are numbered 1 through 10, numbered from north to south. In Spans 1 and 3, Beam Lines 1 and 10 consist of plate girders with 66" deep webs and Beam Lines 2 through 9 consist of W30x108 beams. In Span 2, all of the beam lines consist of plate girders with 66" deep webs. This structure has welded cover plates on the bottom flanges of the beams in Span 3.

The superstructure was rated in fair condition (NBIS Rating = 5) in the 12/10/2012 NBIS bridge inspection due to initial section loss and minor pitting. The superstructure observed during this inspection was consistent with the NBIS rating.

The steel superstructure typically has paint starting to fail, minor rust and initial section loss and minor pitting. In both Spans 1 and 3, the steel bolsters have been welded transversely to the W30x108 beams. These welds have mostly cracked. Bolts connect the top of the bolster to the bottom flange as part of a retrofit done in 1999. In Span 3, the steel beams have welded cover plates with fatigue category E' details. The welded cover plates were visually inspected from the ground and no defects were noted on the welds. See Attachment I – Photos 15 through 19.

Bearings

The bearings are in satisfactory condition with paint starting to fail and minor rust. No excessive tilting was noted during the inspection.

Utilities

The conduits along the South Fascia Beam and South Abutment are in poor condition with heavy deterioration and open conduit covers. See Attachment I – Photos 20 and 21.

Substructure

The substructure was rated in satisfactory condition (NBIS Rating = 6) in the 12/10/2012 NBIS bridge inspection due to cracks and spalls at the abutment caps and pier columns. The substructure condition observed during this inspection was not consistent with the NBIS rating due to the condition of the piers.

Abutments

The reinforced concrete abutments are in satisfactory condition with multiple hairline vertical cracks and small areas of delaminated/spalled concrete. There is 6 square feet of spalled concrete on the West Abutment. There is 10 square feet of spalled/delaminated concrete on the East Abutment. At both abutments, a minor amount of fill appears to be leaking thru the joint in the backwall. No significant defects were noted at the wingwalls. See Attachment F for the Substructure Condition Survey. See Attachment I – Photo 22 through 26.

Piers

The reinforced concrete piers each consist of four columns with a pier cap. The piers are in fair condition with moderate to heavy delaminations and spalls on the columns and pier caps. Pier 1 has approximately 200 square feet of spalled or delaminated concrete. Pier 2 has approximately 106 square feet of spalled or delaminated concrete. See Attachment F for the Substructure Condition Surveys. See Attachment I – Photo 27 through 30.

Slope Protection

The bridge has concrete slope walls. Both slopewalls are in satisfactory condition with minor hairline cracking throughout. The curb at the East Slopewall has separated from the rest of the slopewall, allowing undermining to occur at the south end. The West Slopewall has a 4' x 4' spall on the slopewall curb and a 1/16" transverse crack that goes the full width of the bridge. See Attachment I – Photo 31 through 34.

Inspection History (NBIS Ratings)

Year	Deck	Super	Sub
2012	6	5	6
2011	6	6	6
2009	6	7	6

Geometric, Horizontal & Vertical Clearance / Hydraulic Data

Geometry

I-55 over Cicero Avenue is on a skew. According to the original plans of December 1962 and the repair plans of 1999, the skew at the intersection of the centerlines of I-55 and Cicero Avenue is 21°-40'-17" Left. The typical roadway section for I-55 consists of three 12' lanes, a 10' inside shoulder, a 10' outside shoulder, a 1'-8 3/4" wide curb and parapet on each side of the structure. The I-55 profile grade is on a tangent at +1.50% going from west to east. The structure is on a horizontal curve at a radius of 3819.72' from Station 19+41.41 to Station 32+86.83. The repair plans from 1999 show the vertical minimum clearance at 15'-7 3/8". However, the Master Structure

Report shows the minimum vertical clearance at 15'-5" under the "Key Route under Data" which needs to be verified.

The typical roadway section for Cicero Avenue consists of three lanes in each direction beneath the structure and a raised concrete median. Cicero Avenue is listed as a principal arterial route. Cicero Avenue is located on a 200-ft. long vertical crest curve with 0.36% and -0.30% slopes going from north to south.

As part of the I-55 Managed Lane Phase I Study, I-55 Eastbound at Cicero Avenue will be widened to the inside to accommodate a proposed 12' managed lane. In the eastbound direction, a 4' buffer between the managed lane with 12.5' shoulder and the general purpose traffic lanes is proposed in this 60 foot median section. This widening will be incorporated into the recommended scope of work for this structure.

Hydraulics

At the structure, the I-55 profile is on a +1.50% tangent going from west to east. The bridge deck cross-section is superelevated 3.3%. There are no deck drains on the bridge deck. Therefore, the water is allowed to flow to the deck joints as it runs off the bridge.

IV. POTENTIAL SCOPE OF WORK DETERMINATION & ANALYSIS

As part of the I-55 Managed Lane Phase I Study, In-Kind Repairs, Structure Widening and Structure Replacement alternatives will be evaluated.

Per Section 2.4.2.4 of the IDOT Bridge Manual, consideration was given to retrofit all end of cover plate locations due to average daily truck traffic. From this information, it was determined that a fatigue evaluation was required. The transverse welds at the ends of the cover plates in Span 3 were evaluated for fatigue life and it was determined that the mean service life is less than 50 years. A cover plate retrofit should be installed.

1. In-Kind Repairs

Perform partial and full depth repairs and apply Protective Coat to the existing deck. Repair areas of spalled or delaminated concrete on the existing substructure units. Perform retrofit repairs on the existing Span 3 cover plates.

2. Structure Widening

Remove and replace the deck and approach slabs and widen both approximately 18' to the north. Remove both the northeast and northwest wingwalls and build an extension onto the north side of both abutments. Build an extension onto the north side of both piers.

Install three new beam lines using W30 steel beams and plate girders that will be composite to the widened bridge deck. The new W30 beam will be larger than the existing W30 to account for the bottom flange cover plate. Perform retrofit repairs on the existing Span 3 cover plates. Repair areas of spalled or delaminated concrete on the existing substructure units.

3. Superstructure and Partial Substructure Replacement

Remove and replace the existing W30 steel beam and steel plate girder superstructure with a continuous three-span galvanized steel plate girder superstructure. Remove and replace pier caps and columns, but reuse the existing pier crash walls and footings. Build an extension onto the north side of both piers. Replace the existing abutments with integral abutments placed behind the existing abutments. Replace concrete slope walls. The deck geometry will accommodate the proposed roadway geometry from the I-55 Managed Lane Phase I Study.

4. Structure Replacement

Remove and replace the entire structure with a continuous three-span galvanized steel plate girder superstructure on integral abutments. The deck geometry will accommodate the proposed roadway geometry from the I-55 Managed Lane Phase I Study.

V. DISCUSSION AND RECOMMENDED SCOPE OF WORK

The opinion of probable costs for each of the alternatives is summarized below. See Attachment G for the opinion of probable costs breakdown.

- 1. In-Kind Repairs - \$194,400**
- 2. Structure Widening - \$2,546,200**
- 3. Superstructure and Partial Substructure Replacement - \$5,403,600**
- 4. Structure Replacement - \$6,004,700**

Per the I-55 Managed Lane Phase I Study, the managed lane is expected to be implemented in 2020. All widening and replacement alternatives below assume widening approximately 18' to the centerline of I-55 to accommodate the new managed lane. The proposed structure will provide a 9'-6" outside shoulder, three 12'-0" general purpose traffic lanes, a 4' buffer between the general purpose traffic lanes and the 12'-0" managed traffic lane and a 12'-6" inside shoulder.

Analysis of Alternative 1 – The calculated percent of deck area requiring full depth repairs is 2.2% and the partial depth repairs is 12.0%. The total deck repair percentage is within the 25% limit presented in the Bridge Condition Report Procedures and Practices Manual for bridge deck repair to be cost effective for a deck not being widened. This alternative can be used to extend the life span of the

existing superstructure in the interim prior to implementing the changes required for the Managed Lane project.

Analysis of Alternative 2 – The calculated percent of deck area requiring full depth repairs is 2.2% and partial depth repairs is 11.0%. Since this deck is 50 years old and has recommended repair area near the upper limit (15%) presented in the BCR Procedures and Practices Manual for a widened deck, it is recommended to replace the deck at the time of widening. Cover plate retrofits will be necessary. Deck joints will remain with this alternative, which will lead to continued degradation of the beams and substructure units. This alternative keeps the existing pier caps in service, which have already been repaired as a result of extensive degradation in 1999.

Analysis of Alternative 3 – This alternative replaces the existing W30 steel beam and steel plate girder superstructure with a continuous three-span galvanized steel plate girder superstructure on integral abutments. The proposed integral abutments will be placed behind the existing abutment to help avoid the existing piles. The resulting assumed span arrangement is approximately 70'/114'/70' measured between the centerline of bearings. Uplift at the abutments must be considered in the design phase given the relatively short exterior spans in the continuous structure. Reusing the existing pier crash walls and footings will simplify construction since it will minimize construction impact to Cicero Avenue.

Using galvanized steel eliminates the need to periodically repaint the beam. Providing a continuous structure will also allow for a reduced girder depth over Cicero Avenue, thereby increasing vertical clearance. The longer exterior spans provide an opportunity to relocate the sidewalks, or a multi-use path, along Cicero Avenue behind the piers. Providing new pier caps, pier columns and integral abutments places the critical portions of the substructure on the same life cycle as the superstructure. Eliminating the deck joints will also help to prevent premature degradation of these substructure elements.

Analysis of Alternative 4 – This alternative completely eliminates the 50-year old structure and replaces it with a new structure with an expected 75-year service life.

The benefits of this alternative are similar to Alternative 3, with the addition of removing and replacing the pier crash walls and pier footings. However, this alternative adds construction complications of reconstructing the piers on or near the same footprint as the existing pier footings, and increases construction impacts to Cicero Avenue. The cost is also greater than Alternative 3 due to the removal and reconstruction of the additional pier elements.

VI. FINAL RECOMMENDATION

Stantec recommends Alternative 3 – Superstructure and Partial Substructure Replacement when the I-55 Managed Lane Project occurs. The selected alternative provides a new superstructure and replaces the critical portions of the substructure. Eliminating the deck joints will help to prevent premature degradation of the


replaced substructure elements. As the I-55 Managed Lane Phase I Study is ongoing, the bridge widening to be presented in the TSL should match the final geometry as presented in the final I-55 Managed Lane Phase I Study. Future improvements to Cicero Avenue, to be determined at a later date, should also be addressed in the TSL.

VII. TRAFFIC STAGING

For Alternatives 2, 3 and 4, the existing deck is wide enough to provide two lanes of traffic in the eastbound direction during stage construction. For Alternative 1, the lanes can be temporarily closed as needed to allow for the deck repairs. The traffic staging design will need to be confirmed by IDOT traffic prior to being implemented.

ATTACHMENT A

Location Map

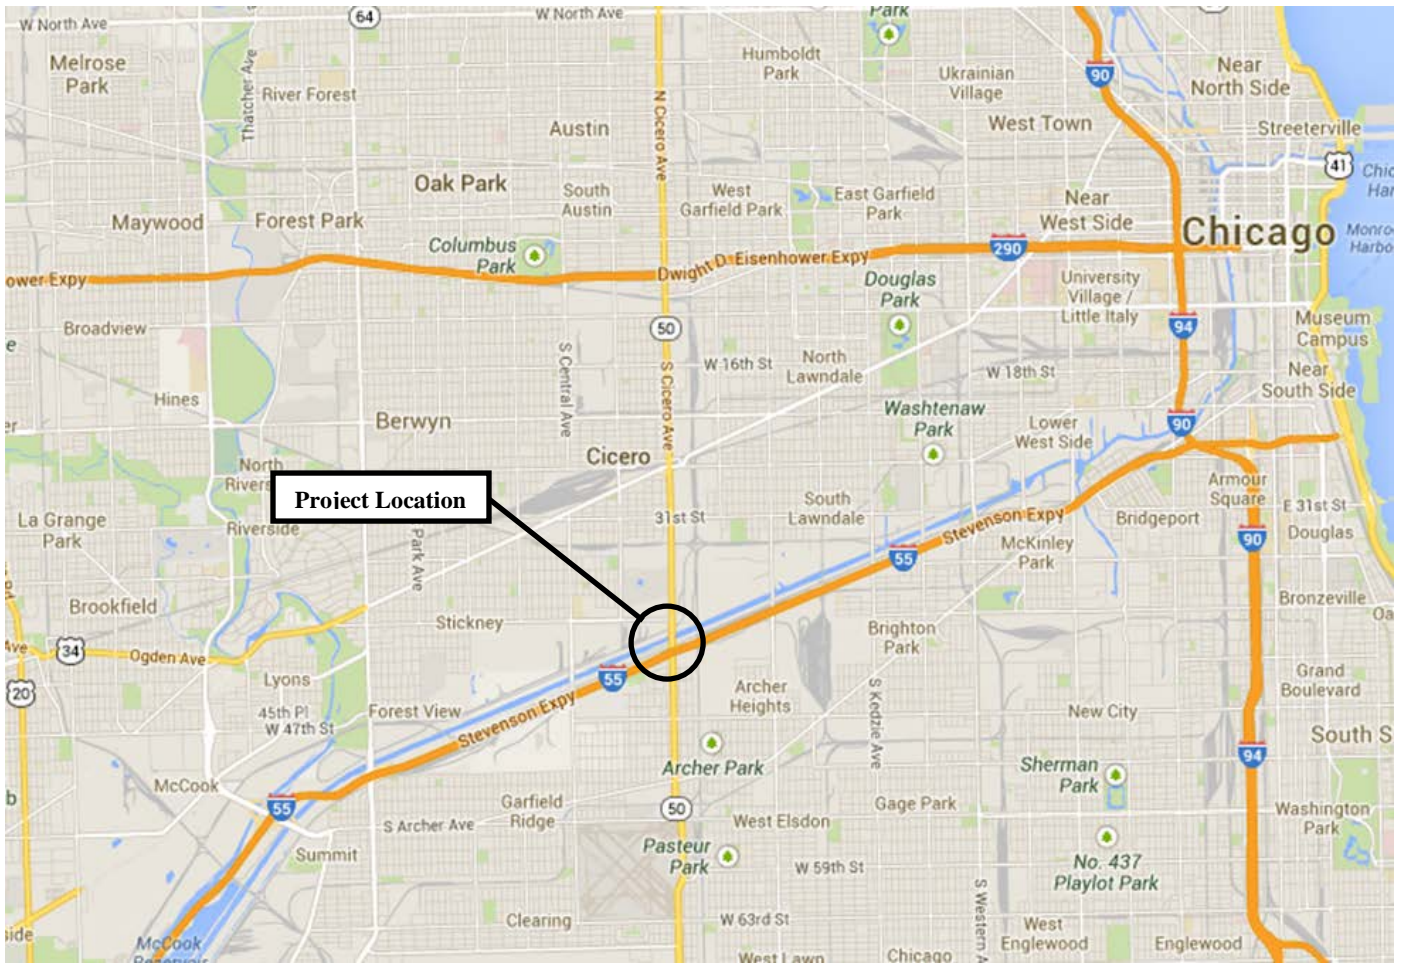


Project Location

N

Location Map

Proposed Improvement:

I-55 over Cicero Avenue (Eastbound)

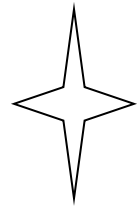

Municipality: Stickney

County: Cook

Route: FAI 055

Project No: P-91-762-10

Structure No.: 016-0016

ATTACHMENT B

IDOT Master Structure Report

**Illinois Department of Transportation
Structures Information Management System
Structure Summary Report**

Date: 10/08/2013

Page: 1

Structure Number: 016-0016

District: 1

Inventory Data

Facility Carried:	I-55 EB STEVENSON	Bridge Name:		Sufficiency Rating:	80.0	Structure Length:	206.7
Feature Crossed:	IL 50 (CICERO AVE)	Location:	5.7 M SW I94	HBP Eligible:	No	AAASHTO Bridge Length:	99.9
Bridge Remarks:		Status Date:	12/2000	Replaced By:	-	Length of Long Span:	115.0
Bridge Status:	1 OPEN - NO RESTRICT	Maint Township:	34 STICKNEY	Replaces:	-	Bridge Roadway Width:	56.0
Status Remarks:				Last Update Date:	03/12/2013	Appr Roadway Width:	60.0
Maint County:	016 COOK			Parallel Structure:	Right	Deck Width:	59.4
Maint Responsibility:	01 I.D.O.T.			Multi-Level Structure Nbr:		Sidewalk Width Right:	0.0
Service On/Under:	5 SECOND LEVEL INTERCHANGE	1 / HIGHWAY		Skew Direction:	L	Sidewalk Width Left:	0.0
Reporting Agency:	1 I.D.O.T. - BUREAU OF MAINTENANCE			Skew Angle:	22 D 0 M 0 S	Navigation Control:	N
Main Span Matl/Type:	3 STEEL	/ 02 STRINGER/MULTI-BEAM/GIRDER		Structure Flared:	No	Navigation Horiz Clear:	0
Nbr Of Main Spans:	3	Nbr Of Approach Spans:	0	Historical Significance:	No	Navigation Vert Clear:	0
Approaches							
Near #1 Matl/Type:	/			Border Bridge State:		Culvert Fill Depth:	0.0
Near #2 Matl/Type:	/			Bdr State SN:		Number Culvert Cells:	0
Far #1 Matl/Type:	/			Bdr State % Responsibility:	0	Culvert Opening Area:	0.0
Far #2 Matl/Type:	/			Structural Steel Wt	996000	Culvert Cell Height:	0.00
Median Width/Type:	0 Ft. / 0	None		Substructure Material:		Culvert Cell Width:	0.00
Guardrail Type L/R:	0None	/ 0		Rated By:	2 IDOT	Rate Method:	1 LOAD FACTOR
Toll Facility Indicator:	0 No Toll			Load Rating Date:	11/05/2001	Railroad Crossing Info	
Latitude:	41 D 49 M 1.05 S	Longitude:	87 D 44 M 38.11 S	Design Load:	01 HS20+MOD	Crossing 1 Nbr:	
Deck Structure Type:	A	CIP CON NRMALLY FORM		Deck Structure Thickness:	7 SD: N FO: N	Crossing 1 Nbr:	
Sidewalks Under Structure:	2	Both Sides Not Separate				RR Lateral Underclear:	0 Ft 0 In

Key Route On Data

Key Route Nbr:	FEDERAL-AID INTERSTATE	Station:	0055	Segment:	10:2500
Appurtenances	Main Route				
Inventory County:	016 COOK	Linked:	Y		
Township/Road Dist	34 STICKNEY	Natl. Hwy System:	On NHS		
Municipality	5540 STICKNEY	Inventory Direction:			
Urban Area:	1051	Curr AADT Yr/Count:	2012 / 61150		
Functional Class:	1 INTERSTATE	Est Truck Percentage:	13		
** CLEARANCES **	South/East	Number Of Lanes:	3		
Max Rdwy Width:	56.0	One Or Two Way:	1 One-Way		
Horizontal:	57.5	Bypass Length:	0		
		Future AADT Yr/Cnt:	2032 / 75808		
		Designated Truck Rte:	CLASS I		
Lateral:		Special Systems:	Yes		

Key Route Under Data

FEDERAL-AID PRIMARY	Station:	0350	Segment:	18:7100
Main Route				
016	Linked:	Y		
62 LAKE (CHICAGO)	Natl. Hwy System:	On NHS		
1051 CHICAGO	Inventory Direction:			
1051	Curr AADT Yr/Count:	2011 / 61600		
3 OTHER PRINCIPAL ARTERIAL	Est Truck Percentage:	12		
South/East	Number Of Lanes:	7		
101.9	One Or Two Way:	2 Two-Way		
101.9	Bypass Length:	0		
	Future AADT Yr/Cnt:	2032 / 63448		
	Designated Truck Rte:	CLASS II		
	Special Systems:	Yes		

***** Marked Route On Data *****

Route #1:	1	Mainline		Kind		Number	
Route #2:	1	Mainline	1	Interstate Highway		055	
Route #3:	1	Mainline					

***** Marked Route Under Data *****

Route #1:	1	Mainline		Kind		Number	
Route #2:	1	Mainline	3	State Highway		050	
Route #3:	1	Mainline					

**Illinois Department of Transportation
Structures Information Management System
Structure Summary Report**

Date: 10/08/2013

Page: 2

Structure Number: 016-0016 District: 1

Data Related to Inspection Information

*** Inspection Intervals *** *** Maximum Allowable Posting Limits ***

Routine NBIS: 24 MOS Underwater: 0 MOS One Truck At A Time: 0 Combination Type 3S-1: Tons Bridge Posting Level: 5 No Posting Required
 Special: N Single Unit Vehicles: Tons Combination Type 3S-2: Tons

Inspection/Appraisal Information

Inspection Date: 12/10/2012 Inspection Temperature: 35Deg. F ** Actual Posted Limits **
 Deck: 6 SATISFACTORY CONDITION - MINOR DETERIORATION Single Unit Vehicles: Tons
 Superstructure: 5 FAIR CONDITION - MINOR SECTION LOSS, CRACKS Combination Type 3S-1: Tons
 Substructure: 6 SATISFACTORY CONDITION - MINOR DETERIORATION Combination Type 3S-2: Tons
 Culvert: N NOT APPLICABLE One Truck At A Time: 0
 Channel and Protection: N NOT APPLICABLE Deck Wearing Surf: F MICRO SIL CON OVRLY Last Paint Type: U
 Structural Evaluation: 5 BETTER THAN ADEQUATE TO BE LEFT IN PLACE Deck Membrane: F NONE FLD AL EPY & ACRLC
 Deck Geometry: 6 EQUAL TO PRESENT MINIMUM CRITERIA Deck Protection: J NONE
 Underclearance-Vert/Lat.: 4 MINIMUM ADEQUACY TO BE LEFT IN PLACE Total Deck Thick: 8.9
 Waterway Adequacy: N NOT APPLICABLE Last Paint Date: 10/2000
 Approach Roadway Align: 8 EQUAL TO PRESENT DESIRABLE CRITERIA
 Bridge Railing Appraisal: 3 Meets Standards
 Approach Guardrail: 233 Not Acceptable Acceptable
 Pier Navig Protection: N N/A

Underwater Inspection/Appraisal Information

Inspection Date: Inspection Category:
 Temperature: Inspection Method: Appraisal Rating:

Scour Critical Information

Rating: Evaluation Method:

Miscellaneous

Analysis Date: Microfilm Data Recorded: Yes

Construction Information

Year: 1963 Original Reconstructed
 Route: FAI-55 Sta: 24+20 Sta:
 Section Nbr: 1112-619-HB
 Contract Nbr:
 Fed Aid Prf#: I 0557029281
 Built By: 1 I.D.O.T.

Waterway Information

Flood Design Frequency:
 Flood Design Q (CFS):
 Flood Design Nat H W E:
 Flood Des Open Prop:

YRS Drainage Area:
 Flood Base Q (CFS):
 Flood Base Nat H W E:

ATTACHMENT C

Bridge Inspection Report



SN: 016-0016	District: 1	Spans: 3	Appr. Spans: 0	Skew: 22.00	ADT: 61150	Truck Pct: 13
ADT Un: 61600	Maint. Co: COOK	Twsp: STICKNEY	Status: OPEN - NO RESTRICT			
Facility Carried: I- 55 EB STEVENSON			Feature Crossed: IL 50 (CICERO AVE)			
Location: 5.7 M SW I94		Municipality: STICKNEY	Team/Sub Section: E26019			
Bridge Name:			Material & Type: STEEL/STRINGER/MULTI-BEAM/GIRDER			
Insp. Intervals (Mo) Routine NBIS: 24		Fracture Critical: 0	Underwater: 0	Special Feature: N/A		
90 - Inspection Date: / /		90C - Temp. (°F):	90A - Program Manager:			
Is Delinquent: <input type="checkbox"/>		Reason:				
90A1 - Team Leader:			90A2 - Inspector:			

90B - Inspection Remarks:

Previous Inspection	2008) DK SOFFIT MAP CRKD & JOINTS LEAKING. STL BMS-SPAN 2 MINOR RUST @BOTT FLANGES. PIER CANTILEVERS MAP CRKD. PIER 2 COL 1 MAP CRKD. 2012) Item 59 lowered to "5" due to init sec loss/minor pitting a@ brng areas of few bm ends above P
------------------------	--

Resources

Time to Inspect (H:M): 1:0	Traffic Control: 3	Boat:	Waders:	Snooper:
Ladder: LL	Manlift:	Bucket Truck:	Other:	

Inspector's Appraisals

	Prev	New	Comments
58 - Deck Condition:	6		
59 - Superstructure Cond:	5		
60 - Substructure Cond:	6		
62 - Culvert Condition:	N		
61 - Channel Condition:	N		
71 - Waterway Adequacy:	N		
72 - Approach Rdw Align:	8		
111 - Pier Navig Protection:	N		

90B - Inspector Remarks:

Routine Inspection Report

Structure Number: 0160016

Additional Inspection Data

36A – Bridge Railing Adequacy:		Prev	New	Rail Types:								
		3			Approach Guardrail Adequacy: 36B – Transitions:		Prev	New	36C – Guardrail:		Prev	New
						2			3			
				36D – Ends:		3						

108A – Wearing Surface Type:		Prev	New	If "L-Other" Describe: _____ If "E-Other" Describe: _____ If "I-Other" Describe: _____
		F		
108B – Type of Membrane:		F		
108C – Deck Protection:		J		
108D – Total Deck Thickness (in):		8.9		

59A – Paint Date (Mo/Yr):		Prev	New	Color: Fascia - _____: Inter. - _____: Railing - _____.		
		10/2000	/			
59B – Paint Type:		U	_____	_____	_____	_____

59C – Utilities Attached:	_____	_____	If "B-Other" Describe: _____
---------------------------	-------	-------	------------------------------

Weight Limit Posting:	70A2 – Single Unit Vehicles:	Prev	New		Tons
	70B2 – Combination Type 3S-1 (3 or 4 axles):				Tons
	70C2 – Combination Type 3S-2 (5 or more axles):				Tons
	70D2 – One Truck at a Time:			0	

Joint Openings (In.) _____

90B – Inspector Remarks Continued:

	Signature	Date
Inspection Team Leader:		/ /
Inspection Program Manager:		/ /

Pontis

Today's Date: 04/19/2013

Structure Number: 016-0016 District: 1 (41) Bridge Status: 1 OPEN - NO RESTRICT
 (6) Feature Crossed: IL 50 (CICERO AVE) (7) Facility Carried: I- 55 EB STEVENSON
 (9) Location: 5.7 M SW 194 (7A) Bridge Name:
 Element Inspection Date: 12/10/2012 Inspectors: SEDLACEKJL

Element Description												
Elem	Env	% 1	Qty 1	% 2	Qty 2	% 3	Qty 3	% 4	Qty 4	% 5	Qty 5	Tot Qty
Concrete Deck Protected w/ Rigid Overlay												
22	4	22	2,725	43	5,262	35	4,250	0	0	0	0	12,237
No deficiencies. Repaired areas exist Map cracked areas. Spalls/delaminations Full depth failures.												
Remarks: Lt transverse crking; Small Isol spalls, HP & map crking; PD patch Ln 2 E Jnt (Span 2 Bay 3 & Span 3 Bay 1)												
Lead Painted Steel Open Girder												
107	4	100	28,530	0	0	0	0	0	0	0	0	28,530
No corrosion Paint distress Rust formation Section loss Section failure												
Remarks: Span 2-Bott flanges freckle rust												
Non-Lead Painted Steel Closed Web/Box Girder and O												
173	4	100	60	0	0	0	0	0	0	0	0	60
No corrosion Paint distress Rust formation Section loss Section failure												
Remarks: Lt pitting (Non-Active) @ Btm Flange South Fascia @ Pier 2 Span 3												
Reinforced Conc Column or Pile Extension												
205	4	100	970	0	0	0	0	0	0	0	0	970
No deterioration Minor cracks/spalls Delams/spalls Analysis warranted												
Remarks: Pier 2 Col#1 HL map crks												
Reinforced Conc Pier Wall												
210	4	100	942	0	0	0	0	0	0	0	0	942
No deterioration Minor cracks/spalls Delams/spalls Analysis warranted												
Remarks: Lt vert crking; Pier 1 Wall HL-med vert leach crks												
Reinforced Conc Abutment												
215	4	98	1,902	2	30	0	0	0	0	0	0	1,932
No deterioration Minor cracks/spalls Delams/spalls Analysis warranted												
Remarks: Lt vert crking in FCR @ W Abut												
Reinforced Conc Pier or Abutment Cap												
234	4	88	224	12	30	0	0	0	0	0	0	254
No deterioration Minor cracks/spalls Delams/spalls Analysis warranted												
Remarks: Cantilever Pier 1 north & south ends. Pier 2 South Cantilever End has map crking and delams. East Abut- Med horiz crks @ Brg #4.												
Preformed Joint Seal												
302	4	90	56	10	6	0	0	0	0	0	0	62
No deterioration Minor deterioration Major deterioration												
Remarks: Leaking @ East Abut & Pier 1												
Neoprene Expansion Joint												
307	4	97	180	3	6	0	0	0	0	0	0	186
The element shows mi The seal maybe punct The seal maybe heavi Major deterioration												
Remarks: Leaking @ West Abut & Pier 2												

Movable Discontinuous Brg.												
311	4	100	30	0	0	0	0	0	0	0	0	30
		No deterioration	Minor deterioration	Advanced corrosion								

Remarks:

Fixed Bearing												
313	4	100	30	0	0	0	0	0	0	0	0	30
		No deterioration	Minor deterioration	Advanced corrosion								

Remarks:

Approach Pavement												
323	4	100	2	0	0	0	0	0	0	0	0	2
		No deterioration	Cracks/spalls	Major cracks/spalls	Broken/Unstable							

Remarks:

Concrete Bridge Railing												
331	4	99	410	1	3	0	0	0	0	0	0	413
		No deterioration	Minor cracks/spalls	Analysis warranted								

Remarks:

Steel Open Girder												
406	4	100	6	0	0	0	0	0	0	0	0	6
		Minor fatigue, out-o	Moderate fatigue, ou	Severe fatigue, out-								

Remarks:

Element Description												
Elem	Env	% 1	Qty 1	% 2	Qty 2	% 3	Qty 3	% 4	Qty 4	% 5	Qty 5	Tot Qty
Concrete Deck Protected w/ Rigid Overlay												
22	4	22	2,725	43	5,262	35	4,250	0	0	0	0	12,237
		No deficiencies.	Repaired areas exist	Map cracked areas.	Spalls/delaminations	Full depth failures.						

Remarks:

Lead Painted Steel Open Girder												
107	4	100	28,530	0	0	0	0	0	0	0	0	28,530
		No corrosion	Paint distress	Rust formation	Section loss	Section failure						

Remarks:

Non-Lead Painted Steel Closed Web/Box Girder and O												
173	4	100	60	0	0	0	0	0	0	0	0	60
		No corrosion	Paint distress	Rust formation	Section loss	Section failure						

Remarks:

Reinforced Conc Column or Pile Extension												
205	4	100	970	0	0	0	0	0	0	0	0	970
		No deterioration	Minor cracks/spalls	Delams/spalls	Analysis warranted							

Remarks:

Reinforced Conc Pier Wall												
210	4	100	942	0	0	0	0	0	0	0	0	942
		No deterioration	Minor cracks/spalls	Delams/spalls	Analysis warranted							

Remarks:

Reinforced Conc Abutment

215	4	98	1,902	2	30	0	0	0	0	0	0	1,932
		No deterioration	Minor cracks/spalls	Delams/spalls	Analysis warranted							

Remarks: Lt vert crking in FCR @ W Abut

Reinforced Conc Pier or Abutment Cap

234	4	88	224	12	30	0	0	0	0	0	0	254
		No deterioration	Minor cracks/spalls	Delams/spalls	Analysis warranted							

Remarks: Cantilever Pier 1 north & south ends. Pier 2 South Cantilever End has map crking and delams. East Abut- Med horiz crks @ Brg #4.

Preformed Joint Seal

302	4	90	56	10	6	0	0	0	0	0	0	62
		No deterioration	Minor deterioration	Major deterioration								

Remarks: Leaking @ East Abut & Pier 1

Neoprene Expansion Joint

307	4	97	180	3	6	0	0	0	0	0	0	186
		The element shows mi	The seal maybe punct	The seal maybe heavi	Major deterioration							

Remarks: Leaking @ West Abut & Pier 2

Movable Discontinuous Brg.

311	4	100	30	0	0	0	0	0	0	0	0	30
		No deterioration	Minor deterioration	Advanced corrosion								

Remarks:

Fixed Bearing

313	4	100	30	0	0	0	0	0	0	0	0	30
		No deterioration	Minor deterioration	Advanced corrosion								

Remarks:

Approach Pavement

323	4	100	2	0	0	0	0	0	0	0	0	2
		No deterioration	Cracks/spalls	Major cracks/spalls		Broken/Unstable						

Remarks: West Aprch- Silicone Relief Jnt missing 80%

Concrete Bridge Railing

331	4	99	410	1	3	0	0	0	0	0	0	413
		No deterioration	Minor cracks/spalls	Analysis warranted								

Remarks: Lt vert crking; Lt spalls plow damage; Parapet spalled @ Pier 2 Joint

Element Description

Elem	Env	% 1	Qty 1	% 2	Qty 2	% 3	Qty 3	% 4	Qty 4	% 5	Qty 5	Tot Qty
Concrete Deck Protected w/ Rigid Overlay												
22	4	23	2,855	43	5,262	34	4,120	0	0	0	0	12,237
		No deficiencies.	Repaired areas exist	Map cracked areas.		Spalls/delaminations		Full depth failures.				

Remarks: Lt transverse crking; Small Isol spalls, HP & map crking; PD patch Ln 2 E Jnt (Span 2 Bay 3 & Span 3 Bay 1)

Lead Painted Steel Open Girder

107	4	100	28,530	0	0	0	0	0	0	0	0	28,530
		No corrosion	Paint distress	Rust formation		Section loss		Section failure				

Remarks: Span 2-Bott flanges freckle rust

Non-Lead Painted Steel Closed Web/Box Girder and O

173	4	100	60	0	0	0	0	0	0	0	0	60
		No corrosion	Paint distress	Rust formation	Section loss			Section failure				

Remarks: Lt pitting (Non-Active) @ Bttm Flange South Fascia @ Pier 2 Span 3

Reinforced Conc Column or Pile Extension

205	4	100	970	0	0	0	0	0	0	0	0	970
		No deterioration	Minor cracks/spalls	Delams/spalls	Analysis warranted							

Remarks: Pier 2 Col#1 HL map crks

Reinforced Conc Pier Wall

210	4	100	942	0	0	0	0	0	0	0	0	942
		No deterioration	Minor cracks/spalls	Delams/spalls	Analysis warranted							

Remarks: Lt vert crking; Pier 1 Wall HL-med vert leach crks

Reinforced Conc Abutment

215	4	98	1,902	2	30	0	0	0	0	0	0	1,932
		No deterioration	Minor cracks/spalls	Delams/spalls	Analysis warranted							

Remarks: Lt vert crking in FCR @ W Abut

Reinforced Conc Pier or Abutment Cap

234	4	89	226	11	28	0	0	0	0	0	0	254
		No deterioration	Minor cracks/spalls	Delams/spalls	Analysis warranted							

Remarks: Cantilever Pier 1 north & south ends. Pier 2 South Cantilever End has map crking and delams. East Abut- Med horiz crks @ Brg #4.

Preformed Joint Seal

302	4	90	56	10	6	0	0	0	0	0	0	62
		No deterioration	Minor deterioration	Major deterioration								

Remarks: Leaking @ East Abut & Pier 1

Neoprene Expansion Joint

307	4	97	180	3	6	0	0	0	0	0	0	186
		The element shows mi	The seal maybe punct	The seal maybe heavi	Major deterioration							

Remarks: Leaking @ West Abut & Pier 2

Movable Discontinuous Brg.

311	4	100	30	0	0	0	0	0	0	0	0	30
		No deterioration	Minor deterioration	Advanced corrosion								

Remarks:

Fixed Bearing

313	4	100	30	0	0	0	0	0	0	0	0	30
		No deterioration	Minor deterioration	Advanced corrosion								

Remarks:

Approach Pavement

323	4	100	2	0	0	0	0	0	0	0	0	2
		No deterioration	Cracks/spalls	Major cracks/spalls	Broken/Unstable							

Remarks: West Apprch- Silicone Relief Jnt missing 80%

Concrete Bridge Railing

331	4	99	410	1	3	0	0	0	0	0	0	413
		No deterioration	Minor cracks/spalls	Analysis warranted								

Remarks: Lt vert crking; Lt spalls plow damage; Parapet spalled @ Pier 2 Joint

Element Description

Elem	Env	% 1	Qty 1	% 2	Qty 2	% 3	Qty 3	% 4	Qty 4	% 5	Qty 5	Tot Qty
Concrete Deck Protected w/ Rigid Overlay												
22	4	23	2,855	43	5,262	34	4,120	0	0	0	0	12,237
		No deficiencies.	Repaired areas exist	Map cracked areas.	Spalls/delaminations	Full depth failures.						
Remarks: Lt transverse crking; Small Isol spalls, HP & map crking; PD patch Ln 2 E Jnt (, Span 2 Bay#3& Span 3 Bay#1)												
Lead Painted Steel Open Girder												
107	4	100	28,530	0	0	0	0	0	0	0	0	28,530
		No corrosion	Paint distress	Rust formation	Section loss	Section failure						
Remarks: Span 2-Bott flanges freckle rust												
Non-Lead Painted Steel Closed Web/Box Girder and O												
173	4	100	60	0	0	0	0	0	0	0	0	60
		No corrosion	Paint distress	Rust formation	Section loss	Section failure						
Remarks:												
Reinforced Conc Column or Pile Extension												
205	4	100	970	0	0	0	0	0	0	0	0	970
		No deterioration	Minor cracks/spalls	Delams/spalls	Analysis warranted							
Remarks: Pier 2 Col#1 HL map crks												
Reinforced Conc Pier Wall												
210	4	100	942	0	0	0	0	0	0	0	0	942
		No deterioration	Minor cracks/spalls	Delams/spalls	Analysis warranted							
Remarks: Lt vert crking; Pier 1 Wall HL-med vert leach crks												
Reinforced Conc Abutment												
215	4	98	1,902	2	30	0	0	0	0	0	0	1,932
		No deterioration	Minor cracks/spalls	Delams/spalls	Analysis warranted							
Remarks: Lt vert crking in FCR @ W Abut												
Reinforced Conc Pier or Abutment Cap												
234	4	92	234	8	20	0	0	0	0	0	0	254
		No deterioration	Minor cracks/spalls	Delams/spalls	Analysis warranted							
Remarks: Cantilever Pier 1 north & south ends. East Abut- Med horiz crks @ Brg #4.												
Preformed Joint Seal												
302	4	90	56	10	6	0	0	0	0	0	0	62
		No deterioration	Minor deterioration	Major deterioration								
Remarks: Leaking @ East Abut & Pier 1												
Neoprene Expansion Joint												
307	4	97	180	3	6	0	0	0	0	0	0	186
		The element shows mi	The seal maybe punct	The seal maybe heavi	Major deterioration							
Remarks: Leaking @ West Abut & Pier 2												
Movable Discontinuous Brg.												
311	4	100	30	0	0	0	0	0	0	0	0	30
		No deterioration	Minor deterioration	Advanced corrosion								
Remarks:												
Fixed Bearing												
313	4	100	30	0	0	0	0	0	0	0	0	30
		No deterioration	Minor deterioration	Advanced corrosion								

Remarks: <input type="text"/>												
Approach Pavement												
323	4	100	2	0	0	0	0	0	0	0	0	2
			Cracks/spalls		Major cracks/spalls		Broken/Unstable					
Remarks: <input type="text" value="West Apprch- Silicone Relief Jnt missing 80%"/>												
Concrete Bridge Railing												
331	4	99	410	1	3	0	0	0	0	0	0	413
			Minor cracks/spalls		Analysis warranted							
Remarks: <input type="text" value="Lt vert crking; Lt spalls plow damage; Parapet spalled @ Pier 2 Joint"/>												

Element Description

Elem	Env	% 1	Qty 1	% 2	Qty 2	% 3	Qty 3	% 4	Qty 4	% 5	Qty 5	Tot Qty
Concrete Deck Protected w/ Rigid Overlay												
22	4	23	2,855	43	5,262	34	4,120	0	0	0	0	12,237
			Repaired areas exist		Map cracked areas.		Spalls/delaminations		Full depth failures.			
Remarks: <input type="text" value="Lt trans crking; Isol spalling, HP & map crking; PD patch Ln 2 E jt"/>												
Lead Painted Steel Open Girder												
107	4	100	28,530	0	0	0	0	0	0	0	0	28,530
			Paint distress		Rust formation		Section loss		Section failure			
Remarks: <input type="text"/>												
Non-Lead Painted Steel Closed Web/Box Girder and O												
173	4	100	60	0	0	0	0	0	0	0	0	60
			Paint distress		Rust formation		Section loss		Section failure			
Remarks: <input type="text"/>												
Reinforced Conc Column or Pile Extension												
205	4	100	970	0	0	0	0	0	0	0	0	970
			Minor cracks/spalls		Delams/spalls		Analysis warranted					
Remarks: <input type="text"/>												
Reinforced Conc Pier Wall												
210	4	100	942	0	0	0	0	0	0	0	0	942
			Minor cracks/spalls		Delams/spalls		Analysis warranted					
Remarks: <input type="text" value="Lt vert crking"/>												
Reinforced Conc Abutment												
215	4	98	1,902	2	30	0	0	0	0	0	0	1,932
			Minor cracks/spalls		Delams/spalls		Analysis warranted					
Remarks: <input type="text" value="Lt vert crking in FCR @ W abt"/>												
Reinforced Conc Pier or Abutment Cap												
234	4	92	234	8	20	0	0	0	0	0	0	254
			Minor cracks/spalls		Delams/spalls		Analysis warranted					
Remarks: <input type="text" value="Cantilever crking both piers south end"/>												
Preformed Joint Seal												
302	4	90	56	10	6	0	0	0	0	0	0	62
			Minor deterioration		Major deterioration							
Remarks: <input type="text"/>												

Neoprene Expansion Joint

307	4	97	180	3	6	0	0	0	0	0	0	186
		The element shows mi	The seal maybe punct	The seal maybe heavi	Major deterioration							

Remarks:

Movable Discontinuous Brg.

311	4	100	30	0	0	0	0	0	0	0	0	30
		No deterioration	Minor deterioration	Advanced corrosion								

Remarks:

Fixed Bearing

313	4	100	30	0	0	0	0	0	0	0	0	30
		No deterioration	Minor deterioration	Advanced corrosion								

Remarks:

Approach Pavement

323	4	100	2	0	0	0	0	0	0	0	0	2
		No deterioration	Cracks/spalls	Major cracks/spalls	Broken/Unstable							

Remarks:

Concrete Bridge Railing

331	4	100	413	0	0	0	0	0	0	0	0	413
		No deterioration	Minor cracks/spalls	Analysis warranted								

Remarks:

Element Description

Elem	Env	% 1	Qty 1	% 2	Qty 2	% 3	Qty 3	% 4	Qty 4	% 5	Qty 5	Tot Qty
Concrete Deck Protected w/ Rigid Overlay												
22	4	23	2,855	43	5,262	34	4,120	0	0	0	0	12,237
		No deficiencies.	Repaired areas exist	Map cracked areas.	Spalls/delaminations	Full depth failures.						

Remarks:

Lead Painted Steel Open Girder

107	4	100	28,530	0	0	0	0	0	0	0	0	28,530
		No corrosion	Paint distress	Rust formation	Section loss	Section failure						

Remarks:

Non-Lead Painted Steel Closed Web/Box Girder and O

173	4	100	60	0	0	0	0	0	0	0	0	60
		No corrosion	Paint distress	Rust formation	Section loss	Section failure						

Remarks:

Reinforced Conc Column or Pile Extension

205	4	100	970	0	0	0	0	0	0	0	0	970
		No deterioration	Minor cracks/spalls	Delams/spalls	Analysis warranted							

Remarks:

Reinforced Conc Pier Wall

210	4	100	942	0	0	0	0	0	0	0	0	942
		No deterioration	Minor cracks/spalls	Delams/spalls	Analysis warranted							

Remarks:

Reinforced Conc Abutment

215	4	100	1,932	0	0	0	0	0	0	0	0	1,932
		No deterioration	Minor cracks/spalls	Delams/spalls	Analysis warranted							

Remarks:

Reinforced Conc Pier or Abutment Cap

234	4	92	234	8	20	0	0	0	0	0	0	254
		No deterioration	Minor cracks/spalls	Delams/spalls	Analysis warranted							

Remarks:

Preformed Joint Seal

302	4	90	56	10	6	0	0	0	0	0	0	62
		No deterioration	Minor deterioration	Major deterioration								

Remarks:

Neoprene Expansion Joint

307	4	97	180	3	6	0	0	0	0	0	0	186
		The element shows mi	The seal maybe punct	The seal maybe heavi		Major deterioration						

Remarks:

Movable Discontinuous Brg.

311	4	100	30	0	0	0	0	0	0	0	0	30
		No deterioration	Minor deterioration	Advanced corrosion								

Remarks:

Fixed Bearing

313	4	100	30	0	0	0	0	0	0	0	0	30
		No deterioration	Minor deterioration	Advanced corrosion								

Remarks:

Approach Pavement

323	4	100	2	0	0	0	0	0	0	0	0	2
		No deterioration	Cracks/spalls	Major cracks/spalls	Broken/Unstable							

Remarks:

Concrete Bridge Railing

331	4	100	413	0	0	0	0	0	0	0	0	413
		No deterioration	Minor cracks/spalls	Analysis warranted								

Remarks:

Element Description

Elem	Env	% 1	Qty 1	% 2	Qty 2	% 3	Qty 3	% 4	Qty 4	% 5	Qty 5	Tot Qty
Concrete Deck Protected w/ Rigid Overlay												
22	4	23	2,855	43	5,262	34	4,120	0	0	0	0	12,237
		No deficiencies.	Repaired areas exist	Map cracked areas.		Spalls/delaminations		Full depth failures.				

Remarks:

Lead Painted Steel Open Girder

107	4	100	28,530	0	0	0	0	0	0	0	0	28,530
		No corrosion	Paint distress	Rust formation		Section loss		Section failure				

Remarks:

Non-Lead Painted Steel Closed Web/Box Girder and O

173	4	100	60	0	0	0	0	0	0	0	0	60
		No corrosion	Paint distress	Rust formation	Section loss	Section failure						

Remarks:

Reinforced Conc Column or Pile Extension

205	4	100	970	0	0	0	0	0	0	0	0	970
		No deterioration	Minor cracks/spalls	Delams/spalls	Analysis warranted							

Remarks:

Reinforced Conc Pier Wall

210	4	100	942	0	0	0	0	0	0	0	0	942
		No deterioration	Minor cracks/spalls	Delams/spalls	Analysis warranted							

Remarks:

Reinforced Conc Abutment

215	4	100	1,932	0	0	0	0	0	0	0	0	1,932
		No deterioration	Minor cracks/spalls	Delams/spalls	Analysis warranted							

Remarks:

Reinforced Conc Pier or Abutment Cap

234	4	92	234	8	20	0	0	0	0	0	0	254
		No deterioration	Minor cracks/spalls	Delams/spalls	Analysis warranted							

Remarks:

Preformed Joint Seal

302	4	90	56	10	6	0	0	0	0	0	0	62
		No deterioration	Minor deterioration	Major deterioration								

Remarks:

Neoprene Expansion Joint

307	4	97	180	3	6	0	0	0	0	0	0	186
		The element shows mi	The seal maybe punct	The seal maybe heavi	Major deterioration							

Remarks:

Movable Discontinuous Brg.

311	4	100	30	0	0	0	0	0	0	0	0	30
		No deterioration	Minor deterioration	Advanced corrosion								

Remarks:

Fixed Bearing

313	4	100	30	0	0	0	0	0	0	0	0	30
		No deterioration	Minor deterioration	Advanced corrosion								

Remarks:

Approach Pavement

323	4	100	2	0	0	0	0	0	0	0	0	2
		No deterioration	Cracks/spalls	Major cracks/spalls		Broken/Unstable						

Remarks:

Concrete Bridge Railing

331	4	100	413	0	0	0	0	0	0	0	0	413
		No deterioration	Minor cracks/spalls	Analysis warranted								

Remarks:

Element Description

Elem	Env	% 1	Qty 1	% 2	Qty 2	% 3	Qty 3	% 4	Qty 4	% 5	Qty 5	Tot Qty
Concrete Deck Protected w/ Rigid Overlay												
22	4	23	2,855	43	5,262	34	4,120	0	0	0	0	12,237
		No deficiencies.	Repaired areas exist		Map cracked areas.		Spalls/delaminations		Full depth failures.			
Remarks:												
Lead Painted Steel Open Girder												
107	4	100	28,530	0	0	0	0	0	0	0	0	28,530
		No corrosion	Paint distress		Rust formation		Section loss		Section failure			
Remarks:												
Non-Lead Painted Steel Closed Web/Box Girder and O												
173	4	100	60	0	0	0	0	0	0	0	0	60
		No corrosion	Paint distress		Rust formation		Section loss		Section failure			
Remarks:												
Reinforced Conc Column or Pile Extension												
205	4	100	970	0	0	0	0	0	0	0	0	970
		No deterioration	Minor cracks/spalls		Delams/spalls		Analysis warranted					
Remarks:												
Reinforced Conc Pier Wall												
210	4	100	942	0	0	0	0	0	0	0	0	942
		No deterioration	Minor cracks/spalls		Delams/spalls		Analysis warranted					
Remarks:												
Reinforced Conc Abutment												
215	4	100	1,932	0	0	0	0	0	0	0	0	1,932
		No deterioration	Minor cracks/spalls		Delams/spalls		Analysis warranted					
Remarks:												
Reinforced Conc Pier or Abutment Cap												
234	4	92	234	8	20	0	0	0	0	0	0	254
		No deterioration	Minor cracks/spalls		Delams/spalls		Analysis warranted					
Remarks:												
Preformed Joint Seal												
302	4	100	62	0	0	0	0	0	0	0	0	62
		No deterioration	Minor deterioration		Major deterioration							
Remarks:												
Neoprene Expansion Joint												
307	4	100	186	0	0	0	0	0	0	0	0	186
		The element shows mi	The seal maybe punct		The seal maybe heavi		Major deterioration					
Remarks:												
Movable Discontinuous Brg.												
311	4	100	30	0	0	0	0	0	0	0	0	30
		No deterioration	Minor deterioration		Advanced corrosion							
Remarks:												
Fixed Bearing												
313	4	100	30	0	0	0	0	0	0	0	0	30
		No deterioration	Minor deterioration		Advanced corrosion							

Remarks:

Approach Pavement

323	4	100	2	0	0	0	0	0	0	0	0	2
	No deterioration		Cracks/spalls		Major cracks/spalls		Broken/Unstable					

Remarks:

Concrete Bridge Railing

331	4	100	413	0	0	0	0	0	0	0	0	413
	No deterioration		Minor cracks/spalls		Analysis warranted							

Remarks:

Element Description

Elem	Env	% 1	Qty 1	% 2	Qty 2	% 3	Qty 3	% 4	Qty 4	% 5	Qty 5	Tot Qty
Concrete Deck Protected w/ AC Overlay												
14	4	75	9,218	0	0	25	3,073	0	0	0	0	12,290
	No deficiencies.		Repaired areas.		Map cracked areas.		Spalls/delam exist.		Full depth failures.			

Remarks:

Lead Painted Steel Open Girder

107	4	93	26,533	7	1,997	0	0	0	0	0	0	28,530
	No corrosion		Paint distress		Rust formation		Section loss		Section failure			

Remarks:

Lead Painted Steel Closed Web/Box Girder and Open

172	4	100	50	0	0	0	0	0	0	0	0	50
	No corrosion		Paint distress		Rust formation		Section loss		Section failure			

Remarks:

Reinforced Conc Column or Pile Extension

205	4	82	795	10	97	8	78	0	0	0	0	970
	No deterioration		Minor cracks/spalls		Delams/spalls		Analysis warranted					

Remarks:

Reinforced Conc Pier Wall

210	4	100	942	0	0	0	0	0	0	0	0	942
	No deterioration		Minor cracks/spalls		Delams/spalls		Analysis warranted					

Remarks:

Reinforced Conc Abutment

215	4	100	1,932	0	0	0	0	0	0	0	0	1,932
	No deterioration		Minor cracks/spalls		Delams/spalls		Analysis warranted					

Remarks:

Reinforced Conc Pier or Abutment Cap

234	4	86	218	8	20	6	15	0	0	0	0	254
	No deterioration		Minor cracks/spalls		Delams/spalls		Analysis warranted					

Remarks:

Neoprene Expansion Joint

307	4	52	207	45	180	3	12	0	0	0	0	399
	The element shows mi		The seal maybe punct		The seal maybe heavi		Major deterioration					

Remarks:

Movable Discontinuous Brg.

311	4	67	20	33	10	0	0	0	0	0	0	30
		No deterioration	Minor deterioration	Advanced corrosion								

Remarks:

Fixed Bearing

313	4	87	26	13	4	0	0	0	0	0	0	30
		No deterioration	Minor deterioration	Advanced corrosion								

Remarks:

Approach Pavement

323	4	0	0	100	2	0	0	0	0	0	0	2
		No deterioration	Cracks/spalls	Major cracks/spalls		Broken/Unstable						

Remarks:

Concrete Bridge Railing



331	4	47	194	29	120	24	99	0	0	0	0	413
		No deterioration	Minor cracks/spalls	Analysis warranted								

Remarks:

Download Date: 04/18/2013


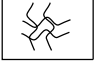


ATTACHMENT D

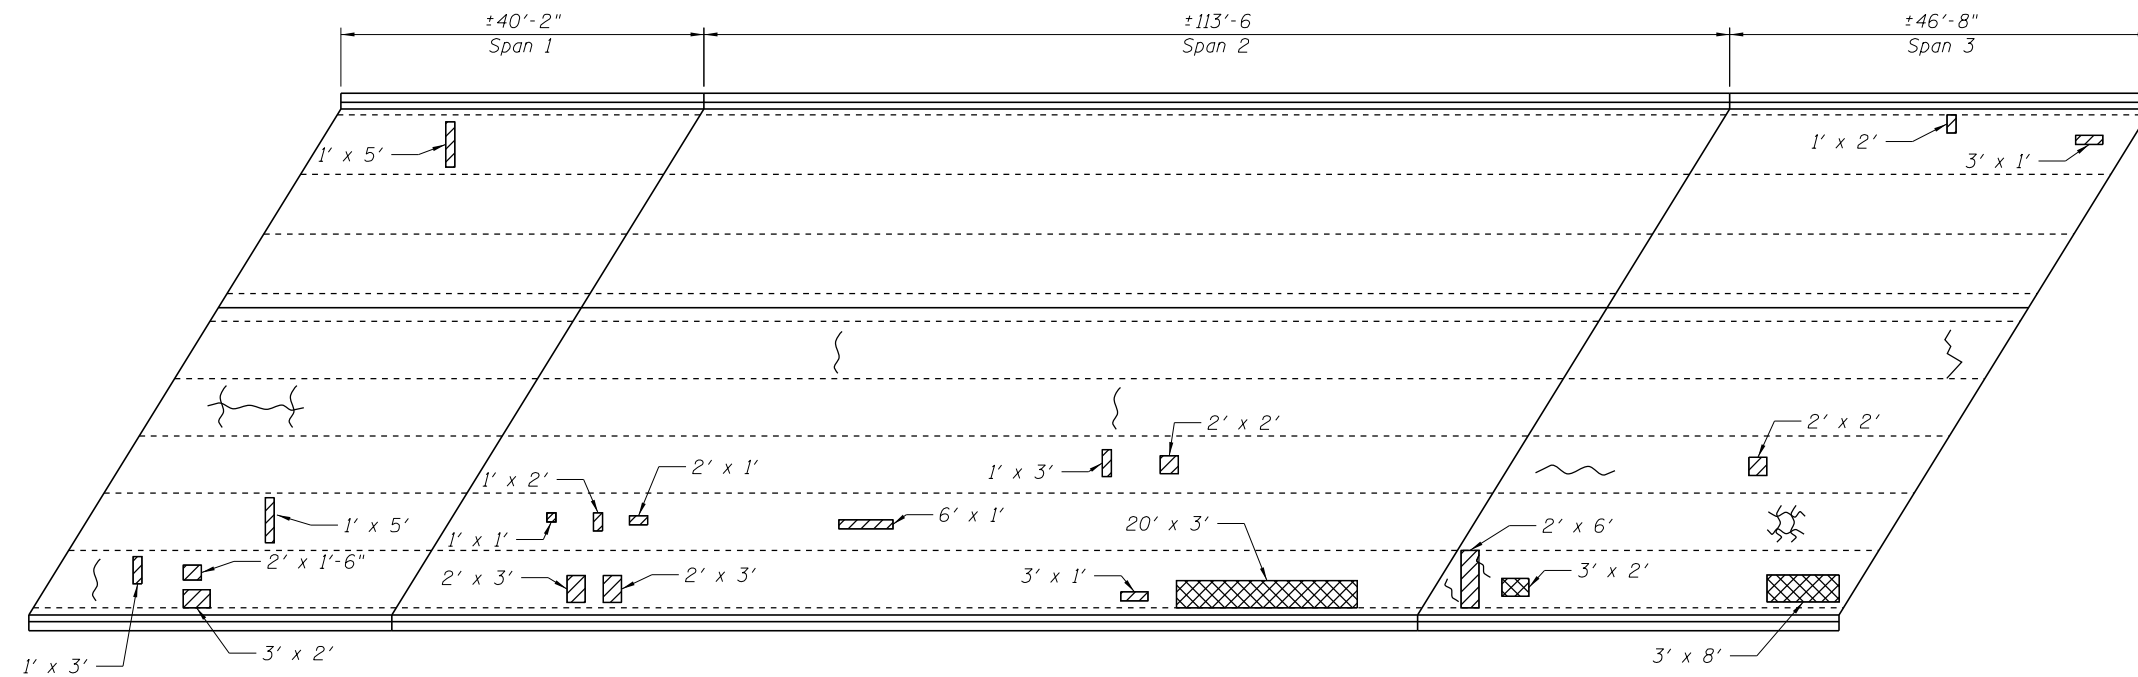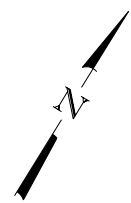Bottom of Deck Condition Survey



UNDERSIDE OF DECK
(Eastbound Bridge)

LEGEND

-  - CRACKED CONCRETE
-  - MAP CRACKING
-  - SPALLED CONCRETE
-  - DELAMINATED CONCRETE

FILE NAME = V:\1786\active\178600037_IDOT_1-95\structural\drawing\shd\deg_Cicero.Avenue.Underside_of_Deck.dgn



USER NAME = jerojas	DESIGNED - JSR	REVISED -
	CHECKED - BPS	REVISED -
PLOT SCALE = N/A	DRAWN - JSR	REVISED -
PLOT DATE = 10/9/2013	CHECKED - BPS	REVISED -

STATE OF ILLINOIS
DEPARTMENT OF TRANSPORTATION

ATTACHMENT D - BOTTOM OF DECK CONDITION SURVEY
STRUCTURE NO. 016-0016

SHEET NO. 1 OF 1 SHEETS

F.A.I. RTE.	SECTION	COUNTY	TOTAL SHEETS	SHEET NO.
55	1112-619-HB	COOK		
CONTRACT NO.				
FED. ROAD DIST. NO. 1 ILLINOIS FED. AID PROJECT				

ATTACHMENT E

**Condition Assessment of the Reinforced
Concrete Bridge Deck**

January 6, 2012

Ms. Diane M. O'Keefe
Deputy Director of Highways
District One Engineer
Illinois Department of Transportation
201 West Center Court
Schaumburg, Illinois 60196-1096
Attn: Ms. Sarah Wilson (Maintenance Bridge Engineer)

Re: Condition Assessment of Bridge Deck
I-55 Eastbound over IL-50 (Cicero Avenue)
Structure No. 016-0016
District One
Work Order 10
PTB No. 153-18
WJE No. 2009.3645.10

Dear Ms. O'Keefe:

At your request, Wiss, Janney, Elstner Associates, Inc. (WJE) completed a condition assessment of the reinforced concrete bridge deck for Structure No. 016-0016. This work included a visual assessment of concrete deterioration from below the structure. Also included was a delamination survey performed on the top of the bridge deck, based on an infrared thermography (IR) survey. Reinforcing bar cover depth determination was also performed using ground penetrating radar (GPR). These inspection tasks began in July and were completed in September.

Structure Description

The I-55 Eastbound Bridge over Cicero Avenue, IL-50 carries three lanes of traffic and two shoulders. This three span structure is comprised of steel beam and concrete deck construction. Each of the 10 girder lines is connected using steel diaphragms or cross frames. All deck and substructure components are comprised of cast-in-place reinforced concrete construction. Reportedly the bridge structure was originally constructed in 1963 and the current overlay was installed in 2000.

The spans have approximate lengths of 40 ft-7 in., 113 ft-11 in., and 46 ft-3 in., from west-to-east, for a total structure length of 206ft-8 in., back-to-back of abutments. The total deck width out-to-out is 59 ft-5 in. and the deck width to the inside faces of the parapet walls is 56 ft. The total resulting bridge deck area is approximately 10,900 sq. ft. A partial elevation view of the structure looking north is included as Figure 1.

Inspection Methods

The condition of the reinforced concrete bridge deck was assessed using several methods. These methods can be broken down into two major categories: Bottom of Deck Inspection Methods and Top of Deck Inspection Methods.

Bottom of Deck Inspection Methods

The condition of the bottom of the reinforced concrete deck was assessed from grade below the structure in September 2011. All accessible areas of the bottom of the deck were assessed visually. This inspection was completed from the ground beneath the bridge outside of active traffic lanes. Binoculars and/or zoom lenses were used to magnify the view of distant surfaces. Plan drawings of the structure including the structural framing were used to record field notes.

Top of Deck Inspection Methods

The condition of the top of the reinforced concrete deck was assessed using IR equipment to map areas of spalls, patches, and delaminations. This work was subcontracted to Infrasense, Inc. and was performed in July, 2011. Rolling lane closures were utilized during data collection periods to allow the IR data collection vehicle to assess the entire bridge deck surface while moving at approximately 3 mph. Impact Echo (IE) and sounding techniques were used to confirm the presence of delaminations at select locations on each bridge deck. All IR data was analyzed and summarized on bridge deck drawing sheets that show the located defects to scale.

GPR equipment was used to identify the cover depth of the top mat of reinforcing steel from the top surface of the deck. The GPR equipment was mounted to an inspection vehicle and scans were completed at normal operating speeds.

Assessment Results

The reinforced concrete bridge deck was found to be in satisfactory condition overall. Results for each assessment category are included below.

Bottom of Deck

Visual inspection from grade below the bridge was used to assess the bottom of the bridge deck. All areas of spalls or delaminations that could be identified visually were documented. In addition, all areas of previously repaired concrete were noted. Table 1 includes a summary of the visual inspection, including total deck soffit area, the area of spalled concrete, the area of delaminated concrete and the area of previous repairs. Figures 2 and 3 show the typical condition of the deck soffit. The results of the bottom of deck survey are shown on Sheet S-3 of Appendix A.

Table 1. Bottom of Deck Deterioration Summary

Soffit Area (sq. ft)	Spalled Area (sq. ft)	Total Area (%)	Delaminated Area (sq. ft)	Total Area (%)	Previously Repaired Area (sq.ft)
10,900	50	0.5	180	1.7	1575

Top of Deck

The top of the bridge deck was assessed using both IR and GPR equipment. The IR survey equipment was able to identify delaminations and spalls present in the bridge deck. Figure 4 is an overall view of the top deck surface looking northeast.

Table 2 includes a summary of the total bridge deck area, the total bridge deck area spalled, the total bridge deck area delaminated, the total bridge deck area that should be programmed for repair work and the rebar cover from the top surface of the deck. Sheet S-1 of Appendix A is a scaled bridge deck plan drawing showing the locations of the delaminated or spalled areas. Sheet S-2 of Appendix A is a scaled bridge deck plan drawing showing an image of the IR scan of the bridge. Sheet S-4 of Appendix A is a scaled bridge deck plan drawing showing the location of suggested partial and full depth concrete repairs using conventional patching techniques. Note that repair area boundaries were selected by expanding the boundaries of each delaminated or spalled area by 6 inches to account for saw cutting outside of the delamination and further deterioration prior to the actual start of any repair work. In addition, repair areas were joined when adjacent repairs were spaced at approximately 2 ft. or less. Full depth repair boundaries were determined based on locations where top and bottom surface defects overlapped. No bottom surface repairs were identified based on recommendations from IDOT.

Table 2. Top of Deck Deterioration Summary

Bridge Deck Area (sq. ft)	Spalled Area (sq. ft)	Total Area (%)	Delaminated Area (sq. ft)	Total Area (%)	Repair Area (sq. ft)	Total Area (%)	Rebar Cover (in.)
10,900	0	0	615	5.6	1382	12.7	3.9

Recommendations and Conclusions

WJE performed a condition assessment of the reinforced concrete bridge deck of the I-55 Eastbound Bridge over IL-50, Cicero Avenue. This condition assessment included: a visual survey of the bottom of the deck and an IR survey of the top of the deck. This information was used to produce repair drawings indicating the size and location of anticipated repair areas.


The repair work should, at a minimum, include partial depth repairs at all locations indicated on Sheet S-4 in Appendix A. If this option is selected, a detailed delamination assessment should be completed by the contractor at the time of the repair work to ensure that all areas of deteriorated concrete are identified. In addition, all re-entrant corners of repair areas should be detailed to include a 4 inch chamfer to reduce the potential for concrete-shrinkage related cracking.

The bridge deck was found to currently be in satisfactory condition, but corrosion-related damage has become apparent and should be repaired.


We would be happy to answer any questions or provide additional information.

Sincerely,

WISS, JANNEY, ELSTNER ASSOCIATES, INC.

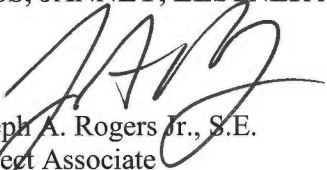

Joseph A. Rogers Jr., S.E.
Project Associate

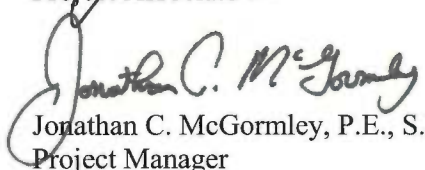

Jonathan C. McGormley, P.E., S.E.
Project Manager

Figures



Figure 1. Elevation view, looking north. Photo from Google Streetview



Figure 2. Typical view, deck soffit, southeast corner.

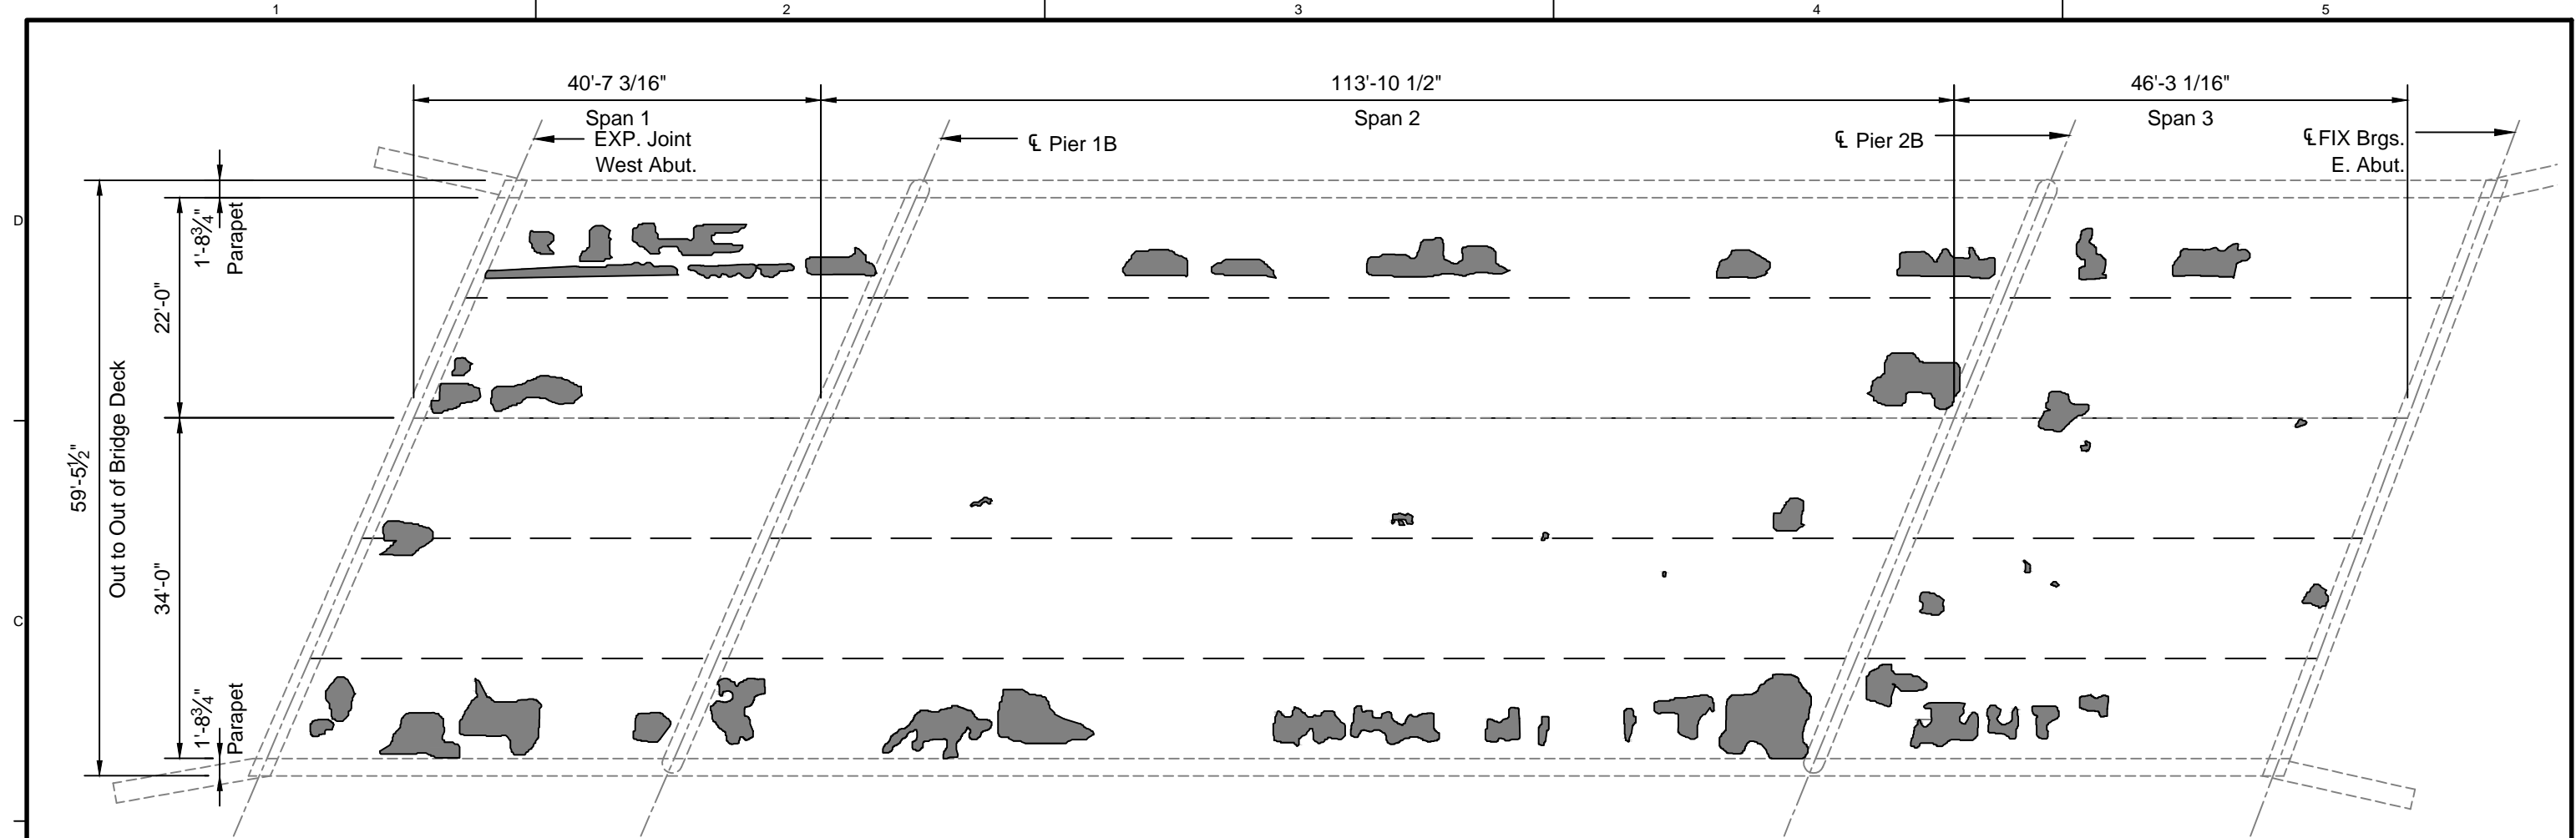


Figure 3. Typical view, deck soffit, west end.

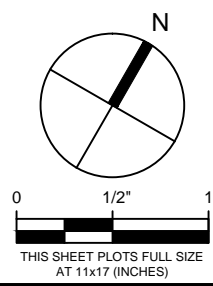


Figure 4. Typical view, deck top surface, looking northeast

Appendix A - Bridge Deck Condition Assessment Drawings



FIELD OBSERVATION SUMMARY		STRUCTURE # 016-0016		LEGEND	
ITEM	UNIT	QUANT.	%	DELAMINATION	
TOTAL AREA	Ac	10,900	100	SPALL	
DELAMINATION	Ac	615	5.6	CRACK	
SPALL	Ac	0	0		
CRACKS	ft	-	-		





WJE ENGINEERS ARCHITECTS MATERIALS SCIENTISTS
 Wiss, Janney, Elstner Associates, Inc.
 330 Pfingsten Road
 Northbrook, Illinois 60062
 847.272.7400 tel | 847.291.4813 fax
 www.wje.com

Client
 Illinois Department of Transportation
 District One
 201 West Center Court
 Schaumburg, Illinois 60196

Project
 Bridge 016-0016
 EASTBOUND I-55 OVER CICERO AVENUE
 Sheet Title
 IR Result - Top Surface

Proj. No. 2009.3645.10
 Date November 19 2011
 Drawn JJZ
 Checked JAR
 Scale 1/16" = 1'-0"

Sheet No. **S1**

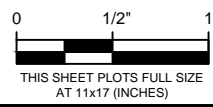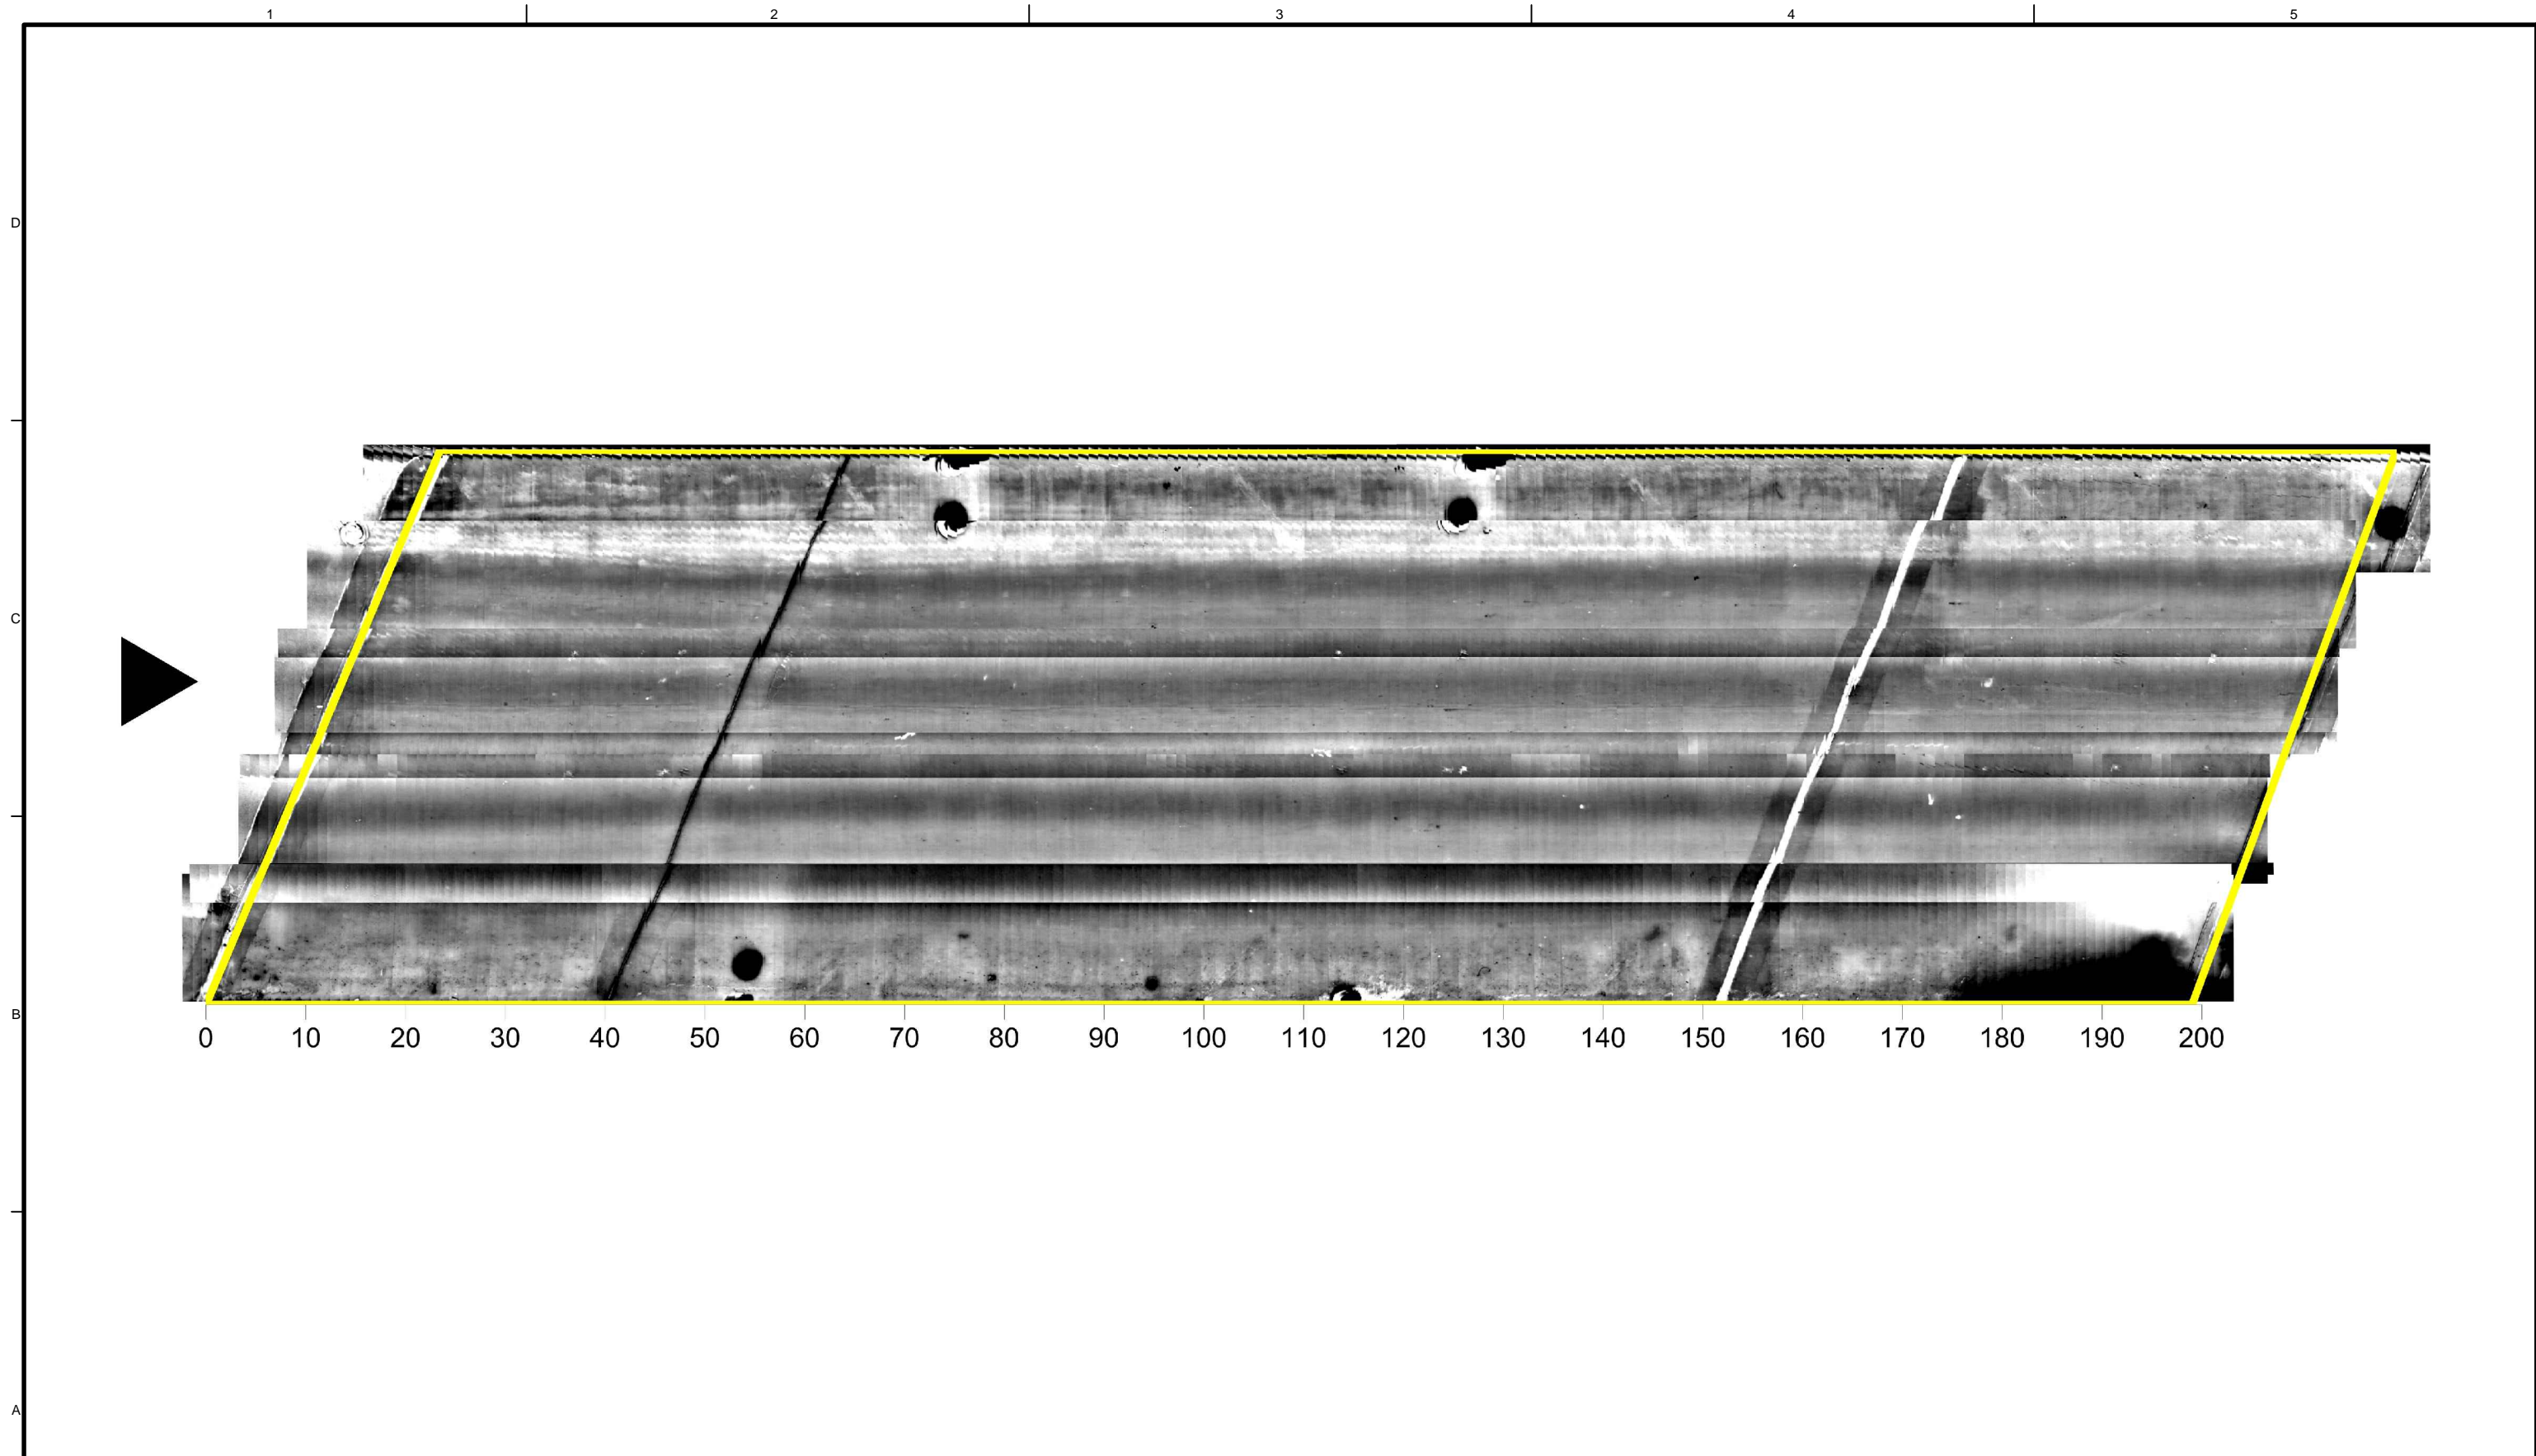


WJE ENGINEERS
ARCHITECTS
MATERIALS SCIENTISTS
Wiss, Janney, Elstner Associates, Inc.
330 Pfingsten Road
Northbrook, Illinois 60062
847.272.7400 tel | 847.291.4813 fax
www.wje.com

Client
Illinois Department of Transportation
District One
201 West Center Court
Schaumburg, Illinois 60196


Project
Bridge 016-0016
EASTBOUND I-55 OVER CICERO AVENUE
Sheet Title
IR Image - Top Surface

Proj. No.	2009.3645.10
Date	November 19 2011
Drawn	JJZ
Checked	JAR
Scale	1/16" = 1'-0"

Sheet No. **S2**

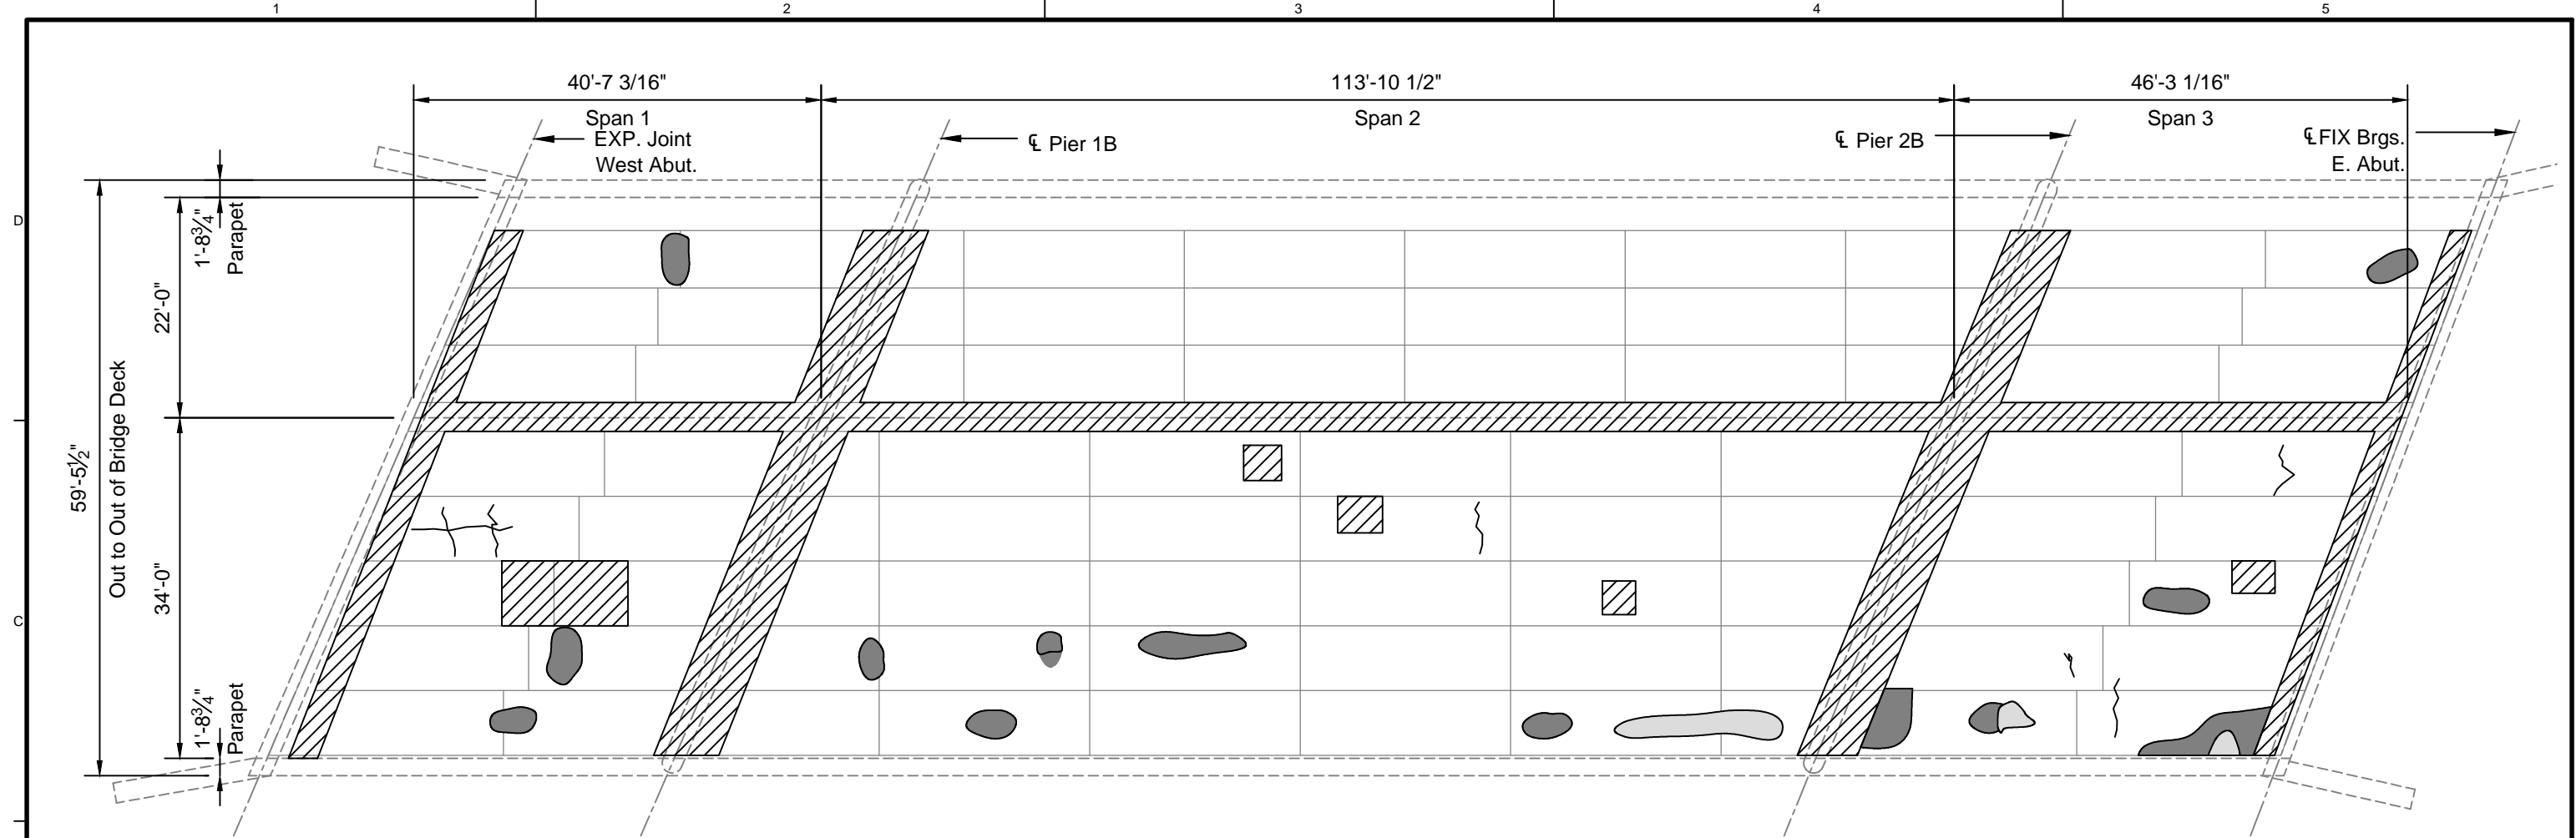

FIELD OBSERVATION SUMMARY		STRUCTURE # 016-0016		LEGEND	
ITEM	UNIT	QUANT.	%		
TOTAL AREA	Ac	10900	100	DELAMINATION	
DELAMINATION	Ac	180	1.7	SPALL	
SPALL	Ac	50	0.5	PREV. REPAIR	
PREVIOUS REPAIRS	Ac	1575	14.4	CRACK	
CRACKS	ft	-	-		

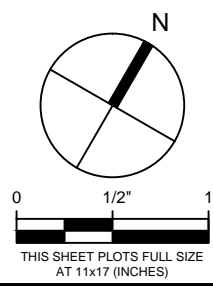


WJE ENGINEERS
ARCHITECTS
MATERIALS SCIENTISTS
Wiss, Janney, Elstner Associates, Inc.
330 Pfingsten Road
Northbrook, Illinois 60062
847.272.7400 tel | 847.291.4813 fax
www.wje.com

Client
Illinois Department of Transportation
District One
201 West Center Court
Schaumburg, Illinois 60196


Project
Bridge 016-0016
EASTBOUND I-55 OVER CICERO AVENUE
Sheet Title
Underside Deterioration

Proj. No. 2009.3645.10
Date November 19 2011
Drawn JJZ
Checked JAR
Scale 1/16" = 1'-0"

Sheet No. **S3**

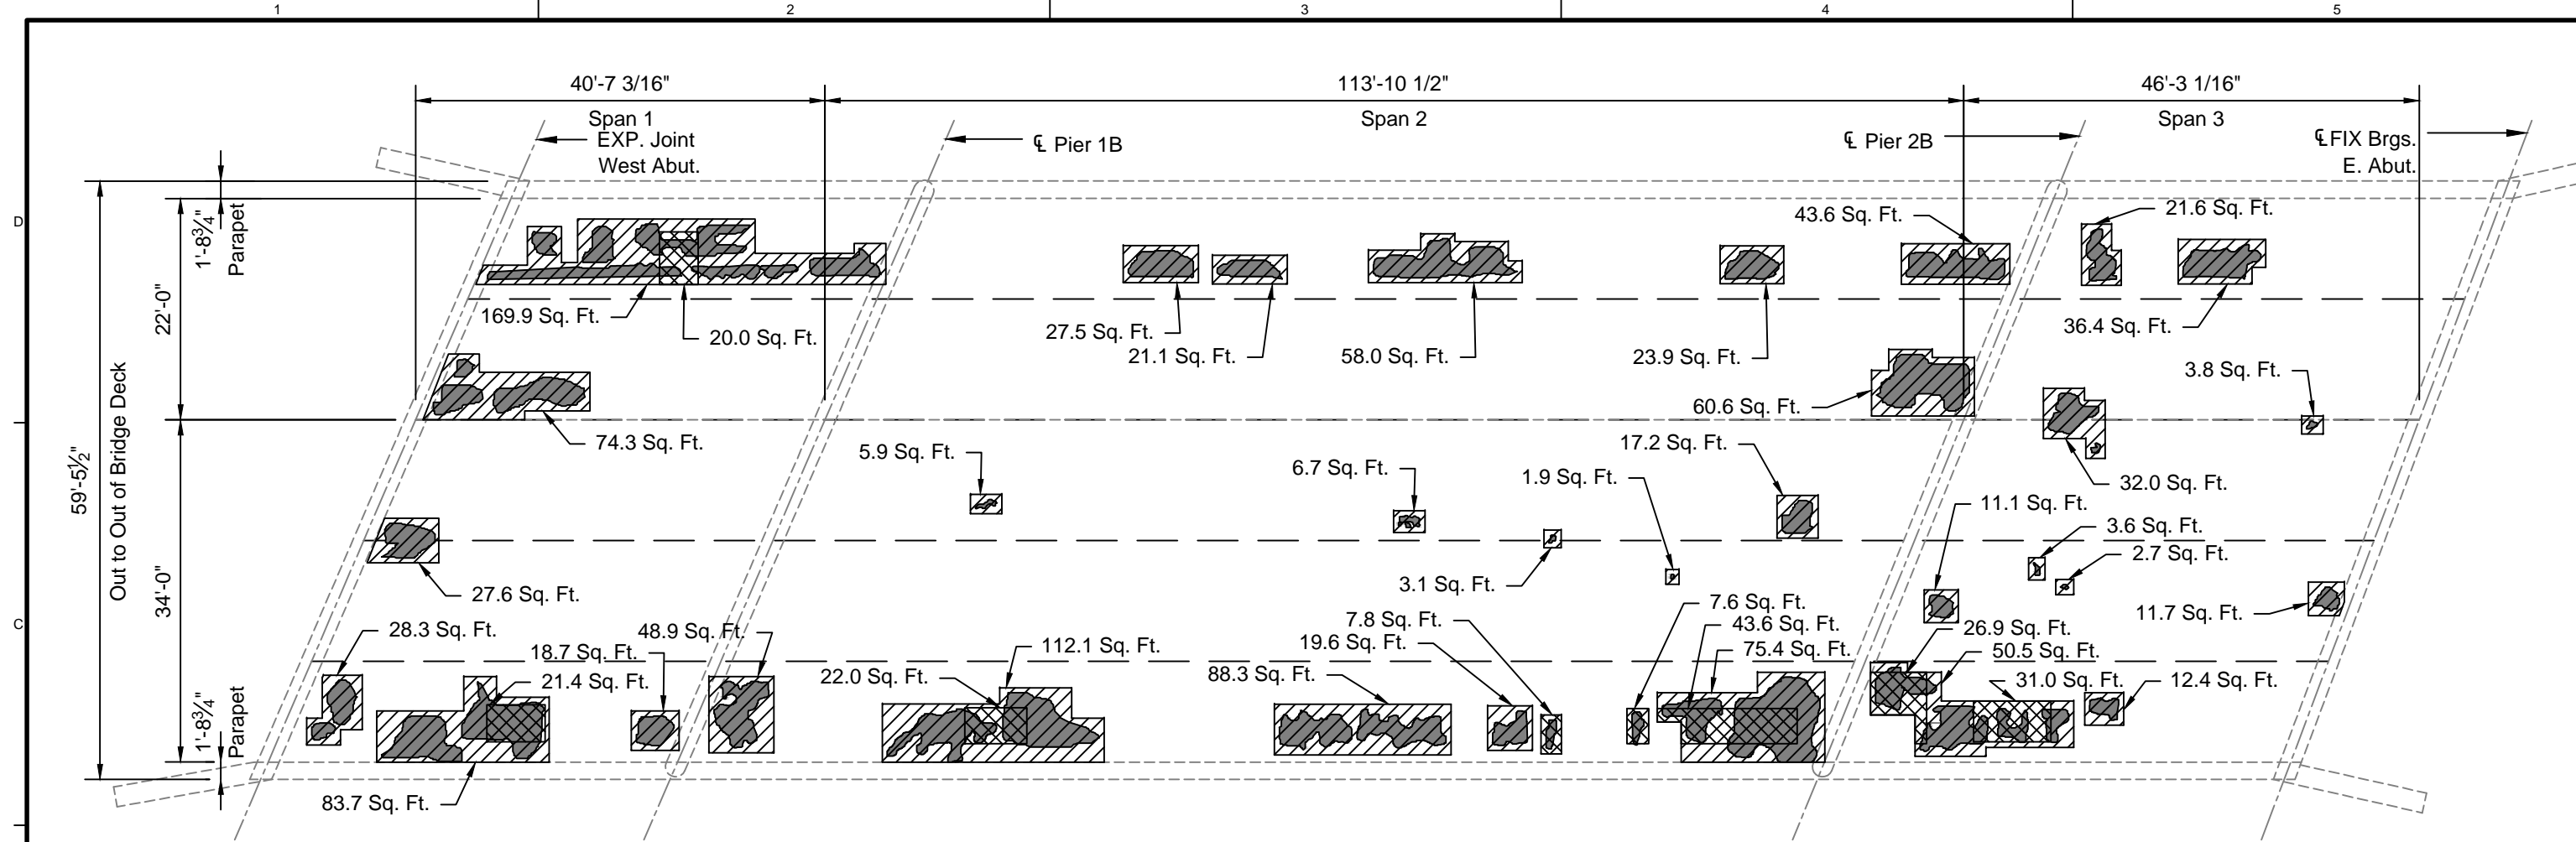

FIELD OBSERVATION SUMMARY		STRUCTURE # 016-0016		LEGEND	
ITEM	UNIT	QUANT.	%		
TOTAL AREA	Ac	10900	100	PARTIAL DEPTH REPAIR	
PARTIAL DEPTH REPAIR	Ac	1202	11.0	FULL DEPTH REPAIR	
FULL DEPTH REPAIR	Ac	180	1.7	DELAMINATION	
DELAMINATION	Ac	615	5.6	SPALL	
SPALL	Ac	0	0	CRACK	
CRACKS	ft	-	-		

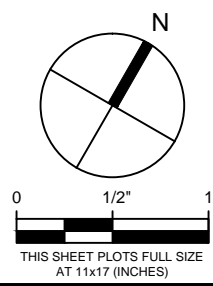

WJE ENGINEERS ARCHITECTS MATERIALS SCIENTISTS
 Wiss, Janney, Elstner Associates, Inc.
 330 Pfingsten Road
 Northbrook, Illinois 60062
 847.272.7400 tel | 847.291.4813 fax
 www.wje.com

Client
Illinois Department of Transportation
 District One
 201 West Center Court
 Schaumburg, Illinois 60196


Project
 Bridge 016-0016
 EASTBOUND I-55 OVER CICERO AVENUE
 Sheet Title
 Proposed Repairs

Proj. No. 2009.3645.10
 Date November 19 2011
 Drawn JJZ
 Checked JAR
 Scale 1/16" = 1'-0"


S4

ATTACHMENT F

Substructure Condition Surveys

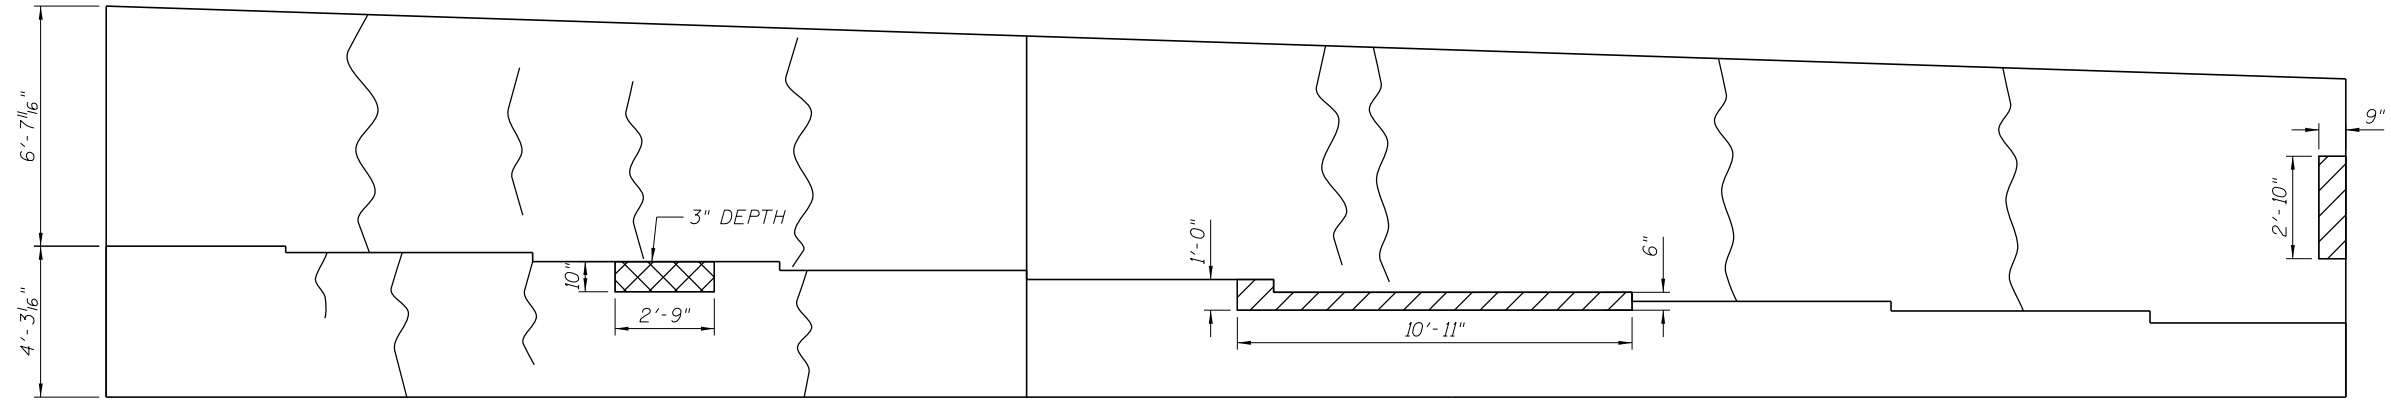

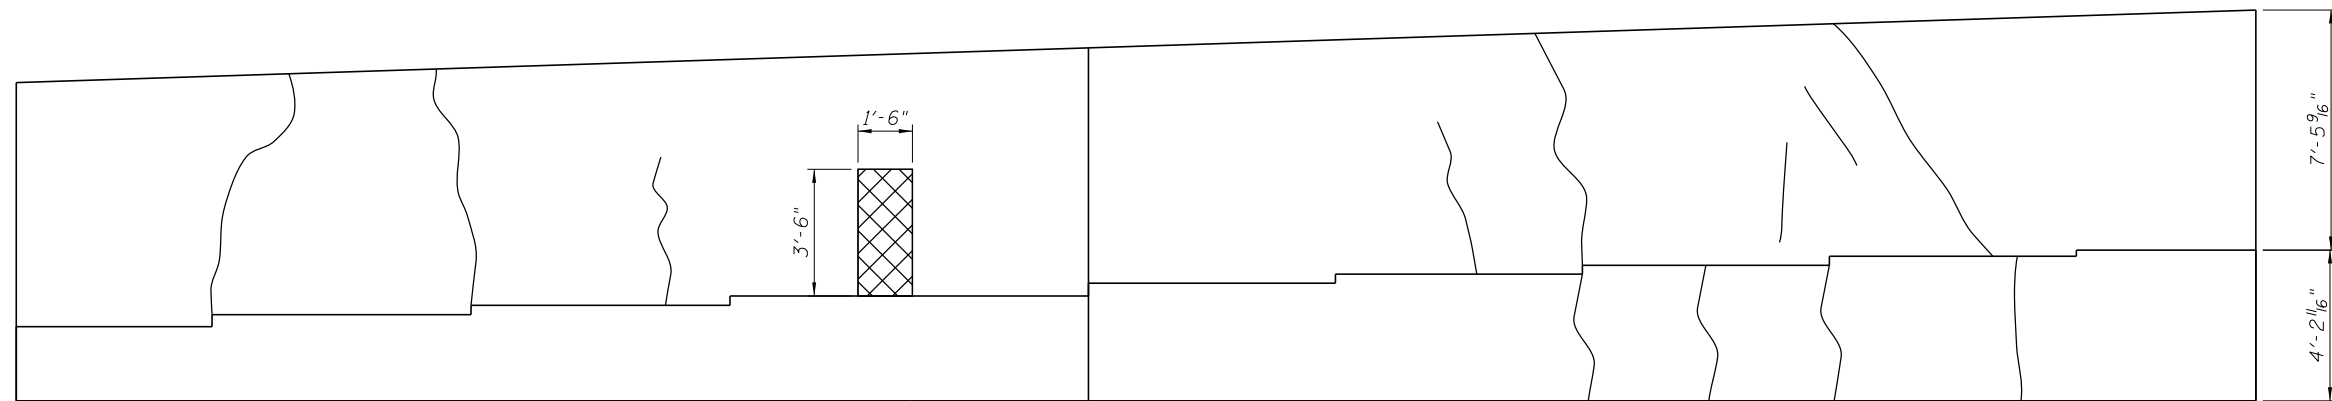


EAST ABUTMENT
LOOKING EAST



WEST ABUTMENT
LOOKING WEST

LEGEND

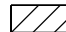-  - HAIRLINE CRACK (UNLESS OTHERWISE NOTED)
-  - SPALLED CONCRETE
-  - DELAMINATED CONCRETE

FILE NAME = V:\1786\active\178600037_IDOT_155\structural\drawing\shd\deg_Cicero.Avenue.Abutment.Elevation.dgn




USER NAME = jerojas	DESIGNED - JSR	REVISED -
	CHECKED - BPS	REVISED -
PLOT SCALE = N/A	DRAWN - JSR	REVISED -
PLOT DATE = 10/7/2013	CHECKED - BPS	REVISED -

STATE OF ILLINOIS
DEPARTMENT OF TRANSPORTATION


ATTACHMENT F - SUBSTRUCTURE CONDITION SURVEY
STRUCTURE NO. 016-0016

SHEET NO. 1 OF 3 SHEETS

F.A.I. RTE.	SECTION	COUNTY	TOTAL SHEETS	SHEET NO.
55	1112-619-HB	COOK		
CONTRACT NO.				
FED. ROAD DIST. NO. 1 ILLINOIS FED. AID PROJECT				

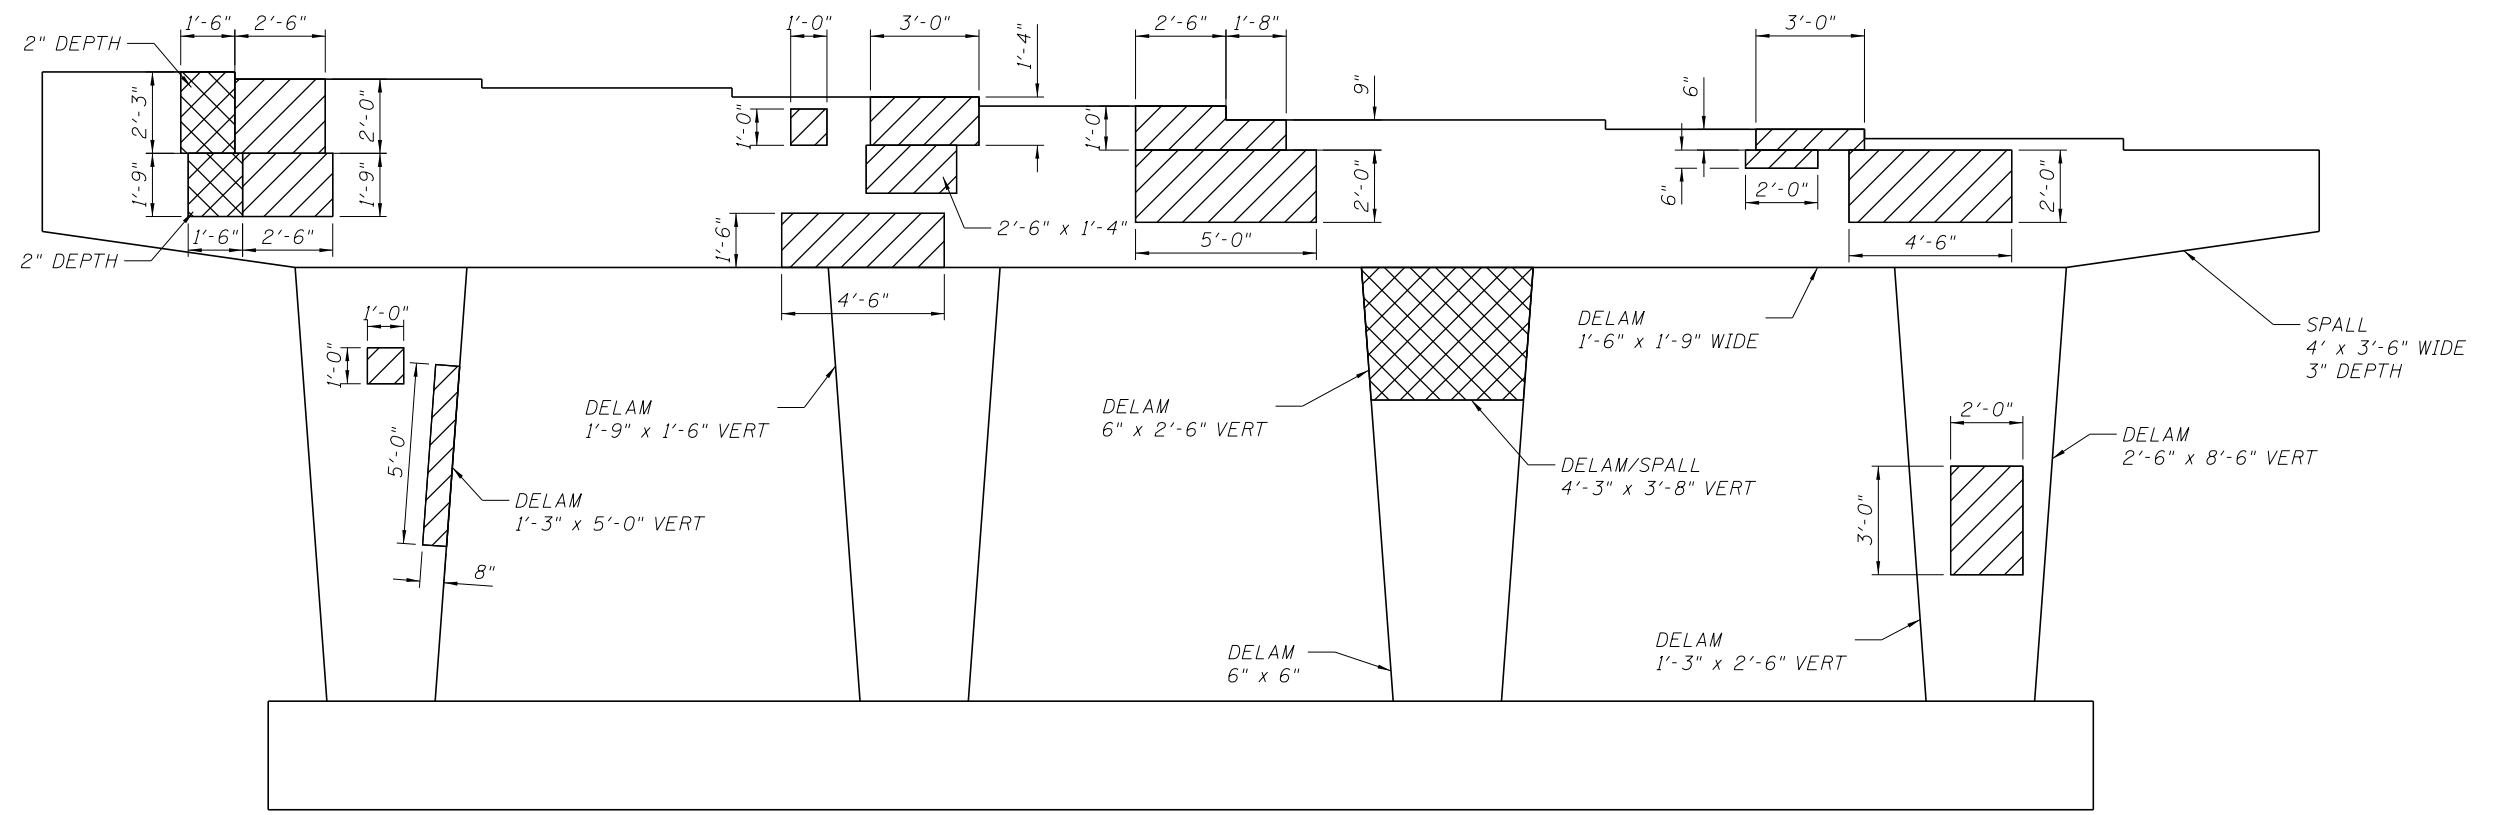

PIER 1
LOOKING EAST

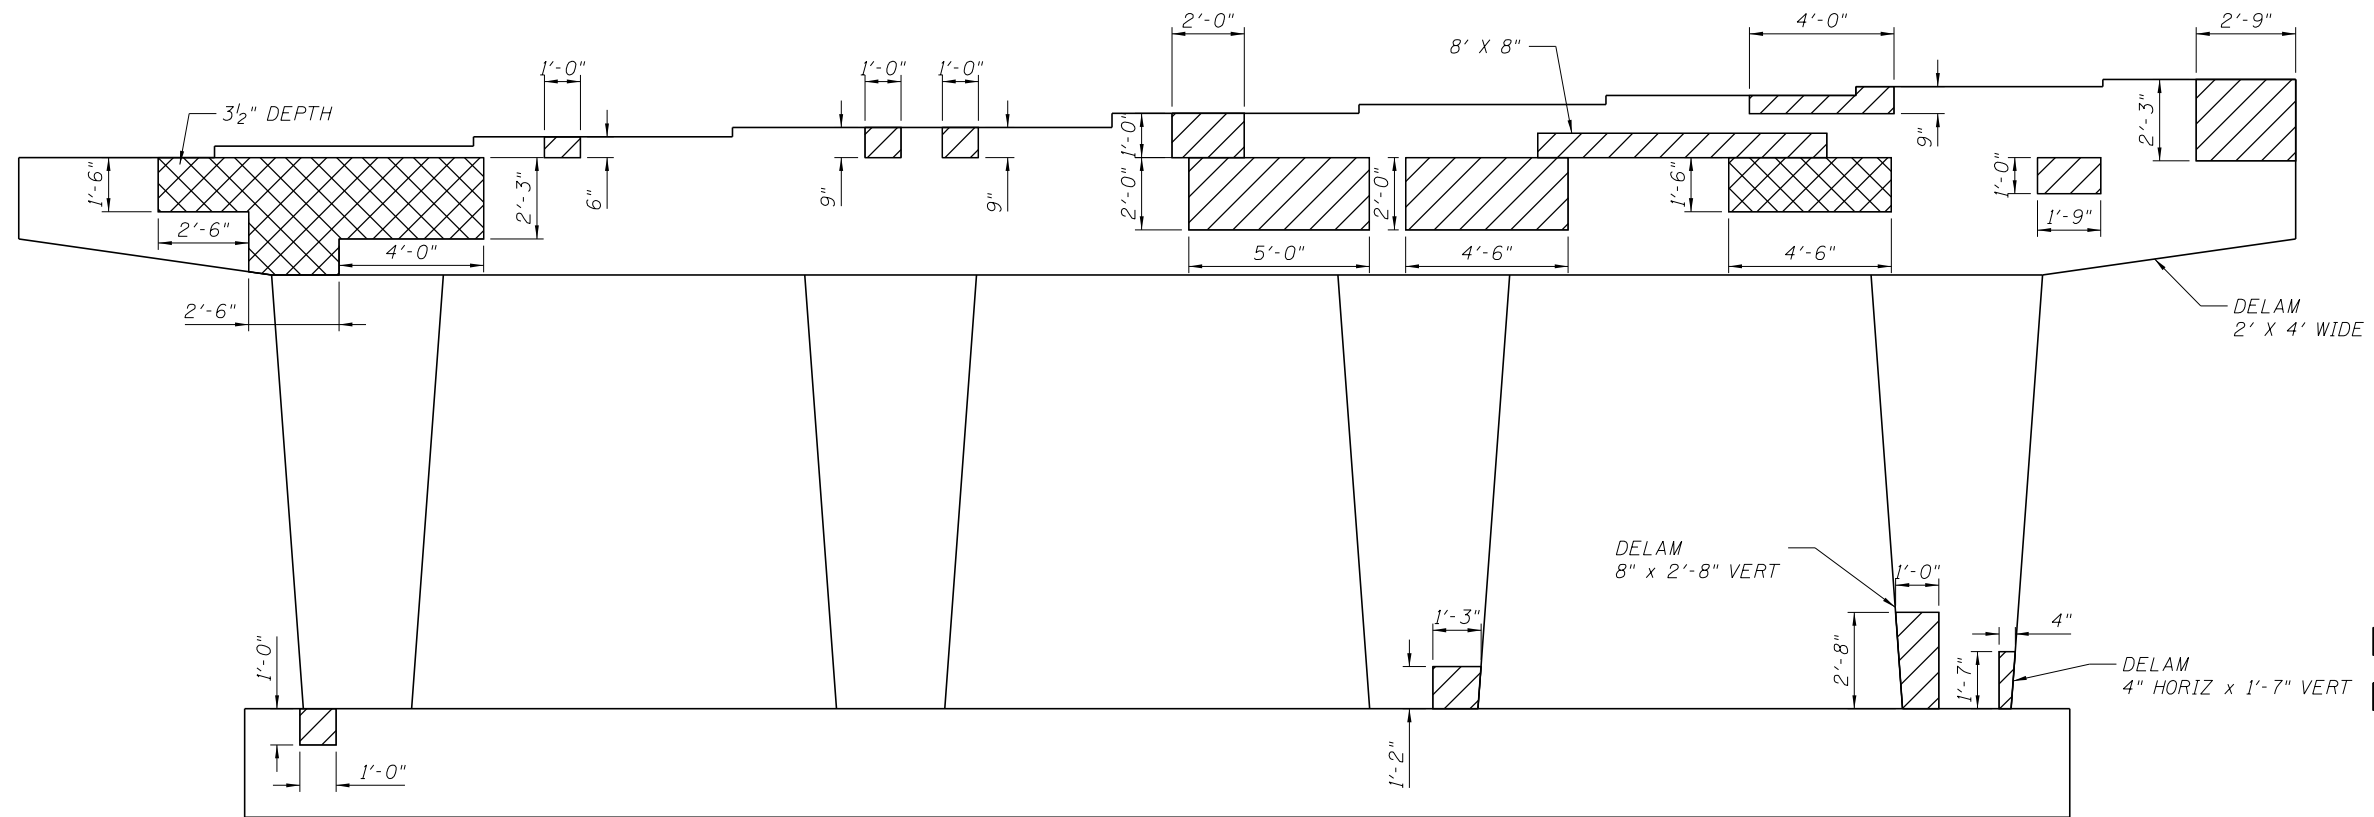

PIER 1
LOOKING WEST

LEGEND

- SPALLED CONCRETE
- DELAMINATED CONCRETE

FILE NAME = W:\1786\active\178600037_IDOT_155\structural\drawing\shd\deg_Cicero.Avenue.Pier.Elevation.dgn




USER NAME = jerojas	DESIGNED - JSR	REVISED -
	CHECKED - BPS	REVISED -
PLOT SCALE = N/A	DRAWN - JSR	REVISED -
PLOT DATE = 10/7/2013	CHECKED - BPS	REVISED -

**STATE OF ILLINOIS
DEPARTMENT OF TRANSPORTATION**


**ATTACHMENT F - SUBSTRUCTURE CONDITION SURVEY
STRUCTURE NO. 016-0016**

SHEET NO. 2 OF 3 SHEETS

F.A.I. RTE. 55	SECTION 1112-619-HB	COUNTY COOK	TOTAL SHEETS	SHEET NO.
CONTRACT NO.				
FED. ROAD DIST. NO. 1 ILLINOIS FED. AID PROJECT				

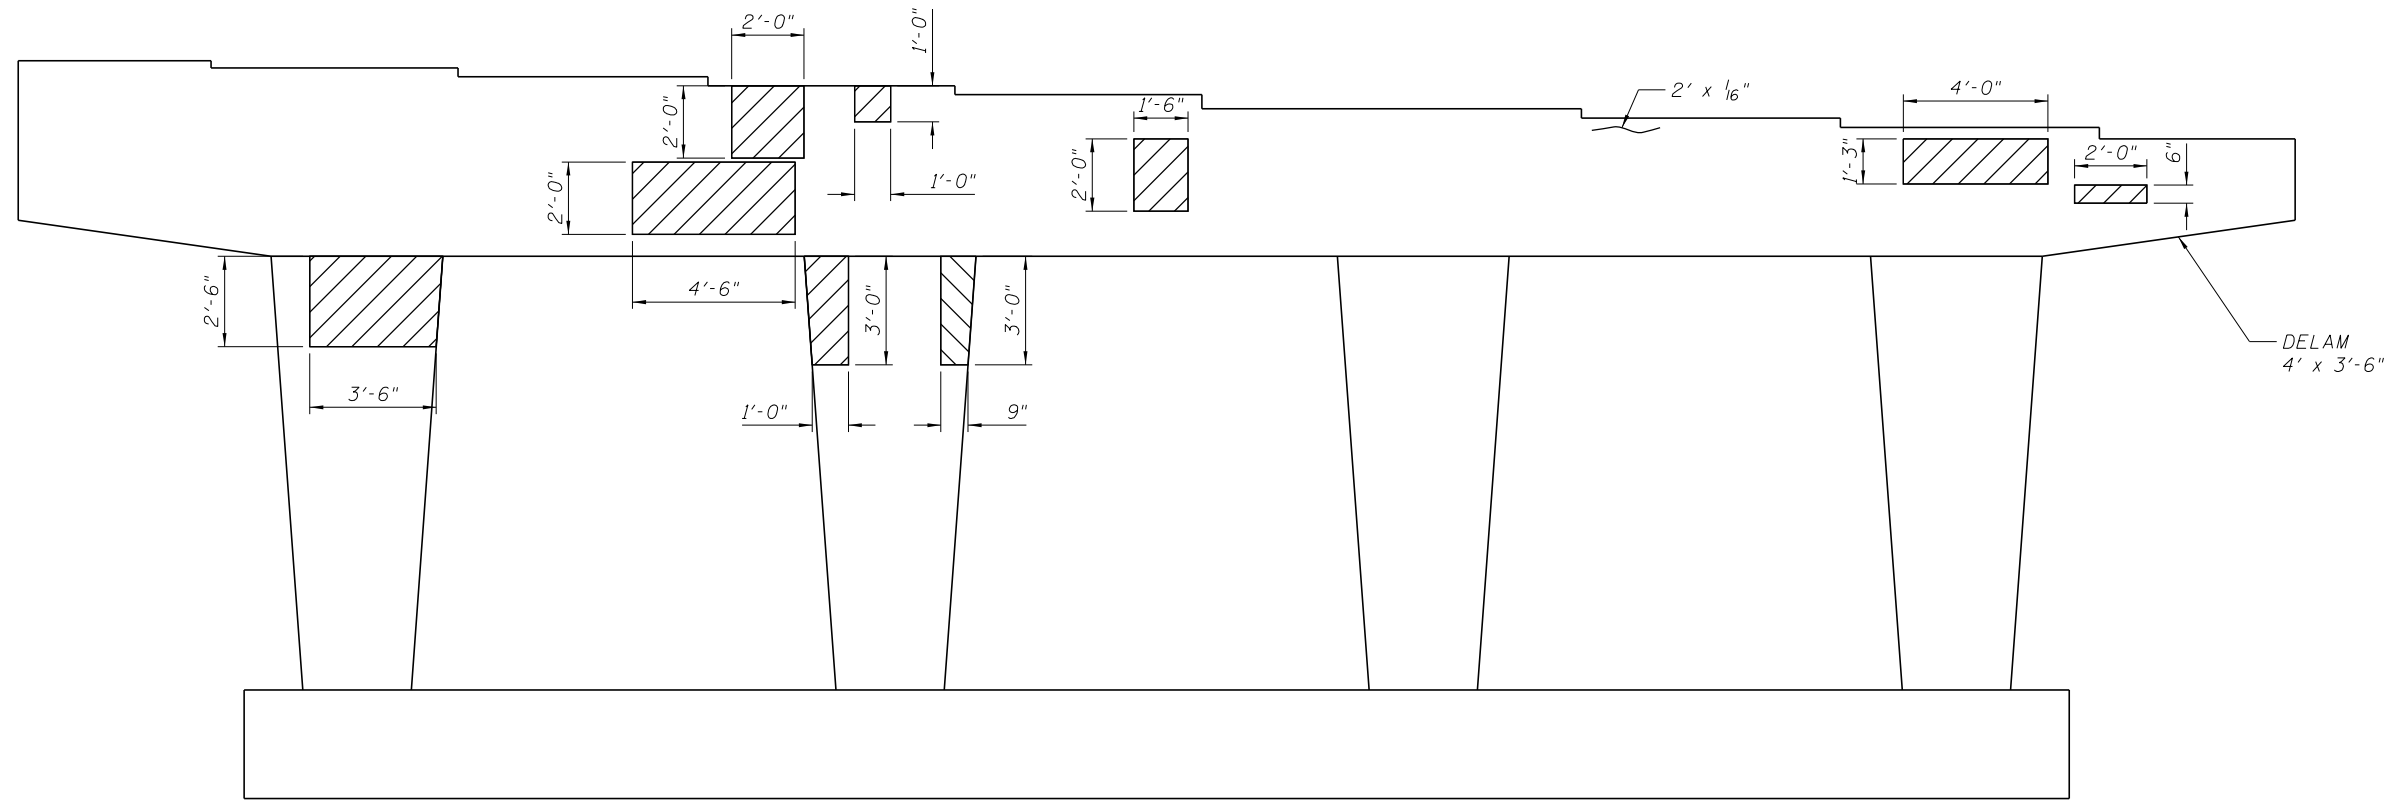
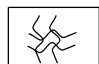
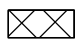
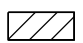


PIER 2
LOOKING EAST

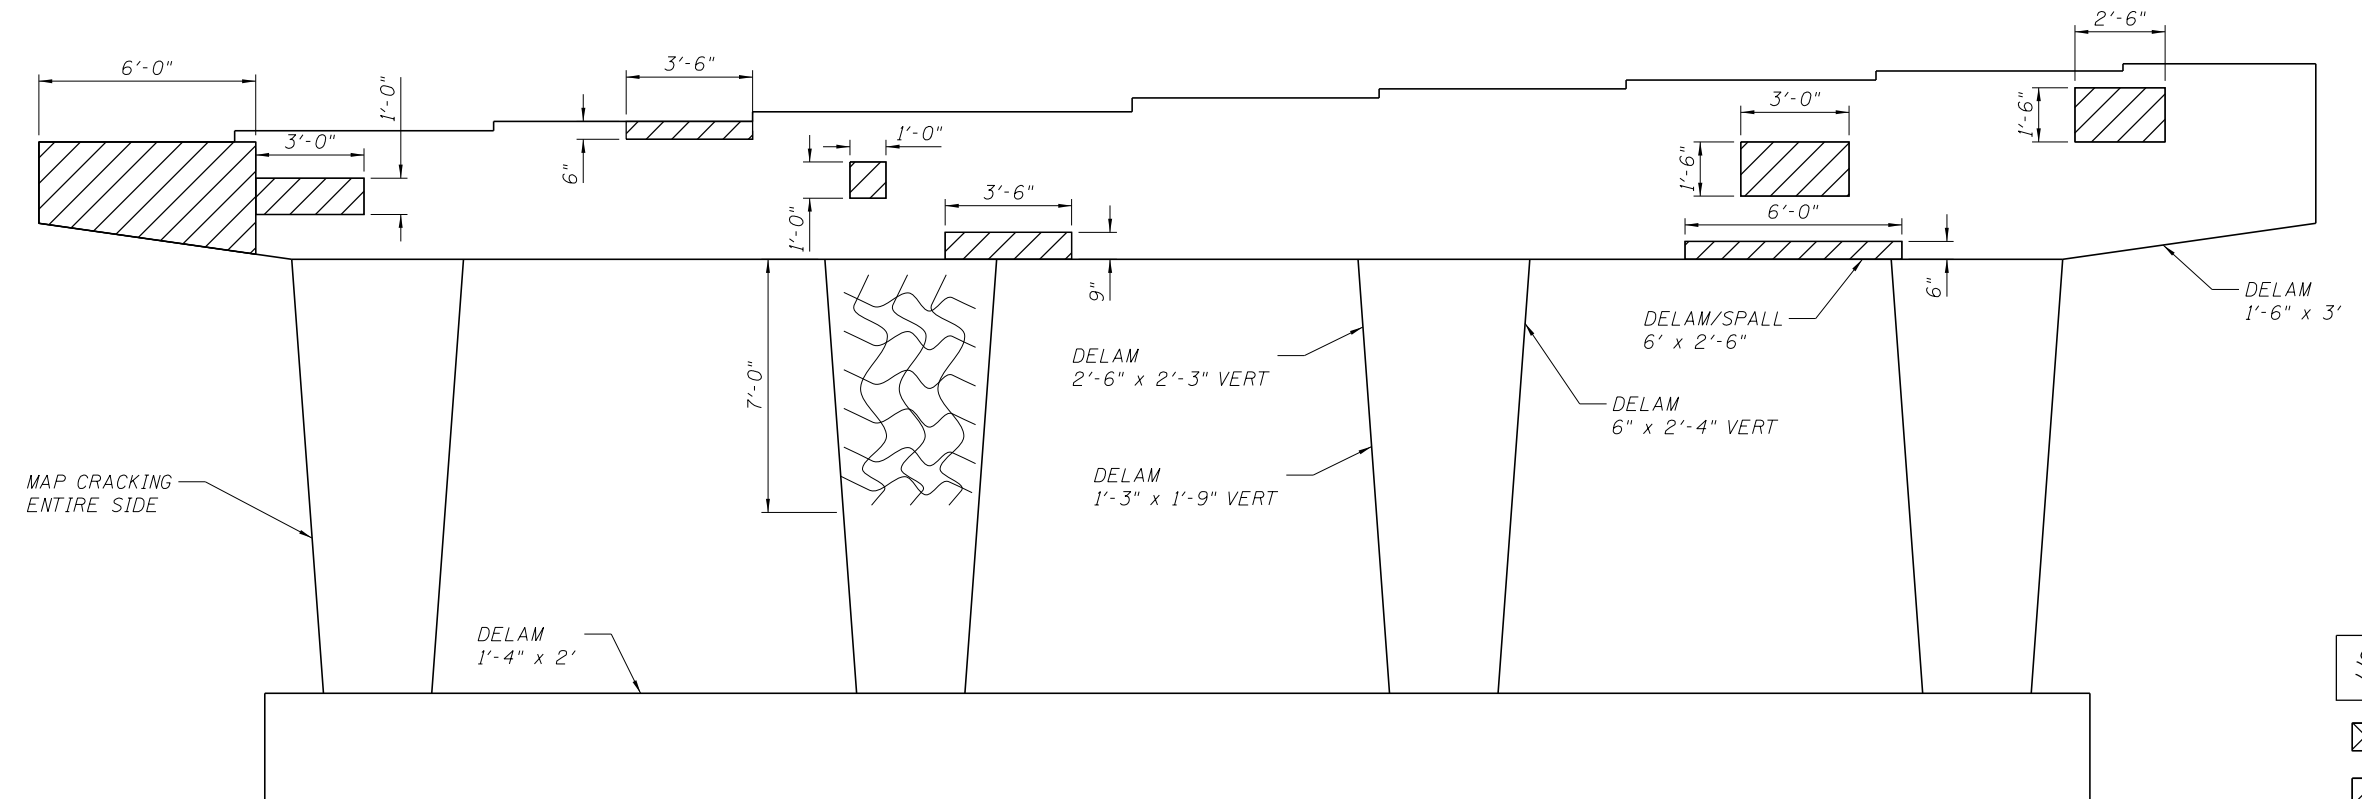

PIER 2
LOOKING WEST

LEGEND

-  - CRACKED CONCRETE
-  - MAP CRACKING
-  - SPALLED CONCRETE
-  - DELAMINATED CONCRETE

FILE NAME = V:\1786\active\178600037_IDOT_1-95\structural\drawing\shd\deg_Cicero.Avenue.Pier_Elevation.dgn



USER NAME = jerojas	DESIGNED - JSR	REVISED -
	CHECKED - BPS	REVISED -
PLOT SCALE = N/A	DRAWN - JSR	REVISED -
PLOT DATE = 10/7/2013	CHECKED - BPS	REVISED -

STATE OF ILLINOIS
DEPARTMENT OF TRANSPORTATION

ATTACHMENT F - SUBSTRUCTURE CONDITION SURVEY
STRUCTURE NO. 016-0016

SHEET NO. 3 OF 3 SHEETS

F.A.I. RTE. 55	SECTION 1112-619-HB	COUNTY COOK	TOTAL SHEETS	SHEET NO.
CONTRACT NO.				
FED. ROAD DIST. NO. 1 ILLINOIS FED. AID PROJECT				

ATTACHMENT G

Opinion of Probable Costs

Sheet: _____ of _____
 Calc By: JSR Date: 10/9/13
 Check By: BHS Date: 12/19/13
 Project Number: 178600037
 Subject: OPINION OF PROBABLE COSTS
I-55 EB over Cicero (016-0016)

ALTERNATIVE 1 - IN-KIND REPAIRS

QUANTITY CODE	QUANTITY DESCRIPTION	QUANTITY	UNIT COST	TOTAL COST
50300300	Protective Coat	1529 sy	\$2.00	\$3,060
50500105	Furnishing and Erecting Structural Steel	2230 lb	\$5.00	\$11,150
Z0012754	Struct Repair of Concrete (Depth = < 5 Inches)	372 sf	\$175	\$65,100
Z0016001	Deck Slab Repair (Full Depth)	18 sy	\$750	\$13,500
Z0016200	Deck Slab Repair (Partial Depth)	141 sy	\$400	\$56,400
SUB TOTAL =				\$149,210
MOBILIZATION (10%) =				\$14,921
CONTINGENCY (20%) =				\$29,842
TOTAL =				\$194,000

ALTERNATIVE 2 - STRUCTURE WIDENING

QUANTITY CODE	QUANTITY DESCRIPTION	QUANTITY	UNIT COST	TOTAL COST
50102400	Concrete Removal	25 cy	\$600	\$15,000
50104720	Removal Existing Concrete Deck	1 LS	\$154,500	\$154,500
50200100	Structure Excavation	281 cy	\$35.00	\$9,840
50300225	Concrete Structures	202 cy	\$700	\$141,400
50300255	Concrete Superstructure	726 cy	\$800	\$580,800
50300260	Bridge Deck Grooving	2189 sy	\$7.00	\$15,320
50300300	Protective Coat	1915 sy	\$2.00	\$3,830
50500105	Furnishing and Erecting Structural Steel	1 LS	\$339,330	\$339,330
50500505	Stud Shear Connectors	1242 each	\$3.00	\$3,730
50800205	Reinforcement Bars, Epoxy Coated	221900 lbs	\$1.75	\$388,330
51201400	Fur Stl Pile HP10x42	2,800 ft	\$45.00	\$126,000
51203400	Test Pile Stl HP10x42	4 each	\$2,000	\$8,000
52000110	Preformed Joint Strip Seal	349 ft	\$175	\$61,080
52100010	Elastomeric Bearing Assembly, Type I	3 each	\$800	\$2,400
59100100	Geocomposite Wall Drain	46 sy	\$25.00	\$1,150
X2070304	Porous Granular Embankment, Special	62 cy	\$50.00	\$3,100
Z0004552	Approach Slab Removal	160 sy	\$35.00	\$5,600
Z0012754	Struct Repair of Concrete (Depth = < 5 Inches)	372 sf	\$175	\$65,100
Z0026407	Temporary Sheet Piling	1108 sf	\$30.00	\$33,230
Z0046304	Pipe Underdrains for Structures 4"	40 ft	\$20.00	\$800
SUB TOTAL =				\$1,958,540
MOBILIZATION (10%) =				\$195,854
CONTINGENCY (20%) =				\$391,708
TOTAL =				\$2,546,200

ALTERNATIVE 3 - SUPERSTRUCTURE AND PARTIAL SUBSTRUCTURE REPLACEMENT


CODE	QUANTITY DESCRIPTION	QUANTITY	UNIT COST	TOTAL COST
50101500	Removal of Existing Superstructures	1 LS	\$185,400	\$185,400
50102400	Concrete Removal	332 cy	\$600	\$199,200
50104650	Slope Wall Removal	719 sy	\$7.00	\$5,030
50200100	Structure Excavation	724 cy	\$35.00	\$25,340
50300225	Concrete Structures	348 cy	\$700	\$243,600
50300255	Concrete Superstructure	962 cy	\$800	\$769,600
50300260	Bridge Deck Grooving	2604 sy	\$7.00	\$18,230
50300300	Protective Coat	2435 sy	\$2.00	\$4,870
50500105	Furnishing and Erecting Structural Steel	1 LS	\$1,834,200	\$1,834,200
50500505	Stud Shear Connectors	9144 each	\$3.00	\$27,430
50800205	Reinforcement Bars, Epoxy Coated	310100 lbs	\$1.75	\$542,680
51100100	Slope Wall 4 Inch	602 sy	\$100	\$60,200
51201400	Fur Stl Pile HP10x42	3240 ft	\$45.00	\$145,800
51203400	Test Pile Stl HP10x42	4 each	\$2,000	\$8,000
52100010	Elastomeric Bearing Assembly, Type I	12 each	\$800	\$9,600
59100100	Geocomposite Wall Drain	172 sy	\$25.00	\$4,300
X2070304	Porous Granular Embankment, Special	352 cy	\$50.00	\$17,600
Z0004552	Approach Slab Removal	160 sy	\$35.00	\$5,600
Z0012754	Structural Repair of Concrete (< 5 Inches)	1 sf	\$350	\$350
Z0026407	Temporary Sheet Piling	1527 sf	\$30.00	\$45,800
Z0046304	Pipe Underdrains for Structures 4"	187 ft	\$20.00	\$3,740
SUB TOTAL =				\$4,156,570
MOBILIZATION (10%) =				\$415,657
CONTINGENCY (20%) =				\$831,314
TOTAL =				\$5,403,600

ALTERNATIVE 4 - STRUCTURE REPLACEMENT


QUANTITY CODE	QUANTITY DESCRIPTION	QUANTITY	UNIT COST	TOTAL COST
50100100	Removal of Existing Structures	1 LS	\$468,000	\$468,000
50104650	Slope Wall Removal	719 sy	\$7.00	\$5,030
50200100	Structure Excavation	1023 cy	\$35.00	\$35,810
50300225	Concrete Structures	585 cy	\$700	\$409,500
50300255	Concrete Superstructure	962 cy	\$800	\$769,600
50300260	Bridge Deck Grooving	2604 sy	\$7.00	\$18,230
50300300	Protective Coat	2435 sy	\$2.00	\$4,870
50500105	Furnishing and Erecting Structural Steel	1 LS	\$1,834,200	\$1,834,200
50500505	Stud Shear Connectors	9144 each	\$3.00	\$27,430
50800205	Reinforcement Bars, Epoxy Coated	357500 lbs	\$1.75	\$625,630
51100100	Slope Wall 4 Inch	602 sy	\$100	\$60,200
51201400	Fur Stl Pile HP10x42	6,120 ft	\$45.00	\$275,400
51203400	Test Pile Stl HP10x42	4 each	\$2,000	\$8,000
59100100	Geocomposite Wall Drain	172 sy	\$25.00	\$4,300
X2070304	Porous Granular Embankment, Special	352 cy	\$50.00	\$17,600
Z0004552	Approach Slab Removal	160 sy	\$35.00	\$5,600
Z0026407	Temporary Sheet Piling	1527 sf	\$30.00	\$45,800
Z0046304	Pipe Underdrains for Structures 4"	187 ft	\$20.00	\$3,740
SUB TOTAL =				\$4,618,940
MOBILIZATION (10%) =				\$461,894
CONTINGENCY (20%) =				\$923,788
TOTAL =				\$6,004,700

ATTACHMENT H

Proposed Structure Drawings

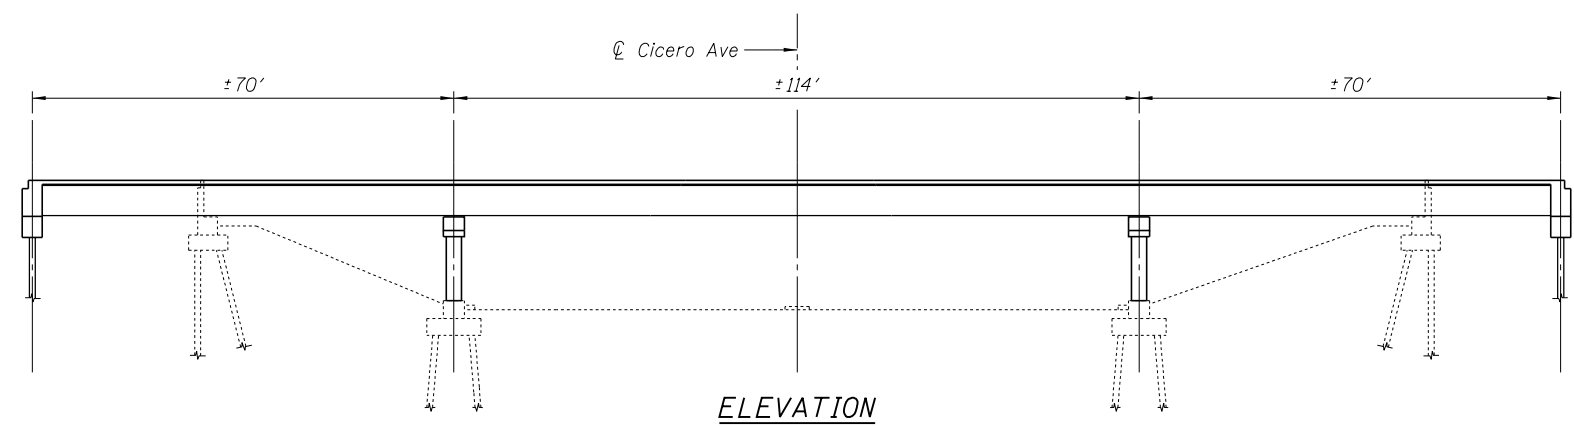

ELEVATION

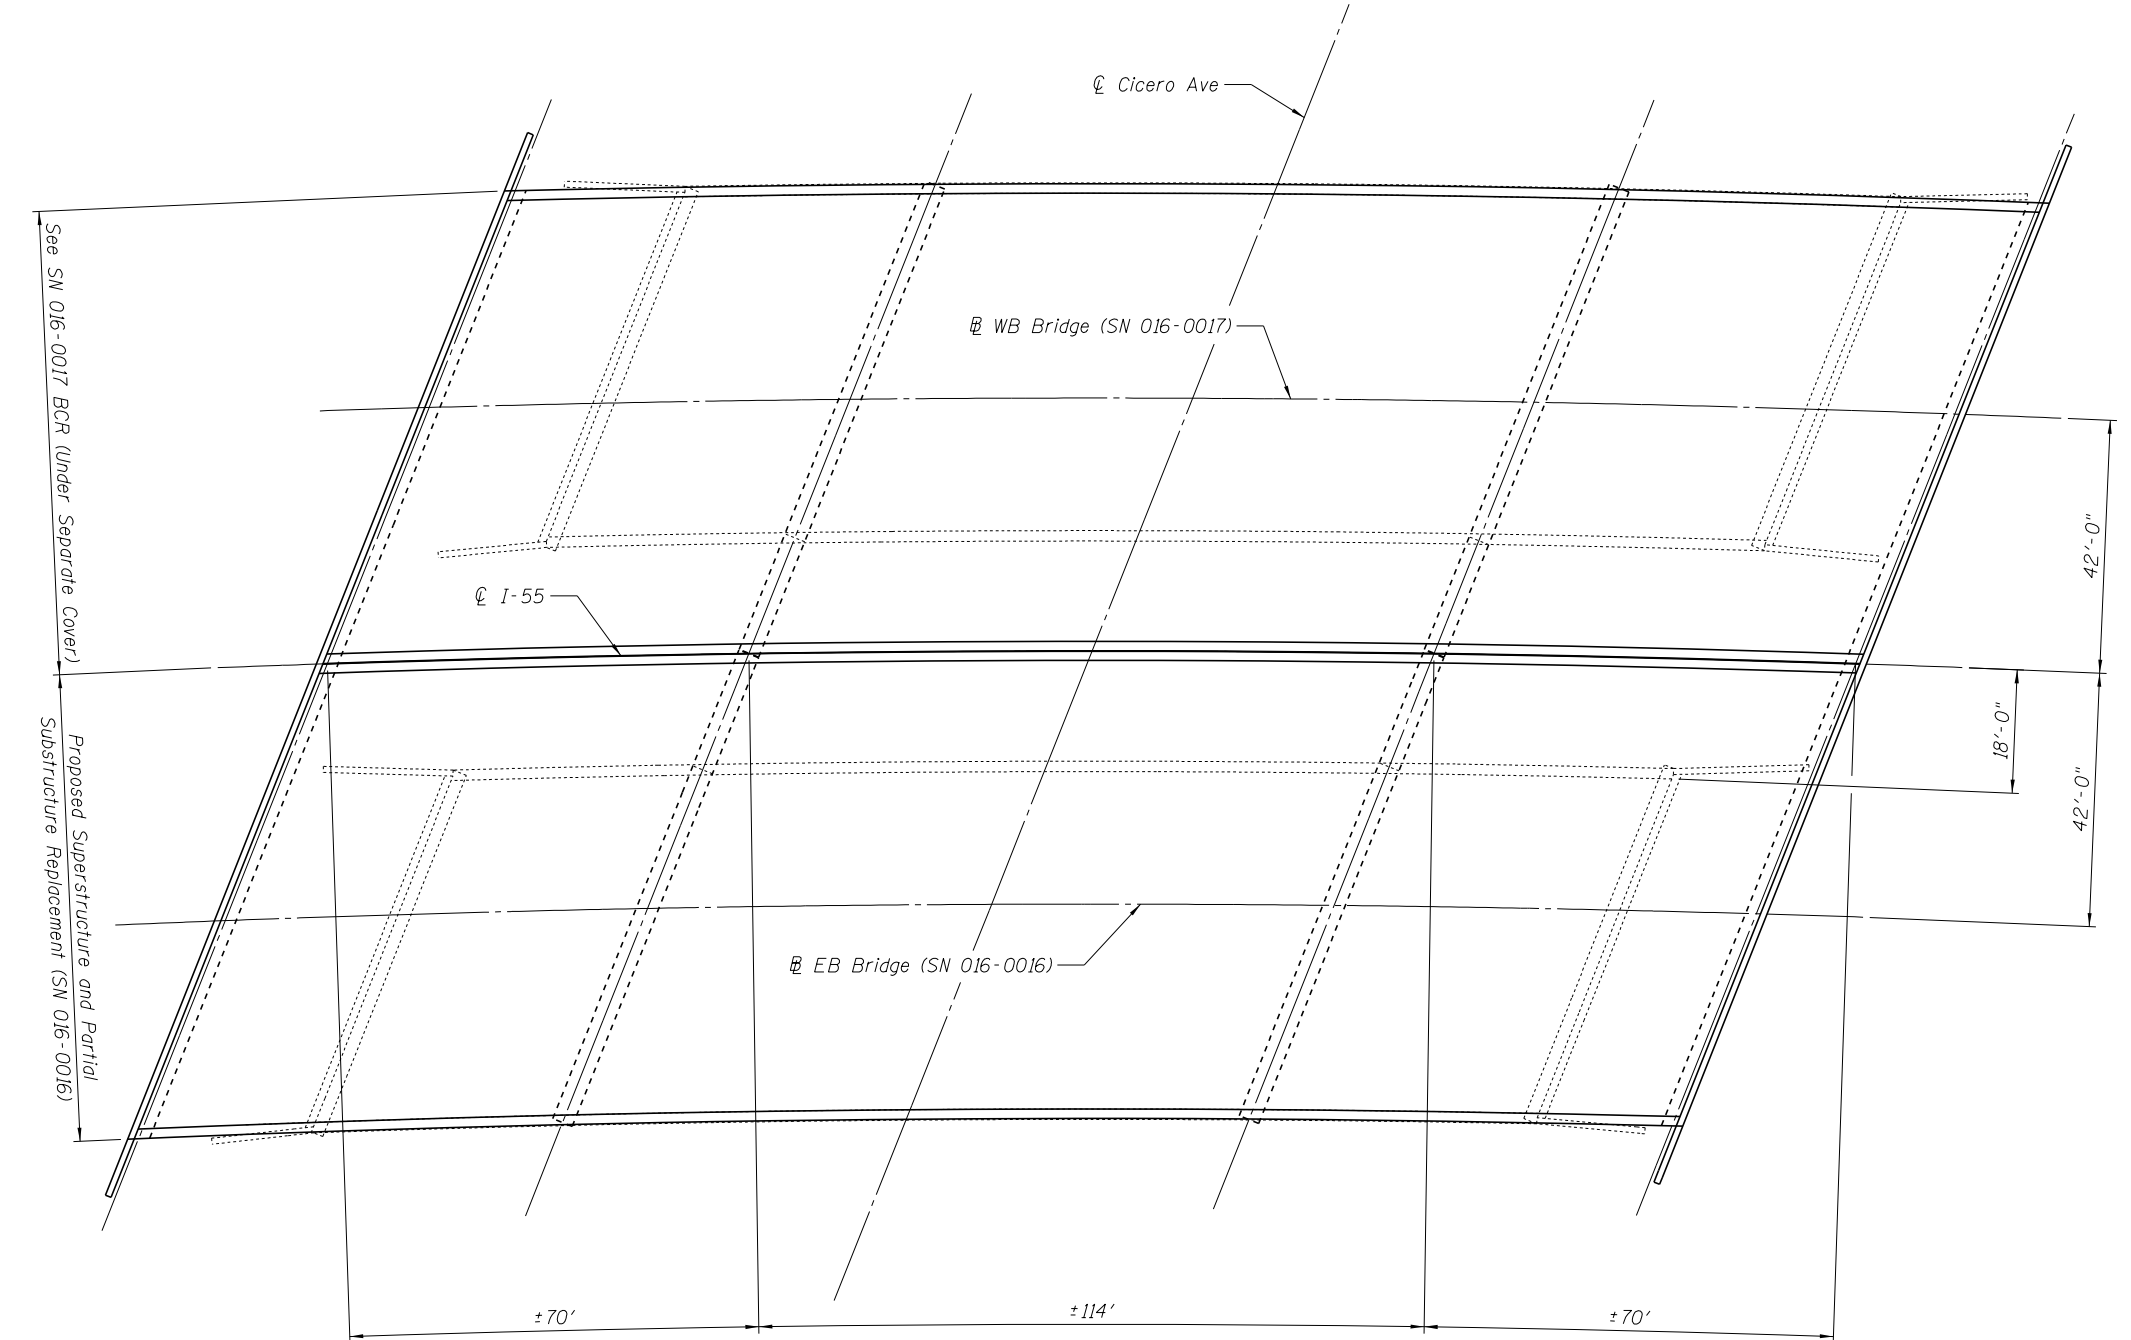

PROPOSED PLAN

Notes:
 The number and location of substructure units, the profile grade, skew angle, and the bridge length and width are subject to refinement in the TSL phase.
 Superstructure type, beam spacing, and rail type to be determined during the TSL phase.

FILE NAME = V:\1786\active\178600037_IDOT_I-55\structural\drawing\shd\dwg_Cicero.Avenue.Deck_Plan.dgn



USER NAME = bsogers	DESIGNED - JSR	REVISED -
	CHECKED - BPS	REVISED -
PLOT SCALE = N/A	DRAWN - JSR	REVISED -
PLOT DATE = 12/19/2013	CHECKED - BPS	REVISED -

**STATE OF ILLINOIS
 DEPARTMENT OF TRANSPORTATION**

**ATTACHMENT H – PROPOSED STRUCTURE DRAWING
 STRUCTURE NO. 016-0016**

SHEET NO. 1 OF 1 SHEETS

F.A.I. RTE. 55	SECTION 1112-619-HB	COUNTY COOK	TOTAL SHEETS	SHEET NO.
FED. ROAD DIST. NO. 1			ILLINOIS FED. AID PROJECT	

ATTACHMENT I

Structure Photos



Photo 1 - Spalls on underside of deck in Span 3 between Beams 9-10 from north, east end, looking east



Photo 2 - Spalls on underside of deck in Span 2 between Beams 9-10 from north, east end, looking west



Photo 3 - Underside of Span 2, south end, looking east



Photo 4 - Underside of deck, Span 1, south end, looking west



Photo 5 – Span 1, looking northeast



Photo 6 – Span 2, looking northeast



Photo 7 - Cracking in shoulder, Span 3, looking east



Photo 8 Span 3, looking northwest



Photo 9 - Outside of South Parapet with minor rust stains, cracking, and minor spalling, looking northeast



Photo 10 - Outside of North Parapet with minor rust stains and cracking, looking southeast



Photo 11 - West Abutment joint, looking north



Photo 12 - Pier 1 joint, looking north



Photo 13 - Pier 2 joint, looking north



Photo 14 - East Abutment joint, looking north



Photo 15 - Typical superstructure in Span 2, looking southwest



Photo 16 - Typical cracked weld between bottom flange of beam in east span and built up steel bolster, looking northeast (Beam 2 from north at East Abutment)



Photo 17 - Typical cover plates on bottom on beams in east span, looking southwest (Beam 3 from north, Span 3)



Photo 18 - South Fascia Beam, looking west



Photo 19 - North Fascia Beam, looking east



Photo 20 - Broken conduit along South Fascia Beam, Span 3, 8' from East Abutment, looking west



Photo 21 - Broken conduit in Span 2 along south fascia beam, 6' from West Pier, looking southeast



Photo 22 - Spall on East Abutment seat between beams 2-3, looking east



Photo 23 - East Abutment, looking east



Photo 24 - West Abutment, looking southwest



Photo 25 - Northwest wingwall, looking southwest



Photo 26 – Southeast wingwall, looking northeast



Photo 27 - East Pier, looking southwest



Photo 28 - Underside of East Pier cap between columns 1-2 from north, looking east

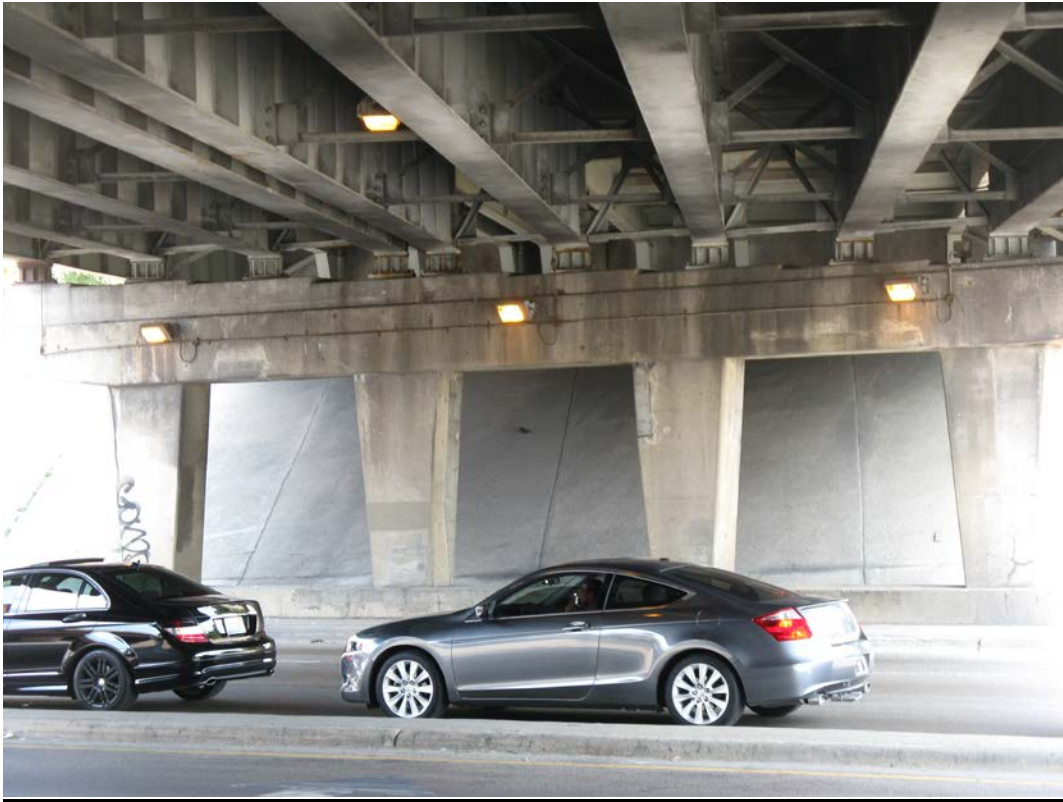


Photo 29 - West Pier, looking east



Photo 30 - Spall on underside of West Pier cap, south end, looking north



Photo 31 - Undermining of east slopewall at south end, looking east



Photo 32 - Undermining of east slopewall at south end, looking east



Photo 33 – East slopewall, north half, looking northeast


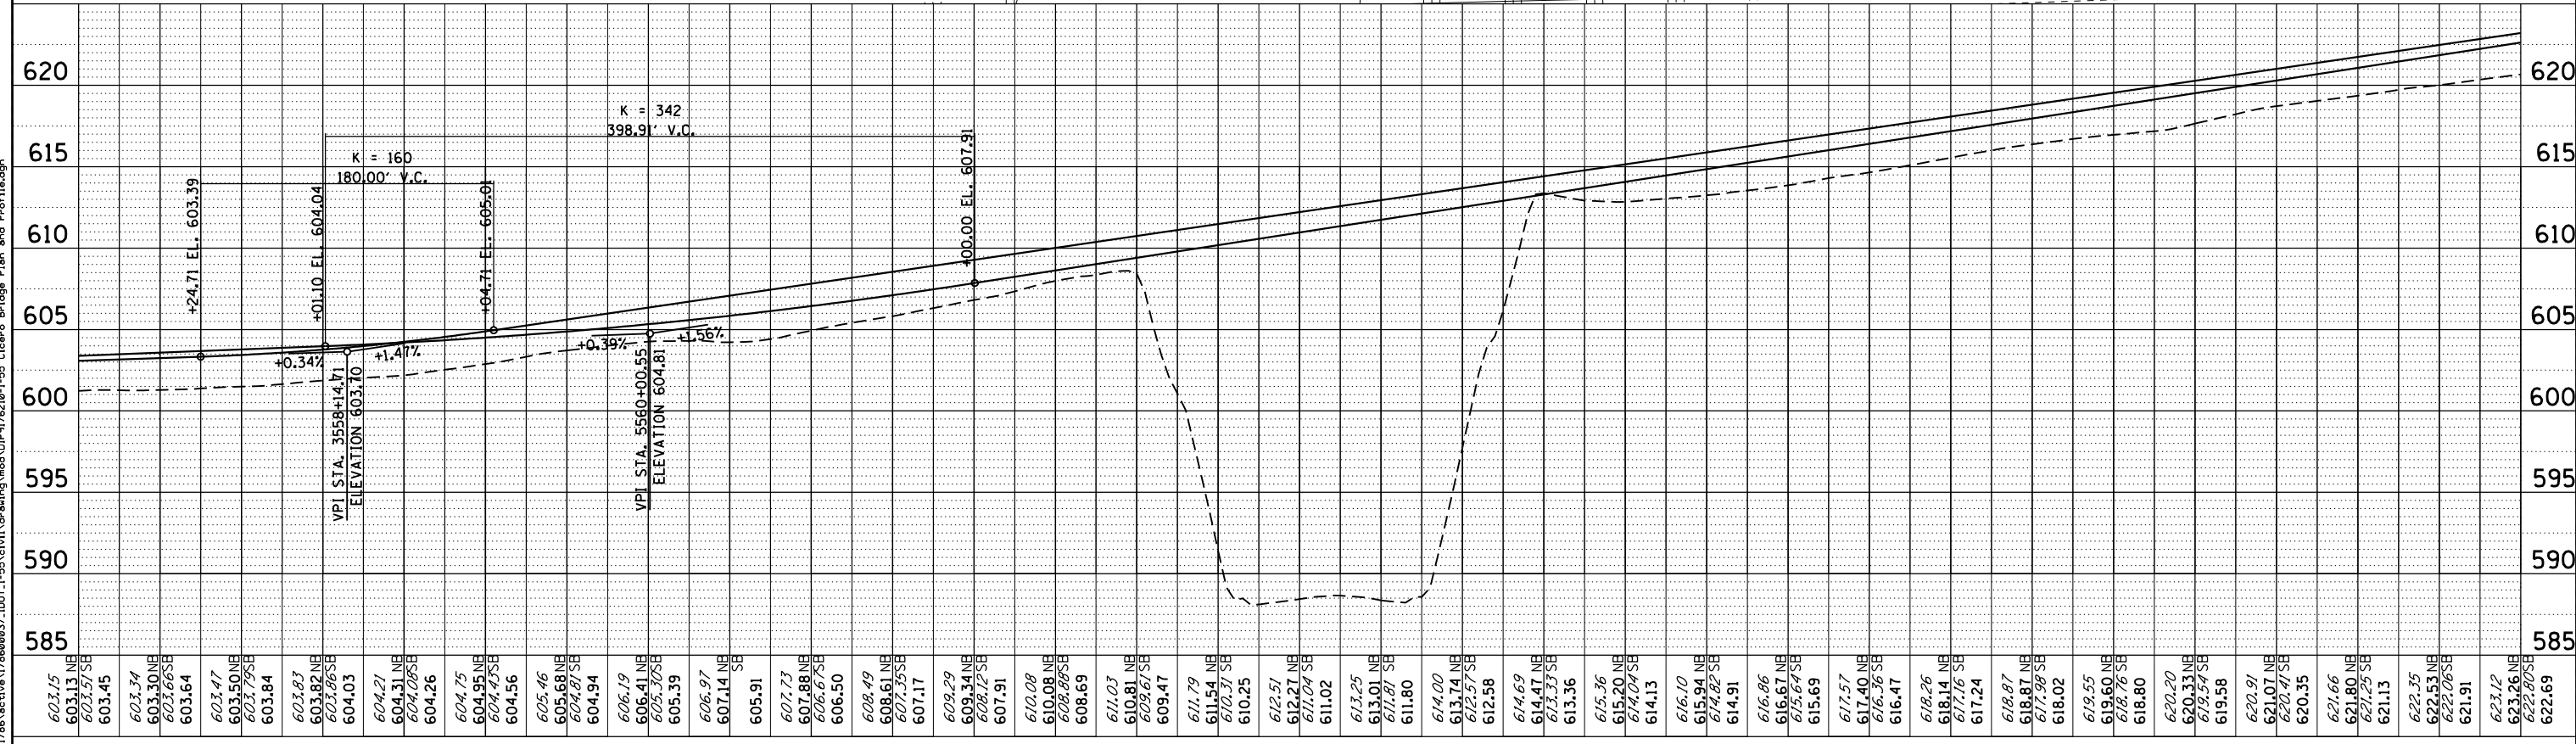


Photo 34 - Broken section of west slopewall curb with vegetation growing in it, approx half way up, looking west

ATTACHMENT J

Proposed Plan & Profile

FILE NAME = V:\1786\active\178600037_1DOT_I-55\civil\drawing\mod\178600037_1DOT_I-55\civil\drawing\mod\178600037_1DOT_I-55\Cicero Bridge Plan and Profile.dgn

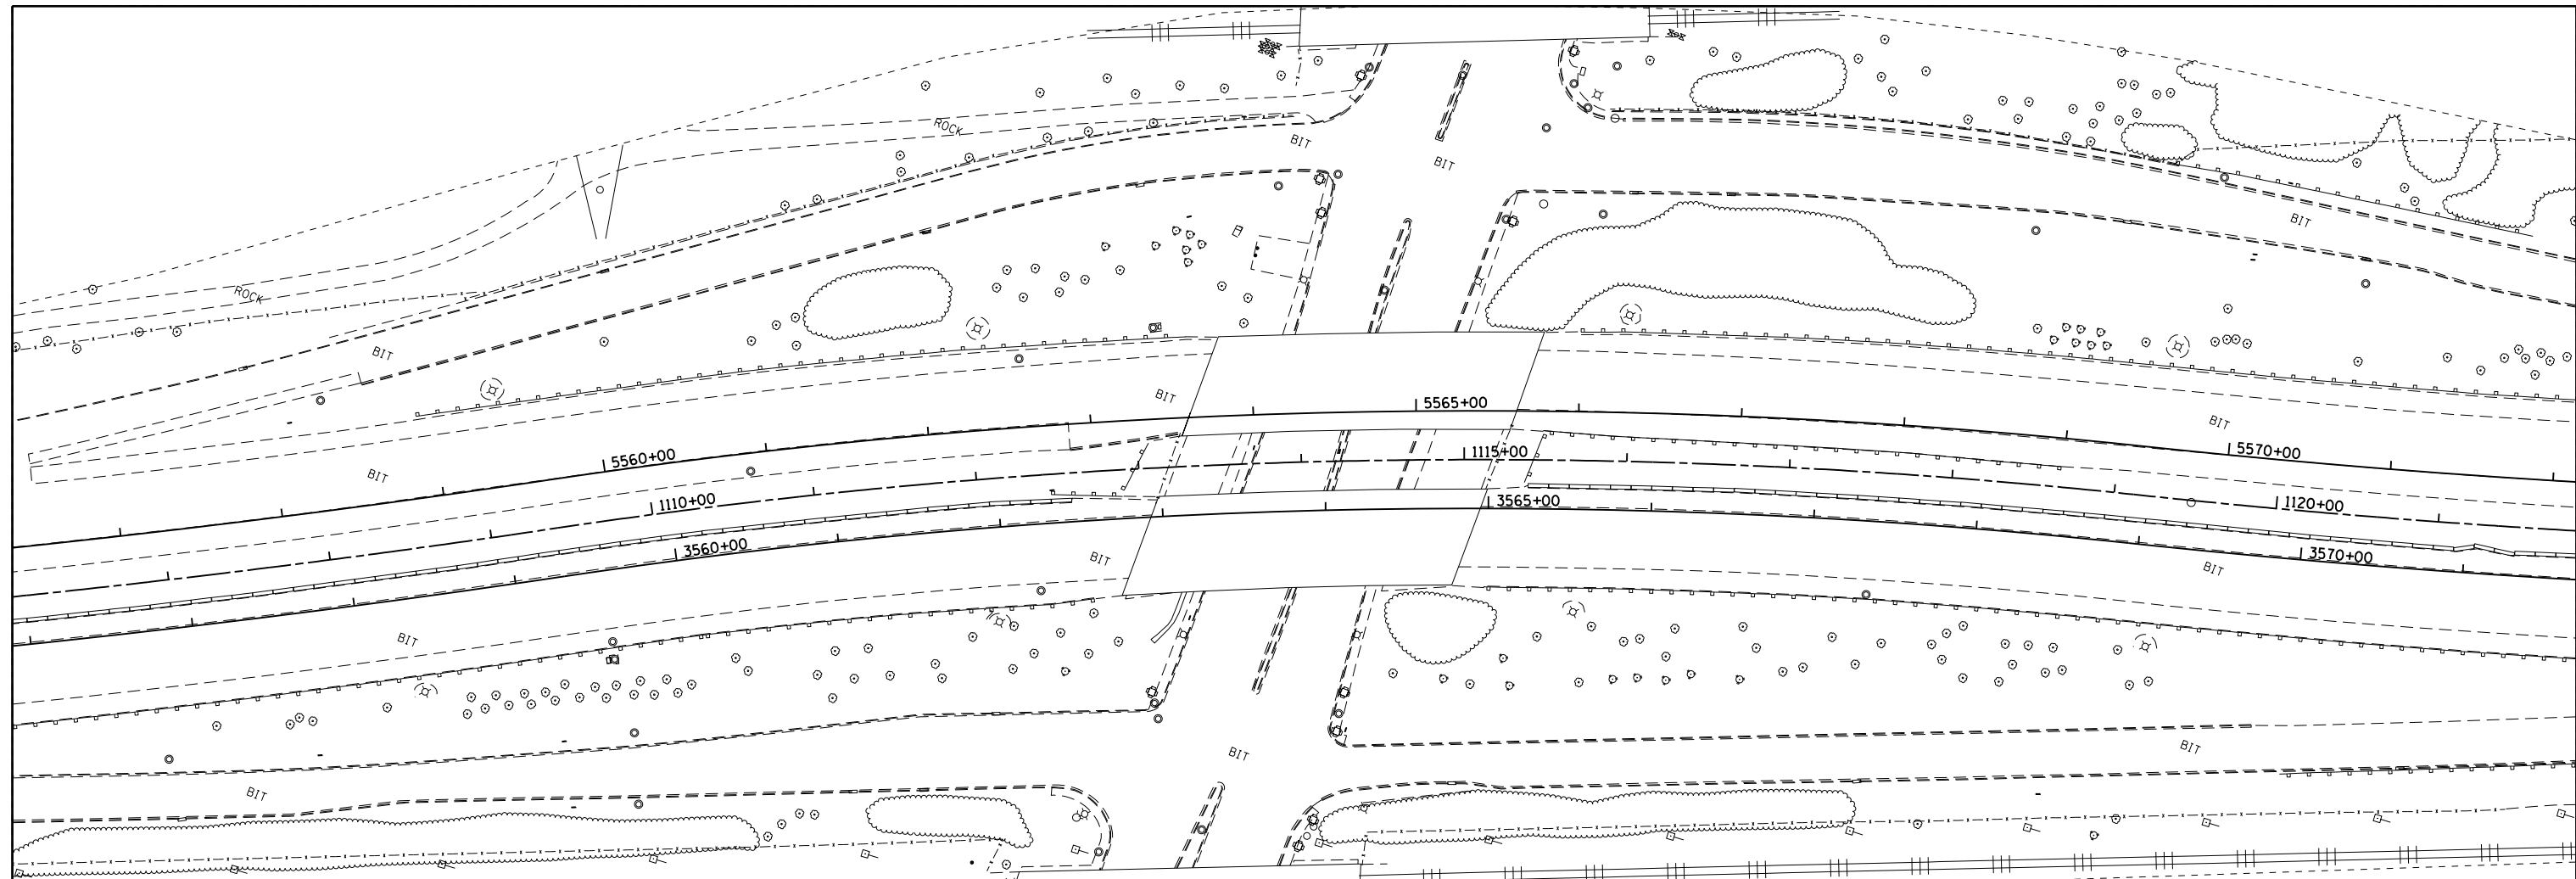

603.15	603.13 NE	603.57 SB	603.45	603.34	603.30 NE	603.65 SB	603.64	603.47	603.50 NE	603.79 SB	603.84	603.83	603.82 NE	603.95 SB	604.03	604.21	604.31 NE	604.09 SB	604.26	604.75	604.95 NE	604.49 SB	604.56	605.46	605.68 NE	604.87 SB	604.94	606.19	606.41 NE	605.37 SB	605.39	606.97	607.14 NE	607.14 SB	605.91	607.73	607.88 NE	606.87 SB	606.50	608.49	608.61 NE	607.39 SB	607.17	609.29	609.34 NE	608.12 SB	607.91	610.08	610.08 NE	608.89 SB	608.69	611.03	611.03 NE	609.67 SB	609.47	611.79	611.54 NE	610.37 SB	610.25	612.51	612.21 NE	611.04 SB	611.02	613.25	613.01 NE	611.81 SB	611.80	614.00	613.74 NE	612.57 SB	612.58	614.69	614.41 NE	613.37 SB	613.36	615.36	615.20 NE	614.04 SB	614.13	616.10	615.94 NE	614.82 SB	614.91	616.86	616.67 NE	615.64 SB	615.69	617.57	617.40 NE	616.36 SB	616.47	618.26	618.14 NE	617.16 SB	617.24	618.87	618.87 NE	617.98 SB	618.02	619.55	619.60 NE	618.76 SB	618.80	620.20	620.33 NE	619.54 SB	619.58	620.91	621.07 NE	620.47 SB	620.35	621.66	621.80 NE	621.29 SB	621.13	622.35	622.53 NE	622.06 SB	621.91	623.12	623.26 NE	622.87 SB	622.69
--------	-----------	-----------	--------	--------	-----------	-----------	--------	



USER NAME = m.j.verheyen	DESIGNED - MJV	REVISED -
PLOT SCALE = 100.0000' / 1in.	DRAWN - STANTEC	REVISED -
PLOT DATE = 10/4/2013	CHECKED -	REVISED -
	DATE - 10/04/2013	REVISED -


STATE OF ILLINOIS
DEPARTMENT OF TRANSPORTATION

ATTACHMENT J	
I-55 OVER CICERO AVE PROPOSED PLAN & PROFILE	
SCALE: 1"=100'	SHEET ___ OF ___ SHEETS STA. _____ TO STA. _____


F.A.I. RTE. 55	SECTION	COUNTY COOK	TOTAL SHEETS	SHEET NO.
CONTRACT NO.				
ILLINOIS FED. AID PROJECT				

ATTACHMENT K

**Existing and Proposed Roadway Cross
Sections**

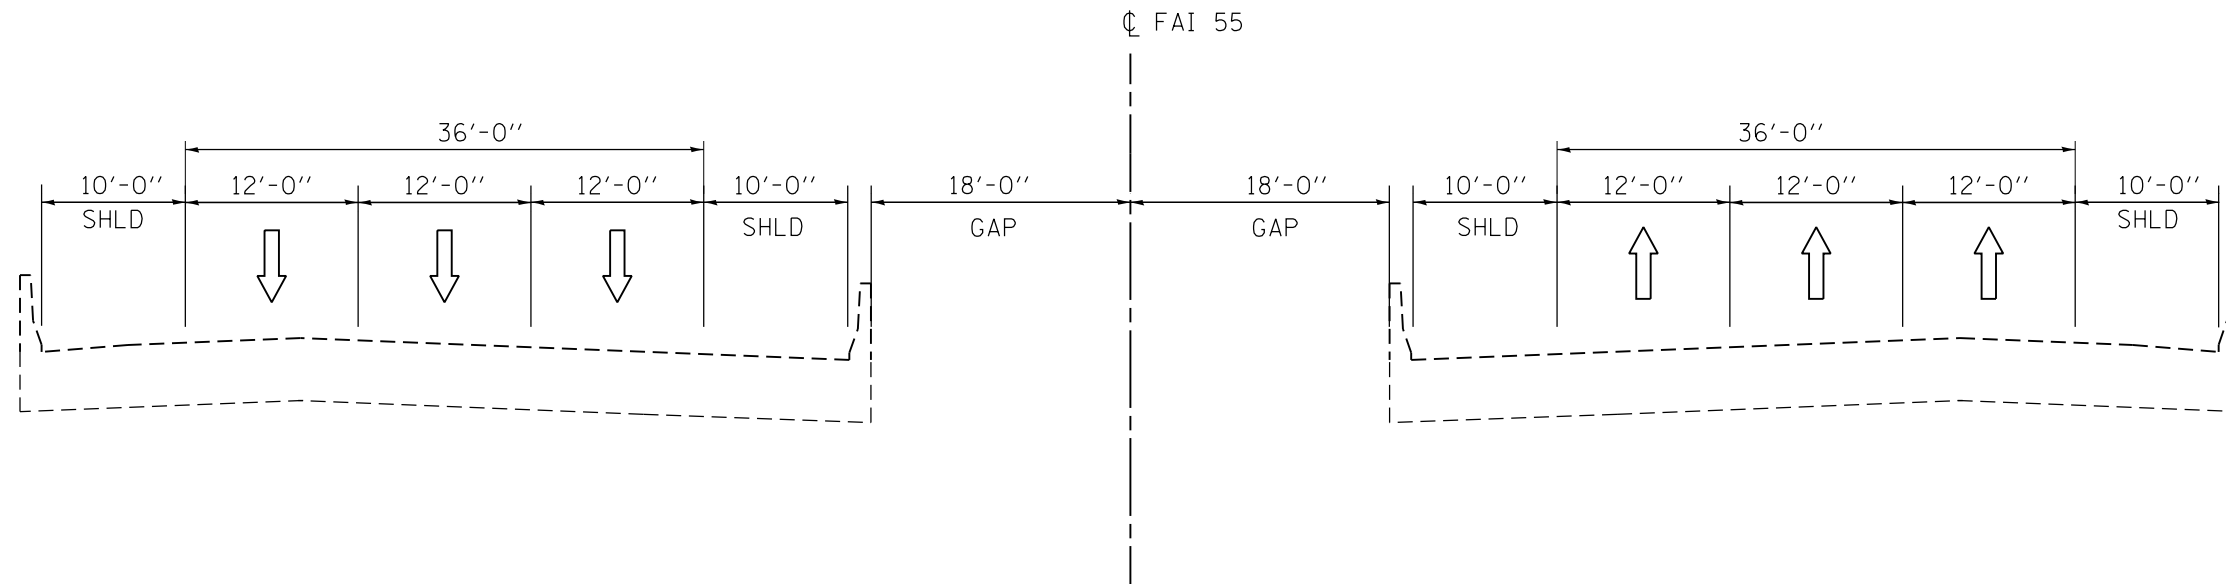

EXISTING I-55 OVER CICERO AVE TYPICAL SECTION

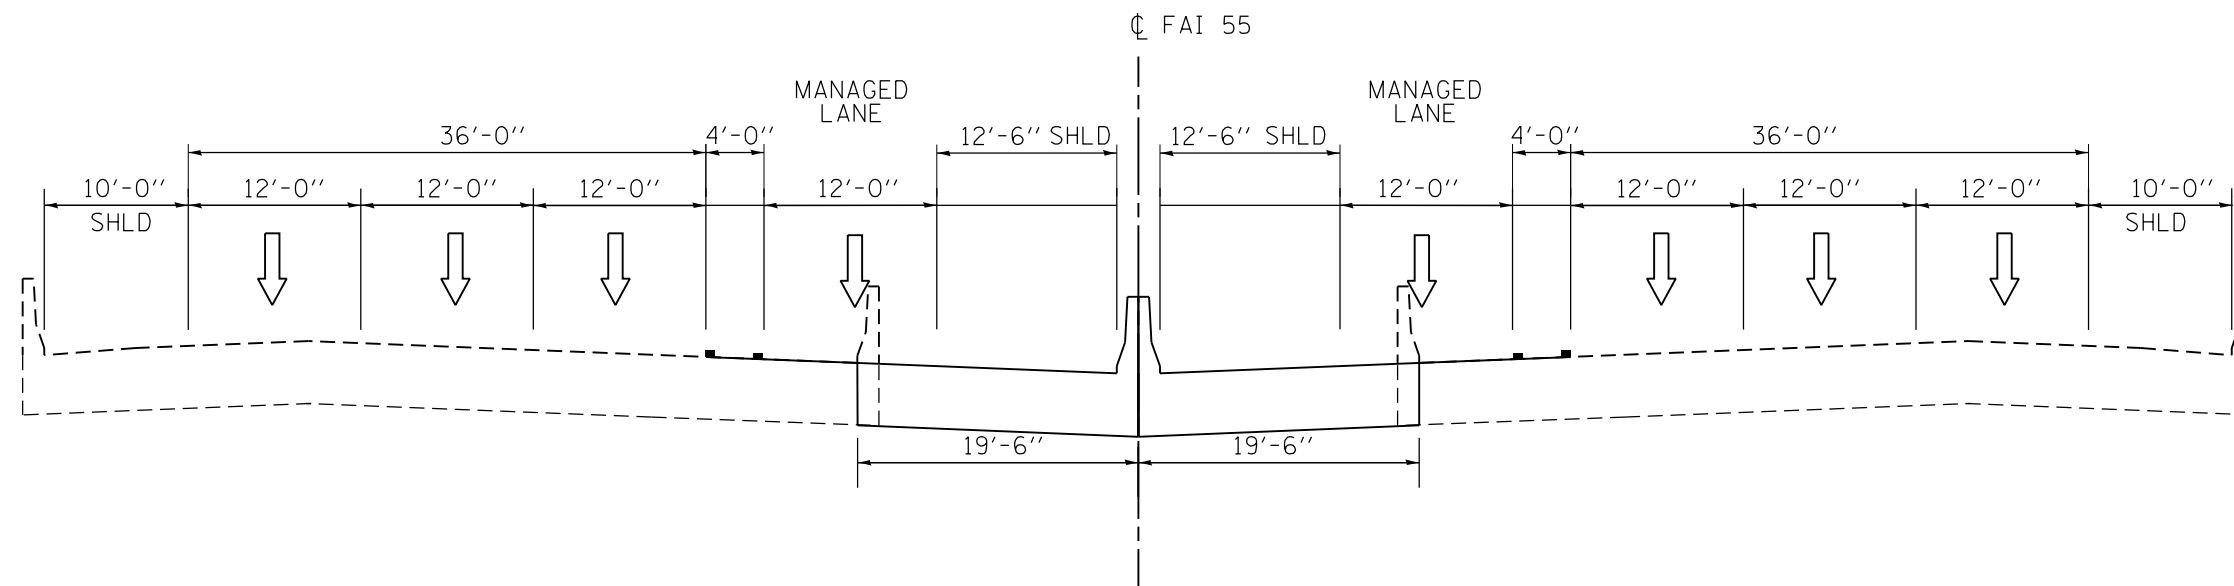

PROPOSED I-55 OVER CICERO AVE TYPICAL SECTION

FILE NAME = V:\7865\active\786500037_IDOT_I-55\civ1\drawing\mod\IP176210-typical-sections\Cicero Ave and RR Structure.dgn



USER NAME = mjverheyen	DESIGNED - MJV	REVISED -
	DRAWN - STANTEC	REVISED -
PLOT SCALE = 13.3343' / 1in.	CHECKED -	REVISED -
PLOT DATE = 10/7/2013	DATE - 10/7/2013	REVISED -

STATE OF ILLINOIS
DEPARTMENT OF TRANSPORTATION

ATTACHMENT K
TYPICAL SECTIONS



SCALE: SHEET 1 OF 2 SHEETS STA. TO STA.

F.A.I. RTE.	SECTION	COUNTY	TOTAL SHEETS	SHEET NO.
55		COOK		
CONTRACT NO.				
ILLINOIS FED. AID PROJECT				


ATTACHMENT L

Abbreviated Existing Plans

F.A.I. RITE	SECTION	EXPRESSWAY	TOTAL SHEETS	SHEET NO.
55	1112-619-MB	SOUTHWEST	32	2C
STA. 23+02.91		TO STA. 25+40.38		
FED. ROAD DIST. NO. 7		ILLINOIS FED. AID PROJECT 1-65-7(29)-281		

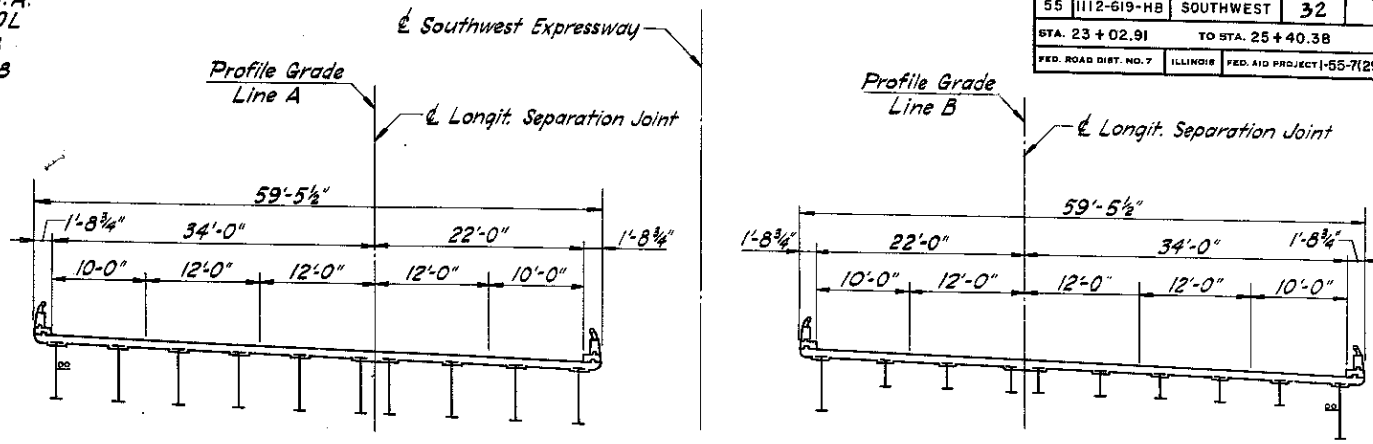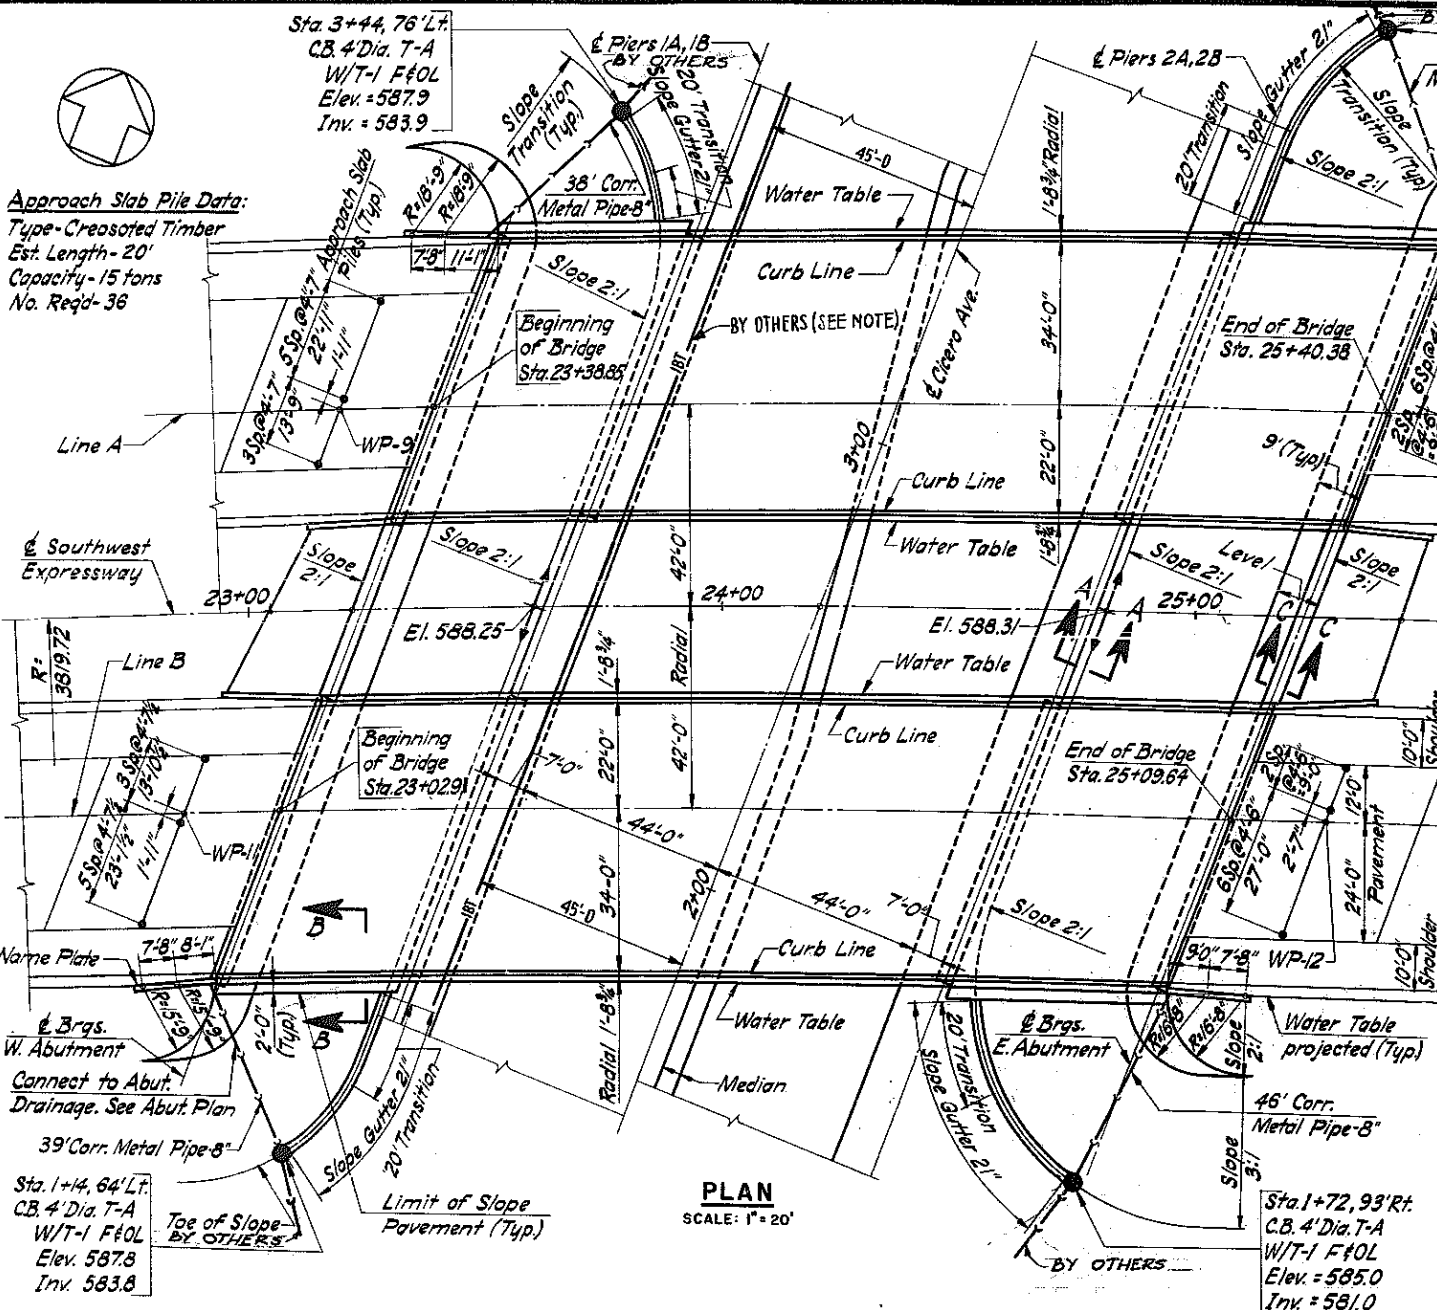

CODE NUMBER	ITEM	UNIT	QUANTITY				
			BRIDGE A		BRIDGE B		TOTAL for 2 Bridges
			Sub.	Super.	Sub.	Super.	
016001	Embankment	Cu. Yds.	14620	—	18,260	—	32,880
019001	Porous Granular Embankment	Cu. Yds.	636	—	618	—	1,254
050001	Class "A" Excavation for Structures	Cu. Yds.	256	—	256	—	512
052003	Class "X" Concrete	Cu. Yds.	470.5	3080	471.2	3090	1,558.7
052021	Protective Coat	Sq. Yds.	—	1449	—	1,454	2,903
054001	Furn. & Erect Struct. Steel	Lbs.	—	496,970	—	498,710	995,680
059001	Reinforcement Bars	Lbs.	62380	78,510	64,470	78,510	283,870
060004	Furnishing Creosoted Piles (up to 20')	Lin. Ft.	360	—	360	—	720
060008	Driving Timber Piles	Lin. Ft.	360	—	360	—	720
060043	Driving Concrete Piles	Lin. Ft.	4335	—	4,425	—	8,760
060044	Furnishing Concrete Piles	Lin. Ft.	4,335	—	4,425	—	8,760
060047	Test Pile Concrete	Ea.	2	—	2	—	4
061001	Name Plates	Ea.	—	1	—	1	2
063001	Corrugated Metal Pipe, 8"	Lin. Ft.	85	—	85	—	170
063020	Perforated Corrugated Metal Pipe, 6"	Lin. Ft.	165	—	165	—	330
075015	C.B. T.A. 4' Dia. T.F. & Open Lid	Ea.	2	—	2	—	4
083002	Slope Wall 4 inch	Sq. Yds.	813	—	719	—	1,532
L02710	Rigid Steel Conduit, 2" Dia.	Lin. Ft.	—	440	—	440	880
L02738	Rigid Steel Conduit, 2 1/2" Dia.	Lin. Ft.	40	—	30	—	70
L02766	Rigid Steel Conduit, 1 1/2" Dia.	Lin. Ft.	—	10	—	20	30
Z08008	Aluminum Handrail	Lin. Ft.	76	403	76	404	959

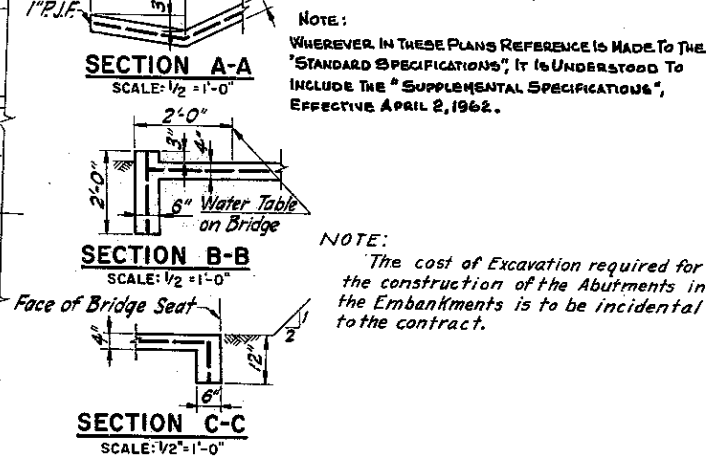

GENERAL NOTES

CONCRETE:

- Coarse aggregate to be used in parapet handrails and end posts must be absolutely free of chert, flint, limonite, lignite and soft sandstone.
- The concrete floor slab shall be finished in accordance with article 51.19 of the standard specifications.
- Sloped wall shall be reinforced with welded wire fabric 6"x6" mesh weighing 58 #/per 100 sq. ft.
- All reinforcement bars shall be lapped 20 diameter: unless otherwise shown.
- Permanent forms will not be permitted in forming the concrete floor.
- Class X concrete shall be used throughout.

STRUCTURAL STEEL:

- Rivets 3/4" φ open holes 5/8" φ unless otherwise noted.
- Anchor bolts shall be set before riveting diaphragms over supports.
- Roadway expansion guards shall be assembled in the shop in proper position with the ends in place and shall be left assembled for shop inspection.
- The following surfaces of the expansion guard shall be given two shop coats of red lead paint: the outside vertical 4" legs of the Ls 6x4x1/4.
- Expansion guards are included in the quantity of structural steel estimated weight 16,560 lbs. Bridge A and 16,610 lbs. Bridge B.
- Except as otherwise provided all structural steel shall receive one shop coat of red lead paint and two field coats of aluminum paint. See article 56.1 to 56.5 inclusive of the standard specifications and the special provisions.
- Structural carbon steel shall conform to specifications for carbon steel A.S.T.M. designation A-36.

SUBSTRUCTURE:

- The contractor shall drive 4 concrete test piles in a permanent location shown on the pier and abutment footing plans as directed by the engineer before ordering the remainder of the piles.
- Concrete piles at abutments shall be driven in holes precored through the embankment.

This work shall be done in accordance with article 60.9(c) of the standard specifications.

TWO SIGNS CONFORMING TO STD. 2160-1 SHALL BE ERRECTED AT LOCATIONS SHOWN ON THE PLANS (SHEET 2B)

UTILITIES:


1. The proposed Illinois Bell Telephone Co. line will be in place prior to beginning bridge construction.

DESIGN LOADS AND STRESSES

Specifications: A. A. S. H. O., 1961
Design Load: H20-S16-44 & alternate
25 psf Future wearing surface

Design Stresses: Structural Steel: F = 20,000 psi
Reinforcement Steel: F = 20,000 psi
Concrete: Fc = 3,500 psi
Ft = 1,400 psi
Fv = 1,000 psi (with earth pressure)
Fv = 75 psi (Footings)
n = 10

Piling: Concrete = 30 ton capacity
Creosoted Timber = 15 ton capacity

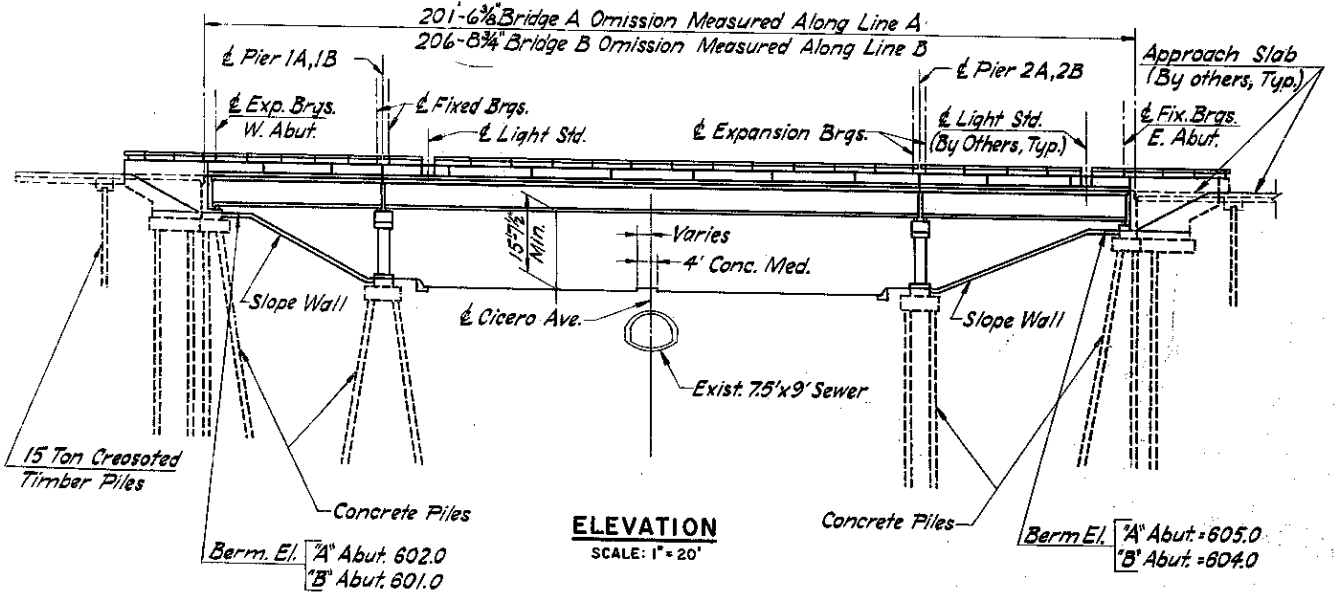

3. Concrete piles at piers shall be driven in holes precored to elevation 574.00.

REVISIONS	
NAME	DATE







ILLINOIS DIVISION OF HIGHWAYS
SOUTHWEST EXPRESSWAY
EXPRESSWAY OVER CICERO AVE.

GENERAL PLAN

SCALE: HORIZ. AS NOTED VERT. AS NOTED
DATE: DEC., 1962
DRAWN BY M. Casone
CHECKED BY S. Rouse

Rev. Removed 200 cu yd Special Excav. Rev. C17A Excav. 1080 to 572 cu yd - Added Metal Handrail Type E - 859 lbs. 3-25-63 Rev. Wt. for E & E.S.S. 433 2903 lbs. 4/2/63

SECTION	EXPRESSWAY	TOTAL SHEETS	SHEET NO.
55	1112-619-HB	SOUTHWEST	52
STA. 23+02.91	TO STA. 25+40.38		
ILLINOIS		FED. AID PROJECT	

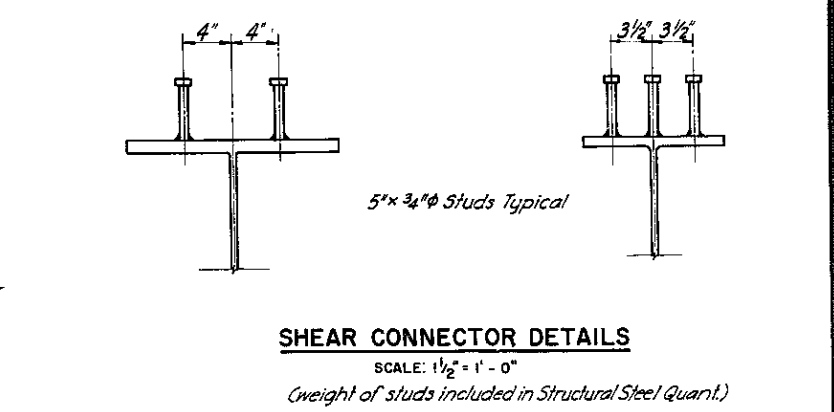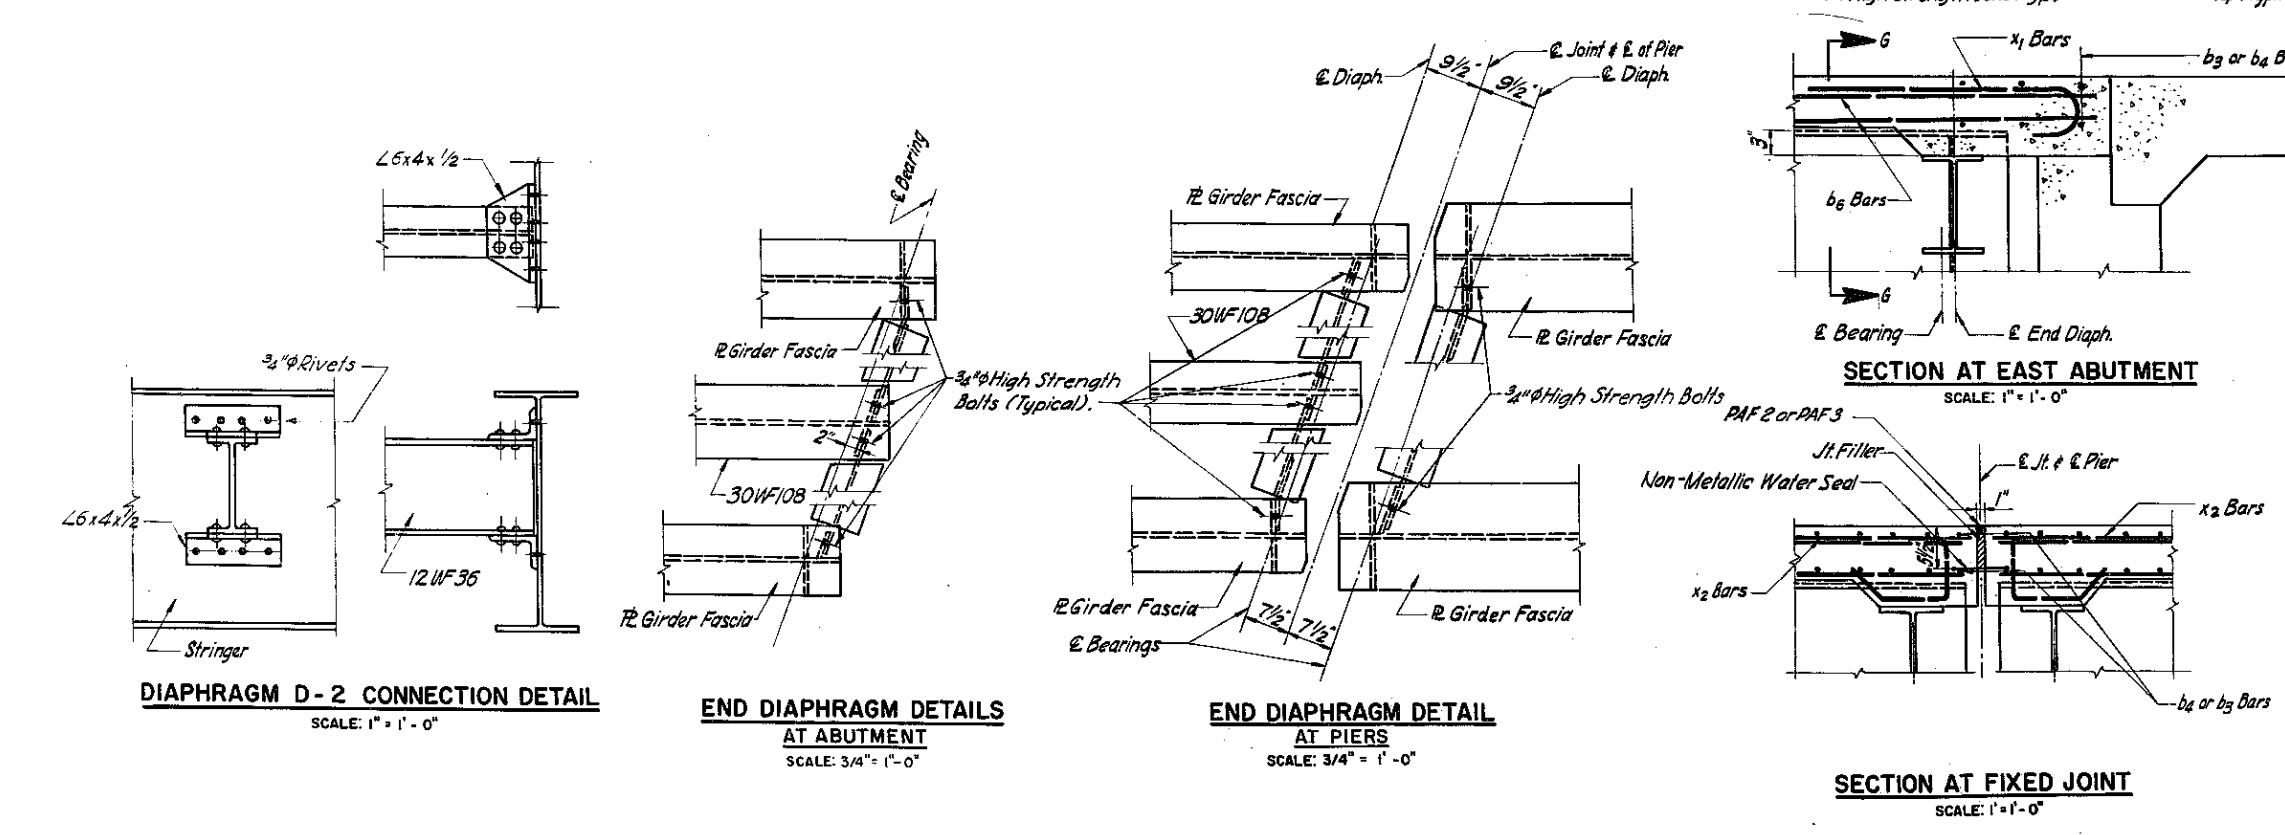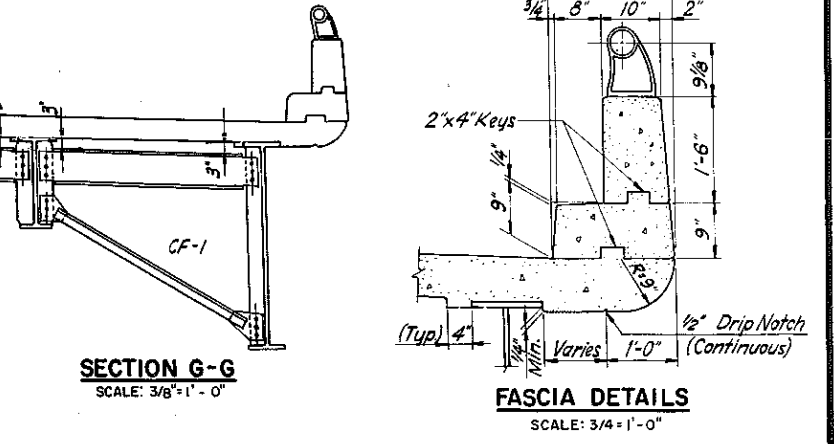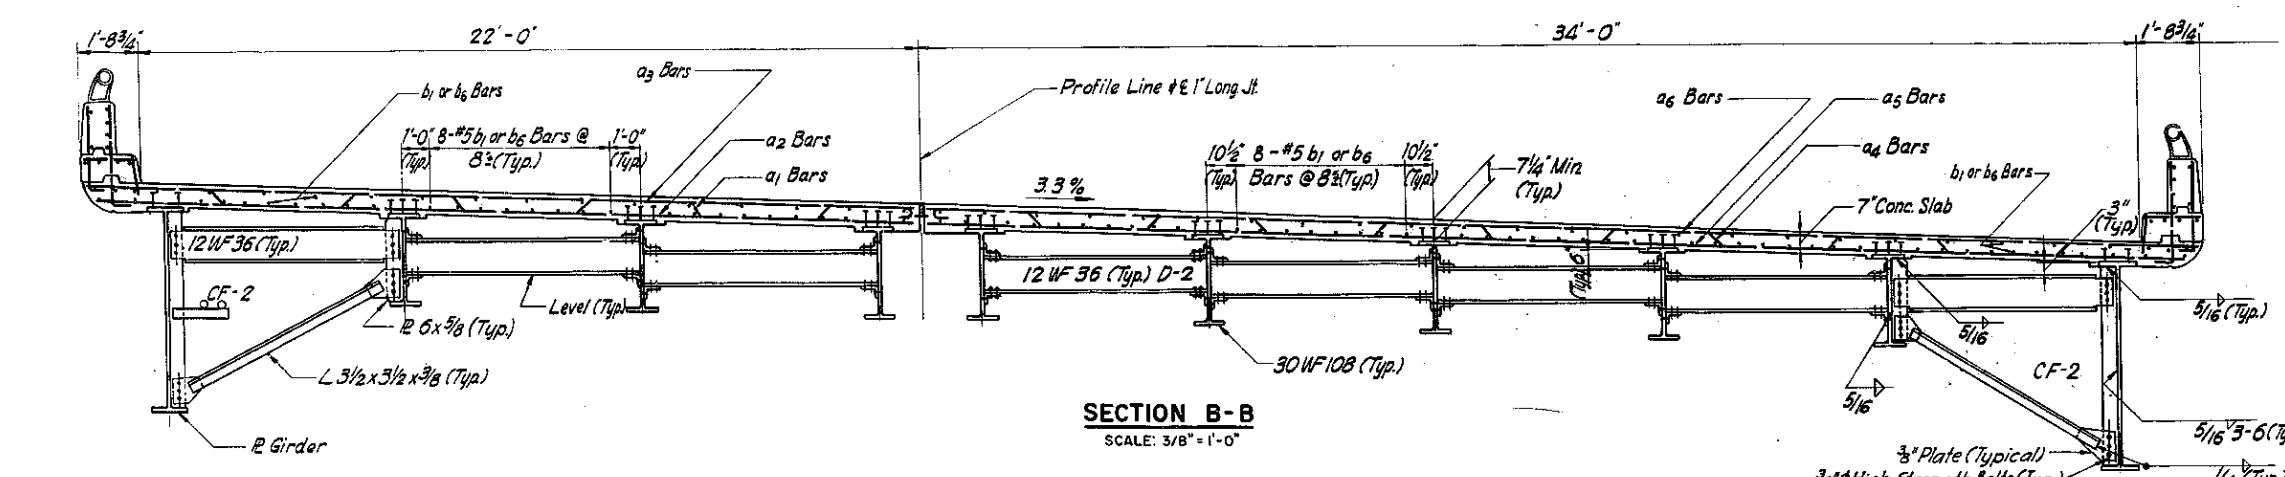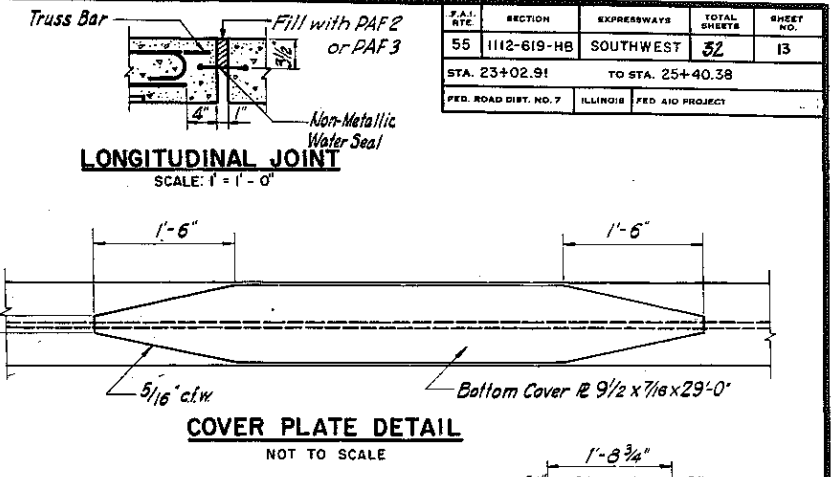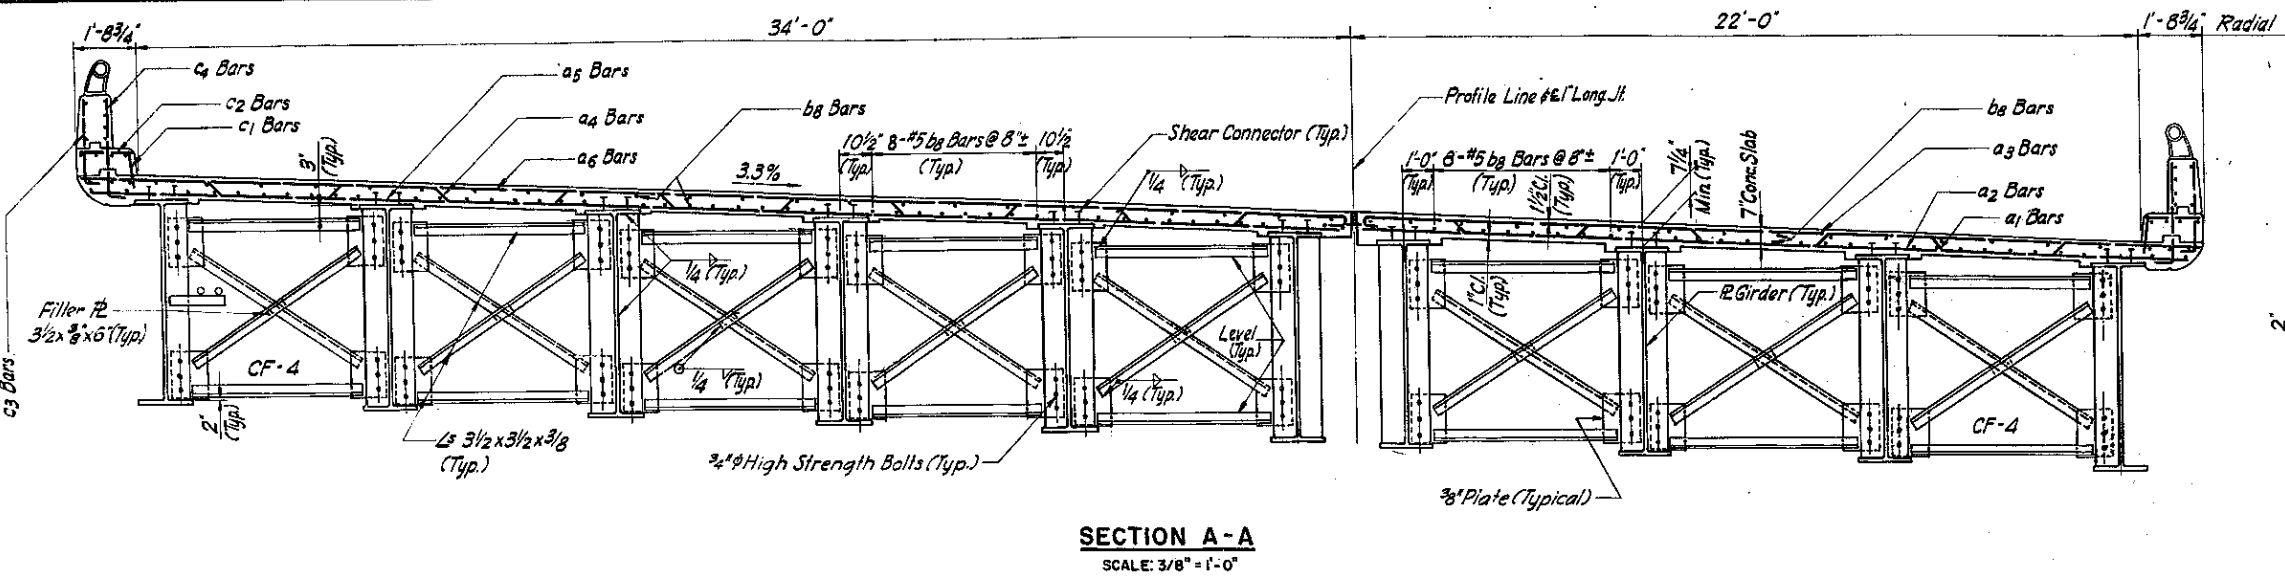

- NOTES:**
1. For location of sections A-A & B-B, see sheet 12.
 2. Section A-A shown for Bridge A, Bridge B similar except for stringer layout and spacing.
 3. Section B-B shown for Bridge B, Bridge A similar except for stringer layout and spacing.
 4. Use 3/4" rivets, except as otherwise noted.

REVISIONS	
NAME	DATE

ILLINOIS DIVISION OF HIGHWAYS
SOUTHWEST EXPRESSWAY
EXPRESSWAY OVER CICERO AVE.
SUPERSTRUCTURE DETAILS

SCALE: HORIZ. AS NOTED
VERT. AS NOTED
DATE: DEC., 1962

DRAWN BY J. White
CHECKED BY G. Harris

BRIDGE CONDITION REPORT

REGION: 1

DISTRICT: 1

ROUTE: FAI 055 / I-55 WB

COUNTY: Cook

STRUCTURE NUMBER: 016-0017

LOCATION: I-55 Westbound over Cicero Avenue



PREPARED BY:  **Stantec**

DATE PREPARED: 12/20/13

PROPOSED LETTING DATE: To Be Determined

TABLE OF CONTENTS

I. GEOGRAPHICAL & ADMINISTRATIVE DATA.....	1
II. PHYSICAL DESCRIPTION OF STRUCTURE	1
III. FIELD INSPECTION & PHYSICAL EVALUATION.....	4
IV. POTENTIAL SCOPE OF WORK DETERMINATION & ANALYSIS.....	7
V. DISCUSSION AND RECOMMENDED SCOPE OF WORK	8
VI. FINAL RECOMMENDATION.....	9
VII. TRAFFIC STAGING	10

ATTACHMENTS:

- A. Location Map
- B. IDOT Master Structure Report
- C. Bridge Inspection Report
- D. Bottom of Deck Condition Survey
- E. Condition Assessment of the Reinforced Concrete Bridge Deck
- F. Substructure Condition Surveys
- G. Opinion of Probable Costs
- H. Proposed Structure Drawings
- I. Structure Photos
- J. Proposed Plan & Profile
- K. Existing and Proposed Roadway Cross Sections
- L. Abbreviated Existing Plans

I. GEOGRAPHICAL & ADMINISTRATIVE DATA

Structure Number: 016-0017
County: Cook
Route Carried: FAI 055 / I-55
Feature Crossed: FAP 0350 / Cicero Avenue
Section: 1112-619-HB
Station: 24+20

Roadway Classification: Federal Aid Interstate
Design/Posted Speed: 70mph / 55mph
***ADT (current/design):** 80,502 (2012) / 114,556 (2040)
***ADTT (current/design):** 13% = 10,465 (2012) / 13% = 14,892 (2040)
***DHV (current/design):** 5,492 (2012) / 7,963 (2040)
Inventory Rating HS: 1.670 – rated 11/05/01
Operating Rating HS: 2.750 – rated 11/05/01
Sufficiency Rating: 80.0
HBP Eligibility: No

*Traffic data per the I-55 Managed Lane Phase I Study

Construction / Reconstruction / Repair History

The structure carrying I-55 Westbound over Illinois Route 50 (Cicero Avenue) was originally built in 1963 as FAI Route 55 over Cicero Avenue under Project I-55-7(29) 281, Section 1112-619 HB. The original construction consisted of parallel 3-span structures. The two structures carried I-55 eastbound and westbound traffic. The structure consisted of a 7” concrete slab with steel plate girders and wide flange beams supported by reinforced concrete abutments and piers.

As part of Contract 80059, bridge rehabilitation was performed in 1999 on the westbound structure. The rehabilitation consisted of removing the bituminous concrete overlay, performing deck repairs, removing and replacing the transverse deck joints, eliminating the longitudinal deck joint, placing a new deck concrete overlay, refurbishing the bearings, cleaning and painting the existing steel bridge and repairing the substructure and slopewall.

II. PHYSICAL DESCRIPTION OF STRUCTURE

The physical description of the structure is based on a review of the existing available plans dated December 1962 and 1999. Refer to Attachment J for select existing structure plan sheets. Individual components of the existing structure are described below:

Structure Type and Length: The bridge is a three span simply supported plate girder and wide flange beam structure. Span 1 and

3 consists of plate girders and wide flange beams and Span 2 consists of plate girders exclusively. The fascia beams in Spans 1 and 3 are plate girders with 66" deep webs. The interior beams in Spans 1 and 3 are W30x108 beams. Span 2 consists entirely of plate girders with 66" deep webs. Each span has 10 beams. The bridge is approximately 201'-6 3/8" long measured back-to-back of abutments along the curve. The substructure consists of two reinforced concrete stub abutments with wingwalls and two multi-column reinforced concrete piers. The abutments and the piers are supported by concrete piles. The bridge has a 7" reinforced concrete deck plus overlay.

Number / Length of Spans: There are a total of three spans, with approximate lengths as follows (dimensioned from centerline of bearing to centerline of bearing along the curve). Spans are numbered from west to east.

Span 1: 40'-2 1/16"
Span 2: 111'-10 1/8"
Span 3: 45'-5 1/2"

Skew: 21°-40'-17" Left.

Structure Width: The total width is 59'-5 1/2" measured radially out-to-out of the deck. The bridge accommodates three 12' lanes of traffic and 10' inside and outside shoulders.

Expansion Joints:
W Abutment: 2" Neoprene Joint
Pier 1: 1 3/4" Preformed Joint Seal
Pier 2: 2 9/16" Neoprene Joint
E Abutment: 1 3/4" Preformed Joint Seal

Bearings:
W Abutment:
Beam Line 1, 10 Expansion, Type 2
Beam Line 2 to 9 Expansion, Type 3 w/ bolster

Pier 1:
Beam Line 1, 10 Fixed, Type 1 and Type 2
Beam Line 2 to 9 Fixed, Type 1 and Type 3 w/
bolster

Pier 2:
Beam Line 1, 10 Expansion, Type 1 and Type 2
Beam Line 2 to 9 Expansion, Type 1 and

E Abutment: Fixed, Type 2

Beam Line 1, 10 Fixed, Type 3 w/ bolster
Beam Line 2 to 9

- Approach Roadway Template: The approach roadway template matches the bridge with three 12' lanes of traffic and 10' inside and outside shoulders.
- Existing Wearing Surface: 2 3/8" Micro Silica Concrete Overlay
- Existing Vertical Alignment: The entire structure is on a +1.50% tangent slope going from west to east.
- Existing Horizontal Alignment: The structure is on a curve at a radius of 3819.72' from Station 19+41.41 to Station 32+86.83.
- Existing Vertical Clearance: 15'-7 3/8" minimum beneath both structures over Cicero Avenue according to the 1999 repair plans. 16'-5" according to the Master Structure Report which needs to be verified.
- Existing Drainage: There are no drains on the bridge deck or approach slabs.
- Parapets and Railings: There are 1'-8 3/4" wide exterior curb and parapets running the length of the bridge. Parapets were modified in 1999 plans to remove a 9" tall by 1'-0" wide existing handrail and replaced with a 9" tall x 1'-0" wide reinforced concrete section. Per the IDOT Bridge Inspection Report dated 12/10/12, the guardrail currently meets acceptable standards while the guardrail ends and transitions do not.
- Existing Utilities Attachments: There are no light poles attached to the bridge, but there are abandoned conduits running along the both fascia beams and the West Abutment. There is a conduit running along the outside of the North Parapet. There are light fixtures and conduits on the insides of both piers and at the midspan of Beam Lines 2, 5 and 9.
- Name Plate: The name plate is located in the northeast corner of the bridge.

III. FIELD INSPECTION & PHYSICAL EVALUATION

A field inspection beneath the structure carrying I-55 Westbound over Cicero Avenue was performed by Stantec on August 21, 2013. The top of deck inspection was performed on September 16, 2013. The high temperature on that date was 65° F. The visual field inspection was performed on foot on the sloped wall, sidewalk and the top of deck. The following conditions were observed:

Deck

Deck

The deck was rated in satisfactory condition (NBIS Rating = 6) in the 12/10/12 NBIS inspection. The deck condition observed during this inspection was consistent with the NBIS rating. The underside of deck has multiple areas of delamination, spalling and map cracking. Based on visual inspection, approximately 3.2% of the underside of deck is delaminated or spalled.

The micro-silica concrete overlay on the top of deck has minor hairline transverse and longitudinal cracking mostly along the shoulders. Wiss, Janey and Elstner performed a condition assessment of the reinforced bridge deck in January 2012. This assessment included a delamination survey performed on the top of the bridge deck using infrared thermography. The infrared thermography indicated 3.9% of the top of deck area was delaminated. See Attachment E for the condition assessment of the reinforced bridge deck. See Attachment I – Photos 1 through 7.

Parapets

The parapets are in satisfactory condition with hairline vertical cracking throughout and minor delaminations and spalls on both the interior and exterior faces of the parapet. The interior faces of both parapets have approximately 10 square feet of delaminated concrete each. The exterior face of the South Parapet has longitudinal hairline cracking with rust staining along most of the length of the parapet.

Joints

The preformed joint seals at the East Abutment and Pier 1 and the neoprene joints at West Abutment and Pier 2 are in satisfactory to fair condition with debris in the joint and minor impact damage. The joint at Pier 2 is missing an approximately 6' long piece of neoprene in the center lane. The width of the joints was measured when the temperature was approximately 65° F. The preformed joint at the East Abutment measured 7/8" wide. The preformed joint at the Pier 1 measured 7/8". The neoprene joint at the Pier 2 measured 2 1/8". The neoprene joint at the West Abutment measured 1 7/16". See Attachment I – Photos 8 through 11.

Superstructure

Beams

The superstructure consists of three simple spans of rolled steel beams and welded plate girders. The beam lines are numbered 1 through 10, numbered from north to south. In Spans 1 and 3, Beam Lines 1 and 10 consist of plate girders with 66" deep webs and Beam Lines 2 through 9 consist of W30x108 beams. In Span 2, all of the beam lines consist of plate girders with 66" deep webs. This structure has welded cover plates on the bottom flanges of the beams in Span 3.

The superstructure was rated in fair condition (NBIS Rating = 5) in the 12/10/2012 NBIS bridge inspection due to initial section loss and minor pitting. The superstructure observed during this inspection was consistent with the NBIS rating.

The steel superstructure typically has paint starting to fail, minor rust and initial section loss and minor pitting. In both Spans 1 and 3, the steel bolsters have been welded to the W30x108 beams. These welds have mostly cracked. Bolts connect the top of the bolster to the bottom flange as part of a retrofit done in 1999. In Span 3, the steel beams have welded cover plates with fatigue category E' details. The welded cover plates were visually inspected from the ground and no defects were noted on the welds. At Beam Line 9, the bolster under the W30 at Pier 1 appears to have a crack at the weld connecting the bolster top plate and the angled side plate. See Attachment I – Photos 12 through 18.

Bearings

The bearings are in satisfactory condition with paint starting to fail and minor rust. No excessive tilting was noted during the inspection. See Attachment I – Photo 21.

Utilities

The conduits along the South Fascia Beam and South Abutment are in poor condition with heavy deterioration and open conduit covers. See Attachment I – Photos 19, 20, 24, 25 and 27.

Substructure

The substructure was rated in satisfactory condition (NBIS Rating = 6) in the 12/10/2012 NBIS bridge inspection due to cracks and spalls at the abutment caps and pier columns. The substructure condition observed during this inspection was not consistent with the NBIS rating due to the condition of the piers.

Abutments

The reinforced concrete abutments are in satisfactory condition with multiple hairline vertical cracks and small areas of delaminated/spalled concrete. There is 9 square feet of spalled/delaminated concrete on the West Abutment. There is 1 square foot of spalled concrete on the East Abutment. At both abutments, a minor amount of fill appears to be leaking thru the joint in the backwall. No significant defects were found on the wingwalls. See Attachment F for the Substructure Condition Survey. See Attachment I – Photo 22, 23, 26, 28 through 31.

Piers

The reinforced concrete piers each consist of four columns with a pier cap. The piers are in fair condition with moderate to heavy delaminations and spalls on the columns and pier caps. Pier 1 has approximately 184 square feet of spalled or delaminated concrete. Pier 2 has approximately 150 square feet of spalled or delaminated concrete. See Attachment F for the Substructure Condition Surveys. See Attachment I – Photo 32 through 37.

Slope Protection

The bridge has concrete slope walls. Both slopewalls are in satisfactory condition with minor hairline cracking throughout. The West Slopewall has a 6 square foot spall with exposed reinforcement. See Attachment I – Photo 38 through 40.

Inspection History (NBIS Ratings)

Year	Deck	Super	Sub
2012	6	5	6
2011	6	7	6
2009	6	7	6

Geometric, Horizontal & Vertical Clearance / Hydraulic Data

Geometry

I-55 over Cicero Avenue is on a skew. According to the original plans of December 1962 and the repair plans of 1999, the skew at the intersection of the centerlines of I-55 and Cicero Avenue is 21°-40'-17" Left. The typical roadway section for I-55 consists of three 12' lanes, a 10' inside shoulder, a 10' outside shoulder, a 1'-8 3/4" wide curb and parapet on each side of the structure. The I-55 profile grade is on a tangent at +1.50% going from west to east. The structure is on a horizontal curve at a radius of 3819.72' from Station 19+41.41 to Station 32+86.83. The repair plans from 1999 show the vertical minimum clearance at 15'-7 3/8" beneath both structures. However, the Master Structure Report shows the minimum vertical clearance at 16'-5" under the "Key Route under Data" which needs to be verified.

The typical roadway section for Cicero Avenue beneath the structure consists of three lanes in each direction, one turning lane in the northbound direction, and a median. Cicero Avenue is listed as a principal arterial route. Cicero Avenue is located on a 200-ft. long vertical crest curve with 0.36% and -0.30% slopes going from north to south.

As part of the I-55 Managed Lane Phase I Study, I-55 Westbound at Cicero Avenue will be widened to the inside to accommodate a proposed 12' managed lane. In the westbound direction, a 4' buffer between the managed lane with 12.5' shoulder and the general purpose traffic lanes is proposed in this existing 60 foot median section. This widening will be incorporated into the recommended scope of work for this structure.

Hydraulics

At the structure, the I-55 profile is on a +1.50% tangent going from west to east. The bridge deck cross-section is superelevated 3.3%. There are no deck drains on the bridge deck. Therefore, the water is allowed to flow to the deck joints as it runs off the bridge.

IV. POTENTIAL SCOPE OF WORK DETERMINATION & ANALYSIS

As part of the I-55 Managed Lane Phase I Study, In-Kind Repairs, Structure Widening and Structure Replacement alternatives will be evaluated.

Per Section 2.4.2.4 of the IDOT Bridge Manual, consideration was given to retrofit all end of cover plate locations due to average daily truck traffic. From this information, it was determined that a fatigue evaluation was required. The transverse welds at the ends of the cover plates in Span 3 were evaluated for fatigue life and it was determined that the mean service life is less than 50 years. A cover plate retrofit should be installed.

1. In-Kind Repairs

Perform partial and full depth repairs and apply Protective Coat to the existing deck. Repair areas of spalled or delaminated concrete on the existing substructure units. Perform retrofit repairs on the existing Span 3 cover plates.

2. Structure Widening

Remove and replace the deck and approach slabs and widen both approximately 18' to the north. Remove both the southeast and southwest wingwalls and build an extension onto the south side of both abutments. Build an extension onto the south side of both piers. Install three new beam lines using W30 steel beams and plate girders that will be composite to the widened bridge deck. The new W30

beam will be larger than the existing W30 to account for the bottom flange cover plate. Perform retrofit repairs on the existing Span 3 cover plates. Repair areas of spalled or delaminated concrete on the existing substructure units.

3. Superstructure and Partial Substructure Replacement

Remove and replace the existing W30 steel beam and steel plate girder superstructure with a continuous three-span galvanized steel plate girder superstructure. Remove and replace pier caps and columns, but reuse the existing pier crash walls and footings. Build an extension onto the south side of both piers. Replace the existing abutments with integral abutments placed behind the existing abutments. Replace concrete slope walls. The deck geometry will accommodate the proposed roadway geometry from the I-55 Managed Lane Phase I Study.

4. Structure Replacement

Remove and replace the entire structure with a continuous three-span galvanized steel plate girder superstructure on integral abutments. The deck geometry will accommodate the proposed roadway geometry from the I-55 Managed Lane Phase I Study.

V. DISCUSSION AND RECOMMENDED SCOPE OF WORK

The opinion of probable costs for each of the alternatives is summarized below. See Attachment G for the opinion of probable costs breakdown.

- 1. In-Kind Repairs – \$177,100**
- 2. Structure Widening – \$2,516,700**
- 3. Superstructure and Partial Substructure Replacement – \$5,421,000**
- 4. Structure Replacement – \$6,014,900**

Per the I-55 Managed Lane Phase I Study, the managed lane is expected to be implemented in 2020. All widening and replacement alternatives below assume widening approximately 18' to the centerline of I-55 to accommodate the new managed lane. The proposed structure will provide a 9'-6" outside shoulder, three 12'-0" general purpose traffic lanes, a 4' buffer between the general purpose traffic lanes and the 12'-0" managed traffic lane and a 12'-6" inside shoulder.

Analysis of Alternative 1 – The calculated percent of deck area requiring full depth repairs is 3.2% and the partial depth repairs is 7.8%. The total deck repair percentage is within the 25% limit presented in the Bridge Condition Report Procedures and Practices Manual for bridge deck repair to be cost effective for a deck not being widened. This alternative can be used to extend the life span of the existing superstructure in the interim prior to implementing the changes required for the Managed Lane project.

Analysis of Alternative 2 – The calculated percent of deck area requiring full depth repairs is 3.2% and partial depth repairs is 7.8%. Since this deck is 50 years old and has recommended repair area approaching the upper limit (15%) presented in the BCR Procedures and Practices Manual for a widened deck, it is recommended to replace the deck at the time of widening. Cover plate retrofits will be necessary. Deck joints will remain with this alternative, which will lead to continued degradation of the beams and substructure units. This alternative keeps the existing pier caps in service, which have already been repaired as a result of extensive degradation in 1999.

Analysis of Alternative 3 – This alternative replaces the existing W30 steel beam and steel plate girder superstructure with a continuous three-span galvanized steel plate girder superstructure on integral abutments. The proposed integral abutments will be placed behind the existing abutment to help avoid the existing piles. The resulting assumed span arrangement is approximately 70'/114'/70' measured between the centerline of bearings. Uplift at the abutments must be considered in the design phase given the relatively short exterior spans in the continuous structure. Reusing the existing pier crash walls and footings will simplify construction since it will minimize construction impact to Cicero Avenue.

Using galvanized steel eliminates the need to periodically repaint the beam. Providing a continuous structure will also allow for a reduced girder depth over Cicero Avenue, thereby increasing vertical clearance. The longer exterior spans provide an opportunity to relocate the sidewalks, or a multi-use path, along Cicero Avenue behind the piers. Providing new pier caps, pier columns and integral abutments places the critical portions of the substructure on the same life cycle as the superstructure. Eliminating the deck joints will also help to prevent premature degradation of these substructure elements.

Analysis of Alternative 4 – This alternative eliminates the 50-year old structure and replaces it with a new structure with an expected 75-year service life.

The benefits of this alternative are similar to Alternative 3, with the addition of removing and replacing the pier crash walls and pier footings. However, this alternative adds construction complications of reconstructing the piers on or near the same footprint as the existing pier footings, and increases construction impacts to Cicero Avenue. The cost is also greater than Alternative 3 due to the removal and reconstruction of the additional pier elements.

VI. FINAL RECOMMENDATION

Stantec recommends Alternative 3 – Superstructure and Partial Substructure Replacement when the I-55 Managed Lane Project occurs. The selected alternative provides a new superstructure and replaces the critical portions of the substructure. Eliminating the deck joints will help to prevent premature degradation of the replaced substructure elements. As the I-55 Managed Lane Phase I Study is ongoing, the bridge widening to be presented in the TSL should match the final geometry as


presented in the final I-55 Managed Lane Phase I Study. Future improvements to Cicero Avenue, to be determined at a later date, should also be addressed in the TSL.

VII. TRAFFIC STAGING

For Alternatives 2, 3 and 4, the existing deck is wide enough to provide two lanes of traffic in the westbound direction during stage construction. For Alternative 1, the lanes can be temporarily closed as needed to allow for the deck repairs. The traffic staging design will need to be confirmed by IDOT traffic prior to being implemented.

ATTACHMENT A

Location Map

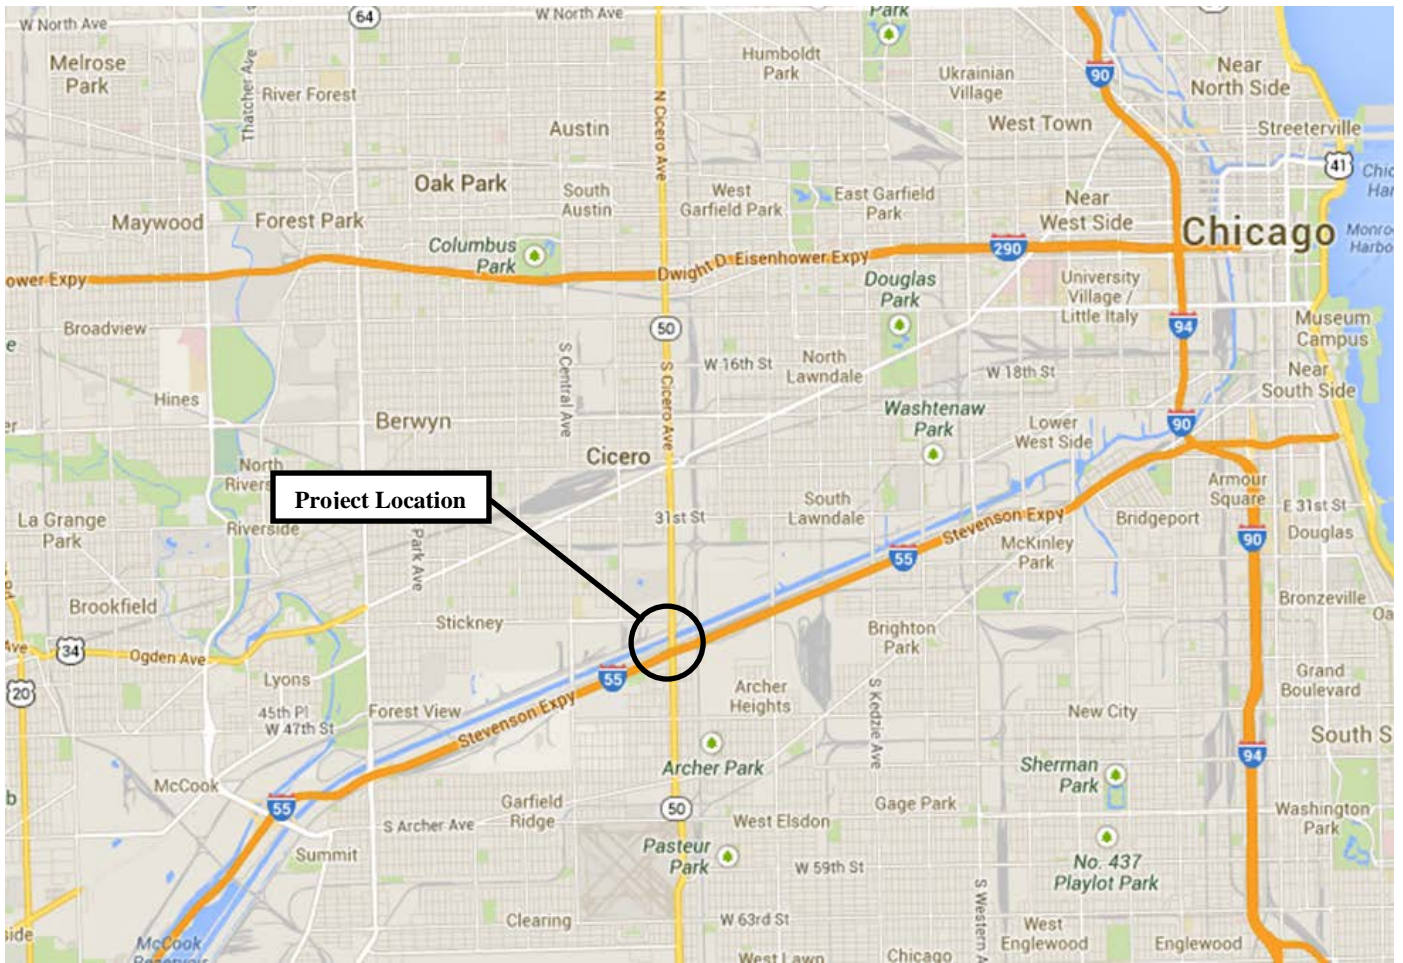

Location Map

Proposed Improvement:

I-55 over Cicero Avenue (Westbound)



Municipality: Stickney

County: Cook

Route: FAI 055

Project No: P-91-762-10

Structure No.: 016-0017

ATTACHMENT B

IDOT Master Structure Report

**Illinois Department of Transportation
Structures Information Management System
Structure Summary Report**

Date: 10/08/2013
Page: 1

Structure Number: 016-0017

District: 1

Inventory Data

Facility Carried:	I-55 WB STEVENSON	Bridge Name:		Sufficiency Rating:	80.0	Structure Length:	202.7
Feature Crossed:	IL 50 (CICERO AVE)	Location:	5.7 M SW I94	HBP Eligible:	No	AAASHTO Bridge Length:	99.9
Bridge Remarks:		Status Date:	12/2000	Replaced By:	-	Length of Long Span:	113.3
Bridge Status:	1 OPEN - NO RESTRICT	Maint Township:	62 LAKE (CHICAGO)	Replaces:	-	Bridge Roadway Width:	56.0
Status Remarks:				Last Update Date:	03/12/2013	Appr Roadway Width:	60.0
Maint County:	016 COOK			Parallel Structure:	Left	Deck Width:	59.4
Maint Responsibility:	01 I.D.O.T.			Multi-Level Structure Nbr:		Sidewalk Width Right:	0.0
Service On/Under:	5 SECOND LEVEL INTERCHANGE	1 / HIGHWAY		Skew Direction:	L	Sidewalk Width Left:	0.0
Reporting Agency:	1 I.D.O.T. - BUREAU OF MAINTENANCE			Skew Angle:	22 D 0 M 0 S	Navigation Control:	N
Main Span Matl/Type:	3 STEEL	/ 02 STRINGER/MULTI-BEAM/GIRDER		Structure Flared:	No	Navigation Horiz Clear:	0
Nbr Of Main Spans:	3	Nbr Of Approach Spans:	0	Historical Significance:	No	Navigation Vert Clear:	0.0
Approaches				Border Bridge State:		Culvert Fill Depth:	0.0
Near #1 Matl/Type:	/			Bdr State SN:		Number Culvert Cells:	0
Near #2 Matl/Type:	/			Bdr State % Responsibility:		Culvert Opening Area:	0.0
Far #1 Matl/Type:	/			Structural Steel Wt	996000	Culvert Cell Height:	0.00
Far #2 Matl/Type:	/			Substructure Material:		Culvert Cell Width:	0.00
Median Width/Type:	0 Ft. / 0	None		Rated By:	2 IDOT	Rate Method:	1 LOAD FACTOR
Guardrail Type L/R:	0None	/ 0		Load Rating Date:	11/05/2001	Railroad Crossing Info	
Toll Facility Indicator:	0 No Toll			Design Load:	01 HS20+MOD	Crossing 1 Nbr:	
Latitude:	41 D 49 M 1.4 S	Longitude:	87 D 44 M 37.16 S	Inventory Rating:	1.670(60)	Crossing 1 Nbr:	
Deck Structure Type:	A CIP CON NRMALLY FORM			Operating Rating:	2.750(99)	RR Lateral Underclear:	0.0
Sidewalks Under Structure:	2 Both Sides Not Separate			Deck Structure Thickness:	7 SD: N FO: N	RR Vertical Underclear:	0 Ft 0 In

Key Route On Data

Key Route Nbr:	FEDERAL-AID INTERSTATE	Station:	0055	Segment:	10.2600
Appurtenances	Main Route			Linked:	Y
Inventory County:	016 COOK	Natl. Hwy System:	On NHS	Inventory Direction:	
Township/Road Dist	34 STICKNEY	Curr AADT Yr/Count:	2012 / 61150	Est Truck Percentage:	13
Municipality	5540 STICKNEY	Number Of Lanes:	3	One Or Two Way:	1 One-Way
Urban Area:	1051	Bypass Length:	0	Future AADT Yr/Cnt:	2032 / 75808
Functional Class:	1 INTERSTATE	Designated Truck Rte:	CLASS I	Special Systems:	Yes
CLEARANCES	South/East	North/West			
Max Rdwy Width:	56.0	0.0			
Horizontal:	57.5	0.0			

Key Route Under Data

FEDERAL-AID PRIMARY	Station:	0350	Segment:	18.6900
Main Route			Linked:	Y
016	Natl. Hwy System:	On NHS	Inventory Direction:	
62 LAKE (CHICAGO)	Curr AADT Yr/Count:	2011 / 40800	Est Truck Percentage:	11
1051 CHICAGO	Number Of Lanes:	7	One Or Two Way:	2 Two-Way
1051 1051	Bypass Length:	0	Future AADT Yr/Cnt:	2032 / 42024
3 OTHER PRINCIPAL ARTERIAL	Designated Truck Rte:	CLASS II	Special Systems:	Yes
South/East	North/West			
101.6				
101.6				

***** Marked Route On Data *****

Route #1:	1 Mainline	Designation		Kind		Number	
Route #2:	1 Mainline		1 Interstate Highway			055	
Route #3:	1 Mainline						

***** Marked Route Under Data *****

Route #1:	1 Mainline	Designation		Kind		Number	
Route #2:	1 Mainline		3 State Highway			050	
Route #3:	1 Mainline						

**Illinois Department of Transportation
Structures Information Management System
Structure Summary Report**

Date: 10/08/2013

Page: 2

Structure Number: 016-0017 District: 1

Data Related to Inspection Information

*** Inspection Intervals *** *** Maximum Allowable Posting Limits ***

Routine NBIS: 24 MOS Underwater: 0 MOS One Truck At A Time: 0 Combination Type 3S-1: Tons Bridge Posting Level: 5 No Posting Required
 Special: N Single Unit Vehicles: Tons Combination Type 3S-2: Tons

Inspection/Appraisal Information

Inspection Date: 12/10/2012 Inspection Temperature: 35Deg. F ** Actual Posted Limits **
 Deck: 6 SATISFACTORY CONDITION - MINOR DETERIORATION Single Unit Vehicles: Tons
 Superstructure: 5 FAIR CONDITION - MINOR SECTION LOSS, CRACKS Combination Type 3S-1: Tons
 Substructure: 6 SATISFACTORY CONDITION - MINOR DETERIORATION Combination Type 3S-2: Tons
 Culvert: N NOT APPLICABLE One Truck At A Time: 0
 Channel and Protection: N NOT APPLICABLE Deck Wearing Surf: F MICRO SIL CON OVRLY Last Paint Type: U
 Structural Evaluation: 5 BETTER THAN ADEQUATE TO BE LEFT IN PLACE Deck Membrane: F NONE FLD AL EPY & ACRLC
 Deck Geometry: 6 EQUAL TO PRESENT MINIMUM CRITERIA Deck Protection: J NONE
 Underclearance-Vert/Lat.: 4 MINIMUM ADEQUACY TO BE LEFT IN PLACE Total Deck Thick: 8.9
 Waterway Adequacy: N NOT APPLICABLE Last Paint Date: 10/2000
 Approach Roadway Align: 8 EQUAL TO PRESENT DESIRABLE CRITERIA
 Bridge Railing Appraisal: 3 Meets Standards
 Approach Guardrail: 233 Not Acceptable Acceptable
 Pier Navig Protection: N N/A

Underwater Inspection/Appraisal Information

Inspection Date: Inspection Category:
 Temperature: Inspection Method: Appraisal Rating:

Scour Critical Information

Evaluation Method:

Miscellaneous

Rating: Microfilm Data Recorded: Yes
 Analysis Date:

Construction Information

Year: 1963 Original Reconstructed
 Route: FAI-55 Sta: 24+20 Sta:
 Section Nbr: 1112-619-HB
 Contract Nbr:
 Fed Aid Prf#: I 0557029281
 Built By: 1 I.D.O.T.

Waterway Information

Flood Design Frequency:
 Flood Design Q (CFS):
 Flood Design Nat H W E:
 Flood Des Open Prop:

YRS Drainage Area:
 Flood Base Q (CFS):
 Flood Base Nat H W E:

ATTACHMENT C

Bridge Inspection Report



SN: 016-0017	District: 1	Spans: 3	Appr. Spans: 0	Skew: 22.00	ADT: 61150	Truck Pct: 13
ADT Un: 40800	Maint. Co: COOK	Twsp: LAKE (CHICAGO)		Status: OPEN - NO RESTRICT		
Facility Carried: I- 55 WB STEVENSON			Feature Crossed: IL 50 (CICERO AVE)			
Location: 5.7 M SW I94		Municipality: STICKNEY		Team/Sub Section: E26019		
Bridge Name:			Material & Type: STEEL/STRINGER/MULTI-BEAM/GIRDER			
Insp. Intervals (Mo) Routine NBIS: 24		Fracture Critical: 0		Underwater: 0	Special Feature: N/A	
90 - Inspection Date: / /		90C - Temp. (°F):		90A - Program Manager:		
Is Delinquent: <input type="checkbox"/>		Reason:				
90A1 - Team Leader:			90A2 - Inspector:			

90B - Inspection Remarks:

Previous Inspection	2008) DK SOFFIT MAP CRKD & SPALLED W/CHLR CONTAM. JOINTS LEAKING. STL BMS-SPANN 2 MINOR RUST @ BOTT FLANGES & LAT BRCNG. PIER 1&2 WALLS SM SPALLS. PIER 2 SOUTH END CANTILEVER MAP CRKD. PIER 2 COL 1 MAP CRKD. Item 59 lowered to "5" due t
------------------------	--

Resources

Time to Inspect (H:M): 1:0	Traffic Control: 3	Boat:	Waders:	Snooper:
Ladder: LL	Manlift:	Bucket Truck:	Other:	

Inspector's Appraisals

	Prev	New	Comments
58 - Deck Condition:	6		
59 - Superstructure Cond:	5		
60 - Substructure Cond:	6		
62 - Culvert Condition:	N		
61 - Channel Condition:	N		
71 - Waterway Adequacy:	N		
72 - Approach Rdw Align:	8		
111 - Pier Navig Protection:	N		

90B - Inspector Remarks:

Routine Inspection Report

Structure Number: 0160017

Additional Inspection Data

36A – Bridge Railing Adequacy:	Prev	New	3		Rail Types:														
Approach Guardrail Adequacy:					36B – Transitions:	Prev	New	2		36C – Guardrail:	Prev	New	3		36D – Ends:	Prev	New	3	

108A – Wearing Surface Type:	Prev	New	F		If "L-Other" Describe:				
108B – Type of Membrane:			F		If "E-Other" Describe:				
108C – Deck Protection:			J		If "I-Other" Describe:				
108D – Total Deck Thickness (in):			8.9						

59A – Paint Date (Mo/Yr):	Prev	New	10/2000	/					
59B – Paint Type:			U		Color: Fascia - ____: Inter. - ____: Railing - ____.				
59C – Utilities Attached:					If "B-Other" Describe: _____				

Weight Limit Posting:	Prev		New		
	70A2 – Single Unit Vehicles:				Tons
	70B2 – Combination Type 3S-1 (3 or 4 axles):				Tons
	70C2 – Combination Type 3S-2 (5 or more axles):				Tons
70D2 – One Truck at a Time:			0		

Joint Openings (In.) _____

90B – Inspector Remarks Continued:

	Signature	Date
Inspection Team Leader:		/ /
Inspection Program Manager:		/ /

Pontis

Today's Date: 04/19/2013

Structure Number: 016-0017 District: 1 (41) Bridge Status: 1 OPEN - NO RESTRICT
 (6) Feature Crossed: IL 50 (CICERO AVE) (7) Facility Carried: I- 55 WB STEVENSON
 (9) Location: 5.7 M SW 194 (7A) Bridge Name:
 Element Inspection Date: 12/10/2012 Inspectors: SEDLACEKJL

Element Description												
Elem	Env	% 1	Qty 1	% 2	Qty 2	% 3	Qty 3	% 4	Qty 4	% 5	Qty 5	Tot Qty
Concrete Deck Protected w/ Rigid Overlay												
22	4	11	1,326	45	5,422	44	5,300	0	0	0	0	12,048
			No deficiencies.	Repaired areas exist	Map cracked areas.	Spalls/delaminations	Full depth failures.					
Remarks: (WS) HL map crking; Soffit) Isol spalls, HPs, HL-Nar leach crks & chlor contam												
Lead Painted Steel Open Girder												
107	4	100	28,224	0	0	0	0	0	0	0	0	28,224
			No corrosion	Paint distress	Rust formation	Section loss	Section failure					
Remarks: Stl Bms-Span 2 minor rust @ Bott flanges & Lat brng.												
Non-Lead Painted Steel Closed Web/Box Girder and O												
173	4	100	60	0	0	0	0	0	0	0	0	60
			No corrosion	Paint distress	Rust formation	Section loss	Section failure					
Remarks:												
Reinforced Conc Column or Pile Extension												
205	4	100	1,068	0	0	0	0	0	0	0	0	1,068
			No deterioration	Minor cracks/spalls	Delams/spalls	Analysis warranted						
Remarks: Pier 2 Col #1 FCR map crkd												
Reinforced Conc Pier Wall												
210	4	100	942	0	0	0	0	0	0	0	0	942
			No deterioration	Minor cracks/spalls	Delams/spalls	Analysis warranted						
Remarks: Pier 1 & 2- small spalls												
Reinforced Conc Abutment												
215	4	100	1,912	0	0	0	0	0	0	0	0	1,912
			No deterioration	Minor cracks/spalls	Delams/spalls	Analysis warranted						
Remarks: HL vert crks in backwall; East Abut- few hl vert crks; West Abut Bkwall -vert crks												
Reinforced Conc Pier or Abutment Cap												
234	4	98	249	2	4	0	0	0	0	0	0	253
			No deterioration	Minor cracks/spalls	Delams/spalls	Analysis warranted						
Remarks: (Abut) Crking @ steps; Pier) Crking in cantilever seat (Pier 2 South Nose)												
Preformed Joint Seal												
302	4	90	56	10	6	0	0	0	0	0	0	62
			No deterioration	Minor deterioration	Major deterioration							
Remarks: Leaking @ East Abut & Pier 1												
Neoprene Expansion Joint												
307	4	89	166	11	20	0	0	0	0	0	0	186
			The element shows mi	The seal maybe punct	The seal maybe heavi	Major deterioration						
Remarks: Leaking @ West Abut & Pier 2; Pier 2 Jnt torn @ Lane 1&2 (12ft). West Abut Jnt torn @ Lane 3 (8ft)												

Movable Discontinuous Brg.												
311	4	100	30	0	0	0	0	0	0	0	0	30
		No deterioration	Minor deterioration	Advanced corrosion								

Remarks:

Fixed Bearing												
313	4	100	30	0	0	0	0	0	0	0	0	30
		No deterioration	Minor deterioration	Advanced corrosion								

Remarks:

Approach Pavement												
323	4	100	2	0	0	0	0	0	0	0	0	2
		No deterioration	Cracks/spalls	Major cracks/spalls		Broken/Unstable						

Remarks:

Concrete Bridge Railing												
331	4	99	402	1	4	0	0	0	0	0	0	406
		No deterioration	Minor cracks/spalls	Analysis warranted								

Remarks:

Steel Open Girder												
406	4	100	6	0	0	0	0	0	0	0	0	6
		Minor fatigue, out-o	Moderate fatigue, ou	Severe fatigue, out-								

Remarks:

Element Description												
Elem	Env	% 1	Qty 1	% 2	Qty 2	% 3	Qty 3	% 4	Qty 4	% 5	Qty 5	Tot Qty
Concrete Deck Protected w/ Rigid Overlay												
22	4	11	1,326	45	5,422	44	5,300	0	0	0	0	12,048
		No deficiencies.	Repaired areas exist	Map cracked areas.		Spalls/delaminations		Full depth failures.				

Remarks:

Lead Painted Steel Open Girder												
107	4	100	28,224	0	0	0	0	0	0	0	0	28,224
		No corrosion	Paint distress	Rust formation		Section loss		Section failure				

Remarks:

Non-Lead Painted Steel Closed Web/Box Girder and O												
173	4	100	60	0	0	0	0	0	0	0	0	60
		No corrosion	Paint distress	Rust formation		Section loss		Section failure				

Remarks:

Reinforced Conc Column or Pile Extension												
205	4	100	1,068	0	0	0	0	0	0	0	0	1,068
		No deterioration	Minor cracks/spalls	Delams/spalls		Analysis warranted						

Remarks:

Reinforced Conc Pier Wall												
210	4	100	942	0	0	0	0	0	0	0	0	942
		No deterioration	Minor cracks/spalls	Delams/spalls		Analysis warranted						

Remarks:

Reinforced Conc Abutment

215	4	100	1,912	0	0	0	0	0	0	0	0	1,912
		No deterioration	Minor cracks/spalls	Delams/spalls	Analysis warranted							

Remarks: HL vert crks in backwall; East Abut- few hl vert crks; West Abut Bkwall -vert crks

Reinforced Conc Pier or Abutment Cap

234	4	98	249	2	4	0	0	0	0	0	0	253
		No deterioration	Minor cracks/spalls	Delams/spalls	Analysis warranted							

Remarks: Abut) Crking @ steps; Pier) Crking in cantilever seat (Pier 2 South Nose)

Preformed Joint Seal

302	4	90	56	10	6	0	0	0	0	0	0	62
		No deterioration	Minor deterioration	Major deterioration								

Remarks: Leaking @ East Abut & Pier 1

Neoprene Expansion Joint

307	4	89	166	11	20	0	0	0	0	0	0	186
		The element shows mi	The seal maybe punct	The seal maybe heavi	Major deterioration							

Remarks: Leaking @ West Abut & Pier 2; Pier 2 Jnt torn @ Lane 1&2 (12ft). West Abut Jnt torn @ Lane 3 (8ft)

Movable Discontinuous Brg.

311	4	100	30	0	0	0	0	0	0	0	0	30
		No deterioration	Minor deterioration	Advanced corrosion								

Remarks:

Fixed Bearing

313	4	100	30	0	0	0	0	0	0	0	0	30
		No deterioration	Minor deterioration	Advanced corrosion								

Remarks:

Approach Pavement

323	4	100	2	0	0	0	0	0	0	0	0	2
		No deterioration	Cracks/spalls	Major cracks/spalls	Broken/Unstable							

Remarks:

Concrete Bridge Railing

331	4	99	402	1	4	0	0	0	0	0	0	406
		No deterioration	Minor cracks/spalls	Analysis warranted								

Remarks: HL vert crks; Few small spalls in water table

Element Description

Elem	Env	% 1	Qty 1	% 2	Qty 2	% 3	Qty 3	% 4	Qty 4	% 5	Qty 5	Tot Qty
------	-----	-----	-------	-----	-------	-----	-------	-----	-------	-----	-------	---------

Concrete Deck Protected w/ Rigid Overlay

22	4	11	1,326	45	5,422	44	5,300	0	0	0	0	12,048
		No deficiencies.	Repaired areas exist	Map cracked areas.	Spalls/delaminations	Full depth failures.						

Remarks: WS)HL map crking; Soffit) Isol spalls, HPs, HL-Nar leach crks & chlor contam

Lead Painted Steel Open Girder

107	4	100	28,224	0	0	0	0	0	0	0	0	28,224
		No corrosion	Paint distress	Rust formation	Section loss	Section failure						

Remarks: Stl Bms-Span 2 minor rust @Bott flanges & Lat brng.

Non-Lead Painted Steel Closed Web/Box Girder and O

173	4	100	60	0	0	0	0	0	0	0	0	60
		No corrosion	Paint distress	Rust formation	Section loss	Section failure						

Remarks:

Reinforced Conc Column or Pile Extension

205	4	100	1,068	0	0	0	0	0	0	0	0	1,068
		No deterioration	Minor cracks/spalls	Delams/spalls	Analysis warranted							

Remarks:

Reinforced Conc Pier Wall

210	4	100	942	0	0	0	0	0	0	0	0	942
		No deterioration	Minor cracks/spalls	Delams/spalls	Analysis warranted							

Remarks:

Reinforced Conc Abutment

215	4	100	1,912	0	0	0	0	0	0	0	0	1,912
		No deterioration	Minor cracks/spalls	Delams/spalls	Analysis warranted							

Remarks:

Reinforced Conc Pier or Abutment Cap

234	4	98	249	2	4	0	0	0	0	0	0	253
		No deterioration	Minor cracks/spalls	Delams/spalls	Analysis warranted							

Remarks:

Preformed Joint Seal

302	4	90	56	10	6	0	0	0	0	0	0	62
		No deterioration	Minor deterioration	Major deterioration								

Remarks:

Neoprene Expansion Joint

307	4	89	166	11	20	0	0	0	0	0	0	186
		The element shows mi	The seal maybe punct	The seal maybe heavi	Major deterioration							

Remarks:

Movable Discontinuous Brg.

311	4	100	30	0	0	0	0	0	0	0	0	30
		No deterioration	Minor deterioration	Advanced corrosion								

Remarks:

Fixed Bearing

313	4	100	30	0	0	0	0	0	0	0	0	30
		No deterioration	Minor deterioration	Advanced corrosion								

Remarks:

Approach Pavement

323	4	100	2	0	0	0	0	0	0	0	0	2
		No deterioration	Cracks/spalls	Major cracks/spalls		Broken/Unstable						

Remarks:

Concrete Bridge Railing

331	4	99	402	1	4	0	0	0	0	0	0	406
		No deterioration	Minor cracks/spalls	Analysis warranted								

Remarks:

Element Description

Elem	Env	% 1	Qty 1	% 2	Qty 2	% 3	Qty 3	% 4	Qty 4	% 5	Qty 5	Tot Qty
Concrete Deck Protected w/ Rigid Overlay												
22	4	11	1,326	45	5,422	44	5,300	0	0	0	0	12,048
		No deficiencies.	Repaired areas exist		Map cracked areas.	Spalls/delaminations		Full depth failures.				
Remarks: WS)HL map crking; Soffit) Isol spalls, HPs, HL-Nar leach crks												
Lead Painted Steel Open Girder												
107	4	100	28,224	0	0	0	0	0	0	0	0	28,224
		No corrosion	Paint distress	Rust formation		Section loss		Section failure				
Remarks:												
Non-Lead Painted Steel Closed Web/Box Girder and O												
173	4	100	60	0	0	0	0	0	0	0	0	60
		No corrosion	Paint distress	Rust formation		Section loss		Section failure				
Remarks:												
Reinforced Conc Column or Pile Extension												
205	4	100	1,068	0	0	0	0	0	0	0	0	1,068
		No deterioration	Minor cracks/spalls	Delams/spalls		Analysis warranted						
Remarks:												
Reinforced Conc Pier Wall												
210	4	100	942	0	0	0	0	0	0	0	0	942
		No deterioration	Minor cracks/spalls	Delams/spalls		Analysis warranted						
Remarks:												
Reinforced Conc Abutment												
215	4	100	1,912	0	0	0	0	0	0	0	0	1,912
		No deterioration	Minor cracks/spalls	Delams/spalls		Analysis warranted						
Remarks: HL vert crks in backwall												
Reinforced Conc Pier or Abutment Cap												
234	4	98	249	2	4	0	0	0	0	0	0	253
		No deterioration	Minor cracks/spalls	Delams/spalls		Analysis warranted						
Remarks: Abut) Crking @ steps; Pier) Crking in cantilever seat												
Preformed Joint Seal												
302	4	90	56	10	6	0	0	0	0	0	0	62
		No deterioration	Minor deterioration	Major deterioration								
Remarks: Leakage @ E Abut												
Neoprene Expansion Joint												
307	4	97	180	3	6	0	0	0	0	0	0	186
		The element shows mi	The seal maybe punct	The seal maybe heavi		Major deterioration						
Remarks: Leakage @ P2												
Movable Discontinuous Brg.												
311	4	100	30	0	0	0	0	0	0	0	0	30
		No deterioration	Minor deterioration	Advanced corrosion								
Remarks:												
Fixed Bearing												
313	4	100	30	0	0	0	0	0	0	0	0	30
		No deterioration	Minor deterioration	Advanced corrosion								

Remarks:

Approach Pavement

323	4	100	2	0	0	0	0	0	0	0	0	2
			No deterioration	Cracks/spalls	Major cracks/spalls	Broken/Unstable						

Remarks:

Concrete Bridge Railing

331	4	99	402	1	4	0	0	0	0	0	0	406
			No deterioration	Minor cracks/spalls	Analysis warranted							

Remarks:

Element Description

Elem	Env	% 1	Qty 1	% 2	Qty 2	% 3	Qty 3	% 4	Qty 4	% 5	Qty 5	Tot Qty
Concrete Deck Protected w/ Rigid Overlay												
22	4	11	1,326	45	5,422	44	5,300	0	0	0	0	12,048
			No deficiencies.	Repaired areas exist	Map cracked areas.	Spalls/delaminations	Full depth failures.					

Remarks:

Lead Painted Steel Open Girder

107	4	100	28,224	0	0	0	0	0	0	0	0	28,224
			No corrosion	Paint distress	Rust formation	Section loss	Section failure					

Remarks:

Non-Lead Painted Steel Closed Web/Box Girder and O

173	4	100	60	0	0	0	0	0	0	0	0	60
			No corrosion	Paint distress	Rust formation	Section loss	Section failure					

Remarks:

Reinforced Conc Column or Pile Extension

205	4	100	1,068	0	0	0	0	0	0	0	0	1,068
			No deterioration	Minor cracks/spalls	Delams/spalls	Analysis warranted						

Remarks:

Reinforced Conc Pier Wall

210	4	100	942	0	0	0	0	0	0	0	0	942
			No deterioration	Minor cracks/spalls	Delams/spalls	Analysis warranted						

Remarks:

Reinforced Conc Abutment

215	4	100	1,912	0	0	0	0	0	0	0	0	1,912
			No deterioration	Minor cracks/spalls	Delams/spalls	Analysis warranted						

Remarks:

Reinforced Conc Pier or Abutment Cap

234	4	98	249	2	4	0	0	0	0	0	0	253
			No deterioration	Minor cracks/spalls	Delams/spalls	Analysis warranted						

Remarks:

Preformed Joint Seal

302	4	90	56	10	6	0	0	0	0	0	0	62
			No deterioration	Minor deterioration	Major deterioration							

Remarks:

Neoprene Expansion Joint

307	4	97	180	3	6	0	0	0	0	0	0	186
-----	---	----	-----	---	---	---	---	---	---	---	---	-----

The element shows mi The seal maybe punct The seal maybe heavi Major deterioration

Remarks:

Movable Discontinuous Brg.

311	4	100	30	0	0	0	0	0	0	0	0	30
-----	---	-----	----	---	---	---	---	---	---	---	---	----

No deterioration Minor deterioration Advanced corrosion

Remarks:

Fixed Bearing

313	4	100	30	0	0	0	0	0	0	0	0	30
-----	---	-----	----	---	---	---	---	---	---	---	---	----

No deterioration Minor deterioration Advanced corrosion

Remarks:

Approach Pavement

323	4	100	2	0	0	0	0	0	0	0	0	2
-----	---	-----	---	---	---	---	---	---	---	---	---	---

No deterioration Cracks/spalls Major cracks/spalls Broken/Unstable

Remarks:

Concrete Bridge Railing

331	4	100	406	0	0	0	0	0	0	0	0	406
-----	---	-----	-----	---	---	---	---	---	---	---	---	-----

No deterioration Minor cracks/spalls Analysis warranted

Remarks:

Element Description

Elem	Env	% 1	Qty 1	% 2	Qty 2	% 3	Qty 3	% 4	Qty 4	% 5	Qty 5	Tot Qty
------	-----	-----	-------	-----	-------	-----	-------	-----	-------	-----	-------	---------

Concrete Deck Protected w/ Rigid Overlay

22	4	11	1,326	45	5,422	44	5,300	0	0	0	0	12,048
----	---	----	-------	----	-------	----	-------	---	---	---	---	--------

No deficiencies. Repaired areas exist Map cracked areas. Spalls/delaminations Full depth failures.

Remarks:

Lead Painted Steel Open Girder

107	4	100	28,224	0	0	0	0	0	0	0	0	28,224
-----	---	-----	--------	---	---	---	---	---	---	---	---	--------

No corrosion Paint distress Rust formation Section loss Section failure

Remarks:

Non-Lead Painted Steel Closed Web/Box Girder and O

173	4	100	60	0	0	0	0	0	0	0	0	60
-----	---	-----	----	---	---	---	---	---	---	---	---	----

No corrosion Paint distress Rust formation Section loss Section failure

Remarks:

Reinforced Conc Column or Pile Extension

205	4	100	1,068	0	0	0	0	0	0	0	0	1,068
-----	---	-----	-------	---	---	---	---	---	---	---	---	-------

No deterioration Minor cracks/spalls Delams/spalls Analysis warranted

Remarks:

Reinforced Conc Pier Wall

210	4	100	942	0	0	0	0	0	0	0	0	942
-----	---	-----	-----	---	---	---	---	---	---	---	---	-----

No deterioration Minor cracks/spalls Delams/spalls Analysis warranted

Remarks:

Reinforced Conc Abutment

215	4	100	1,912	0	0	0	0	0	0	0	0	1,912
			No deterioration	Minor cracks/spalls	Delams/spalls	Analysis warranted						

Remarks:

Reinforced Conc Pier or Abutment Cap

234	4	98	249	2	4	0	0	0	0	0	0	253
			No deterioration	Minor cracks/spalls	Delams/spalls	Analysis warranted						

Remarks:

Preformed Joint Seal

302	4	90	56	10	6	0	0	0	0	0	0	62
			No deterioration	Minor deterioration	Major deterioration							

Remarks:

Neoprene Expansion Joint

307	4	97	180	3	6	0	0	0	0	0	0	186
			The element shows mi	The seal maybe punct	The seal maybe heavi	Major deterioration						

Remarks:

Movable Discontinuous Brg.

311	4	100	30	0	0	0	0	0	0	0	0	30
			No deterioration	Minor deterioration	Advanced corrosion							

Remarks:

Fixed Bearing

313	4	100	30	0	0	0	0	0	0	0	0	30
			No deterioration	Minor deterioration	Advanced corrosion							

Remarks:

Approach Pavement

323	4	100	2	0	0	0	0	0	0	0	0	2
			No deterioration	Cracks/spalls	Major cracks/spalls	Broken/Unstable						

Remarks:

Concrete Bridge Railing

331	4	100	406	0	0	0	0	0	0	0	0	406
			No deterioration	Minor cracks/spalls	Analysis warranted							

Remarks:

Element Description

Elem	Env	% 1	Qty 1	% 2	Qty 2	% 3	Qty 3	% 4	Qty 4	% 5	Qty 5	Tot Qty
Concrete Deck Protected w/ Rigid Overlay												
22	4	11	1,326	45	5,422	44	5,300	0	0	0	0	12,048
			No deficiencies.	Repaired areas exist	Map cracked areas.	Spalls/delaminations		Full depth failures.				

Remarks:

Lead Painted Steel Open Girder

107	4	100	28,224	0	0	0	0	0	0	0	0	28,224
			No corrosion	Paint distress	Rust formation	Section loss	Section failure					

Remarks:

Non-Lead Painted Steel Closed Web/Box Girder and O

173	4	100	60	0	0	0	0	0	0	0	0	60
		No corrosion	Paint distress	Rust formation	Section loss	Section failure						

Remarks:

Reinforced Conc Column or Pile Extension

205	4	100	1,068	0	0	0	0	0	0	0	0	1,068
		No deterioration	Minor cracks/spalls	Delams/spalls	Analysis warranted							

Remarks:

Reinforced Conc Pier Wall

210	4	100	942	0	0	0	0	0	0	0	0	942
		No deterioration	Minor cracks/spalls	Delams/spalls	Analysis warranted							

Remarks:

Reinforced Conc Abutment

215	4	100	1,912	0	0	0	0	0	0	0	0	1,912
		No deterioration	Minor cracks/spalls	Delams/spalls	Analysis warranted							

Remarks:

Reinforced Conc Pier or Abutment Cap

234	4	100	253	0	0	0	0	0	0	0	0	253
		No deterioration	Minor cracks/spalls	Delams/spalls	Analysis warranted							

Remarks:

Preformed Joint Seal

302	4	100	62	0	0	0	0	0	0	0	0	62
		No deterioration	Minor deterioration	Major deterioration								

Remarks:

Neoprene Expansion Joint

307	4	100	186	0	0	0	0	0	0	0	0	186
		The element shows mi	The seal maybe punct	The seal maybe heavi	Major deterioration							

Remarks:

Movable Discontinuous Brg.

311	4	100	30	0	0	0	0	0	0	0	0	30
		No deterioration	Minor deterioration	Advanced corrosion								

Remarks:

Fixed Bearing

313	4	100	30	0	0	0	0	0	0	0	0	30
		No deterioration	Minor deterioration	Advanced corrosion								

Remarks:

Approach Pavement

323	4	100	2	0	0	0	0	0	0	0	0	2
		No deterioration	Cracks/spalls	Major cracks/spalls		Broken/Unstable						

Remarks:

Concrete Bridge Railing

331	4	100	406	0	0	0	0	0	0	0	0	406
		No deterioration	Minor cracks/spalls	Analysis warranted								

Remarks:

Element Description

Elem	Env	% 1	Qty 1	% 2	Qty 2	% 3	Qty 3	% 4	Qty 4	% 5	Qty 5	Tot Qty
Concrete Deck Protected w/ AC Overlay												
14	4	65	7,789	0	0	35	4,194	0	0	0	0	11,983
		No deficiencies.	Repaired areas.	Map cracked areas.		Spalls/delam exist.		Full depth failures.				
Remarks: <input type="text"/>												
Lead Painted Steel Open Girder												
107	4	94	26,531	6	1,693	0	0	0	0	0	0	28,224
		No corrosion	Paint distress	Rust formation		Section loss		Section failure				
Remarks: <input type="text"/>												
Lead Painted Steel Closed Web/Box Girder and Open												
172	4	92	46	8	4	0	0	0	0	0	0	50
		No corrosion	Paint distress	Rust formation		Section loss		Section failure				
Remarks: <input type="text"/>												
Reinforced Conc Column or Pile Extension												
205	4	84	897	9	96	7	75	0	0	0	0	1,068
		No deterioration	Minor cracks/spalls	Delams/spalls		Analysis warranted						
Remarks: <input type="text"/>												
Reinforced Conc Pier Wall												
210	4	100	942	0	0	0	0	0	0	0	0	942
		No deterioration	Minor cracks/spalls	Delams/spalls		Analysis warranted						
Remarks: <input type="text"/>												
Reinforced Conc Abutment												
215	4	97	1,855	2	38	1	19	0	0	0	0	1,912
		No deterioration	Minor cracks/spalls	Delams/spalls		Analysis warranted						
Remarks: <input type="text"/>												
Reinforced Conc Pier or Abutment Cap												
234	4	69	175	24	61	7	18	0	0	0	0	253
		No deterioration	Minor cracks/spalls	Delams/spalls		Analysis warranted						
Remarks: <input type="text"/>												
Neoprene Expansion Joint												
307	4	76	299	20	79	4	16	0	0	0	0	394
		The element shows mi	The seal maybe punct	The seal maybe heavi		Major deterioration						
Remarks: <input type="text"/>												
Movable Discontinuous Brg.												
311	4	100	30	0	0	0	0	0	0	0	0	30
		No deterioration	Minor deterioration	Advanced corrosion								
Remarks: <input type="text"/>												
Fixed Bearing												
313	4	100	30	0	0	0	0	0	0	0	0	30
		No deterioration	Minor deterioration	Advanced corrosion								
Remarks: <input type="text"/>												
Approach Pavement												
323	4	100	2	0	0	0	0	0	0	0	0	2
		No deterioration	Cracks/spalls	Major cracks/spalls		Broken/Unstable						

Remarks:

Concrete Bridge Railing

331	4	58	234	25	101	17	69	0	0	0	0	403
-----	---	----	-----	----	-----	----	----	---	---	---	---	-----

No deterioration

Minor cracks/spalls



Analysis warranted

Remarks:

Download Date: 04/18/2013

ATTACHMENT D

Bottom of Deck Condition Survey

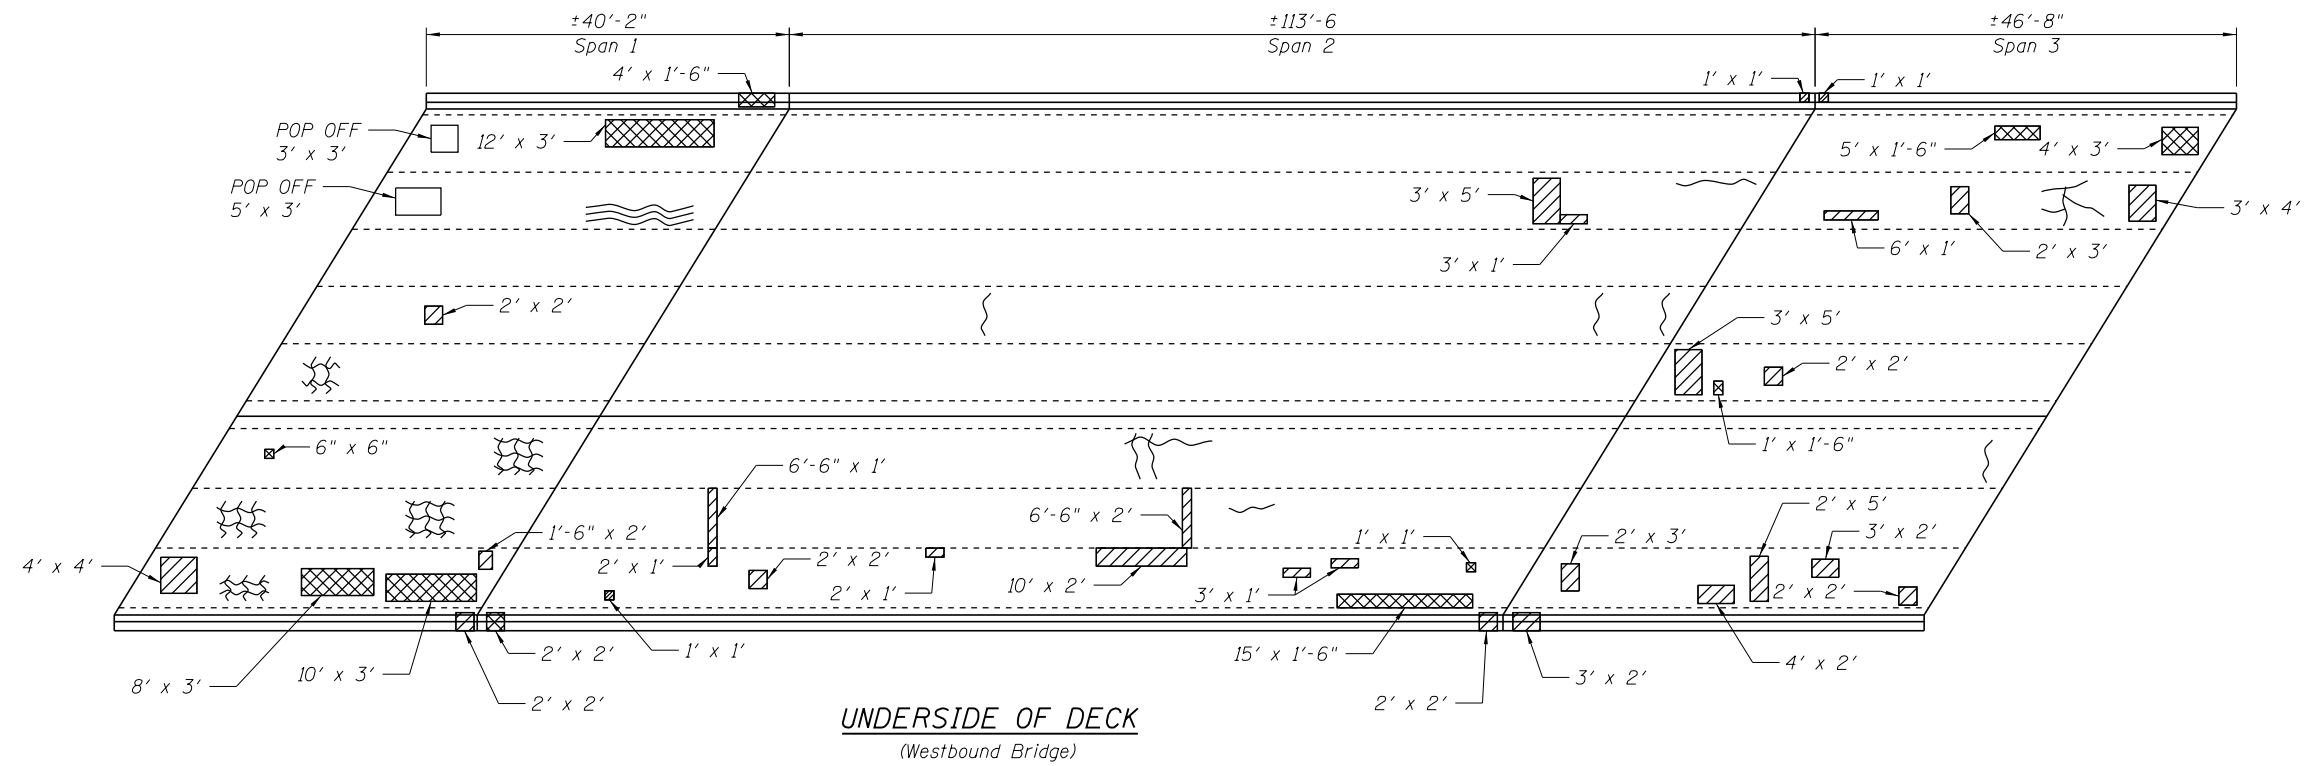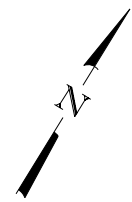

UNDERSIDE OF DECK
(Westbound Bridge)

NOTE:
① CENTER SPAN HAS SIGNIFICANT AMOUNT OF DISCOLORED CONCRETE & POP OFF IN EACH BAY

LEGEND

- CRACKED CONCRETE
- MAP CRACKING
- SPALLED CONCRETE
- DELAMINATED CONCRETE

FILE NAME = W:\1786\active\178600037_IDOT_1-95\structural\drawing\shd\dwg_Cicero.Avenue.Underside_of_Deck.dgn



USER NAME = jerojas	DESIGNED - JSR	REVISED -
	CHECKED - BPS	REVISED -
PLOT SCALE = N/A	DRAWN - JSR	REVISED -
PLOT DATE = 10/9/2013	CHECKED - BPS	REVISED -

STATE OF ILLINOIS
DEPARTMENT OF TRANSPORTATION

ATTACHMENT D - BOTTOM OF DECK CONDITION SURVEY
STRUCTURE NO. 016-0017

SHEET NO. 1 OF 1 SHEETS

F.A.I. RTE. 55	SECTION 1112-619-HB	COUNTY COOK	TOTAL SHEETS	SHEET NO.
FED. ROAD DIST. NO. 1		ILLINOIS FED. AID PROJECT		

ATTACHMENT E

**Condition Assessment of the Reinforced
Concrete Bridge Deck**

January 6, 2012

Ms. Diane M. O'Keefe
Deputy Director of Highways
District One Engineer
Illinois Department of Transportation
201 West Center Court
Schaumburg, Illinois 60196-1096
Attn: Ms. Sarah Wilson (Maintenance Bridge Engineer)

Re: Condition Assessment of Bridge Deck
I-55 Westbound over IL-50 (Cicero Avenue)
Structure No. 016-0017
District One
Work Order 10
PTB No. 153-18
WJE No. 2009.3645.10

Dear Ms. O'Keefe:

At your request, Wiss, Janney, Elstner Associates, Inc. (WJE) completed a condition assessment of the reinforced concrete bridge deck for Structure No. 016-0017. This work included a visual assessment of concrete deterioration from below the structure. Also included was a delamination survey performed on the top of the bridge deck, based on an infrared thermography (IR) survey. Reinforcing bar cover depth determination was also performed using ground penetrating radar (GPR). These inspection tasks began in July and were completed in September.

Structure Description

The I-55 Westbound Bridge over IL-50, Cicero Avenue carries three lanes of traffic and two shoulders. This three span structure is comprised of steel beam and concrete deck construction. Each of the 10 girder lines is connected using steel diaphragms or cross frames. All deck and substructure components are comprised of cast-in-place reinforced concrete construction. Reportedly the bridge structure was originally constructed in 1963 and the current overlay was installed in 2000.

The spans have approximate lengths of 42 ft-3 in, 113 ft-5 in, and 45 ft-8 in., from west-to-east, for a total structure length of 202 ft-8 in., back-to-back of abutments. The total deck width out-to-out is 59 ft-5 in. and the deck width to the inside faces of the parapet walls is 56 ft. The total resulting bridge deck area is approximately 11,055 sq. ft. A partial elevation view of the structure looking south is included as Figure 1.

Inspection Methods

The condition of the reinforced concrete bridge deck was assessed using several methods. These methods can be broken down into two major categories: Bottom of Deck Inspection Methods and Top of Deck Inspection Methods.

Bottom of Deck Inspection Methods

The condition of the bottom of the reinforced concrete deck was assessed from grade below the structure in September 2011. All accessible areas of the bottom of the deck were assessed visually. This inspection was completed from the ground beneath the bridge outside of active traffic lanes. Binoculars and/or zoom lenses were used to magnify the view of distant surfaces. Plan drawings of the structure including the structural framing were used to record field notes.

Top of Deck Inspection Methods

The condition of the top of the reinforced concrete deck was assessed using IR equipment to map areas of spalls, patches, and delaminations. This work was subcontracted to Infrasense, Inc. and was performed in July, 2011. Rolling lane closures were utilized during data collection periods to allow the IR data collection vehicle to assess the entire bridge deck surface while moving at approximately 3 mph. Impact Echo (IE) and sounding techniques were used to confirm the presence of delaminations at select locations on each bridge deck. All IR data was analyzed and summarized on bridge deck drawing sheets that show the located defects to scale.

GPR equipment was used to identify the cover depth of the top mat of reinforcing steel from the top surface of the deck. The GPR equipment was mounted to an inspection vehicle and scans were completed at normal operating speeds.

Assessment Results

The reinforced concrete bridge deck was found to be in satisfactory condition overall. Results for each assessment category are included below.

Bottom of Deck

Visual inspection from grade below the bridge was used to assess the bottom of the bridge deck. All areas of spalls or delaminations that could be identified visually were documented. In addition, all areas of previously repaired concrete were noted. Table 1 includes a summary of the visual inspection, including total deck soffit area, the area of spalled concrete, the area of delaminated concrete and the area of previous repairs. Figures 2 and 3 show the typical condition of the deck soffit. The results of the bottom of deck survey are shown on Sheet S-3 of Appendix A.

Table 1. Bottom of Deck Deterioration Summary

Soffit Area (sq. ft)	Spalled Area (sq. ft)	Total Area (%)	Delaminated Area (sq. ft)	Total Area (%)	Previously Repaired Area (sq.ft)
11,055	70	0.6	285	2.6	1705

Top of Deck

The top of the bridge deck was assessed using both IR and GPR equipment. The IR survey equipment was able to identify delaminations and spalls present in the bridge deck. Figure 4 is an overall view of the top deck surface looking southwest.

Table 2 includes a summary of the total bridge deck area, the total bridge deck area spalled, the total bridge deck area delaminated, the total bridge deck area that should be programmed for repair work and the rebar cover from the top surface of the deck. Sheet S-1 of Appendix A is a scaled bridge deck plan drawing showing the locations of the delaminated or spalled areas. Sheet S-2 of Appendix A is a scaled bridge deck plan drawing showing an image of the IR scan of the bridge. Sheet S-4 of Appendix A is a scaled bridge deck plan drawing showing the location of suggested partial and full depth concrete repairs using conventional patching techniques. Note that repair area boundaries were selected by expanding the boundaries of each delaminated or spalled area by 6 inches to account for saw cutting outside of the delamination and further deterioration prior to the actual start of any repair work. In addition, repair areas were joined when adjacent repairs were spaced at approximately 2 ft. or less. Full depth repair boundaries were determined based on locations where top and bottom surface defects overlapped. No bottom surface repairs were identified based on recommendations from IDOT.

Table 2. Top of Deck Deterioration Summary

Bridge Deck Area (sq. ft)	Spalled Area (sq. ft)	Total Area (%)	Delaminated Area (sq. ft)	Total Area (%)	Repair Area (sq. ft)	Total Area (%)	Rebar Cover (in.)
11,055	0	0	430	3.9	983	8.9	3.9

Recommendations and Conclusions

WJE performed a condition assessment of the reinforced concrete bridge deck of the I-55 Westbound Bridge over IL-50, Cicero Avenue. This condition assessment included: a visual survey of the bottom of the deck and an IR survey of the top of the deck. This information was used to produce repair drawings indicating the size and location of anticipated repair areas.


The repair work should, at a minimum, include partial depth repairs at all locations indicated on Sheet S-4 in Appendix A. If this option is selected, a detailed delamination assessment should be completed by the contractor at the time of the repair work to ensure that all areas of deteriorated concrete are identified. In addition, all re-entrant corners of repair areas should be detailed to include a 4 inch chamfer to reduce the potential for concrete-shrinkage related cracking.

The bridge deck was found to currently be in satisfactory condition, but corrosion-related damage has become apparent and should be repaired.


We would be happy to answer any questions or provide additional information.

Sincerely,

WISS, JANNEY, ELSTNER ASSOCIATES, INC.

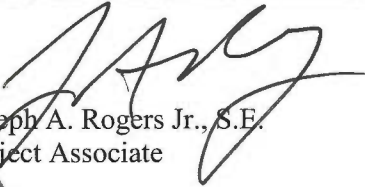

Joseph A. Rogers Jr., S.E.
Project Associate

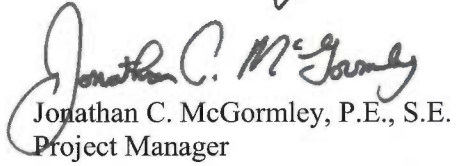

Jonathan C. McGormley, P.E., S.E.
Project Manager

Figures



Figure 1. Elevation view, looking south



Figure 2. Typical view, deck soffit, northeast corner.

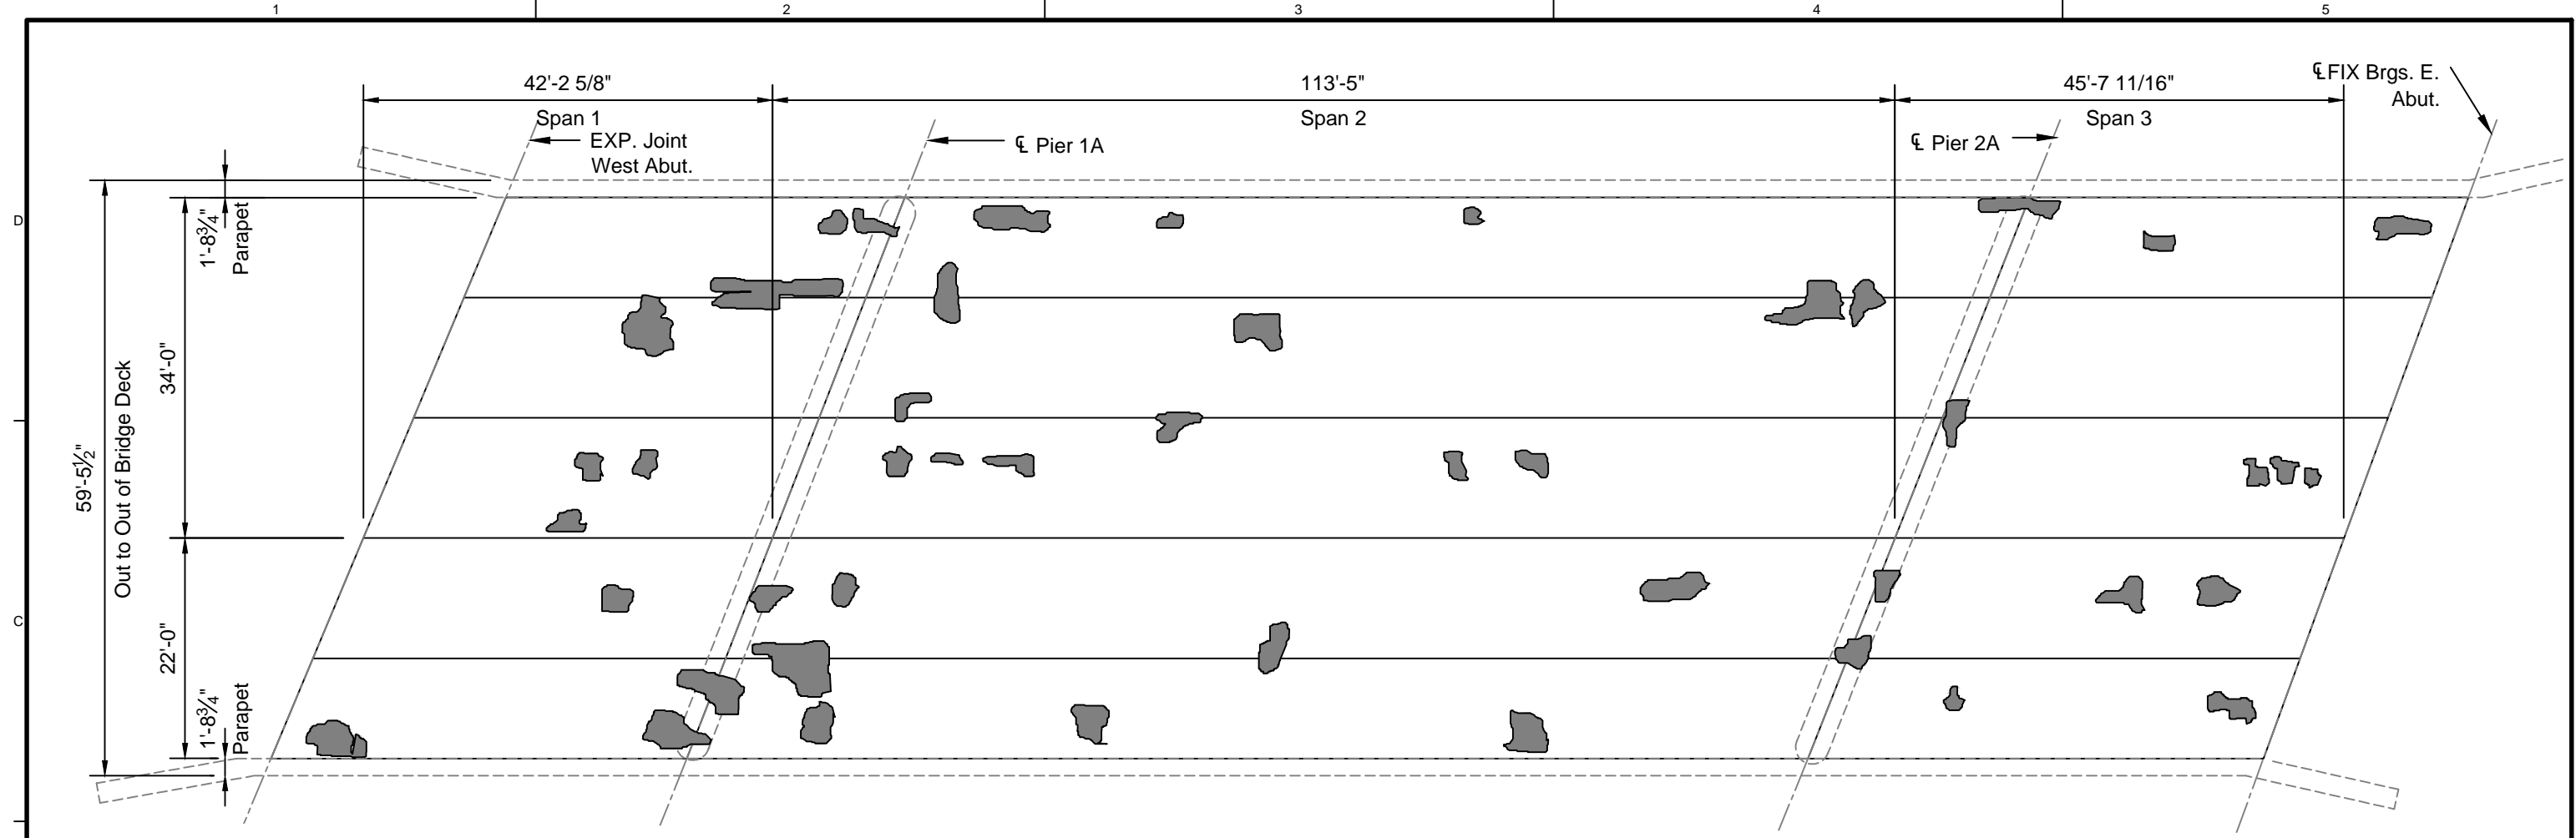


Figure 3. Typical view, deck soffit, looking west.

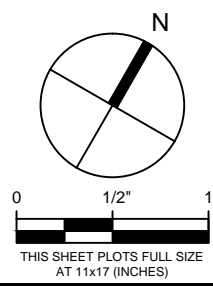


Figure 4. Typical view, deck top surface, looking southwest

Appendix A - Bridge Deck Condition Assessment Drawings



FIELD OBSERVATION SUMMARY		STRUCTURE # 016-0017		LEGEND	
ITEM	UNIT	QUANT.	%	DELAMINATION	SPALL
TOTAL AREA	Ac	11055	100		
DELAMINATION	Ac	430	3.9		
SPALL	Ac	0	0		
CRACKS	ft	-	-		




WJE ENGINEERS ARCHITECTS MATERIALS SCIENTISTS
 Wiss, Janney, Elstner Associates, Inc.
 330 Pfingsten Road
 Northbrook, Illinois 60062
 847.272.7400 tel | 847.291.4813 fax
 www.wje.com

Client
 Illinois Department of Transportation
 District One
 201 West Center Court
 Schaumburg, Illinois 60196

Project
 Bridge 016-0017
 WESTBOUND I-55 OVER CICERO AVENUE
 Sheet Title
 IR Result - Top Surface


Proj. No. 2009.3645.10
 Date November 19 2011
 Drawn JJZ
 Checked JAR
 Scale 1/16" = 1'-0"

Sheet No. **S1**

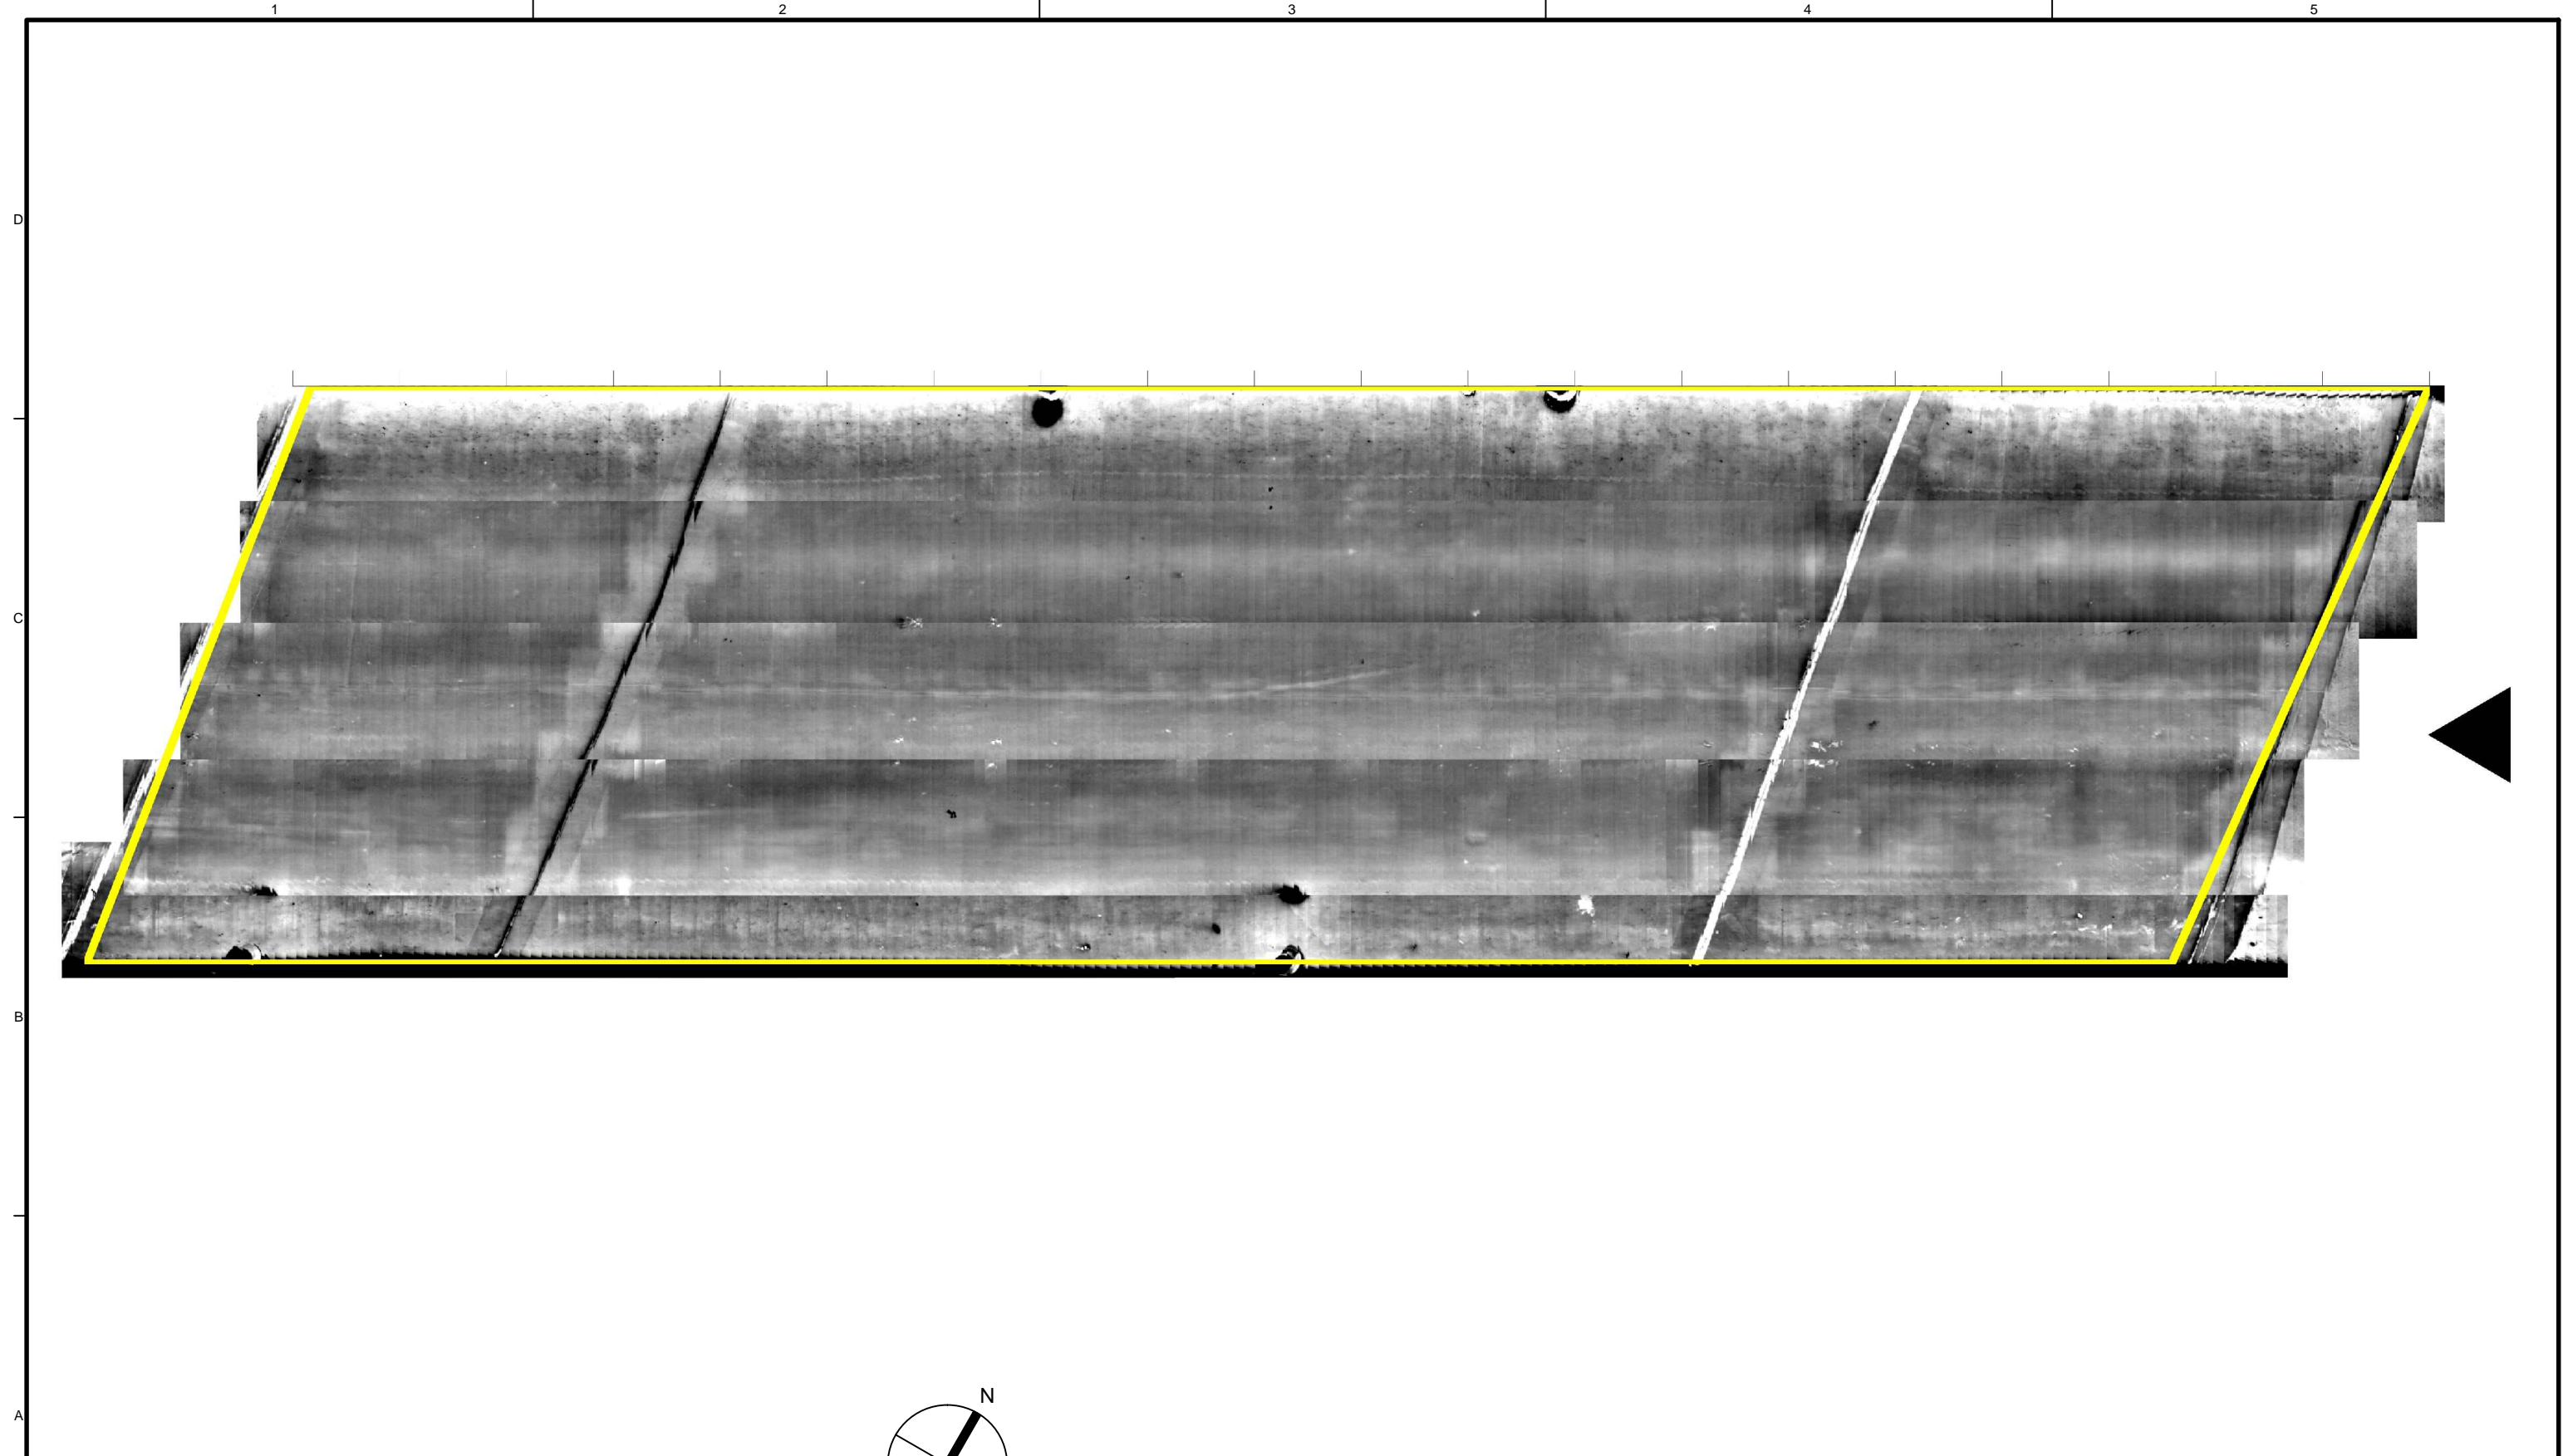

D
C
B
A

1 2 3 4 5

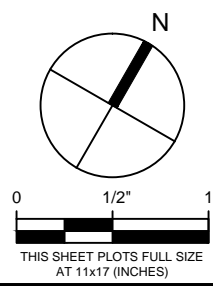


WJE ENGINEERS
ARCHITECTS
MATERIALS SCIENTISTS
Wiss, Janney, Elstner Associates, Inc.
330 Pfingsten Road
Northbrook, Illinois 60062
847.272.7400 tel | 847.291.4813 fax
www.wje.com

Client
 Illinois Department
of Transportation
District One
201 West Center Court
Schaumburg, Illinois 60196


Project
Bridge 016-0017
WESTBOUND I-55 OVER CICERO AVENUE
Sheet Title
IR Image - Top Surface

Proj. No.	2009.3645.10
Date	November 19 2011
Drawn	JJZ
Checked	JAR
Scale	1/16" = 1'

Sheet No. **S2**

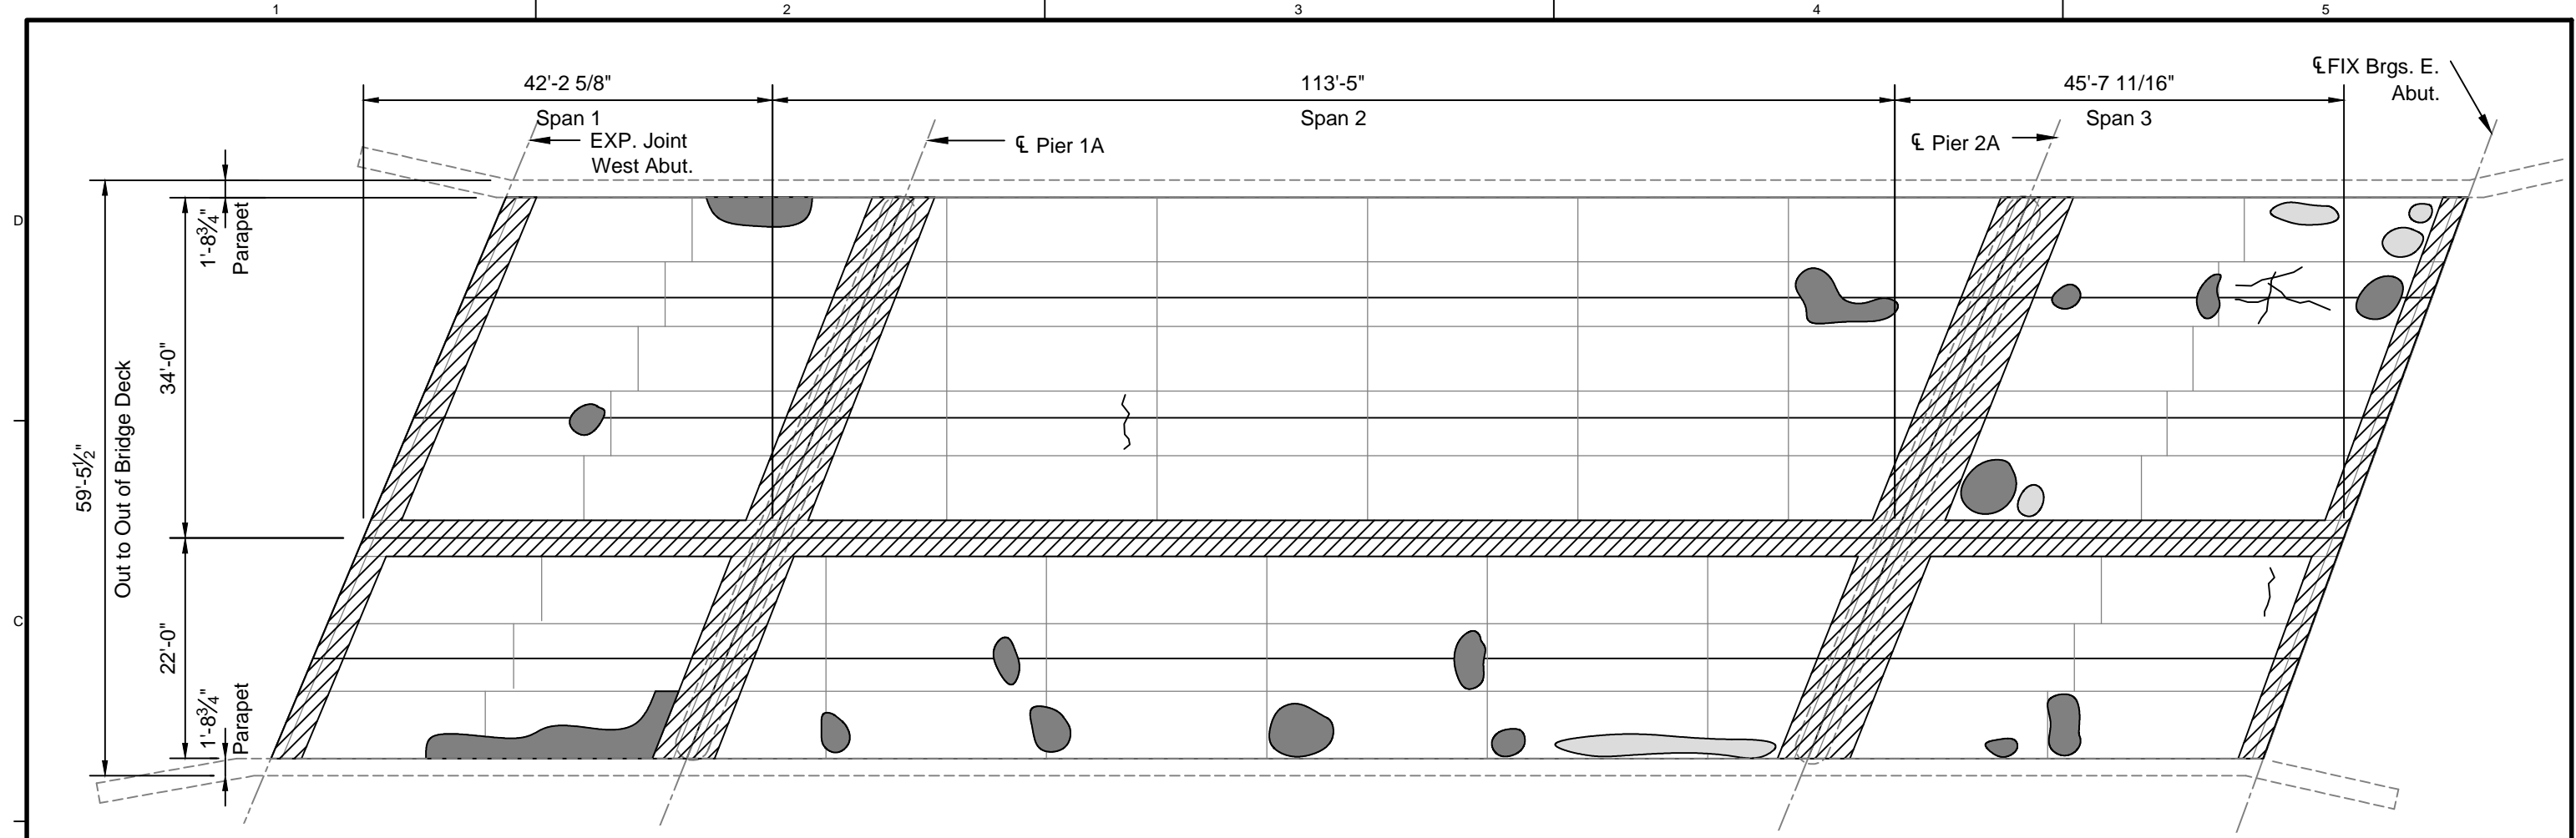

FIELD OBSERVATION SUMMARY		STRUCTURE # 016-0017		LEGEND	
ITEM	UNIT	QUANT.	%		
TOTAL AREA	Ac	11055	100	DELAMINATION	
DELAMINATION	Ac	285	2.6	SPALL	
SPALL	Ac	70	0.6	PREV. REPAIR	
PREVIOUS REPAIRS	Ac	1705	15.4	CRACK	
CRACKS	ft	-	-		

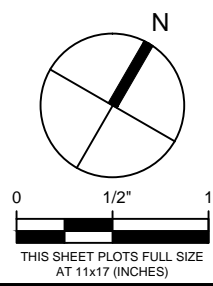


WJE ENGINEERS ARCHITECTS MATERIALS SCIENTISTS
 Wiss, Janney, Elstner Associates, Inc.
 330 Pfingsten Road
 Northbrook, Illinois 60062
 847.272.7400 tel | 847.291.4813 fax
 www.wje.com

Client
 Illinois Department of Transportation
 District One
 201 West Center Court
 Schaumburg, Illinois 60196


Project
 Bridge 016-0017
 WESTBOUND I-55 OVER CICERO AVENUE
 Sheet Title
 Underside Deterioration

Proj. No. 2009.3645.10
 Date November 19 2011
 Drawn JJZ
 Checked JAR
 Scale 1/16" = 1'-0"

S3
 Sheet No.

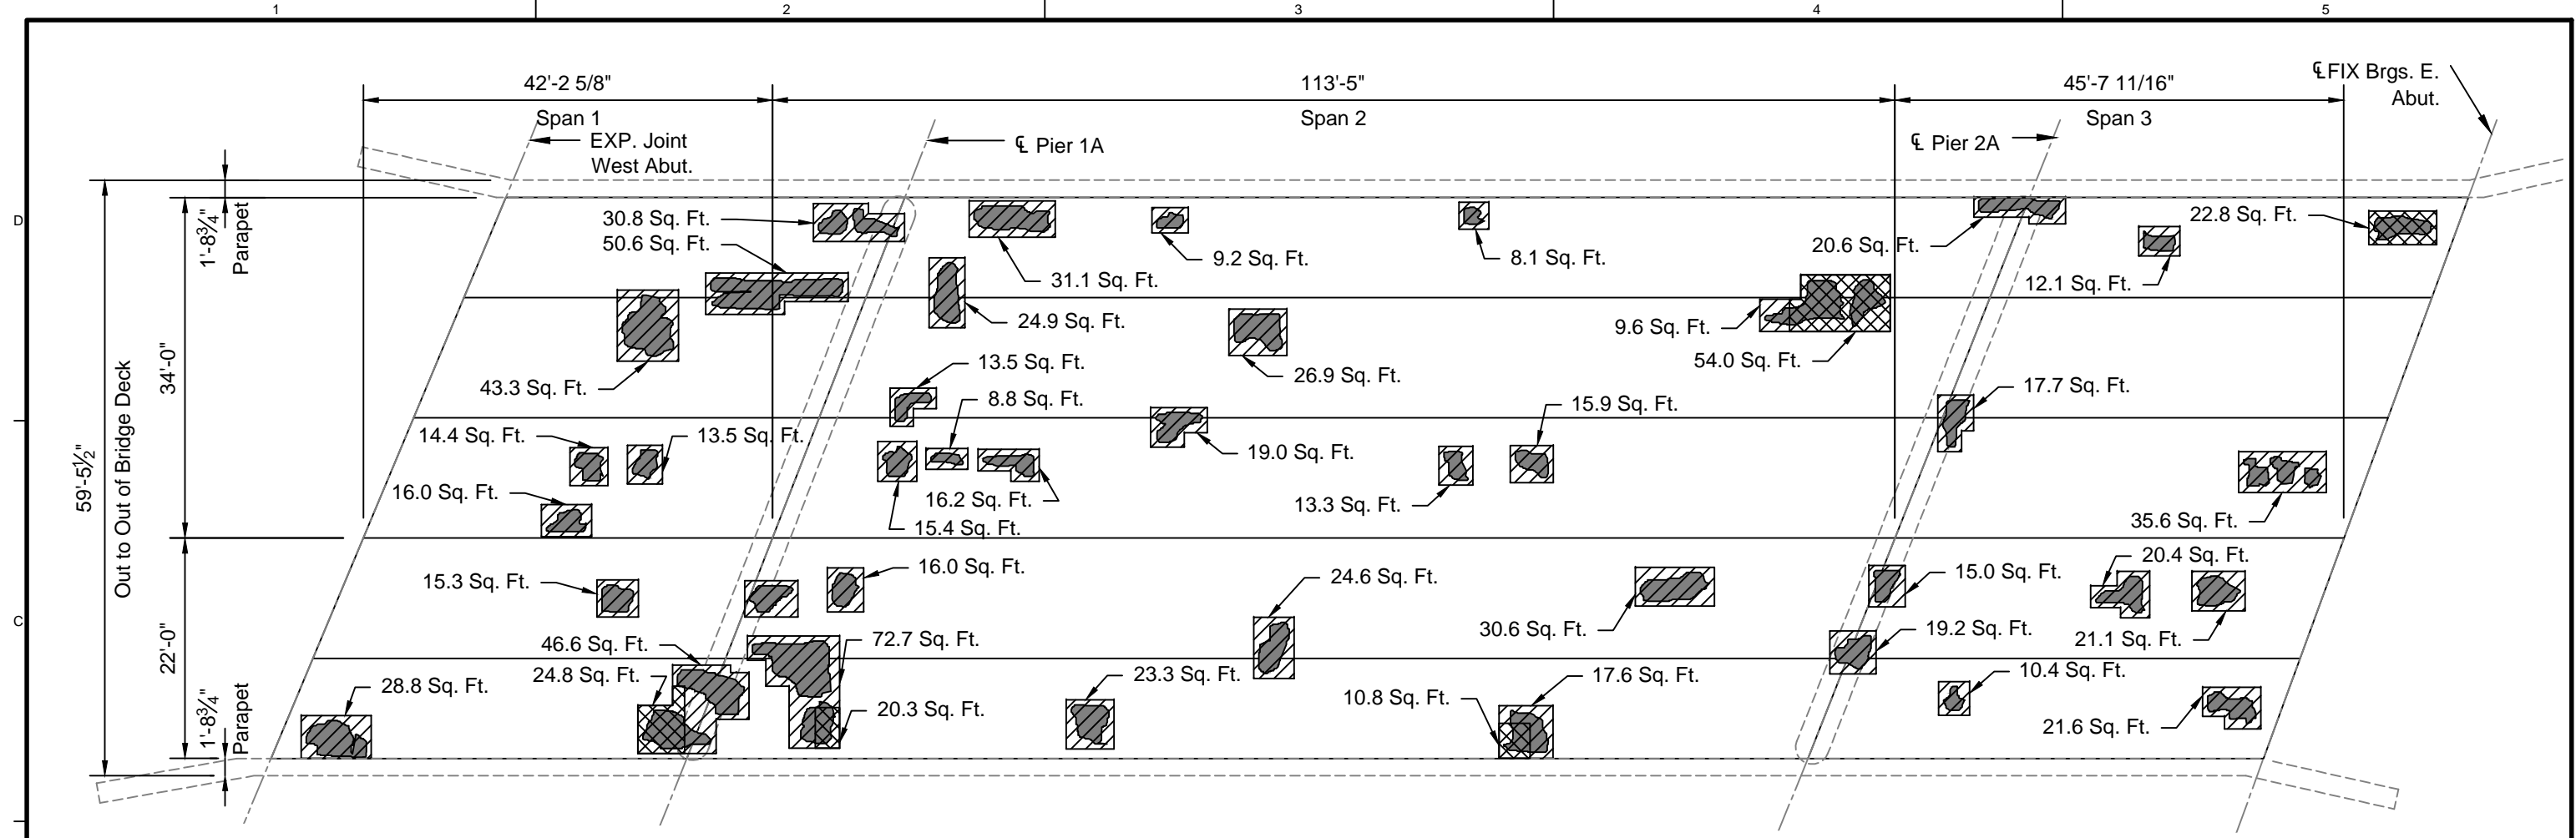

FIELD OBSERVATION SUMMARY		STRUCTURE # 016-0017		LEGEND	
ITEM	UNIT	QUANT.	%		
TOTAL AREA	Ac	11055	100	PARTIAL DEPTH REPAIR	
PARTIAL DEPTH REPAIR	Ac	861	7.8	FULL DEPTH REPAIR	
FULL DEPTH REPAIR	Ac	122	1.1	DELAMINATION	
DELAMINATION	Ac	430	3.9	SPALL	
SPALL	Ac	0	0	CRACK	
CRACKS	ft	-	-		

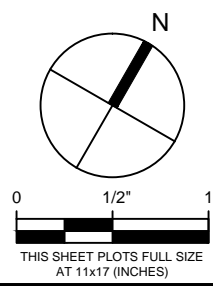

WJE ENGINEERS ARCHITECTS MATERIALS SCIENTISTS
 Wiss, Janney, Elstner Associates, Inc.
 330 Pfingsten Road
 Northbrook, Illinois 60062
 847.272.7400 tel | 847.291.4813 fax
 www.wje.com

Client
Illinois Department of Transportation
 District One
 201 West Center Court
 Schaumburg, Illinois 60196


Project
 Bridge 016-0017
 WESTBOUND I-55 OVER CICERO AVENUE
 Sheet Title
 Proposed Repairs

Proj. No. 2009.3645.10
 Date November 19 2011
 Drawn JJZ
 Checked JAR
 Scale 1/16" = 1'-0"


Sheet No. **S4**

ATTACHMENT F

Substructure Condition Surveys

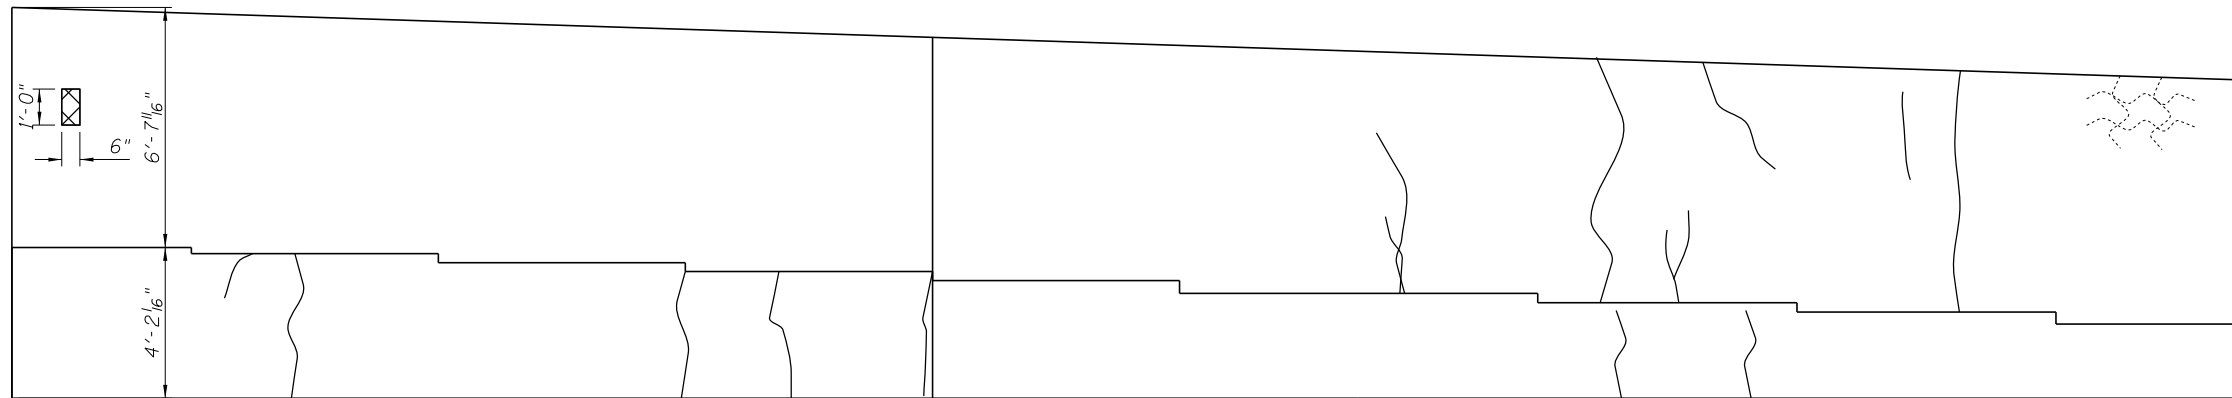




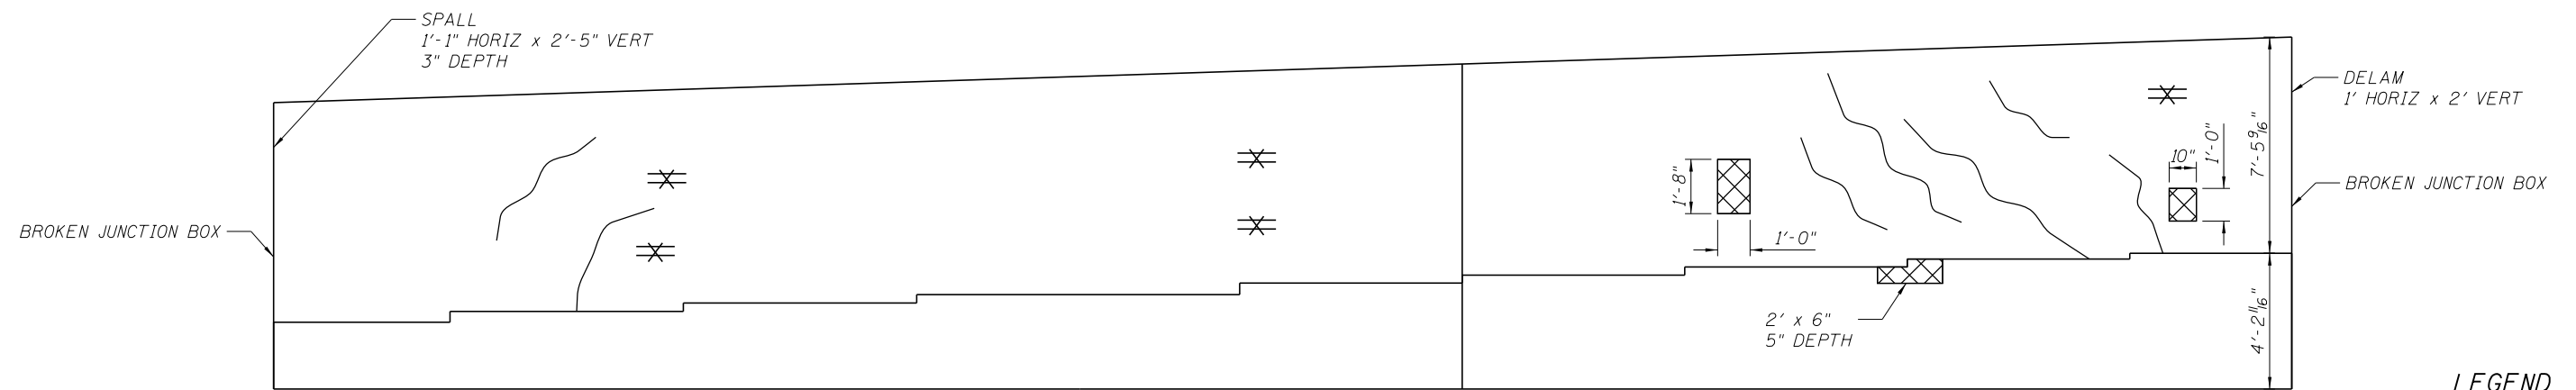

EAST ABUTMENT
LOOKING EAST

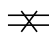

WEST ABUTMENT
LOOKING WEST

LEGEND

-  - BROKEN CONDUIT
-  - HAIRLINE CRACK UNLESS OTHERWISE NOTED
-  - LIGHT MAP CRACKING
-  - SPALLED CONCRETE
-  - DELAMINATED CONCRETE

FILE NAME = V:\1786\active\178600037_IDOT_155\structural\drawing\shd\deg_Cicero.Avenue.Abutment.Elevation.dgn




USER NAME = jerojas	DESIGNED - JSR	REVISED -
	CHECKED - BPS	REVISED -
PLOT SCALE = N/A	DRAWN - JSR	REVISED -
PLOT DATE = 10/7/2013	CHECKED - BPS	REVISED -

STATE OF ILLINOIS
DEPARTMENT OF TRANSPORTATION


ATTACHMENT F - SUBSTRUCTURE CONDITION SURVEY
STRUCTURE NO. 016-0017

SHEET NO. 1 OF 3 SHEETS

F.A.I. RTE.	SECTION	COUNTY	TOTAL SHEETS	SHEET NO.
55	1112-619-HB	COOK		
CONTRACT NO.				
FED. ROAD DIST. NO. 1 ILLINOIS FED. AID PROJECT				

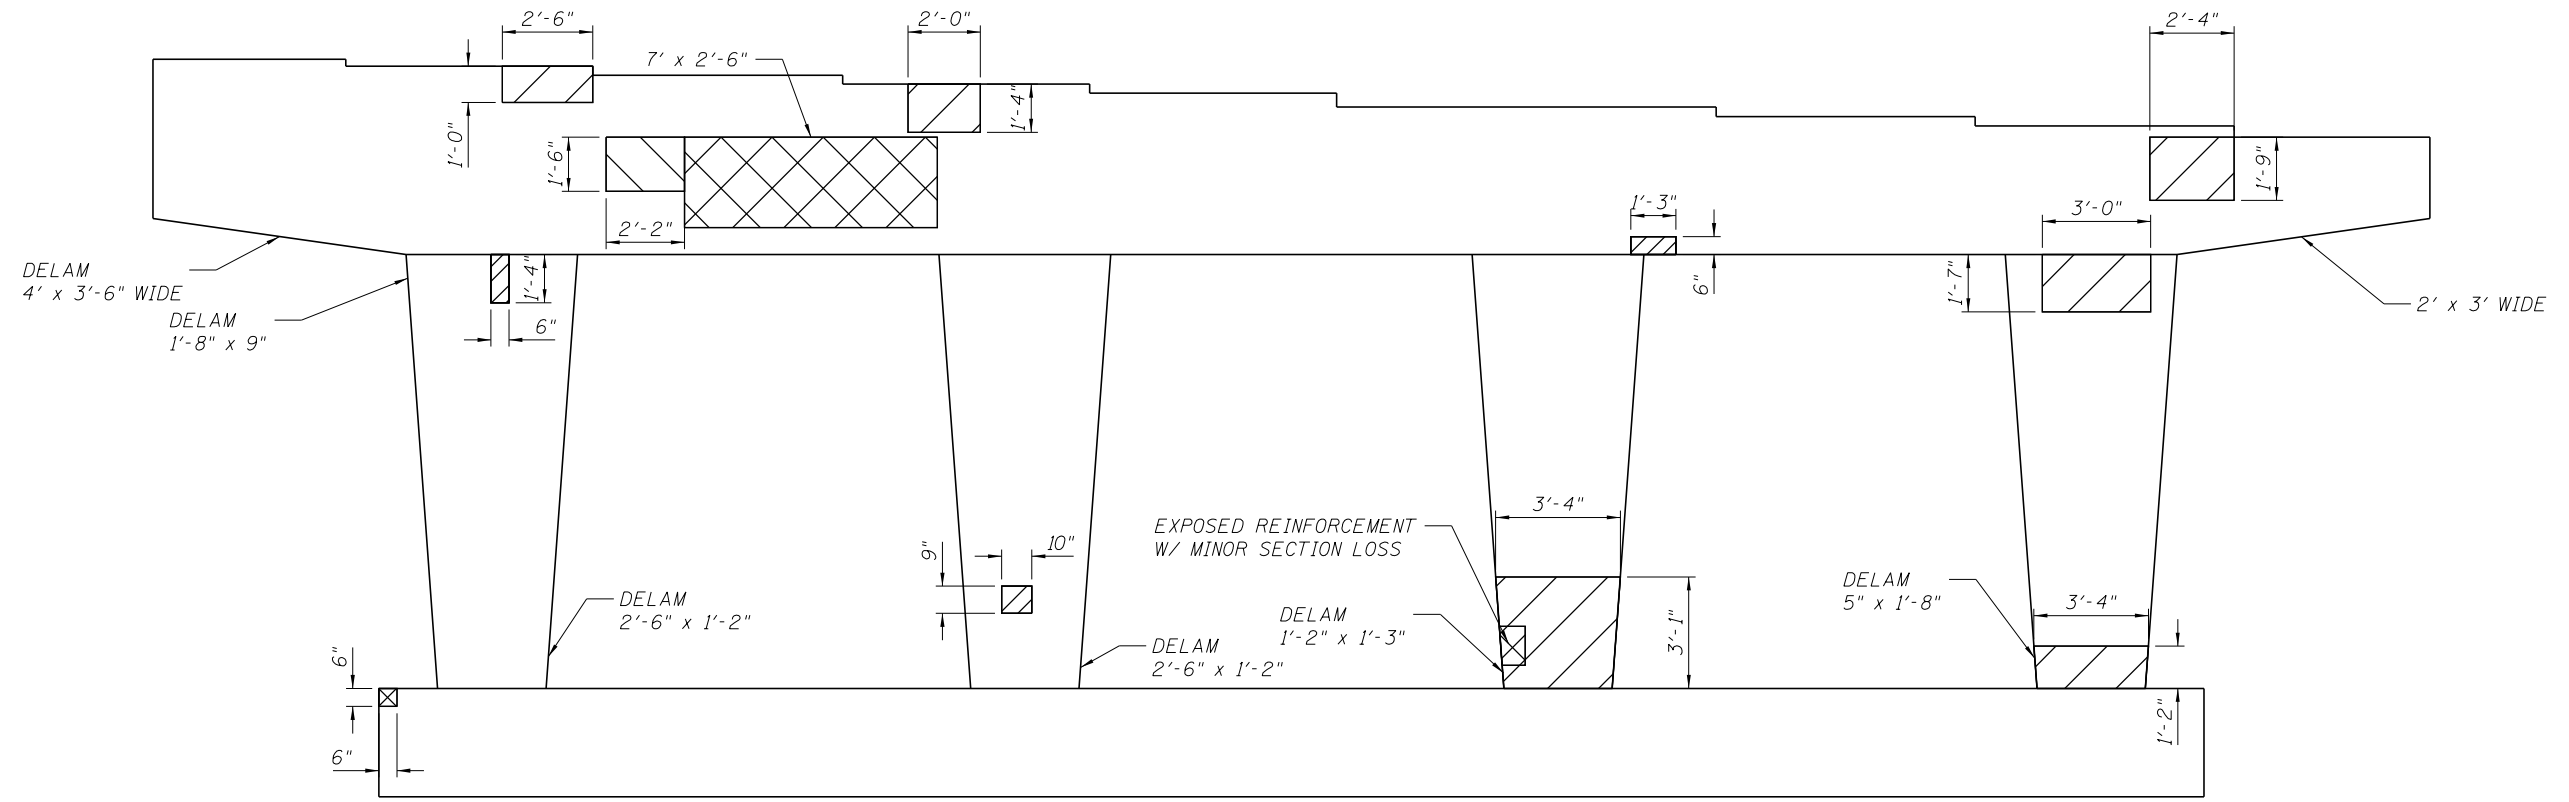

PIER 1
LOOKING EAST

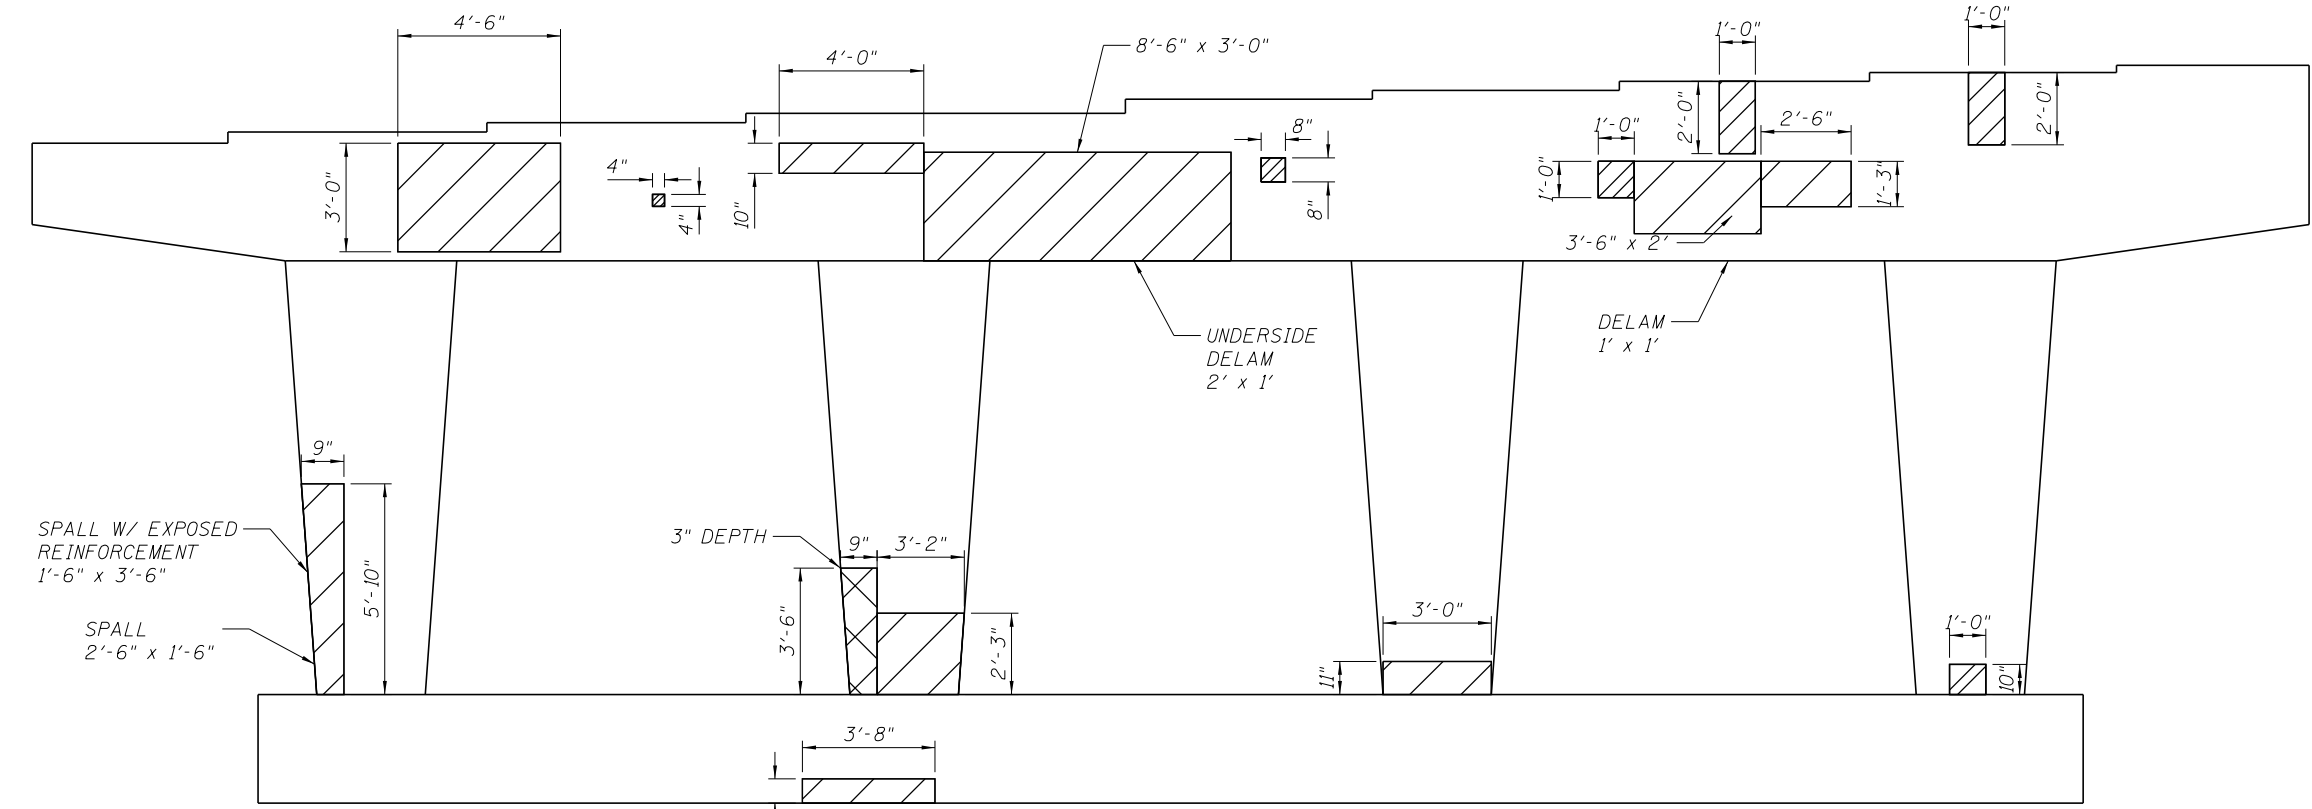

PIER 1
LOOKING WEST

LEGEND

- SPALLED CONCRETE
- DELAMINATED CONCRETE

FILE NAME = W:\1786\active\178600037_IDOT_155\structural\drawing\shd\dwg_Cicero_Avenue_Pier_Elevation.dgn




USER NAME = jerojas	DESIGNED - JSR	REVISED -
PLOT SCALE = N/A	CHECKED - BPS	REVISED -
PLOT DATE = 10/7/2013	DRAWN - JSR	REVISED -
	CHECKED - BPS	REVISED -

**STATE OF ILLINOIS
DEPARTMENT OF TRANSPORTATION**


**ATTACHMENT F - SUPERSTRUCTURE CONDITION SURVEY
STRUCTURE NO. 016-0017**

SHEET NO. 2 OF 3 SHEETS

F.A.I. RTE. 55	SECTION 1112-619-HB	COUNTY COOK	TOTAL SHEETS	SHEET NO.
FED. ROAD DIST. NO. 1			ILLINOIS FED. AID PROJECT	

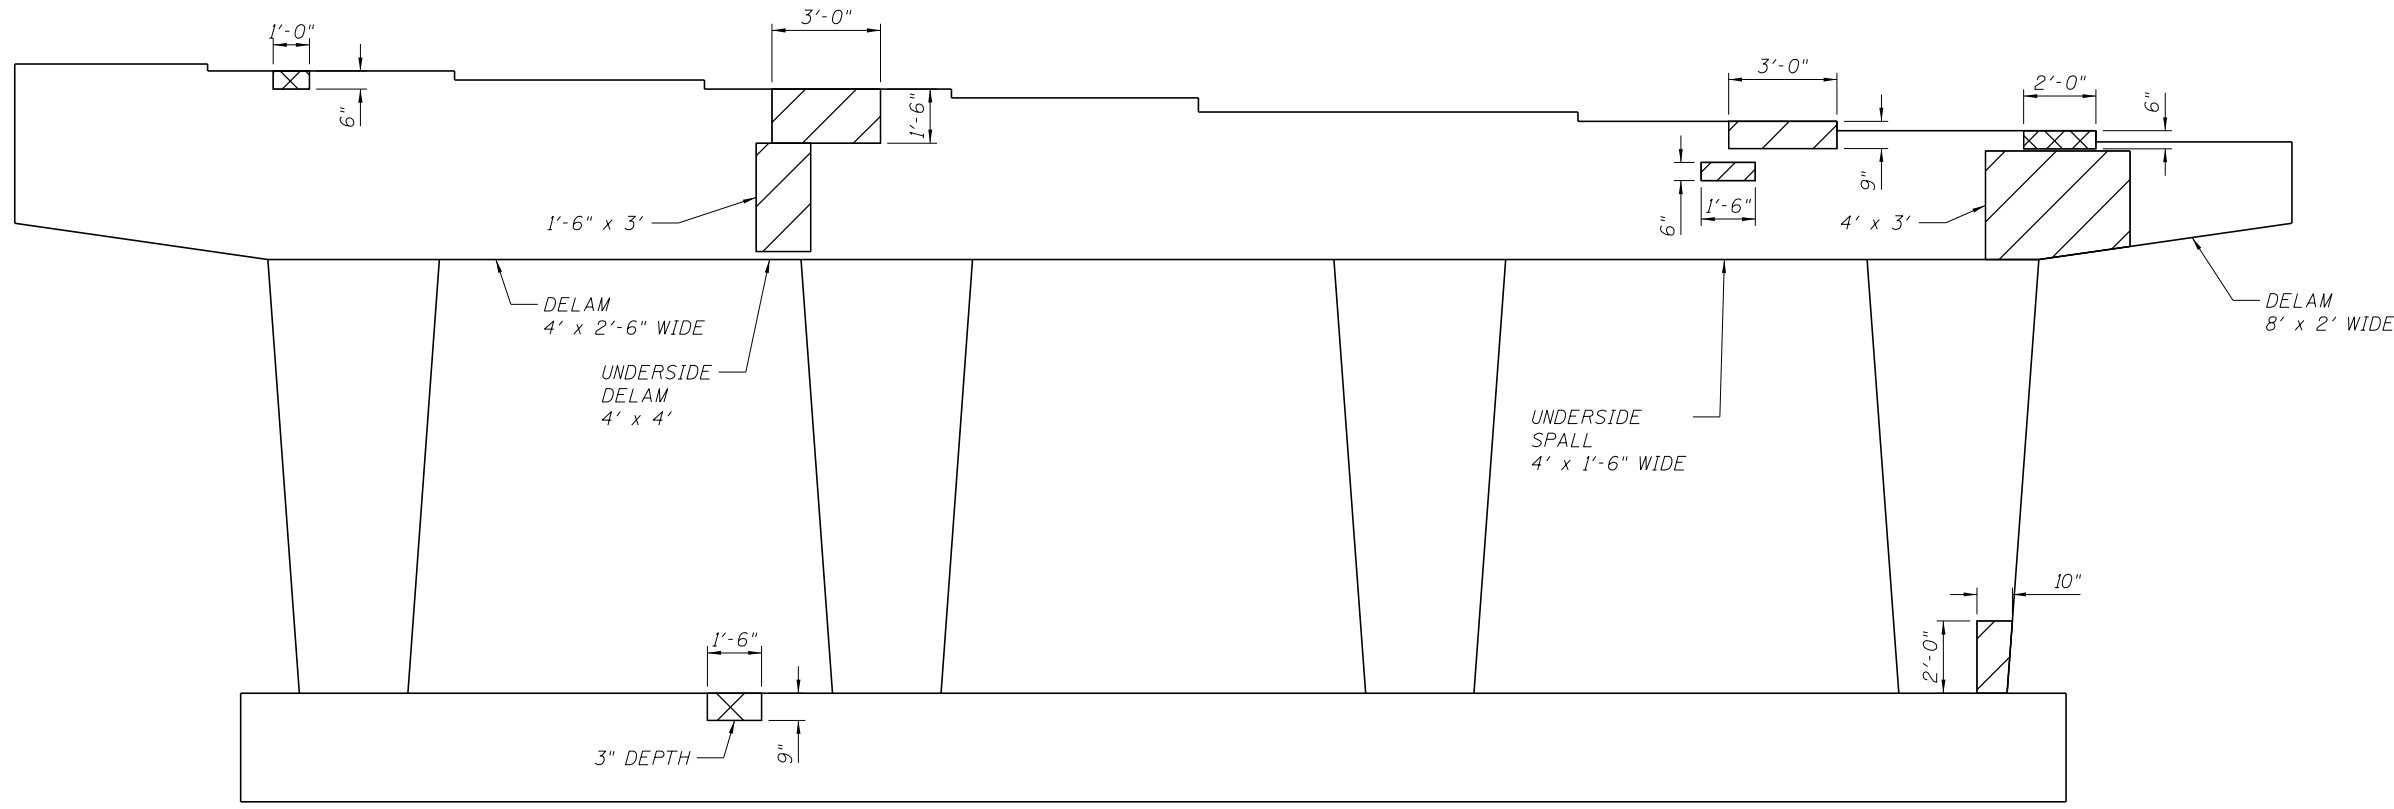

PIER 2
LOOKING EAST

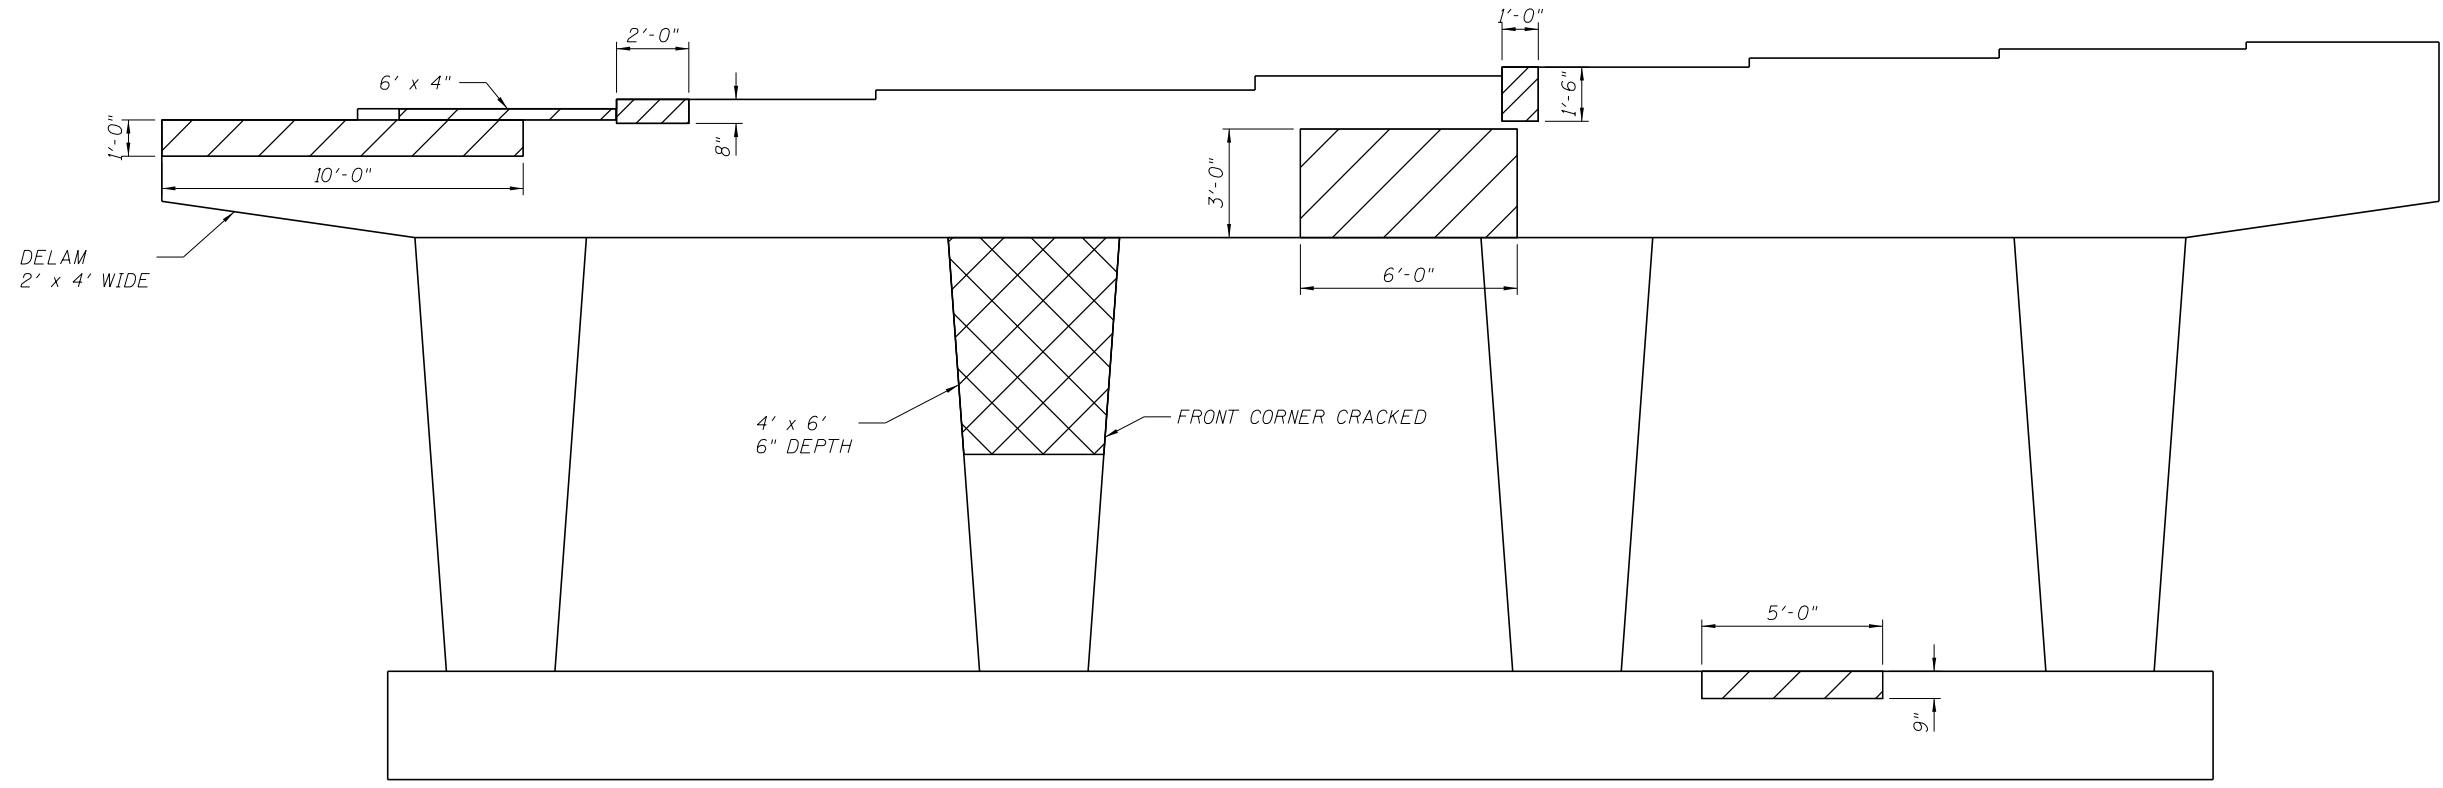

PIER 2
LOOKING WEST

LEGEND

- SPALLED CONCRETE
- DELAMINATED CONCRETE

FILE NAME = W:\1786\active\178600037_IDOT_1-95\structural\drawing\shd\dwg_Cicero.Avenue.Pier.Elevation.dgn



USER NAME = jerojas	DESIGNED - JSR	REVISED -
	CHECKED - BPS	REVISED -
PLOT SCALE = N/A	DRAWN - JSR	REVISED -
PLOT DATE = 10/7/2013	CHECKED - BPS	REVISED -

STATE OF ILLINOIS
DEPARTMENT OF TRANSPORTATION

ATTACHMENT F - SUBSTRUCTURE CONDITION SURVEY
STRUCTURE NO. 016-0017

SHEET NO. 3 OF 3 SHEETS

F.A.I. RTE.	SECTION	COUNTY	TOTAL SHEETS	SHEET NO.
55	1112-619-HB	COOK		
CONTRACT NO.				
FED. ROAD DIST. NO. 1 ILLINOIS FED. AID PROJECT				

ATTACHMENT G

Opinion of Probable Costs

Sheet: _____ of _____
 Calc By: JSR Date: 10/9/13
 Check By: BHS Date: 12/19/13
 Project Number: 178600037
 Subject: OPINION OF PROBABLE COSTS
I-55 WB over Cicero (016-0017)

ALTERNATIVE 1 - IN-KIND REPAIRS

QUANTITY CODE	QUANTITY DESCRIPTION	QUANTITY	UNIT COST	TOTAL COST
50300300	Protective Coat	1507 sy	\$2.00	\$3,010
50500105	Furnishing and Erecting Structural Steel	2230 lb	\$5.00	\$11,150
Z0012754	Struct Repair of Concrete (Depth = < 5 Inches)	326 sf	\$175	\$57,050
Z0016001	Deck Slab Repair (Full Depth)	37 sy	\$750	\$27,750
Z0016200	Deck Slab Repair (Partial Depth)	93 sy	\$400	\$37,200
SUB TOTAL =				\$136,160
MOBILIZATION (10%) =				\$13,616
CONTINGENCY (20%) =				\$27,232
TOTAL =				\$177,100

ALTERNATIVE 2 - STRUCTURE WIDENING

QUANTITY CODE	QUANTITY DESCRIPTION	QUANTITY	UNIT COST	TOTAL COST
50102400	Concrete Removal	19 cy	\$600	\$11,100
50104720	Removal Existing Concrete Deck	1 LS	\$154,000	\$154,000
50200100	Structure Excavation	269 cy	\$35.00	\$9,420
50300225	Concrete Structures	201 cy	\$700	\$140,700
50300255	Concrete Superstructure	720 cy	\$800	\$576,000
50300260	Bridge Deck Grooving	2167 sy	\$7.00	\$15,170
50300300	Protective Coat	1883 sy	\$2.00	\$3,770
50500105	Furnishing and Erecting Structural Steel	1 LS	\$337,830	\$337,830
50500505	Stud Shear Connectors	1242 each	\$3.00	\$3,730
50800205	Reinforcement Bars, Epoxy Coated	220200 lbs	\$1.75	\$385,350
51201400	Fur Stl Pile HP10x42	2,800 ft	\$45.00	\$126,000
51203400	Test Pile Stl HP10x42	4 each	\$2,000	\$8,000
52000110	Preformed Joint Strip Seal	352 ft	\$175	\$61,600
52100010	Elastomeric Bearing Assembly, Type I	3 each	\$800	\$2,400
59100100	Geocomposite Wall Drain	46 sy	\$25.00	\$1,150
X2070304	Porous Granular Embankment, Special	62 cy	\$50.00	\$3,100
Z0004552	Approach Slab Removal	160 sy	\$35.00	\$5,600
Z0012754	Struct Repair of Concrete (Depth = < 5 Inches)	326 sf	\$175	\$57,050
Z0026407	Temporary Sheet Piling	1103 sf	\$30.00	\$33,090
Z0046304	Pipe Underdrains for Structures 4"	40 ft	\$20.00	\$800
SUB TOTAL =				\$1,935,860
MOBILIZATION (10%) =				\$193,586
CONTINGENCY (20%) =				\$387,172
TOTAL =				\$2,516,700

Sheet: _____ of _____
 Calc By: JSR Date: 10/9/13
 Check By: BHS Date: 12/19/13
 Project Number: 178600037
 Subject: OPINION OF PROBABLE COSTS
I-55 WB over Cicero (016-0017)

ALTERNATIVE 3 - SUPERSTRUCTURE AND PARTIAL SUBSTRUCTURE REPLACEMENT


CODE	QUANTITY DESCRIPTION	QUANTITY	UNIT COST	TOTAL COST
50101500	Removal of Existing Superstructures	1 LS	\$184,800	\$184,800
50102400	Concrete Removal	331 cy	\$600	\$198,600
50104650	Slope Wall Removal	813 sy	\$7.00	\$5,690
50200100	Structure Excavation	690 cy	\$35.00	\$24,150
50300225	Concrete Structures	350 cy	\$700	\$245,000
50300255	Concrete Superstructure	970 cy	\$800	\$776,000
50300260	Bridge Deck Grooving	2629 sy	\$7.00	\$18,400
50300300	Protective Coat	2455 sy	\$2.00	\$4,910
50500105	Furnishing and Erecting Structural Steel	1 LS	\$1,834,200	\$1,834,200
50500505	Stud Shear Connectors	9144 each	\$3.00	\$27,430
50800205	Reinforcement Bars, Epoxy Coated	312500 lbs	\$1.75	\$546,880
51100100	Slope Wall 4 Inch	606 sy	\$100	\$60,600
51201400	Fur Stl Pile HP10x42	3240 ft	\$45.00	\$145,800
51203400	Test Pile Stl HP10x42	4 each	\$2,000	\$8,000
52100010	Elastomeric Bearing Assembly, Type I	12 each	\$800	\$9,600
59100100	Geocomposite Wall Drain	174 sy	\$25.00	\$4,350
X2070304	Porous Granular Embankment, Special	355 cy	\$50.00	\$17,750
Z0004552	Approach Slab Removal	160 sy	\$35.00	\$5,600
Z0012754	Structural Repair of Concrete (< 5 Inches)	8 sf	\$350	\$2,680
Z0026407	Temporary Sheet Piling	1527 sf	\$30.00	\$45,800
Z0046304	Pipe Underdrains for Structures 4"	188 ft	\$20.00	\$3,760
SUB TOTAL =				\$4,170,000
MOBILIZATION (10%) =				\$417,000
CONTINGENCY (20%) =				\$834,000
TOTAL =				\$5,421,000

ALTERNATIVE 4 - STRUCTURE REPLACEMENT


QUANTITY CODE	QUANTITY DESCRIPTION	QUANTITY	UNIT COST	TOTAL COST
50100100	Removal of Existing Structures	1 LS	\$467,000	\$467,000
50200100	Structure Excavation	993 cy	\$35.00	\$34,760
50300225	Concrete Structures	589 cy	\$700	\$412,300
50300255	Concrete Superstructure	970 cy	\$800	\$776,000
50300260	Bridge Deck Grooving	2629 sy	\$7.00	\$18,400
50300300	Protective Coat	2455 sy	\$2.00	\$4,910
50500105	Furnishing and Erecting Structural Steel	1 LS	\$1,834,200	\$1,834,200
50500505	Stud Shear Connectors	9144 each	\$3.00	\$27,430
50800205	Reinforcement Bars, Epoxy Coated	360300 lbs	\$1.75	\$630,530
51100100	Slope Wall 4 Inch	606 sy	\$100.00	\$60,600
51201400	Fur Stl Pile HP10x42	6,120 ft	\$45.00	\$275,400
51203400	Test Pile Stl HP10x42	4 each	\$2,000	\$8,000
59100100	Geocomposite Wall Drain	174 sy	\$25.00	\$4,350
X2070304	Porous Granular Embankment, Special	355 cy	\$50.00	\$17,750
Z0004552	Approach Slab Removal	160 sy	\$35.00	\$5,600
Z0026407	Temporary Sheet Piling	1527 sf	\$30.00	\$45,800
Z0046304	Pipe Underdrains for Structures 4"	188 ft	\$20.00	\$3,760
SUB TOTAL =				\$4,626,790
MOBILIZATION (10%) =				\$462,679
CONTINGENCY (20%) =				\$925,358
TOTAL =				\$6,014,900

ATTACHMENT H

Proposed Structure Drawings

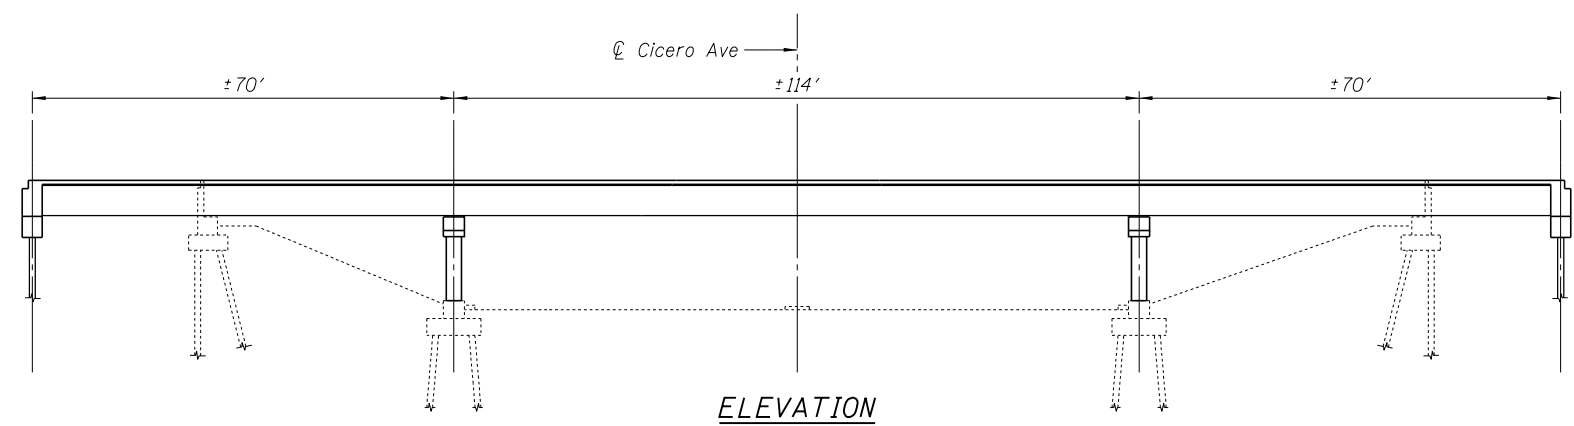

Notes:
 The number and location of substructure units, the profile grade, skew angle, and the bridge length and width are subject to refinement in the TSL phase.
 Superstructure type, beam spacing, and rail type to be determined during the TSL phase.

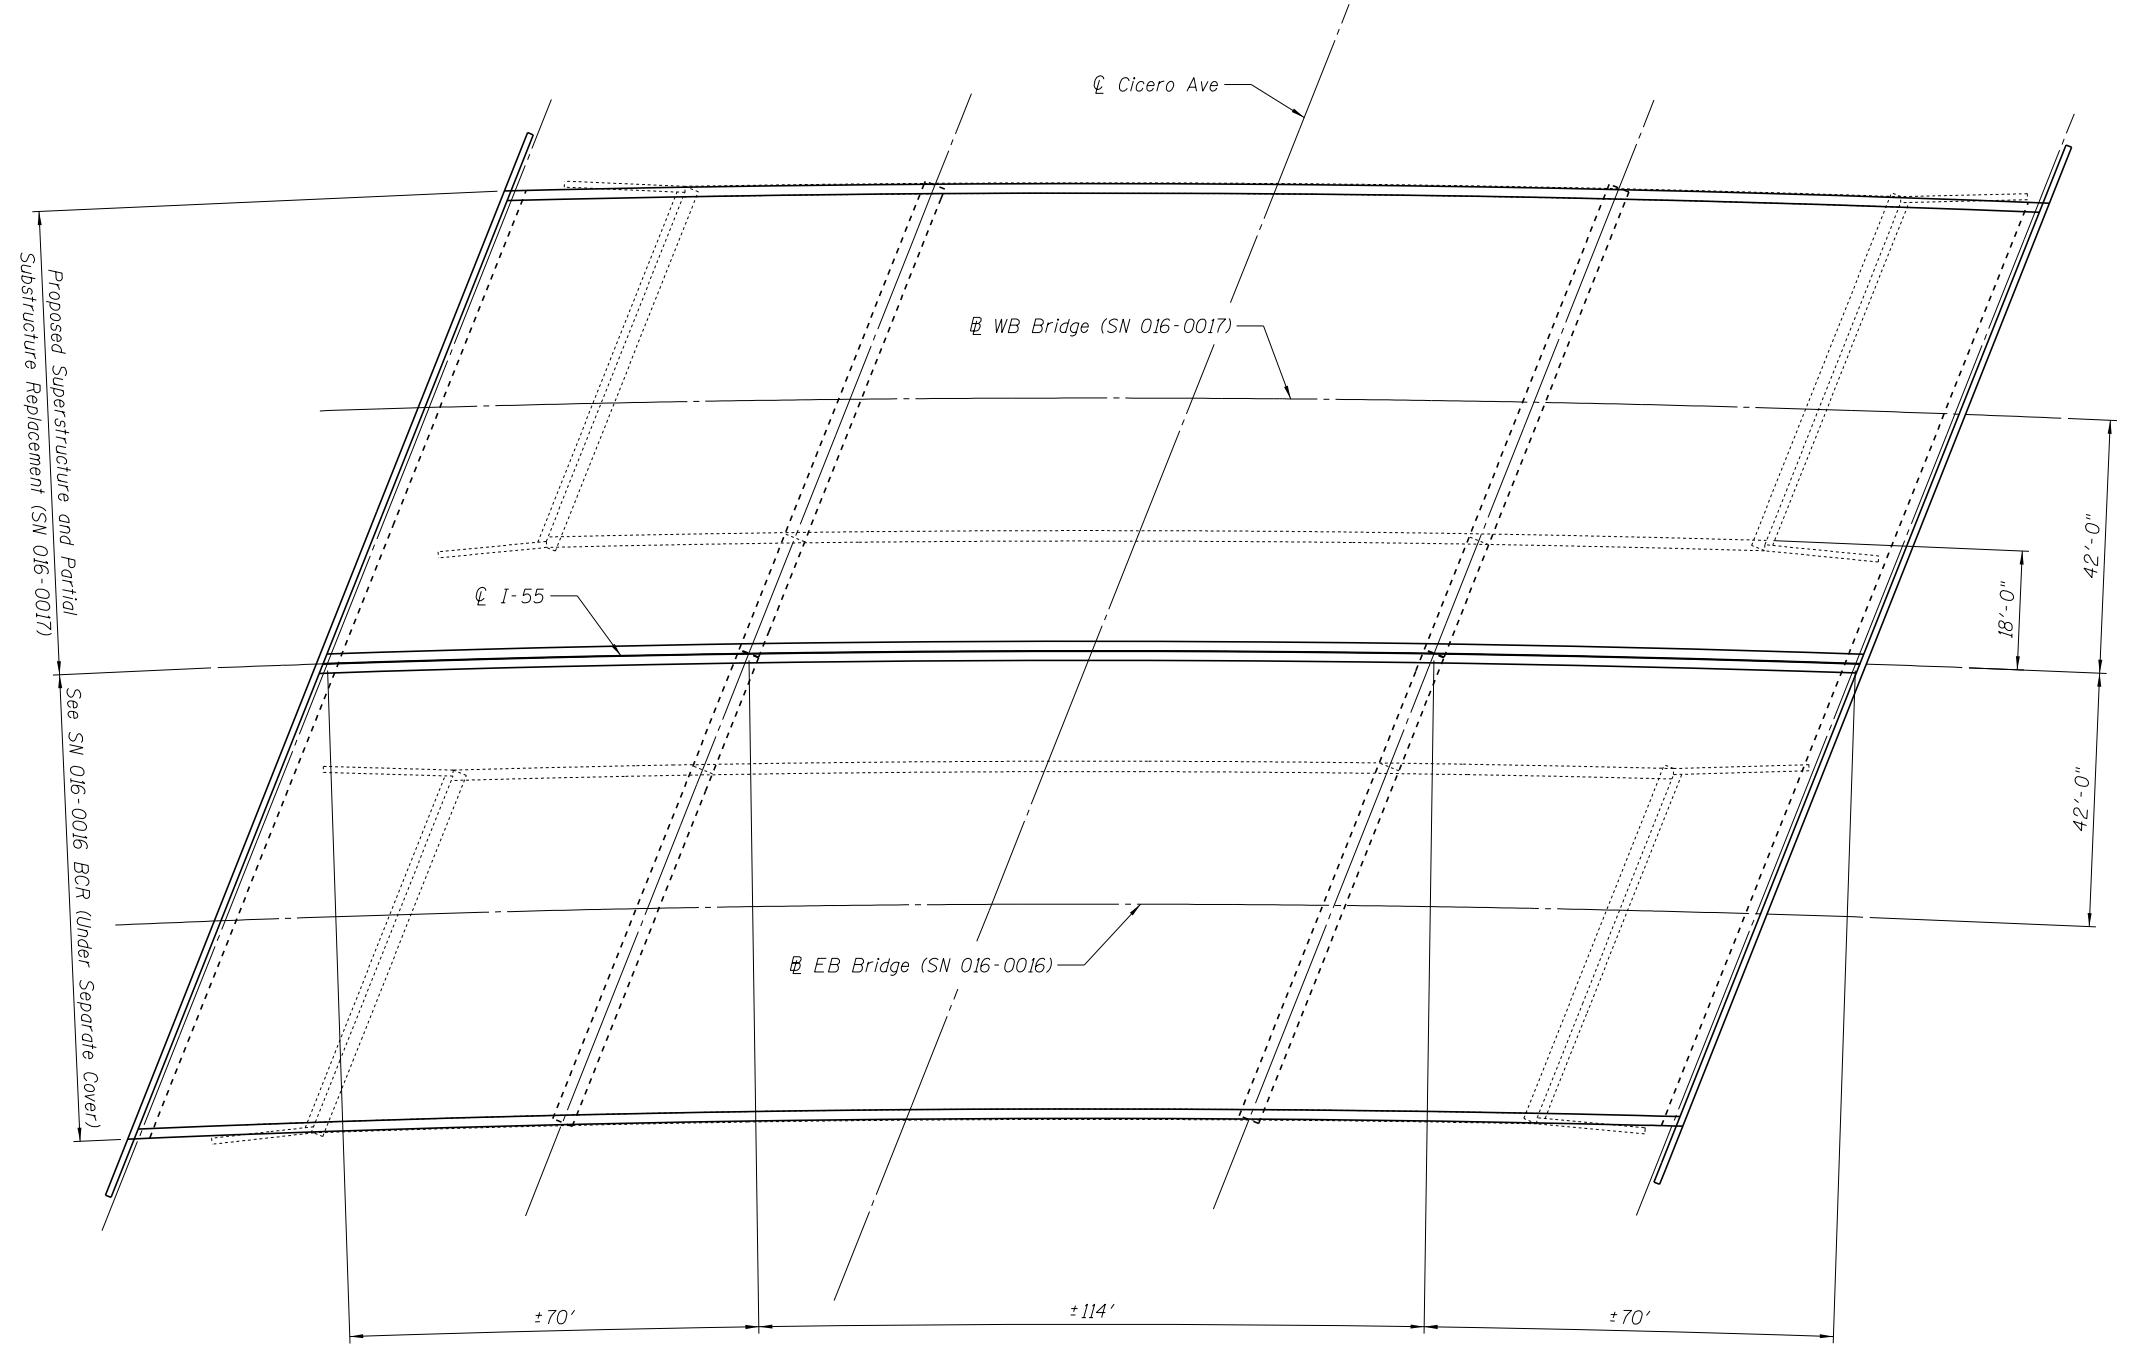

Proposed Superstructure and Partial Substructure Replacement (SN 016-0017)
 See SN 016-0016 BCR (Under Separate Cover)

FILE NAME =



USER NAME = bsogers	DESIGNED - JSR	REVISED -
	CHECKED - BPS	REVISED -
PLOT SCALE = N/A	DRAWN - JSR	REVISED -
PLOT DATE = 12/19/2013	CHECKED - BPS	REVISED -

**STATE OF ILLINOIS
 DEPARTMENT OF TRANSPORTATION**

**ATTACHMENT H – PROPOSED STRUCTURE DRAWING
 STRUCTURE NO. 016-0017**

SHEET NO. 1 OF 1 SHEETS

F.A.I. RTE. = 55	SECTION = 1112-619-HB	COUNTY = COOK	TOTAL SHEETS =	SHEET NO. =
FED. ROAD DIST. NO. 1 ILLINOIS FED. AID PROJECT			CONTRACT NO. =	

ATTACHMENT I

Structure Photos



Photo 1 - Spalling in bay 9, Span 2 , east end, looking west



Photo 2 - Spall underside of deck in Span 3, east end, between beams 1-2 from north, looking west



Photo 3 - Underside of Deck, Span 2, south end, looking east



Photo 4 - Typical discolored concrete and pop off in Span 2, looking east



Photo 5 – Span 3, looking southwest



Photo 6 – Span 2, looking southwest



Photo 7 – Span 1, looking southwest



Photo 8 - East Abutment joint, looking south



Photo 9 - East Pier joint, looking south

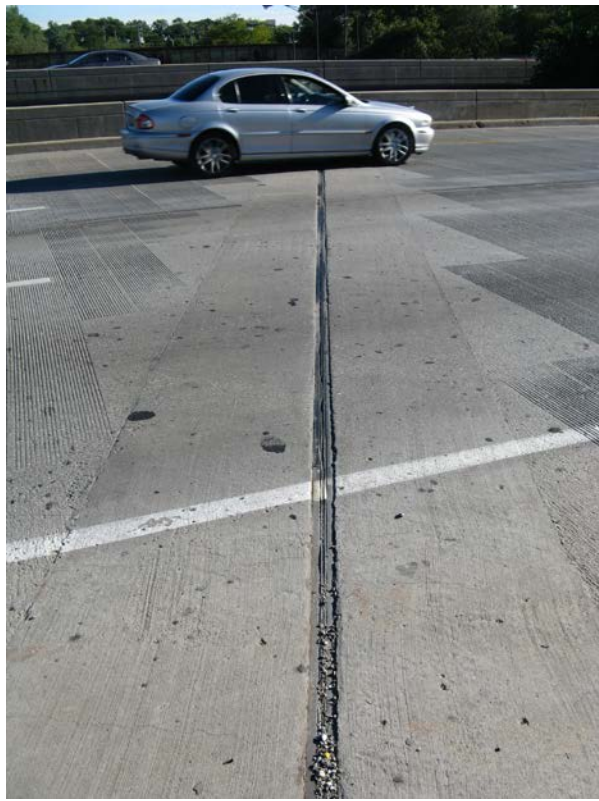


Photo 10 - West Pier joint, looking south



Photo 11 - West Abutment joint, looking south



Photo 12 - Crack in built up pedestal on beam 9 from north at West Pier, west span, looking east



Photo 13 - Close up of photo 12



Photo 14 - Typical cracked weld between bottom flange of beam and built up steel pedestal, Beam 6 at East Abutment, looking southeast



Photo 15 - Typical beam with cover plate in Span 1, Beam 4, looking southwest



Photo 16 – Paint peel on Beam 9 in Span 2, looking east



Photo 17 - South fascia beam, looking west



Photo 18 - North fascia beam, Span 2, looking west



Photo 19 - Failed conduit connections, looking southwest



Photo 20 - Broken conduit from brackets along south fascia beam in Span 1, looking southwest



Photo 21 - Typical end beam bearing, beam 1 from north, West Abutment, looking southwest



Photo 22 - East Abutment, looking east



Photo 23 - West Abutment, looking southwest



Photo 24 - Broken and open conduit on north end of West Abutment, looking south



Photo 25 - Broken conduit at West Abutment backwall in bay 1 from north, looking west



Photo 26 - Spall on West Abutment seat in bay 2 from north, looking east

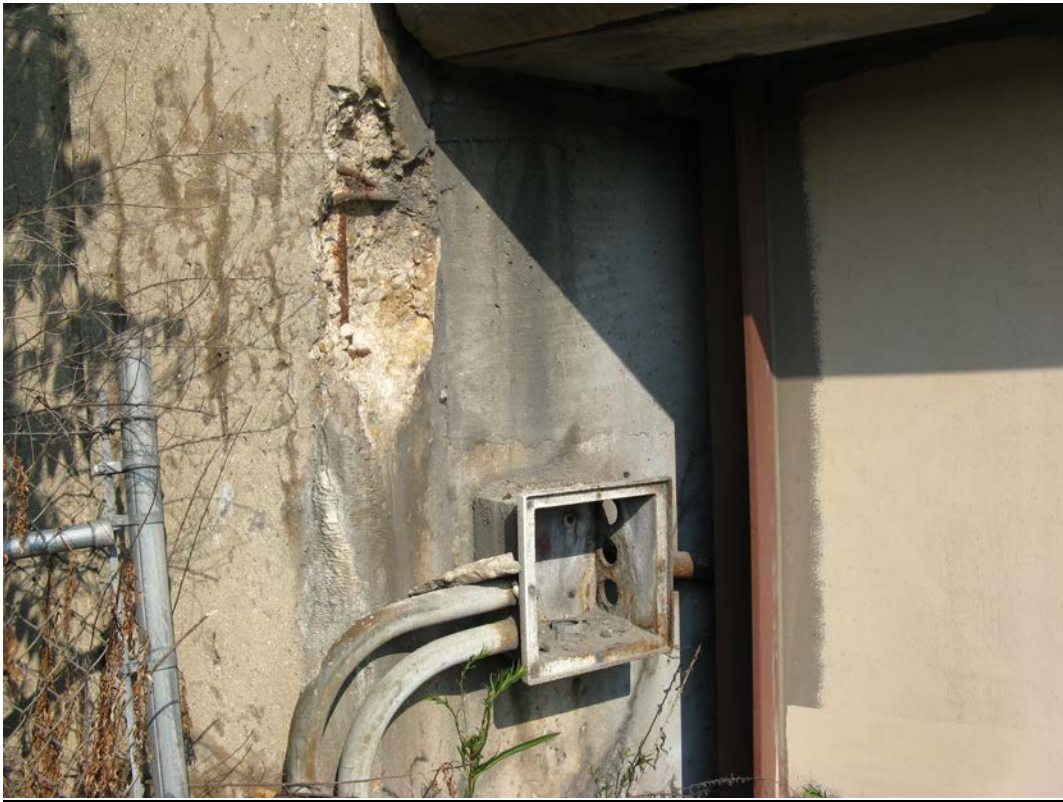


Photo 27 - Spall on front face of West Abutment backwall at south end and open conduit junction box, looking north



Photo 28 - Northwest Wingwall, looking southwest

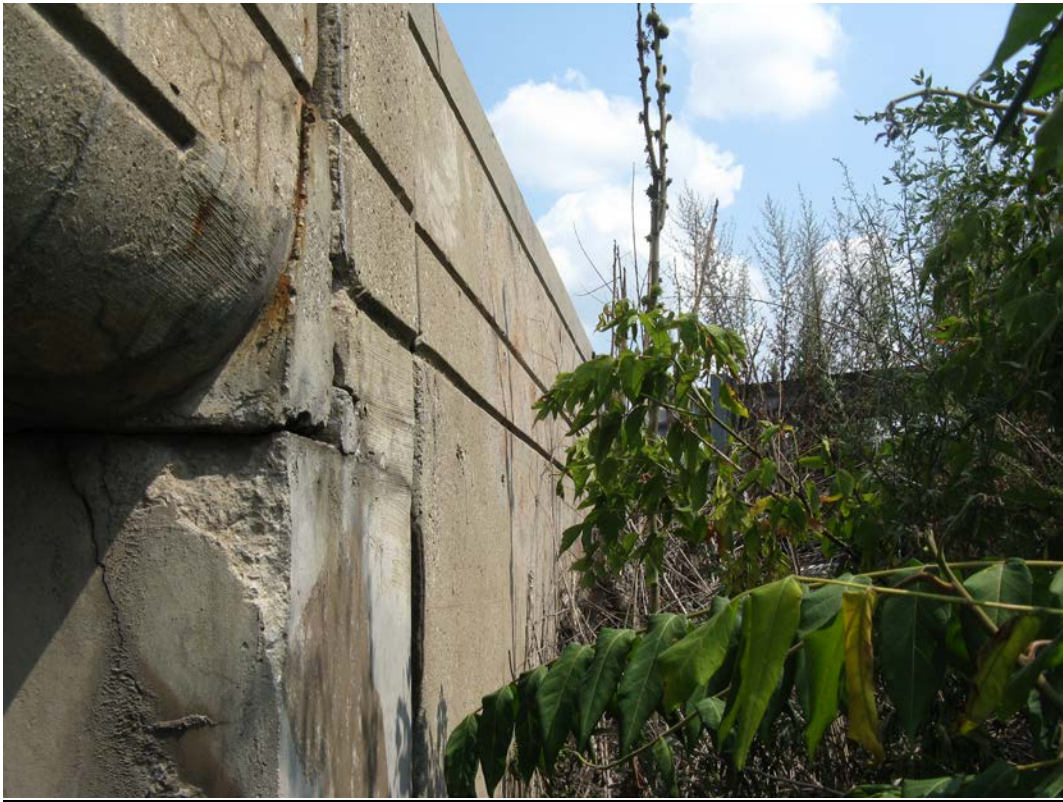


Photo 29 - Southeast Wingwall, looking east



Photo 30 – Southwest wingwall, looking west



Photo 31 – Northeast wingwall, looking southeast



Photo 32 - East Pier, west face, looking east



Photo 33 - East Pier, spall on underside of cap in between columns 3-4 from north, looking up and east



Photo 34 – East Pier, delam on northeast corner, looking southwest



Photo 35 - Spall in East Pier crashwall, north of second column from north, west face, looking southeast



Photo 36 - West Pier, west face, north end, looking northeast



Photo 37 - Spall on West Pier, south face, bottom of fourth column from north, looking north



Photo 38 - North half of east slopewall, looking northeast



Photo 39 – Cracks in north end of west sloped wall, looking southwest


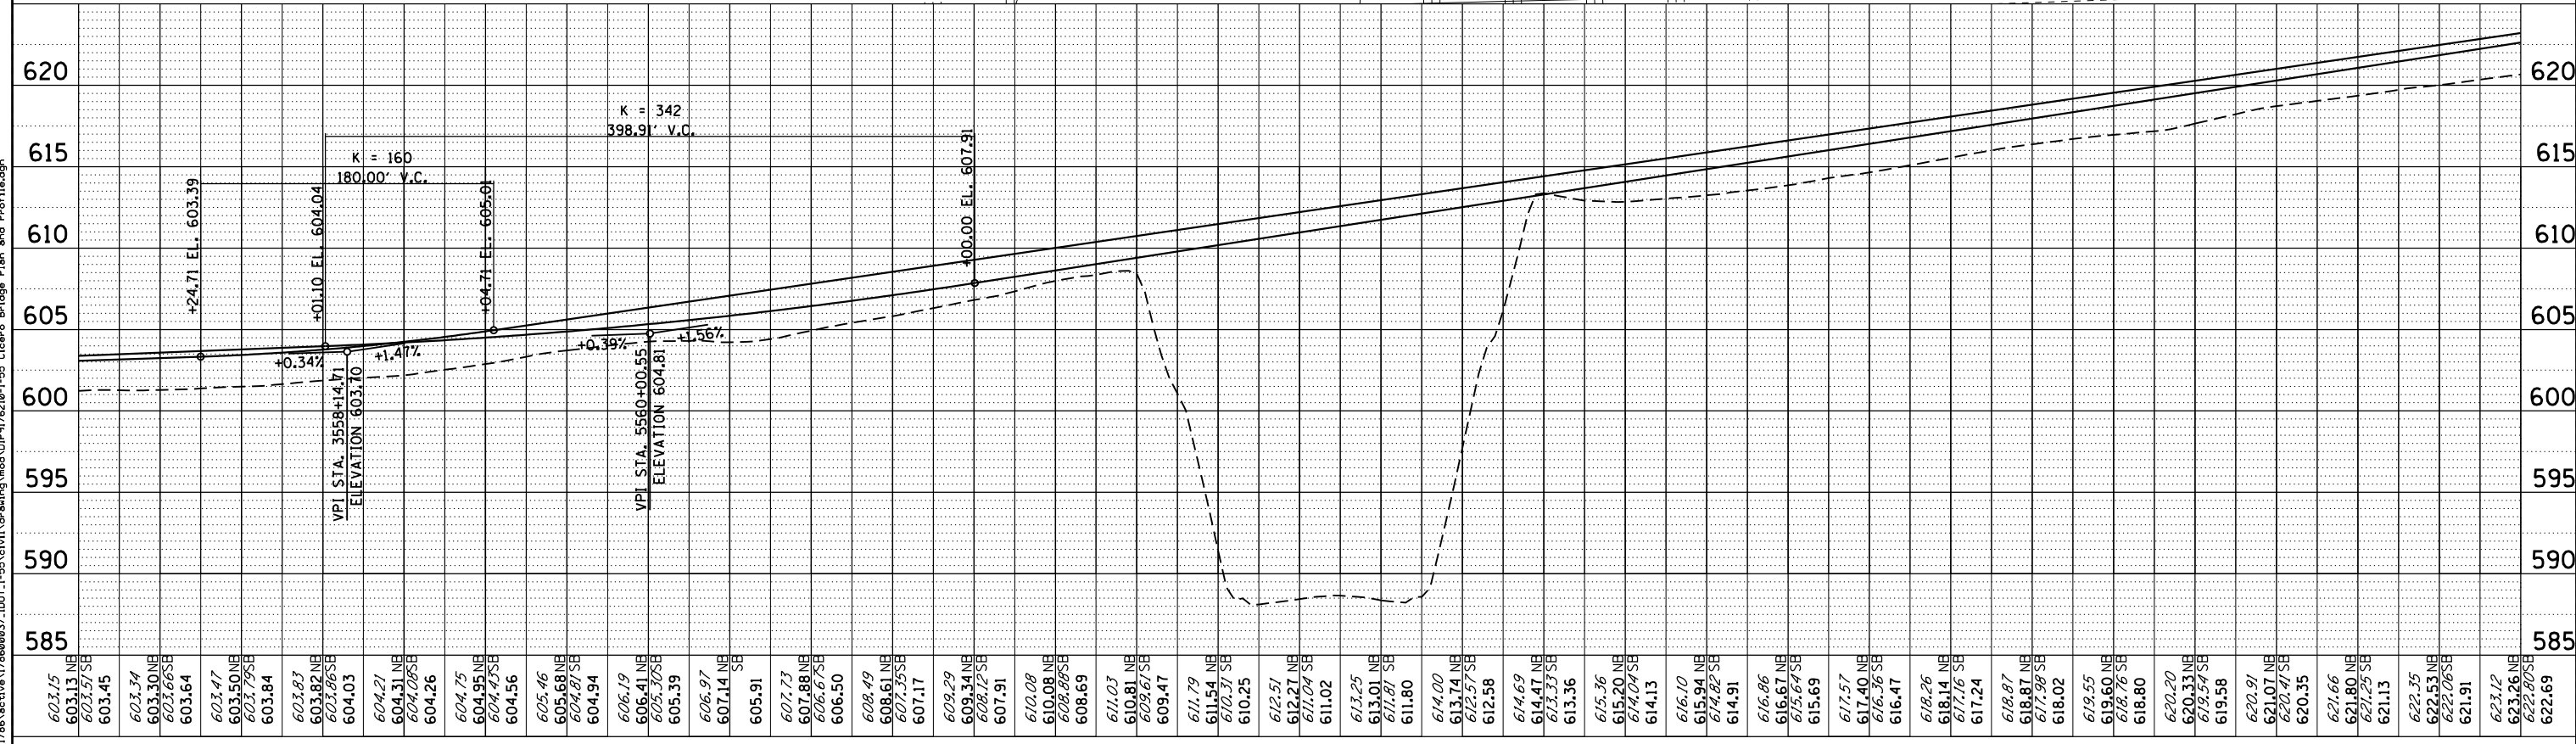


Photo 40 - Spall in west sloped wall, looking west

ATTACHMENT J

Proposed Plan & Profile

FILE NAME = V:\1786\active\178600037_1DOT_I-55\civil\drawing\mod\178600037_1DOT_I-55\civil\drawing\mod\178600037_1DOT_I-55\Cicero Bridge Plan and Profile.dgn

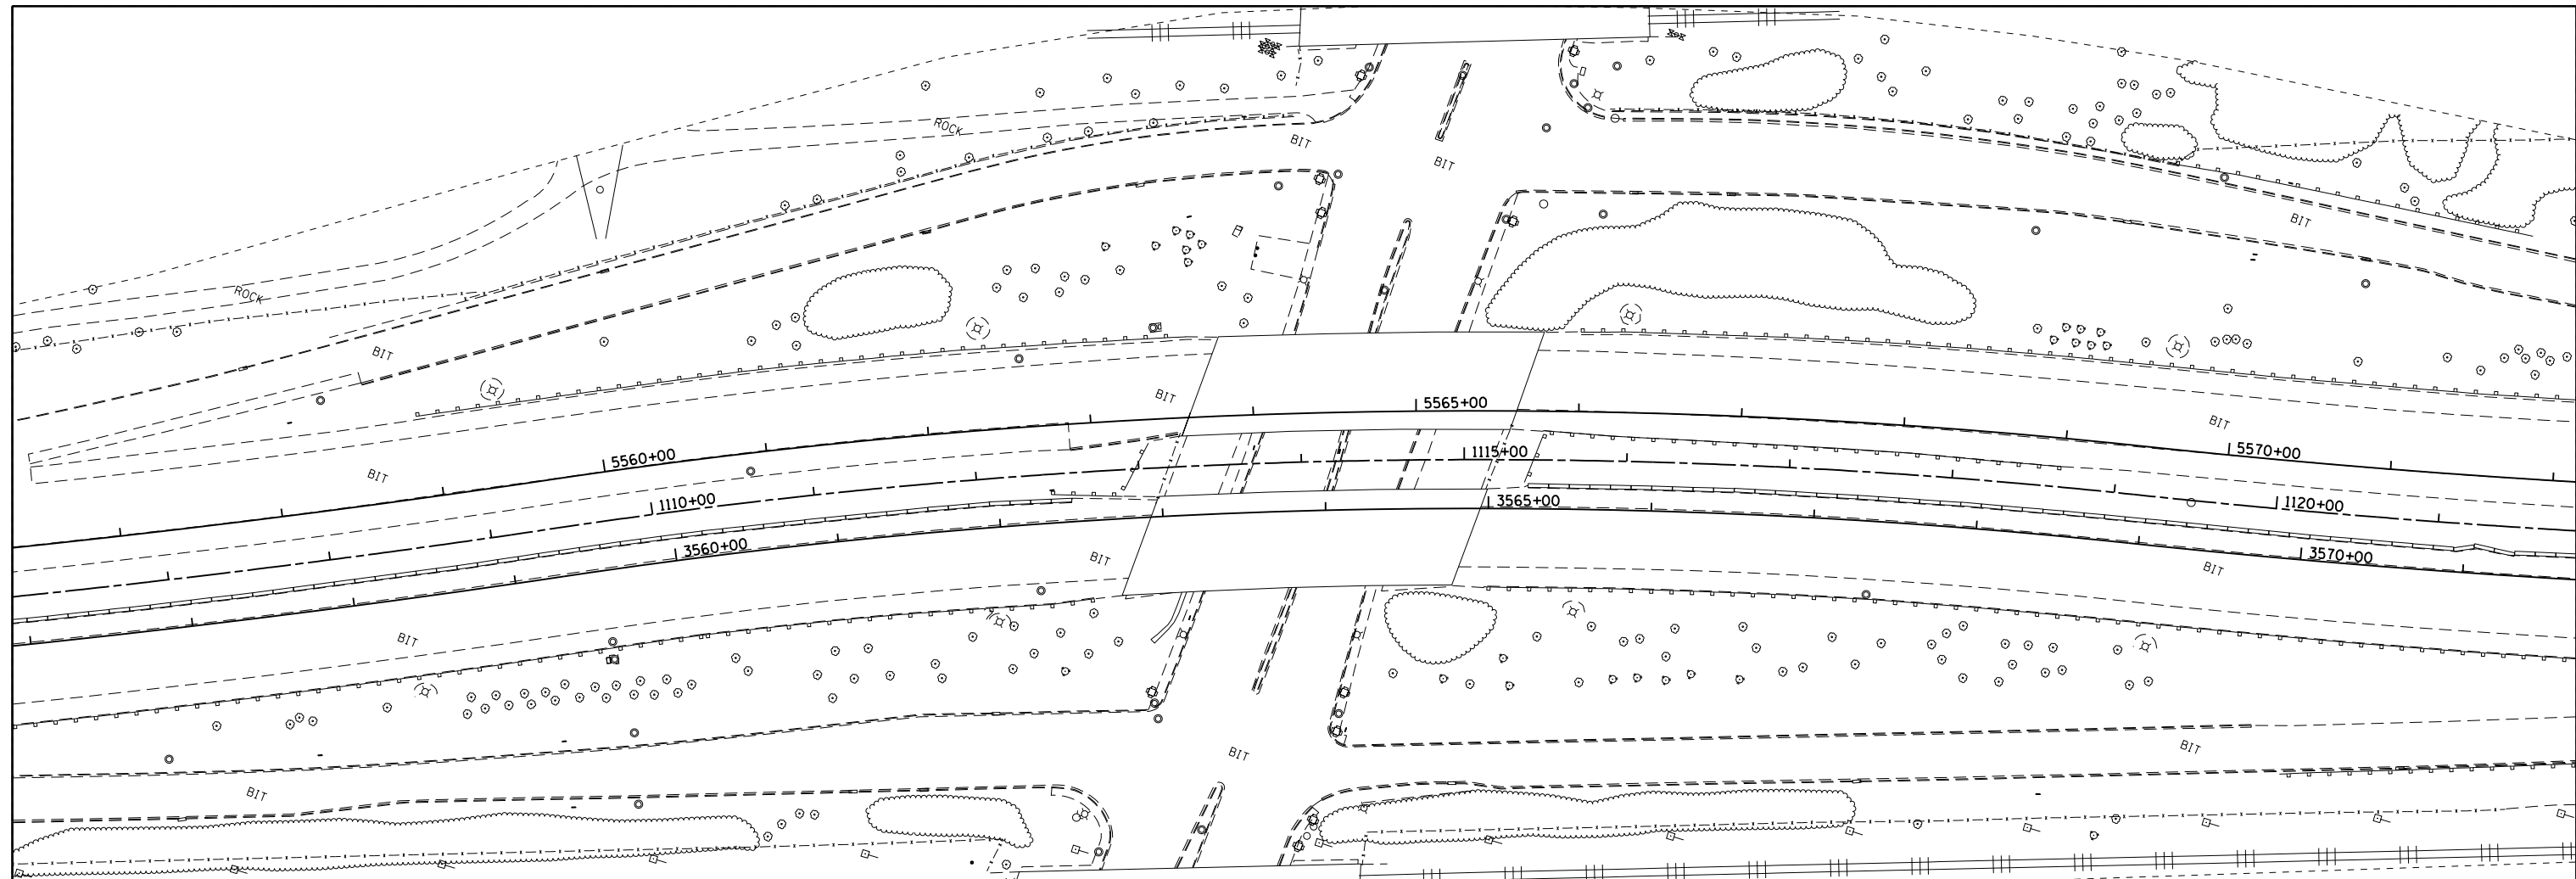

603.15	603.13 NE	603.57 SB	603.45	603.34	603.30 NE	603.65 SB	603.64	603.47	603.50 NE	603.79 SB	603.84	603.83	603.82 NE	603.95 SB	604.03	604.21	604.31 NE	604.09 SB	604.26	604.75	604.95 NE	604.49 SB	604.56	605.46	605.68 NE	604.87 SB	604.94	606.19	606.41 NE	605.37 SB	605.39	606.97	607.14 NE	607.14 SB	605.91	607.73	607.88 NE	606.87 SB	606.50	608.49	608.61 NE	607.39 SB	607.17	609.29	609.34 NE	608.12 SB	607.91	610.08	610.08 NE	608.89 SB	608.69	611.03	611.03 NE	609.67 SB	609.47	611.79	611.54 NE	610.37 SB	610.25	612.51	612.21 NE	611.04 SB	611.02	613.25	613.01 NE	611.81 SB	611.80	614.00	613.74 NE	612.57 SB	612.58	614.69	614.41 NE	613.37 SB	613.36	615.36	615.20 NE	614.04 SB	614.13	616.10	615.94 NE	614.82 SB	614.91	616.86	616.67 NE	615.64 SB	615.69	617.57	617.40 NE	616.36 SB	616.47	618.26	618.14 NE	617.16 SB	617.24	618.87	618.87 NE	617.98 SB	618.02	619.55	619.60 NE	618.76 SB	618.80	620.20	620.33 NE	619.54 SB	619.58	620.91	621.07 NE	620.47 SB	620.35	621.66	621.80 NE	621.29 SB	621.13	622.35	622.53 NE	622.06 SB	621.91	623.12	623.26 NE	622.80 SB	622.69
--------	-----------	-----------	--------	--------	-----------	-----------	--------	



USER NAME = m.j.verheyen	DESIGNED - MJV	REVISED -
PLOT SCALE = 100.0000' / 1in.	DRAWN - STANTEC	REVISED -
PLOT DATE = 10/4/2013	CHECKED -	REVISED -
	DATE - 10/04/2013	REVISED -


STATE OF ILLINOIS
DEPARTMENT OF TRANSPORTATION

ATTACHMENT J	
I-55 OVER CICERO AVE PROPOSED PLAN & PROFILE	
SCALE: 1"=100'	SHEET ___ OF ___ SHEETS STA. _____ TO STA. _____


F.A.I. RTE. 55	SECTION	COUNTY COOK	TOTAL SHEETS	SHEET NO.
CONTRACT NO.				
ILLINOIS FED. AID PROJECT				

ATTACHMENT K

**Existing and Proposed Roadway Cross
Sections**

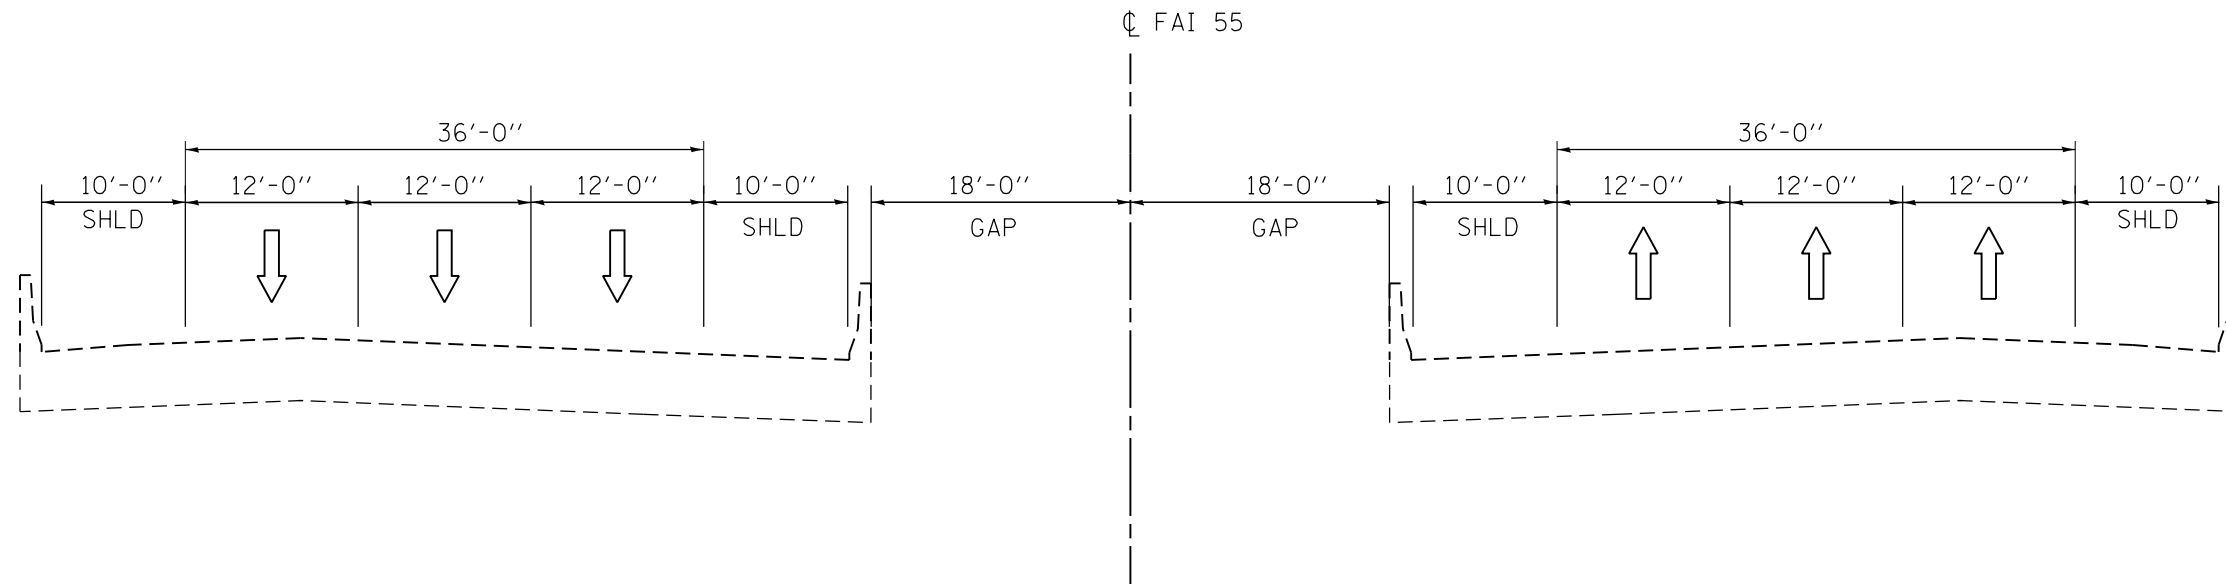

EXISTING I-55 OVER CICERO AVE TYPICAL SECTION

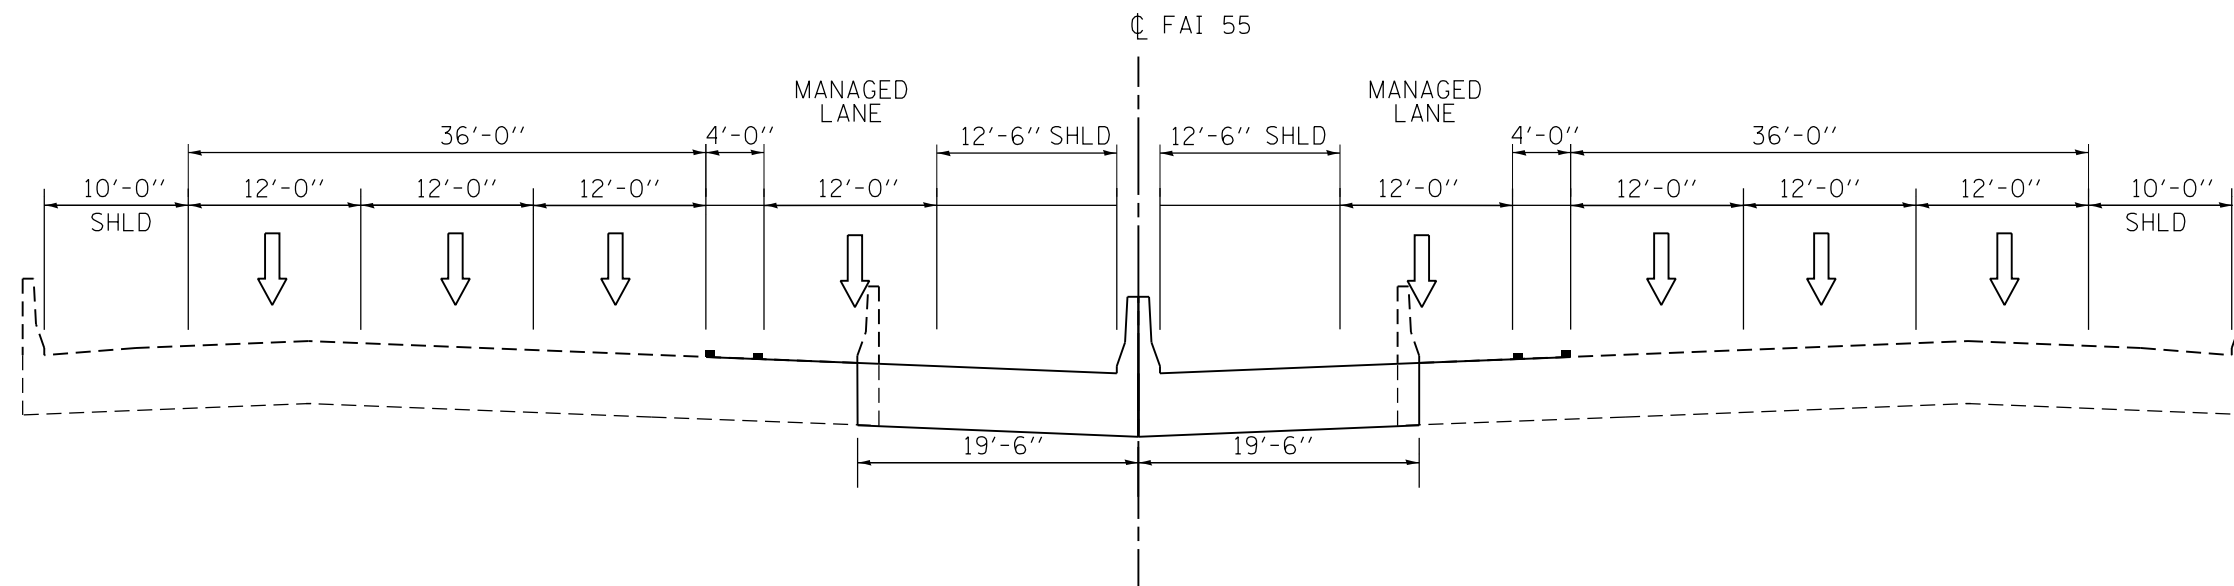

PROPOSED I-55 OVER CICERO AVE TYPICAL SECTION

FILE NAME = V:\7865\active\786500037_IDOT_I-55\civ1\drawing\mod\IP176210-typical-sections\Cicero Ave and RR Structure.dgn



USER NAME = mjverheyen	DESIGNED - MJV	REVISED -
	DRAWN - STANTEC	REVISED -
PLOT SCALE = 13.3343' / 1in.	CHECKED -	REVISED -
PLOT DATE = 10/7/2013	DATE - 10/7/2013	REVISED -

STATE OF ILLINOIS
DEPARTMENT OF TRANSPORTATION

ATTACHMENT K
TYPICAL SECTIONS



SCALE: SHEET 1 OF 2 SHEETS STA. TO STA.

F.A.I. RTE.	SECTION	COUNTY	TOTAL SHEETS	SHEET NO.
55		COOK		
CONTRACT NO.				
ILLINOIS FED. AID PROJECT				


ATTACHMENT L

Abbreviated Existing Plans

F.A.I. RITE	SECTION	EXPRESSWAY	TOTAL SHEETS	SHEET NO.
55	1112-619-MB	SOUTHWEST	32	2C
STA. 23+02.91		TO STA. 25+40.38		
FED. ROAD DIST. NO. 7		ILLINOIS FED. AID PROJECT 1-65-7(29)-281		

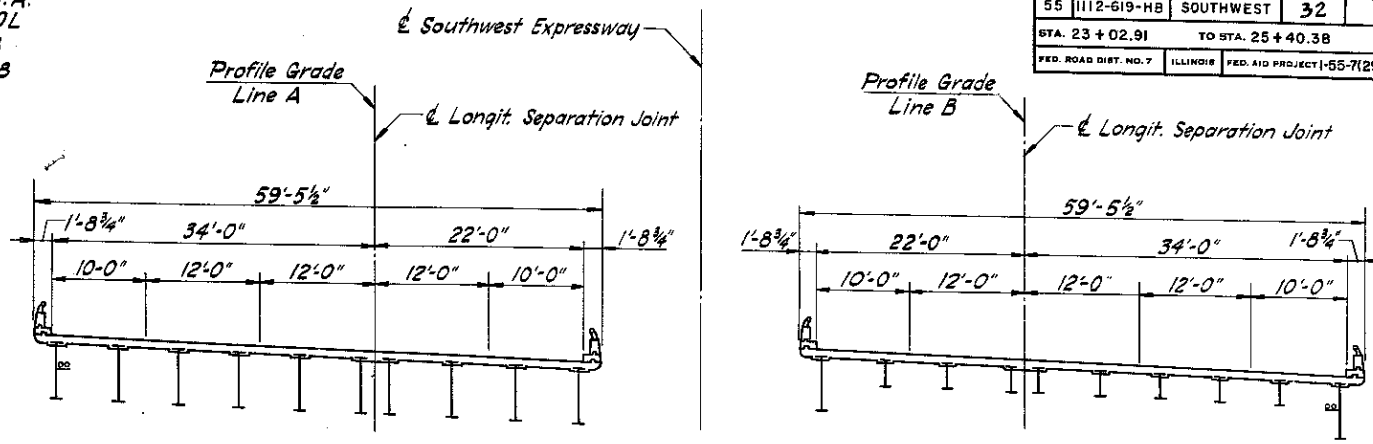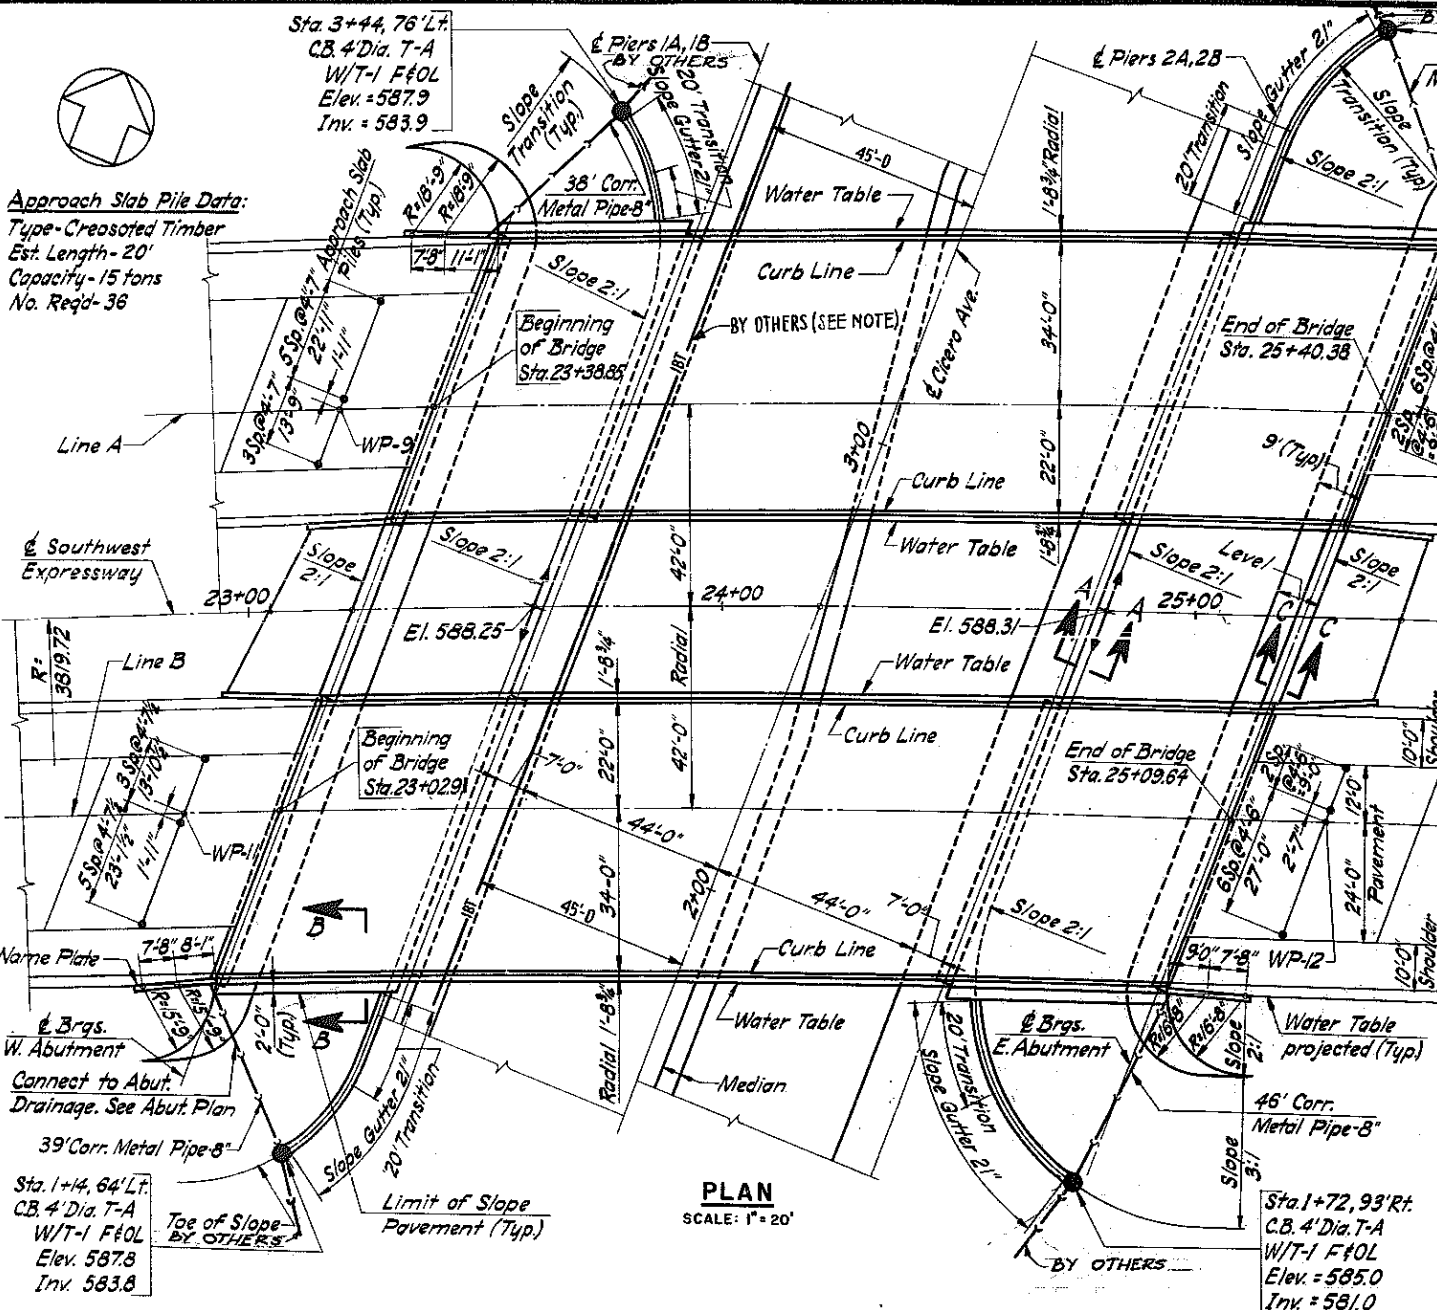

CODE NUMBER	ITEM	UNIT	QUANTITY				
			BRIDGE A		BRIDGE B		TOTAL for 2 Bridges
			Sub.	Super.	Sub.	Super.	
016001	Embankment	Cu. Yds.	14620	—	18,260	—	32,880
019001	Porous Granular Embankment	Cu. Yds.	636	—	618	—	1,254
050001	Class "A" Excavation for Structures	Cu. Yds.	256	—	256	—	512
052003	Class "X" Concrete	Cu. Yds.	470.5	3080	471.2	3090	1,558.7
052021	Protective Coat	Sq. Yds.	—	1449	—	1,454	2,903
054001	Furn. & Erect Struct. Steel	Lbs.	—	496,970	—	498,710	995,680
059001	Reinforcement Bars	Lbs.	62380	78,510	64,470	78,510	283,870
060004	Furnishing Creosoted Piles (up to 20')	Lin. Ft.	360	—	360	—	720
060008	Driving Timber Piles	Lin. Ft.	360	—	360	—	720
060043	Driving Concrete Piles	Lin. Ft.	4335	—	4,425	—	8,760
060044	Furnishing Concrete Piles	Lin. Ft.	4,335	—	4,425	—	8,760
060047	Test Pile Concrete	Ea.	2	—	2	—	4
061001	Name Plates	Ea.	—	1	—	1	2
063001	Corrugated Metal Pipe, 8"	Lin. Ft.	85	—	85	—	170
063020	Perforated Corrugated Metal Pipe, 6"	Lin. Ft.	165	—	165	—	330
075015	C.B. T.A. 4' Dia. T.F. & Open Lid	Ea.	2	—	2	—	4
083002	Slope Wall 4 inch	Sq. Yds.	813	—	719	—	1,532
L02710	Rigid Steel Conduit, 2" Dia.	Lin. Ft.	—	440	—	440	880
L02738	Rigid Steel Conduit, 2 1/2" Dia.	Lin. Ft.	40	—	30	—	70
L02766	Rigid Steel Conduit, 1 1/2" Dia.	Lin. Ft.	—	10	—	20	30
Z08008	Aluminum Handrail	Lin. Ft.	76	403	76	404	959

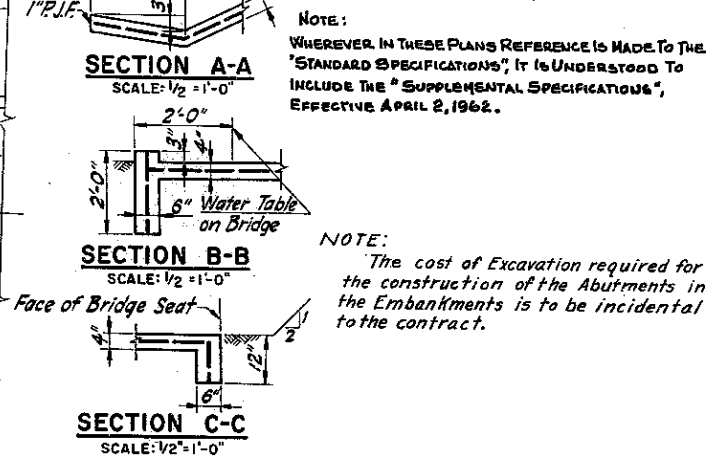

GENERAL NOTES

CONCRETE:

- Coarse aggregate to be used in parapet handrails and end posts must be absolutely free of chert, flint, limonite, lignite and soft sandstone.
- The concrete floor slab shall be finished in accordance with article 51.19 of the standard specifications.
- Sloped wall shall be reinforced with welded wire fabric 6"x6" mesh weighing 58 #/per 100 sq. ft.
- All reinforcement bars shall be lapped 20 diameter: unless otherwise shown.
- Permanent forms will not be permitted in forming the concrete floor.
- Class X concrete shall be used throughout.

STRUCTURAL STEEL:

- Rivets 3/4" φ open holes 1/16" φ unless otherwise noted.
- Anchor bolts shall be set before riveting diaphragms over supports.
- Roadway expansion guards shall be assembled in the shop in proper position with the ends in place and shall be left assembled for shop inspection.
- The following surfaces of the expansion guard shall be given two shop coats of red lead paint: the outside vertical 4" legs of the Ls 6x4x1/4.
- Expansion guards are included in the quantity of structural steel estimated weight 16,560 lbs. Bridge A and 16,610 lbs. Bridge B.
- Except as otherwise provided all structural steel shall receive one shop coat of red lead paint and two field coats of aluminum paint. See article 56.1 to 56.5 inclusive of the standard specifications and the special provisions.
- Structural carbon steel shall conform to specifications for carbon steel A.S.T.M. designation A-36.

SUBSTRUCTURE:

- The contractor shall drive 4 concrete test piles in a permanent location shown on the pier and abutment footing plans as directed by the engineer before ordering the remainder of the piles.
- Concrete piles at abutments shall be driven in holes precored through the embankment.

This work shall be done in accordance with article 60.9(c) of the standard specifications.

TWO SIGNS CONFORMING TO STD. 2160-1 SHALL BE ERRECTED AT LOCATIONS SHOWN ON THE PLANS (SHEET 2B)

UTILITIES:


1. The proposed Illinois Bell Telephone Co. line will be in place prior to beginning bridge construction.

DESIGN LOADS AND STRESSES

Specifications: A. A. S. H. O., 1961
Design Load: H20-S16-44 & alternate
25 psf Future wearing surface

Design Stresses: Structural Steel: F = 20,000 psi
Reinforcement Steel: F = 20,000 psi
Concrete: Fc = 3,500 psi
Ft = 1,400 psi
Fv = 1,000 psi (with earth pressure)
Fv = 75 psi (Footings)
n = 10

Piling: Concrete = 30 ton capacity
Creosoted Timber = 15 ton capacity

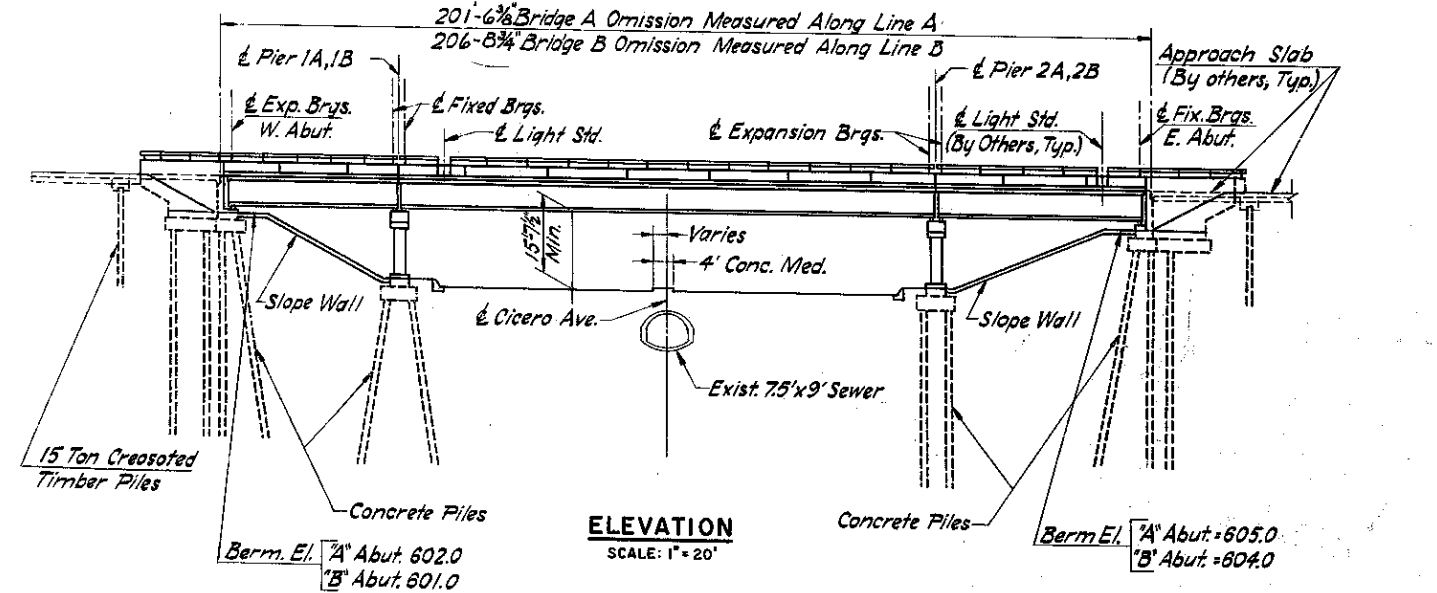

REVISIONS	
NAME	DATE


ILLINOIS DIVISION OF HIGHWAYS
SOUTHWEST EXPRESSWAY
EXPRESSWAY OVER CICERO AVE.

GENERAL PLAN


SCALE: HORIZ. AS NOTED
VERT. AS NOTED
DRAWN BY M. Casone
DATE: DEC. 1962
CHECKED BY S. Rouse

Rev. Removed 200 cu yd Special Excav. Rev. C17A Excav. 1080 to 572 cu yd - Added Metal Handrail Type E - 859 lbs. 3-25-63 Rev. Wt. for E & E.S.S. 433 2903 lbs. 4/1/63


SECTION	EXPRESSWAY	TOTAL SHEETS	SHEET NO.
55	1112-619-HB	SOUTHWEST	52
STA. 23+02.91	TO STA. 25+40.38		
ILLINOIS		FED. AID PROJECT	

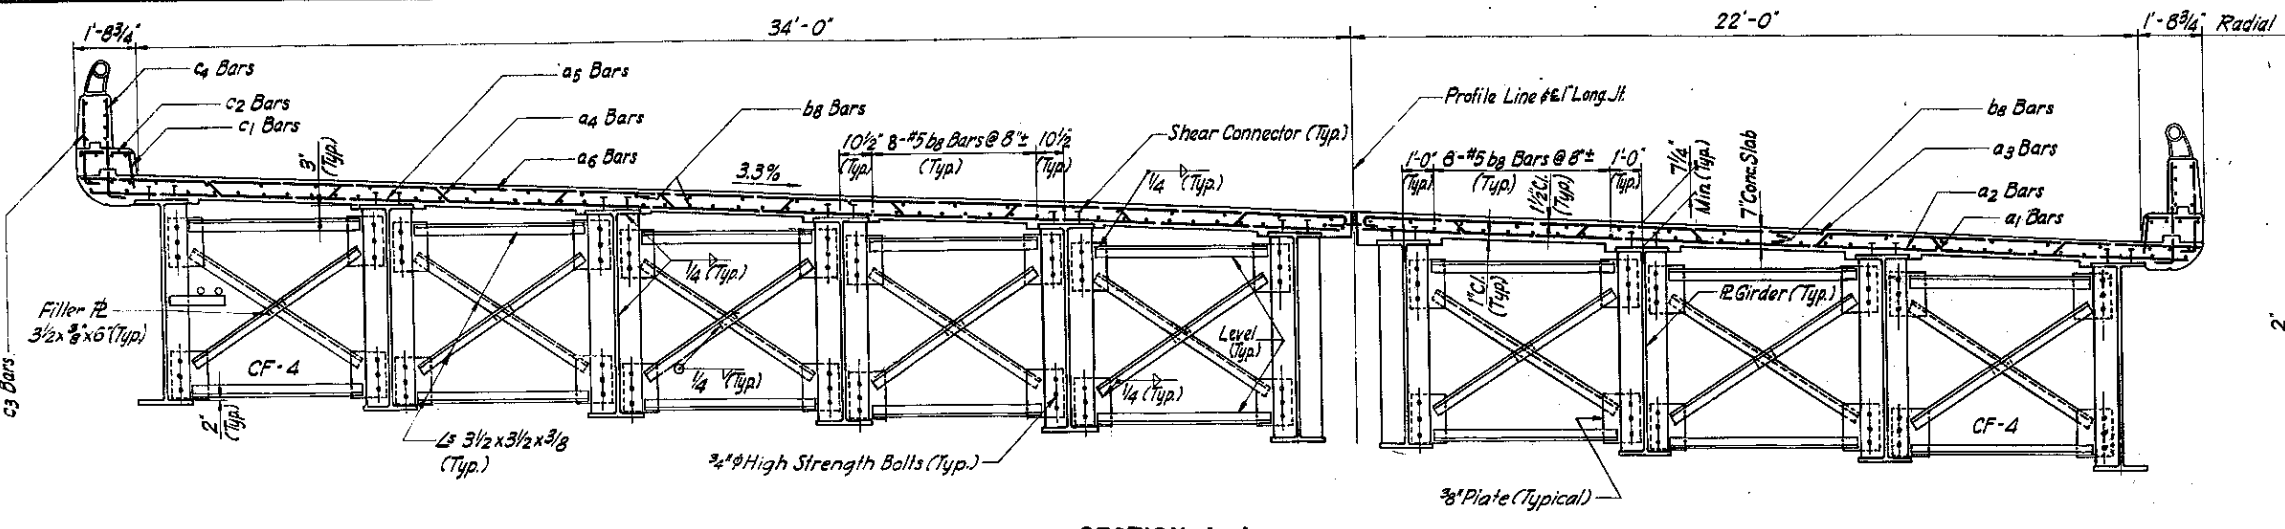


SECTION A-A
SCALE: 3/8" = 1'-0"

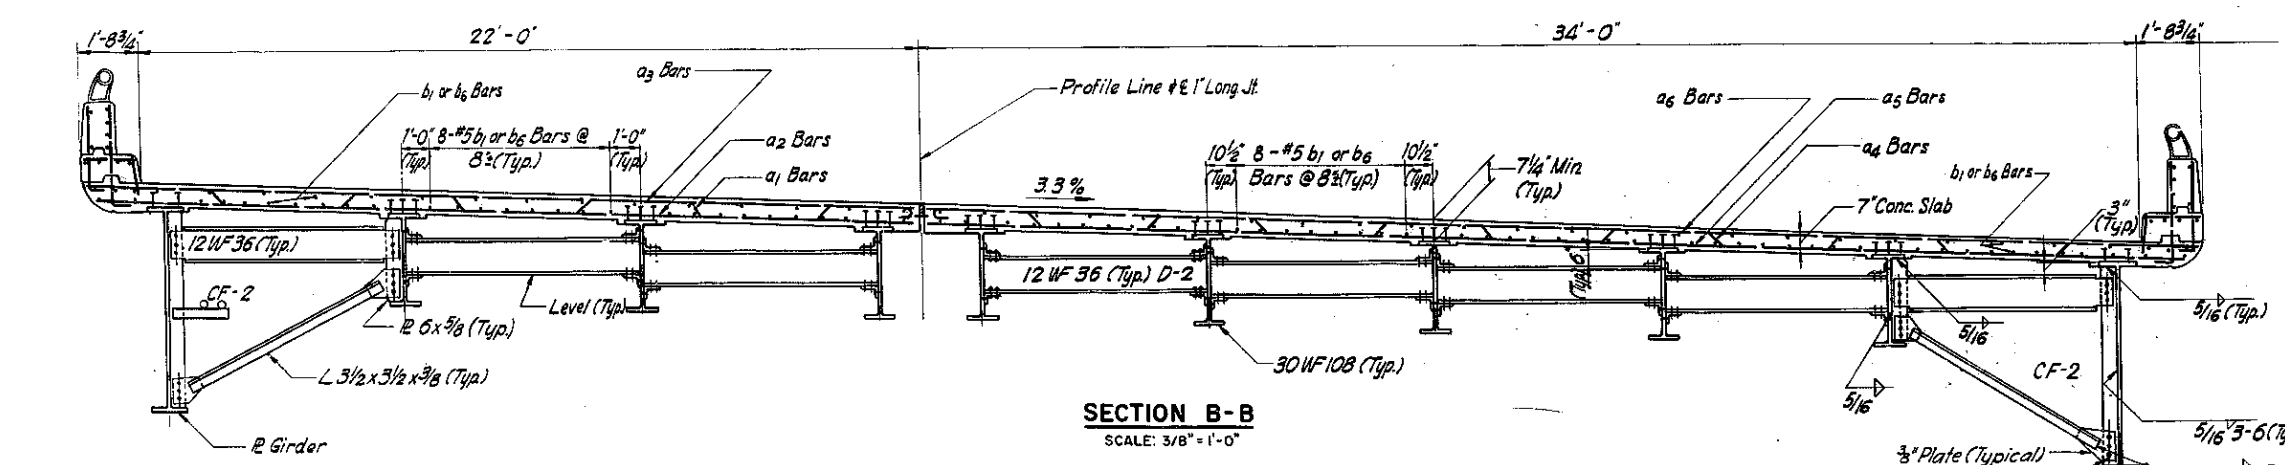


SECTION B-B
SCALE: 3/8" = 1'-0"

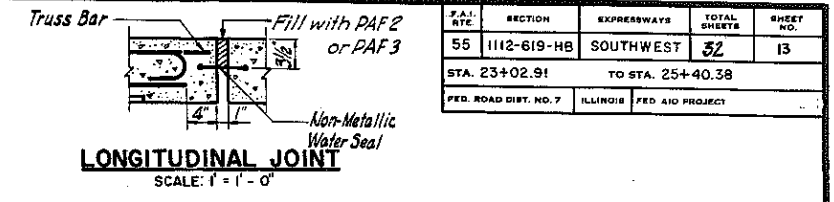

LONGITUDINAL JOINT
SCALE: 1" = 1'-0"

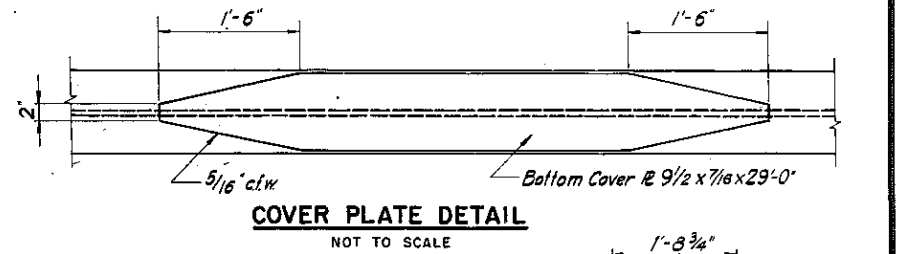


COVER PLATE DETAIL
NOT TO SCALE

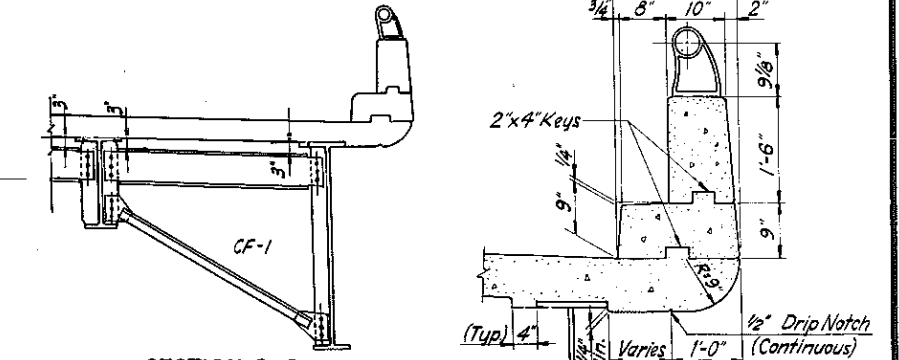

SECTION G-G
SCALE: 3/8" = 1'-0"

FASCIA DETAILS
SCALE: 3/4" = 1'-0"

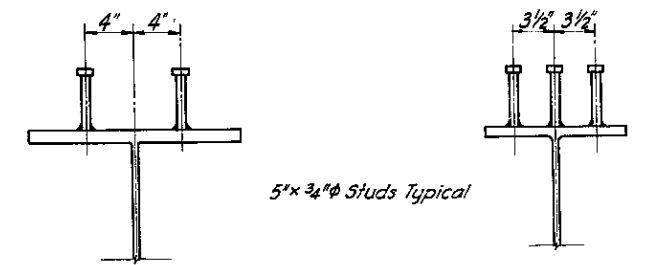


SHEAR CONNECTOR DETAILS
SCALE: 1/2" = 1'-0"


(Weight of studs included in Structural Steel Quant.)

NOTES:


1. For location of sections A-A & B-B, see sheet 12.
2. Section A-A shown for Bridge A, Bridge B similar except for stringer layout and spacing.
3. Section B-B shown for Bridge B, Bridge A similar except for stringer layout and spacing.
4. Use 3/4 inch rivets, except as otherwise noted.

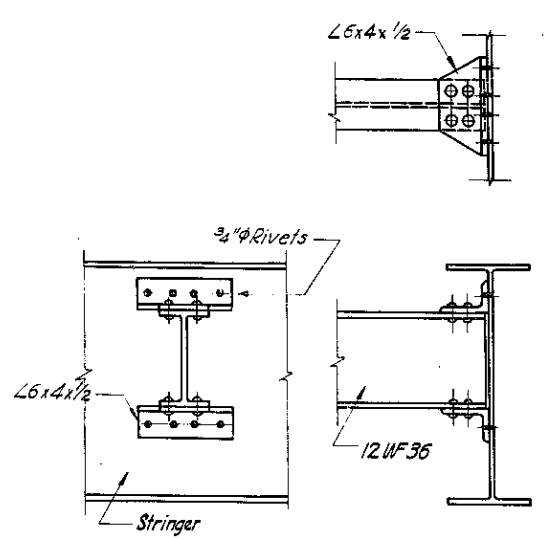


DIAPHRAGM D-2 CONNECTION DETAIL
SCALE: 1" = 1'-0"

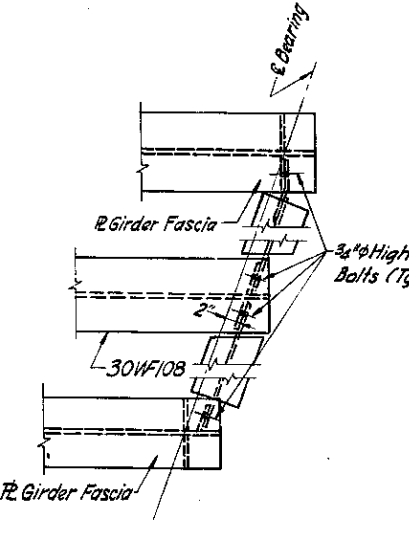


END DIAPHRAGM DETAILS AT ABUTMENT
SCALE: 3/4" = 1'-0"

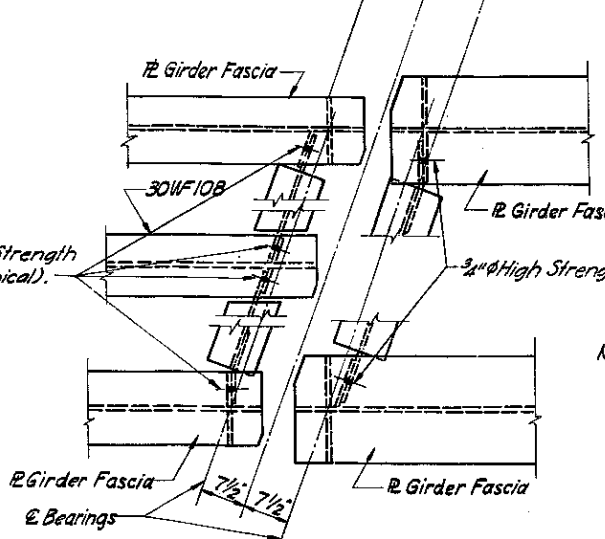

END DIAPHRAGM DETAIL AT PIERS
SCALE: 3/4" = 1'-0"

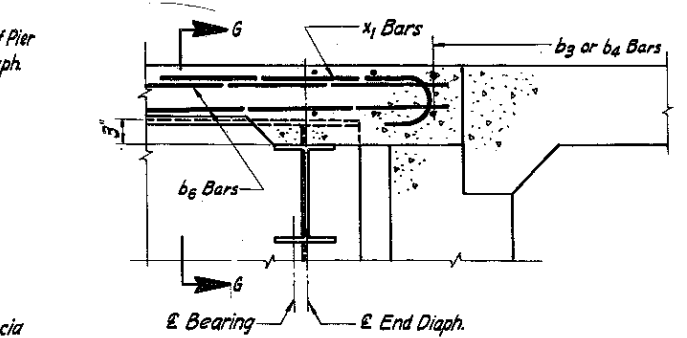

SECTION AT EAST ABUTMENT
SCALE: 1" = 1'-0"

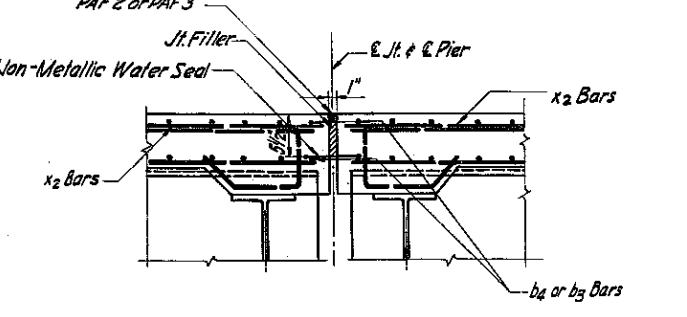

SECTION AT FIXED JOINT
SCALE: 1" = 1'-0"

REVISIONS	
NAME	DATE

ILLINOIS DIVISION OF HIGHWAYS
SOUTHWEST EXPRESSWAY
EXPRESSWAY OVER CICERO AVE.

SUPERSTRUCTURE DETAILS

SCALE: HORIZ. AS NOTED
VERT. AS NOTED
DATE: DEC, 1962

DRAWN BY J. White
CHECKED BY G. Harris

BRIDGE CONDITION REPORT

REGION: 1

DISTRICT: 1

ROUTE: FAI 055/ I-55 EB

COUNTY: Cook

JOB NUMBER: P-91-762-10

STRUCTURE NUMBER: 016-0018

LOCATION: I-55 Eastbound over RR-BRC



PREPARED BY:  **Stantec**

DATE PREPARED: 12/20/13

PROPOSED LETTING DATE: To Be Determined

TABLE OF CONTENTS

I. GEOGRAPHICAL & ADMINISTRATIVE DATA.....	1
II. PHYSICAL DESCRIPTION OF STRUCTURE	1
III. FIELD INSPECTION & PHYSICAL EVALUATION.....	3
IV. POTENTIAL SCOPE OF WORK DETERMINATION & ANALYSIS.....	7
V. DISCUSSION AND RECOMMENDED SCOPE OF WORK	8
VI. FINAL RECOMMENDATION.....	10
VII. TRAFFIC STAGING	10

ATTACHMENTS:

- A. Location Map
- B. IDOT Master Structure Report
- C. Bridge Inspection Report
- D. Bottom of Deck Condition Survey
- E. Condition Assessment of the Reinforced Concrete Bridge Deck
- F. Substructure Condition Surveys
- G. Opinion of Probable Costs
- H. Proposed Structure Drawings
- I. Structure Photos
- J. Proposed Plan & Profile
- K. Existing and Proposed Roadway Cross Sections
- L. Abbreviated Existing Plans

I. GEOGRAPHICAL & ADMINISTRATIVE DATA

Structure Number:	016-0018
County:	Cook
Route Carried:	FAI 055 / I-55
Feature Crossed:	RR-BRC
Section:	1212-620-VB
Station:	25+03.37

Roadway Classification:	Federal Aid Interstate
Design/Posted Speed:	70mph / 55mph
*ADT (current/design):	86,748 (2012) / 120,186 (2040)
*ADTT (current/design):	13% = 11,277 (2012) / 13% = 15,624 (2040)
*DHV (current/design):	5,053 (2012) / 7,601 (2040)
Inventory Rating HS:	1.070 – rated 11/05/01
Operating Rating HS:	1.680 – rated 11/05/01
Sufficiency Rating:	84.0
HBP Eligibility:	No

* Traffic data per the I-55 Managed Lane Phase I Study

Construction / Reconstruction / Repair History

The structure carrying I-55 Eastbound over the BRC Railroad (RR-BRC) was originally built in 1963 as FAI Route 55 over RR-BRC under Project IG-55-7(34) 281, Section 1212-620-VB. The original construction consisted of parallel three span structures. The two structures carried I-55 eastbound and westbound traffic.

As part of Contract 82944, plans dated 12/15/95, pin and link replacement was performed. As part of Contract 80059, bridge rehabilitation was performed in 1999. The rehabilitation consisted of removing the bituminous concrete overlay, performing deck repairs, removing and replacing the transverse deck joints, eliminating the longitudinal deck joint, placing a new deck concrete overlay, refurbishing the bearings, cleaning and painting the existing steel bridge and repairing the substructure and slopewall.

II. PHYSICAL DESCRIPTION OF STRUCTURE

The physical description of the structure is based on a review of the existing available plans dated 9/13/63, 12/15/95, and 1999. Refer to Attachment L for select existing structure plan sheets. Individual components of the existing structure are described below:

Structure Type and Length: The bridge is a flared three span wide flange structure with pin and link assemblies in Spans 1

and 3. The exterior beams are W36x135 in Spans 1 and 3. All the interior beams are W27x114 in Spans 1 and 3. The W-beams used in Span 2 are W36x150 with a 1" thick cover plate outside of the bottom flange. The bridge is 168'-2" long measured from back-to-back of abutment. The substructure consists of two reinforced concrete stub abutments with wingwalls and two multi-column reinforced concrete piers. The abutments are supported by concrete piles and the piers are supported on creosoted timber piles. The bridge has a 7" reinforced concrete deck plus overlay.

Number / Length of Spans: There are a total of three spans, with approximate lengths as follows (dimensioned from centerline of bearing to centerline of bearing). Spans are numbered from west to east.

Span 1: 42'-0"
Span 2: 80'-0"
Span 3: 42'-0"

Skew: 22°-00'-23" Left

Structure Width: The total width varies from approximately 81'-1" to 84'-6" measured out-to-out of the deck. The bridge accommodates three 12' lanes of traffic, a ramp lane with variable gore, a 10' inside shoulder, a 5' outside shoulder, and a curb and parapet on each side.

Expansion Joints: W Abutment: 1 3/4" Preformed Joint Seal
Pier 1: 2" Neoprene Joint
Pier 2: 2" Neoprene Joint
E Abutment: 1 3/4" Preformed Joint Seal

Bearings: W Abutment: Fixed
Pier 1: Fixed
Pier 2: Expansion
E Abutment: Fixed

Approach Roadway Template: The approach roadway template matches the bridge with three 12' lanes of traffic, a ramp lane with variable gore, a 10' inside shoulder, and a 5' outside shoulder. The width of the west approach roadway is wider than the east approach roadway due to the variable gore/ramp lane.

Existing Wearing Surface:	2 3/8" Micro Silica Concrete Overlay
Existing Vertical Alignment:	The structure is located on a 1,000-ft. long vertical crest curve with 1.50% and -0.80% slopes going from west to east. The entire structure is located in the -0.80% slope region.
Existing Horizontal Alignment:	The structure is on a horizontal tangent section.
Existing Vertical Clearance:	23'-0" min over BRC Railroad according to the 1999 repair plans.
Existing Drainage:	No existing drainage exists on the structure or approach slabs.
Parapets and Railings:	There are 1'-8 3/4" wide exterior curb and parapets running the length of the bridge. Parapets were modified in 1999 plans to remove a 9" tall by 1'-0" wide existing handrail and replaced with a 9" tall x 1'-0" wide reinforced concrete section. Per the IDOT Bridge Inspection Report dated 12/10/12, the guardrail currently meets acceptable standards while the guardrail ends and transitions do not.
Existing Utilities Attachments:	There are no light poles attached to the bridge, but there is conduit running along the south parapet.
Name Plate:	The two name plates are located on the inside face of the northeast and southwest wingwalls.

III. FIELD INSPECTION & PHYSICAL EVALUATION

A field inspection of the entire structure carrying I-55 Eastbound over the BRC Railroad was performed by Stantec on September 16, 2013. The high temperature on that date was 65° F. The visual field inspection was performed on foot on the slopewall and the top of deck. The following conditions were observed:

Deck

Deck

The deck was rated in fair condition (NBIS Rating = 5) in the 12/10/12 NBIS inspection. The deck condition observed during this inspection was consistent with the NBIS rating. The underside of deck has multiple areas of delamination, spalling and map cracking. Based on visual inspection, approximately 6.0% of the underside of deck is delaminated or spalled.

The micro-silica concrete overlay on the top of deck has minor hairline transverse and longitudinal cracking mostly along the shoulders. Wiss, Janey and Elstner performed a condition assessment of the reinforced bridge deck in July 2011. This assessment included a delamination survey performed on the top of the bridge deck using infrared thermography. The infrared thermography indicated 4.6% of the top of deck area was delaminated. See Attachment E for the condition assessment of the reinforced bridge deck. See Attachment I – Photos 1 through 7.

Parapets

The parapets are in satisfactory condition with hairline vertical cracking throughout and minor delaminations and spalls on the interior face of the parapet. The interior face of the South Parapet has approximately 20 square feet of delaminated concrete. The exterior face of the North parapet has approximately 5 square feet of spalled concrete and the exterior face of the South Parapet has approximately 32 square feet of spalled concrete. See Attachment I - Photos 8 and 9.

Joints

The preformed joint seals at the abutments and the neoprene joint at the piers are in satisfactory condition with debris in the joint and minor impact damage on the joints. The width of the joints was measured when the temperature was approximately 65° F. The preformed joint at the West Abutment measured ¾” wide. The neoprene joint at the West Pier measured 1 9/16”. The neoprene joint at the East Pier measured 1 7/16”. The preformed joint at the East Abutment measured 3/4”. See Attachment I – Photos 10 through 13.

Superstructure

Beams

The superstructure consists of three spans of variable sized rolled steel beams. The beam lines are numbered 1 through 14, numbered from north to south. In Spans 1 and 3, Beam Lines 1 and 14 consist of W36x135 beams and Beam Lines 2 through 13 consist of W27x114 beams. In Span 2, all of the beam lines consist of W36x150 beams. This structure has pin and link assemblies in Spans 1 and 3 and welded cover plates on the bottom flanges of the beams in Span 2.

The superstructure was rated in fair condition (NBIS Rating = 5) in the 12/10/2012 NBIS bridge inspection due to initial section loss and minor pitting. The superstructure observed during this inspection was consistent with the NBIS rating.

The steel superstructure typically has paint starting to fail, minor rust and initial section loss and minor pitting. The pin and link assemblies were visually inspected from the ground and no defects were noted. The 12/10/2012 NBIS inspection used an under bridge inspection unit to do a close up inspection of the pin and link assemblies and no defects were noted. See Attachment C for the Bridge Inspection Report. The steel beams have welded cover plates with fatigue category E' details. The welded cover plates were visually inspected from the ground and no defects were noted on the welds. See Attachment I – Photos 14 through 17.

Bearings

The steel rocker expansion bearings are in satisfactory condition with paint starting to fail and minor rust. No excessive tilting was noted during the inspection. See Attachment I – Photo 19.

Utilities

There is an abandoned utility box on the underside of deck in Span 3 at the south end of the span. See Attachment I – Photo 18.

Substructure

The substructure was rated in satisfactory condition (NBIS Rating = 6) in the 12/10/2012 NBIS bridge inspection due to cracks and spalls at the abutment caps and pier columns. The substructure condition observed during this inspection was consistent with the NBIS rating.

Abutments

The reinforced concrete abutments are in satisfactory condition with multiple vertical cracks that vary in widths from hairline to 3/8" wide. The length of the 1/16" or wider vertical cracks is approximately 23' on the East Abutment and 3' on the West Abutment. There is 2 square feet of spalled concrete on the East Abutment. See Attachment F for the Substructure Condition Survey. See Attachment I – Photo 20 and 21.

Piers

The reinforced concrete piers each consist of seven columns with a pier cap. The piers are in satisfactory condition with minor delaminations and spalls on the columns and pier caps. Pier 1 has approximately 69 square feet of spalled or delaminated concrete. Pier 2 has approximately 8 square feet of spalled or delaminated concrete. See Attachment F for the Substructure Condition Survey. See Attachment I – Photo 22 through 25.

Slope Protection

The bridge has concrete slope walls. The East Slopewall has approximately 50' of transverse cracking. The West Slopewall has approximately 20'

transverse cracking along the bottom. At the southeast corner of the West Slopewall, there is an area approximately 40' long by 8' wide that has settled 3" away from the rest of the slopewall. The East Slopewall has a void at the on the north end approximately 15' west of the abutment. The extent of the void was unable to be determined but the embankment next to the slopewall was not eroded away. See Attachment I – Photo 26.

Inspection History (NBIS Ratings)

Year	Deck	Super	Sub
2012	5	5	6
2011	5	6	6
2009	5	6	6

Geometric, Horizontal & Vertical Clearance / Hydraulic Data

Geometry

I-55 Eastbound over RR-BRC is on a 22°-00'-23" skew left. The typical roadway section consists of three 12' lanes, a variable width ramp gore/lane, a 10' inside shoulder, a 5' outside shoulder, a 1'-8 3/4" wide curb and parapet on each side of the structure. The structure is located on a 1,000-ft. long vertical crest curve with 1.50% and -0.80% slopes going from west to east. The entire structure is located in the -0.80% slope region. The structure is on a horizontal tangent section. The repair plans from 1999 show the vertical minimum clearance at 23'-0" from top of rail to bottom of steel.

The top of rail profile for the RR-BRC at for the west track slopes upwards at a +0.08% slope going north.

As part of the I-55 Managed Lane Phase I Study, I-55 Eastbound at the BRC Railroad will be widened to the inside to accommodate a proposed 12' managed lane eastbound. In the eastbound direction, a 4' buffer between the managed lane with 12.5' shoulder and the general purpose traffic lanes is proposed in this 60 foot median section. This widening will be incorporated into the recommended scope of work for this structure.

Hydraulics

At the structure, the I-55 profile is on a vertical crest curve with the crest of the curve at the location of the structure. The bridge deck goes through superelevation transitions with the center lane and outside lane level 15' east of the back of the West Abutment. The bridge deck achieves normal crown with the center lane at 1% and the outer lane at 2% on the bridge deck approximately 9' west of the East Abutment. There are no deck drains on the bridge deck. Therefore, the water is allowed to flow to the deck joints as it runs off the bridge.

IV. POTENTIAL SCOPE OF WORK DETERMINATION & ANALYSIS

As part of the I-55 Managed Lane Phase I Study, In-Kind Repairs, Structure Widening and Structure Replacement alternatives will be evaluated.

Per Section 2.4.2.4 of the IDOT Bridge Manual, consideration was given to retrofit all end of cover plate locations due to average daily truck traffic. From this information, it was determined that a fatigue evaluation was required. The transverse welds at the ends of the cover plates in Span 2 were evaluated for fatigue life and it was determined that the mean service life is less than 50 years. A cover plate retrofit should be installed.

Repainting the bridge was considered due to the paint starting to fail. All Bridge Designers Memorandum 10.1 states that structures over railroads will typically be cleaned and painted only at deck joints and at the fascia girders. As the paint system is only starting to fail, zone painting was determined not to be necessary at this time for both alternatives.

Since all alternatives would have work being performed near the railroad tracks, the cost of Railroad Protective Liability Insurance should be considered in the opinion of probable costs.

1. In-Kind Repairs

Perform partial and full depth deck repairs and apply Protective Coat to the existing deck. Repair areas of spalled or delaminated concrete on existing abutments and wingwalls. Perform retrofit repairs on the existing Span 2 cover plates. Fill the void under the slopewall at the northwest corner.

2. Structure Widening

Remove and replace the concrete deck and approach slabs and widen both approximately 18' to the centerline of I-55. Remove both the northeast and northwest wingwalls and build an extension onto the north side of both abutments. Build an extension onto the north side of both piers. Install 3 new beam lines using W27 and W36 steel beams with pin and link assemblies that will be composite to the widened bridge deck. The new W36 beam will be larger sections than the existing W36 to compensate for the omission of a bottom flange cover plate. Perform retrofit repairs on the existing Span 2 cover plates. Repair areas of spalled or delaminated concrete on existing abutments and wingwalls. Fill the void under the slopewall at the north end and repair the southeast corner.

3. Superstructure and Partial Substructure Replacement

Remove and replace the existing steel beam superstructure with galvanized W36 continuous steel beams. Remove and replace pier

caps, but reuse the existing pier columns and footings. Build an extension onto the north side of both piers. Replace the existing abutments with integral abutments placed behind the existing abutments. Replace concrete slope walls. The deck geometry will accommodate the proposed roadway geometry from the I-55 Managed Lane Phase I Study.

4. Structure Replacement

Remove and replace the entire structure with a continuous three-span galvanized steel W-shape beam superstructure on integral abutments. The deck geometry will accommodate the proposed roadway geometry from the I-55 Managed Lane Phase I Study.

V. DISCUSSION AND RECOMMENDED SCOPE OF WORK

The opinion of probable costs for each of the alternatives is summarized below. See Attachment G for the opinion of probable costs breakdown.

- 1. In-Kind Repairs – \$248,800**
- 2. Structure Widening – \$2,629,900**
- 3. Superstructure and Partial Substructure Replacement – \$4,676,600**
- 4. Structure Replacement – \$5,809,600**

Per the I-55 Managed Lane Phase I Study, the managed lane is expected to be implemented in 2020. All widening and replacement alternatives below assume the proposed structure will provide a 6'-0" outside shoulder, one 16'-0" ramp lane, a variable width gore, three 12'-0" general purpose traffic lanes, a 4' buffer between the general purpose traffic lanes and the 11'-0" managed traffic lane and a 12'-6" inside shoulder.

Analysis of Alternative 1 – The calculated percent of deck area requiring full depth repairs is 6.0% and the partial depth repairs is 8.0%. The total deck repair percentage is within the 25% limit presented in the Bridge Condition Report Procedures and Practices Manual for deck repair to be cost effective for a deck not being widened. This alternative can be used to extend the life span of the existing superstructure in the interim prior to implementing the changes required for the Managed Lane project.

Analysis of Alternative 2 – This alternative widens the structure approximately 18' to the centerline of I-55 to accommodate the new managed lane. The calculated percent of deck area requiring full depth repairs is 6.0% and partial depth repairs is 8.0%. Since this deck is 50 years old and has a recommended repair area at the upper limit (15%) presented in the BCR Procedures and Practices Manual for deck repair to be cost effective for a widened deck, it is recommended to replace the deck at the time of widening.

The existing pin and link assemblies were evaluated for elimination by making the structure continuous. This was considered not practical as it would require replacing the W27 beams in Spans 1 and 3 and replacing the existing abutments to account for the deeper beams. Instead, the pin and link assemblies will remain on the existing beams, which is not preferred from a maintenance standpoint. Cover plate retrofits will be necessary. Deck joints will also remain with this alternative, which will lead to continued degradation of the beams and substructure units.

Analysis of Alternative 3 – This alternative replaces existing W27 and W36 steel beam superstructure with a continuous three-span galvanized steel rolled beam (W36) superstructure on new integral abutments. The proposed abutments should be placed behind the existing abutments to avoid conflicting with the existing concrete piles. The resulting assumed span arrangement is approximately 50'/80'/50' measured between the centerline of bearings. Uplift at the abutments must be considered in the design phase given the relatively short exterior spans in the continuous structure.

The existing pier columns are in satisfactory condition with minimal rehabilitation required. Reusing the existing pier columns and footings will simplify construction since it will minimize construction impact to the BRC Railroad. In the future, the pier columns can be encased or strengthened with carbon fiber wrap if the rate of concrete degradation exceeds that of the replaced structure elements.

Using galvanized steel eliminates the need to periodically repaint the beam. Eliminating the deck joints will also help to prevent premature degradation of the beams and substructure elements. Providing new pier caps and integral abutments places most of the substructure on the same life cycle as the superstructure. The vertical clearance over the railroad will slightly improve due to the efficiency of the continuous structure allowing for the elimination of cover plates.

Analysis of Alternative 4 – This alternative completely eliminates the 50-year old structure and replaces it with a new structure with an expected 75-year service life. Increasing the length of Span 2 to avoid the existing piles is not feasible since deeper beams would be required, thereby reducing the vertical clearance over the railroad. On the other hand, shortening Span 2 cannot be assumed since moving the piers closer to the tracks will likely be prohibited by the railroad. Therefore, the new piers will be assumed at the same location as the existing, thereby creating piling conflicts with the existing timber piles. Similar to Alternative 3, for cost estimating purposes the proposed structure is assumed to have spans of approximately 50'/80'/50'.

The benefits of this alternative are similar to Alternative 3, with the addition of removing and replacing the pier columns and pier footings. Therefore, future maintenance of the pier columns will be less than the structure provided in Alternative 3. However, this alternative adds construction complications of reconstructing the piers on the same footprint as the existing pier footings. The cost is also greater than Alternative 3 due to the removal and reconstruction of the additional pier elements.

VI. FINAL RECOMMENDATION

Stantec recommends Alternative 3 – Superstructure and Partial Substructure Replacement when the I-55 Managed Lane Project occurs. The selected alternative provides a new superstructure and replaces most of the critical portions of the substructure. Eliminating the deck joints will help to prevent premature degradation of the replaced substructure elements. As the I-55 Managed Lane Phase I Study is ongoing, the bridge widening to be presented in the TSL should match the final geometry as presented in the final I-55 Managed Lane Phase I Study.


Based on the current condition of the bridge, the repairs of the deck or the substructure are not required in the short term. The ends of the cover plates and the pin and link assemblies should continue to be monitored by inspection.

VII. TRAFFIC STAGING


For Alternatives 2, 3, and 4, the existing deck is wide enough to provide two lanes of traffic in the eastbound direction during stage construction. For Alternative 1, the lanes can be temporarily closed as needed to allow for the deck repairs. The traffic staging design will need to be confirmed by IDOT traffic prior to being implemented.

ATTACHMENT A

Location Map

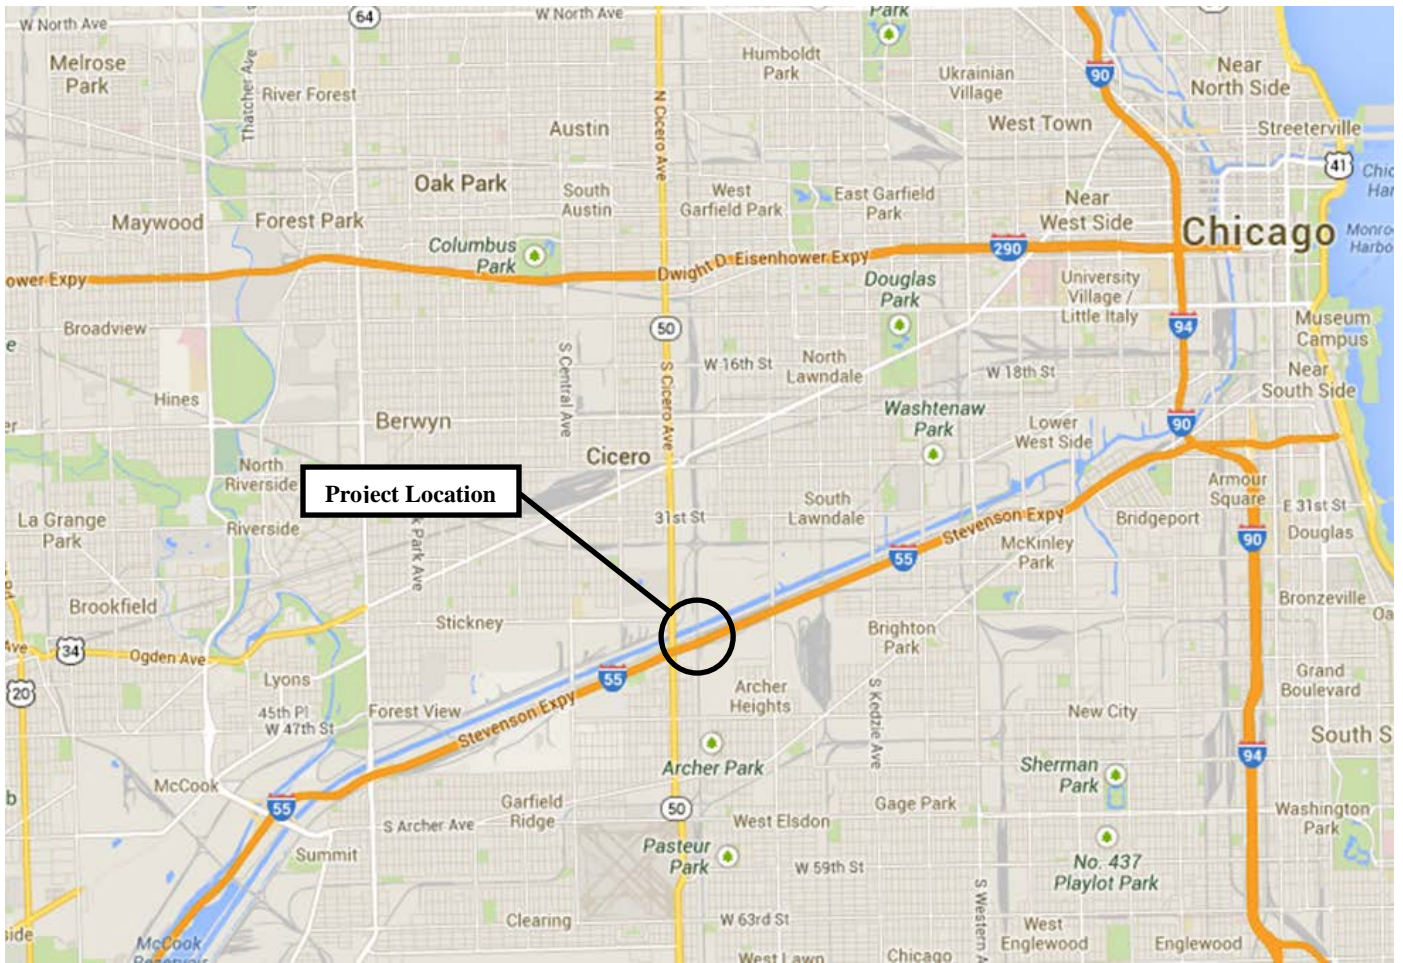

N

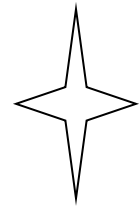

Location Map

Proposed Improvement:

I-55 over BRC Railroad (Eastbound)

Municipality: Chicago

County: Cook

Route: FAI 055

Project No: P-91-762-10

Structure No.: 016-0018

ATTACHMENT B

IDOT Master Structure Report

**Illinois Department of Transportation
Structures Information Management System
Structure Summary Report**

Date: 10/07/2013

Page: 1

Structure Number: 016-0018

District: 1

Inventory Data

Facility Carried:	I-55 EB STEVENSON	Bridge Name:		Sufficiency Rating:	84.0	Structure Length:	168.1
Feature Crossed:	RR - BRC	Location:	0.3 M NE ILL 50	HBP Eligible:	No	AASHTO Bridge Length:	99.9
Bridge Remarks:		Status Date:	12/2000	Replaced By:	016-2669	Length of Long Span:	78.0
Bridge Status:	1 OPEN - NO RESTRICT	Maint Township:	62 LAKE (CHICAGO)	Replaces:	-	Bridge Roadway Width:	77.7
Status Remarks:				Last Update Date:	07/05/2012	Appr Roadway Width:	60.0
Maint County:	016 COOK			Parallel Structure:	Right	Deck Width:	81.1
Maint Responsibility:	01 I.D.O.T.			Multi-Level Structure Nbr:		Sidewalk Width Right:	0.0
Service On/Under:	1 HIGHWAY	2 / RAILROAD		Skew Direction:	L	Sidewalk Width Left:	0.0
Reporting Agency:	1 I.D.O.T. - BUREAU OF MAINTENANCE			Skew Angle:	22 D 0 M 23 S	Navigation Control:	N
Main Span Matl/Type:	4 STEEL CONTINUOUS	/ 02 STRINGER/MULTI-BEAM/GIRDER		Structure Flared:	Yes	Navigation Horiz Clear:	0
Nbr Of Main Spans:	3	Nbr Of Approach Spans:	0	Historical Significance:	No	Navigation Vert Clear:	0.0
Approaches							
Near #1 Matl/Type:				Border Bridge State:		Culvert Fill Depth:	0.0
Near #2 Matl/Type:				Bdr State SN:		Number Culvert Cells:	0
Far #1 Matl/Type:				Bdr State % Responsibility:	0	Culvert Opening Area:	0.0
Far #2 Matl/Type:				Structural Steel Wt	896000	Culvert Cell Height:	0.00
Median Width/Type:	0 Ft. / 0	None		Substructure Material:		Culvert Cell Width:	0.00
Guardrail Type L/R:	0None	/ 0		Rated By:	2 IDOT	Rate Method:	2 ALLOWABLE STRESS
Toll Facility Indicator:	0 No Toll			Inventory Rating:	1.070(38)	Load Rating Date:	11/05/2001
Latitude:	41 D 49 M 5.86 S	Longitude:	87 D 44 M 20.4 S	Operating Rating:	1.680(60)	Crossing 1 Nbr:	
Deck Structure Type:	A	CIP CON NRMLLY FORM		Design Load:	01 HS20+MOD	Crossing 1 Nbr:	
Sidewalks Under Structure:	0	None		Deck Structure Thickness:	7 SD: N FO: N	RR Lateral Underclear:	22 Ft
						RR Vertical Underclear:	10 In

Key Route On Data

Key Route Nbr:	FEDERAL-AID INTERSTATE	Station:	0055	Station:	10.6000
Appurtenances	Main Route	Segment:		Linked:	Y
Inventory County:	016 COOK	Natl. Hwy System:	On NHS	Inventory Direction:	
Township/Road Dist	62 LAKE (CHICAGO)	Curr AADT Yr/Count:	2012 / 72400	Est Truck Percentage:	7
Municipality	1051 CHICAGO	Number Of Lanes:	4	One Or Two Way:	1 One-Way
Urban Area:	1051	Bypass Length:	0	Future AADT Yr/Cnt:	2032 / 75808
Functional Class:	1 INTERSTATE	Designated Truck Rte:	CLASS I	Special Systems:	Yes
** CLEARANCES **	South/East	North/West			
Max Rdwy Width:	77.7				
Horizontal:	79.1	0.0			

Key Route Under Data

Station:	
Segment:	
Linked:	
Natl. Hwy System:	/
Inventory Direction:	
Curr AADT Yr/Count:	
Est Truck Percentage:	
Number Of Lanes:	
One Or Two Way:	
Bypass Length:	
Future AADT Yr/Cnt:	
Designated Truck Rte:	
Special Systems:	

***** Marked Route On Data *****

Route #1:	1	Mainline	Designation	1	Interstate Highway	Kind	Highway	Number	055
Route #2:	1	Mainline							
Route #3:	1	Mainline							

***** Marked Route Under Data *****

Designation		Kind		Number	
--------------------	--	-------------	--	---------------	--

**Illinois Department of Transportation
Structures Information Management System
Structure Summary Report**

Date: 10/07/2013

Page: 2

Structure Number: 016-0018 District: 1

Data Related to Inspection Information

*** Inspection Intervals *** *** Maximum Allowable Posting Limits ***

Routine NBIS: 24 MOS Underwater: 0 MOS One Truck At A Time: 0 Combination Type 3S-1: Tons Bridge Posting Level: 5 No Posting Required
 Special: Y Single Unit Vehicles: Tons Combination Type 3S-2: Tons

Inspection/Appraisal Information

Inspection Date: 12/10/2012 Inspection Temperature: 35Deg. F ** Actual Posted Limits **
 Deck: 5 FAIR CONDITION - MINOR SECTION LOSS, CRACKS Single Unit Vehicles: Tons
 Superstructure: 5 FAIR CONDITION - MINOR SECTION LOSS, CRACKS Combination Type 3S-1: Tons
 Substructure: 6 SATISFACTORY CONDITION - MINOR DETERIORATION Combination Type 3S-2: Tons
 Culvert: N NOT APPLICABLE One Truck At A Time: 0
 Channel and Protection: N NOT APPLICABLE Deck Wearing Surf: F MICRO SIL CON OVRLY Last Paint Type: U
 Structural Evaluation: 5 BETTER THAN ADEQUATE TO BE LEFT IN PLACE Deck Membrane: F NONE FLD AL EPY & ACRLC
 Deck Geometry: 9 SUPERIOR TO PRESENT DESIRABLE CRITERIA Deck Protection: J NONE
 Underclearance-Vert/Lat.: 6 EQUAL TO PRESENT MINIMUM CRITERIA Total Deck Thick: 8.7
 Waterway Adequacy: N NOT APPLICABLE Last Paint Date: 07/2000
 Approach Roadway Align: 8 EQUAL TO PRESENT DESIRABLE CRITERIA
 Bridge Railing Appraisal: 2 Doesn't Meet Standards
 Approach Guardrail: 232 Not Acceptable Acceptable Not Acceptable
 Pier Navig Protection: N N/A

Underwater Inspection/Appraisal Information

Inspection Date: Inspection Category:
 Temperature: Inspection Method:

Appraisal Rating:

Scour Critical Information

Evaluation Method:

Miscellaneous

Yes

Construction Information

Year: 1963 Original Reconstructed
 Route: FAI-55 Sta: 25+03.37
 Section Nbr: 1212-620-VB
 Contract Nbr:
 Fed Aid Prf#: IG 0557034281
 Built By: 1 I.D.O.T.

Waterway Information

Flood Design Frequency:
 Flood Design Q (CFS):
 Flood Design Nat H W E:
 Flood Des Open Prop:

YRS Drainage Area:
 Flood Base Q (CFS):
 Flood Base Nat H W E:

ATTACHMENT C

Bridge Inspection Report



SN: 016-0018	District: 1	Spans: 3	Appr. Spans: 0	Skew: 22.01	ADT: 72400	Truck Pct: 7
ADT Un:	Maint. Co: COOK	Twsp: LAKE (CHICAGO)		Status: OPEN - NO RESTRICT		
Facility Carried: I- 55 EB STEVENSON			Feature Crossed: RR - BRC			
Location: 0.3 M NE ILL 50		Municipality: CHICAGO		Team/Sub Section: E26019		
Bridge Name:			Material & Type: STEEL CONTINUOUS/STRINGER/MULTI-BEAM/GIRDER			
Insp. Intervals (Mo) Routine NBIS: 24		Fracture Critical: 0		Underwater: 0	Special Feature: 48	
90 - Inspection Date: / /		90C - Temp. (°F):		90A - Program Manager:		
Is Delinquent: <input type="checkbox"/>		Reason:				
90A1 - Team Leader:			90A2 - Inspector:			

90B - Inspection Remarks:

Previous Inspection	2008) #58-DK CHLOR CONTAM W/LEACHING MAP CRKS & SM SPALLS. FILLETS SPALLING. #59 PAINT PEELING & RUST TYP. ESP @FASCIAS & BMS 6 & 7. #60 CRKS@ ABUT CAPS & COLUMNS. 2012) Item 59 lowered to "5" due to init. sec loss/minor pitting @ brng
------------------------	---

Resources

Time to Inspect (H:M): 1:0	Traffic Control: 3	Boat:	Waders:	Snooper:
Ladder:	Manlift:	Bucket Truck:	Other: UB50 for Pin & Link	

Inspector's Appraisals

	Prev	New	Comments
58 - Deck Condition:	5		
59 - Superstructure Cond:	5		
60 - Substructure Cond:	6		
62 - Culvert Condition:	N		
61 - Channel Condition:	N		
71 - Waterway Adequacy:	N		
72 - Approach Rdw Align:	8		
111 - Pier Navig Protection:	N		

90B - Inspector Remarks:

Routine Inspection Report

Structure Number: 0160018

Additional Inspection Data

36A – Bridge Railing Adequacy:	Prev	New	Rail Types:				36B – Transitions: <input type="checkbox"/>	Prev	New	36C – Guardrail: <input type="checkbox"/>	Prev	New	36D – Ends: <input type="checkbox"/>
	2												
Approach Guardrail Adequacy:													
						2				3			2

108A – Wearing Surface Type:	Prev	New	If "L-Other" Describe: _____	
	F			
108B – Type of Membrane:	F		If "E-Other" Describe: _____	
108C – Deck Protection:	J		If "I-Other" Describe: _____	
108D – Total Deck Thickness (in):	8.7			

59A – Paint Date (Mo/Yr):	Prev	New	Color: Fascia - ____: Inter. - ____: Railing - ____.	
	07/2000	/		
59B – Paint Type:	U			
59C – Utilities Attached:			If "B-Other" Describe: _____	

		Prev	New	
Weight Limit Posting:	70A2 – Single Unit Vehicles:			Tons
	70B2 – Combination Type 3S-1 (3 or 4 axles):			Tons
	70C2 – Combination Type 3S-2 (5 or more axles):			Tons
	70D2 – One Truck at a Time:	0		

Joint Openings (In.) _____

90B – Inspector Remarks Continued:

	Signature	Date
Inspection Team Leader:		/ /
Inspection Program Manager:		/ /

Pontis

Today's Date: 04/19/2013

Structure Number: 016-0018 District: 1 (41) Bridge Status: 1 OPEN - NO RESTRICT
 (6) Feature Crossed: RR - BRC (7) Facility Carried: I- 55 EB STEVENSON
 (9) Location: 0.3 M NE ILL 50 (7A) Bridge Name:
 Element Inspection Date: 12/10/2012 Inspectors: SEDLACEKJL

Element Description												
Elem	Env	% 1	Qty 1	% 2	Qty 2	% 3	Qty 3	% 4	Qty 4	% 5	Qty 5	Tot Qty
Concrete Deck Protected w/ Rigid Overlay												
22	4	64	8,856	26	3,550	10	1,375	0	0	0	25	13,806
No deficiencies. Repaired areas exist Map cracked areas. Spalls/delaminations Full depth failures.												
Remarks: Soffit-Chlor contam areas w/map crks;HPs@const jt WS) HL map cracking w/isol PD patch emerging. Fillets spalling typ.												
Lead Painted Steel Open Girder												
107	4	30	5,483	50	9,137	20	3,553	0	0	0	0	18,173
No corrosion Paint distress Rust formation Section loss Section failure												
Remarks: Freckled rust thru-out; Bott flanges-Lt surf rust(mod @ edges & Bm 6&7) Paint peel@ bttm flng; Init sec loss(minor pitting on fascias)												
Lead Painted Steel Pin and/or Hanger												
161	4	96	27	4	1	0	0	0	0	0	0	28
No corrosion Paint distress Rust formation Section loss Section failure												
Remarks: Span 1 Bm #14- coverplate misaligned.												
Non-Lead Painted Steel Closed Web/Box Girder and O												
173	4	100	84	0	0	0	0	0	0	0	0	84
No corrosion Paint distress Rust formation Section loss Section failure												
Remarks: Init pitting @ Abuts & Diaphs												
Reinforced Conc Column or Pile Extension												
205	3	99	3,263	0	0	1	34	0	0	0	0	3,297
No deterioration Minor cracks/spalls Delams/spalls Analysis warranted												
Remarks: HL-Nar crks w/HPs and shallow rebar spalls. P1 undercap-spalls @ Col 3&4; P2 Col 7 hl-med vert crks.												
Reinforced Conc Abutment												
215	3	100	972	0	0	0	0	0	0	0	0	972
No deterioration Minor cracks/spalls Delams/spalls Analysis warranted												
Remarks: Backwall-HL-Nar vert crks												
Reinforced Conc Pier or Abutment Cap												
234	3	91	278	1	4	7	22	0	0	0	0	304
No deterioration Minor cracks/spalls Delams/spalls Analysis warranted												
Remarks: Abut)HL-Nar vert leach crks Piers)P2 btwn cols 3-4 edge crk & HP bttm cap, P1 spall w/exp @ S Nose												
Preformed Joint Seal												
302	4	100	168	0	0	0	0	0	0	0	0	168
No deterioration Minor deterioration Major deterioration												
Remarks:												
Neoprene Expansion Joint												
307	4	100	174	0	0	0	0	0	0	0	0	174
The element shows mi The seal maybe punct The seal maybe heavi Major deterioration												
Remarks: Plow damage												

Movable Discontinuous Brg.

311	4	100	28	0	0	0	0	0	0	0	0	28
		No deterioration	Minor deterioration	Advanced corrosion								

Remarks:

Fixed Bearing

313	4	100	14	0	0	0	0	0	0	0	0	14
		No deterioration	Minor deterioration	Advanced corrosion								

Remarks:

Moveable Steel Bearings below continuous decks

316	4	100	14	0	0	0	0	0	0	0	0	14
		No deterioration	Minor deterioration	Advanced corrosion								

Remarks:

Approach Pavement

323	4	100	2	0	0	0	0	0	0	0	0	2
		No deterioration	Cracks/spalls	Major cracks/spalls	Broken/Unstable							

Remarks:

Concrete Bridge Railing

331	4	100	334	0	0	0	0	0	0	0	0	334
		No deterioration	Minor cracks/spalls	Analysis warranted								

Remarks:

Steel Pin and Hanger

411	4	0	0	100	28	0	0	0	0	0	0	28
		Minor fatigue, out-o	Moderate fatigue, ou	Severe fatigue, out-								

Remarks:

Element Description

Elem	Env	% 1	Qty 1	% 2	Qty 2	% 3	Qty 3	% 4	Qty 4	% 5	Qty 5	Tot Qty
Concrete Deck Protected w/ Rigid Overlay												
22	4	65	8,976	26	3,550	9	1,255	0	0	0	25	13,806
		No deficiencies.	Repaired areas exist	Map cracked areas.	Spalls/delaminations	Full depth failures.						

Remarks:

Lead Painted Steel Open Girder

107	4	30	5,483	50	9,137	20	3,553	0	0	0	0	18,173
		No corrosion	Paint distress	Rust formation	Section loss	Section failure						

Remarks:

Lead Painted Steel Pin and/or Hanger

161	4	96	27	4	1	0	0	0	0	0	0	28
		No corrosion	Paint distress	Rust formation	Section loss	Section failure						

Remarks:

Non-Lead Painted Steel Closed Web/Box Girder and O

173	4	100	84	0	0	0	0	0	0	0	0	84
		No corrosion	Paint distress	Rust formation	Section loss	Section failure						

Remarks:

Reinforced Conc Column or Pile Extension

205	3	99	3,263	0	0	1	34	0	0	0	0	3,297
No deterioration		Minor cracks/spalls		Delams/spalls		Analysis warranted						

Remarks: HL-Nar crks w/HPs and shallow rebar spalls. P1 undercap-spalls @ Col 3&4; P2 Col 7 hl-med vert crks.

Reinforced Conc Abutment

215	3	100	972	0	0	0	0	0	0	0	0	972
No deterioration		Minor cracks/spalls		Delams/spalls		Analysis warranted						

Remarks: Backwall-HL-Nar vert crks

Reinforced Conc Pier or Abutment Cap

234	3	91	278	1	4	7	22	0	0	0	0	304
No deterioration		Minor cracks/spalls		Delams/spalls		Analysis warranted						

Remarks: Abut)HL-Nar vert leach crks Piers)P2 btwn cols 3-4 edge crk & HP bttm cap, P1 spall w/exp @ S Nose

Preformed Joint Seal

302	4	100	168	0	0	0	0	0	0	0	0	168
No deterioration		Minor deterioration		Major deterioration								

Remarks:

Neoprene Expansion Joint

307	4	100	174	0	0	0	0	0	0	0	0	174
The element shows mi		The seal maybe punct		The seal maybe heavi		Major deterioration						

Remarks: Plow damage

Movable Discontinuous Brg.

311	4	100	28	0	0	0	0	0	0	0	0	28
No deterioration		Minor deterioration		Advanced corrosion								

Remarks:

Fixed Bearing

313	4	100	14	0	0	0	0	0	0	0	0	14
No deterioration		Minor deterioration		Advanced corrosion								

Remarks:

Moveable Steel Bearings below continuous decks

316	4	100	14	0	0	0	0	0	0	0	0	14
No deterioration		Minor deterioration		Advanced corrosion								

Remarks:

Approach Pavement

323	4	100	2	0	0	0	0	0	0	0	0	2
No deterioration		Cracks/spalls		Major cracks/spalls		Broken/Unstable						

Remarks: Longit crking

Concrete Bridge Railing

331	4	100	334	0	0	0	0	0	0	0	0	334
No deterioration		Minor cracks/spalls		Analysis warranted								

Remarks: HL vert crks. W Abut @ water table 3ft x 6in spall w/exp rebar.

Steel Pin and Hanger

411	4	0	0	100	28	0	0	0	0	0	0	28
Minor fatigue, out-o		Moderate fatigue, ou		Severe fatigue, out-								

Remarks: Span 1 Bm #14- coverplate misaligned.

Element Description

Elem	Env	% 1	Qty 1	% 2	Qty 2	% 3	Qty 3	% 4	Qty 4	% 5	Qty 5	Tot Qty
Concrete Deck Protected w/ Rigid Overlay												
22	4	66	9,148	26	3,550	8	1,108	0	0	0	0	13,806
		No deficiencies.	Repaired areas exist	Map cracked areas.	Spalls/delaminations	Full depth failures.						
Remarks: Soffit-Chlor contam areas w/map crks;HPs@const jt WS) HL-Nar trans crks w/long crks in Ln1. Fillets spalling typ.												
Lead Painted Steel Open Girder												
107	4	30	5,483	50	9,137	20	3,553	0	0	0	0	18,173
		No corrosion	Paint distress	Rust formation	Section loss	Section failure						
Remarks: Freckled rust thru-out; Bott flanges-Lt surf rust(mod @ edges & Bm 6&7) Paint peel@ bttm flng; Init sec loss(minor pitting on fascias)												
Lead Painted Steel Pin and/or Hanger												
161	4	96	27	4	1	0	0	0	0	0	0	28
		No corrosion	Paint distress	Rust formation	Section loss	Section failure						
Remarks: Span 1 Bm #14- coverplate misaligned.												
Non-Lead Painted Steel Closed Web/Box Girder and O												
173	4	100	84	0	0	0	0	0	0	0	0	84
		No corrosion	Paint distress	Rust formation	Section loss	Section failure						
Remarks: Init pitting @ Abuts & Diaphs												
Reinforced Conc Column or Pile Extension												
205	3	99	3,263	0	0	1	34	0	0	0	0	3,297
		No deterioration	Minor cracks/spalls	Delams/spalls	Analysis warranted							
Remarks: HL-Nar crks w/HPs and shallow rebar spalls. P1 undercap-spalls @ Col 3&4; P2 Col 7 hl-med vert crks.												
Reinforced Conc Abutment												
215	3	100	972	0	0	0	0	0	0	0	0	972
		No deterioration	Minor cracks/spalls	Delams/spalls	Analysis warranted							
Remarks: Backwall-HL-Nar vert crks												
Reinforced Conc Pier or Abutment Cap												
234	3	93	282	1	4	6	18	0	0	0	0	304
		No deterioration	Minor cracks/spalls	Delams/spalls	Analysis warranted							
Remarks: (Abut)HL-Nar vert leach crks Piers)P2 btwn cols 3-4 edge crk & HP bttm cap, P1 spall w/exp @ S Nose												
Preformed Joint Seal												
302	4	100	168	0	0	0	0	0	0	0	0	168
		No deterioration	Minor deterioration	Major deterioration								
Remarks:												
Neoprene Expansion Joint												
307	4	100	174	0	0	0	0	0	0	0	0	174
		The element shows mi	The seal maybe punct	The seal maybe heavi	Major deterioration							
Remarks: Plow damage												
Movable Discontinuous Brg.												
311	4	100	28	0	0	0	0	0	0	0	0	28
		No deterioration	Minor deterioration	Advanced corrosion								
Remarks:												
Fixed Bearing												
313	4	100	14	0	0	0	0	0	0	0	0	14
		No deterioration	Minor deterioration	Advanced corrosion								

Remarks:

Moveable Steel Bearings below continuous decks

316	4	100	14	0	0	0	0	0	0	0	0	14
			No deterioration	Minor deterioration	Advanced corrosion							

Remarks:

Approach Pavement

323	4	100	2	0	0	0	0	0	0	0	0	2
			No deterioration	Cracks/spalls	Major cracks/spalls		Broken/Unstable					

Remarks: Longit crking

Concrete Bridge Railing

331	4	100	334	0	0	0	0	0	0	0	0	334
			No deterioration	Minor cracks/spalls	Analysis warranted							

Remarks: HL vert crks. W Abut @ water table 3ft x 6in spall w/exp rebar.

Steel Pin and Hanger

411	4	0	0	100	28	0	0	0	0	0	0	28
			Minor fatigue, out-o	Moderate fatigue, ou	Severe fatigue, out-							

Remarks: Span 1 Bm #14- coverplate misaligned.

Element Description

Elem	Env	% 1	Qty 1	% 2	Qty 2	% 3	Qty 3	% 4	Qty 4	% 5	Qty 5	Tot Qty
Concrete Deck Protected w/ Rigid Overlay												
22	4	67	9,218	26	3,540	8	1,048	0	0	0	0	13,806
			No deficiencies.	Repaired areas exist	Map cracked areas.	Spalls/delaminations		Full depth failures.				

Remarks: Soffit)Chlor contam areas w/map crks;HPs@const jt WS) HL-Nar trans crks w/long crks in Ln1

Lead Painted Steel Open Girder

107	4	31	5,543	50	9,087	19	3,543	0	0	0	0	18,173
			No corrosion	Paint distress	Rust formation	Section loss	Section failure					

Remarks: Freckled rust throughout; Lwr flanges have Lt surf rust(mod @ edges) Paint peels on bot of bttm fl; Init sec loss(minor pitting on fascias)

Lead Painted Steel Pin and/or Hanger

161	4	100	28	0	0	0	0	0	0	0	0	28
			No corrosion	Paint distress	Rust formation	Section loss	Section failure					

Remarks:

Non-Lead Painted Steel Closed Web/Box Girder and O

173	4	100	84	0	0	0	0	0	0	0	0	84
			No corrosion	Paint distress	Rust formation	Section loss	Section failure					

Remarks: Init pitting @ abuts & diaphs

Reinforced Conc Column or Pile Extension

205	3	99	3,263	0	0	1	34	0	0	0	0	3,297
			No deterioration	Minor cracks/spalls	Delams/spalls	Analysis warranted						

Remarks: HL-Nar crks w/HPs and shallow rebar spalls

Reinforced Conc Abutment

215	3	100	972	0	0	0	0	0	0	0	0	972
			No deterioration	Minor cracks/spalls	Delams/spalls	Analysis warranted						

Remarks: Backwall) HL-Nar vert crks

Reinforced Conc Pier or Abutment Cap

234	3	93	282	1	4	6	18	0	0	0	0	304
No deterioration		Minor cracks/spalls		Delams/spalls		Analysis warranted						

Remarks:

Preformed Joint Seal

302	4	100	168	0	0	0	0	0	0	0	0	168
No deterioration		Minor deterioration		Major deterioration								

Remarks:

Neoprene Expansion Joint

307	4	100	174	0	0	0	0	0	0	0	0	174
The element shows mi		The seal maybe punct		The seal maybe heavi		Major deterioration						

Remarks:

Movable Discontinuous Brg.

311	4	100	28	0	0	0	0	0	0	0	0	28
No deterioration		Minor deterioration		Advanced corrosion								

Remarks:

Fixed Bearing

313	4	100	14	0	0	0	0	0	0	0	0	14
No deterioration		Minor deterioration		Advanced corrosion								

Remarks:

Moveable Steel Bearings below continuous decks

316	4	100	14	0	0	0	0	0	0	0	0	14
No deterioration		Minor deterioration		Advanced corrosion								

Remarks:

Approach Pavement

323	4	100	2	0	0	0	0	0	0	0	0	2
No deterioration		Cracks/spalls		Major cracks/spalls		Broken/Unstable						

Remarks:

Concrete Bridge Railing

331	4	100	334	0	0	0	0	0	0	0	0	334
No deterioration		Minor cracks/spalls		Analysis warranted								

Remarks:

Steel Pin and Hanger

411	4	0	0	100	28	0	0	0	0	0	0	28
Minor fatigue, out-o		Moderate fatigue, ou		Severe fatigue, out-								

Remarks:

Element Description

Elem	Env	% 1	Qty 1	% 2	Qty 2	% 3	Qty 3	% 4	Qty 4	% 5	Qty 5	Tot Qty
Concrete Deck Protected w/ Rigid Overlay												
22	4	67	9,218	26	3,540	8	1,048	0	0	0	0	13,806
		No deficiencies.	Repaired areas exist	Map cracked areas.	Spalls/delaminations	Full depth failures.						
Remarks: <input type="text"/>												
Lead Painted Steel Open Girder												
107	4	31	5,543	50	9,087	19	3,543	0	0	0	0	18,173
		No corrosion	Paint distress	Rust formation	Section loss	Section failure						
Remarks: <input type="text"/>												
Lead Painted Steel Pin and/or Hanger												
161	4	100	28	0	0	0	0	0	0	0	0	28
		No corrosion	Paint distress	Rust formation	Section loss	Section failure						
Remarks: <input type="text"/>												
Non-Lead Painted Steel Closed Web/Box Girder and O												
173	4	100	84	0	0	0	0	0	0	0	0	84
		No corrosion	Paint distress	Rust formation	Section loss	Section failure						
Remarks: <input type="text"/>												
Reinforced Conc Column or Pile Extension												
205	3	100	3,297	0	0	0	0	0	0	0	0	3,297
		No deterioration	Minor cracks/spalls	Delams/spalls	Analysis warranted							
Remarks: <input type="text"/>												
Reinforced Conc Abutment												
215	3	100	972	0	0	0	0	0	0	0	0	972
		No deterioration	Minor cracks/spalls	Delams/spalls	Analysis warranted							
Remarks: <input type="text"/>												
Reinforced Conc Pier or Abutment Cap												
234	3	100	304	0	0	0	0	0	0	0	0	304
		No deterioration	Minor cracks/spalls	Delams/spalls	Analysis warranted							
Remarks: <input type="text"/>												
Preformed Joint Seal												
302	4	100	168	0	0	0	0	0	0	0	0	168
		No deterioration	Minor deterioration	Major deterioration								
Remarks: <input type="text"/>												
Neoprene Expansion Joint												
307	4	100	174	0	0	0	0	0	0	0	0	174
		The element shows mi	The seal maybe punct	The seal maybe heavi	Major deterioration							
Remarks: <input type="text"/>												
Movable Discontinuous Brg.												
311	4	100	28	0	0	0	0	0	0	0	0	28
		No deterioration	Minor deterioration	Advanced corrosion								
Remarks: <input type="text"/>												
Fixed Bearing												
313	4	100	14	0	0	0	0	0	0	0	0	14
		No deterioration	Minor deterioration	Advanced corrosion								

Remarks:

Moveable Steel Bearings below continuous decks

316	4	100	14	0	0	0	0	0	0	0	0	14
		No deterioration	Minor deterioration	Advanced corrosion								

Remarks:

Approach Pavement

323	4	100	2	0	0	0	0	0	0	0	0	2
		No deterioration	Cracks/spalls	Major cracks/spalls	Broken/Unstable							

Remarks:

Concrete Bridge Railing

331	4	100	334	0	0	0	0	0	0	0	0	334
		No deterioration	Minor cracks/spalls	Analysis warranted								

Remarks:

Steel Pin and Hanger

411	4	0	0	100	28	0	0	0	0	0	0	28
		Minor fatigue, out-o	Moderate fatigue, ou	Severe fatigue, out-								

Remarks:

Element Description

Elem	Env	% 1	Qty 1	% 2	Qty 2	% 3	Qty 3	% 4	Qty 4	% 5	Qty 5	Tot Qty
------	-----	-----	-------	-----	-------	-----	-------	-----	-------	-----	-------	---------

Concrete Deck Protected w/ Rigid Overlay

22	4	67	9,218	26	3,540	8	1,048	0	0	0	0	13,806
		No deficiencies.	Repaired areas exist	Map cracked areas.	Spalls/delaminations	Full depth failures.						

Remarks:

Lead Painted Steel Open Girder

107	4	31	5,543	50	9,087	19	3,543	0	0	0	0	18,173
		No corrosion	Paint distress	Rust formation	Section loss	Section failure						

Remarks:

Lead Painted Steel Pin and/or Hanger

161	4	100	28	0	0	0	0	0	0	0	0	28
		No corrosion	Paint distress	Rust formation	Section loss	Section failure						

Remarks:

Non-Lead Painted Steel Closed Web/Box Girder and O

173	4	100	84	0	0	0	0	0	0	0	0	84
		No corrosion	Paint distress	Rust formation	Section loss	Section failure						

Remarks:

Reinforced Conc Column or Pile Extension

205	3	100	3,297	0	0	0	0	0	0	0	0	3,297
		No deterioration	Minor cracks/spalls	Delams/spalls	Analysis warranted							

Remarks:

Reinforced Conc Abutment

215	3	100	972	0	0	0	0	0	0	0	0	972
		No deterioration	Minor cracks/spalls	Delams/spalls	Analysis warranted							

Remarks:

Reinforced Conc Pier or Abutment Cap

234	3	100	304	0	0	0	0	0	0	0	0	304
		No deterioration	Minor cracks/spalls	Delams/spalls	Analysis warranted							

Remarks:

Preformed Joint Seal

302	4	100	168	0	0	0	0	0	0	0	0	168
		No deterioration	Minor deterioration	Major deterioration								

Remarks:

Neoprene Expansion Joint

307	4	100	174	0	0	0	0	0	0	0	0	174
		The element shows mi	The seal maybe punct	The seal maybe heavi	Major deterioration							

Remarks:

Movable Discontinuous Brg.

311	4	100	28	0	0	0	0	0	0	0	0	28
		No deterioration	Minor deterioration	Advanced corrosion								

Remarks:

Fixed Bearing

313	4	100	14	0	0	0	0	0	0	0	0	14
		No deterioration	Minor deterioration	Advanced corrosion								

Remarks:

Moveable Steel Bearings below continuous decks

316	4	100	14	0	0	0	0	0	0	0	0	14
		No deterioration	Minor deterioration	Advanced corrosion								

Remarks:

Approach Pavement

323	4	100	2	0	0	0	0	0	0	0	0	2
		No deterioration	Cracks/spalls	Major cracks/spalls	Broken/Unstable							

Remarks:

Concrete Bridge Railing

331	4	100	334	0	0	0	0	0	0	0	0	334
		No deterioration	Minor cracks/spalls	Analysis warranted								

Remarks:

Steel Pin and Hanger

411	4	0	0	100	28	0	0	0	0	0	0	28
		Minor fatigue, out-o	Moderate fatigue, ou	Severe fatigue, out-								

Remarks:

Element Description

Elem	Env	% 1	Qty 1	% 2	Qty 2	% 3	Qty 3	% 4	Qty 4	% 5	Qty 5	Tot Qty
Concrete Deck Protected w/ Rigid Overlay												
22	4	68	9,341	25	3,495	7	970	0	0	0	0	13,806
		No deficiencies.	Repaired areas exist	Map cracked areas.	Spalls/delaminations	Full depth failures.						
Remarks: <input type="text"/>												
Lead Painted Steel Open Girder												
107	4	82	14,973	18	3,200	0	0	0	0	0	0	18,173
		No corrosion	Paint distress	Rust formation	Section loss	Section failure						
Remarks: <input type="text"/>												
Lead Painted Steel Pin and/or Hanger												
161	4	100	28	0	0	0	0	0	0	0	0	28
		No corrosion	Paint distress	Rust formation	Section loss	Section failure						
Remarks: <input type="text"/>												
Non-Lead Painted Steel Closed Web/Box Girder and O												
173	4	100	84	0	0	0	0	0	0	0	0	84
		No corrosion	Paint distress	Rust formation	Section loss	Section failure						
Remarks: <input type="text"/>												
Reinforced Conc Column or Pile Extension												
205	3	100	3,297	0	0	0	0	0	0	0	0	3,297
		No deterioration	Minor cracks/spalls	Delams/spalls	Analysis warranted							
Remarks: <input type="text"/>												
Reinforced Conc Abutment												
215	3	100	972	0	0	0	0	0	0	0	0	972
		No deterioration	Minor cracks/spalls	Delams/spalls	Analysis warranted							
Remarks: <input type="text"/>												
Reinforced Conc Pier or Abutment Cap												
234	3	100	304	0	0	0	0	0	0	0	0	304
		No deterioration	Minor cracks/spalls	Delams/spalls	Analysis warranted							
Remarks: <input type="text"/>												
Preformed Joint Seal												
302	4	100	168	0	0	0	0	0	0	0	0	168
		No deterioration	Minor deterioration	Major deterioration								
Remarks: <input type="text"/>												
Neoprene Expansion Joint												
307	4	100	174	0	0	0	0	0	0	0	0	174
		The element shows mi	The seal maybe punct	The seal maybe heavi	Major deterioration							
Remarks: <input type="text"/>												
Movable Discontinuous Brg.												
311	4	100	28	0	0	0	0	0	0	0	0	28
		No deterioration	Minor deterioration	Advanced corrosion								
Remarks: <input type="text"/>												
Fixed Bearing												
313	4	100	14	0	0	0	0	0	0	0	0	14
		No deterioration	Minor deterioration	Advanced corrosion								

Remarks:

Moveable Steel Bearings below continuous decks

316	4	100	14	0	0	0	0	0	0	0	0	14
			No deterioration	Minor deterioration	Advanced corrosion							

Remarks:

Approach Pavement

323	4	100	2	0	0	0	0	0	0	0	0	2
			No deterioration	Cracks/spalls	Major cracks/spalls	Broken/Unstable						

Remarks:

Concrete Bridge Railing

331	4	100	334	0	0	0	0	0	0	0	0	334
			No deterioration	Minor cracks/spalls	Analysis warranted							

Remarks:

Steel Pin and Hanger

411	4	0	0	100	28	0	0	0	0	0	0	28
			Minor fatigue, out-o	Moderate fatigue, ou	Severe fatigue, out-							

Remarks:

Element Description

Elem	Env	% 1	Qty 1	% 2	Qty 2	% 3	Qty 3	% 4	Qty 4	% 5	Qty 5	Tot Qty
------	-----	-----	-------	-----	-------	-----	-------	-----	-------	-----	-------	---------

Concrete Deck Protected w/ AC Overlay

14	4	90	12,063	0	0	10	1,340	0	0	0	0	13,403
			No deficiencies.	Repaired areas.	Map cracked areas.	Spalls/delam exist.	Full depth failures.					

Remarks:

Lead Painted Steel Open Girder

107	4	89	16,174	11	1,999	0	0	0	0	0	0	18,173
			No corrosion	Paint distress	Rust formation	Section loss	Section failure					

Remarks:

Lead Painted Steel Pin and/or Hanger

161	4	100	28	0	0	0	0	0	0	0	0	28
			No corrosion	Paint distress	Rust formation	Section loss	Section failure					

Remarks:

Lead Painted Steel Closed Web/Box Girder and Open

172	4	100	84	0	0	0	0	0	0	0	0	84
			No corrosion	Paint distress	Rust formation	Section loss	Section failure					

Remarks:

Reinforced Conc Column or Pile Extension

205	3	100	3,297	0	0	0	0	0	0	0	0	3,297
			No deterioration	Minor cracks/spalls	Delams/spalls	Analysis warranted						

Remarks:

Reinforced Conc Abutment

215	3	93	904	3	29	4	39	0	0	0	0	972
			No deterioration	Minor cracks/spalls	Delams/spalls	Analysis warranted						

Remarks:

Reinforced Conc Pier or Abutment Cap

234	3	100	304	0	0	0	0	0	0	0	0	304
		No deterioration	Minor cracks/spalls	Delams/spalls	Analysis warranted							

Remarks:

Neoprene Expansion Joint

307	4	60	90	40	60	0	0	0	0	0	0	150
		The element shows mi	The seal maybe punct	The seal maybe heavi	Major deterioration							

Remarks:

Movable Discontinuous Brg.

311	4	100	28	0	0	0	0	0	0	0	0	28
		No deterioration	Minor deterioration	Advanced corrosion								

Remarks:

Fixed Bearing

313	4	100	14	0	0	0	0	0	0	0	0	14
		No deterioration	Minor deterioration	Advanced corrosion								

Remarks:

Moveable Steel Bearings below continuous decks

316	4	100	14	0	0	0	0	0	0	0	0	14
		No deterioration	Minor deterioration	Advanced corrosion								

Remarks:

Approach Pavement

323	4	0	0	100	2	0	0	0	0	0	0	2
		No deterioration	Cracks/spalls	Major cracks/spalls		Broken/Unstable						

Remarks:

Concrete Bridge Railing

331	4	84	281	12	40	4	13	0	0	0	0	334
		No deterioration	Minor cracks/spalls	Analysis warranted								

Remarks:

Steel Pin and Hanger


411	4	0	0	0	0	100	28	0	0	0	0	28
		Minor fatigue, out-o	Moderate fatigue, ou	Severe fatigue, out-								

Remarks:

Download Date: 04/18/2013

ATTACHMENT D

Bottom of Deck Condition Survey

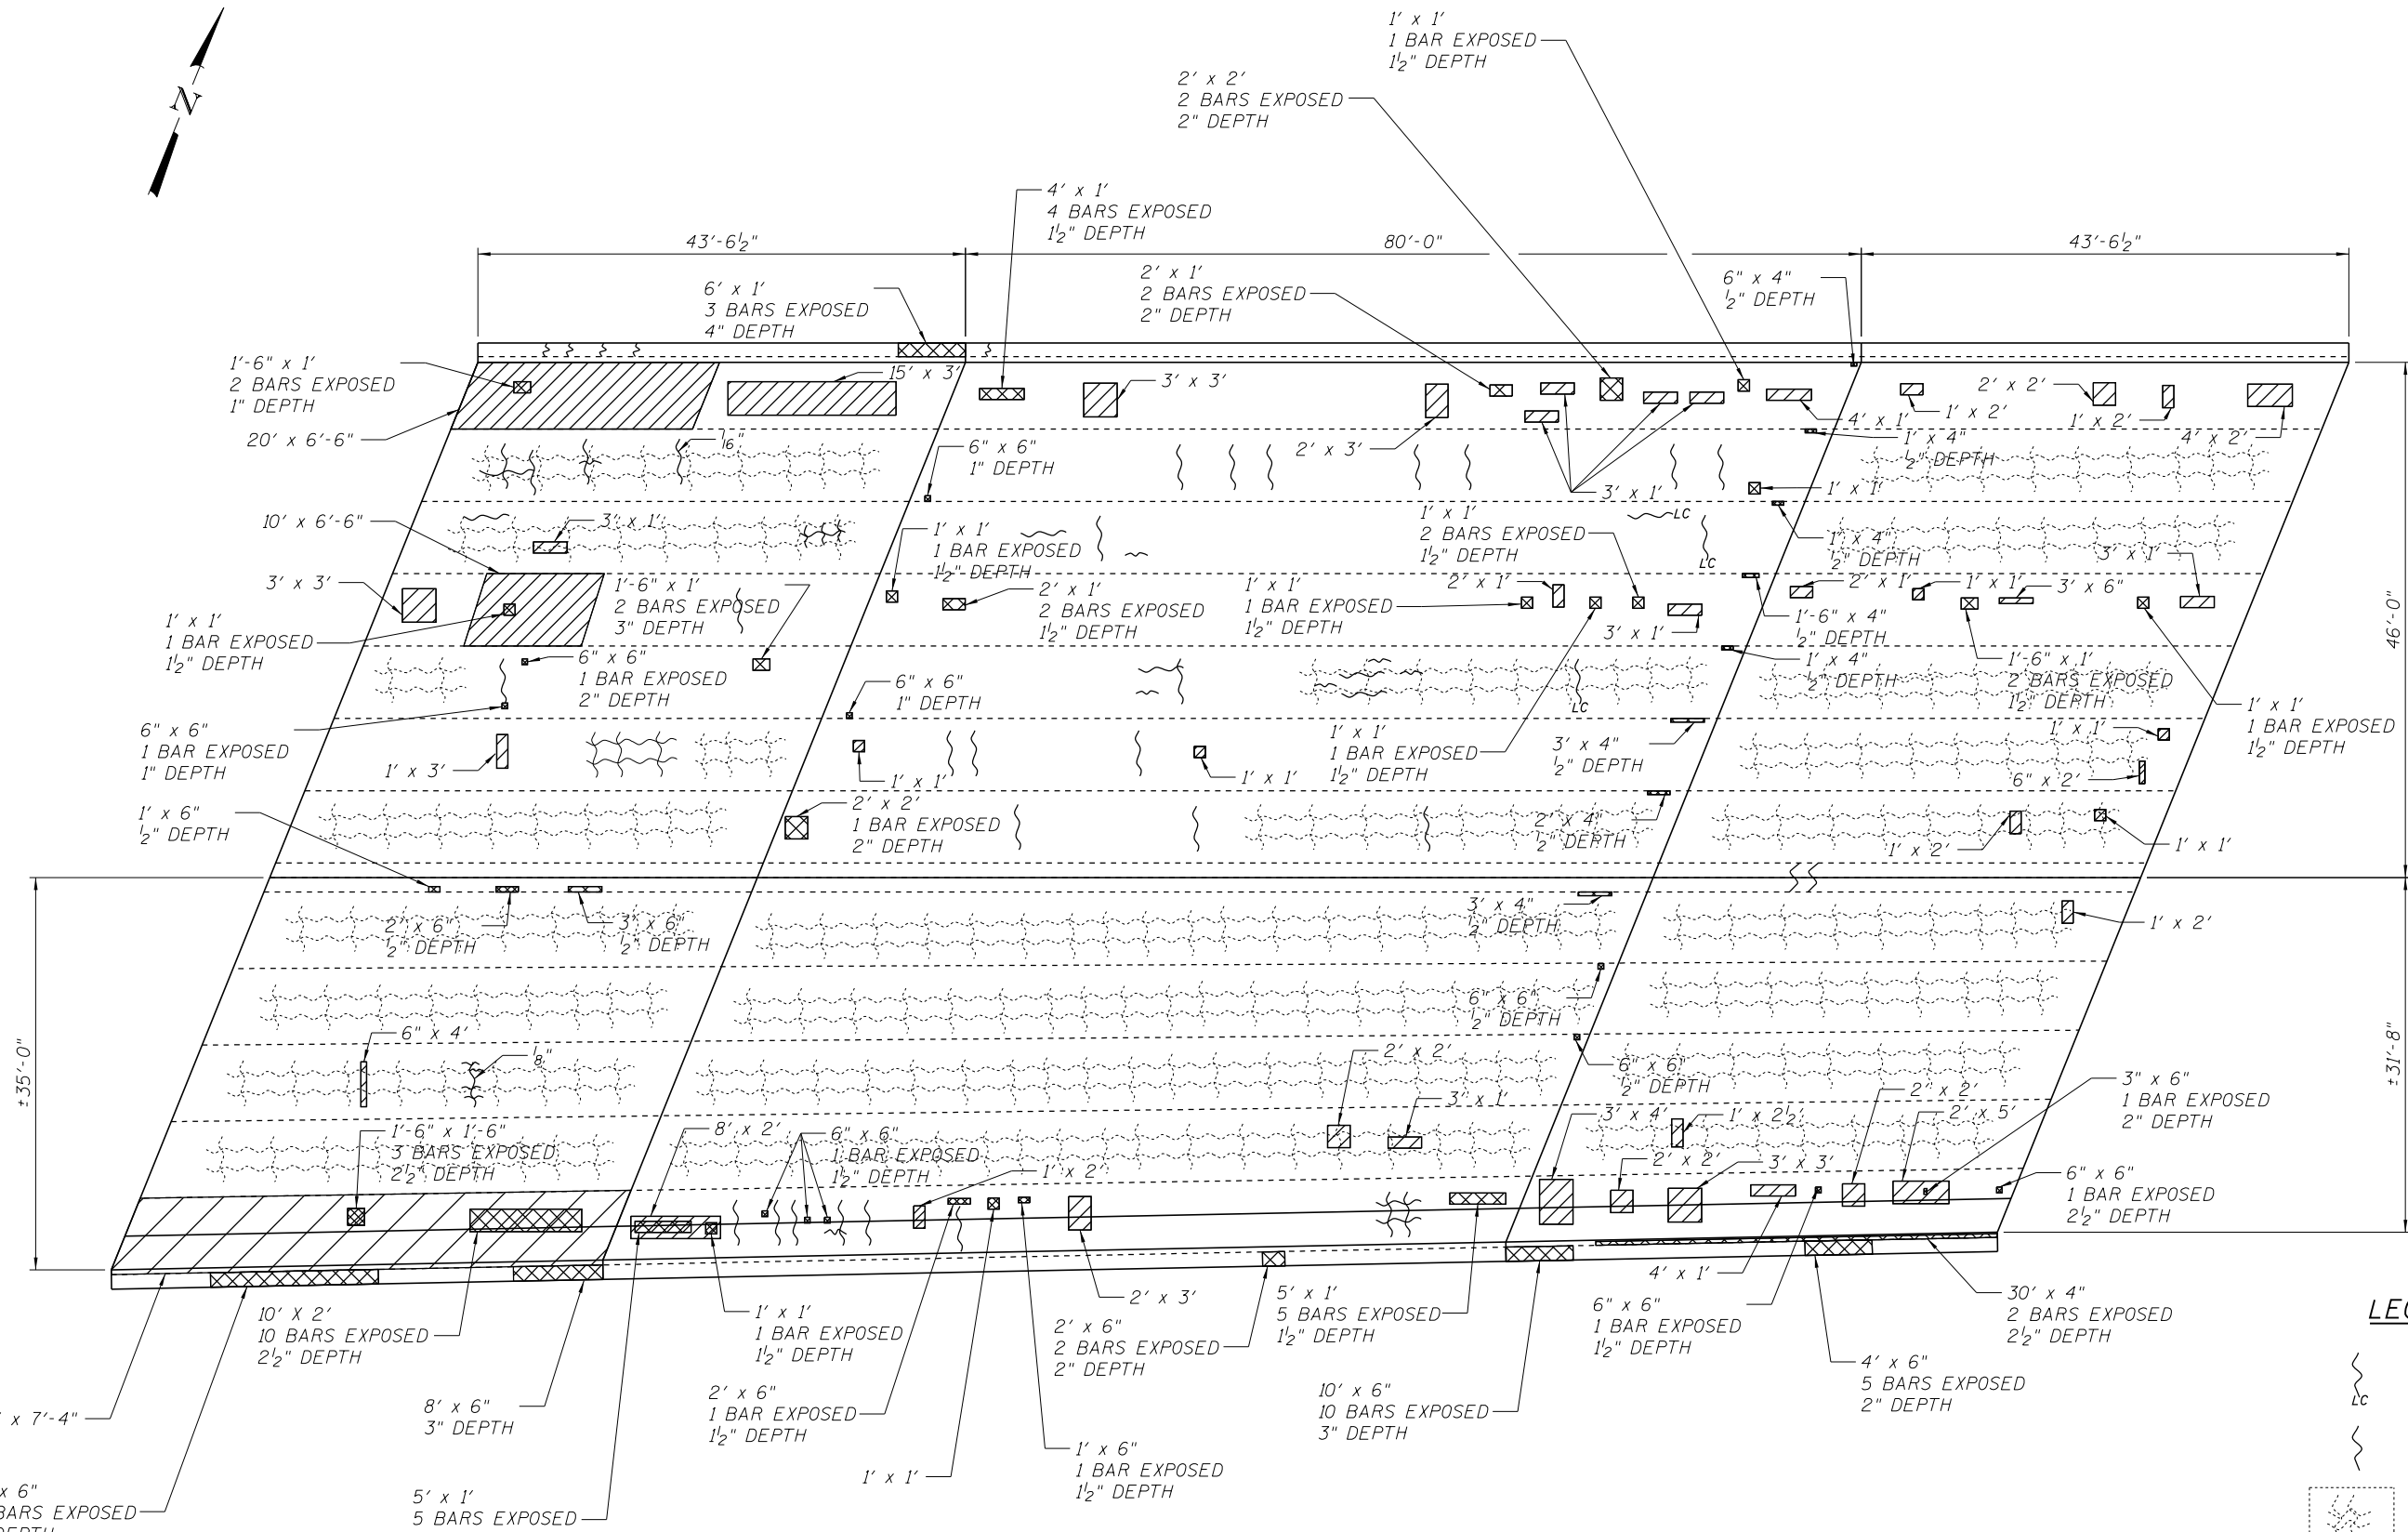

UNDERSIDE OF DECK
(EASTBOUND BRIDGE)

LEGEND

- CRACKED CONCRETE (LEACHING)
- CRACKED CONCRETE
- LIGHT MAP CRACKING
- SPALLED CONCRETE
- DELAMINATED CONCRETE

FILE NAME = W:\1786\active\178600037_IDOT_1-95\structural\drawing\shd\dwg_BRC_Railroad_UnderSide_of_Deck_Plan.dgn



USER NAME = jara_jas	DESIGNED - JSR	REVISED -
CHECKED - BPS	REVISOR -	REVISION -
PLOT SCALE = N/A	DRAWN - JSR	REVISOR -
PLOT DATE = 10/4/2013	CHECKED - BPS	REVISION -

STATE OF ILLINOIS
DEPARTMENT OF TRANSPORTATION

ATTACHMENT D - BOTTOM OF DECK CONDITION SURVEY
STRUCTURE NO. 016-0018

SHEET NO. 1 OF 1 SHEETS

F.A.I. RTE. = 55	SECTION = 1212-620-VB	COUNTY = COOK	TOTAL SHEETS =	SHEET NO. =
CONTRACT NO.				
FED. ROAD DIST. NO. 1 ILLINOIS FED. AID PROJECT				

ATTACHMENT E

**Condition Assessment of the Reinforced
Concrete Bridge Deck**

January 6, 2012

Ms. Diane M. O'Keefe
Deputy Director of Highways
District One Engineer
Illinois Department of Transportation
201 West Center Court
Schaumburg, Illinois 60196-1096
Attn: Ms. Sarah Wilson (Maintenance Bridge Engineer)

Re: Condition Assessment of Bridge Deck
I-55 Eastbound over BRC Railroad
Structure No. 016-0018
District One
Work Order 10
PTB No. 153-18
WJE No. 2009.3645.10

Dear Ms. O'Keefe:

At your request, Wiss, Janney, Elstner Associates, Inc. (WJE) completed a condition assessment of the reinforced concrete bridge deck for Structure No. 016-0018. This work included a visual assessment of concrete deterioration from below the structure. Also included was a delamination survey performed on the top of the bridge deck, based on an infrared thermography (IR) survey. Reinforcing bar cover depth determination was also performed using ground penetrating radar (GPR). These inspection tasks began in July and were completed in September.

Structure Description

The I-55 Eastbound Bridge over BRC Railroad carries four lanes of traffic and two shoulders. This three span structure is comprised of a concrete deck supported by steel beams. Each of the 14 girder lines is connected using steel diaphragms. All deck and substructure components are comprised of cast-in-place reinforced concrete construction. Reportedly the bridge structure was originally constructed in 1963 and the current overlay was installed in 2000.

The spans have approximate lengths of 42 ft, 80 ft, and 42 ft, from west to east, for a total structure length of 168 ft-2 in., back-to-back of abutments. The total deck width varies. The total resulting bridge deck area is approximately 13,260 sq. ft. A partial elevation view of the structure looking southwest is included as Figure 1.

Inspection Methods

The condition of the reinforced concrete bridge deck was assessed using several methods. These methods can be broken down into two major categories: Bottom of Deck Inspection Methods and Top of Deck Inspection Methods.

Bottom of Deck Inspection Methods

The condition of the bottom of the reinforced concrete deck was assessed from grade below the structure in September 2011. All accessible areas of the bottom of the deck were assessed visually. This inspection was completed from the ground beneath the bridge outside of active railroad tracks. Binoculars and/or zoom lenses were used to magnify the view of distant surfaces. Plan drawings of the structure including the structural framing were used to record field notes.

Top of Deck Inspection Methods

The condition of the top of the reinforced concrete deck was assessed using IR equipment to map areas of spalls, patches, and delaminations. This work was subcontracted to Infrasense, Inc. and was performed in July, 2011. Rolling lane closures were utilized during data collection periods to allow the IR data collection vehicle to assess the entire bridge deck surface while moving at approximately 3 mph. Impact Echo (IE) and sounding techniques were used to confirm the presence of delaminations at select locations on each bridge deck. All IR data was analyzed and summarized on bridge deck drawing sheets that show the located defects to scale.

GPR equipment was used to identify the cover depth of the top mat of reinforcing steel from the top surface of the deck. The GPR equipment was mounted to an inspection vehicle and scans were completed at normal operating speeds.

Assessment Results

The reinforced concrete bridge deck was found to be in satisfactory condition overall. Results for each assessment category are included below.

Bottom of Deck

Visual inspection from grade below the bridge was used to assess the bottom of the bridge deck. All areas of spalls or delaminations that could be identified visually were documented. In addition, all areas of previously repaired concrete were noted. Table 1 includes a summary of the visual inspection, including total deck soffit area, the area of spalled concrete, the area of delaminated concrete and the area of previous repairs. Figures 2 and 3 show the typical condition of the deck soffit. The results of the bottom of deck survey are shown on Sheet S-3 of Appendix A.

Table 1. Bottom of Deck Deterioration Summary

Soffit Area (sq. ft)	Spalled Area (sq. ft)	Total Area (%)	Delaminated Area (sq. ft)	Total Area (%)	Previously Repaired Area (sq.ft)
13,260	20	0.2	355	2.7	2130

Top of Deck

The top of the bridge deck was assessed using both IR and GPR equipment. The IR survey equipment was able to identify delaminations and spalls present in the bridge deck. Figure 4 is an overall view of the top deck surface looking northwest.

Table 2 includes a summary of the total bridge deck area, the total bridge deck area spalled, the total bridge deck area delaminated, the total bridge deck area that should be programmed for repair work and the rebar cover from the top surface of the deck. Sheet S-1 of Appendix A is a scaled bridge deck plan drawing showing the locations of the delaminated or spalled areas. Sheet S-2 of Appendix A is a scaled bridge deck plan drawing showing an image of the IR scan of the bridge. Sheet S-4 of Appendix A is a scaled bridge deck plan drawing showing the location of suggested partial and full depth concrete repairs using conventional patching techniques. Note that repair area boundaries were selected by expanding the boundaries of each delaminated or spalled area by 6 inches to account for saw cutting outside of the delamination and further deterioration prior to the actual start of any repair work. In addition, repair areas were joined when adjacent repairs were spaced at approximately 2 ft. or less. Full depth repair boundaries were determined based on locations where top and bottom surface defects overlapped. No bottom surface repairs were identified based on recommendations from IDOT.

Table 2. Top of Deck Deterioration Summary

Bridge Deck Area (sq. ft)	Spalled Area (sq. ft)	Total Area (%)	Delaminated Area (sq. ft)	Total Area (%)	Repair Area (sq. ft)	Total Area (%)	Rebar Cover (in.)
13,260	0	0	605	4.6	1223	9.2	4.4

Recommendations and Conclusions

WJE performed a condition assessment of the reinforced concrete bridge deck of the I-55 Eastbound Bridge over BRC Railroad. This condition assessment included: a visual survey of the bottom of the deck and an IR survey of the top of the deck. This information was used to produce repair drawings indicating the size and location of anticipated repair areas.


The repair work should, at a minimum, include partial depth repairs at all locations indicated on Sheet S-4 in Appendix A. If this option is selected, a detailed delamination assessment should be completed by the contractor at the time of the repair work to ensure that all areas of deteriorated concrete are identified. In addition, all re-entrant corners of repair areas should be detailed to include a 4 inch chamfer to reduce the potential for concrete-shrinkage related cracking.

The bridge deck was found to currently be in satisfactory condition, but corrosion-related damage has become apparent and should be repaired.


We would be happy to answer any questions or provide additional information.

Sincerely,

WISS, JANNEY, ELSTNER ASSOCIATES, INC.

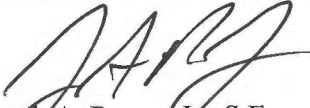

Joseph A. Rogers Jr., S.E.
Project Associate

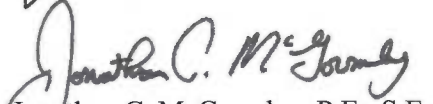

Jonathan C. McGormley, P.E., S.E.
Project Manager

Figures



Figure 1. Elevation View, looking southwest.



Figure 2. Typical view, deck soffit, looking west.

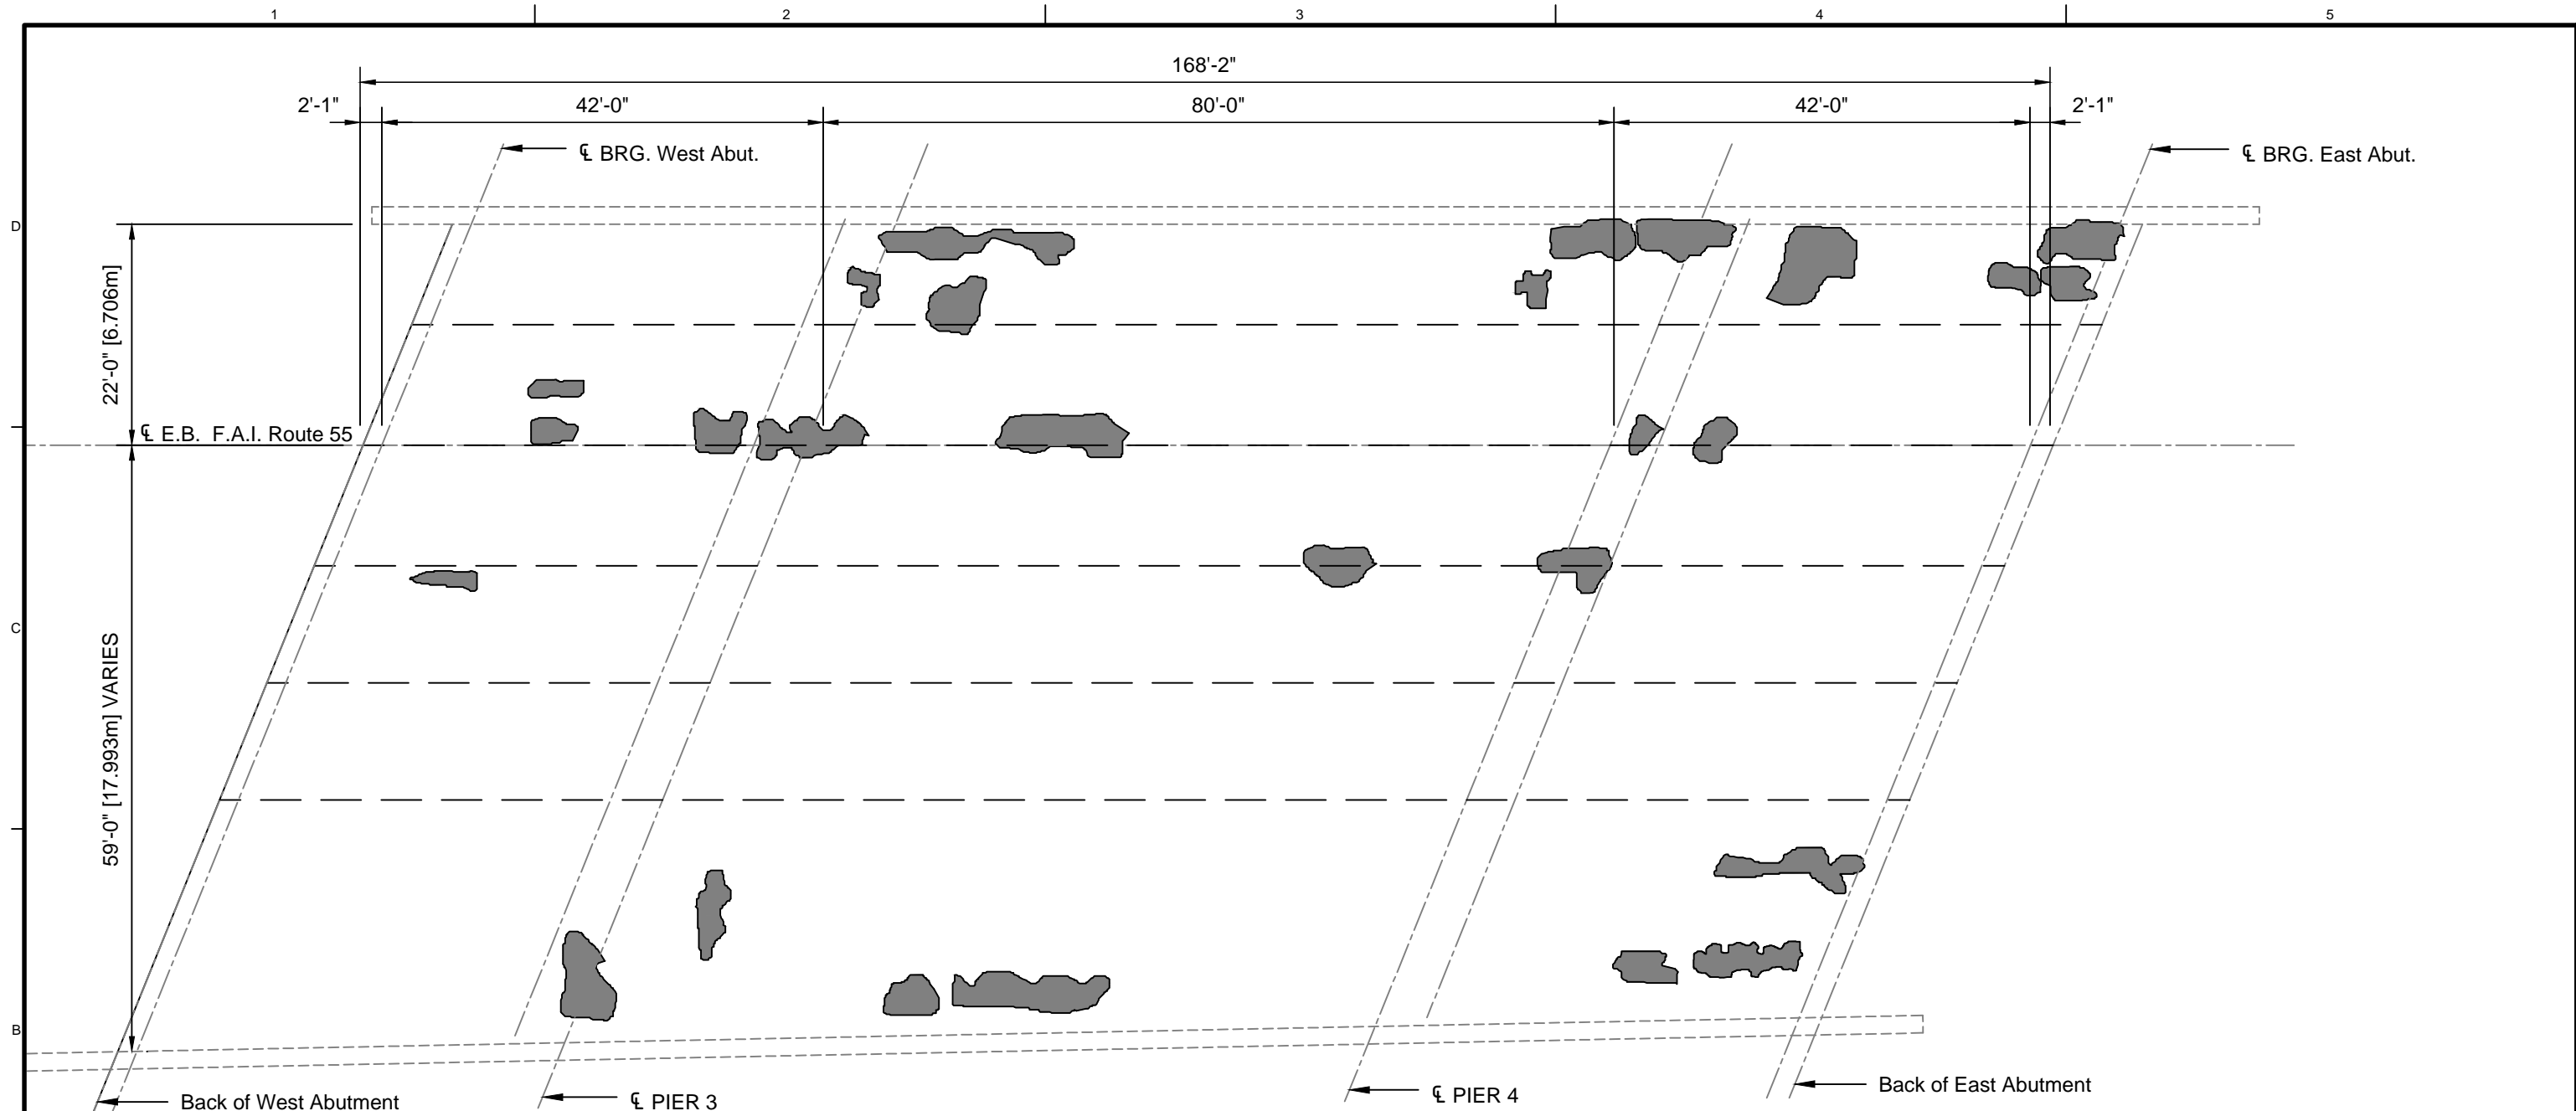


Figure 3. Typical view, deck soffit, looking east.

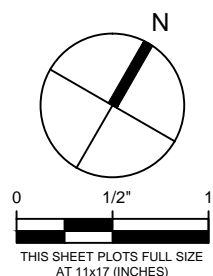


Figure 4. Typical view, deck top surface, looking northwest

Appendix A - Bridge Deck Condition Assessment Drawings



FIELD OBSERVATION SUMMARY		STRUCTURE # 016-0018		LEGEND	
ITEM	UNIT	QUANT.	%	DELAMINATION	SPALL
TOTAL AREA	Ac	13260	100		
DELAMINATION	Ac	605	4.6		
SPALL	Ac	0	0		
CRACKS	ft	-	-		




WJE ENGINEERS
ARCHITECTS
MATERIALS SCIENTISTS
Wiss, Janney, Elstner Associates, Inc.
330 Pfingsten Road
Northbrook, Illinois 60062
847.272.7400 tel | 847.291.4813 fax
www.wje.com

Client
Illinois Department of Transportation
District One
201 West Center Court
Schaumburg, Illinois 60196

Project
Bridge 016-0018
EASTBOUND I-55 OVER R.R.
Sheet Title
IR Result - Top Surface

Proj. No. 2009.3645.10
Date November 19 2011
Drawn JJZ
Checked JAR
Scale 1/16" = 1'-0"

Sheet No. **S1**

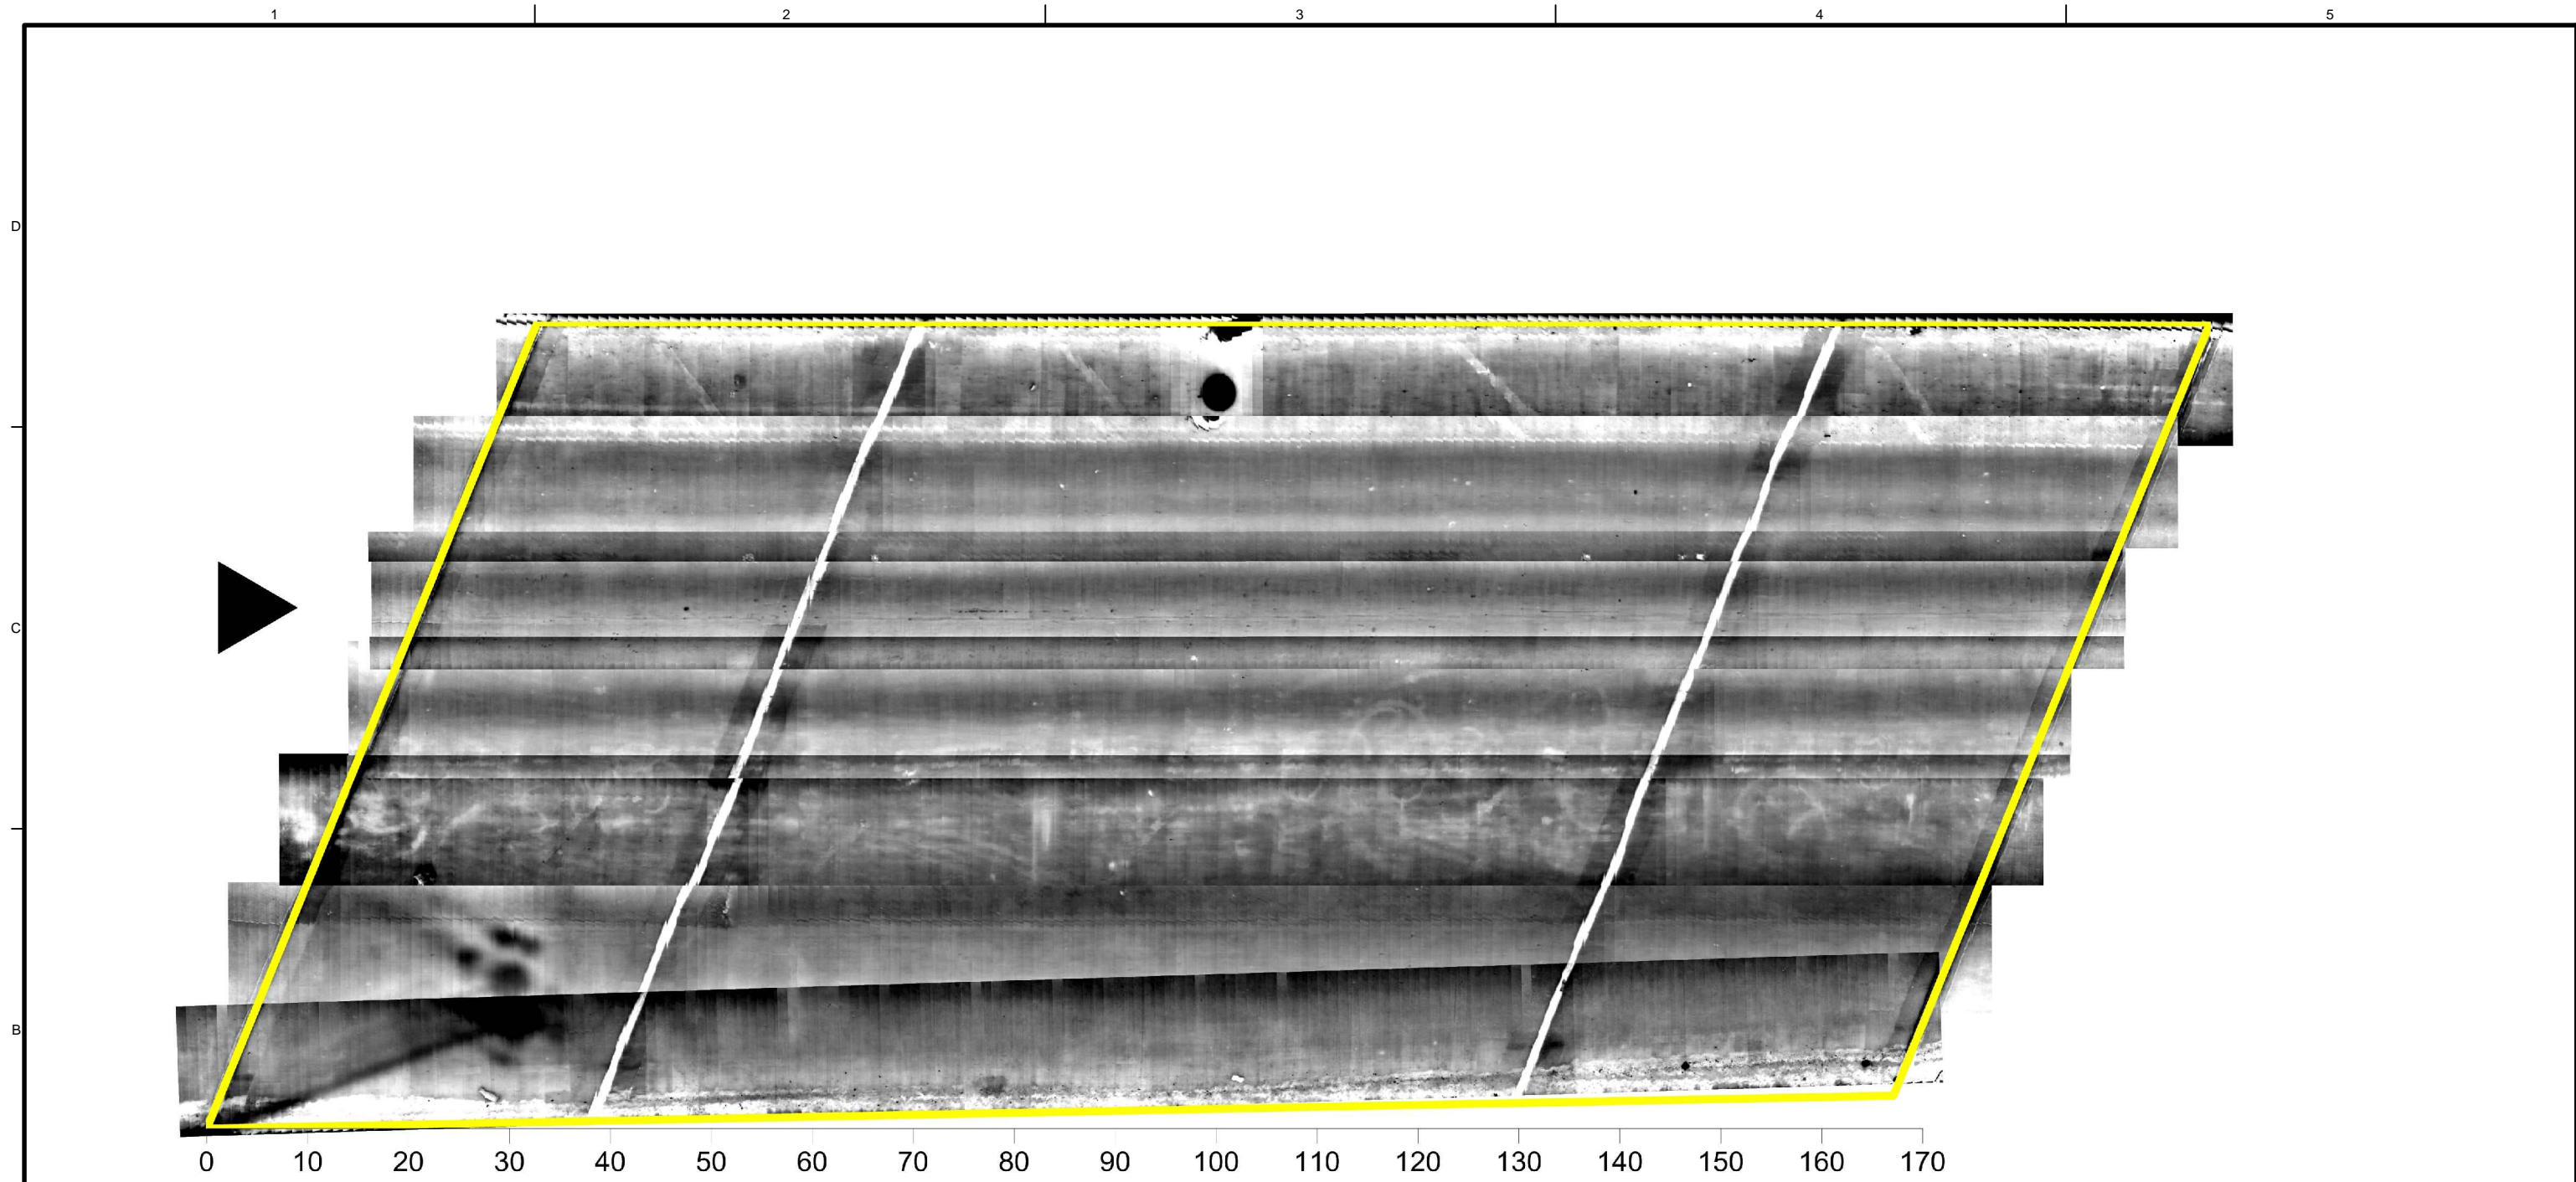


A

B

C

D

0 10 20 30 40 50 60 70 80 90 100 110 120 130 140 150 160 170

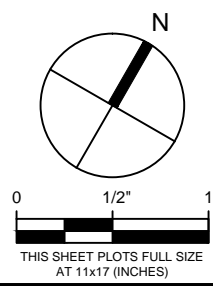


WJE ENGINEERS
ARCHITECTS
MATERIALS SCIENTISTS
Wiss, Janney, Elstner Associates, Inc.
330 Pfingsten Road
Northbrook, Illinois 60062
847.272.7400 tel | 847.291.4813 fax
www.wje.com

Client
Illinois Department of Transportation
District One
201 West Center Court
Schaumburg, Illinois 60196


Project
Bridge 016-0018
EASTBOUND I-55 OVER R.R.
Sheet Title
IR Image - Top Surface

Proj. No.	2009.3645.10
Date	November 19 2011
Drawn	JJZ
Checked	JAR
Scale	1/16" = 1'-0"

Sheet No. **S2**

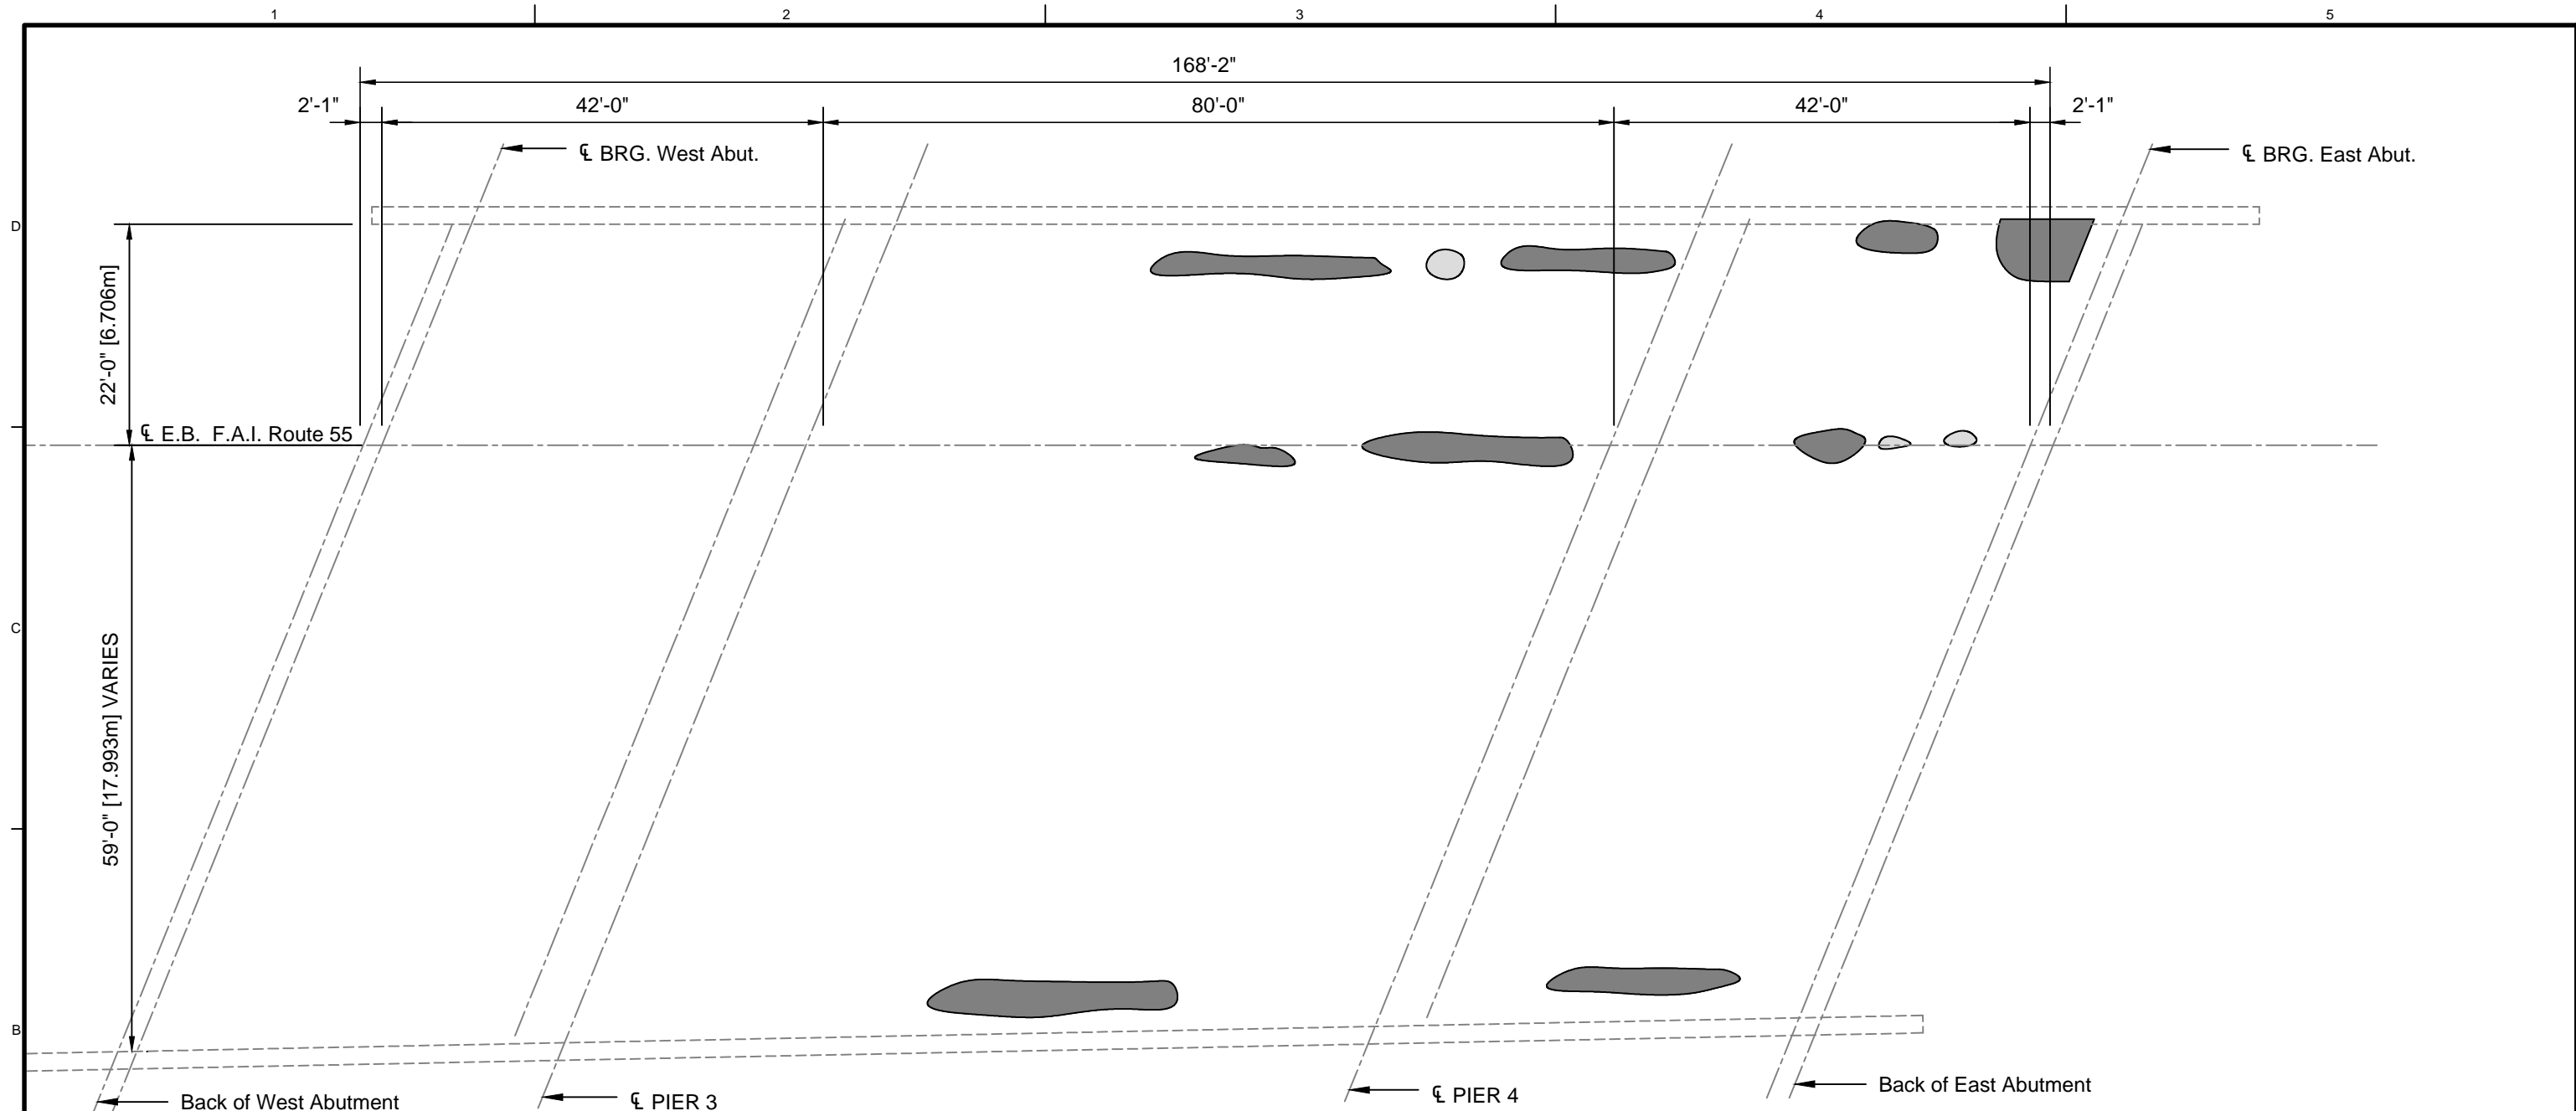

FIELD OBSERVATION SUMMARY		STRUCTURE # 016-0018		LEGEND	
ITEM	UNIT	QUANT.	%		
TOTAL AREA	Ac	13260	100	DELAMINATION	
DELAMINATION	Ac	355	2.7	SPALL	
SPALL	Ac	20	0.2	PREV. REPAIR	
PREVIOUS REPAIRS	Ac	2130	16.1	CRACK	
CRACKS	ft	-	-		

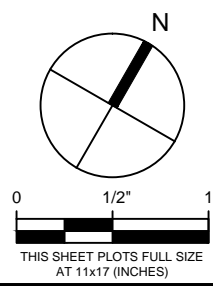


WJE ENGINEERS
ARCHITECTS
MATERIALS SCIENTISTS
Wiss, Janney, Elstner Associates, Inc.
330 Pfingsten Road
Northbrook, Illinois 60062
847.272.7400 tel | 847.291.4813 fax
www.wje.com

Client
Illinois Department of Transportation
District One
201 West Center Court
Schaumburg, Illinois 60196


Project
Bridge 016-0018
EASTBOUND I-55 OVER R.R.
Sheet Title
Underside Deterioration

Proj. No. 2009.3645.10
Date November 19 2011
Drawn JJZ
Checked JAR
Scale 1/16" = 1'-0"

Sheet No. **S3**

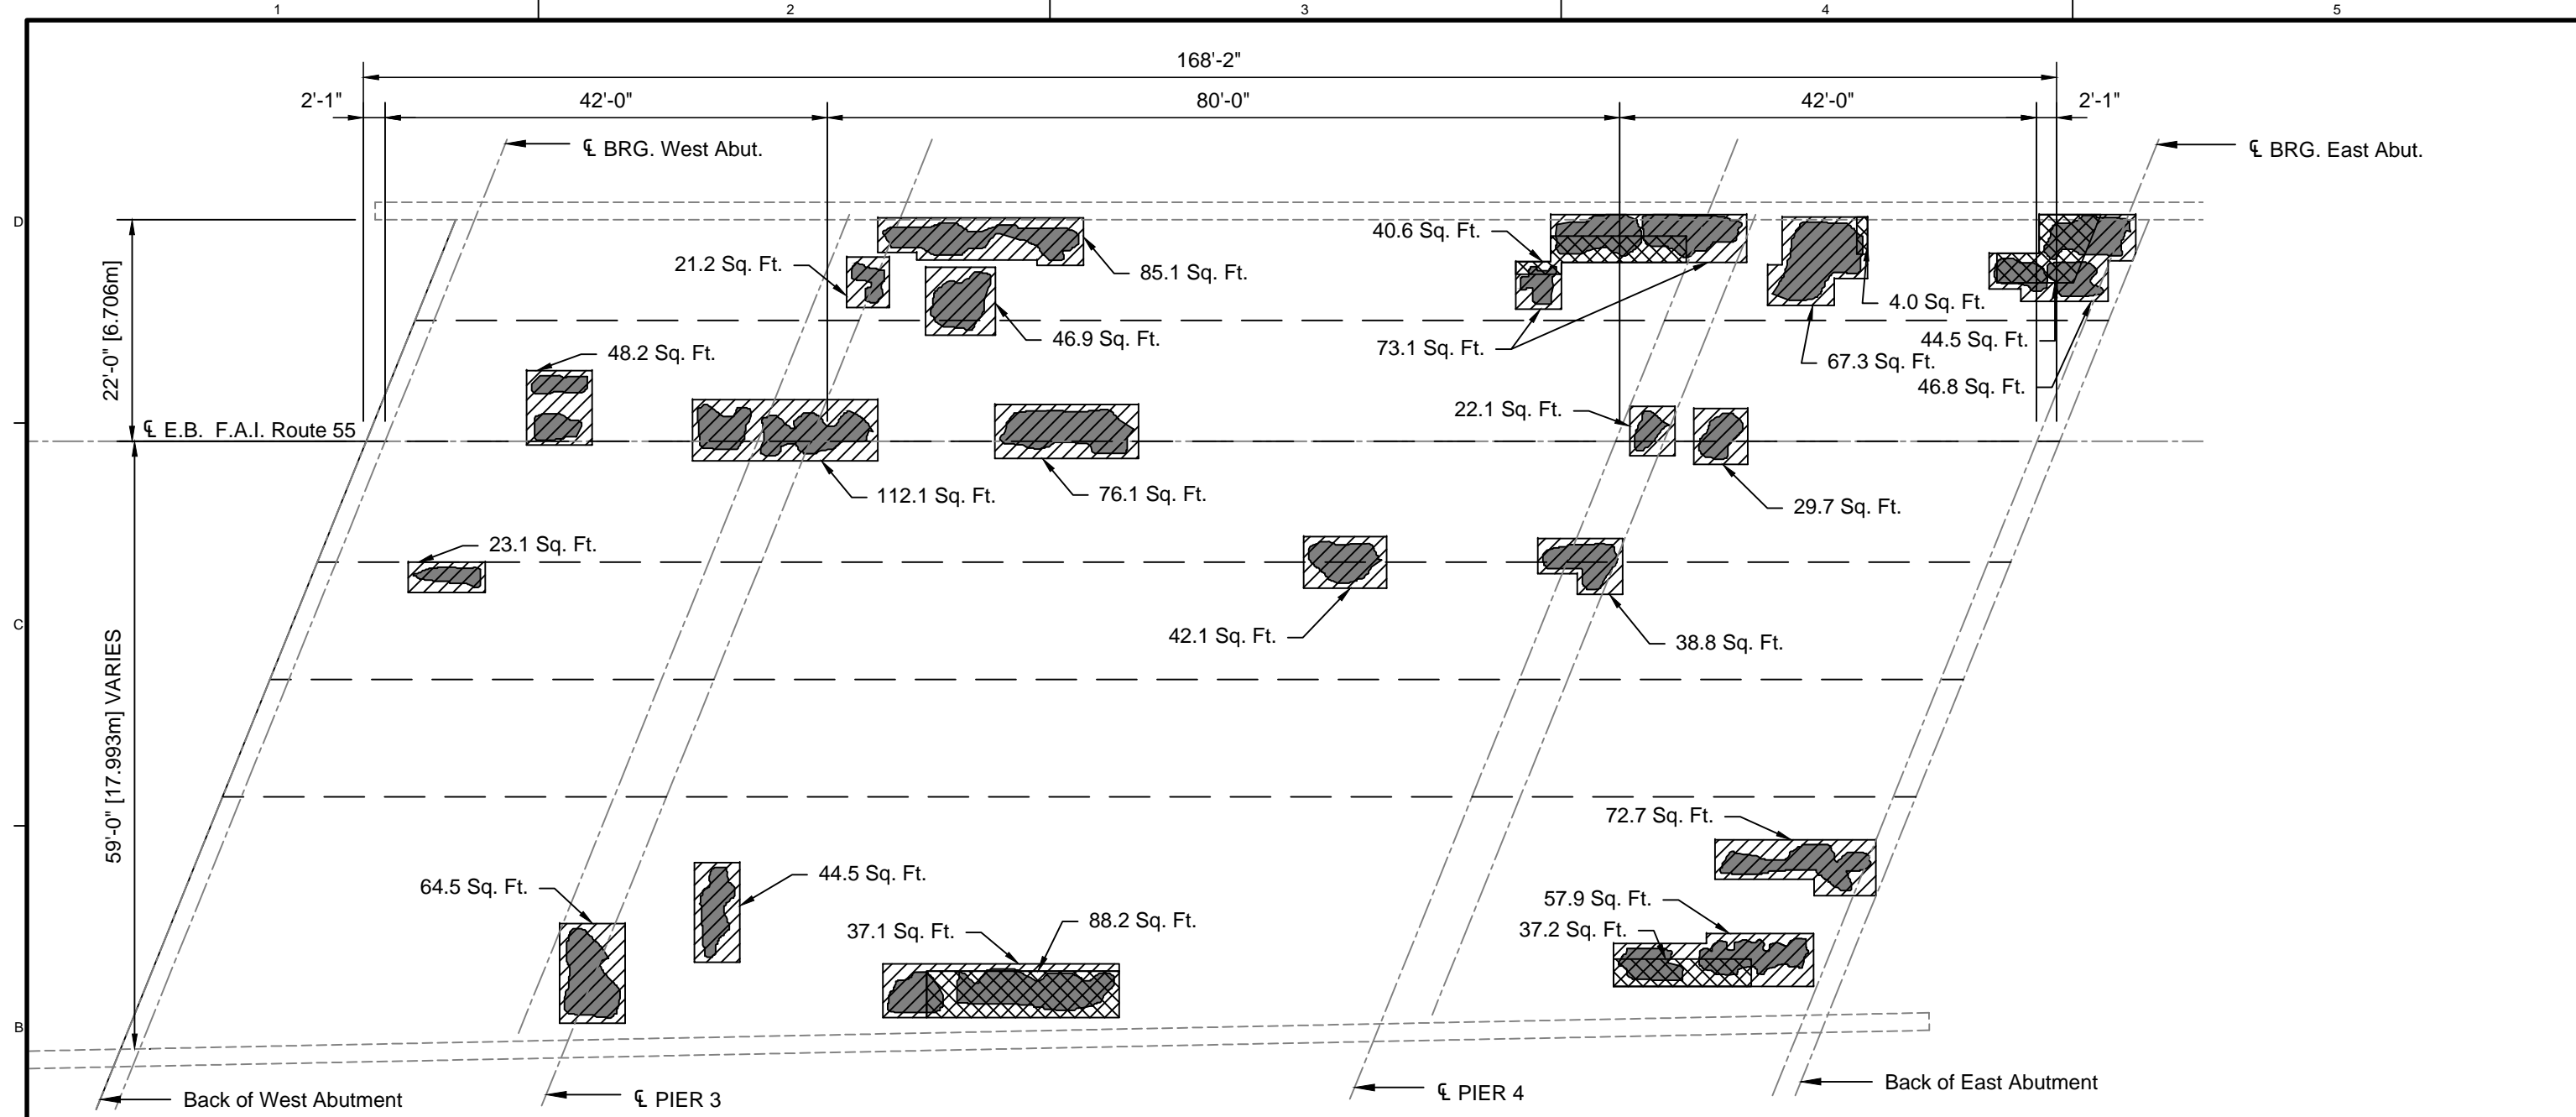

FIELD OBSERVATION SUMMARY		STRUCTURE # 016-0018		LEGEND	
ITEM	UNIT	QUANT.	%		
TOTAL AREA	Ac	13260	100	PARTIAL DEPTH REPAIR	
PARTIAL DEPTH REPAIR	Ac	1009	7.6	FULL DEPTH REPAIR	
FULL DEPTH REPAIR	Ac	214	1.6	DELAMINATION	
DELAMINATION	Ac	605	4.6	SPALL	
SPALL	Ac	0	0	CRACK	
CRACKS	ft	-	-		

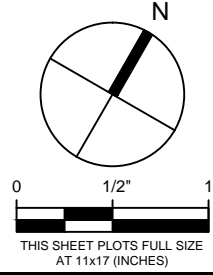

WJE ENGINEERS ARCHITECTS MATERIALS SCIENTISTS
 Wiss, Janney, Elstner Associates, Inc.
 330 Pfingsten Road
 Northbrook, Illinois 60062
 847.272.7400 tel | 847.291.4813 fax
 www.wje.com

Client
Illinois Department of Transportation
 District One
 201 West Center Court
 Schaumburg, Illinois 60196

Project
 Bridge 016-0018
 EASTBOUND I-55 OVER R.R.
 Sheet Title
 Proposed Repairs


Proj. No. 2009.3645.10
 Date November 19 2011
 Drawn JJZ
 Checked JAR
 Scale 1/16" = 1'-0"

Sheet No.


S4

ATTACHMENT F

Substructure Condition Surveys

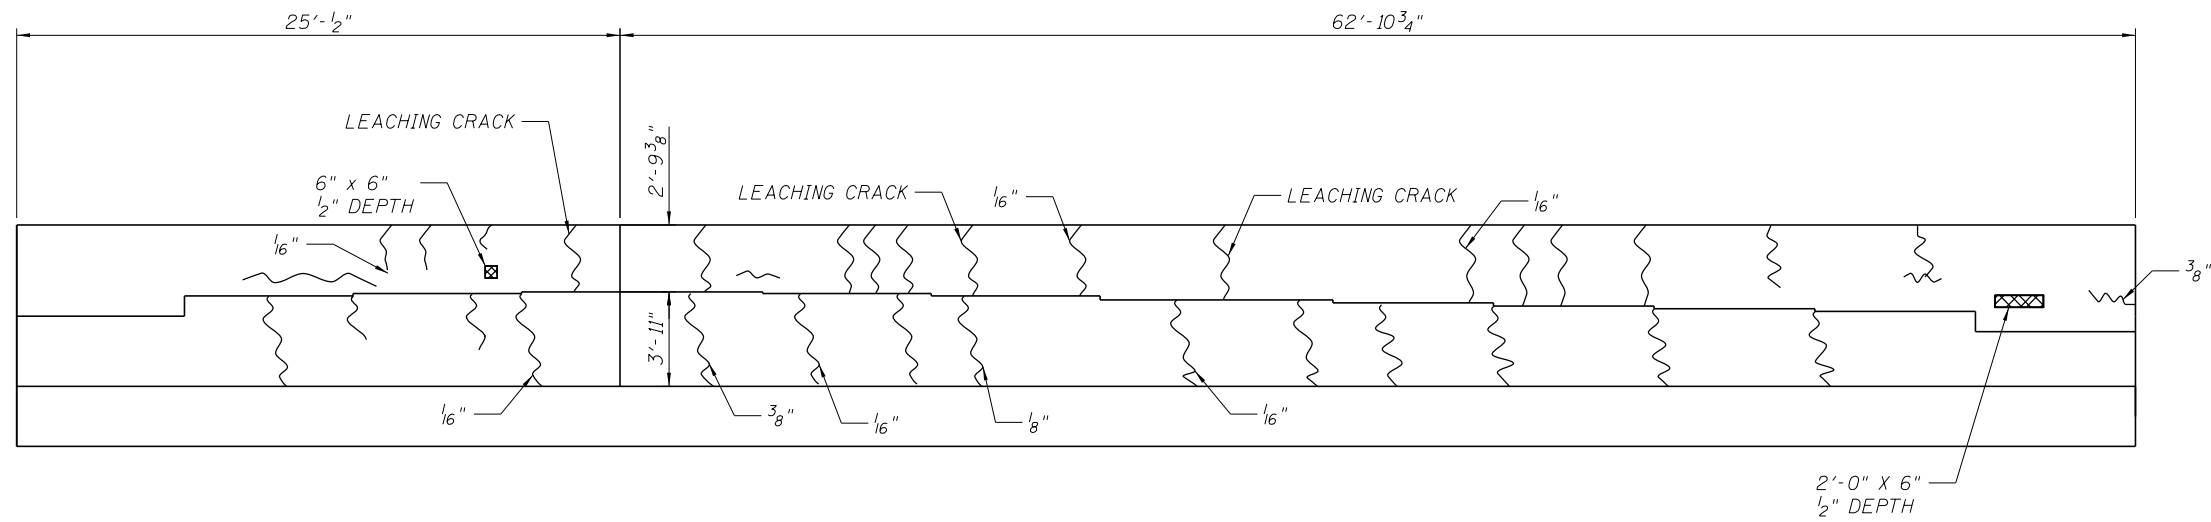

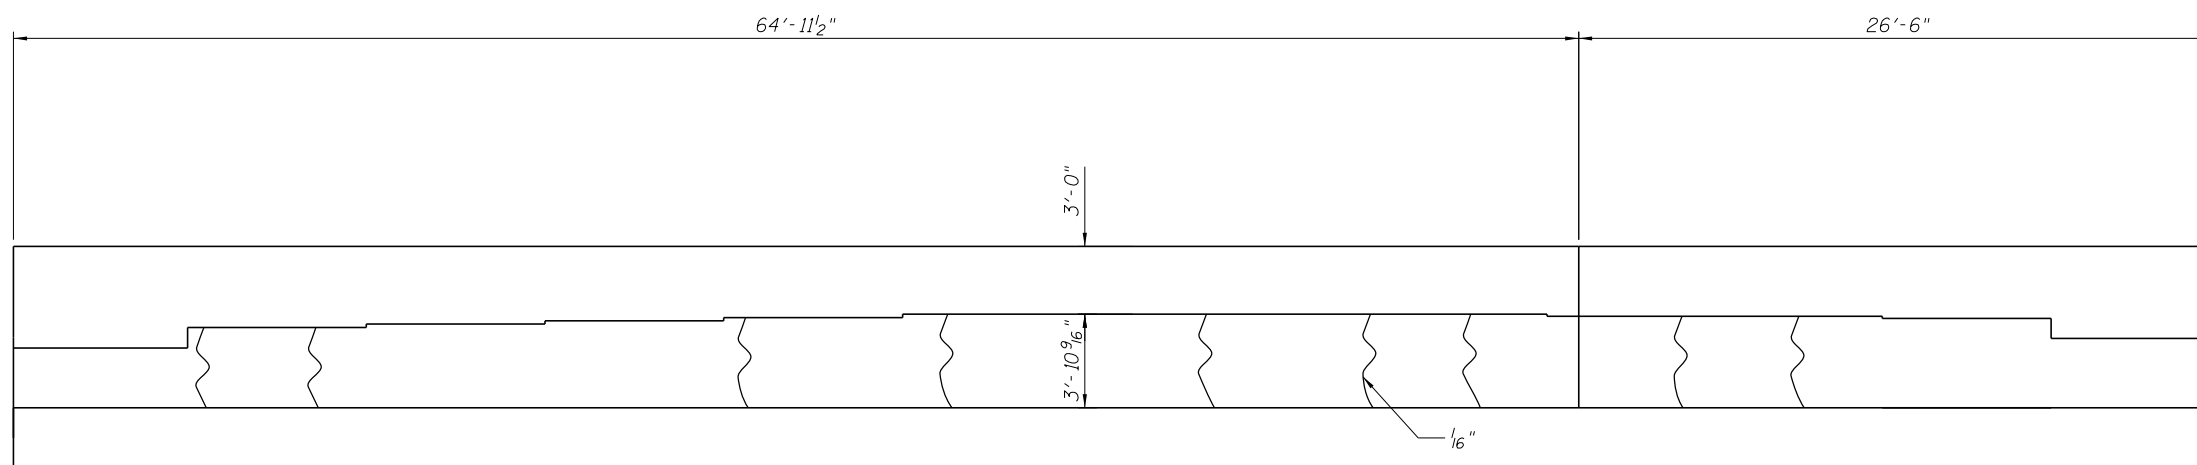


EAST ABUTMENT LOOKING EAST



WEST ABUTMENT LOOKING WEST

LEGEND

-  - HAIRLINE CRACK (UNLESS OTHERWISE NOTED)
-  - SPALLED CONCRETE
-  - DELAMINATED CONCRETE

FILE NAME = V:\1786\active\178600037_IDOT_155\structural\drawing\shd\dwg_BRC_Railroad_Abument_Elevation.dgn



USER NAME = jerojas	DESIGNED - JSR	REVISED -
	CHECKED - BPS	REVISED -
PLOT SCALE = N/A	DRAWN - JSR	REVISED -
PLOT DATE = 10/5/2013	CHECKED - BPS	REVISED -


**STATE OF ILLINOIS
DEPARTMENT OF TRANSPORTATION**

**ATTACHMENT F - SUBSTRUCTURE CONDITION SURVEY
STRUCTURE NO. 016-0018**


SHEET NO. 1 OF 3 SHEETS

F.A.I. RTE.	SECTION	COUNTY	TOTAL SHEETS	SHEET NO.
55	1212-620-VB	COOK		
CONTRACT NO.				
FED. ROAD DIST. NO. 1 ILLINOIS FED. AID PROJECT				

UNDERSIDE
SPALL
1' 6" X 3' WIDE
1 1/2" DEPTH
3 BARS EXPOSED

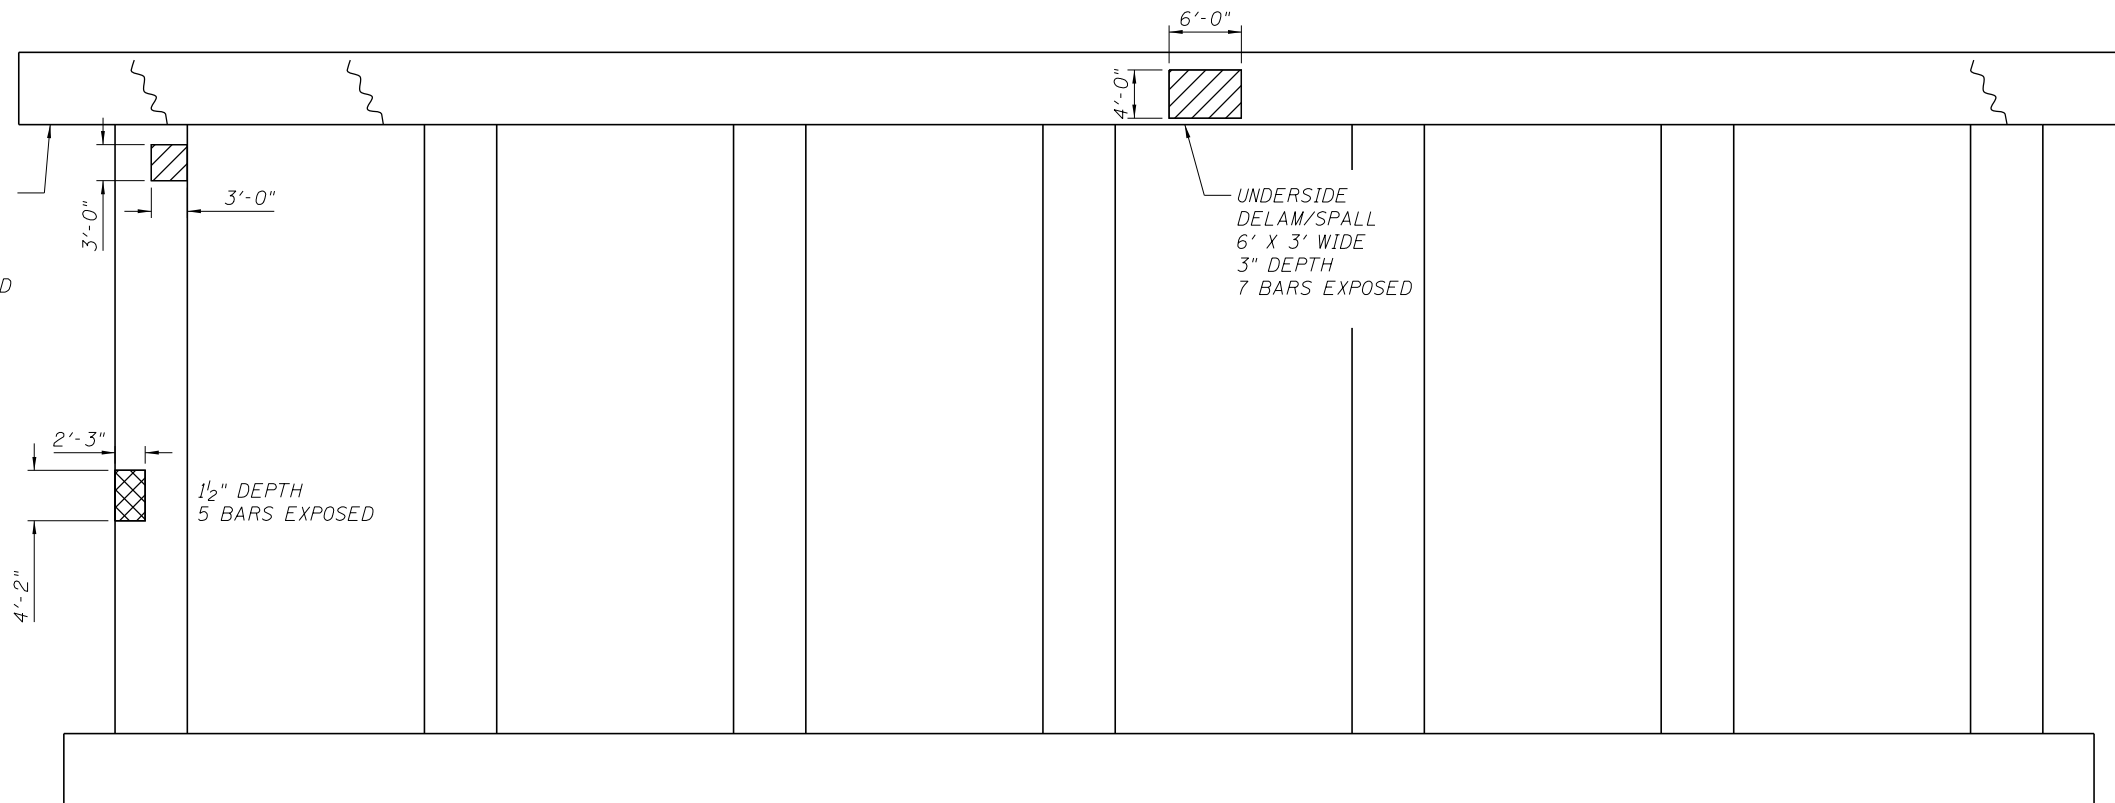

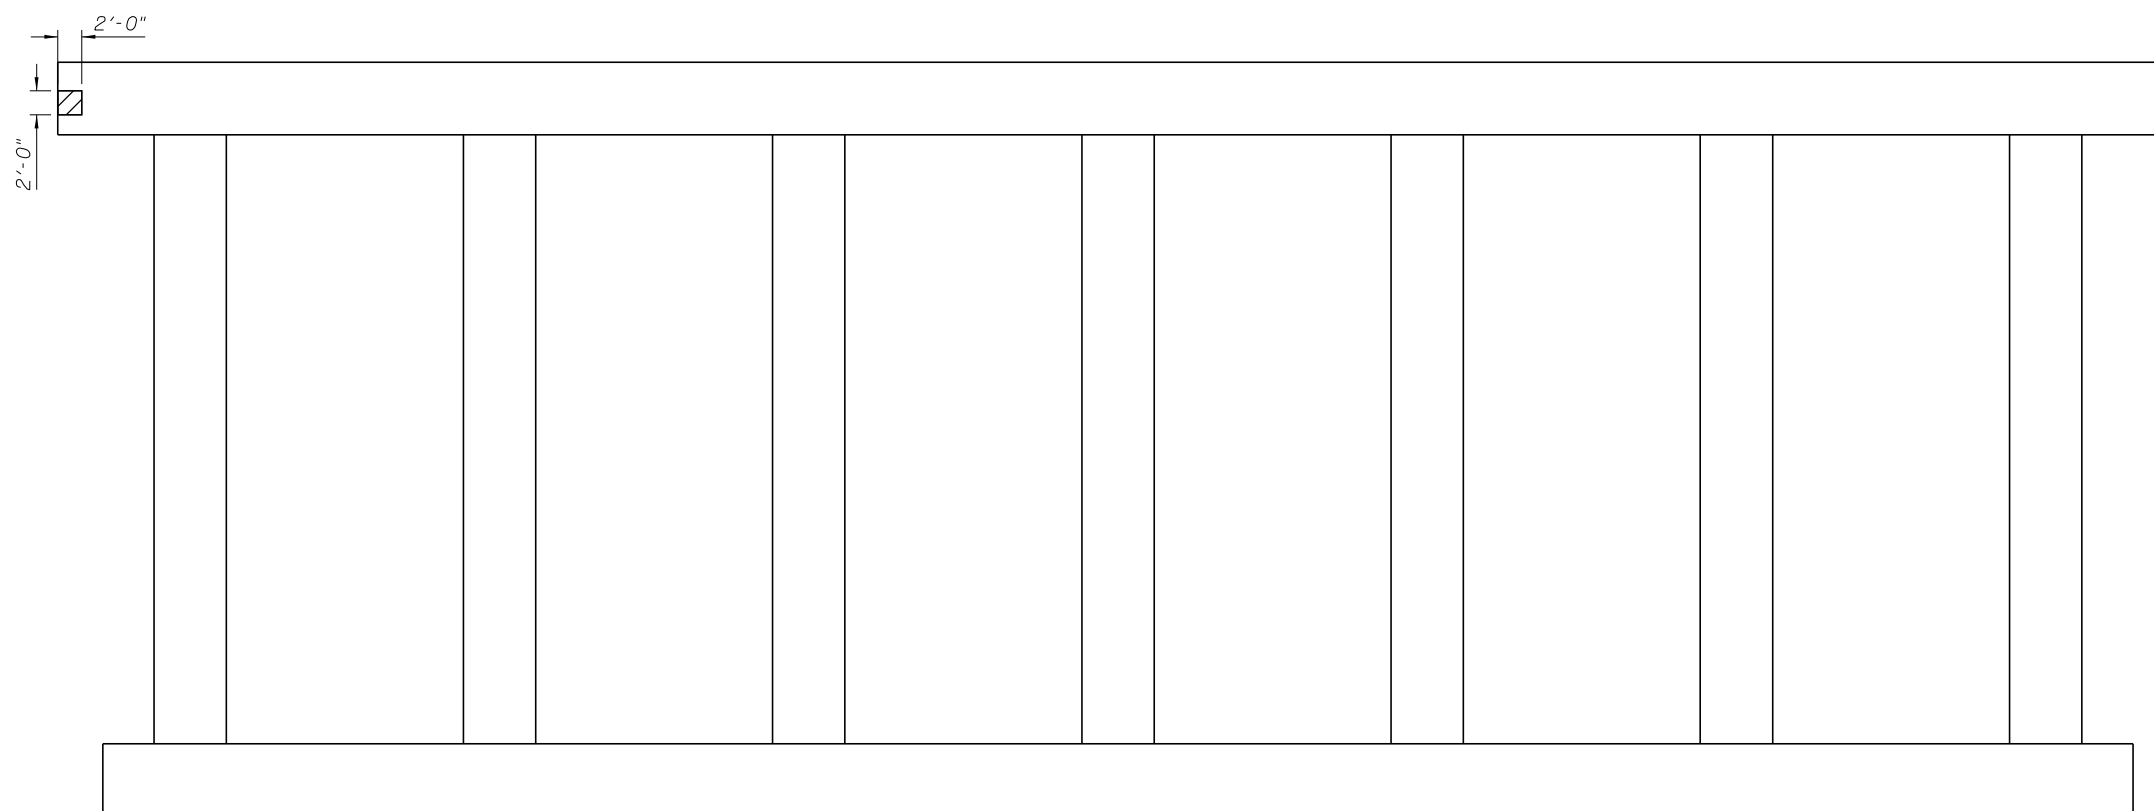


PIER 1
LOOKING EAST



PIER 1
LOOKING WEST

LEGEND

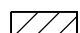-  - CRACKED CONCRETE
-  - SPALLED CONCRETE
-  - DELAMINATED CONCRETE

FILE NAME = W:\1786\active\178600037_IDOT_1-95\structural\drawing\shd\dwg_BRC_Railroad_Pier-Elevation.dgn




USER NAME = jerojas	DESIGNED - JSR	REVISED -
	CHECKED - BPS	REVISED -
PLOT SCALE = N/A	DRAWN - JSR	REVISED -
PLOT DATE = 10/5/2013	CHECKED - BPS	REVISED -

STATE OF ILLINOIS
DEPARTMENT OF TRANSPORTATION

ATTACHMENT F - SUBSTRUCTURE CONDITION SURVEY
STRUCTURE NO. 016-0018


SHEET NO. 2 OF 3 SHEETS

F.A.I. RTE.	SECTION	COUNTY	TOTAL SHEETS	SHEET NO.
55	1212-620-VB	COOK		
CONTRACT NO.				
FED. ROAD DIST. NO. 1 ILLINOIS FED. AID PROJECT				

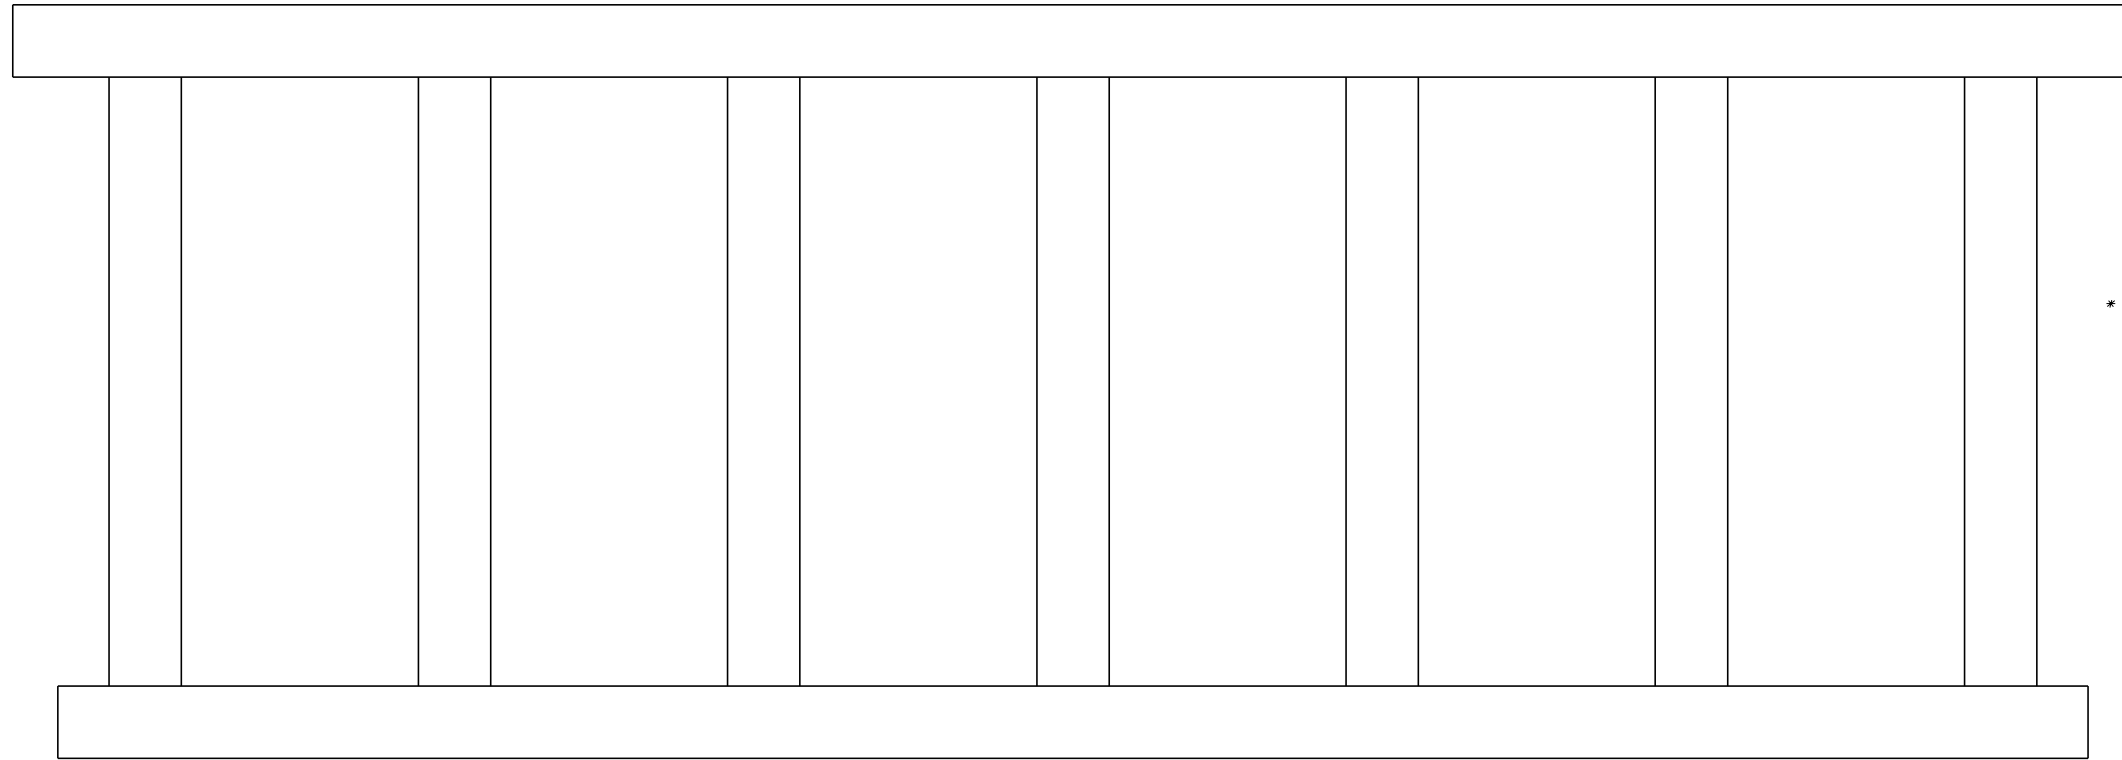

* NO DEFECTS

PIER 2
LOOKING EAST

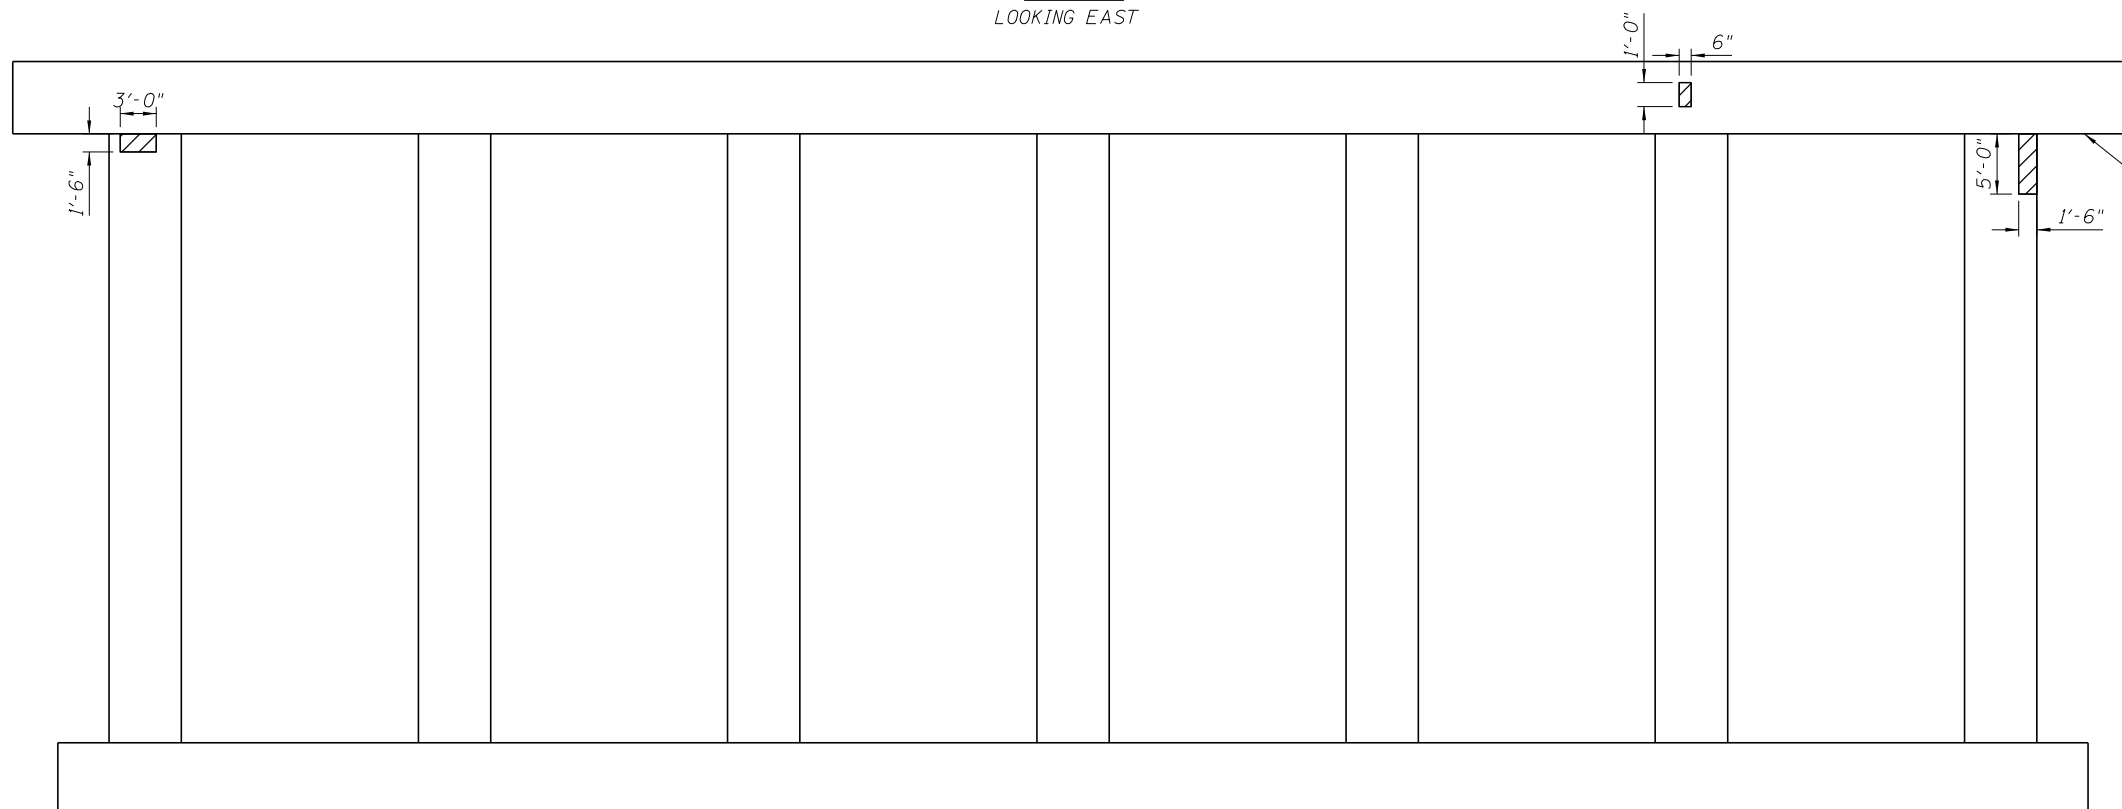

UNDERSIDE
DELAM/SPALL
1'-6" X 3'-0" WIDE
3" DEPTH
2 BARS EXPOSED

PIER 2
LOOKING WEST

LEGEND

- SPALLED CONCRETE
- DELAMINATED CONCRETE

FILE NAME = V:\1786\active\178600037_IDOT_1-95\structural\drawing\shd\dwg_BRC_Railroad_Pier-Elevation.dgn



USER NAME = jerojas	DESIGNED - JSR	REVISED -
	CHECKED - BPS	REVISED -
PLOT SCALE = N/A	DRAWN - JSR	REVISED -
PLOT DATE = 10/5/2013	CHECKED - BPS	REVISED -

STATE OF ILLINOIS
DEPARTMENT OF TRANSPORTATION

ATTACHMENT F - SUBSTRUCTURE CONDITION SURVEY
STRUCTURE NO. 016-0018

SHEET NO. 3 OF 3 SHEETS

F.A.I. RTE.	SECTION	COUNTY	TOTAL SHEETS	SHEET NO.
55	1212-620-VB	COOK		
CONTRACT NO.				
FED. ROAD DIST. NO. 1 ILLINOIS FED. AID PROJECT				

ATTACHMENT G

Opinion of Probable Costs

Sheet: _____ of _____
 Calc By: JSR Date: 10/5/13
 Check By: BHS Date: 12/17/13
 Project Number: 178600037
 Subject: OPINION OF PROBABLE COST
I-55 EB over BRC Railroad (016-0018)

ALTERNATIVE 1 - IN-KIND REPAIRS

QUANTITY CODE	QUANTITY DESCRIPTION	QUANTITY	UNIT COST	TOTAL COST
50300300	Protective Coat	1680 sy	\$2.00	\$3,360
50500105	Furnishing and Erecting Structural Steel	7940 lb	\$5.00	\$39,700
59000200	Epoxy Crack Injection	26 ft	\$150	\$3,900
Z0012754	Struct Repair of Concrete (Depth = < 5 Inches)	136 sf	\$175	\$23,800
Z0016001	Deck Slab Repair (Full Depth)	89 sy	\$750	\$66,750
Z0016200	Deck Slab Repair (Partial Depth)	122 sy	\$400	\$48,800
Z0048665	Railroad Protective Liability Insurance	1 LS	\$5,000	\$5,000
SUB TOTAL =				\$191,310
MOBILIZATION (10%) =				\$19,131
CONTINGENCY (20%) =				\$38,262
TOTAL =				\$248,800

ALTERNATIVE 2 - STRUCTURE WIDENING

QUANTITY CODE	QUANTITY DESCRIPTION	QUANTITY	UNIT COST	TOTAL COST
50102400	Concrete Removal	9 cy	\$600	\$5,400
50104720	Removal of Existing Concrete Deck	1 LS	\$179,000	\$179,000
50200100	Structure Excavation	258 cy	\$35.00	\$9,030
50300225	Concrete Structures	212 cy	\$700	\$148,400
50300255	Concrete Superstructure	807 cy	\$800	\$645,600
50300260	Bridge Deck Grooving	2465 sy	\$7.00	\$17,260
50300300	Protective Coat	1995 sy	\$2.00	\$3,990
50500105	Furnishing and Erecting Structural Steel	1 LS	\$285,600	\$285,600
50500505	Stud Shear Connectors	378 each	\$3.00	\$1,130
50800205	Reinforcement Bars, Epoxy Coated	244150 lbs	\$1.75	\$427,260
51201400	Fur Stil Pile HP10x42	3,280 ft	\$45.00	\$147,600
51203400	Test Pile Stil HP10x42	4 each	\$2,000	\$8,000
52000110	Preformed Joint Strip Seal	450 ft	\$175	\$78,750
52100010	Elastomeric Bearing Assembly, Type I	3 each	\$800	\$2,400
59000200	Epoxy Crack Injection	26 ft	\$150	\$3,900
59100100	Geocomposite Wall Drain	26 sy	\$25.00	\$650
X2070304	Porous Granular Embankment, Special	36 cy	\$50.00	\$1,800
Z0004552	Approach Slab Removal	292 sy	\$35.00	\$10,220
Z0012754	Struct Repair of Concrete (Depth = < 5 Inches)	136 sf	\$175	\$23,800
Z0026407	Temporary Sheet Piling	580 sf	\$30.00	\$17,410
Z0046304	Pipe Underdrains for Structures 4"	40 ft	\$20.00	\$800
Z0048665	Railroad Protective Liability Insurance	1 LS	\$5,000	\$5,000
SUB TOTAL =				\$2,023,000
MOBILIZATION (10%) =				\$202,300
CONTINGENCY (20%) =				\$404,600
TOTAL =				\$2,629,900

Sheet: _____ of _____
 Calc By: JSR Date: 10/5/13
 Check By: BHS Date: 12/17/13
 Project Number: 178600037
 Subject: OPINION OF PROBABLE COST
I-55 EB over BRC Railroad (016-0018)

ALTERNATIVE 3 - SUPERSTRUCTURE AND PARTIAL SUBSTRUCTURE REPLACEMENT

CODE	QUANTITY DESCRIPTION	QUANTITY	UNIT COST	TOTAL COST
50101500	Removal of Existing Superstructures	1 LS	\$215,000	\$215,000
50102400	Concrete Removal	305 cy	\$600	\$183,000
50104650	Slope Wall Removal	1530 sy	\$7.00	\$10,710
50200100	Structure Excavation	679 cy	\$35.00	\$23,760
50300225	Concrete Structures	337 cy	\$700	\$235,900
50300255	Concrete Superstructure	944 cy	\$800	\$755,200
50300260	Bridge Deck Grooving	2629 sy	\$7.00	\$18,400
50300300	Protective Coat	2226 sy	\$2.00	\$4,450
50500105	Furnishing and Erecting Structural Steel	1 LS	\$1,126,000	\$1,126,000
50500505	Stud Shear Connectors	9180 each	\$3.00	\$27,540
50800205	Reinforcement Bars, Epoxy Coated	303400 lbs	\$1.75	\$530,950
51100100	Slope Wall 4 Inch	1458 sy	\$100	\$145,800
51201400	Fur Stl Pile HP10x42	4540 ft	\$45.00	\$204,300
51203400	Test Pile Stl HP10x42	4 each	\$2,000	\$8,000
52100010	Elastomeric Bearing Assembly, Type I	17 each	\$800	\$13,600
59100100	Geocomposite Wall Drain	162 sy	\$25.00	\$4,050
X2070304	Porous Granular Embankment, Special	275 cy	\$50.00	\$13,750
Z0004552	Approach Slab Removal	292 sy	\$35.00	\$10,220
Z0012754	Structural Repair of Concrete (< 5 Inches)	52 sf	\$175	\$9,100
Z0026407	Temporary Sheet Piling	1597 sf	\$30.00	\$47,910
Z0046304	Pipe Underdrains for Structures 4"	237 ft	\$20.00	\$4,740
Z0048665	Railroad Protective Liability Insurance	1 LS	\$5,000	\$5,000
SUB TOTAL =				\$3,597,380
MOBILIZATION (10%) =				\$359,738
CONTINGENCY (20%) =				\$719,476
TOTAL =				\$4,676,600

ALTERNATIVE 4 - STRUCTURE REPLACEMENT


QUANTITY CODE	QUANTITY DESCRIPTION	QUANTITY	UNIT COST	TOTAL COST
50100100	Removal of Existing Structures	1 LS	\$578,000	\$578,000
50104650	Slope Wall Removal	1530 sy	\$7.00	\$10,710
50200100	Structure Excavation	1217 cy	\$35.00	\$42,600
50300225	Concrete Structures	699 cy	\$700	\$489,300
50300255	Concrete Superstructure	944 cy	\$800	\$755,200
50300260	Bridge Deck Grooving	2629 sy	\$7.00	\$18,400
50300300	Protective Coat	2226 sy	\$2.00	\$4,450
50500105	Furnishing and Erecting Structural Steel	1 LS	\$1,126,000	\$1,126,000
50500505	Stud Shear Connectors	9180 each	\$3.00	\$27,540
50800205	Reinforcement Bars, Epoxy Coated	375800 lbs	\$1.75	\$657,650
51100100	Slope Wall 4 Inch	1458 sy	\$100	\$145,800
51201400	Fur Stl Pile HP10x42	9,580 ft	\$45.00	\$431,100
51203400	Test Pile Stl HP10x42	4 each	\$2,000	\$8,000
52100010	Elastomeric Bearing Assembly, Type I	17 each	\$800	\$13,600
59100100	Geocomposite Wall Drain	162 sy	\$25.00	\$4,050
X2070304	Porous Granular Embankment, Special	275 cy	\$50.00	\$13,750
Z0004552	Approach Slab Removal	292 sy	\$35.00	\$10,220
Z0026407	Temporary Sheet Piling	4093 sf	\$30.00	\$122,790
Z0046304	Pipe Underdrains for Structures 4"	237 ft	\$20.00	\$4,740
Z0048665	Railroad Protective Liability Insurance	1 LS	\$5,000	\$5,000
SUB TOTAL =				\$4,468,900
MOBILIZATION (10%) =				\$446,890
CONTINGENCY (20%) =				\$893,780
TOTAL =				\$5,809,600

ATTACHMENT H
Proposed Structure Drawings


Notes:

The number and location of substructure units, the profile grade, skew angle, and the bridge length and width are subject to refinement in the TSL phase.

Superstructure type, beam spacing, and rail type to be determined during the TSL phase.

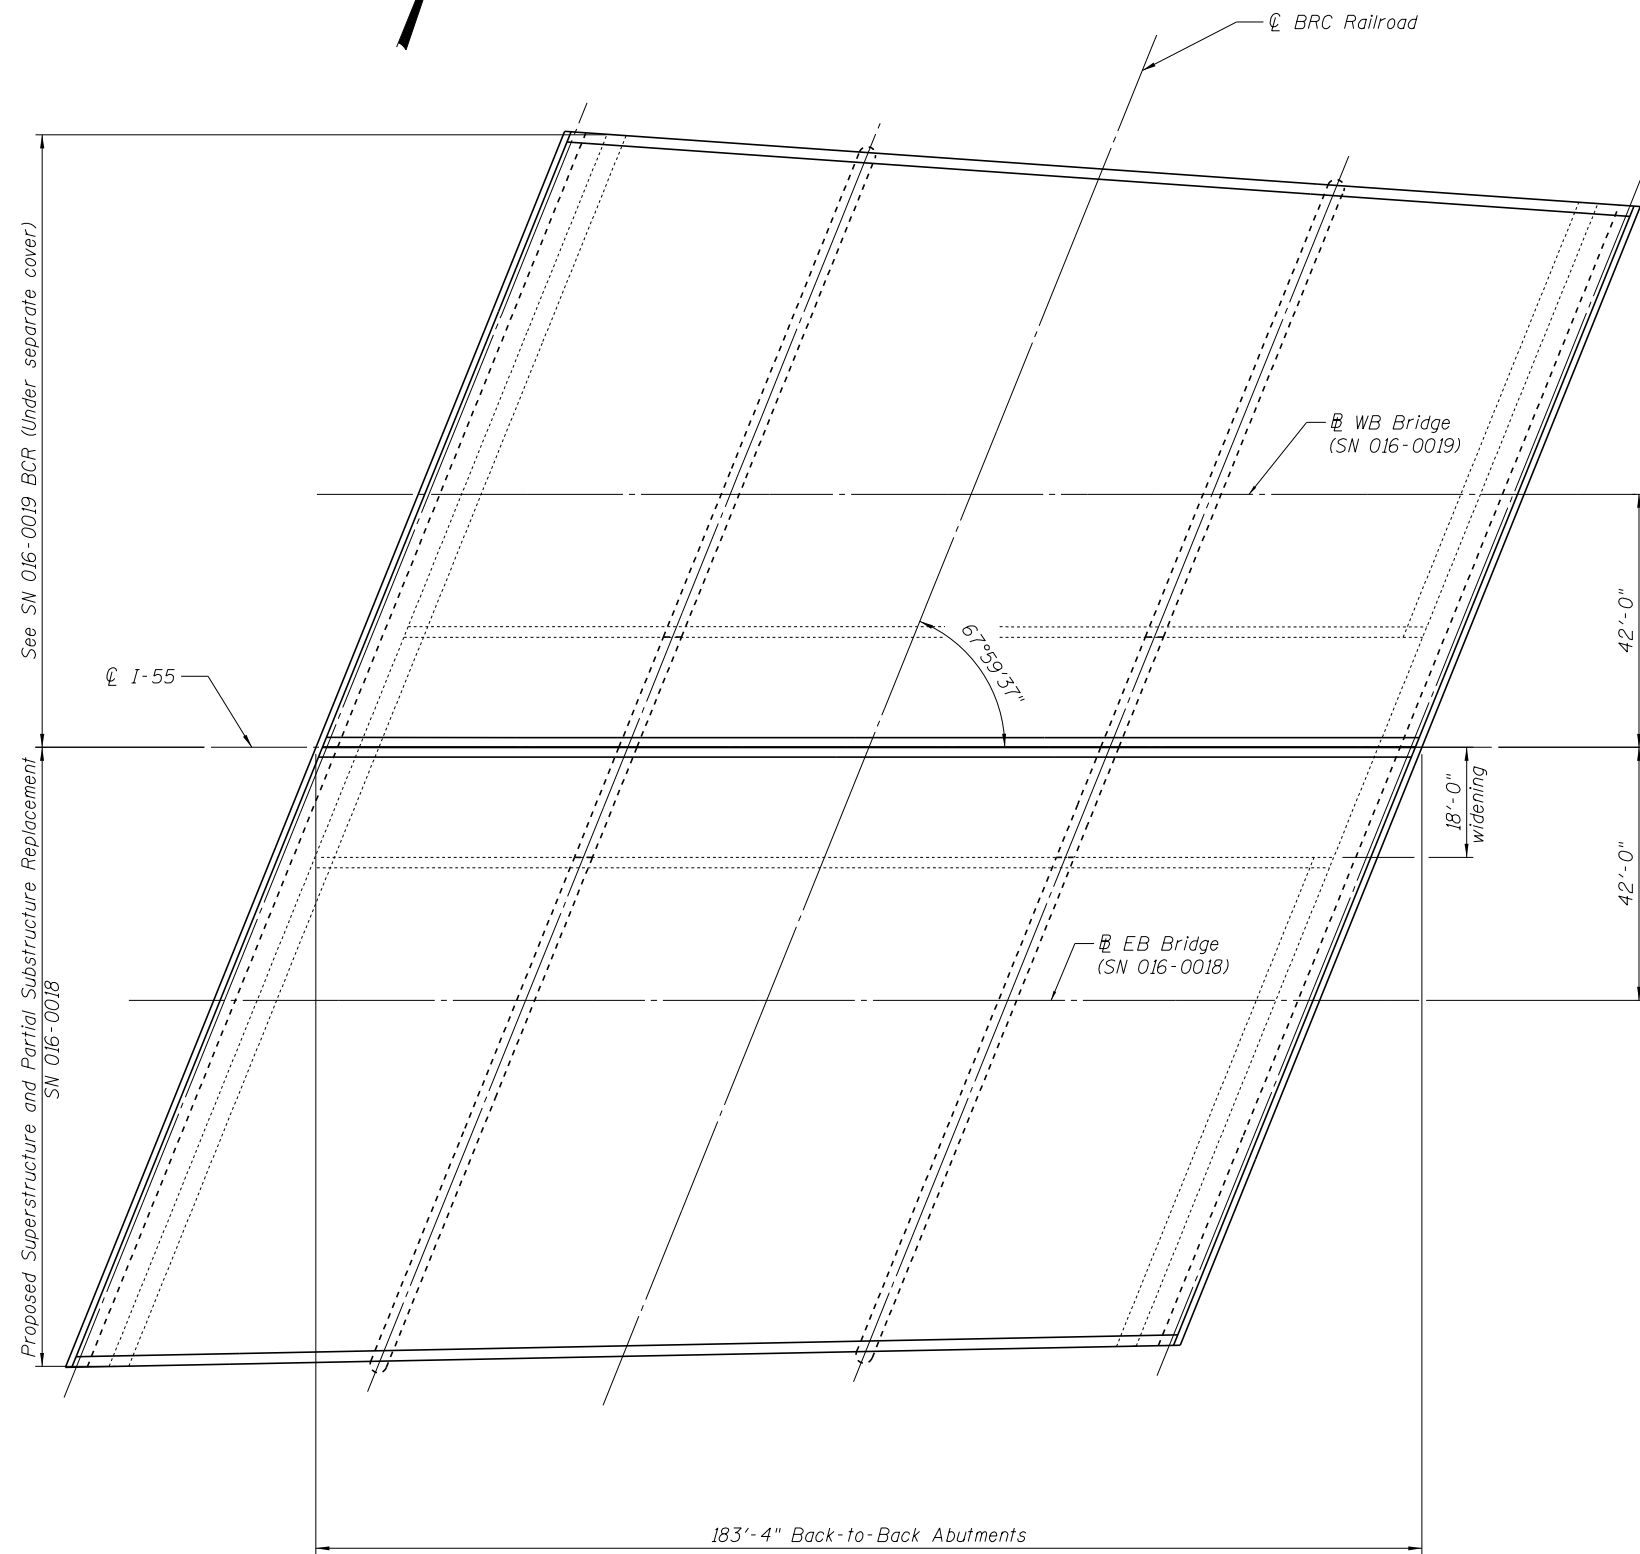

PROPOSED PLAN

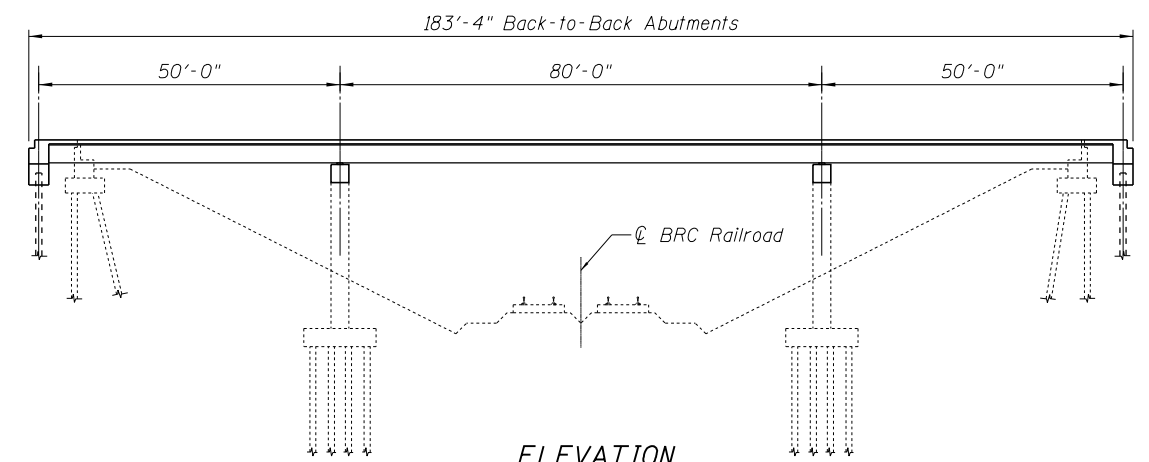

ELEVATION

FILE NAME = W:\1786\active\178600037_IDOT_I-55\structural\drawing\shd\dwg_BRC_Railroad_Deck_Plan.dgn



USER NAME = bsajers	DESIGNED - JSR	REVISED - _____
	CHECKED - BPS	REVISED - _____
PLOT SCALE = N/A	DRAWN - JSR	REVISED - _____
PLOT DATE = 12/17/2013	CHECKED - BPS	REVISED - _____

STATE OF ILLINOIS
DEPARTMENT OF TRANSPORTATION

ATTACHMENT H - PROPOSED STRUCTURE DRAWINGS
STRUCTURE NO. 016-0018

SHEET NO. 1 OF 1 SHEETS

F.A.I. RTE.	SECTION	COUNTY	TOTAL SHEETS	SHEET NO.
55	1212-620-VB	COOK		
CONTRACT NO.				
FED. ROAD DIST. NO. 1 ILLINOIS FED. AID PROJECT				

ATTACHMENT I
Structure Photos



Photo 1 - Delaminated underside of deck at south side of Span 1



Photo 2 - Typical underside of Span 1, looking west



Photo 3 - Typical underside of Span 3, looking east



Photo 4 - Typical underside of Span 2, looking west



Photo 5 – Top of Deck in Span 3, looking northwest

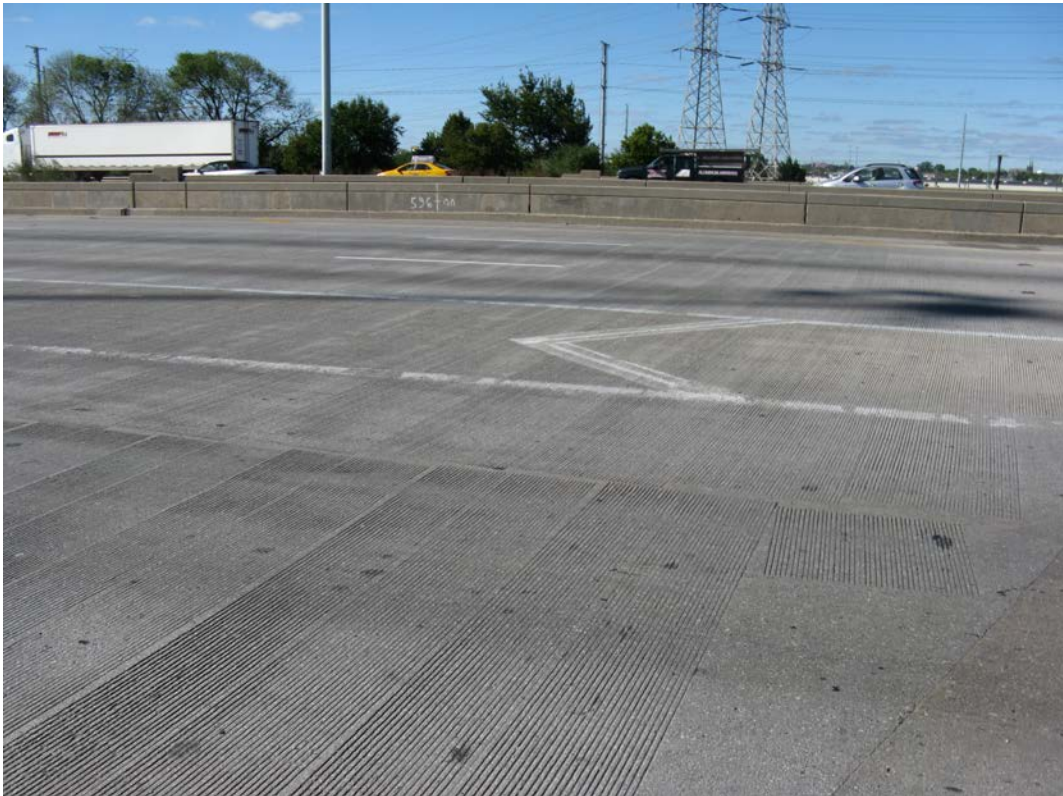


Photo 6 – Top of Deck in Span 2, looking northwest



Photo 7 – Top of Deck in Span 1, looking northwest



Photo 8 - Spalled parapet at north side at Span 1, looking southeast



Photo 9 - Spalled parapet on south side of Span 3, looking west



Photo 10 - East Abutment joint, looking north



Photo 11 - Pier 2 joint, looking north



Photo 12 - Pier 1 joint, looking north



Photo 13 - West Abutment joint, looking north



Photo 14 - Underside of Span 2 Beams, looking east



Photo 15 - North fascia, looking southwest



Photo 16 - Pin and link hangers in Span 1, looking north



Photo 17 - South fascia in Span 3, looking northwest



Photo 18 - Abandoned utility box in Span 3, southern most bay



Photo 19 - Typical bearing at East Abutment, looking southeast



Photo 20 - West Abutment, looking northwest



Photo 21 - East Abutment, looking southeast



Photo 22 – Pier 1, looking northeast



Photo 23 - Delaminated and spalled underside of Pier 1, looking northeast



Photo 24 - Spalled column at Pier 1





Photo 25 – Pier 2, looking southwest



Photo 26 - Cracked west slopewall at southeast corner, looking east

ATTACHMENT J
Proposed Plan & Profile

FILE NAME = V:\1786\active\178600037_1DOT_1-55\civil\drawing\mod\1786210-1-55_BRC_RR_Bridge_Plan_and_Profile.dgn

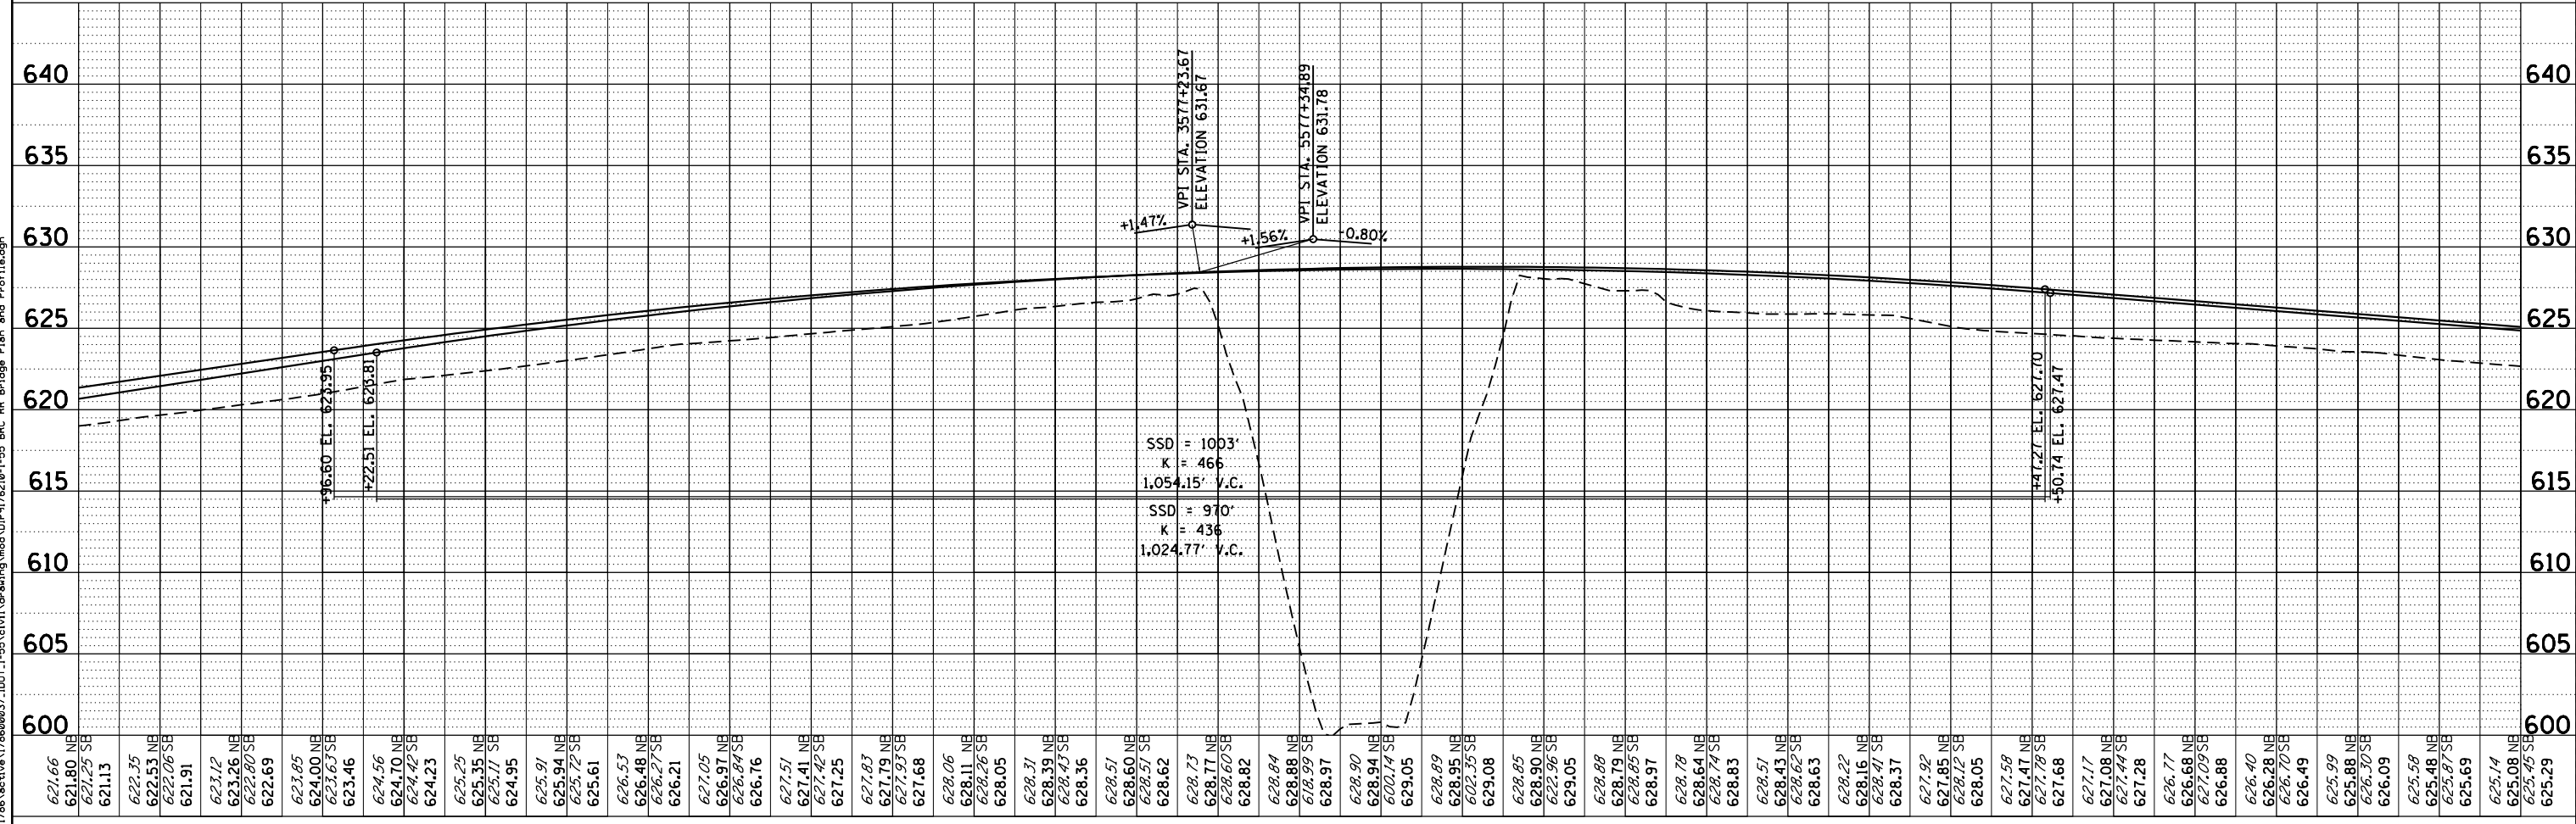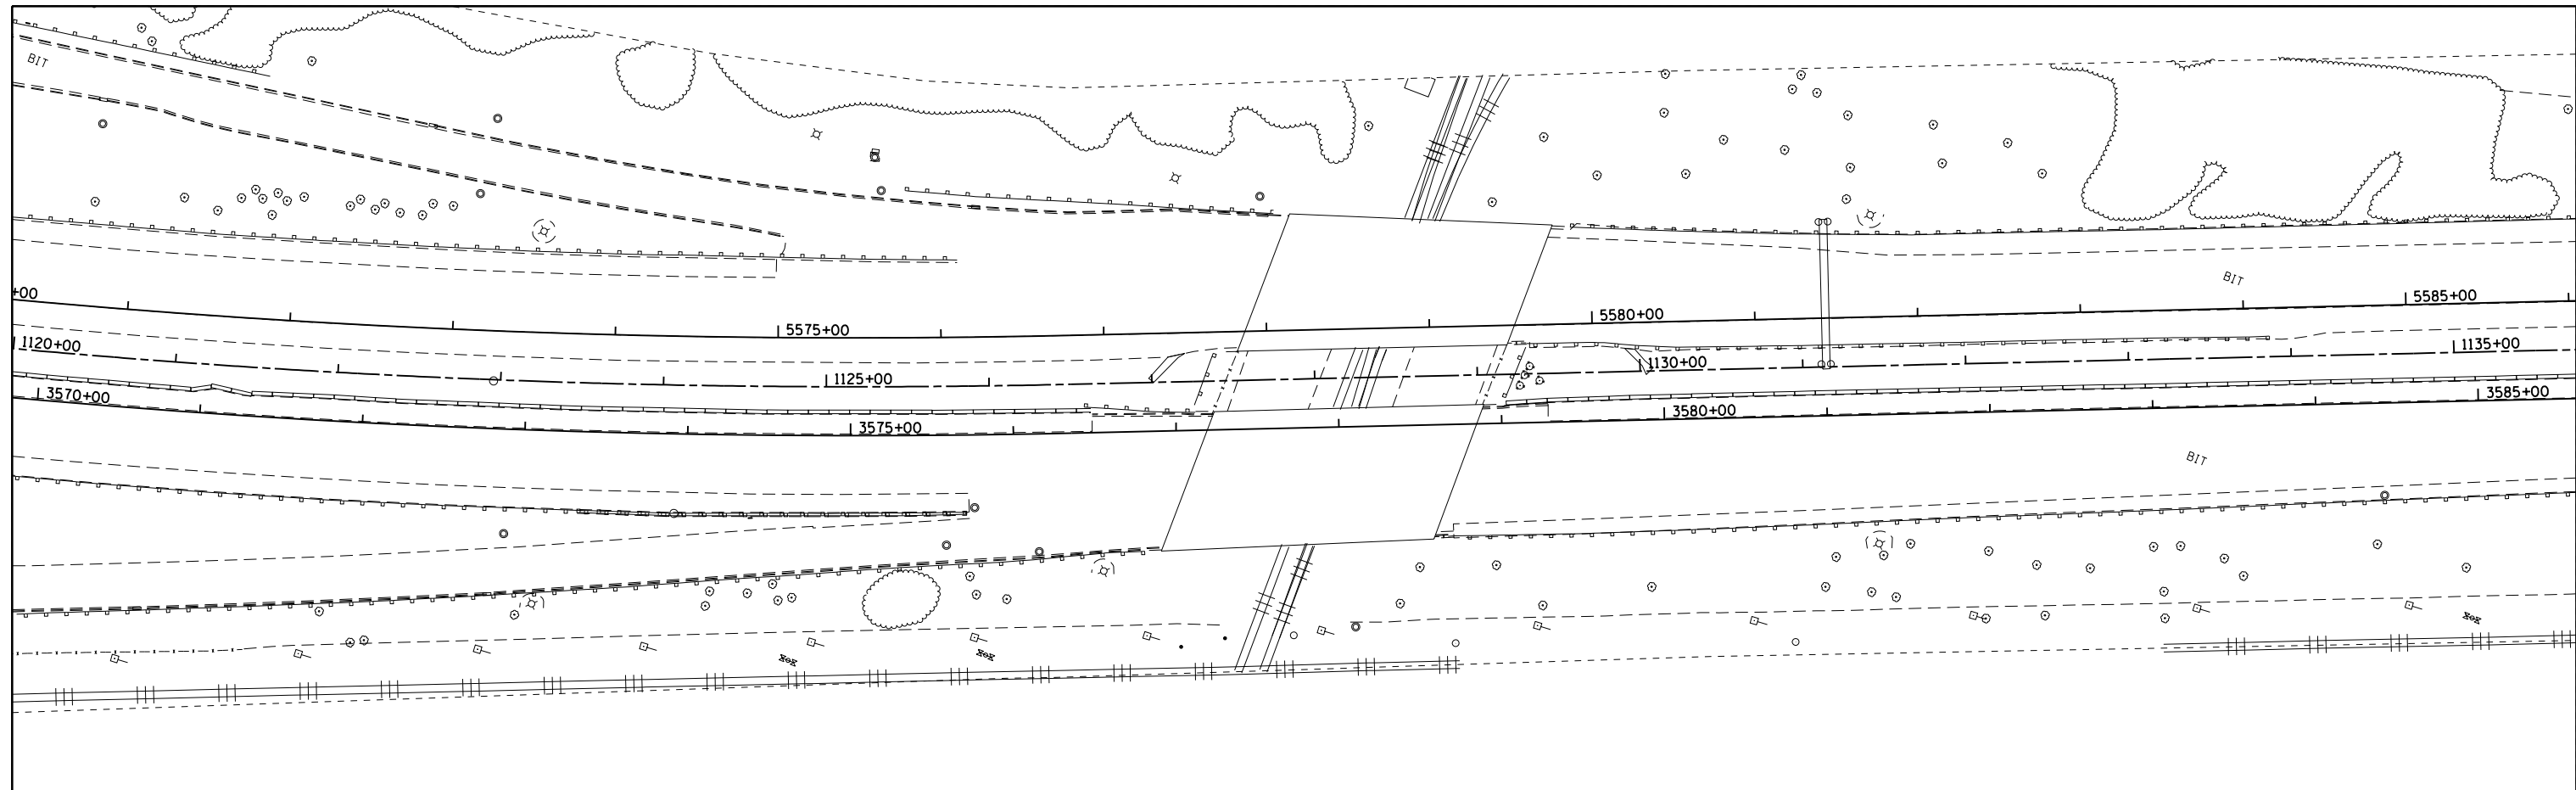

USER NAME = m.j.verhagen	DESIGNED - MJV	REVISED -
PLOT SCALE = 100.0000' / 1"	DRAWN - STANTEC	REVISED -
PLOT DATE = 10/4/2013	CHECKED -	REVISED -
	DATE - 10/04/2013	REVISED -


**STATE OF ILLINOIS
DEPARTMENT OF TRANSPORTATION**

ATTACHMENT J	
I-55 OVER BRC RAILROAD PROPOSED PLAN & PROFILE	
SCALE: 1"=100'	SHEET ___ OF ___ SHEETS STA. _____ TO STA. _____


F.A.I. RTE. 55	SECTION	COUNTY COOK	TOTAL SHEETS	SHEET NO.
CONTRACT NO.				
ILLINOIS FED. AID PROJECT				

ATTACHMENT K

**Existing and Proposed Roadway Cross
Sections**

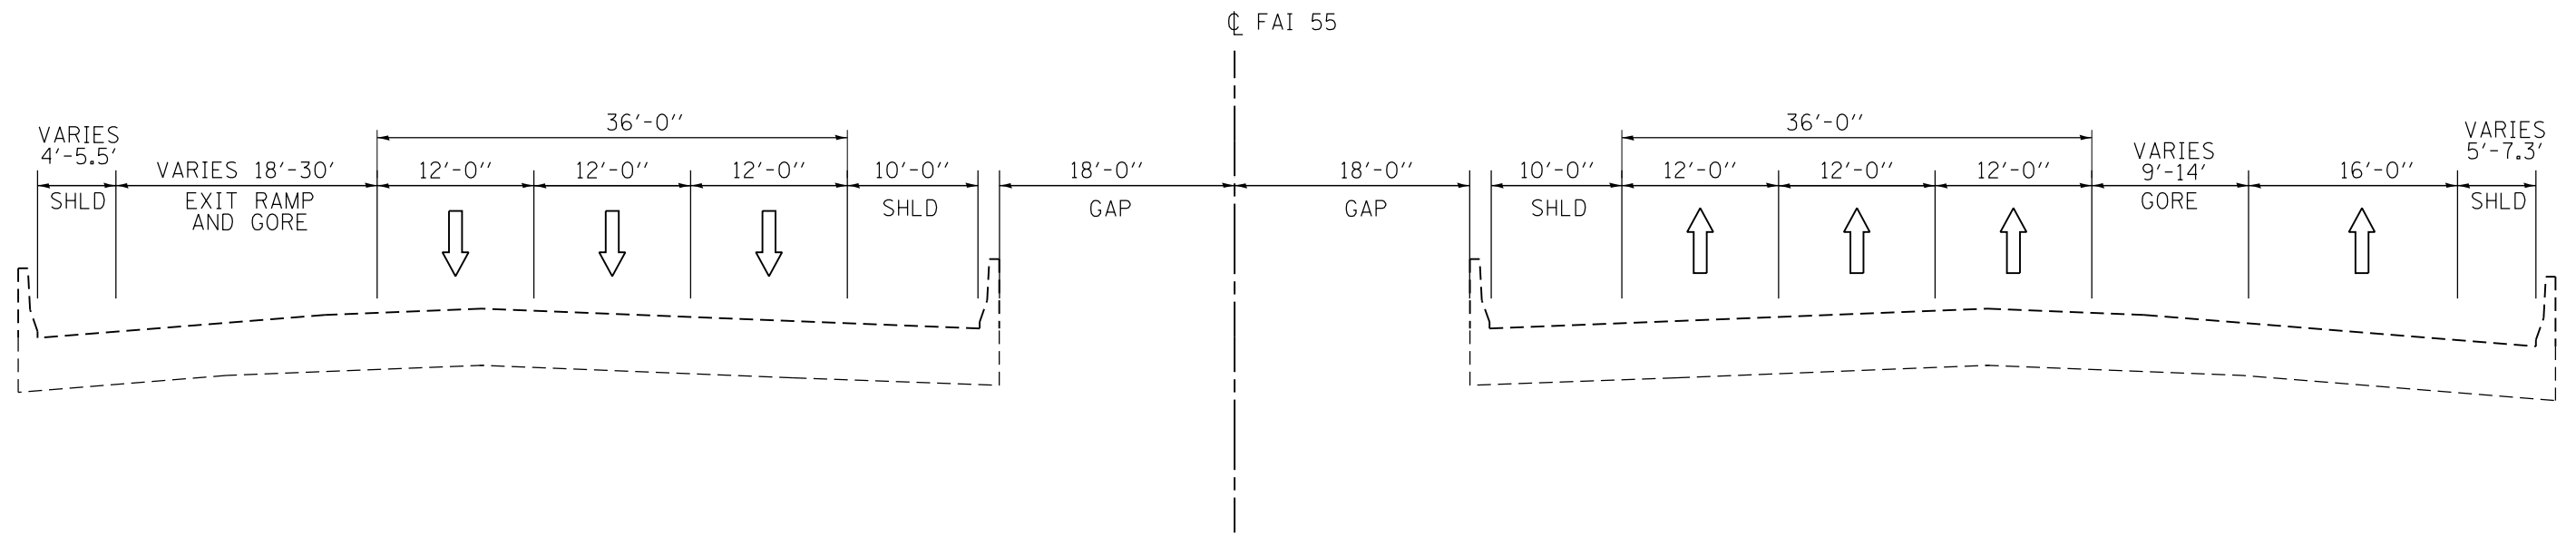

EXISTING I-55 OVER BRC RR TYPICAL SECTION

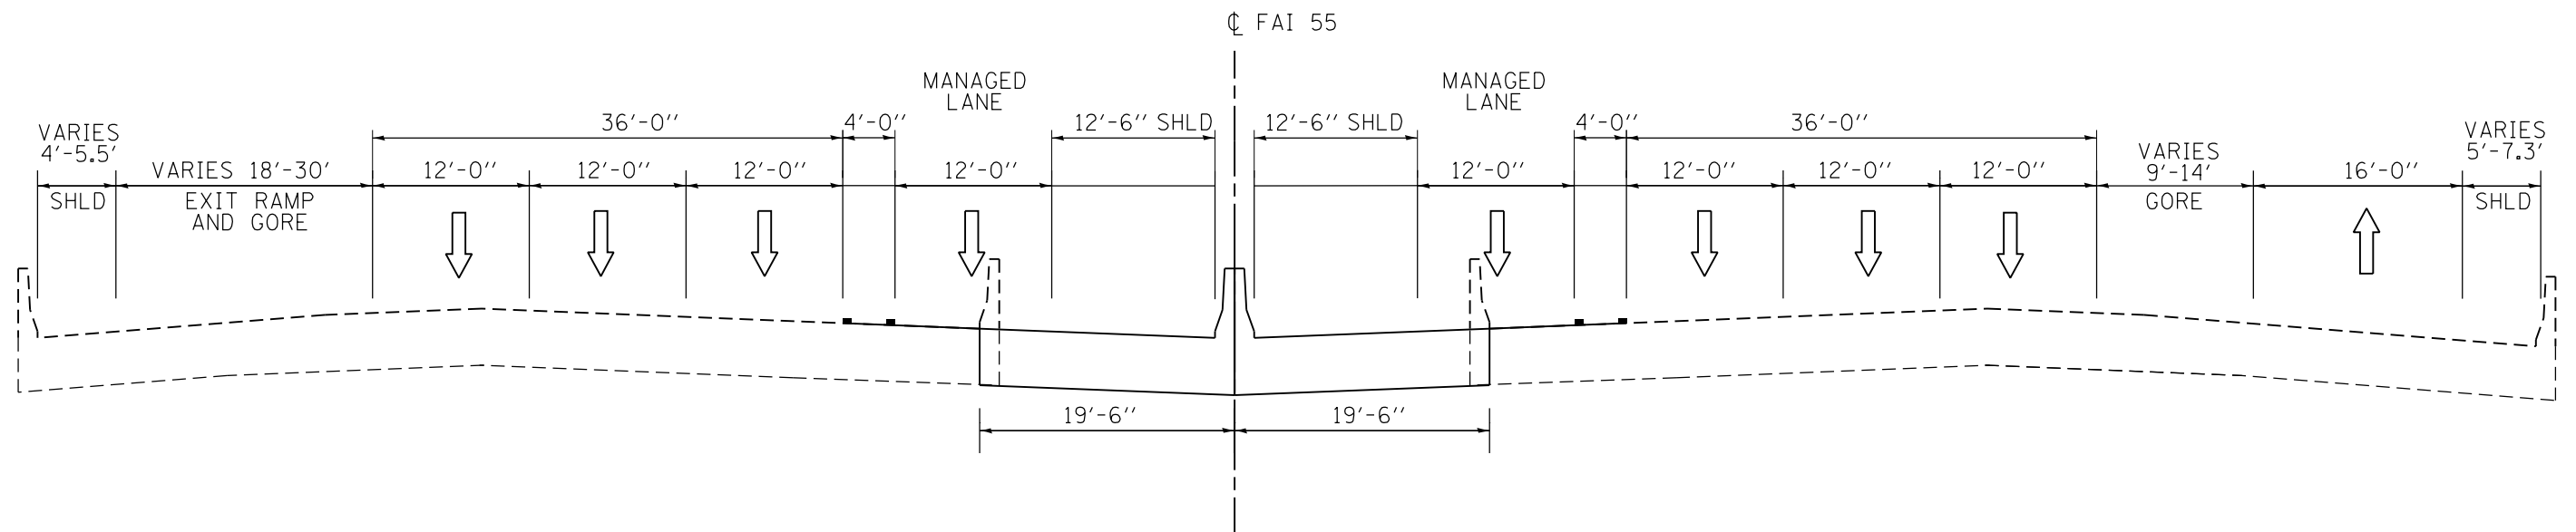

PROPOSED I-55 OVER BRC RR TYPICAL SECTION

FILE NAME = V:\1786\active\1786\0037_1001_1-55\sv1\drawing\mod\1786\1786210-typical-sections\Cicero Ave and RR Structure.dgn



USER NAME = mjverheyen	DESIGNED - MJV	REVISED -
PLOT SCALE = 13,3300' / in.	DRAWN - STANTEC	REVISED -
PLOT DATE = 10/4/2013	CHECKED -	REVISED -
	DATE - 10/4/2013	REVISED -

STATE OF ILLINOIS
DEPARTMENT OF TRANSPORTATION

ATTACHMENT K
TYPICAL SECTIONS

SCALE: SHEET 2 OF 2 SHEETS STA. TO STA.

F.A.I. RTE.	SECTION	COUNTY	TOTAL SHEETS	SHEET NO.
55		COOK		
CONTRACT NO.				
ILLINOIS FED. AID PROJECT				


ATTACHMENT L

Abbreviated Existing Plans

FEDERAL AID ROUTE NO.	SECTION	EXPRESSWAYS	TOTAL SHEETS	SHEET NO.
66	1818-280 v. 8	SOUTHWEST	33	3
FE' ROAD DIST. NO.	ILLINOIS PROJECT 16-55-7 (54) 281			

Note:
Bulkheads required to retain earth at fascia girder bearings for existing R.R. Bridge are not a part of these plans.




Creosoted Piles, 15 Ton capacity, for approach slabs. Do not drive approach piles below elev. 627.0. Final cutoff to be by others. (Typical) Est. Length of Piles 30'

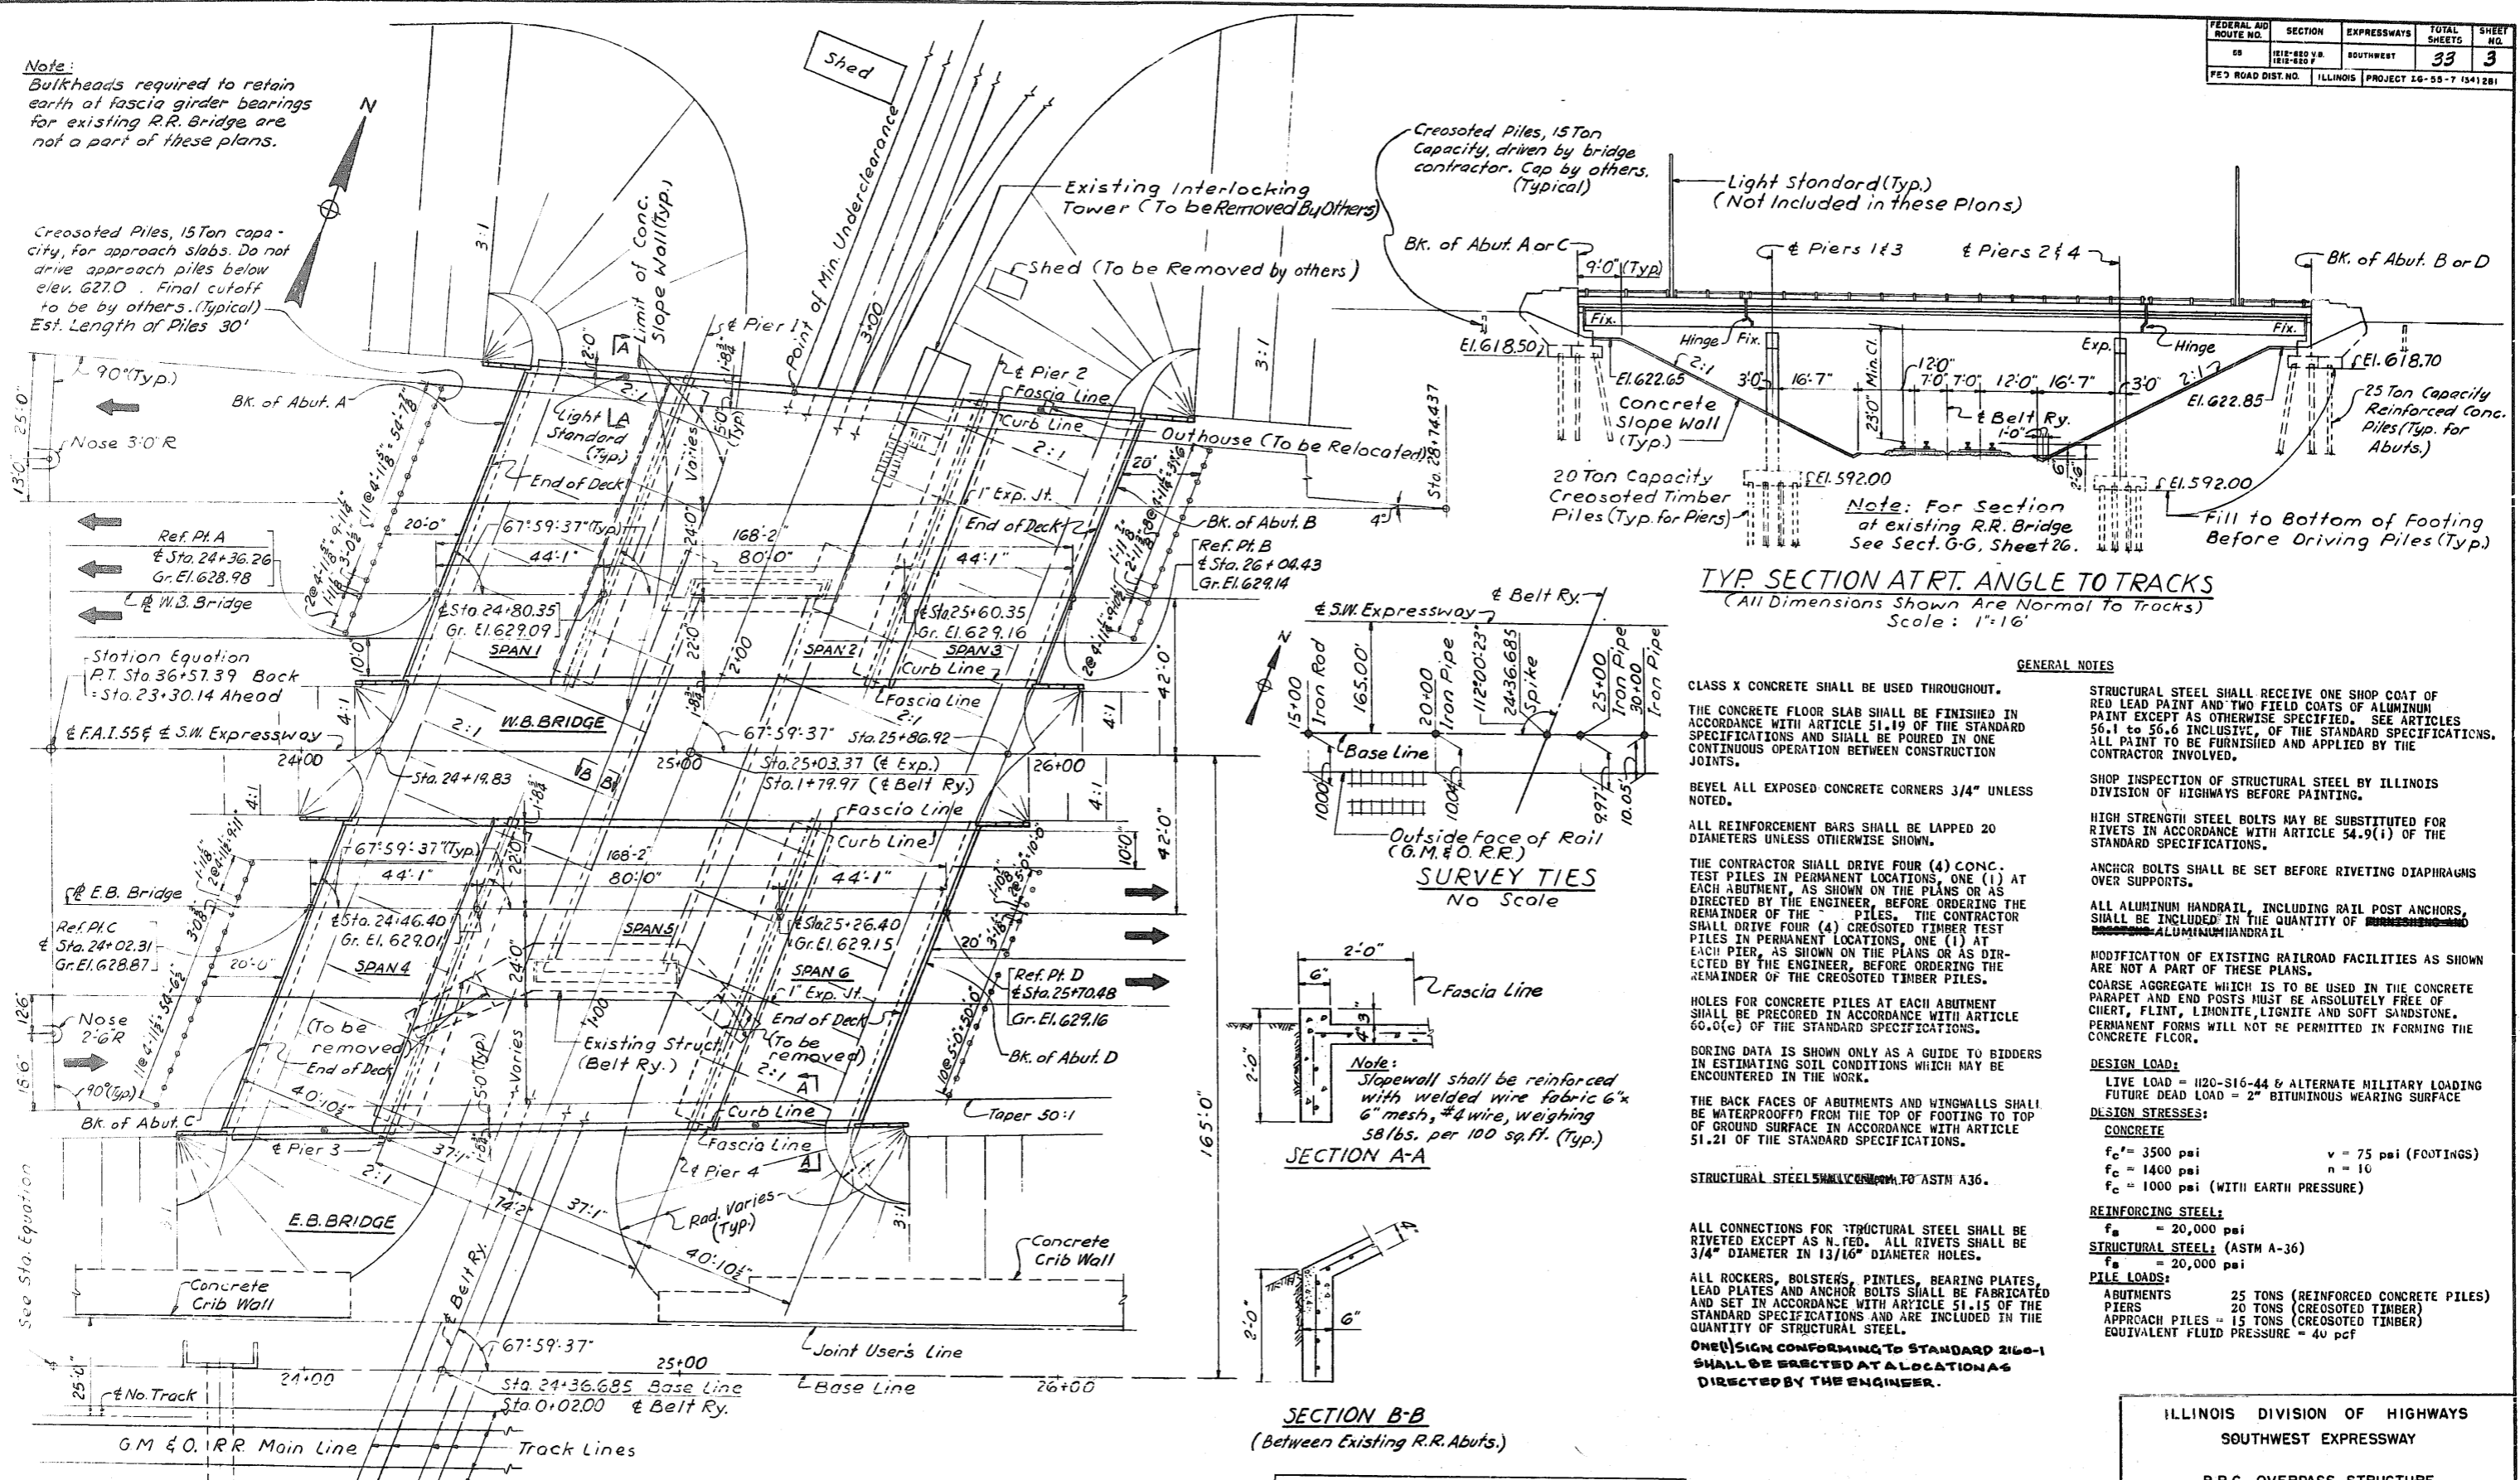

TYP. SECTION AT RT. ANGLE TO TRACKS
(All Dimensions Shown Are Normal To Tracks)
Scale: 1"=16'

GENERAL NOTES

- CLASS X CONCRETE SHALL BE USED THROUGHOUT.
 - THE CONCRETE FLOOR SLAB SHALL BE FINISHED IN ACCORDANCE WITH ARTICLE 51.19 OF THE STANDARD SPECIFICATIONS AND SHALL BE POURED IN ONE CONTINUOUS OPERATION BETWEEN CONSTRUCTION JOINTS.
 - BEVEL ALL EXPOSED CONCRETE CORNERS 3/4" UNLESS NOTED.
 - ALL REINFORCEMENT BARS SHALL BE LAPPED 20 DIAMETERS UNLESS OTHERWISE SHOWN.
 - THE CONTRACTOR SHALL DRIVE FOUR (4) CONCRETE TEST PILES IN PERMANENT LOCATIONS, ONE (1) AT EACH ABUTMENT, AS SHOWN ON THE PLANS OR AS DIRECTED BY THE ENGINEER, BEFORE ORDERING THE REMAINDER OF THE PILES. THE CONTRACTOR SHALL DRIVE FOUR (4) CREOSOTED TIMBER TEST PILES IN PERMANENT LOCATIONS, ONE (1) AT EACH PIER, AS SHOWN ON THE PLANS OR AS DIRECTED BY THE ENGINEER, BEFORE ORDERING THE REMAINDER OF THE CREOSOTED TIMBER PILES.
 - HOLES FOR CONCRETE PILES AT EACH ABUTMENT SHALL BE PRECURED IN ACCORDANCE WITH ARTICLE 60.0(c) OF THE STANDARD SPECIFICATIONS.
 - BORING DATA IS SHOWN ONLY AS A GUIDE TO BIDDERS IN ESTIMATING SOIL CONDITIONS WHICH MAY BE ENCOUNTERED IN THE WORK.
 - THE BACK FACES OF ABUTMENTS AND WINGWALLS SHALL BE WATERPROOFED FROM THE TOP OF FOOTING TO TOP OF GROUND SURFACE IN ACCORDANCE WITH ARTICLE 51.21 OF THE STANDARD SPECIFICATIONS.
 - STRUCTURAL STEEL SHALL CONFORM TO ASTM A36.
 - ALL CONNECTIONS FOR STRUCTURAL STEEL SHALL BE RIVETED EXCEPT AS NOTED. ALL RIVETS SHALL BE 3/4" DIAMETER IN 13/16" DIAMETER HOLES.
 - ALL ROCKERS, BOLSTERS, PINTLES, BEARING PLATES, LEAD PLATES AND ANCHOR BOLTS SHALL BE FABRICATED AND SET IN ACCORDANCE WITH ARTICLE 51.15 OF THE STANDARD SPECIFICATIONS AND ARE INCLUDED IN THE QUANTITY OF STRUCTURAL STEEL.
 - ONE SIGN CONFORMING TO STANDARD 2160-1 SHALL BE ERRECTED AT A LOCATION AS DIRECTED BY THE ENGINEER.
- STRUCTURAL STEEL SHALL RECEIVE ONE SHOP COAT OF RED LEAD PAINT AND TWO FELD COATS OF ALUMINUM PAINT EXCEPT AS OTHERWISE SPECIFIED. SEE ARTICLES 56.1 TO 56.6 INCLUSIVE, OF THE STANDARD SPECIFICATIONS. ALL PAINT TO BE FURNISHED AND APPLIED BY THE CONTRACTOR INVOLVED.
- SHOP INSPECTION OF STRUCTURAL STEEL BY ILLINOIS DIVISION OF HIGHWAYS BEFORE PAINTING.
- HIGH STRENGTH STEEL BOLTS MAY BE SUBSTITUTED FOR RIVETS IN ACCORDANCE WITH ARTICLE 54.9(i) OF THE STANDARD SPECIFICATIONS.
- ANCHOR BOLTS SHALL BE SET BEFORE RIVETING DIAPHRAGMS OVER SUPPORTS.
- ALL ALUMINUM HANDRAIL, INCLUDING RAIL POST ANCHORS, SHALL BE INCLUDED IN THE QUANTITY OF ~~ALUMINUM HANDRAIL~~ ALUMINUM HANDRAIL.
- MODIFICATION OF EXISTING RAILROAD FACILITIES AS SHOWN ARE NOT A PART OF THESE PLANS.
- COARSE AGGREGATE WHICH IS TO BE USED IN THE CONCRETE PARAPET AND END POSTS MUST BE ABSOLUTELY FREE OF CHERT, FLINT, LIMONITE, LIGNITE AND SOFT SANDSTONE. PERMANENT FORMS WILL NOT BE PERMITTED IN FORMING THE CONCRETE FLOOR.
- DESIGN LOAD:**
LIVE LOAD = H20-S16-44 & ALTERNATE MILITARY LOADING
FUTURE DEAD LOAD = 2" BITUMINOUS WEARING SURFACE
- DESIGN STRESSES:**
- CONCRETE**
f_c' = 3500 psi v = 75 psi (FOOTINGS)
f_c = 1400 psi n = 10
f_c = 1000 psi (WITH EARTH PRESSURE)
- REINFORCING STEEL:**
f_s = 20,000 psi
- STRUCTURAL STEEL: (ASTM A-36)**
f_s = 20,000 psi
- PILE LOADS:**
ABUTMENTS 25 TONS (REINFORCED CONCRETE PILES)
PIERS 20 TONS (CREOSOTED TIMBER)
APPROACH PILES = 15 TONS (CREOSOTED TIMBER)
EQUIVALENT FLUID PRESSURE = 4u pcf

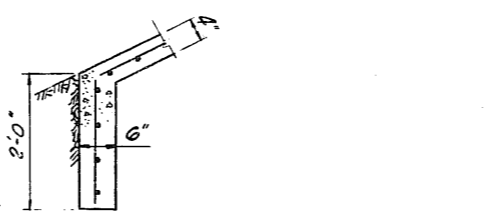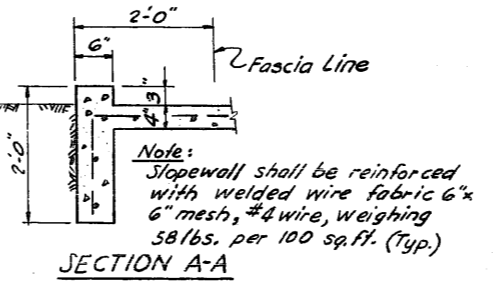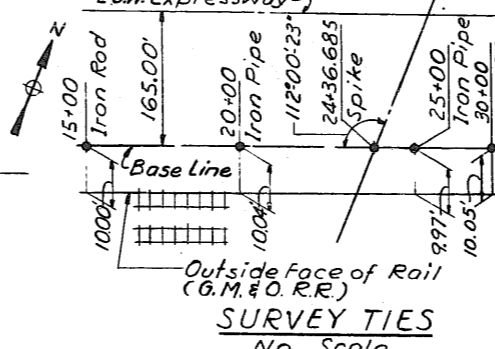

BILL OF MATERIAL




ITEM	UNIT	QUANTITY
Slopewall, 4"	Sq. Yds.	3060
Creosoted Piles, 20' to 38' ft.	Lin. Ft.	1680

PLAN
Scale: 1"=20'

ILLINOIS DIVISION OF HIGHWAYS
SOUTHWEST EXPRESSWAY
B.R.C. OVERPASS STRUCTURE
GENERAL PLAN AND ELEVATION
SCALE: AS NOTED DATE: 9-13-63


Rev. 11-18-63: Deleted Creo. Piles up to 20' (240'), Added Creo. Piles 20.1' to 38' (1680'). M.C.K.

FEDERAL AID ROUTE NO.	SECTION	EXPRESSWAY	TOTAL SHEETS	SHEET NO.
88	1B12-620V8	SOUTHWEST	33	9
STA.	TO STA.			
	FED. ROAD DIV. NO. 4 ILLINOIS PROJECT			

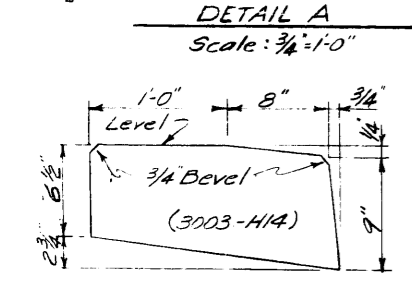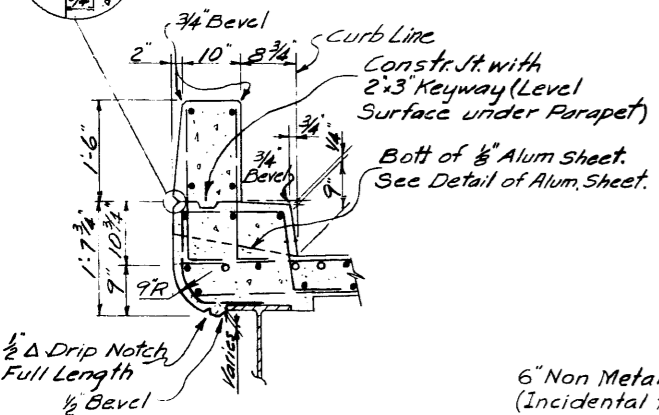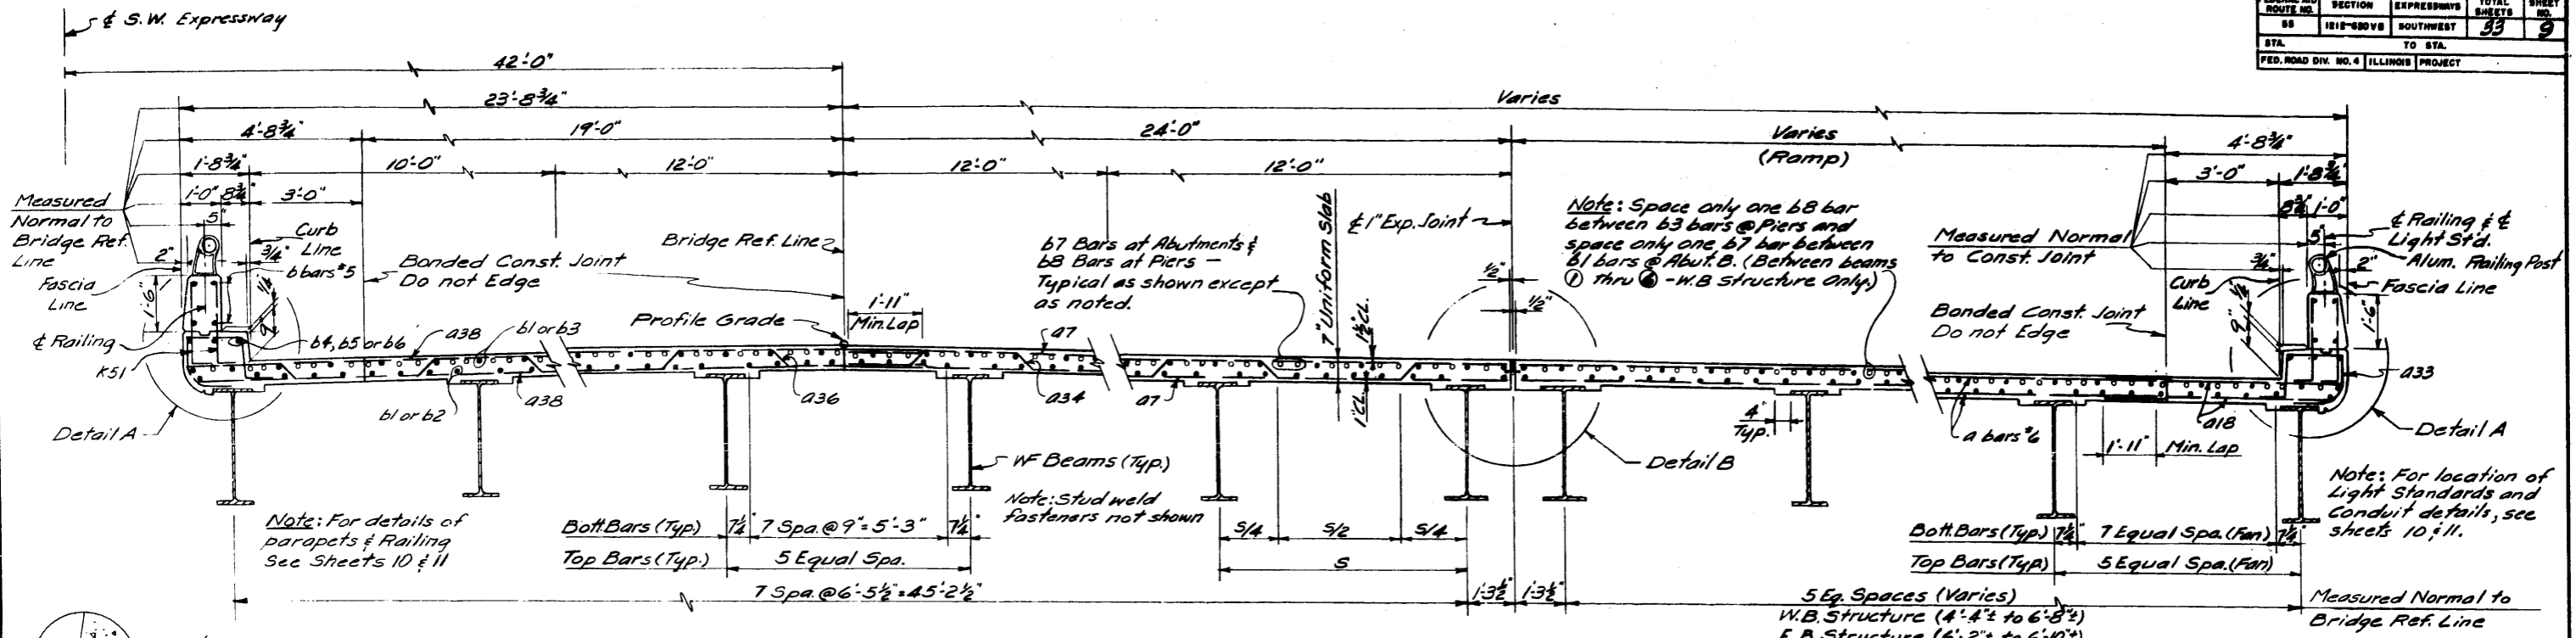


DETAIL OF 1/8" ALUMINUM SHEETS
Scale: 1 1/2"=1'-0"


DECK CROSS SECTION
W.B. Structure Looking West
E.B. Structure Looking East
Scale: 1/2"=1'-0"

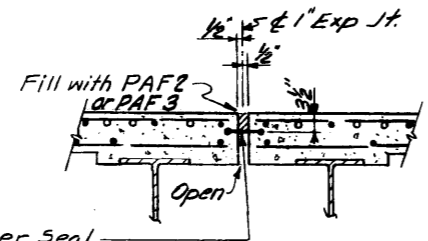

DETAIL B
Scale: 3/4"=1'-0"


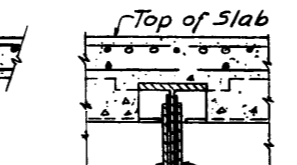


SECTION C-C
Scale: 3/4"=1'-0"

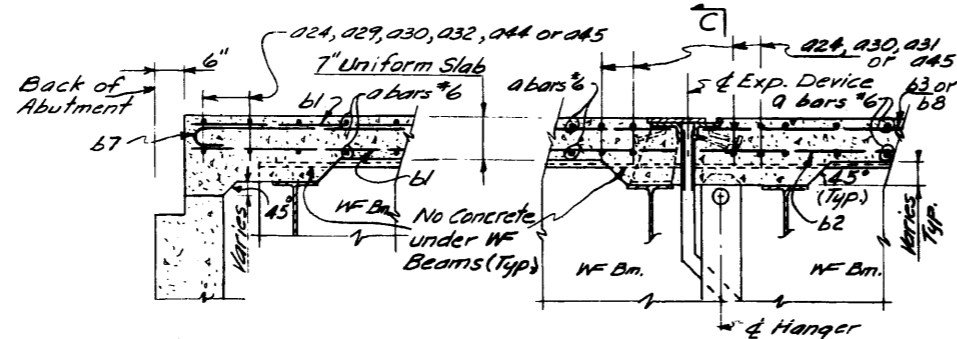

SECTION A-A
Scale: 3/4"=1'-0"

SECTION B-B
Scale: 3/4"=1'-0"

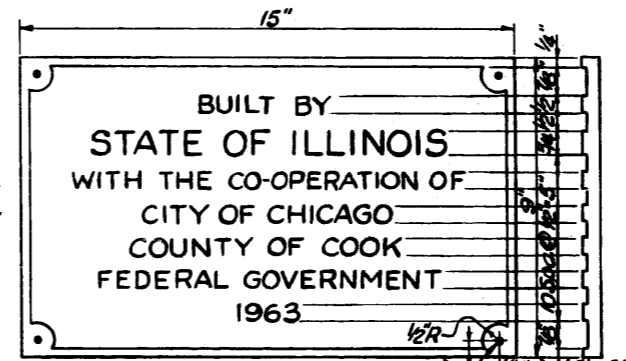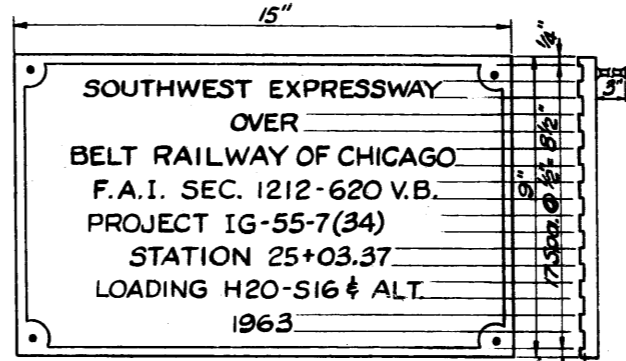

Notes for Name Plates: The material shall be best quality brass or bronze. Border and lettering shall be raised 1/8", square cut and not tapered. The top surface shall be polished and have a matted background.

The Contractor shall obtain approval of the Engineer before commencement of work and inscription.

Use two name plates, one of each type shown above, for each bridge located on the abutment wingwalls and as directed by the Engineer.

BILL OF MATERIAL			
Description	Unit	EQ.	W.B.
Class X Concrete	Cu. Yds.	358.1	338.4
Protective Coat	Sq. Yds.	1628	1532
Aluminum Handrail	Lin. Ft.	331	325
Reinforcement Bars	Lbs.	92,338	92,654
Conduit, 1 1/2" Dia. Galvanized Steel	Lin. Ft.	11	11
Conduit, 2" Dia. Galvanized Steel	Lin. Ft.	94	94
2" Asbestos Cement Conduit, Type 1	Lin. Ft.	251	245
Cast Iron Junction Boxes	Each	2	2
Name Plates	Each	2	2

ILLINOIS DIVISION OF HIGHWAYS
SOUTHWEST EXPRESSWAY
B.R.C. OVERPASS STRUCTURE
DECK DETAILS
SCALE: AS NOTED DATE: 9-13-63

BRIDGE CONDITION REPORT

REGION: 1

DISTRICT: 1

ROUTE: FAI-55 / I-55 WB

COUNTY: Cook

JOB NUMBER: P-91-762-10

STRUCTURE NUMBER: 016-0019

LOCATION: I-55 Westbound over RR-BRC



PREPARED BY:  **Stantec**

DATE PREPARED: 12/20/13

PROPOSED LETTING DATE: To Be Determined

TABLE OF CONTENTS

I. GEOGRAPHICAL & ADMINISTRATIVE DATA.....	1
II. PHYSICAL DESCRIPTION OF STRUCTURE	1
III. FIELD INSPECTION & PHYSICAL EVALUATION.....	3
IV. POTENTIAL SCOPE OF WORK DETERMINATION & ANALYSIS.....	7
V. DISCUSSION AND RECOMMENDED SCOPE OF WORK	8
VI. FINAL RECOMMENDATION.....	10
VII. TRAFFIC STAGING	10

ATTACHMENTS:

- A. Location Map
- B. IDOT Master Structure Report
- C. Bridge Inspection Report
- D. Bottom of Deck Condition Survey
- E. Condition Assessment of the Reinforced Concrete Bridge Deck
- F. Substructure Condition Surveys
- G. Opinion of Probable Costs
- H. Proposed Structure Drawings
- I. Structure Photos
- J. Proposed Plan & Profile
- K. Existing and Proposed Roadway Cross Sections
- L. Abbreviated Existing Plans

I. GEOGRAPHICAL & ADMINISTRATIVE DATA

Structure Number: 016-0019
County: Cook
Route Carried: FAI 055 / I-55
Feature Crossed: RR-BRC
Section: 1212-620-VB
Station: 25+03.37

Roadway Classification: Federal Aid Interstate
Design/Posted Speed: 70mph / 55 mph
***ADT (current/design):** 80,502 (2012) / 114,556 (2040)
***ADTT (current/design):** 13% = 10,465 (2012) / 13% = 14,892 (2040)
***DHV (current/design):** 5,492 (2012) / 7,963 (2040)
Inventory Rating HS: 1.070 – rated 11/5/01
Operating Rating HS: 1.680 – rated 11/5/01
Sufficiency Rating: 86.0
HBP Eligibility: No

*Traffic data per the I-55 Managed Lane Phase I Study

Construction / Reconstruction / Repair History

The structure carrying I-55 Westbound over the BRC Railroad (RR-BRC) was originally built in 1963 as FAI Route 55 over RR-BRC under Project IG-55-7(34) 281, Section 1212-620-VB. The original construction consisted of parallel three span structures. The two structures carried I-55 eastbound and westbound traffic.

As part of Contract 82944, plans dated 12/15/95, pin and link replacement was performed. As part of Contract 80059, bridge rehabilitation was performed in 1999. The rehabilitation consisted of removing the bituminous concrete overlay, performing deck repairs, removing and replacing the transverse deck joints, eliminating the longitudinal deck joint, placing a new deck concrete overlay, refurbishing the bearings, cleaning and painting the existing steel bridge and repairing the substructure and slopewall.

II. PHYSICAL DESCRIPTION OF STRUCTURE

The physical description of the structure is based on a review of the existing available plans dated 9/13/63, 12/15/95, and 1999. Refer to Attachment L for select existing structure plan sheets. Individual components of the existing structure are described below:

Structure Type and Length: The bridge is a flared three span wide flange steel structure with pin and link assemblies in spans 1 and 3. The exterior beams are W36x135 in Spans 1

and 3. All the interior beams are W27x114 in Spans 1 and 3. The W-beams in Span 2 are W35x150 with a 1" thick cover plate outside of the bottom flange. The bridge is 168'-2" long measured from back-to-back of abutments. The substructure consists of two reinforced concrete stub abutments with wingwalls and two multi-column reinforced concrete piers. The abutments are supported by concrete piles and the piers are supported on creosoted timber piles. The bridge has a 7" reinforced concrete deck plus overlay.

Number / Length of Spans: There are a total of three spans, with approximate lengths as follows (dimensioned from centerline of bearing to centerline of bearing). Spans are numbered from west to east.

Span 1: 42'-0"
Span 2: 80'-0"
Span 3: 42'-0"

Skew: 22°-00'-23" Left

Structure Width: The total width varies from approximately 72'-2" to 83'-6" measured out-to-out of the deck. The bridge accommodates three 12' lanes of traffic, a ramp lane with variable gore, a 10' inside shoulder, a 5' outside shoulder, and a curb and parapet on each side.

Expansion Joints: W Abutment: 1 3/4" Preformed Joint Seal
Pier 1: 2" Neoprene Joint
Pier 2: 2" Neoprene Joint
E Abutment: 1 3/4" Preformed Joint Seal

Bearings: W Abutment: Fixed
Pier 1: Fixed
Pier 2: Expansion
E Abutment: Fixed

Approach Roadway Template: The approach roadway template matches the bridge with three 12' lanes of traffic, a variable ramp lane with variable gore, a 10' inside shoulder, and a 5' outside shoulder. The width of the west approach roadway is wider than the east approach roadway due to the variable gore/ramp lane.

Existing Wearing Surface:	2 3/8" Micro Silica Concrete Overlay
Existing Vertical Alignment:	The structure is located on a 1,000-ft. long vertical crest curve with 1.50% and -0.80% slopes going from west to east. The entire structure is located in the -0.80% slope region.
Existing Horizontal Alignment:	The structure is on a horizontal tangent section.
Existing Vertical Clearance:	23'-0" min over BRC Railroad according to the 1999 repair plans.
Existing Drainage:	No existing drainage exists on the structure or approach slabs.
Parapets and Railings:	There are 1'-8 3/4" wide exterior curb and parapets running the length of the bridge. Parapets were modified in 1999 plans to remove a 9" tall by 1'-0" wide existing handrail and replaced with a 9" tall x 1'-0" wide reinforced concrete section. Per the IDOT Bridge Inspection Report dated 12/10/12, the guardrail currently meets acceptable standards while the guardrail ends and transitions do not.
Existing Utilities Attachments:	There are no light poles attached to the bridge, but there is conduit running along the north parapet.
Name Plate:	The two name plates are located on the inside face of the northeast and southwest wingwalls.

III. FIELD INSPECTION & PHYSICAL EVALUATION

A field inspection of the entire structure carrying I-55 Westbound over the BRC Railroad was performed by Stantec on September 16, 2013. The high temperature on that date was 65° F. The visual field inspection was performed on foot on the slopewall and the top of deck. The following conditions were observed:

Deck

Deck

The deck was rated in fair condition (NBIS Rating = 5) in the 12/10/12 NBIS inspection. The deck condition observed during this inspection was consistent with the NBIS rating. The underside of deck has multiple areas of delamination, spalling, transverse and map cracking. Based on visual

inspection, approximately 4.6 % of the underside of deck is delaminated or spalled.

The micro-silica concrete overlay on the top of deck has minor hairline transverse and longitudinal cracking mostly along the shoulders. One spall that measured 1 square foot was noted on the top of deck in the gore. Wiss, Janey and Elstner performed a condition assessment of the reinforced bridge deck in July 2011. This assessment included a delamination survey performed on the top of the bridge deck using infrared thermography. The infrared thermography indicated 5.4% of the top of deck area was delaminated. See Attachment E for the condition assessment of the reinforced bridge deck. See Attachment I – Photos 1 through 6.

Parapets

The parapets are in satisfactory condition with hairline vertical cracking throughout and minor delaminations and spalls on both the interior and exterior faces of the parapet. The interior face of the South Parapet has approximately 5 square feet of delaminated concrete. The exterior face of the North Parapet has approximately 8 square feet of spalled concrete. See Attachment I – Photos 7 through 8.

Joints

The preformed joint seals at the abutments and the neoprene joint at the piers are in satisfactory condition with debris in the joint and minor impact damage on the joints. The width of the joints was measured when the temperature was approximately 65° F. The preformed joint at the West Abutment measured ¾” wide. The neoprene joint at the West Pier measured 1 9/16”. The neoprene joint at the East Pier measured 1 7/16”. The preformed joint at the East Abutment measured 11/16”. See Attachment I – Photos 9 through 13.

Superstructure

Beams

The superstructure consists of three spans of variable sized rolled steel beams. The beam lines are numbered 1 through 14, numbered from north to south. In Spans 1 and 3, Beam Lines 1 and 14 consist of W36x135 beams and Beam Lines 2 through 13 consist of W27x114 beams. In Span 2, all of the beam lines consist of W36x150 beams. This structure has pin and link assemblies in Spans 1 and 3 and welded cover plates on the bottom flanges of the beams in Span 2.

The superstructure was rated in fair condition (NBIS Rating = 5) in the 12/10/2012 NBIS bridge inspection due to initial section loss and minor pitting. The superstructure observed during this inspection was consistent with the NBIS rating.

The steel superstructure typically has paint starting to fail, minor rust and initial section loss and minor pitting. The pin and link assemblies were visually inspected from the ground. In Span 1, the guide plate under the pin and link assembly at the south fascia beam is bent downward away from the restraining plates. The 12/10/2012 NBIS inspection used an under bridge inspection unit to do a close up inspection of the pin and link assemblies and no defects were noted. See Attachment C for the Bridge Inspection Report. The steel beams have welded cover plates with fatigue category E' details. The welded cover plates were visually inspected from the ground and no defects were noted on the welds. See Attachment I – Photos 14 through 18.

Bearings

The steel rocker expansion bearings are in satisfactory condition with paint starting to fail and minor rust. No excessive tilting was noted during the inspection. See Attachment I – Photo 19.

Utilities

An abandoned conduit is located on the inside of the south fascia beam. The conduit has many broken brackets and the conduit has fallen down in Span 3. See Attachment I – Photos 20 and 21.

Substructure

The substructure was rated in satisfactory condition (NBIS Rating = 6) in the 12/10/2012 NBIS bridge inspection due to cracks and spalls at the abutment caps and pier columns. The substructure condition observed during this inspection was consistent with the NBIS rating.

Abutments

The reinforced concrete abutments are in satisfactory condition with multiple vertical cracks that vary in widths from hairline to 3/8" wide. The length of the 1/16" or wider vertical cracks is approximately 20' on the East Abutment and 16' on the West Abutment. There is 7 square feet of delaminated concrete on the East Abutment. See Attachment F for the Substructure Condition Survey. See Attachment I – Photos 22 and 23.

Piers

The reinforced concrete piers each consist of seven columns with a pier cap. The piers are in satisfactory condition with minor delaminations and spalls on the columns and pier caps. Pier 1 has approximately 67 square feet of spalled or delaminated concrete. Pier 2 has approximately 8 square feet of spalled or delaminated concrete. See Attachment F for the Substructure Condition Survey. See Attachment I – 24 through 26.

Slope Protection

The bridge has concrete slope walls. The East Slopewall has approximately 50' of transverse cracking. The West Slopewall has approximately 50' transverse cracking along the bottom and at the northwest corner of the slopewall. The West Slopewall has a void at the top of the slopewall on the north end. The extent of the void was unable to be determined but the embankment next to the slopewall was not eroded away. See Attachment I – 27 and 28.

Inspection History (NBIS Ratings)

Year	Deck	Super	Sub
2012	5	5	6
2011	5	6	6
2009	5	6	6

Geometric, Horizontal & Vertical Clearance / Hydraulic Data

Geometry

I-55 Westbound over RR-BRC is on a 22°-00'-23" skew left. The typical roadway section consists of three 12' lanes, a variable width ramp gore/lane, a 10' inside shoulder, a 5' outside shoulder, a 1'-8 3/4" wide curb and parapet on each side of the structure. The structure is located on a 1,000-ft. long vertical crest curve with 1.50% and -0.80% slopes going from west to east. The entire structure is located in the -0.80% slope region. The structure is on a horizontal tangent section. The repair plans from 1999 show the vertical minimum clearance at 23'-0" from top of rail to bottom of steel.

The top of rail profile for the RR-BRC at for the west track slopes upwards at a +0.08% slope going north.

As part of the I-55 Managed Lane Phase I Study, I-55 Westbound at the BRC Railroad will be widened to the inside to accommodate a proposed 12' managed lane westbound. In the westbound direction, a 4' buffer between the managed lane with 12.5' shoulder and the general purpose traffic lanes is proposed in this 60 foot median section. This widening will be incorporated into the recommended scope of work for this structure.

Hydraulics

At the structure, the I-55 profile is on a vertical crest curve with the crest of the curve at the location of the structure. The bridge deck goes through superelevation transitions with the inside lane and inside shoulder level 19' west of the back of the West Abutment. The bridge deck achieves normal crown with the inside lane at 1% and the shoulder at 2% on the bridge deck approximately 47' west of the Pier 2. There are no deck drains on the bridge

deck. Therefore, the water is allowed to flow to the deck joints as it runs off the bridge.

IV. POTENTIAL SCOPE OF WORK DETERMINATION & ANALYSIS

As part of the I-55 Managed Lane Phase I Study, In-Kind Repairs, Structure Widening and Structure Replacement alternatives will be evaluated.

Per Section 2.4.2.4 of the IDOT Bridge Manual, consideration was given to retrofit all end of cover plate locations due to average daily truck traffic. From this information, it was determined that a fatigue evaluation was required. The transverse welds at the ends of the cover plates in Span 2 were evaluated for fatigue life and it was determined that the mean service life is less than 50 years. A cover plate retrofit should be installed.

Repainting the bridge was considered due to the paint starting to fail. All Bridge Designers Memorandum 10.1 states that structures over railroads will typically be cleaned and painted only at deck joints and the fascias. As the paint system is only starting to fail, zone painting was determined not to be necessary at this time for both alternatives.

Since all alternatives would have work being performed near the railroad tracks, the cost of Railroad Protective Liability Insurance should be considered in the opinion of probable costs.

1. In-Kind Repairs

Perform partial and full depth deck repairs and apply Protective Coat to the existing deck. Repair areas of spalled or delaminated concrete on existing abutments and wingwalls. Repair the guide plate at the south fascia beam in Span 1. Perform retrofit repairs on the existing Span 2 cover plates. Fill the void under the slopewall at the northwest corner.

2. Structure Widening

Remove and replace the concrete deck and approach slabs and widen both approximately 18' to the centerline of I-55. Remove both the southeast and southwest wingwalls and build an extension onto the south side of both abutments. Build an extension onto the south side of both piers. Install 3 new beam lines using W27 and W36 steel beams with pin and link assemblies that will be composite to the widened bridge deck. The new W36 beam will be larger sections than the existing W36x150 to compensate for the omission of a bottom flange cover plate. Perform retrofit repairs on the existing Span 2 cover plates. Repair areas of spalled or delaminated concrete on

existing abutments and wingwalls. Fill the void under the sloped wall at the northwest corner.

3. Superstructure and Partial Substructure Replacement

Remove and replace the existing steel beam superstructure with galvanized W36 continuous steel beams. Remove and replace pier caps, but reuse the existing pier columns and footings. Build an extension onto the south side of both piers. Replace the existing abutments with integral abutments placed behind the existing abutments. Replace concrete slope walls. The deck geometry will accommodate the proposed roadway geometry from the I-55 Managed Lane Phase I Study.

4. Structure Replacement

Remove and replace the entire structure with a continuous three-span galvanized steel W-shape beam superstructure on integral abutments. The deck geometry will accommodate the proposed roadway geometry from the I-55 Managed Lane Phase I Study.

V. DISCUSSION AND RECOMMENDED SCOPE OF WORK

The opinion of probable costs for each of the alternatives is summarized below. See Attachment G for the opinion of probable costs breakdown.

- 1. In-Kind Repairs – \$224,100**
- 2. Structure Widening – \$2,540,700**
- 3. Superstructure and Partial Substructure Replacement – \$4,523,200**
- 4. Structure Replacement – \$5,613,800**

Per the I-55 Managed Lane Phase I Study, the managed lane is expected to be implemented in 2020. All widening and replacement alternatives below assume the proposed structure will provide a 6'-0" outside shoulder, one 16'-0" ramp lane, a variable width gore, three 12'-0" general purpose traffic lanes, a 4' buffer between the general purpose traffic lanes and the 11'-0" managed traffic lane and a 12'-6" inside shoulder.

Analysis of Alternative 1 – The calculated percent of deck area requiring full depth repairs is 4.6% and the partial depth repairs is 10.0%. The total deck repair percentage is within the 25% limit presented in the Bridge Condition Report Procedures and Practices Manual for deck repair to be cost effective for a deck not being widened. This alternative can be used to extend the life span of the existing superstructure in the interim prior to implementing the changes required for the Managed Lane project.

Analysis of Alternative 2 – This alternative widens the structure approximately 18' to the centerline of I-55 to accommodate the new managed lane. The calculated percent of deck area requiring full depth repairs is 4.6% and partial depth repairs is

10.0%. Since this deck is 50 years old and has a recommended repair area at the upper limit (15%) presented in the BCR Procedures and Practices Manual for deck repair to be cost effective for a widened deck, it is recommended to replace the deck at the time of widening.

The existing pin and link assemblies were evaluated for elimination by making the structure continuous. This was considered not practical as it would require replacing the W27 beams in Spans 1 and 3 and replacing the existing abutments to account for the deeper beams. Instead, the pin and link assemblies will remain on the existing beams, which is not preferred from a maintenance standpoint. Cover plate retrofits will be necessary. Deck joints will also remain with this alternative, which will lead to continued degradation of the beams and substructure units.

Analysis of Alternative 3 – This alternative replaces existing W27 and W36 steel beam superstructure with a continuous three-span galvanized steel rolled beam (W36) superstructure on new integral abutments. The proposed abutments should be placed behind the existing abutments to avoid conflicting with the existing concrete piles. The resulting assumed span arrangement is approximately 50'/80'/50' measured between the centerline of bearings. Uplift at the abutments must be considered in the design phase given the relatively short exterior spans in the continuous structure.

The existing pier columns are in satisfactory condition with minimal rehabilitation required. Reusing the existing pier columns and footings will simplify construction since it will minimize construction impact to the BRC Railroad. In the future, the pier columns can be encased or strengthened with carbon fiber wrap if the rate of concrete degradation exceeds that of the replaced structure elements.

Using galvanized steel eliminates the need to periodically repaint the beam. Eliminating the deck joints will also help to prevent premature degradation of the beams and substructure elements. Providing new pier caps and integral abutments places most of the substructure on the same life cycle as the superstructure. The vertical clearance over the railroad will slightly improve due to the efficiency of the continuous structure allowing for the elimination of cover plates.

Analysis of Alternative 4 – This alternative completely eliminates the 50-year old structure and replaces it with a new structure with an expected 75-year service life. Increasing the length of Span 2 to avoid the existing piles is not feasible since deeper beams would be required, thereby reducing the vertical clearance over the railroad. On the other hand, shortening Span 2 cannot be assumed since moving the piers closer to the tracks will likely be prohibited by the railroad. Therefore, the new piers will be assumed at the same location as the existing, thereby creating piling conflicts with the existing timber piles. Similar to Alternative 3, for cost estimating purposes the proposed structure is assumed to have spans of approximately 50'/80'/50'.

The benefits of this alternative are similar to Alternative 3, with the addition of removing and replacing the pier columns and pier footings. Therefore, future maintenance of the pier columns will be less than the structure provided in

Alternative 3. However, this alternative adds construction complications of reconstructing the piers on the same footprint as the existing pier footings. The cost is also greater than Alternative 3 due to the removal and reconstruction of the additional pier elements.

VI. FINAL RECOMMENDATION

Stantec recommends Alternative 3 – Superstructure and Partial Substructure Replacement when the I-55 Managed Lane Project occurs. The selected alternative provides a new superstructure and replaces most of the critical portions of the substructure. Eliminating the deck joints will help to prevent premature degradation of the replaced substructure elements. As the I-55 Managed Lane Phase I Study is ongoing, the bridge widening to be presented in the TSL should match the final geometry as presented in the final I-55 Managed Lane Phase I Study.


Based on the current condition of the bridge, the repairs of the deck or the substructure are not required in the short term. The ends of the cover plates and the pin and link assemblies should continue to be monitored by inspection.

VII. TRAFFIC STAGING


For Alternatives 2, 3 and 4, the existing deck is wide enough to provide two lanes of traffic in the westbound direction during stage construction. For Alternative 1, the lanes can be temporarily closed as needed to allow for the deck repairs. The traffic staging design will need to be confirmed by IDOT traffic prior to being implemented.

ATTACHMENT A

Location Map

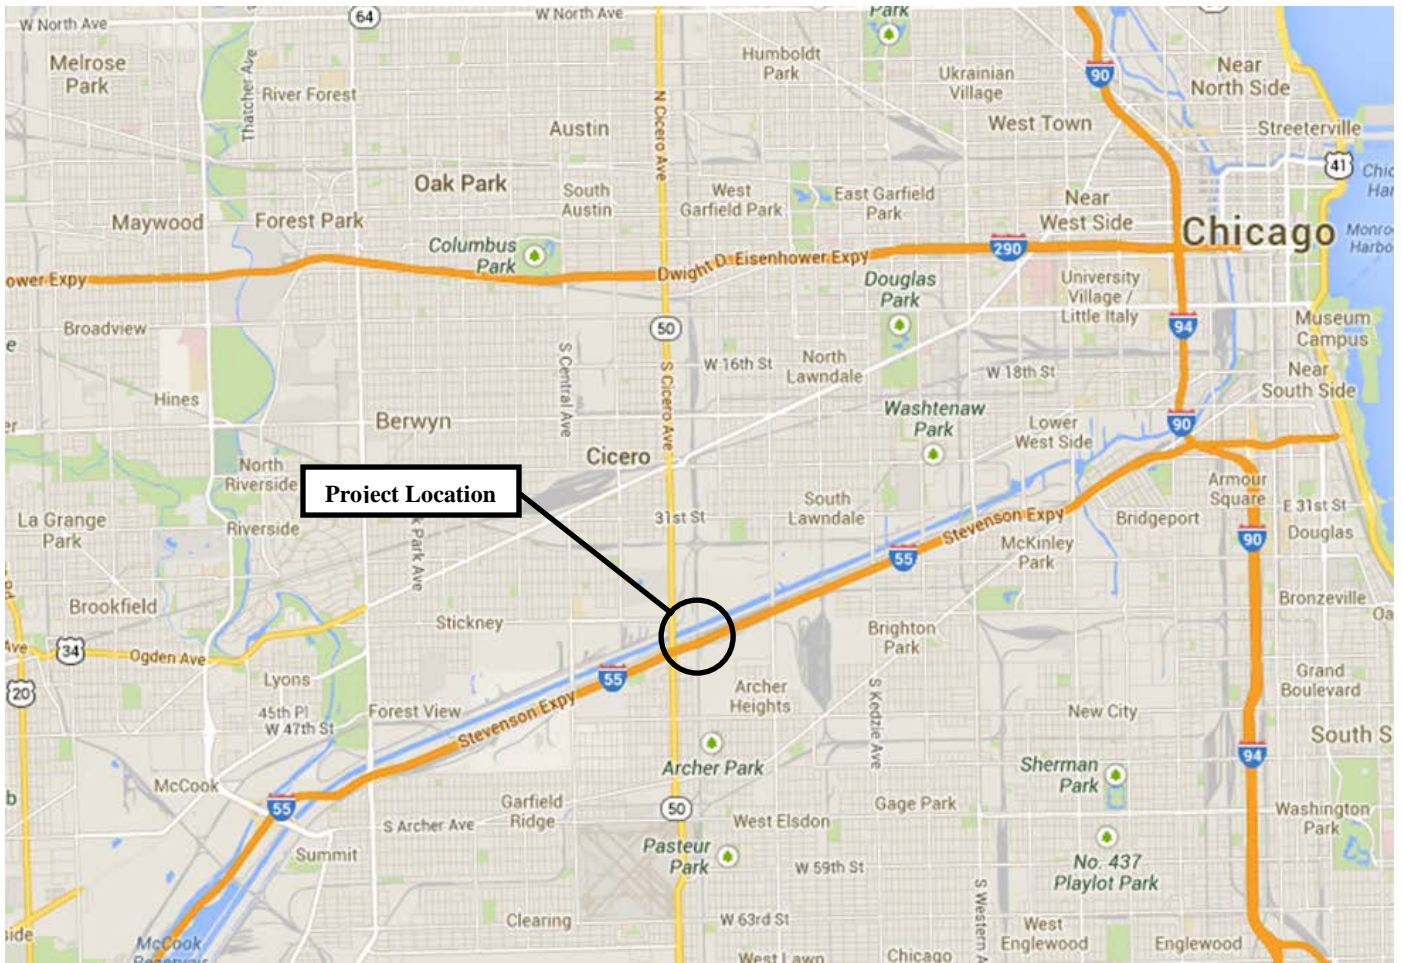

N

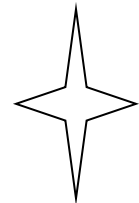

Location Map

Proposed Improvement:

I-55 over BRC Railroad (Westbound)

Municipality: Chicago

County: Cook

Route: FAI 055

Project No: P-91-762-10

Structure No.: 016-0019

ATTACHMENT B

IDOT Master Structure Report

**Illinois Department of Transportation
Structures Information Management System
Structure Summary Report**

Date: 10/07/2013

Page: 1

Structure Number: 016-0019

District: 1

Inventory Data

Facility Carried:	I-55 WB STEVENSON	Bridge Name:		Sufficiency Rating:	86.0	Structure Length:	168.1
Feature Crossed:	RR - BRC	Location:	0.25 M E ILL 50	HBP Eligible:	No	AASHTO Bridge Length:	99.9
Bridge Remarks:		Status Date:	12/2000	Replaced By:	016-2670	Length of Long Span:	91.0
Bridge Status:	1 OPEN - NO RESTRICT	Maint Township:	62 LAKE (CHICAGO)	Replaces:	-	Bridge Roadway Width:	68.6
Status Remarks:				Last Update Date:	07/05/2012	Appr Roadway Width:	60.0
Maint County:	016 COOK			Parallel Structure:	Left	Deck Width:	72.0
Maint Responsibility:	01 I.D.O.T.			Multi-Level Structure Nbr:		Sidewalk Width Right:	0.0
Service On/Under:	1 HIGHWAY	Skew Angle:	2 / RAILROAD	Skew Direction:	L	Sidewalk Width Left:	0.0
Reporting Agency:	1 I.D.O.T. - BUREAU OF MAINTENANCE	Skew Significance:		Structure Flared:	S	Navigation Horiz Clear:	N N/A
Main Span Matl/Type:	4 STEEL CONTINUOUS	Nbr Of Approach Spans:	0	Historical Significance:	Yes	Navigation Vert Clear:	0
Nbr Of Main Spans:	3			Border Bridge State:	No	Navigation Vert Clear:	0.0
Approaches				Bdr State SN:		Culvert Fill Depth:	0.0
Near #1 Matl/Type:				Bdr State % Responsibility:		Number Culvert Cells:	0
Near #2 Matl/Type:				Structural Steel Wt	896000	Culvert Opening Area:	0.0
Far #1 Matl/Type:				Substructure Material:		Culvert Cell Height:	0.00
Far #2 Matl/Type:				Rated By:	2 IDOT	Culvert Cell Width:	0.00
Median Width/Type:	0 Ft. / 0			Load Rating Date:	11/05/2001	Rate Method:	2 ALLOWABLE STRESS
Guardrail Type L/R:	0None			Inventory Rating:	1.070(38)	Crossing 1 Nbr:	
Toll Facility Indicator:	0 No Toll			Operating Rating:	1.680(60)	Crossing 1 Nbr:	
Latitude:	41 D 49 M 6 S	Longitude:	87 D 44 M 19.93 S	Design Load:	01 HS20+MOD	RR Lateral Underclear:	14.0
Deck Structure Type:	A CIP CON NRMALLY FORM			Deck Structure Thickness:	7 SD: N	RR Vertical Underclear:	22 Ft 08 In
Sidewalks Under Structure:	0 None						

Key Route On Data

Key Route Nbr:	FEDERAL-AID INTERSTATE	Station:	0055	Station:	10.6100
Appurtenances	Main Route	Segment:		Linked:	Y
Inventory County:	016 COOK	Natl. Hwy System:	On NHS	Inventory Direction:	
Township/Road Dist	62 LAKE (CHICAGO)	Curr AADT Yr/Count:	2012 / 72400	Est Truck Percentage:	7
Municipality	1051 CHICAGO	Number Of Lanes:	4	One Or Two Way:	1 One-Way
Urban Area:	1051	Bypass Length:	0	Future AADT Yr/Cnt:	2032 / 75808
Functional Class:	1 INTERSTATE	Designated Truck Rte:	CLASS I	Special Systems:	Yes
** CLEARANCES **	South/East	North/West			
Max Rdwy Width:	68.6				
Horizontal:	70.0				

Key Route Under Data

Station:	
Segment:	
Linked:	
Natl. Hwy System:	/
Inventory Direction:	
Curr AADT Yr/Count:	
Est Truck Percentage:	
Number Of Lanes:	
One Or Two Way:	
Bypass Length:	
Future AADT Yr/Cnt:	
Designated Truck Rte:	
Special Systems:	

***** Marked Route On Data *****

Route #1:	1	Designation	Interstate Highway	Kind	Highway	Number	055
Route #2:	1						
Route #3:	1						

***** Marked Route Under Data *****

Designation		Kind		Number	
--------------------	--	-------------	--	---------------	--

**Illinois Department of Transportation
Structures Information Management System
Structure Summary Report**

Date: 10/07/2013

Page: 2

Structure Number: 016-0019 District: 1

Data Related to Inspection Information

*** Inspection Intervals *** *** Maximum Allowable Posting Limits ***

Routine NBIS: 24 MOS Underwater: 0 MOS One Truck At A Time: 0 Combination Type 3S-1: Tons Bridge Posting Level: 5 No Posting Required
 Special: Y Single Unit Vehicles: Tons Combination Type 3S-2: Tons

Inspection/Appraisal Information

Inspection Date: 12/10/2012 Inspection Temperature: 35Deg. F ** Actual Posted Limits **
 Deck: 5 FAIR CONDITION - MINOR SECTION LOSS, CRACKS Single Unit Vehicles: Tons
 Superstructure: 5 FAIR CONDITION - MINOR SECTION LOSS, CRACKS Combination Type 3S-1: Tons
 Substructure: 6 SATISFACTORY CONDITION - MINOR DETERIORATION Combination Type 3S-2: Tons
 Culvert: N NOT APPLICABLE One Truck At A Time: 0
 Channel and Protection: N NOT APPLICABLE Deck Wearing Surf: F MICRO SIL CON OVRLY Last Paint Type: T
 Structural Evaluation: 5 BETTER THAN ADEQUATE TO BE LEFT IN PLACE Deck Membrane: F NONE FLD ZINC & ACRYLIC
 Deck Geometry: 7 BETTER THAN PRESENT MINIMUM CRITERIA Deck Protection: J NONE
 Underclearance-Vert/Lat.: 6 EQUAL TO PRESENT MINIMUM CRITERIA Total Deck Thick: 8.7
 Waterway Adequacy: N NOT APPLICABLE Last Paint Date: 07/2000
 Approach Roadway Align: 8 EQUAL TO PRESENT DESIRABLE CRITERIA
 Bridge Railing Appraisal: 3 Meets Standards
 Approach Guardrail: 233 Not Acceptable Acceptable
 Pier Navig Protection: N N/A Acceptable

Underwater Inspection/Appraisal Information

Inspection Date: Inspection Category:
 Temperature: Inspection Method:

Appraisal Rating:

Scour Critical Information

Evaluation Method:

Miscellaneous

Yes

Construction Information

Year: 1963 Original Reconstructed
 Route: FAI-55 Sta: 25+03.37
 Section Nbr: 1212-620-VB
 Contract Nbr:
 Fed Aid Prf#: IG 0557034281
 Built By: 1 I.D.O.T.

Waterway Information

Flood Design Frequency:
 Flood Design Q (CFS):
 Flood Design Nat H W E:
 Flood Des Open Prop:

YRS Drainage Area:
 Flood Base Q (CFS):
 Flood Base Nat H W E:

ATTACHMENT C

Bridge Inspection Report



SN: 016-0019	District: 1	Spans: 3	Appr. Spans: 0	Skew: 22.01	ADT: 72400	Truck Pct: 7
ADT Un:	Maint. Co: COOK	Twsp: LAKE (CHICAGO)		Status: OPEN - NO RESTRICT		
Facility Carried: I- 55 WB STEVENSON			Feature Crossed: RR - BRC			
Location 0.25 M E ILL 50		Municipality: CHICAGO		Team/Sub Section E26019		
Bridge Name:			Material & Type: STEEL CONTINUOUS/STRINGER/MULTI-BEAM/GIRDER			
Insp. Intervals (Mo) Routine NBIS 24		Fracture Critical: 0		Underwater: 0	Special Feature: 48	
90 - Inspection Date: / /		90C - Temp. (°F):		90A - Program Manager:		
Is Delinquent: <input type="checkbox"/>		Reason:				
90A1 - Team Leader:			90A2 - Inspector:			

90B - Inspection Remarks:

Previous Inspection	(2008) #58-DK CHLOR CONTAM W/LEACHING MAPCRKS & SM SPALLS. FILLETS SPALLING. #59 PAINT PEELING & RUST TYP. ESP @ FASCIAS & BMS 8 & 9. #60 CRKS& SPALLS@ ABUT CAPS & COLUMNS. 2012) Item 59 lowered to "5" due to init. sec loss/minor pitting
------------------------	---

Resources

Time to Inspect (H:M): 1:0	Traffic Control: 3	Boat:	Waders:	Snooper:
Ladder:	Manlift:	Bucket Truck:	Other: UB50 for Pin & Link	

Inspector's Appraisals

	Prev	New	Comments
58 - Deck Condition:	5		
59 - Superstructure Cond:	5		
60 - Substructure Cond:	6		
62 - Culvert Condition:	N		
61 - Channel Condition:	N		
71 - Waterway Adequacy:	N		
72 - Approach Rdw Align:	8		
111 - Pier Navig Protection:	N		

90B - Inspector Remarks:

Routine Inspection Report

Structure Number: 0160019

Additional Inspection Data

36A - Bridge Railing Adequacy:	Prev	New	3		Rail Types:	Prev	New	New	New		
Approach Guardrail Adequacy:			36B - Transitions:	2		36C - Guardrail:	3		36D - Ends:	3	

108A - Wearing Surface Type:	Prev	New	F		If "L-Other" Describe:	_____
108B - Type of Membrane:	Prev	New	F		If "E-Other" Describe:	_____
108C - Deck Protection:	Prev	New	J		If "I-Other" Describe:	_____
108D - Total Deck Thickness (in):			8.7			

59A - Paint Date (Mo/Yr):	Prev	New	07/2000	/	
59B - Paint Type:			T	_____	_____

Color: Fascia - ____: Inter. - ____: Railing - ____.

59C - Utilities Attached:	_____	_____	If "B-Other" Describe:	_____
---------------------------	-------	-------	------------------------	-------

Weight Limit Posting:	70A2 - Single Unit Vehicles:	Prev	New			Tons
	70B2 - Combination Type 3S-1 (3 or 4 axles):					Tons
	70C2 - Combination Type 3S-2 (5 or more axles):					Tons
	70D2 - One Truck at a Time:			0		

Joint Openings (In.) _____

90B - Inspector Remarks Continued:

	Signature	Date
Inspection Team Leader:		/ /
Inspection Program Manager:		/ /

Pontis

Today's Date: 04/19/2013

Structure Number: 016-0019 District: 1 (41) Bridge Status: 1 OPEN - NO RESTRICT
 (6) Feature Crossed: RR - BRC (7) Facility Carried: I- 55 WB STEVENSON
 (9) Location: 0.25 M E ILL 50 (7A) Bridge Name:
 Element Inspection Date: 12/10/2012 Inspectors: SEDLACEKJL

Element Description												
Elem	Env	% 1	Qty 1	% 2	Qty 2	% 3	Qty 3	% 4	Qty 4	% 5	Qty 5	Tot Qty
Concrete Deck Protected w/ Rigid Overlay												
22	4	62	8,016	31	4,092	7	910	0	0	0	16	13,034
No deficiencies. Repaired areas exist Map cracked areas. Spalls/delaminations Full depth failures.												
Remarks: Soffit- Chlor Contam, map crking w/HPs; Spalling w/exp rebar along longit jnt WS- HL diag & long crks spans 1&3; Isol HL map crks mainly S. Shldr; Few pop-outs w/PD emerging, Fillets spalling typ.												
Lead Painted Steel Open Girder												
107	4	29	5,349	51	9,180	20	3,644	0	0	0	0	18,173
No corrosion Paint distress Rust formation Section loss Section failure												
Remarks: Lt to med rust @ bot flng & scattered web areas; Laminated rust @ top of bttm fl Bms #8&9 w/minor pitting due to old long. jt; Init sec loss to fascias. Paint peeling @ #8&9 and Fascias.												
Lead Painted Steel Pin and/or Hanger												
161	4	100	28	0	0	0	0	0	0	0	0	28
No corrosion Paint distress Rust formation Section loss Section failure												
Remarks:												
Non-Lead Painted Steel Closed Web/Box Girder and O												
173	4	100	84	0	0	0	0	0	0	0	0	84
No corrosion Paint distress Rust formation Section loss Section failure												
Remarks: Init pitting @ abut diaphs												
Reinforced Conc Column or Pile Extension												
205	3	100	3,293	0	0	0	4	0	0	0	0	3,297
No deterioration Minor cracks/spalls Delams/spalls Analysis warranted												
Remarks: Few shallow spalls w/ exp rebar. Pier 1 spall w/rebar @ col #7.												
Reinforced Conc Abutment												
215	4	100	1,092	0	0	0	0	0	0	0	0	1,092
No deterioration Minor cracks/spalls Delams/spalls Analysis warranted												
Remarks: Backwall) HL leach crks; Isol spall @ NW backwall												
Reinforced Conc Pier or Abutment Cap												
234	3	93	292	1	3	6	19	0	0	0	0	314
No deterioration Minor cracks/spalls Delams/spalls Analysis warranted												
Remarks: Abut) HL-Nar Vert leach crks; Piers) Shallow Rebar spalls @ N end P1. Pier 1 Cap spall/delam @ Bms 9&10. WAbut @ spalls @Bm13/14 & Bm 12/13. EAbut @ Bm1&2.												
Preformed Joint Seal												
302	4	100	156	0	0	0	0	0	0	0	0	156
No deterioration Minor deterioration Major deterioration												
Remarks:												
Neoprene Expansion Joint												
307	4	100	162	0	0	0	0	0	0	0	0	162
The element shows mi The seal maybe punct The seal maybe heavi Major deterioration												

Remarks:

Continuous Seal Neoprene Expansion Joint

308	4	100	162	0	0	0	0	0	0	0	0	162
		The element shows mi	The seal maybe punct	The seal maybe heavi	Major deterioration							

Remarks:

Movable Discontinous Brg.

311	4	100	28	0	0	0	0	0	0	0	0	28
		No deterioration	Minor deterioration	Advanced corrosion								

Remarks:

Fixed Bearing

313	4	100	14	0	0	0	0	0	0	0	0	14
		No deterioration	Minor deterioration	Advanced corrosion								

Remarks:

Moveable Steel Bearings below continuous decks

316	4	100	14	0	0	0	0	0	0	0	0	14
		No deterioration	Minor deterioration	Advanced corrosion								

Remarks:

Approach Pavement

323	4	100	2	0	0	0	0	0	0	0	0	2
		No deterioration	Cracks/spalls	Major cracks/spalls	Broken/Unstable							

Remarks:

Concrete Bridge Railing

331	4	100	334	0	0	0	0	0	0	0	0	334
		No deterioration	Minor cracks/spalls	Analysis warranted								

Remarks:

Steel Pin and Hanger

411	4	0	0	100	28	0	0	0	0	0	0	28
		Minor fatigue, out-o	Moderate fatigue, ou	Severe fatigue, out-								

Remarks:

Element Description

Elem	Env	% 1	Qty 1	% 2	Qty 2	% 3	Qty 3	% 4	Qty 4	% 5	Qty 5	Tot Qty
Concrete Deck Protected w/ Rigid Overlay												
22	4	62	8,121	31	4,092	6	805	0	0	0	16	13,034
		No deficiencies.	Repaired areas exist	Map cracked areas.	Spalls/delaminations	Full depth failures.						

Remarks:

Lead Painted Steel Open Girder												
107	4	29	5,349	51	9,180	20	3,644	0	0	0	0	18,173
		No corrosion	Paint distress	Rust formation	Section loss	Section failure						

Remarks:

Lead Painted Steel Pin and/or Hanger												
161	4	100	28	0	0	0	0	0	0	0	0	28
		No corrosion	Paint distress	Rust formation	Section loss	Section failure						

Remarks:

Non-Lead Painted Steel Closed Web/Box Girder and O

173	4	100	84	0	0	0	0	0	0	0	0	84
			No corrosion	Paint distress	Rust formation	Section loss	Section failure					

Remarks: Init pitting @ abut diaphs

Reinforced Conc Column or Pile Extension

205	3	100	3,293	0	0	0	4	0	0	0	0	3,297
			No deterioration	Minor cracks/spalls	Delams/spalls	Analysis warranted						

Remarks: Few shallow spalls w/ exp rebar. Pier 1 spall w/rebar @ col #7.

Reinforced Conc Abutment

215	4	100	1,092	0	0	0	0	0	0	0	0	1,092
			No deterioration	Minor cracks/spalls	Delams/spalls	Analysis warranted						

Remarks: Backwall) HL leach crks; Isol spall @ NW backwall

Reinforced Conc Pier or Abutment Cap

234	3	93	292	1	3	6	19	0	0	0	0	314
			No deterioration	Minor cracks/spalls	Delams/spalls	Analysis warranted						

Remarks: Abut) HL-Nar Vert leach crks; Piers) Shallow Rebar spalls @ N end P1. Pier 1 Cap spall/delam @ Bms 9&10. WAbut @ spalls @ Bm13/14 & Bm 12/13. EAbut @ Bm1&2.

Preformed Joint Seal

302	4	100	156	0	0	0	0	0	0	0	0	156
			No deterioration	Minor deterioration	Major deterioration							

Remarks:

Neoprene Expansion Joint

307	4	100	162	0	0	0	0	0	0	0	0	162
			The element shows mi	The seal maybe punct	The seal maybe heavi	Major deterioration						

Remarks:

Continuous Seal Neoprene Expansion Joint

308	4	100	162	0	0	0	0	0	0	0	0	162
			The element shows mi	The seal maybe punct	The seal maybe heavi	Major deterioration						

Remarks:

Movable Discontinuous Brg.

311	4	100	28	0	0	0	0	0	0	0	0	28
			No deterioration	Minor deterioration	Advanced corrosion							

Remarks:

Fixed Bearing

313	4	100	14	0	0	0	0	0	0	0	0	14
			No deterioration	Minor deterioration	Advanced corrosion							

Remarks:

Moveable Steel Bearings below continuous decks

316	4	100	14	0	0	0	0	0	0	0	0	14
			No deterioration	Minor deterioration	Advanced corrosion							

Remarks:

Approach Pavement

323	4	100	2	0	0	0	0	0	0	0	0	2
			No deterioration	Cracks/spalls	Major cracks/spalls	Broken/Unstable						

Remarks: Nar random crks

Concrete Bridge Railing

331	4	100	334	0	0	0	0	0	0	0	0	334
			No deterioration	Minor cracks/spalls	Analysis warranted							

Remarks: HL Vert crks

Steel Pin and Hanger

411	4	0	0	100	28	0	0	0	0	0	0	28
			Minor fatigue, out-o	Moderate fatigue, ou	Severe fatigue, out-							

Remarks: Span 1 Pier 1 coverplate misaligned.

Element Description

Elem	Env	% 1	Qty 1	% 2	Qty 2	% 3	Qty 3	% 4	Qty 4	% 5	Qty 5	Tot Qty
Concrete Deck Protected w/ Rigid Overlay												
22	4	64	8,287	31	4,092	5	655	0	0	0	0	13,034
			No deficiencies.	Repaired areas exist	Map cracked areas.	Spalls/delaminations	Full depth failures.					

Remarks: Soffit- Chlor Contam, map crking w/HPs; Spalling w/exp rebar along longit jnt WS- HL diag & long crks spans 1&3; Isol HL map crks mainly S. Shldr; Few pop-outs w/PD emerging, Fillets spalling typ.

Lead Painted Steel Open Girder

107	4	29	5,349	51	9,180	20	3,644	0	0	0	0	18,173
			No corrosion	Paint distress	Rust formation	Section loss	Section failure					

Remarks: Lt to med rust @ bot flng & scattered web areas; Laminated rust @ top of bttm fl Bms #8&9 w/minor pitting due to old long. jt; Init sec loss to fascias. Paint peeling @ #8&9 and Fascias.

Lead Painted Steel Pin and/or Hanger

161	4	100	28	0	0	0	0	0	0	0	0	28
			No corrosion	Paint distress	Rust formation	Section loss	Section failure					

Remarks:

Non-Lead Painted Steel Closed Web/Box Girder and O

173	4	100	84	0	0	0	0	0	0	0	0	84
			No corrosion	Paint distress	Rust formation	Section loss	Section failure					

Remarks: Init pitting @ abut diaphs

Reinforced Conc Column or Pile Extension

205	3	100	3,293	0	0	0	4	0	0	0	0	3,297
			No deterioration	Minor cracks/spalls	Delams/spalls	Analysis warranted						

Remarks: Few shallow spalls w/ exp rebar. Pier 1 spall w/rebar @ col #7.

Reinforced Conc Abutment

215	4	100	1,092	0	0	0	0	0	0	0	0	1,092
			No deterioration	Minor cracks/spalls	Delams/spalls	Analysis warranted						

Remarks: Backwall) HL leach crks; Isol spall @ NW backwall

Reinforced Conc Pier or Abutment Cap

234	3	93	292	1	3	6	19	0	0	0	0	314
			No deterioration	Minor cracks/spalls	Delams/spalls	Analysis warranted						

Remarks: Abut) HL-Nar Vert leach crks; Piers) Shallow Rebar spalls @ N end P1. Pier 1Cap spall/delam @ Bms 9&10. WAbut @ spalls @Bm13/14 & Bm 12/13. EAbut @ Bm1&2.

Preformed Joint Seal

302	4	100	156	0	0	0	0	0	0	0	0	156
			No deterioration	Minor deterioration	Major deterioration							

Remarks:

Neoprene Expansion Joint

307	4	100	162	0	0	0	0	0	0	0	0	162
-----	---	-----	-----	---	---	---	---	---	---	---	---	-----

The element shows mi The seal maybe punct The seal maybe heavi Major deterioration

Remarks:

Continuous Seal Neoprene Expansion Joint

308	4	100	162	0	0	0	0	0	0	0	0	162
-----	---	-----	-----	---	---	---	---	---	---	---	---	-----

The element shows mi The seal maybe punct The seal maybe heavi Major deterioration

Remarks:

Movable Discontinuous Brg.

311	4	100	28	0	0	0	0	0	0	0	0	28
-----	---	-----	----	---	---	---	---	---	---	---	---	----

No deterioration Minor deterioration Advanced corrosion

Remarks:

Fixed Bearing

313	4	100	14	0	0	0	0	0	0	0	0	14
-----	---	-----	----	---	---	---	---	---	---	---	---	----

No deterioration Minor deterioration Advanced corrosion

Remarks:

Moveable Steel Bearings below continuous decks

316	4	100	14	0	0	0	0	0	0	0	0	14
-----	---	-----	----	---	---	---	---	---	---	---	---	----

No deterioration Minor deterioration Advanced corrosion

Remarks:

Approach Pavement

323	4	100	2	0	0	0	0	0	0	0	0	2
-----	---	-----	---	---	---	---	---	---	---	---	---	---

No deterioration Cracks/spalls Major cracks/spalls Broken/Unstable

Remarks:

Concrete Bridge Railing

331	4	100	334	0	0	0	0	0	0	0	0	334
-----	---	-----	-----	---	---	---	---	---	---	---	---	-----

No deterioration Minor cracks/spalls Analysis warranted

Remarks:

Steel Pin and Hanger

411	4	0	0	100	28	0	0	0	0	0	0	28
-----	---	---	---	-----	----	---	---	---	---	---	---	----

Minor fatigue, out-o Moderate fatigue, ou Severe fatigue, out-

Remarks:

Element Description

Elem	Env	% 1	Qty 1	% 2	Qty 2	% 3	Qty 3	% 4	Qty 4	% 5	Qty 5	Tot Qty
------	-----	-----	-------	-----	-------	-----	-------	-----	-------	-----	-------	---------

Concrete Deck Protected w/ Rigid Overlay

22	4	64	8,314	31	4,092	5	628	0	0	0	0	13,034
		No deficiencies.	Repaired areas exist	Map cracked areas.	Spalls/delaminations	Full depth failures.						

Remarks: Soffit) Map crking w/HPs; Spalling w/exp rebar along long jt (WS) HL diag & long crks spans 1&3; Isol HL map crks mainly S. Shldr; Few pop-outs w/PD emerging

Lead Painted Steel Open Girder

107	4	29	5,349	51	9,180	20	3,644	0	0	0	0	18,173
		No corrosion	Paint distress	Rust formation	Section loss	Section failure						

Remarks: Lt rust to bot fl & scattered web areas; Laminated rust to top of btm fl Bms 8&9 w/minor pitting due to old long. jt; Init sec loss to fascias

Lead Painted Steel Pin and/or Hanger

161	4	100	28	0	0	0	0	0	0	0	0	28
		No corrosion	Paint distress	Rust formation	Section loss	Section failure						

Remarks:

Non-Lead Painted Steel Closed Web/Box Girder and O

173	4	100	84	0	0	0	0	0	0	0	0	84
		No corrosion	Paint distress	Rust formation	Section loss	Section failure						

Remarks: Init pitting @ abut diaphrs

Reinforced Conc Column or Pile Extension

205	3	100	3,293	0	0	0	4	0	0	0	0	3,297
		No deterioration	Minor cracks/spalls	Delams/spalls	Analysis warranted							

Remarks: Few shallow rebar spalls

Reinforced Conc Abutment

215	4	100	1,092	0	0	0	0	0	0	0	0	1,092
		No deterioration	Minor cracks/spalls	Delams/spalls	Analysis warranted							

Remarks: Backwall) HL leach crks; Isol spall @ NW backwall

Reinforced Conc Pier or Abutment Cap

234	3	94	294	1	3	5	17	0	0	0	0	314
		No deterioration	Minor cracks/spalls	Delams/spalls	Analysis warranted							

Remarks: Abut) HL-Nar Vert crks; Piers) Shallow Rebar spalls @ N end P1

Preformed Joint Seal

302	4	100	156	0	0	0	0	0	0	0	0	156
		No deterioration	Minor deterioration	Major deterioration								

Remarks:

Neoprene Expansion Joint

307	4	100	162	0	0	0	0	0	0	0	0	162
		The element shows mi	The seal maybe punct	The seal maybe heavi	Major deterioration							

Remarks:

Continuous Seal Neoprene Expansion Joint

308	4	100	162	0	0	0	0	0	0	0	0	162
		The element shows mi	The seal maybe punct	The seal maybe heavi	Major deterioration							

Remarks:

Movable Discontinuous Brg.

311	4	100	28	0	0	0	0	0	0	0	0	28
		No deterioration	Minor deterioration	Advanced corrosion								

Remarks:

Fixed Bearing

313	4	100	14	0	0	0	0	0	0	0	0	14
		No deterioration	Minor deterioration	Advanced corrosion								

Remarks:

Moveable Steel Bearings below continuous decks

316	4	100	14	0	0	0	0	0	0	0	0	14
		No deterioration	Minor deterioration	Advanced corrosion								

Remarks:

Approach Pavement

323	4	100	2	0	0	0	0	0	0	0	0	2
		No deterioration	Cracks/spalls	Major cracks/spalls	Broken/Unstable							

Remarks:

Concrete Bridge Railing

331	4	100	334	0	0	0	0	0	0	0	0	334
		No deterioration	Minor cracks/spalls	Analysis warranted								

Remarks:

Steel Pin and Hanger

411	4	0	0	100	28	0	0	0	0	0	0	28
		Minor fatigue, out-o	Moderate fatigue, ou	Severe fatigue, out-								

Remarks:

Element Description

Elem	Env	% 1	Qty 1	% 2	Qty 2	% 3	Qty 3	% 4	Qty 4	% 5	Qty 5	Tot Qty
Concrete Deck Protected w/ Rigid Overlay												
22	4	64	8,314	31	4,092	5	628	0	0	0	0	13,034
		No deficiencies.	Repaired areas exist	Map cracked areas.	Spalls/delaminations	Full depth failures.						

Remarks:

Lead Painted Steel Open Girder

107	4	29	5,349	51	9,180	20	3,644	0	0	0	0	18,173
		No corrosion	Paint distress	Rust formation	Section loss	Section failure						

Remarks:

Lead Painted Steel Pin and/or Hanger

161	4	100	28	0	0	0	0	0	0	0	0	28
		No corrosion	Paint distress	Rust formation	Section loss	Section failure						

Remarks:

Non-Lead Painted Steel Closed Web/Box Girder and O

173	4	100	84	0	0	0	0	0	0	0	0	84
		No corrosion	Paint distress	Rust formation	Section loss	Section failure						

Remarks:

Reinforced Conc Column or Pile Extension

205	3	100	3,297	0	0	0	0	0	0	0	0	3,297
		No deterioration	Minor cracks/spalls	Delams/spalls	Analysis warranted							

Remarks:

Reinforced Conc Abutment

215	4	100	1,092	0	0	0	0	0	0	0	0	1,092
		No deterioration	Minor cracks/spalls	Delams/spalls	Analysis warranted							

Remarks:

Reinforced Conc Pier or Abutment Cap

234	3	100	314	0	0	0	0	0	0	0	0	314
		No deterioration	Minor cracks/spalls	Delams/spalls	Analysis warranted							

Remarks:

Preformed Joint Seal

302	4	100	156	0	0	0	0	0	0	0	0	156
		No deterioration	Minor deterioration	Major deterioration								

Remarks:

Neoprene Expansion Joint

307	4	100	162	0	0	0	0	0	0	0	0	162
		The element shows mi	The seal maybe punct	The seal maybe heavi	Major deterioration							

Remarks:

Movable Discontinuous Brg.

311	4	100	28	0	0	0	0	0	0	0	0	28
		No deterioration	Minor deterioration	Advanced corrosion								

Remarks:

Fixed Bearing

313	4	100	14	0	0	0	0	0	0	0	0	14
		No deterioration	Minor deterioration	Advanced corrosion								

Remarks:

Moveable Steel Bearings below continuous decks

316	4	100	14	0	0	0	0	0	0	0	0	14
		No deterioration	Minor deterioration	Advanced corrosion								

Remarks:

Approach Pavement

323	4	100	2	0	0	0	0	0	0	0	0	2
		No deterioration	Cracks/spalls	Major cracks/spalls	Broken/Unstable							

Remarks:

Concrete Bridge Railing

331	4	100	334	0	0	0	0	0	0	0	0	334
		No deterioration	Minor cracks/spalls	Analysis warranted								

Remarks:

Steel Pin and Hanger

411	4	0	0	100	28	0	0	0	0	0	0	28
		Minor fatigue, out-o	Moderate fatigue, ou	Severe fatigue, out-								

Remarks:

Element Description

Elem	Env	% 1	Qty 1	% 2	Qty 2	% 3	Qty 3	% 4	Qty 4	% 5	Qty 5	Tot Qty
Concrete Deck Protected w/ Rigid Overlay												
22	4	64	8,314	31	4,092	5	628	0	0	0	0	13,034
		No deficiencies.	Repaired areas exist	Map cracked areas.	Spalls/delaminations	Full depth failures.						
Remarks: <input type="text"/>												
Lead Painted Steel Open Girder												
107	4	29	5,349	51	9,180	20	3,644	0	0	0	0	18,173
		No corrosion	Paint distress	Rust formation	Section loss	Section failure						
Remarks: <input type="text"/>												
Lead Painted Steel Pin and/or Hanger												
161	4	100	28	0	0	0	0	0	0	0	0	28
		No corrosion	Paint distress	Rust formation	Section loss	Section failure						
Remarks: <input type="text"/>												
Non-Lead Painted Steel Closed Web/Box Girder and O												
173	4	100	84	0	0	0	0	0	0	0	0	84
		No corrosion	Paint distress	Rust formation	Section loss	Section failure						
Remarks: <input type="text"/>												
Reinforced Conc Column or Pile Extension												
205	3	100	3,297	0	0	0	0	0	0	0	0	3,297
		No deterioration	Minor cracks/spalls	Delams/spalls	Analysis warranted							
Remarks: <input type="text"/>												
Reinforced Conc Abutment												
215	4	100	1,092	0	0	0	0	0	0	0	0	1,092
		No deterioration	Minor cracks/spalls	Delams/spalls	Analysis warranted							
Remarks: <input type="text"/>												
Reinforced Conc Pier or Abutment Cap												
234	3	100	314	0	0	0	0	0	0	0	0	314
		No deterioration	Minor cracks/spalls	Delams/spalls	Analysis warranted							
Remarks: <input type="text"/>												
Preformed Joint Seal												
302	4	100	156	0	0	0	0	0	0	0	0	156
		No deterioration	Minor deterioration	Major deterioration								
Remarks: <input type="text"/>												
Neoprene Expansion Joint												
307	4	100	162	0	0	0	0	0	0	0	0	162
		The element shows mi	The seal maybe punct	The seal maybe heavi	Major deterioration							
Remarks: <input type="text"/>												
Movable Discontinuous Brg.												
311	4	100	28	0	0	0	0	0	0	0	0	28
		No deterioration	Minor deterioration	Advanced corrosion								
Remarks: <input type="text"/>												
Fixed Bearing												
313	4	100	14	0	0	0	0	0	0	0	0	14
		No deterioration	Minor deterioration	Advanced corrosion								

Remarks:

Moveable Steel Bearings below continuous decks

316	4	100	14	0	0	0	0	0	0	0	0	14
		No deterioration	Minor deterioration	Advanced corrosion								

Remarks:

Approach Pavement

323	4	100	2	0	0	0	0	0	0	0	0	2
		No deterioration	Cracks/spalls	Major cracks/spalls	Broken/Unstable							

Remarks:

Concrete Bridge Railing

331	4	100	334	0	0	0	0	0	0	0	0	334
		No deterioration	Minor cracks/spalls	Analysis warranted								

Remarks:

Steel Pin and Hanger

411	4	0	0	100	28	0	0	0	0	0	0	28
		Minor fatigue, out-o	Moderate fatigue, ou	Severe fatigue, out-								

Remarks:

Element Description

Elem	Env	% 1	Qty 1	% 2	Qty 2	% 3	Qty 3	% 4	Qty 4	% 5	Qty 5	Tot Qty
------	-----	-----	-------	-----	-------	-----	-------	-----	-------	-----	-------	---------

Concrete Deck Protected w/ Rigid Overlay

22	4	64	8,314	31	4,092	5	628	0	0	0	0	13,034
		No deficiencies.	Repaired areas exist	Map cracked areas.	Spalls/delaminations	Full depth failures.						

Remarks:

Lead Painted Steel Open Girder

107	4	85	15,473	15	2,700	0	0	0	0	0	0	18,173
		No corrosion	Paint distress	Rust formation	Section loss	Section failure						

Remarks:

Lead Painted Steel Pin and/or Hanger

161	4	100	28	0	0	0	0	0	0	0	0	28
		No corrosion	Paint distress	Rust formation	Section loss	Section failure						

Remarks:

Non-Lead Painted Steel Closed Web/Box Girder and O

173	4	100	84	0	0	0	0	0	0	0	0	84
		No corrosion	Paint distress	Rust formation	Section loss	Section failure						

Remarks:

Reinforced Conc Column or Pile Extension

205	3	100	3,297	0	0	0	0	0	0	0	0	3,297
		No deterioration	Minor cracks/spalls	Delams/spalls	Analysis warranted							

Remarks:

Reinforced Conc Abutment

215	4	100	1,092	0	0	0	0	0	0	0	0	1,092
		No deterioration	Minor cracks/spalls	Delams/spalls	Analysis warranted							

Remarks:

Reinforced Conc Pier or Abutment Cap

234	3	100	314	0	0	0	0	0	0	0	0	314
		No deterioration	Minor cracks/spalls	Delams/spalls	Analysis warranted							

Remarks:

Preformed Joint Seal

302	4	100	156	0	0	0	0	0	0	0	0	156
		No deterioration	Minor deterioration	Major deterioration								

Remarks:

Neoprene Expansion Joint

307	4	100	162	0	0	0	0	0	0	0	0	162
		The element shows mi	The seal maybe punct	The seal maybe heavi	Major deterioration							

Remarks:

Movable Discontinuous Brg.

311	4	100	28	0	0	0	0	0	0	0	0	28
		No deterioration	Minor deterioration	Advanced corrosion								

Remarks:

Fixed Bearing

313	4	100	14	0	0	0	0	0	0	0	0	14
		No deterioration	Minor deterioration	Advanced corrosion								

Remarks:

Moveable Steel Bearings below continuous decks

316	4	100	14	0	0	0	0	0	0	0	0	14
		No deterioration	Minor deterioration	Advanced corrosion								

Remarks:

Approach Pavement

323	4	100	2	0	0	0	0	0	0	0	0	2
		No deterioration	Cracks/spalls	Major cracks/spalls	Broken/Unstable							

Remarks:

Concrete Bridge Railing

331	4	100	334	0	0	0	0	0	0	0	0	334
		No deterioration	Minor cracks/spalls	Analysis warranted								

Remarks:

Steel Pin and Hanger

411	4	0	0	100	28	0	0	0	0	0	0	28
		Minor fatigue, out-o	Moderate fatigue, ou	Severe fatigue, out-								

Remarks:

Element Description

Elem	Env	% 1	Qty 1	% 2	Qty 2	% 3	Qty 3	% 4	Qty 4	% 5	Qty 5	Tot Qty
Concrete Deck Protected w/ AC Overlay												
14	4	90	11,235	0	0	10	1,248	0	0	0	0	12,483
		No deficiencies.	Repaired areas.	Map cracked areas.		Spalls/delam exist.		Full depth failures.				
Remarks: <input type="text"/>												
Lead Painted Steel Open Girder												
107	4	90	16,356	10	1,817	0	0	0	0	0	0	18,173
		No corrosion	Paint distress	Rust formation		Section loss		Section failure				
Remarks: <input type="text"/>												
Lead Painted Steel Pin and/or Hanger												
161	4	100	28	0	0	0	0	0	0	0	0	28
		No corrosion	Paint distress	Rust formation		Section loss		Section failure				
Remarks: <input type="text"/>												
Lead Painted Steel Closed Web/Box Girder and Open												
172	4	100	84	0	0	0	0	0	0	0	0	84
		No corrosion	Paint distress	Rust formation		Section loss		Section failure				
Remarks: <input type="text"/>												
Reinforced Conc Column or Pile Extension												
205	3	100	3,297	0	0	0	0	0	0	0	0	3,297
		No deterioration	Minor cracks/spalls	Delams/spalls		Analysis warranted						
Remarks: <input type="text"/>												
Reinforced Conc Abutment												
215	4	90	983	5	55	5	55	0	0	0	0	1,092
		No deterioration	Minor cracks/spalls	Delams/spalls		Analysis warranted						
Remarks: <input type="text"/>												
Reinforced Conc Pier or Abutment Cap												
234	3	100	314	0	0	0	0	0	0	0	0	314
		No deterioration	Minor cracks/spalls	Delams/spalls		Analysis warranted						
Remarks: <input type="text"/>												
Neoprene Expansion Joint												
307	4	0	0	100	150	0	0	0	0	0	0	150
		The element shows mi		The seal maybe punct		The seal maybe heavi		Major deterioration				
Remarks: <input type="text"/>												
Movable Discontinuous Brg.												
311	4	100	28	0	0	0	0	0	0	0	0	28
		No deterioration	Minor deterioration	Advanced corrosion								
Remarks: <input type="text"/>												
Fixed Bearing												
313	4	100	14	0	0	0	0	0	0	0	0	14
		No deterioration	Minor deterioration	Advanced corrosion								
Remarks: <input type="text"/>												
Moveable Steel Bearings below continuous decks												
316	4	100	14	0	0	0	0	0	0	0	0	14
		No deterioration	Minor deterioration	Advanced corrosion								

Remarks:

Approach Pavement

323	4	0	0	100	2	0	0	0	0	0	0	2
	No deterioration	Cracks/spalls			Major cracks/spalls		Broken/Unstable					

Remarks:

Concrete Bridge Railing

331	4	82	274	12	40	6	20	0	0	0	0	334
	No deterioration	Minor cracks/spalls		Analysis warranted								

Remarks:

Steel Pin and Hanger


411	4	0	0	0	0	100	28	0	0	0	0	28
	Minor fatigue, out-o	Moderate fatigue, ou		Severe fatigue, out-								

Remarks:

Download Date: 04/18/2013

ATTACHMENT D

Bottom of Deck Condition Survey

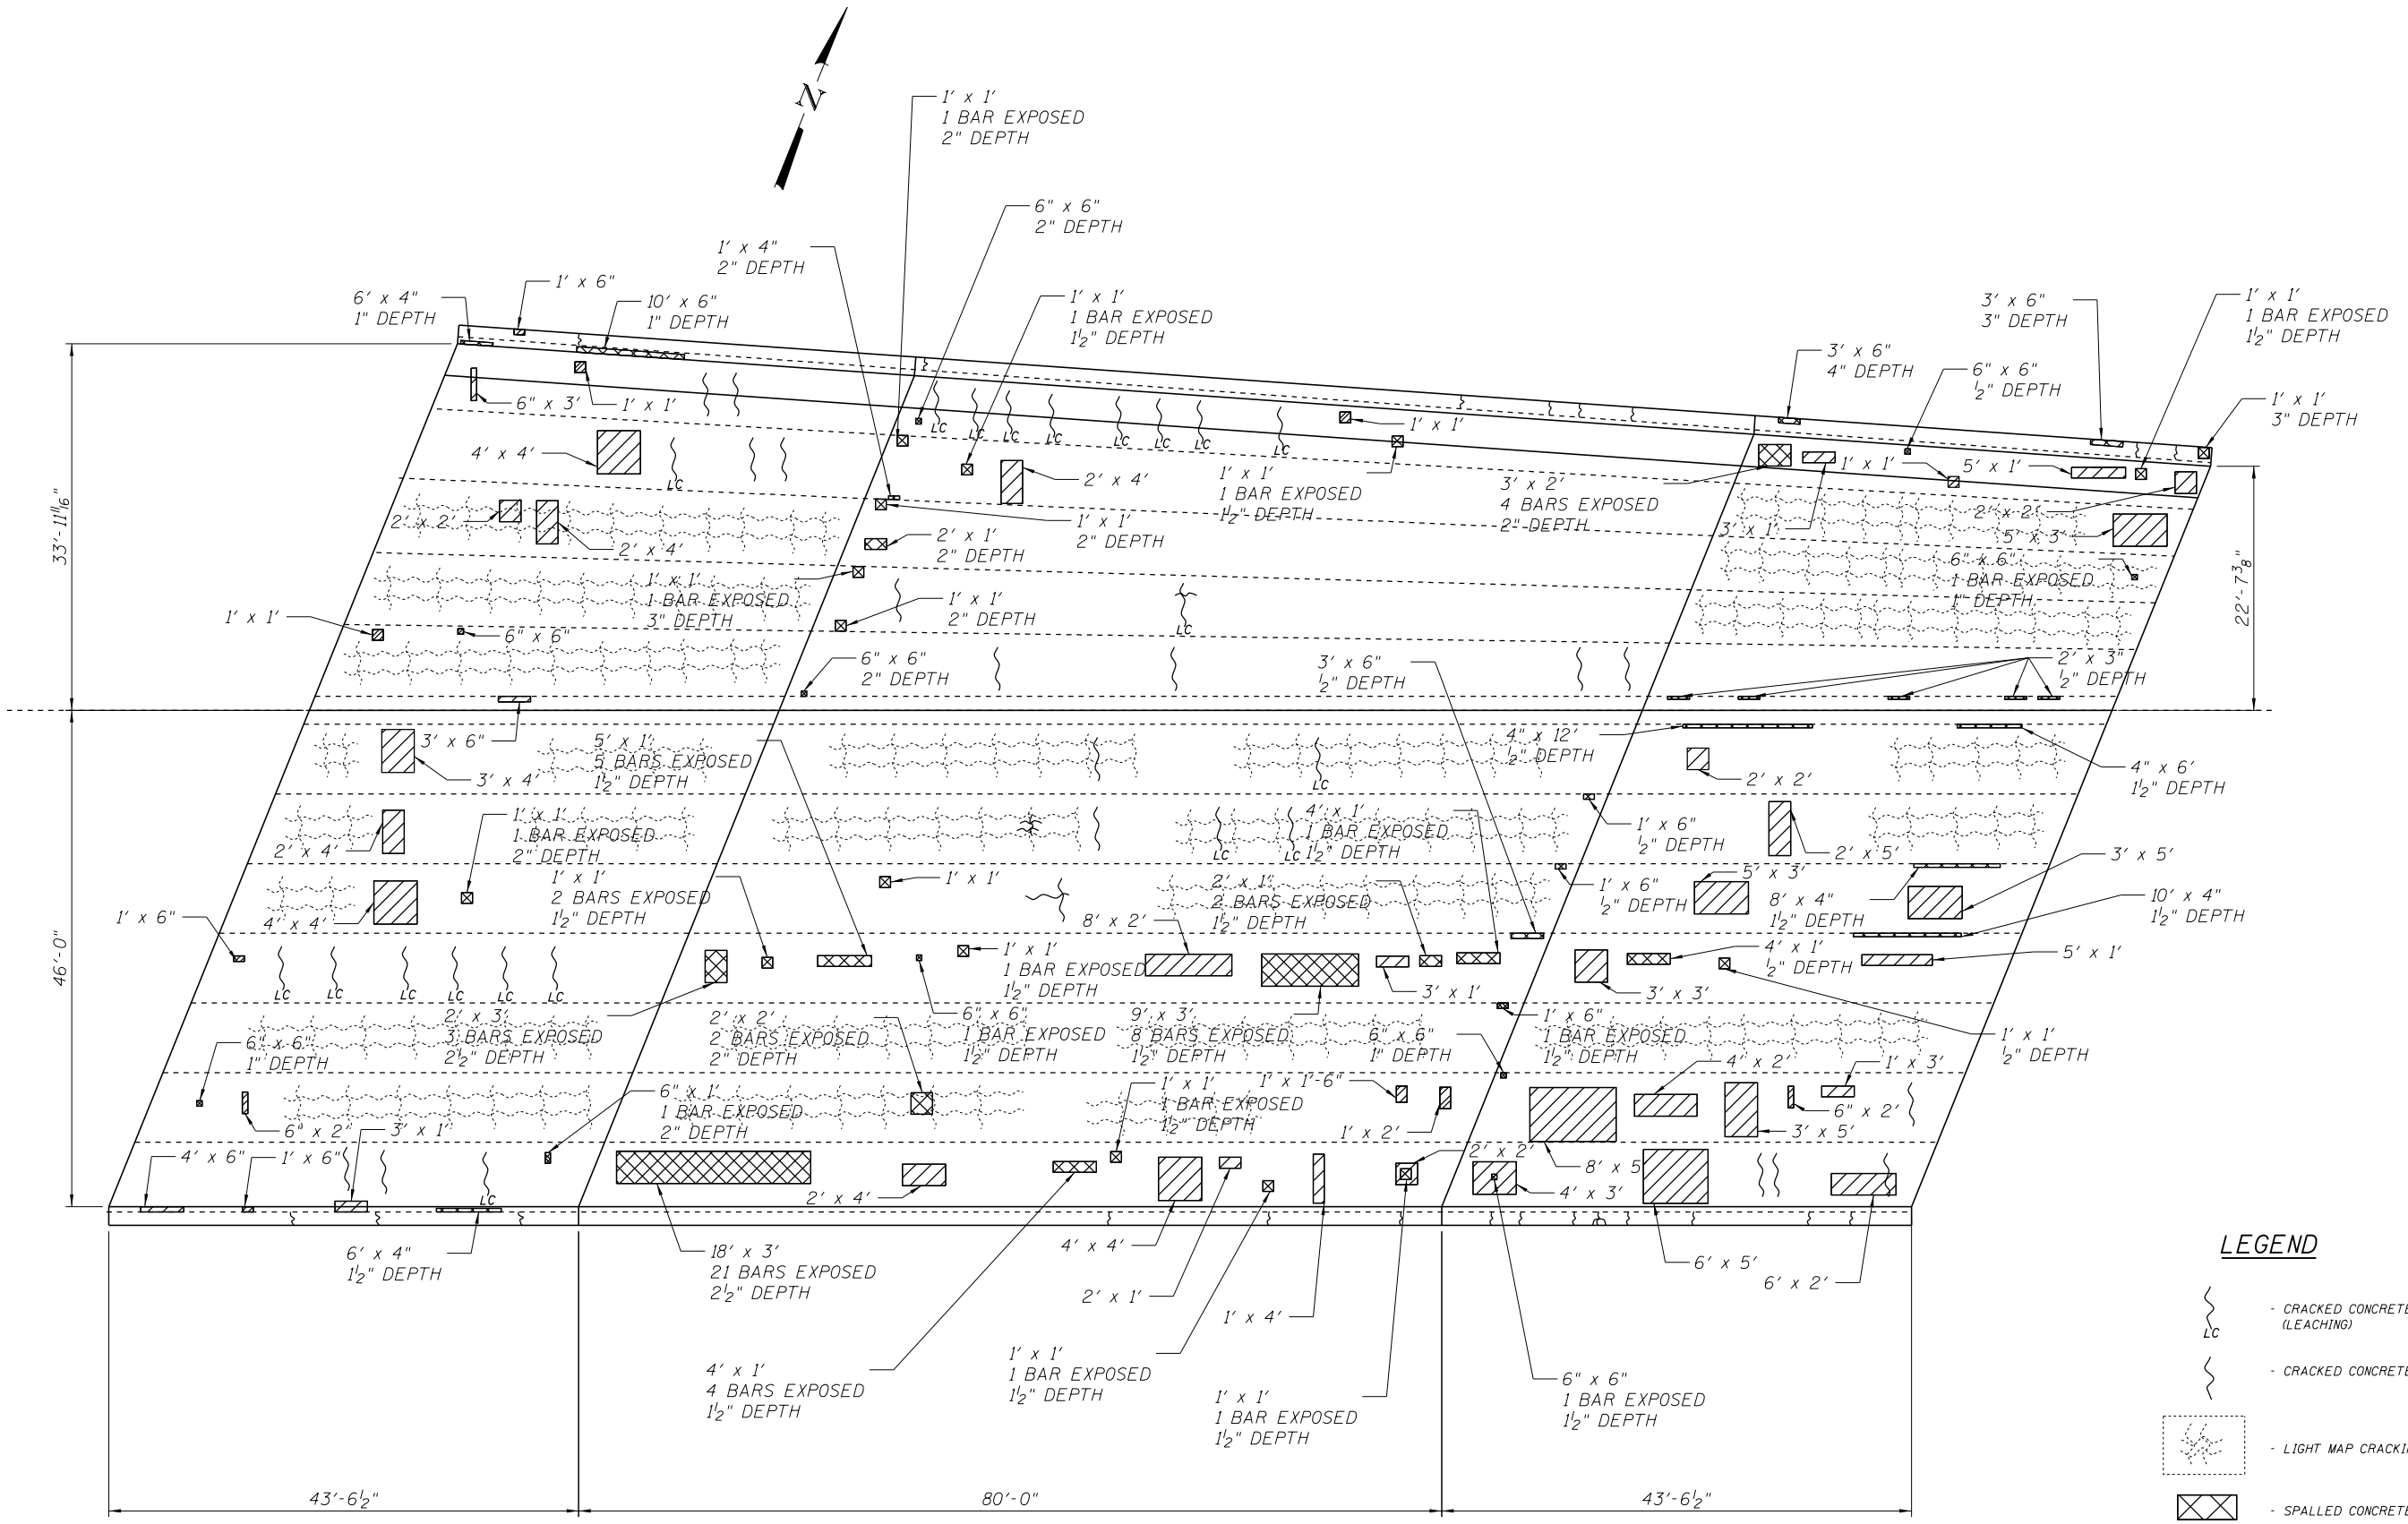

UNDERSIDE OF DECK
(WESTBOUND BRIDGE)

LEGEND

- CRACKED CONCRETE (LEACHING)
- CRACKED CONCRETE
- LIGHT MAP CRACKING
- SPALLED CONCRETE
- DELAMINATED CONCRETE

FILE NAME = W:\1786 active\178600037_IDOT_155 structural\drawing\shd\dwg_BRC_Railroad_UnderSide_of_Deck_Plan.dgn



USER NAME = jerojas	DESIGNED - JSR	REVISED -
PLOT SCALE = N/A	CHECKED - BPS	REVISED -
PLOT DATE = 10/4/2013	DRAWN - JSR	REVISED -
	CHECKED - BPS	REVISED -

STATE OF ILLINOIS
DEPARTMENT OF TRANSPORTATION

ATTACHMENT D - BOTTOM OF DECK CONDITION SURVEY
STRUCTURE NO. 016-0019
SHEET NO. 1 OF 1 SHEETS

F.A.I. RTE. = 55	SECTION = 1212-620-VB	COUNTY = COOK	TOTAL SHEETS =	SHEET NO. =
FED. ROAD DIST. NO. 1		ILLINOIS FED. AID PROJECT		

ATTACHMENT E

**Condition Assessment of the Reinforced
Concrete Bridge Deck**

January 6, 2012

Ms. Diane M. O'Keefe
Deputy Director of Highways
District One Engineer
Illinois Department of Transportation
201 West Center Court
Schaumburg, Illinois 60196-1096
Attn: Ms. Sarah Wilson (Maintenance Bridge Engineer)

Re: Condition Assessment of Bridge Deck
I-55 Westbound over BRC Railroad
Structure No. 016-0019
District One
Work Order 10
PTB No. 153-18
WJE No. 2009.3645.10

Dear Ms. O'Keefe:

At your request, Wiss, Janney, Elstner Associates, Inc. (WJE) completed a condition assessment of the reinforced concrete bridge deck for Structure No. 016-0019. This work included a visual assessment of concrete deterioration from below the structure. Also included was a delamination survey performed on the top of the bridge deck, based on an infrared thermography (IR) survey. Reinforcing bar cover depth determination was also performed using ground penetrating radar (GPR). These inspection tasks began in July and were completed in September.

Structure Description

The I-55 Westbound Bridge over BRC Railroad carries four lanes of traffic and two shoulders. This three span structure is comprised of a concrete deck supported by steel beams. Each of the 14 girder lines is connected using steel diaphragms. All deck and substructure components are comprised of cast-in-place reinforced concrete construction. Reportedly the bridge structure was originally constructed in 1963 and the current overlay was installed in 2000.

The spans have approximate lengths of 42 ft, 80 ft, and 42 ft, from west to east, for a total structure length of 168 ft-2 in., back-to-back of abutments. The total deck width varies. The total resulting bridge deck area is approximately 12,415 sq. ft. A partial elevation view of the structure looking northwest is included as Figure 1.

Inspection Methods

The condition of the reinforced concrete bridge deck was assessed using several methods. These methods can be broken down into two major categories: Bottom of Deck Inspection Methods and Top of Deck Inspection Methods.

Bottom of Deck Inspection Methods

The condition of the bottom of the reinforced concrete deck was assessed from grade below the structure in September 2011. All accessible areas of the bottom of the deck were assessed visually. This inspection was completed from the ground beneath the bridge outside of active railroad tracks. Binoculars and/or zoom lenses were used to magnify the view of distant surfaces. Plan drawings of the structure including the structural framing were used to record field notes.

Top of Deck Inspection Methods

The condition of the top of the reinforced concrete deck was assessed using IR equipment to map areas of spalls, patches, and delaminations. This work was subcontracted to Infrasense, Inc. and was performed in July, 2011. Rolling lane closures were utilized during data collection periods to allow the IR data collection vehicle to assess the entire bridge deck surface while moving at approximately 3 mph. Impact Echo (IE) and sounding techniques were used to confirm the presence of delaminations at select locations on each bridge deck. All IR data was analyzed and summarized on bridge deck drawing sheets that show the located defects to scale.

GPR equipment was used to identify the cover depth of the top mat of reinforcing steel from the top surface of the deck. The GPR equipment was mounted to an inspection vehicle and scans were completed at normal operating speeds.

Assessment Results

The reinforced concrete bridge deck was found to be in satisfactory condition overall. Results for each assessment category are included below.

Bottom of Deck

Visual inspection from grade below the bridge was used to assess the bottom of the bridge deck. All areas of spalls or delaminations that could be identified visually were documented. In addition, all areas of previously repaired concrete were noted. Table 1 includes a summary of the visual inspection, including total deck soffit area, the area of spalled concrete, the area of delaminated concrete and the area of previous repairs. Figures 2 and 3 show the typical condition of the deck soffit. The results of the bottom of deck survey are shown on Sheet S-3 of Appendix A.

Table 1. Bottom of Deck Deterioration Summary

Soffit Area (sq. ft)	Spalled Area (sq. ft)	Total Area (%)	Delaminated Area (sq. ft)	Total Area (%)	Previously Repaired Area (sq.ft)
12,415	25	0.2	235	1.9	2155

Top of Deck

The top of the bridge deck was assessed using both IR and GPR equipment. The IR survey equipment was able to identify delaminations and spalls present in the bridge deck. Figure 4 is an overall view of the top deck surface looking southwest.

Table 2 includes a summary of the total bridge deck area, the total bridge deck area spalled, the total bridge deck area delaminated, the total bridge deck area that should be programmed for repair work and the rebar cover from the top surface of the deck. Sheet S-1 of Appendix A is a scaled bridge deck plan drawing showing the locations of the delaminated or spalled areas. Sheet S-2 of Appendix A is a scaled bridge deck plan drawing showing an image of the IR scan of the bridge. Sheet S-4 of Appendix A is a scaled bridge deck plan drawing showing the location of suggested partial and full depth concrete repairs using conventional patching techniques. Note that repair area boundaries were selected by expanding the boundaries of each delaminated or spalled area by 6 inches to account for saw cutting outside of the delamination and further deterioration prior to the actual start of any repair work. In addition, repair areas were joined when adjacent repairs were spaced at approximately 2 ft. or less. Full depth repair boundaries were determined based on locations where top and bottom surface defects overlapped. No bottom surface repairs were identified based on recommendations from IDOT.

Table 2. Top of Deck Deterioration Summary

Bridge Deck Area (sq. ft)	Spalled Area (sq. ft)	Total Area (%)	Delaminated Area (sq. ft)	Total Area (%)	Repair Area (sq. ft)	Total Area (%)	Rebar Cover (in.)
12,415	0	0	665	5.4	1414	11.4	3.4

Recommendations and Conclusions

WJE performed a condition assessment of the reinforced concrete bridge deck of the I-55 Westbound Bridge over BRC Railroad. This condition assessment included: a visual survey of the bottom of the deck and an IR survey of the top of the deck. This information was used to produce repair drawings indicating the size and location of anticipated repair areas.

The repair work should, at a minimum, include partial depth repairs at all locations indicated on Sheet S-4 in Appendix A. If this option is selected, a detailed delamination assessment should be completed by the contractor at the time of the repair work to ensure that all areas of deteriorated concrete are identified. In addition, all re-entrant corners of repair areas should be detailed to include a 4 inch chamfer to reduce the potential for concrete-shrinkage related cracking.

The bridge deck was found to currently be in satisfactory condition, but corrosion-related damage has become apparent and should be repaired.


We would be happy to answer any questions or provide additional information.

Sincerely,

WISS, JANNEY, ELSTNER ASSOCIATES, INC.



Joseph A. Rogers Jr., S.E.
Project Associate

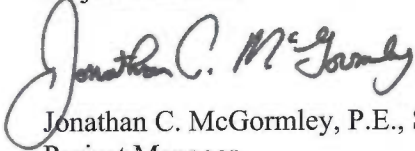

Jonathan C. McGormley, P.E., S.E.
Project Manager

Figures



Figure 1. Elevation View, looking northwest.



Figure 2. Typical view, deck soffit, looking west.

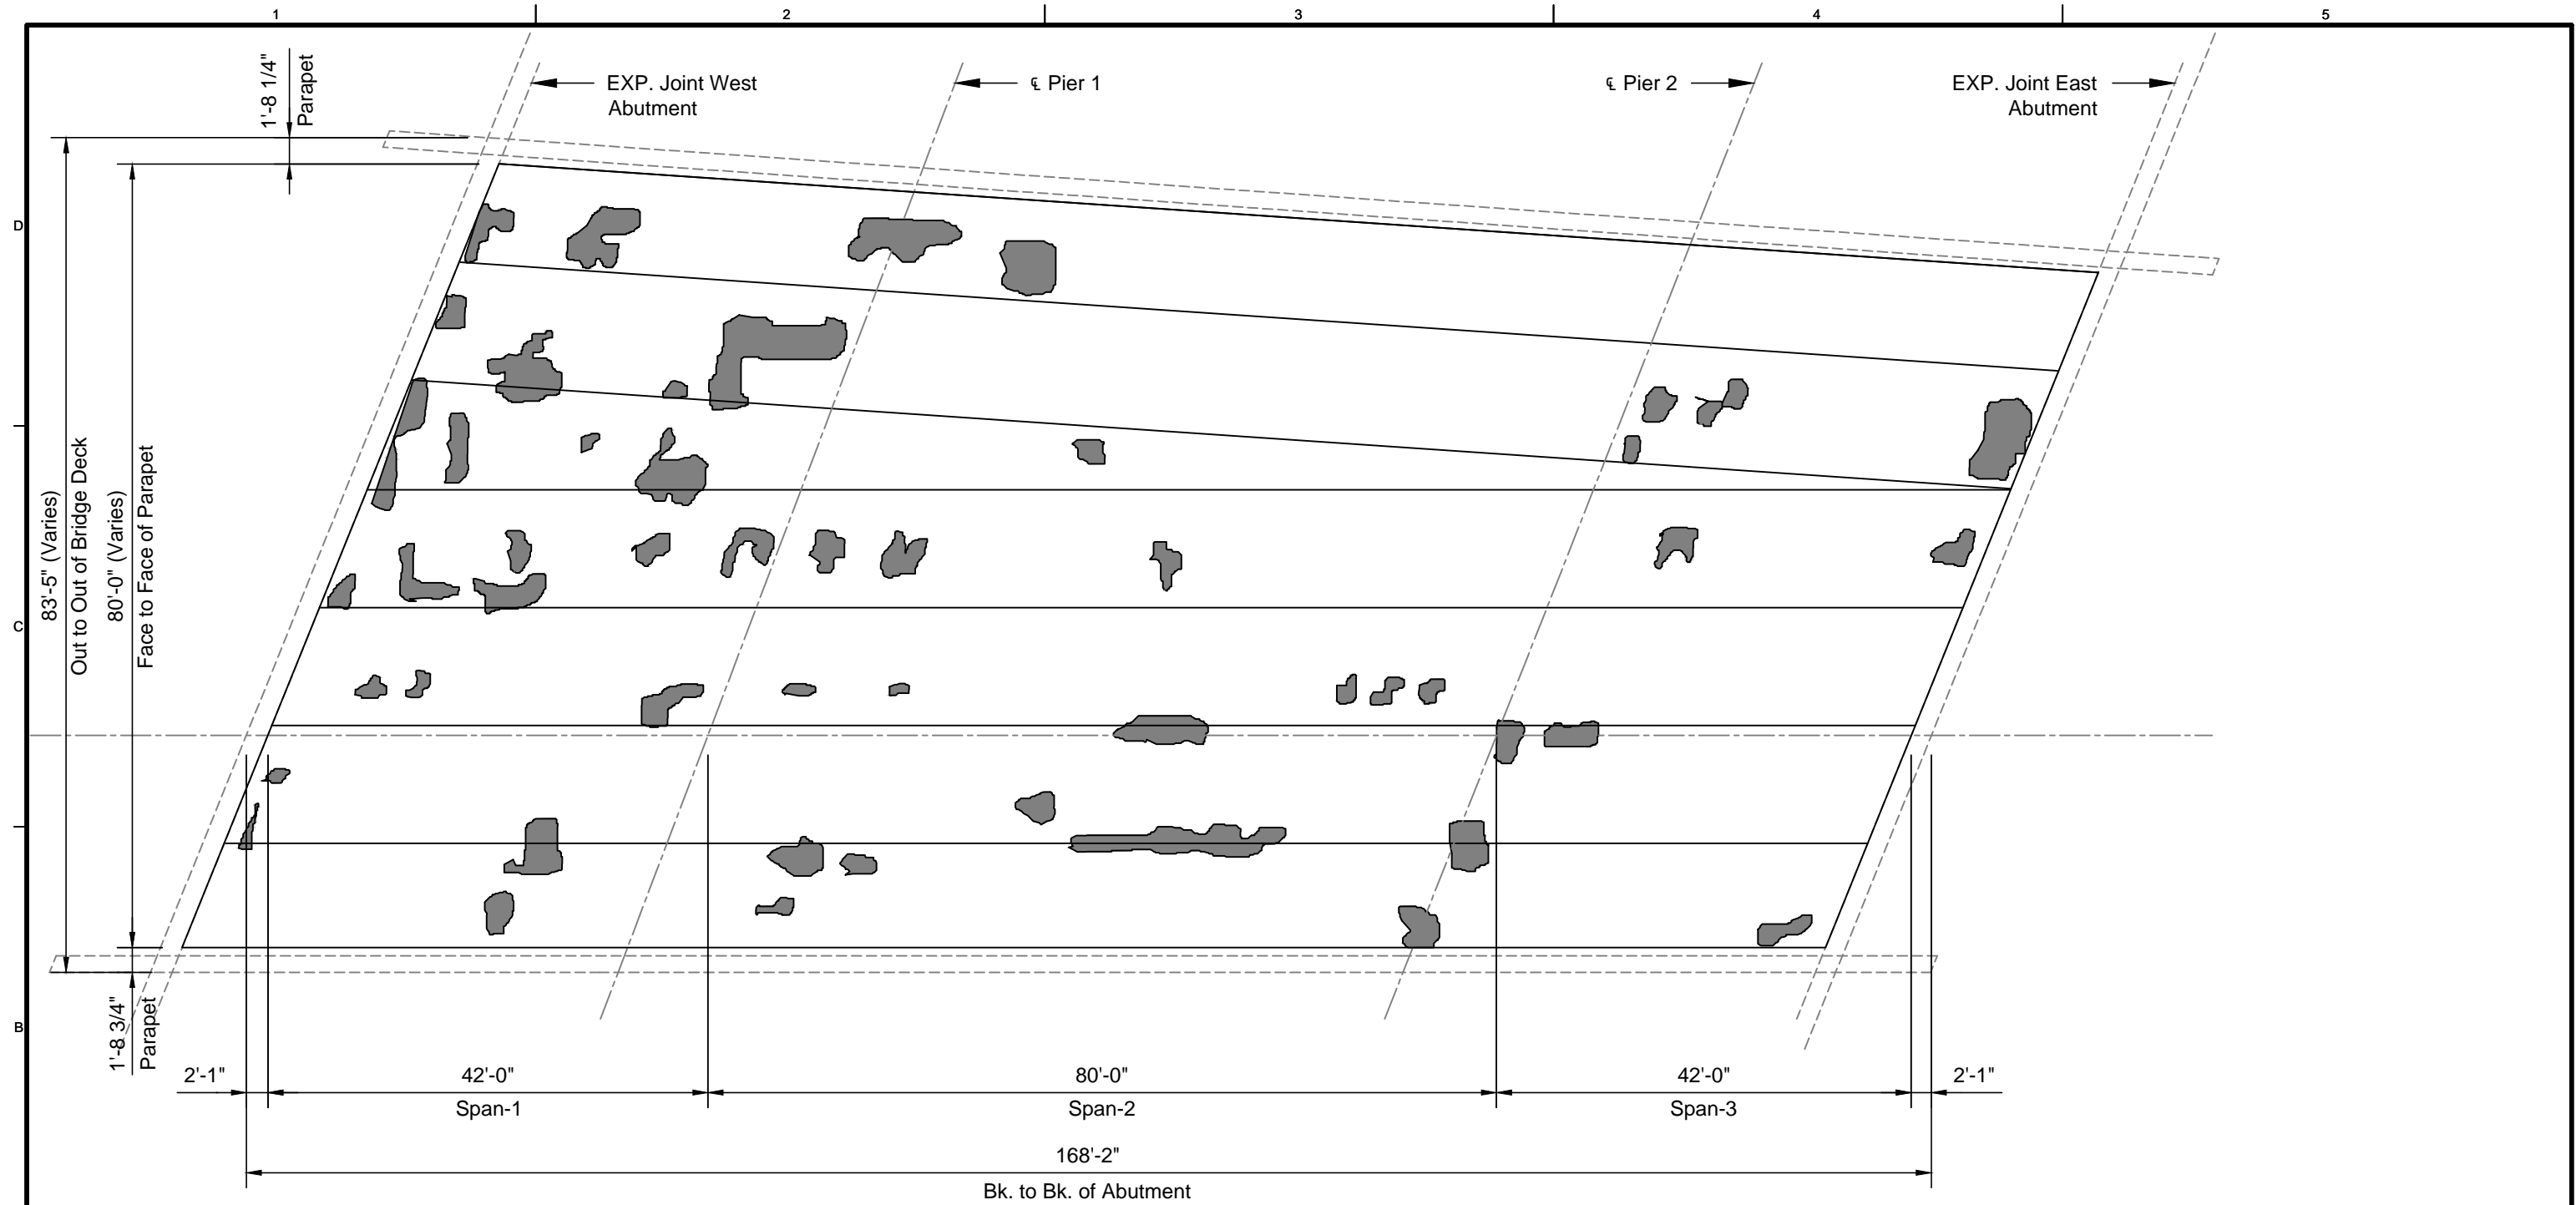


Figure 3. Typical view, deck soffit, looking east.

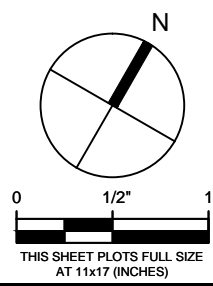


Figure 4. Typical view, deck top surface, looking southwest

Appendix A - Bridge Deck Condition Assessment Drawings



FIELD OBSERVATION SUMMARY		STRUCTURE # 016-0019		LEGEND	
ITEM	UNIT	QUANT.	%	DELAMINATION	
TOTAL AREA	Ac	12415	100	SPALL	
DELAMINATION	Ac	665	5.4	CRACK	
SPALL	Ac	0	0		
CRACKS	ft	-	-		




WJE ENGINEERS ARCHITECTS MATERIALS SCIENTISTS
 Wiss, Janney, Elstner Associates, Inc.
 330 Pfingsten Road
 Northbrook, Illinois 60062
 847.272.7400 tel | 847.291.4813 fax
 www.wje.com

Client
 Illinois Department of Transportation
 District One
 201 West Center Court
 Schaumburg, Illinois 60196


Project
Bridge 016-0019
 WESTBOUND I-55 OVER R.R.
 Sheet Title
IR Result - Top Surface

Proj. No. 2009.3645.10
 Date November 19 2011
 Drawn JJZ
 Checked JAR
 Scale $\frac{1}{8"=1'-0"}$

Sheet No. **S1**

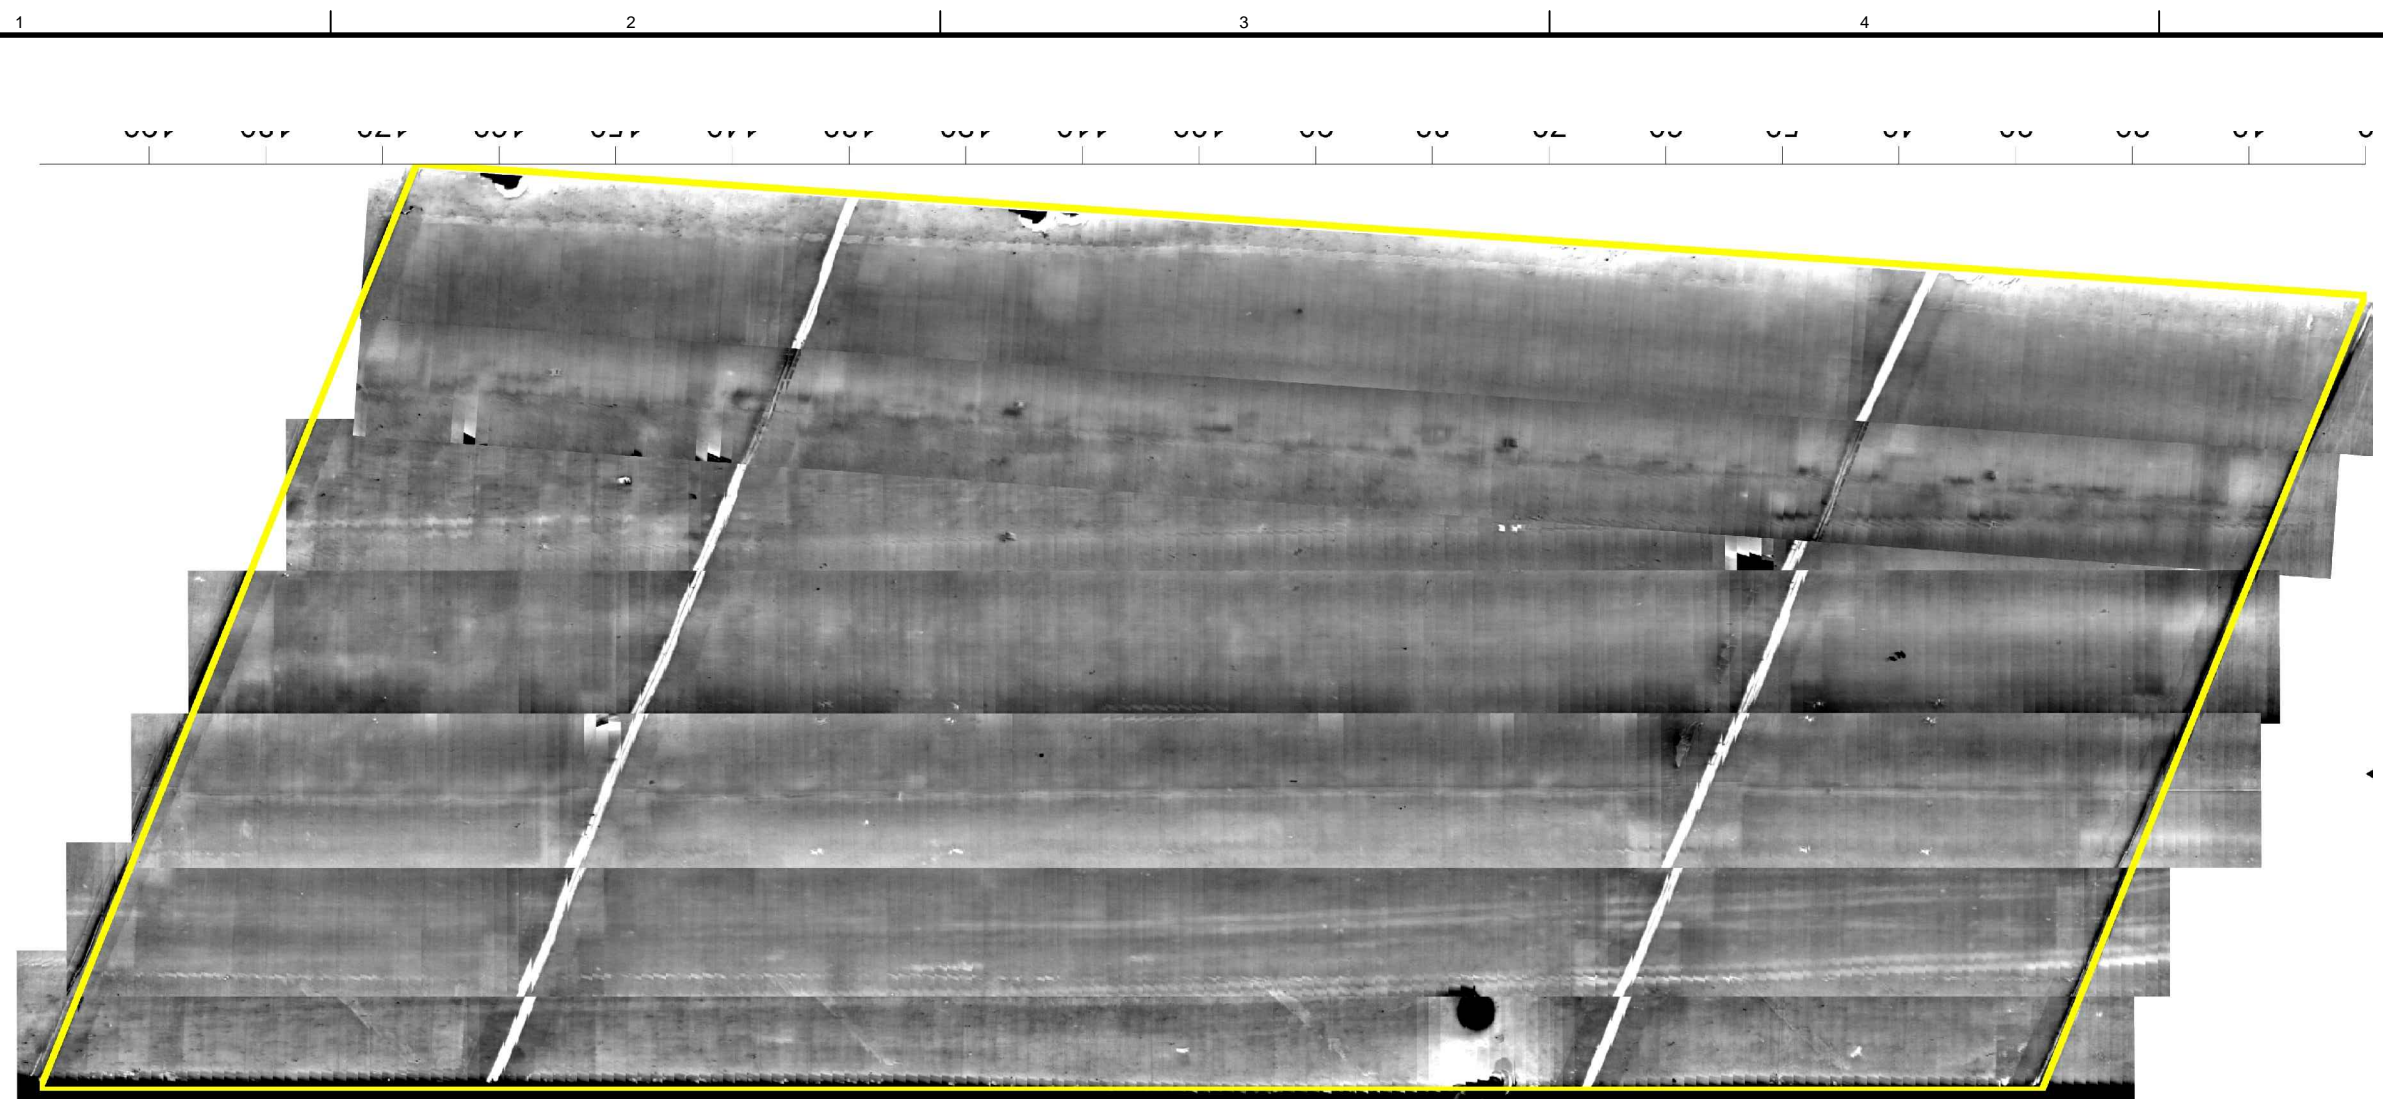

D
C
B
A

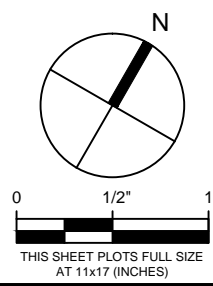


WJE ENGINEERS
ARCHITECTS
MATERIALS SCIENTISTS
Wiss, Janney, Elstner Associates, Inc.
330 Pfingsten Road
Northbrook, Illinois 60062
847.272.7400 tel | 847.291.4813 fax
www.wje.com

Client
Illinois Department of Transportation
District One
201 West Center Court
Schaumburg, Illinois 60196


Project
Bridge 016-0019
WESTBOUND I-55 OVER R.R.
Sheet Title
IR Image - Top Surface

Proj. No.	2009.3645.10
Date	November 19 2011
Drawn	JJZ
Checked	JAR
Scale	1/16" = 1'

Sheet No. **S2**

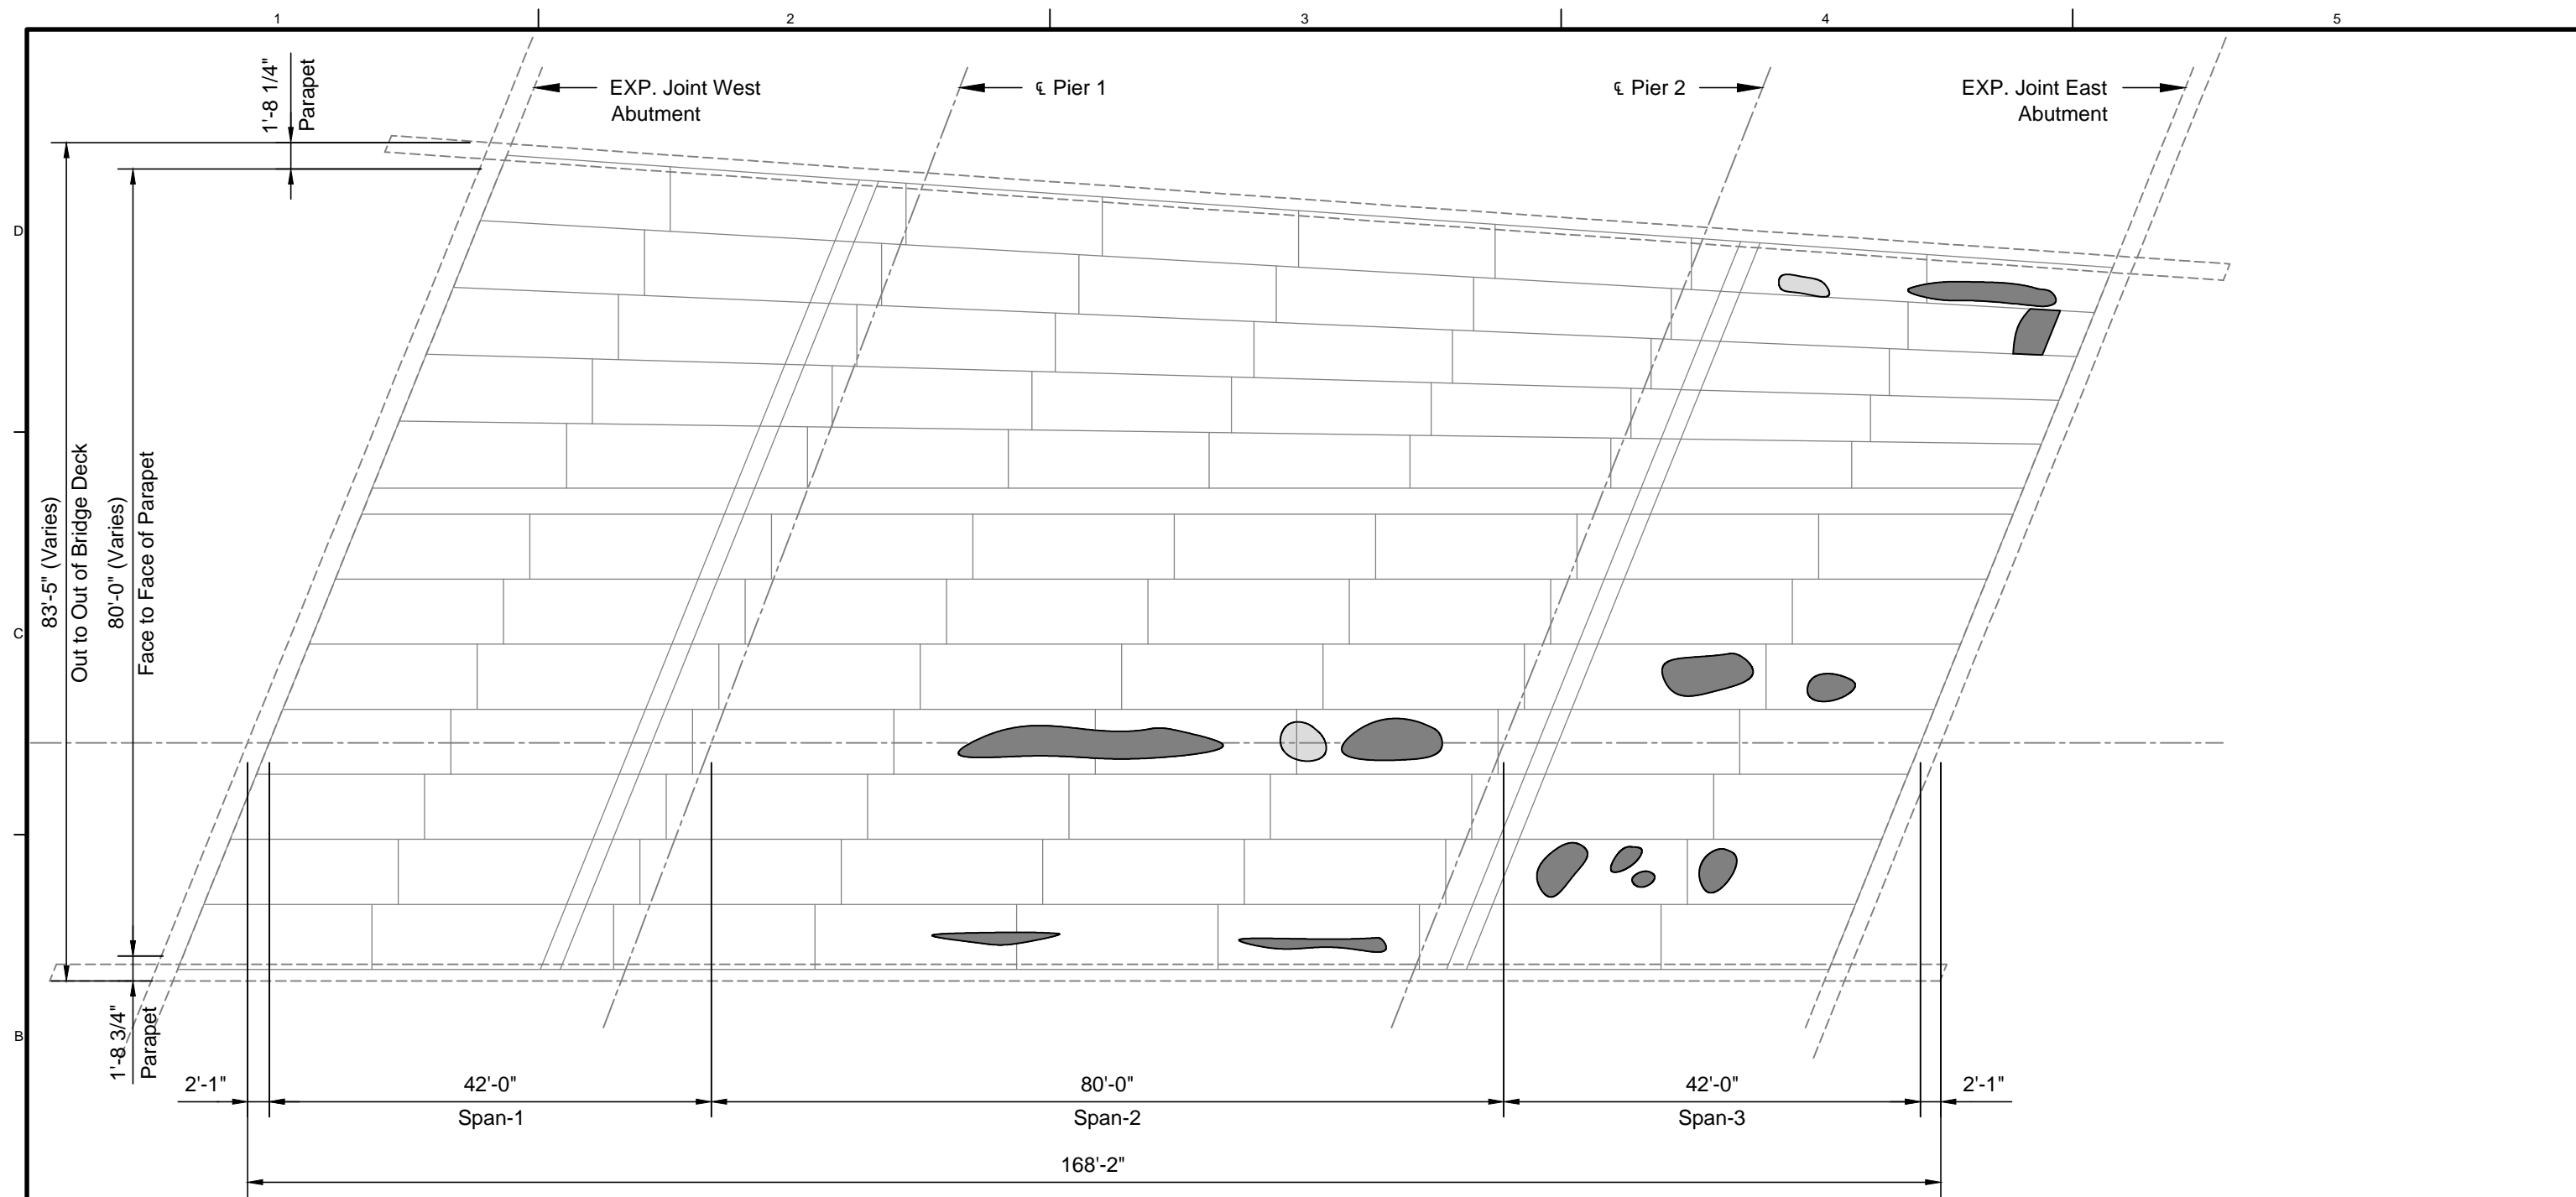

FIELD OBSERVATION SUMMARY		STRUCTURE # 016-0019		LEGEND	
ITEM	UNIT	QUANT.	%		
TOTAL AREA	Ac	12415	100	DELAMINATION	
DELAMINATION	Ac	235	1.9	SPALL	
SPALL	Ac	25	0.2	PREV. REPAIR	
PREVIOUS REPAIRS	Ac	2155	17.4	CRACK	
CRACKS	ft	-	-		

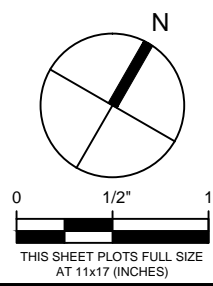


WJE ENGINEERS ARCHITECTS MATERIALS SCIENTISTS
 Wiss, Janney, Elstner Associates, Inc.
 330 Pfingsten Road
 Northbrook, Illinois 60062
 847.272.7400 tel | 847.291.4813 fax
 www.wje.com

Client
 Illinois Department of Transportation
 District One
 201 West Center Court
 Schaumburg, Illinois 60196


Project
 Bridge 016-0019
 WESTBOUND I-55 OVER R.R.
 Sheet Title
 Underside Deterioration

Proj. No. 2009.3645.10
 Date November 19 2011
 Drawn JJZ
 Checked JAR
 Scale 1/16" = 1'

Sheet No. **S3**

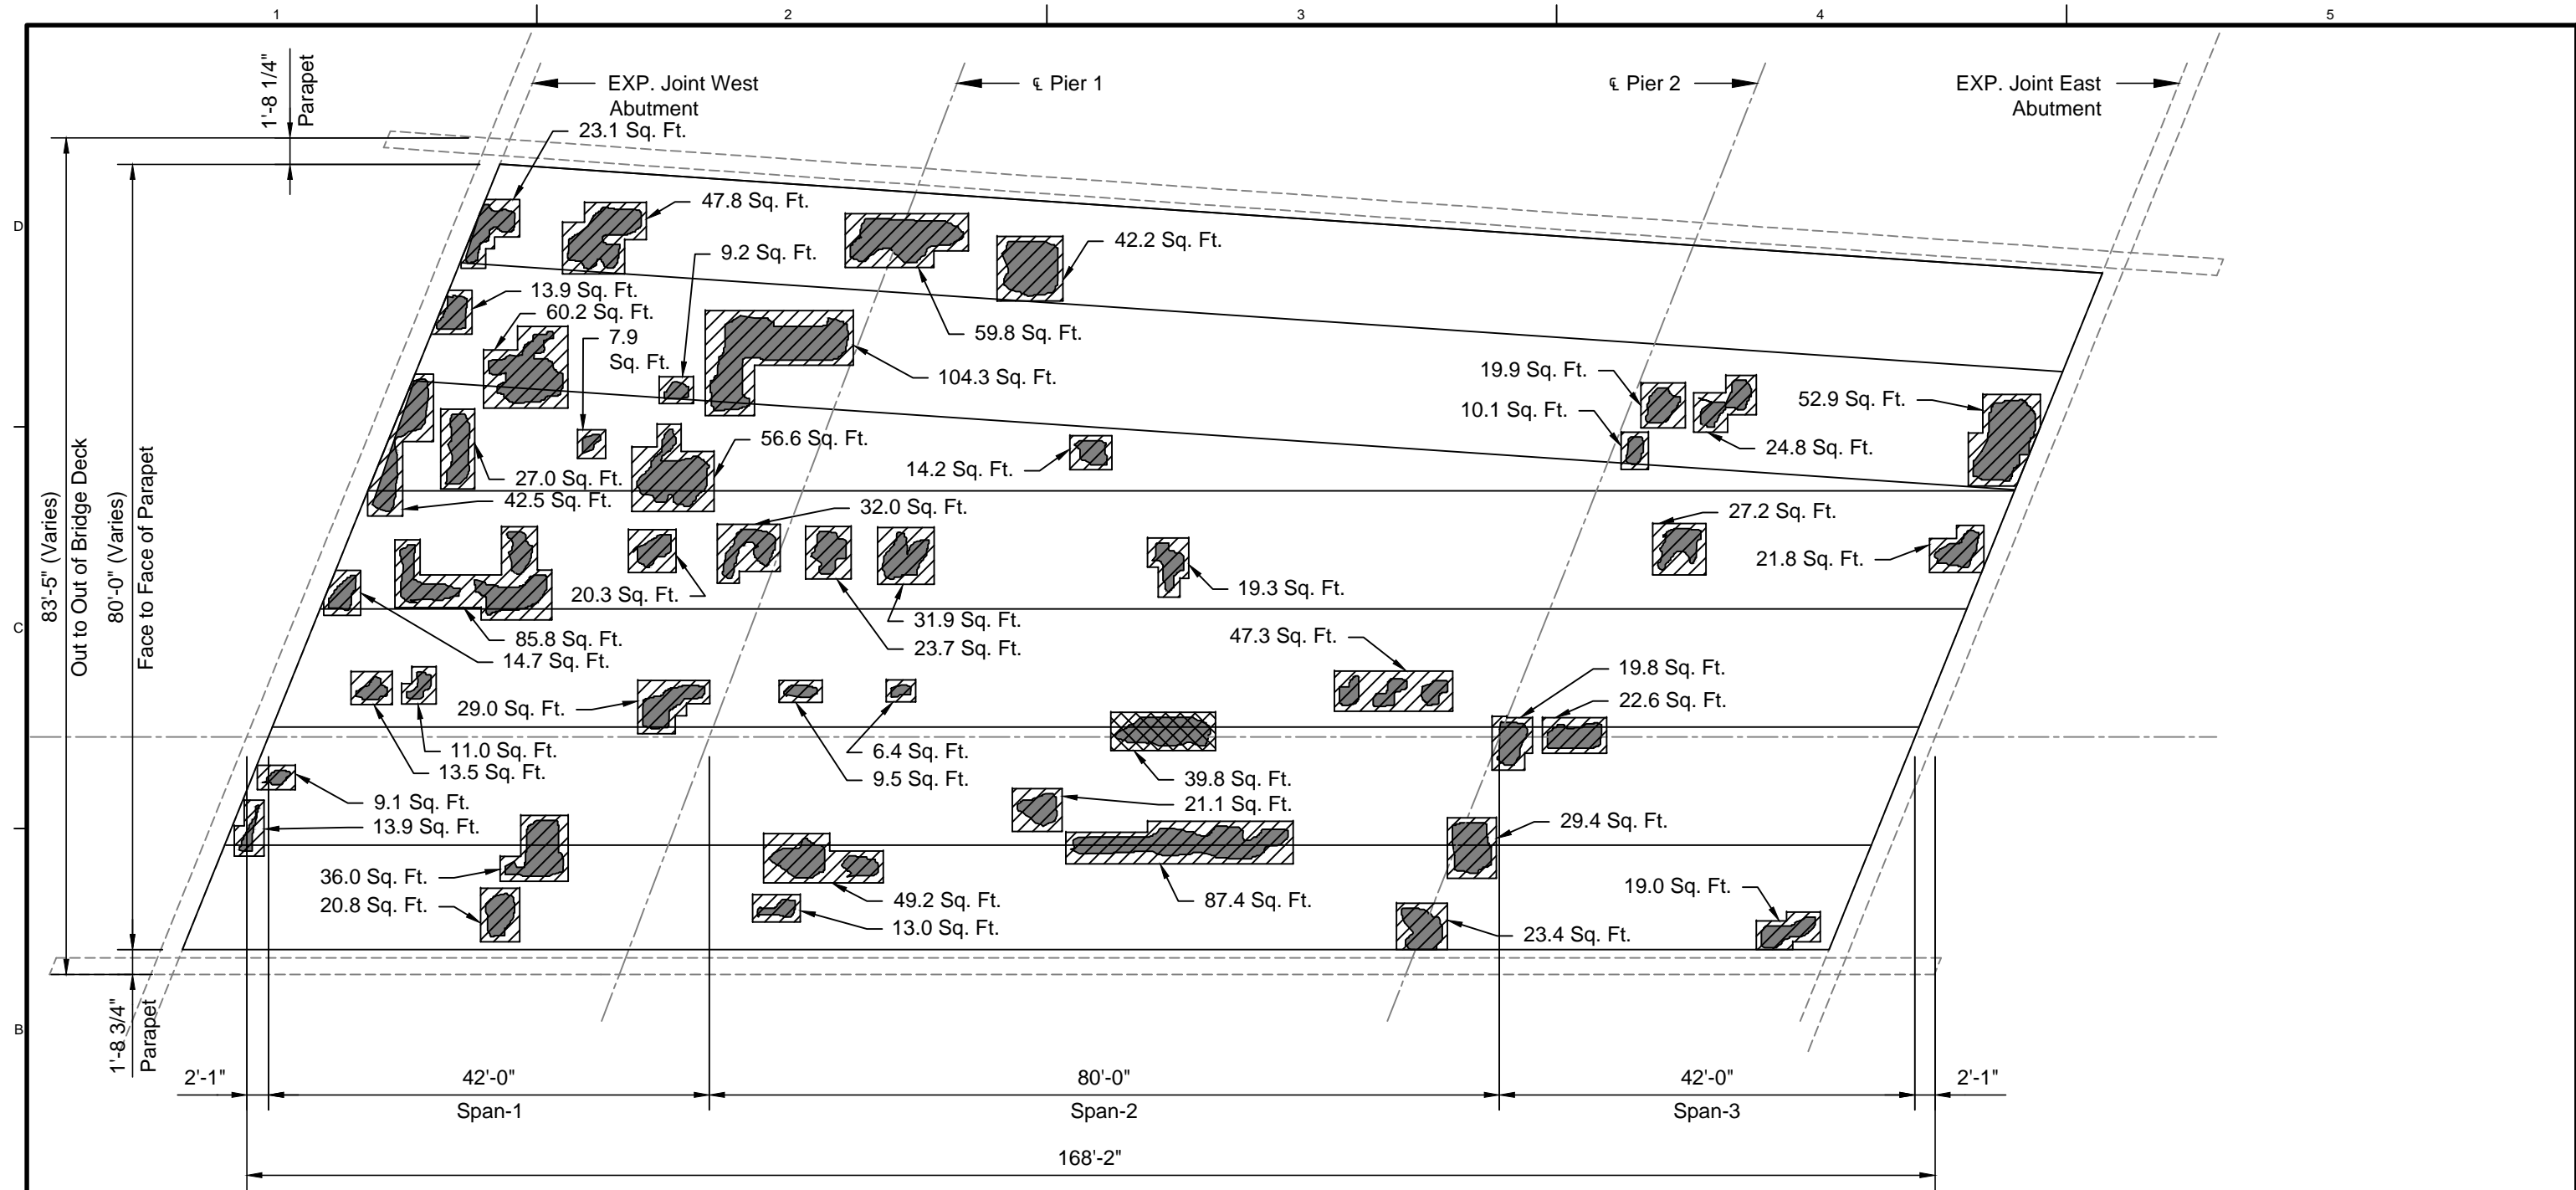

FIELD OBSERVATION SUMMARY		STRUCTURE # 016-0019		LEGEND	
ITEM	UNIT	QUANT.	%		
TOTAL AREA	Ac	12415	100	PARTIAL DEPTH REPAIR	
PARTIAL DEPTH REPAIR	Ac	1374	11.1	FULL DEPTH REPAIR	
FULL DEPTH REPAIR	Ac	40	0.3	DELAMINATION	
DELAMINATION	Ac	665	5.4	SPALL	
SPALL	Ac	0	0	CRACK	
CRACKS	ft	-	-		

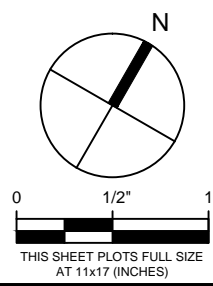

WJE ENGINEERS ARCHITECTS MATERIALS SCIENTISTS
 Wiss, Janney, Elstner Associates, Inc.
 330 Pfingsten Road
 Northbrook, Illinois 60062
 847.272.7400 tel | 847.291.4813 fax
 www.wje.com

Client
Illinois Department of Transportation
 District One
 201 West Center Court
 Schaumburg, Illinois 60196


Project
 Bridge 016-0019
 WESTBOUND I-55 OVER R.R.
 Sheet Title
 Proposed Repairs

Proj. No. 2009.3645.10
 Date November 19 2011
 Drawn JJZ
 Checked JAR
 Scale 1/16" = 1'-0"


Sheet No. **S4**

ATTACHMENT F

Substructure Condition Surveys

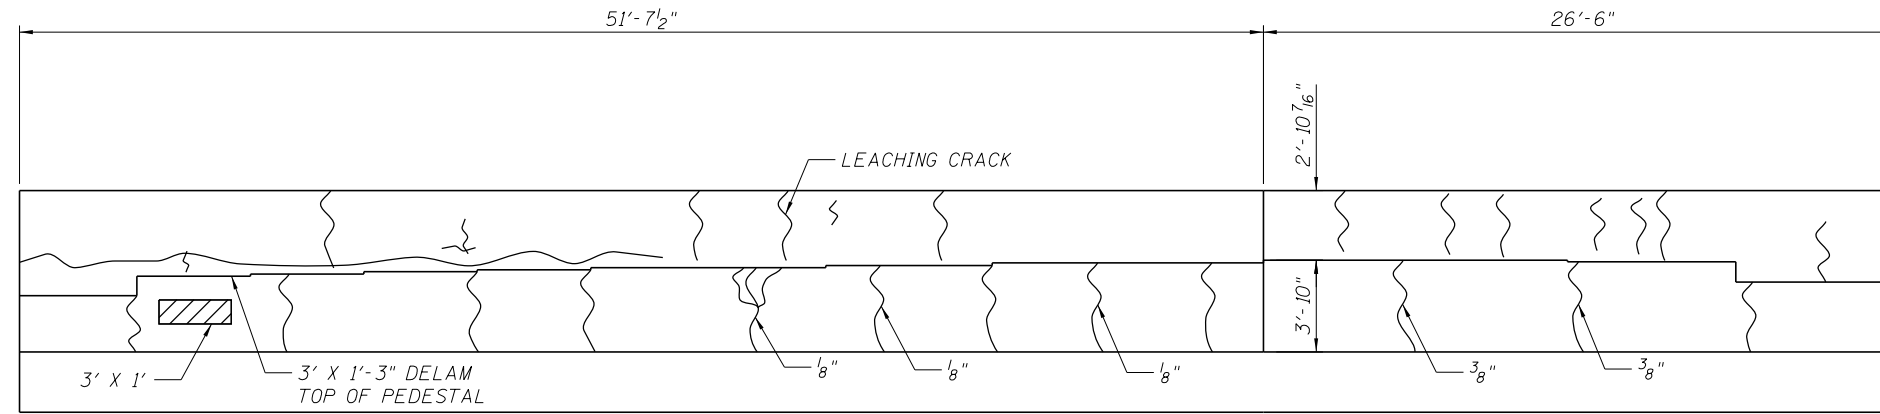

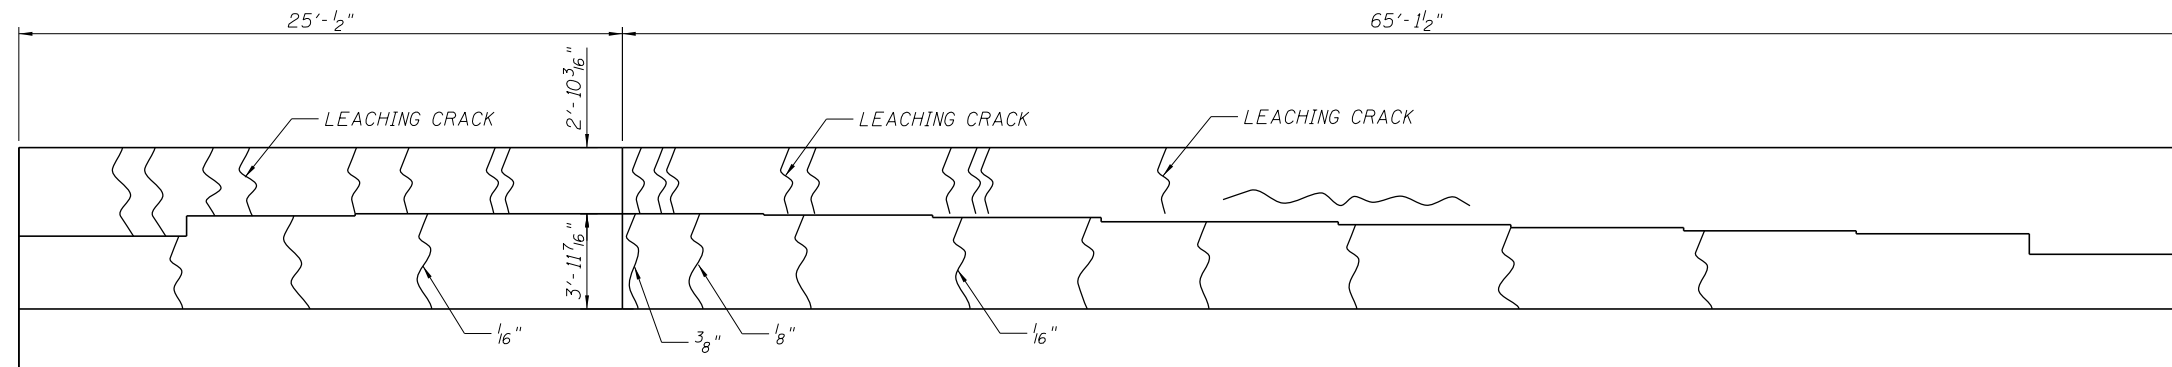


EAST ABUTMENT LOOKING EAST



WEST ABUTMENT LOOKING WEST

LEGEND

 -  - HAIRLINE CRACK (UNLESS OTHERWISE NOTED)
-  - SPALLED CONCRETE
-  - DELAMINATED CONCRETE

FILE NAME = V:\1786\active\178600037_IDOT_1-95\structural\drawing\shd\dwg_BRC_Railroad_Abument_Elevation.dgn




USER NAME = jerojas	DESIGNED - JSR	REVISED -
	CHECKED - BPS	REVISED -
PLOT SCALE = N/A	DRAWN - JSR	REVISED -
PLOT DATE = 10/4/2013	CHECKED - BPS	REVISED -

**STATE OF ILLINOIS
DEPARTMENT OF TRANSPORTATION**


**ATTACHMENT F - SUBSTRUCTURE CONDITION SURVEY
STRUCTURE NO. 016-0019**

SHEET NO. 1 OF 3 SHEETS

F.A.I. RTE.	SECTION	COUNTY	TOTAL SHEETS	SHEET NO.
55	1212-620-VB	COOK		
CONTRACT NO.				
FED. ROAD DIST. NO. 1 ILLINOIS FED. AID PROJECT				

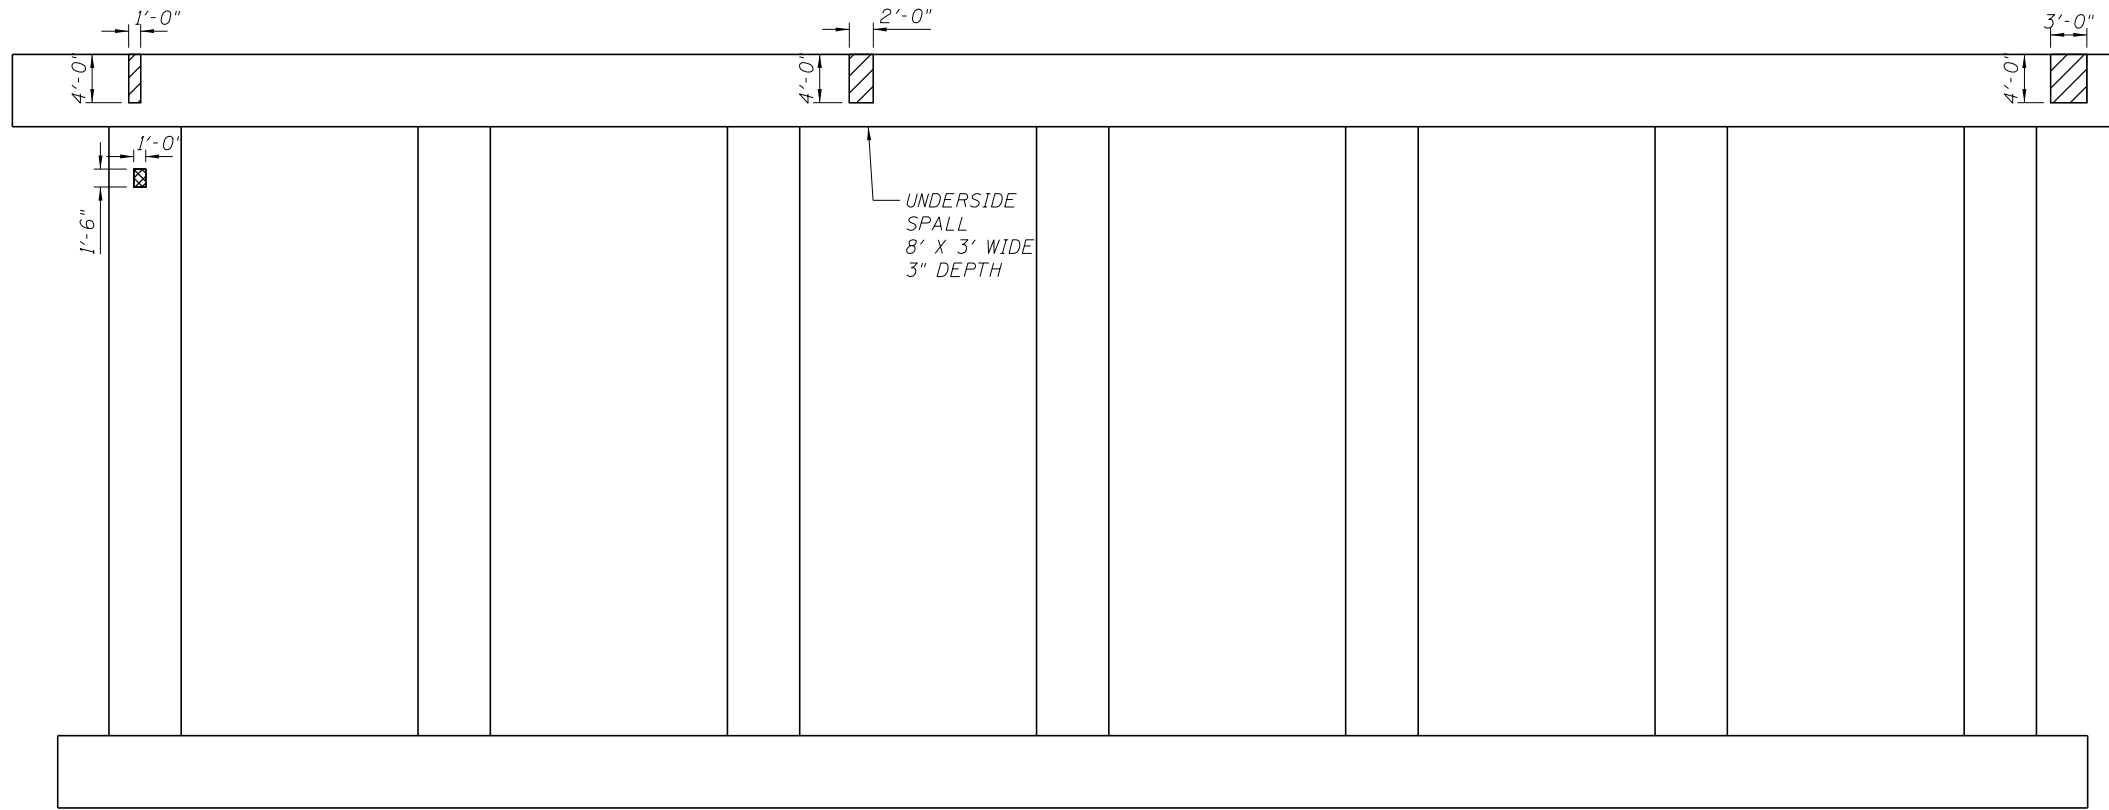

PIER 1
LOOKING EAST

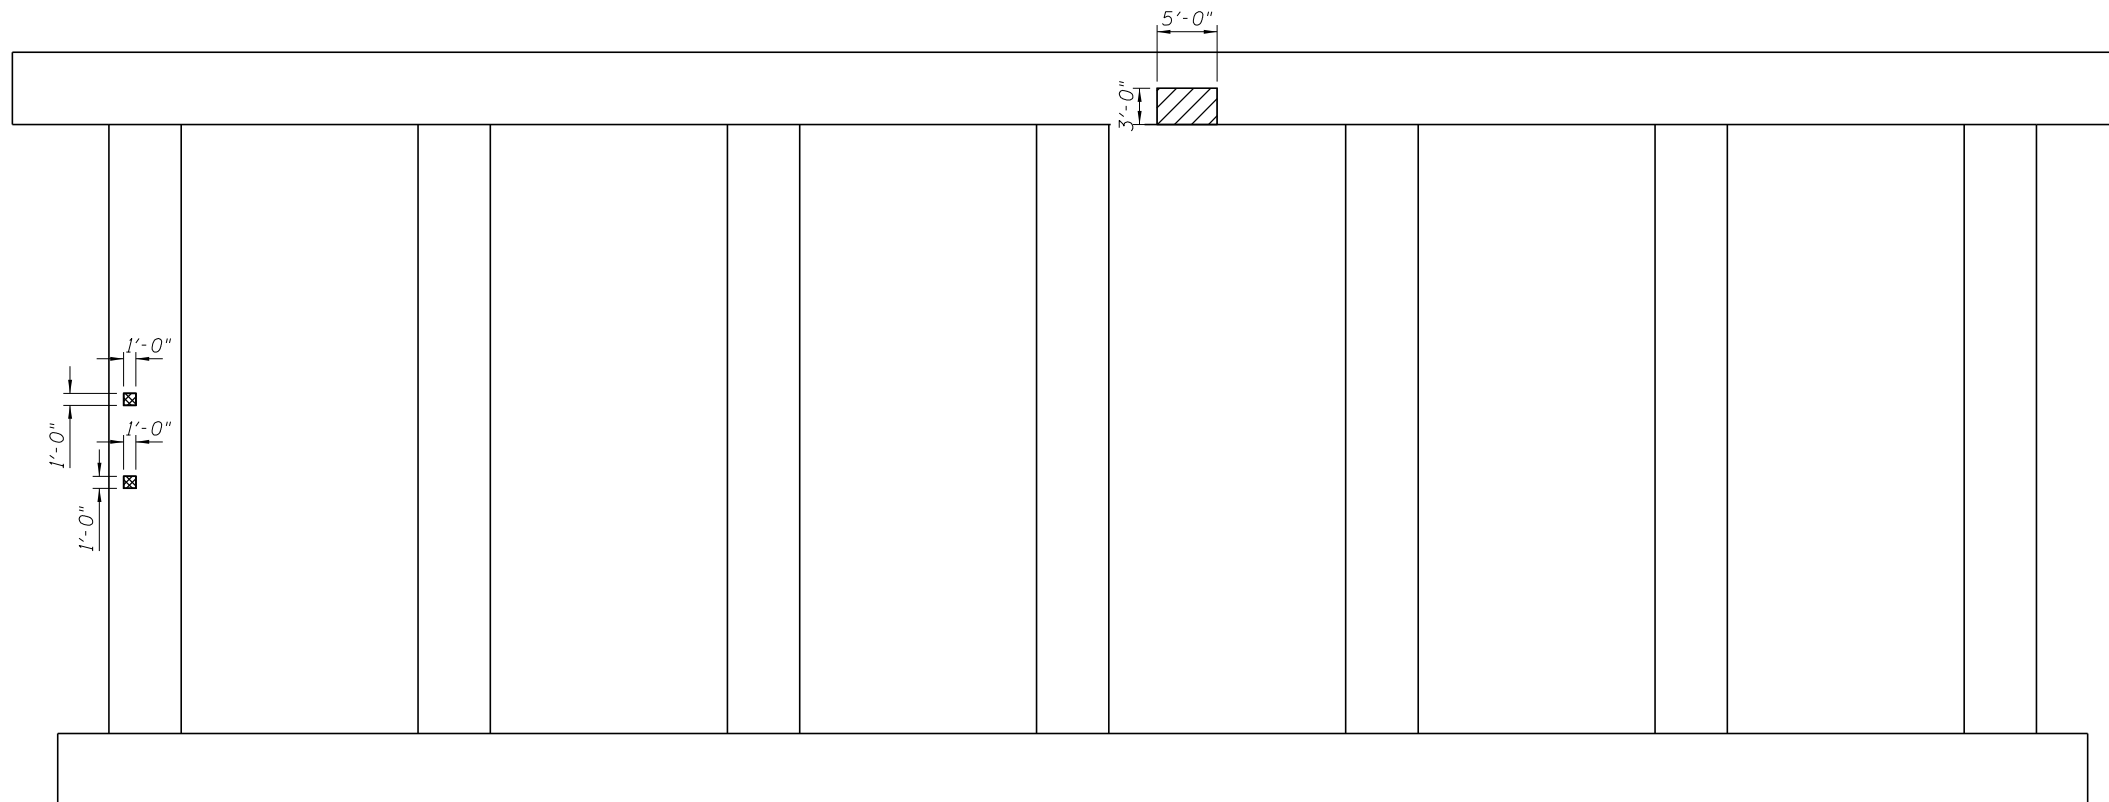

PIER 1
LOOKING WEST

LEGEND

- SPALLED CONCRETE
- DELAMINATED CONCRETE

FILE NAME = V:\1786\active\178600037_IDOT_1-95\structural\drawing\shd\dwg_BRC_Railroad_Pier-Elevation.dgn




USER NAME = jerojas	DESIGNED - JSR	REVISED -
	CHECKED - BPS	REVISED -
PLOT SCALE = N/A	DRAWN - JSR	REVISED -
PLOT DATE = 10/4/2013	CHECKED - BPS	REVISED -

STATE OF ILLINOIS
DEPARTMENT OF TRANSPORTATION


ATTACHMENT F - SUBSTRUCTURE CONDITION SURVEY
STRUCTURE NO. 016-0019

SHEET NO. 2 OF 3 SHEETS

F.A.I. RTE.	SECTION	COUNTY	TOTAL SHEETS	SHEET NO.
55	1212-620-VB	COOK		
CONTRACT NO.				
FED. ROAD DIST. NO. 1 ILLINOIS FED. AID PROJECT				

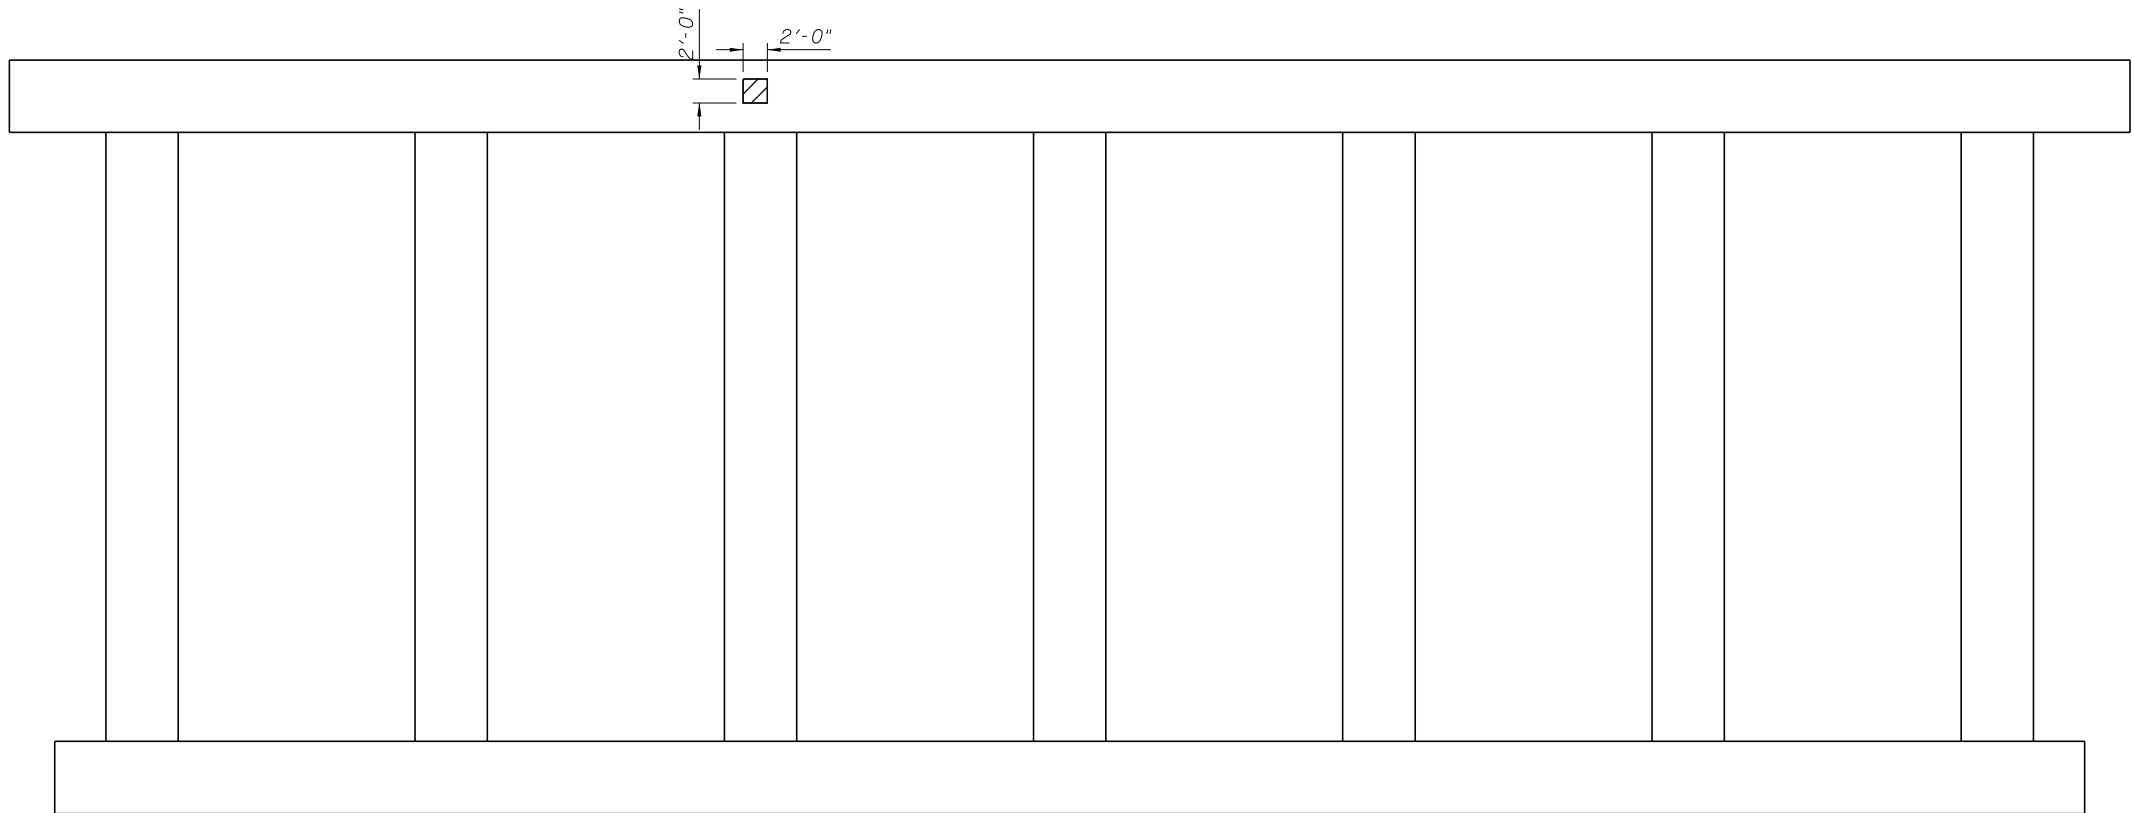

PIER 2
LOOKING EAST

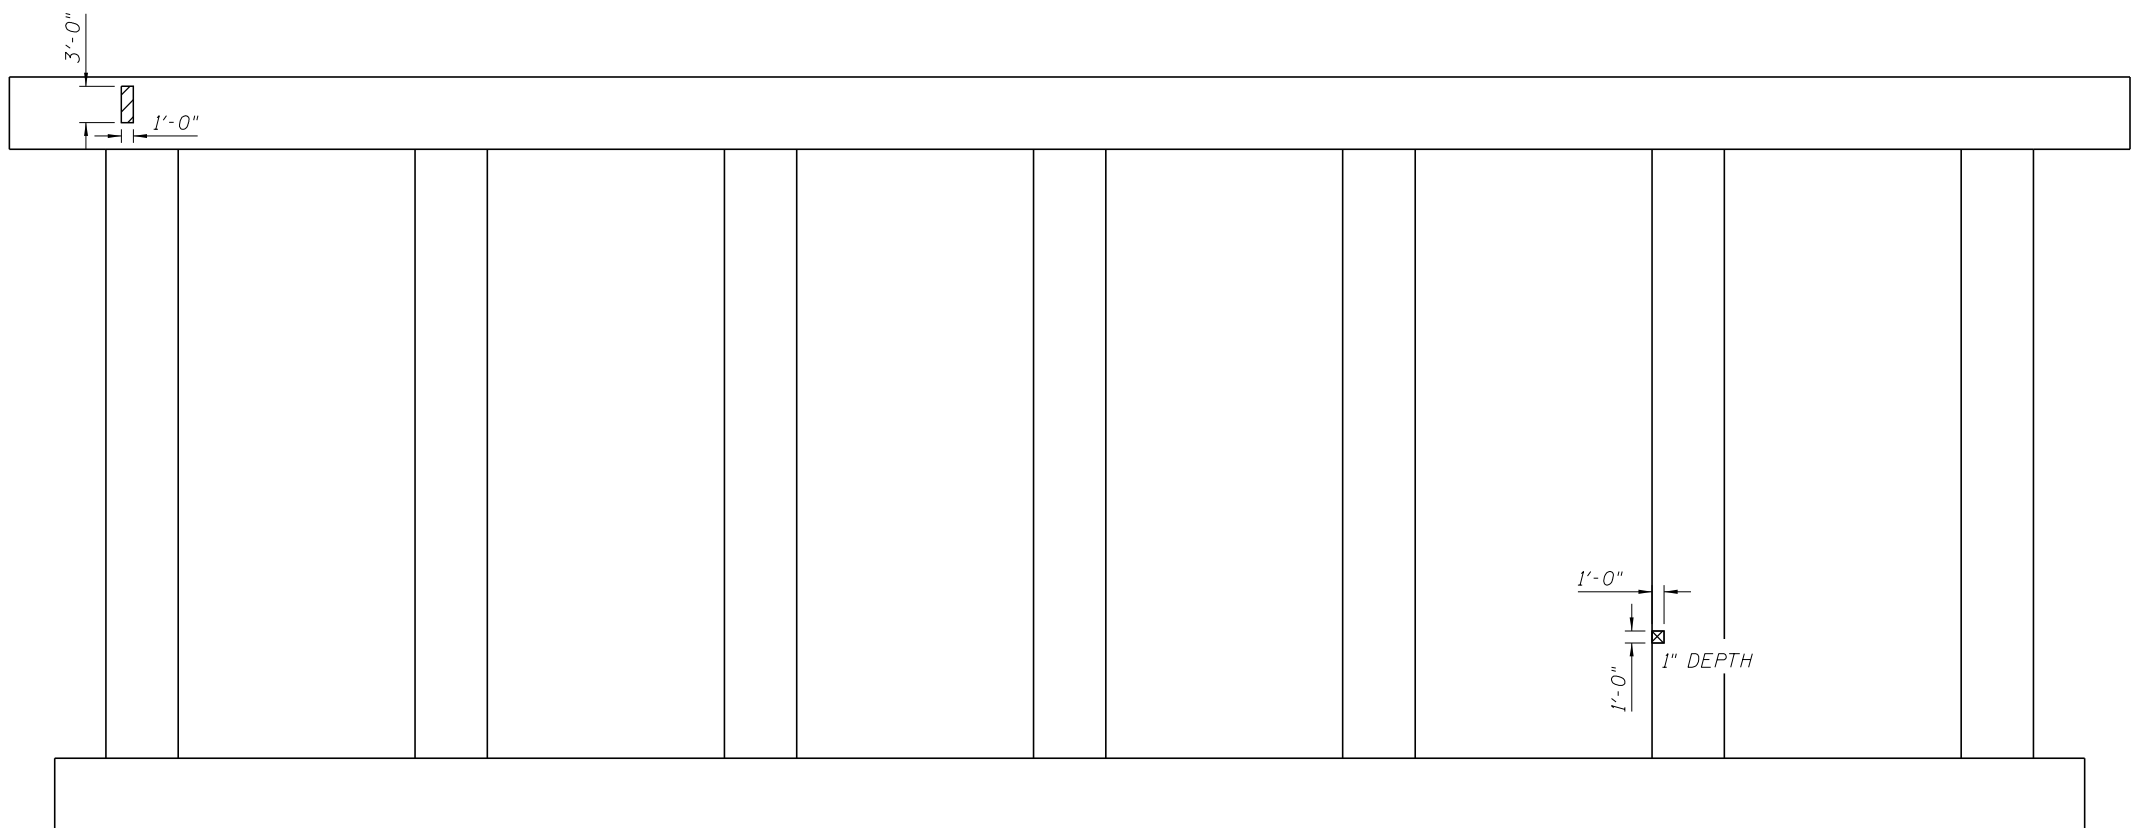

PIER 2
LOOKING WEST

LEGEND

-  - SPALLED CONCRETE
-  - DELAMINATED CONCRETE

FILE NAME = V:\1786\active\178600037_IDOT_155\structural\drawing\shd\dwg_BRC_Railroad_Pier-Elevation.dgn



USER NAME = jerojas	DESIGNED - JSR	REVISED -
	CHECKED - BPS	REVISED -
PLOT SCALE = N/A	DRAWN - JSR	REVISED -
PLOT DATE = 10/4/2013	CHECKED - BPS	REVISED -

**STATE OF ILLINOIS
DEPARTMENT OF TRANSPORTATION**

**ATTACHMENT F - SUBSTRUCTURE CONDITION SURVEY
STRUCTURE NO. 016-0019**

SHEET NO. 3 OF 3 SHEETS

F.A.I. RTE.	SECTION	COUNTY	TOTAL SHEETS	SHEET NO.
55	1212-620-VB	COOK		
CONTRACT NO.				
FED. ROAD DIST. NO. 1 ILLINOIS FED. AID PROJECT				

ATTACHMENT G

Opinion of Probable Costs

Sheet: _____ of _____
 Calc By: JSR Date: 10/4/13
 Check By: BHS Date: 12/19/13
 Project Number: 178600037
 Subject: OPINION OF PROBABLE COST
I-55 WB over BRC Railroad (016-0019)

ALTERNATIVE 1 - IN-KIND REPAIRS

QUANTITY CODE	QUANTITY DESCRIPTION	QUANTITY	UNIT COST	TOTAL COST
50300300	Protective Coat	1585 sy	\$2.00	\$3,170
50500105	Furnishing and Erecting Structural Steel	7940 lb	\$5.00	\$39,700
59000200	Epoxy Crack Injection	36 ft	\$150	\$5,400
Z0012754	Struct Repair of Concrete (Depth = < 5 Inches)	95 sf	\$175	\$16,630
Z0016001	Deck Slab Repair (Full Depth)	63 sy	\$750	\$47,250
Z0016200	Deck Slab Repair (Partial Depth)	138 sy	\$400	\$55,200
Z0048665	Railroad Protective Liability Insurance	1 LS	\$5,000	\$5,000
SUB TOTAL =				\$172,350
MOBILIZATION (10%) =				\$17,235
CONTINGENCY (20%) =				\$34,470
TOTAL =				\$224,100

ALTERNATIVE 2 - STRUCTURE WIDENING

QUANTITY CODE	QUANTITY DESCRIPTION	QUANTITY	UNIT COST	TOTAL COST
50102400	Concrete Removal	9 cy	\$600	\$5,160
50104720	Removal of Existing Concrete Deck	1 LS	\$169,000	\$169,000
50200100	Structure Excavation	209 cy	\$35.00	\$7,320
50300225	Concrete Structures	210 cy	\$700	\$147,000
50300255	Concrete Superstructure	770 cy	\$800	\$616,000
50300260	Bridge Deck Grooving	2336 sy	\$7.00	\$16,350
50300300	Protective Coat	1900 sy	\$2.00	\$3,800
50500105	Furnishing and Erecting Structural Steel	1 LS	\$285,600	\$285,600
50500505	Stud Shear Connectors	378 each	\$3.00	\$1,130
50800205	Reinforcement Bars, Epoxy Coated	234500 lbs	\$1.75	\$410,380
51201400	Fur Stl Pile HP10x42	3,280 ft	\$45.00	\$147,600
51203400	Test Pile Stl HP10x42	4 each	\$2,000	\$8,000
52000110	Preformed Joint Strip Seal	428 ft	\$175	\$74,900
52100010	Elastomeric Bearing Assembly, Type I	3 each	\$800	\$2,400
59000200	Epoxy Crack Injection	36 ft	\$150	\$5,400
59100100	Geocomposite Wall Drain	30 sy	\$25.00	\$750
X2070304	Porous Granular Embankment, Special	40 cy	\$50.00	\$2,000
Z0004552	Approach Slab Removal	270 sy	\$35.00	\$9,450
Z0012754	Struct Repair of Concrete (Depth = < 5 Inches)	95 sf	\$175	\$16,630
Z0026407	Temporary Sheet Piling	657 sf	\$30.00	\$19,700
Z0046304	Pipe Underdrains for Structures 4"	40 ft	\$20.00	\$800
Z0048665	Railroad Protective Liability Insurance	1 LS	\$5,000	\$5,000
SUB TOTAL =				\$1,954,370
MOBILIZATION (10%) =				\$195,437
CONTINGENCY (20%) =				\$390,874
TOTAL =				\$2,540,700

Sheet: _____ of _____
 Calc By: JSR Date: 10/4/13
 Check By: BHS Date: 12/19/13
 Project Number: 178600037
 Subject: OPINION OF PROBABLE COST
I-55 WB over BRC Railroad (016-0019)


ALTERNATIVE 3 - SUPERSTRUCTURE AND PARTIAL SUBSTRUCTURE REPLACEMENT

CODE	QUANTITY DESCRIPTION	QUANTITY	UNIT COST	TOTAL COST
50101500	Removal of Existing Superstructures	1 LS	\$203,000	\$203,000
50102400	Concrete Removal	271 cy	\$600	\$162,600
50104650	Slope Wall Removal	1530 sy	\$7.00	\$10,710
50200100	Structure Excavation	653 cy	\$35.00	\$22,870
50300225	Concrete Structures	325 cy	\$700	\$227,500
50300255	Concrete Superstructure	900 cy	\$800	\$720,000
50300260	Bridge Deck Grooving	2492 sy	\$7.00	\$17,440
50300300	Protective Coat	2122 sy	\$2.00	\$4,240
50500105	Furnishing and Erecting Structural Steel	1 LS	\$1,126,000	\$1,126,000
50500505	Stud Shear Connectors	9180 each	\$3.00	\$27,540
50800205	Reinforcement Bars, Epoxy Coated	290000 lbs	\$1.75	\$507,500
51100100	Slope Wall 4 Inch	1386 sy	\$100	\$138,600
51201400	Fur Stl Pile HP10x42	4540 ft	\$45.00	\$204,300
51203400	Test Pile Stl HP10x42	4 each	\$2,000	\$8,000
52100010	Elastomeric Bearing Assembly, Type I	17 each	\$800	\$13,600
59100100	Geocomposite Wall Drain	154 sy	\$25.00	\$3,850
X2070304	Porous Granular Embankment, Special	262 cy	\$50.00	\$13,100
Z0004552	Approach Slab Removal	270 sy	\$35.00	\$9,450
Z0012754	Structural Repair of Concrete (< 5 Inches)	5 sf	\$350	\$1,580
Z0026407	Temporary Sheet Piling	1597 sf	\$30.00	\$47,910
Z0046304	Pipe Underdrains for Structures 4"	226 ft	\$20.00	\$4,520
Z0048665	Railroad Protective Liability Insurance	1 LS	\$5,000	\$5,000
SUB TOTAL =				\$3,479,310
MOBILIZATION (10%) =				\$347,931
CONTINGENCY (20%) =				\$695,862
TOTAL =				\$4,523,200

ALTERNATIVE 4 - STRUCTURE REPLACEMENT


QUANTITY CODE	QUANTITY DESCRIPTION	QUANTITY	UNIT COST	TOTAL COST
50100100	Removal of Existing Structures	1 LS	\$550,000	\$550,000
50104650	Slope Wall Removal	1530 sy	\$7.00	\$10,710
50200100	Structure Excavation	1159 cy	\$35.00	\$40,570
50300225	Concrete Structures	672 cy	\$700	\$470,400
50300255	Concrete Superstructure	900 cy	\$800	\$720,000
50300260	Bridge Deck Grooving	2492 sy	\$7.00	\$17,440
50300300	Protective Coat	2122 sy	\$2.00	\$4,240
50500105	Furnishing and Erecting Structural Steel	1 LS	\$1,126,000	\$1,126,000
50500505	Stud Shear Connectors	9180 each	\$3.00	\$27,540
50800205	Reinforcement Bars, Epoxy Coated	359400 lbs	\$1.75	\$628,950
51100100	Slope Wall 4 Inch	1386 sy	\$100	\$138,600
51201400	Fur Stl Pile HP10x42	9,580 ft	\$45.00	\$431,100
51203400	Test Pile Stl HP10x42	4 each	\$2,000	\$8,000
59100100	Geocomposite Wall Drain	154 sy	\$25.00	\$3,850
X2070304	Porous Granular Embankment, Special	262 cy	\$50.00	\$13,100
Z0026407	Temporary Sheet Piling	3942 sf	\$30.00	\$118,260
Z0046304	Pipe Underdrains for Structures 4"	226 ft	\$20.00	\$4,520
Z0048665	Railroad Protective Liability Insurance	1 LS	\$5,000	\$5,000
SUB TOTAL =				\$4,318,280
MOBILIZATION (10%) =				\$431,828
CONTINGENCY (20%) =				\$863,656
TOTAL =				\$5,613,800

ATTACHMENT H
Proposed Structure Drawings

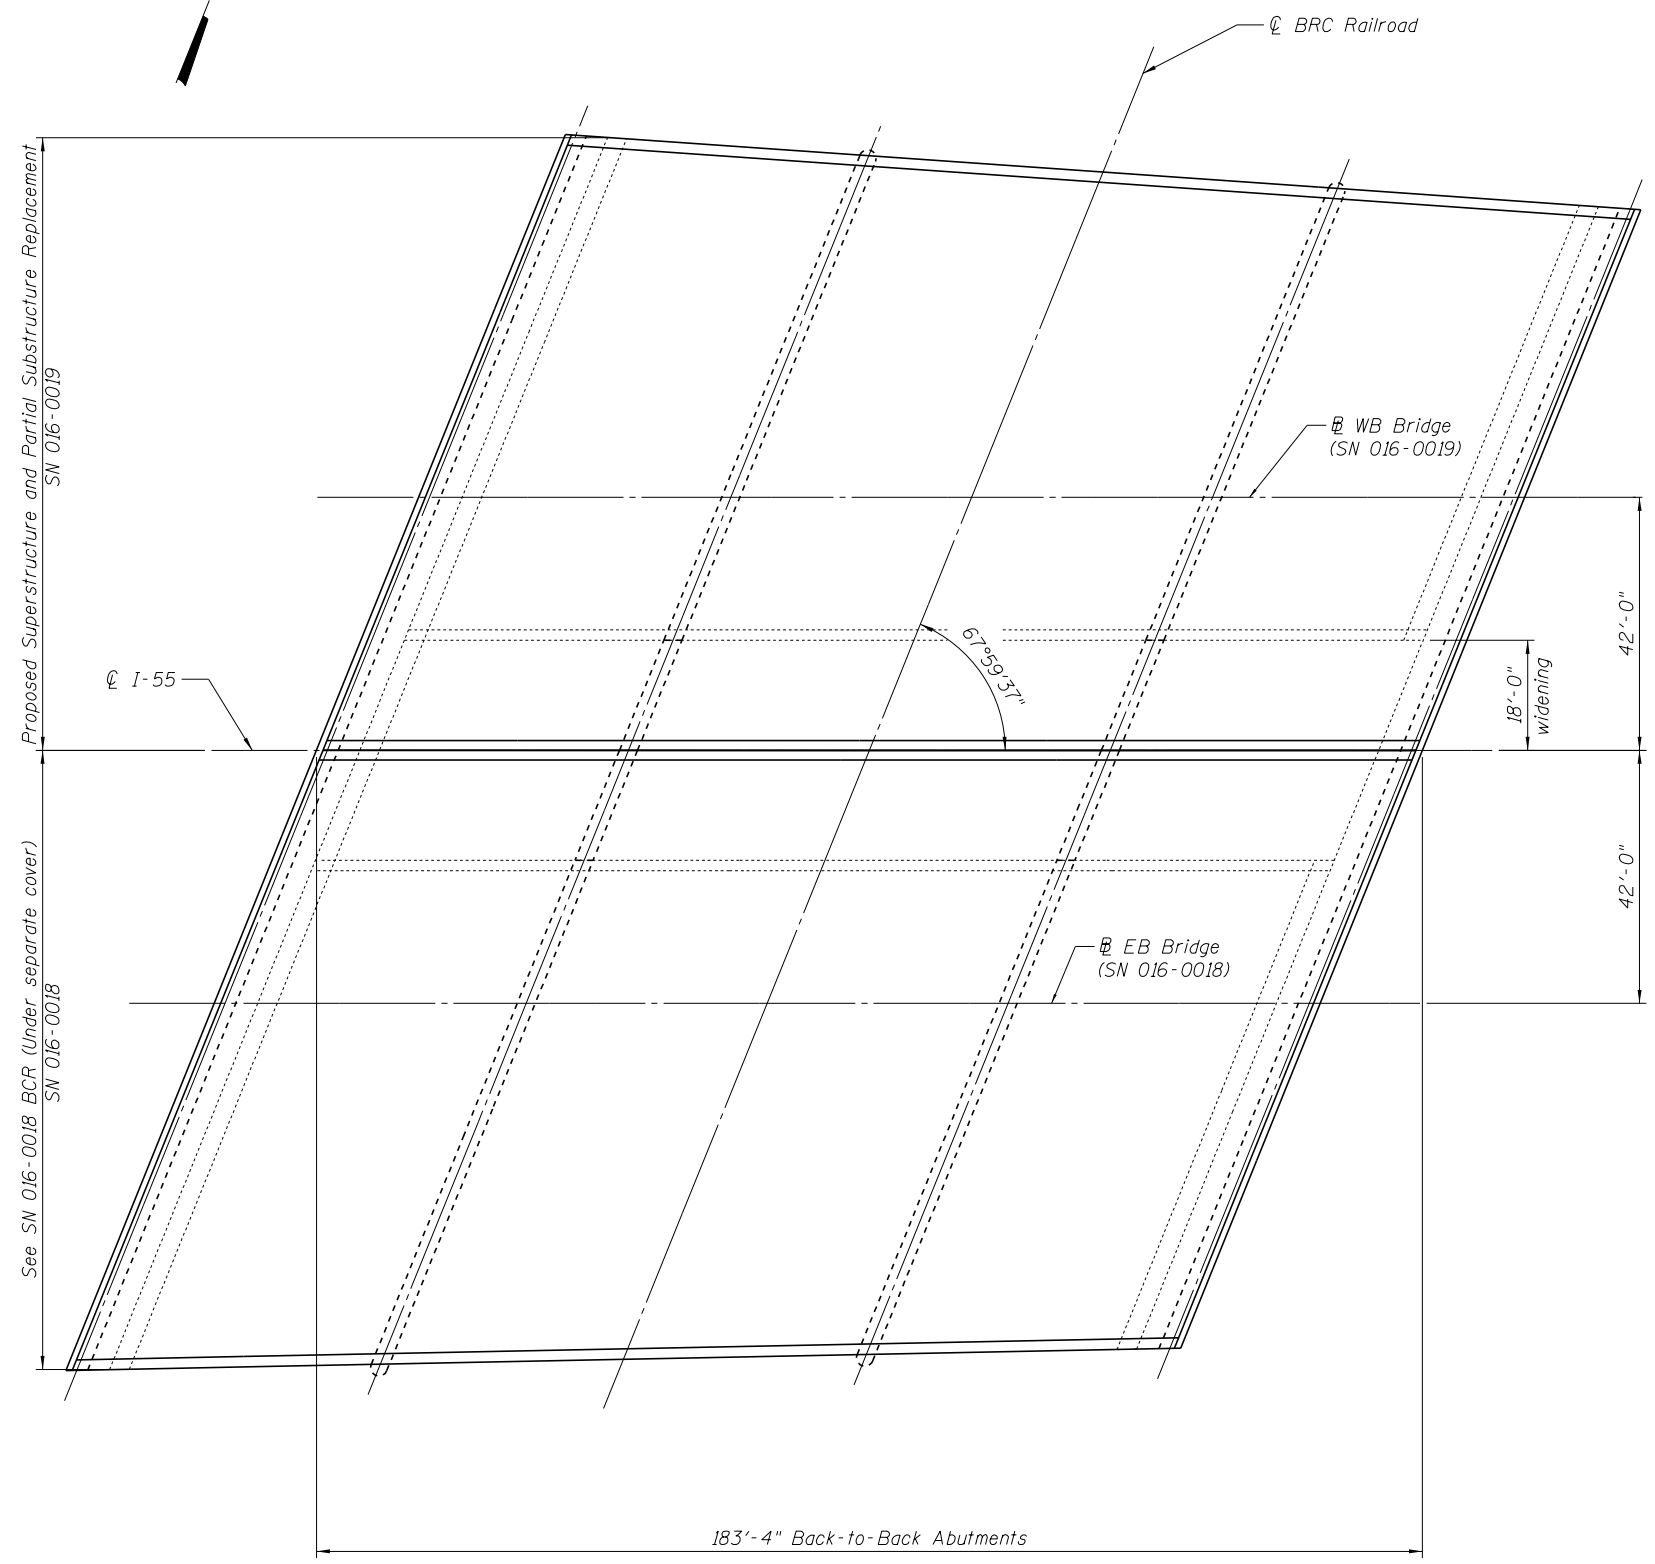

PROPOSED PLAN

Notes:
 The number and location of substructure units, the profile grade, skew angle, and the bridge length and width are subject to refinement in the TSL phase.
 Superstructure type, beam spacing, and rail type to be determined during the TSL phase.

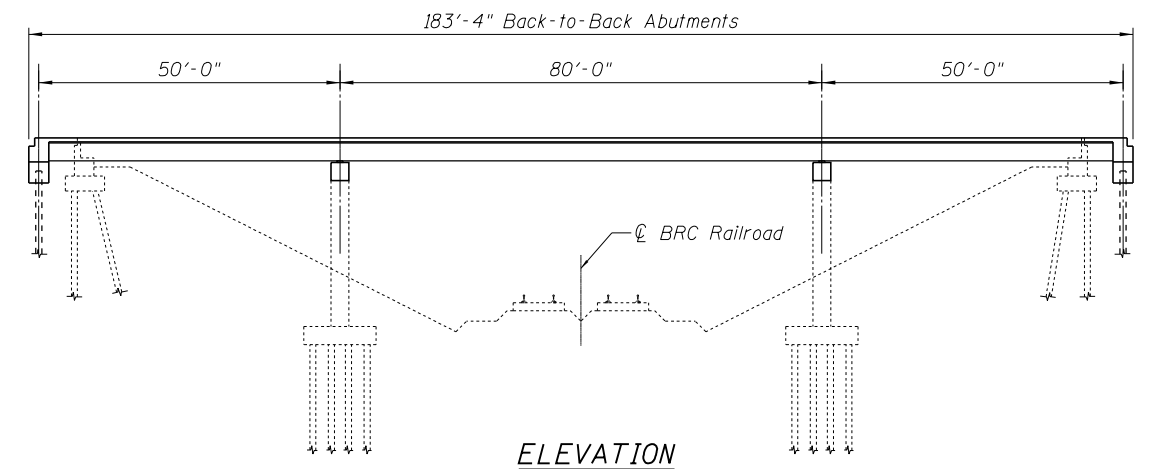

ELEVATION

FILE NAME = V:\1786\active\178600037_IDOT_I-55\structural\drawing\shd\dwg_BRC_Railroad_Deck_Plan.dgn



USER NAME = bsogers	DESIGNED - JSR	REVISED - _____
	CHECKED - BPS	REVISED - _____
PLOT SCALE = N/A	DRAWN - JSR	REVISED - _____
PLOT DATE = 12/17/2013	CHECKED - BPS	REVISED - _____

**STATE OF ILLINOIS
 DEPARTMENT OF TRANSPORTATION**

**ATTACHMENT H - PROPOSED STRUCTURE DRAWINGS
 STRUCTURE NO. 016-0019**

SHEET NO. 1 OF 1 SHEETS

F.A.I. RTE. 55	SECTION 1212-620-VB	COUNTY COOK	TOTAL SHEETS _____	SHEET NO. _____
CONTRACT NO.				
FED. ROAD DIST. NO. 1 ILLINOIS FED. AID PROJECT				

ATTACHMENT I
Structure Photos



Photo 1 - Underside of Span 2, looking west



Photo 2 - Underside of Span 3, looking east



Photo 3 - Deteriorated concrete in Span 1, looking west



Photo 4 – Top of Deck in Span 1, looking south



Photo 5 – Top of Deck, Span 1, looking south



Photo 6 – Top of Deck Span 1, looking southwest



Photo 7 - North parapet in Span 1, looking west



Photo 8 - South parapet in Span 3, looking northwest

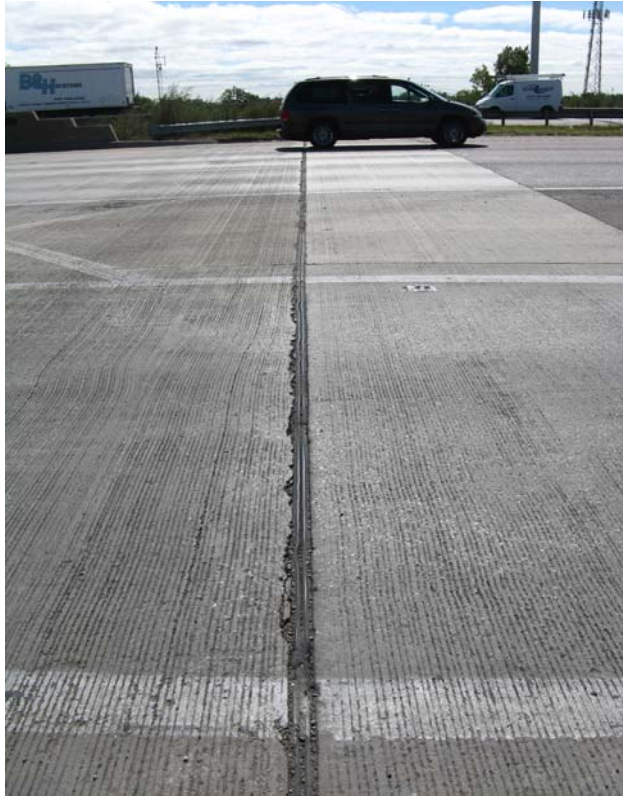


Photo 9 - Typical joint at approach slab (West Approach shown), looking south



Photo 10 - West Abutment joint, looking south



Photo 11 – Pier 1 joint, looking south



Photo 12 – Pier 2 joint, looking south



Photo 13 - East Abutment joint, looking south



Photo 14 - South fascia beam, looking northeast



Photo 15 - Bent guide plate at south fascia beam in Span 1, looking southeast



Photo 16 - Underside of Span 2 Beams, looking east



Photo 17 - North fascia, looking southeast



Photo 18 – Span South fascia, looking north



Photo 19 - Typical bearing at East Abutment, looking southeast



Photo 20 - Broken conduit on south side of Span 3, looking south



Photo 21 - Broken brackets on conduit, looking south



Photo 22 - East Abutment, looking southeast



Photo 23 - West Abutment, looking northwest



Photo 24 - Pier 1, looking west



Photo 25 – Pier 2, looking east





Photo 26 - Underside and face of Pier 1, looking east



Photo 27 - Crack at Span 1 sloped wall, looking northwest

ATTACHMENT J
Proposed Plan & Profile

FILE NAME = V:\1786\active\178600037_1DOT_1-55\civil\drawing\mod\1786210-1-55_BRC_RR_Bridge_Plan_and_Profile.dgn

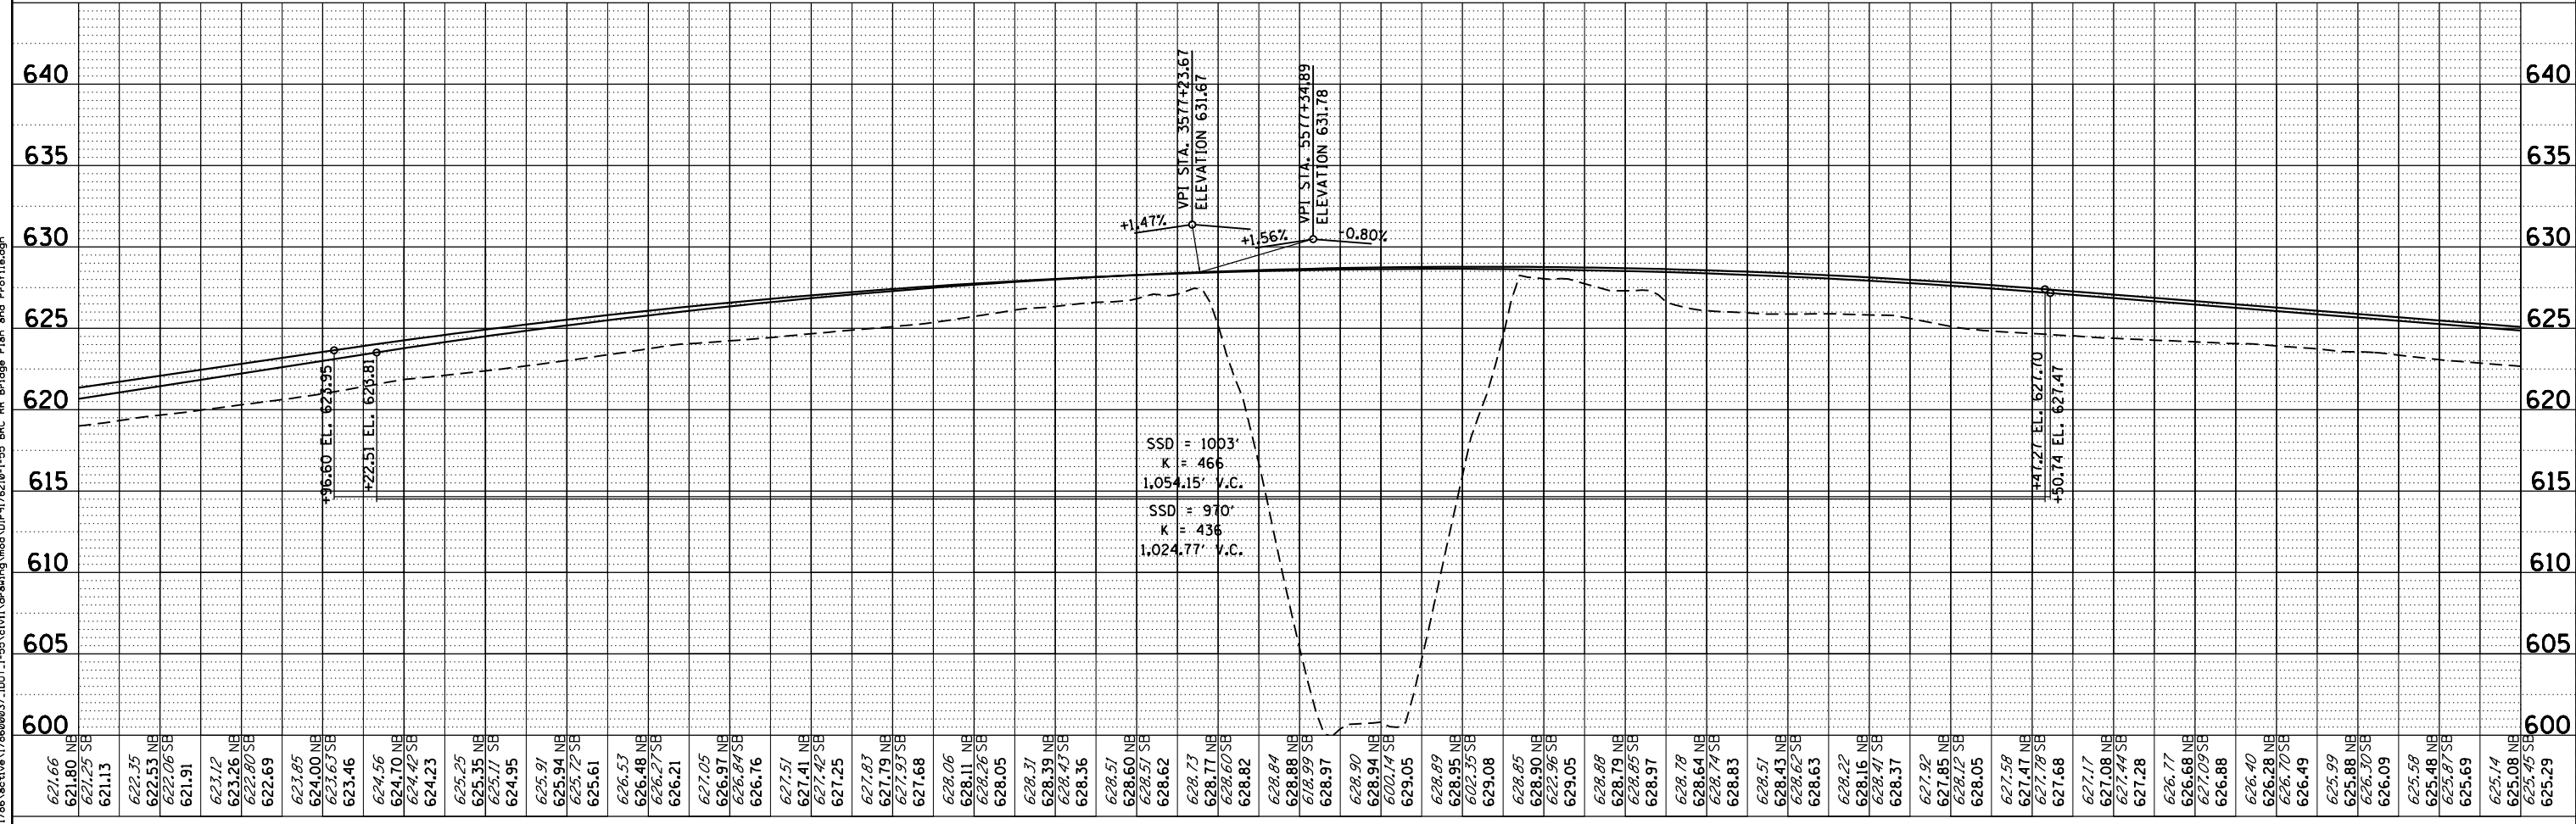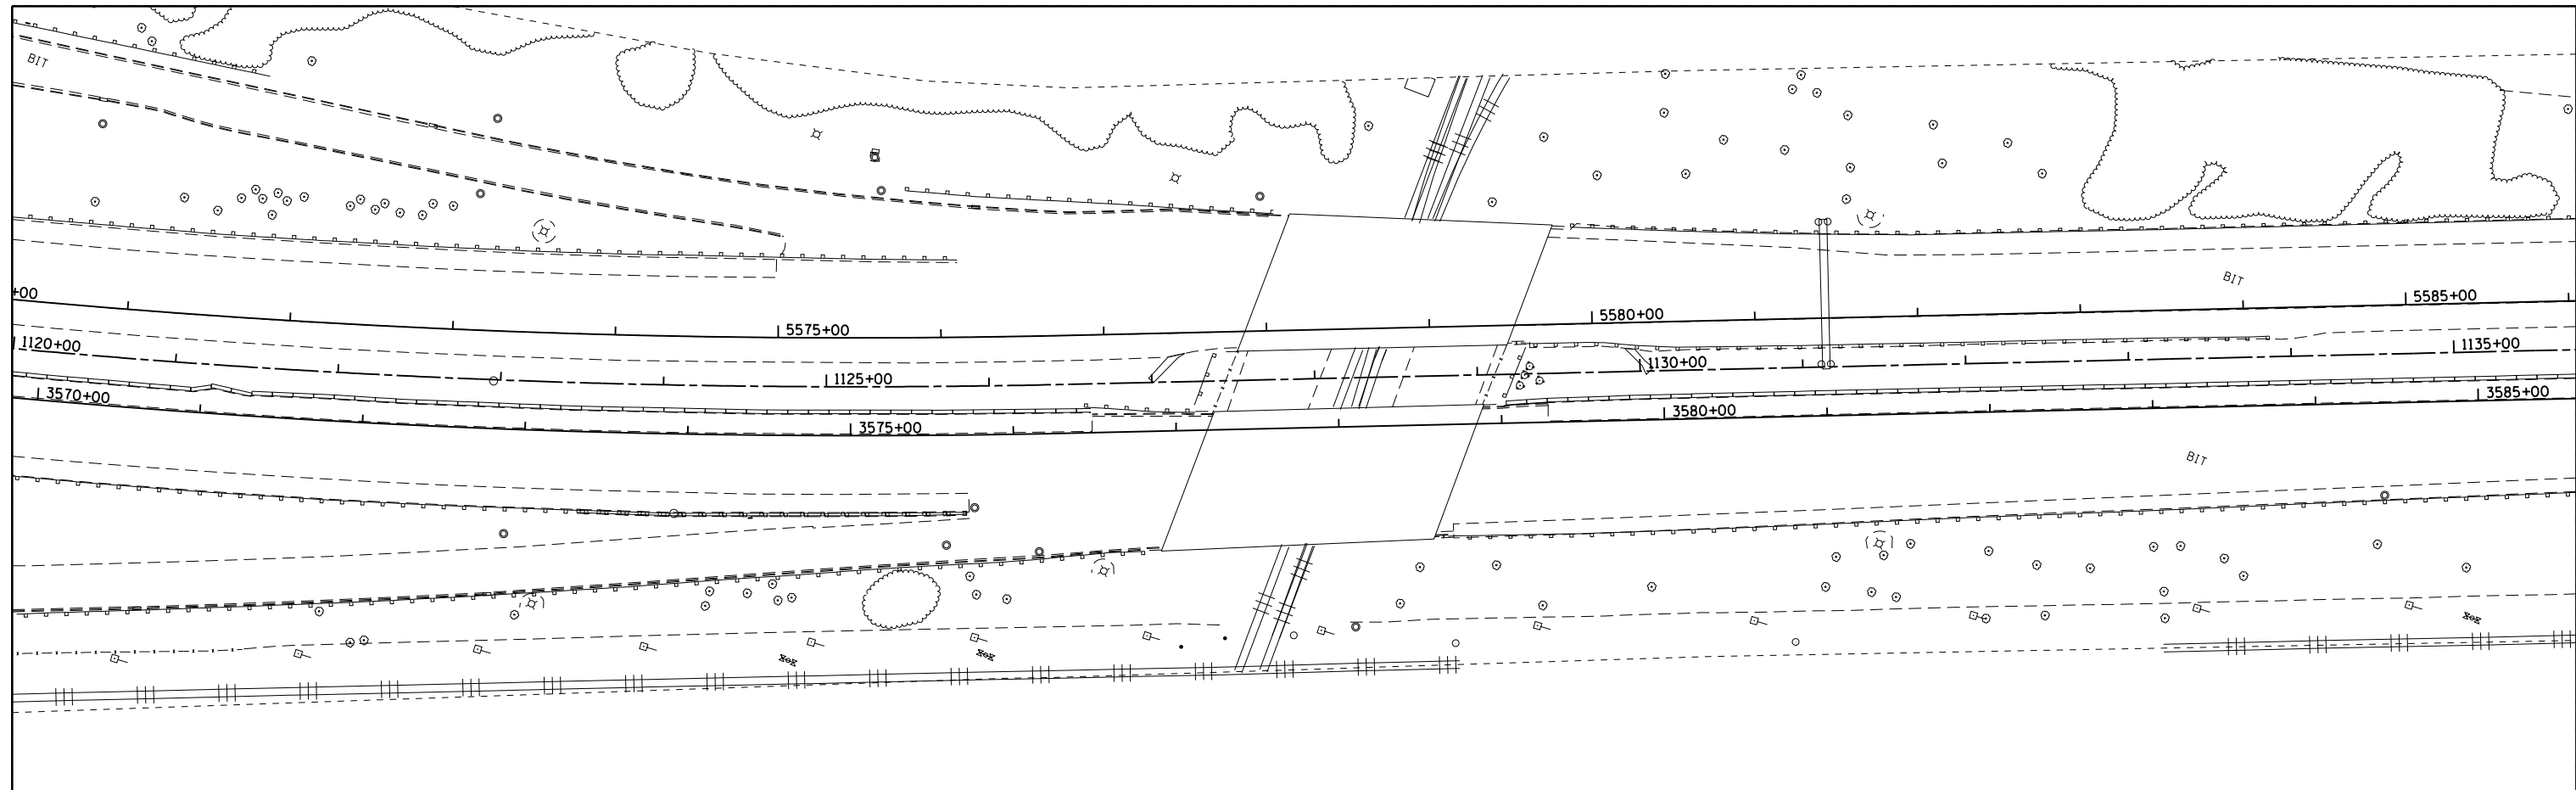

USER NAME = m.j.verhagen	DESIGNED - MJV	REVISED -
PLOT SCALE = 100.0000' / 1"	DRAWN - STANTEC	REVISED -
PLOT DATE = 10/4/2013	CHECKED -	REVISED -
	DATE - 10/04/2013	REVISED -


**STATE OF ILLINOIS
DEPARTMENT OF TRANSPORTATION**

ATTACHMENT J	
I-55 OVER BRC RAILROAD PROPOSED PLAN & PROFILE	
SCALE: 1"=100'	SHEET ___ OF ___ SHEETS STA. _____ TO STA. _____


F.A.I. RTE. 55	SECTION	COUNTY COOK	TOTAL SHEETS	SHEET NO.
CONTRACT NO.				
ILLINOIS FED. AID PROJECT				

ATTACHMENT K

**Existing and Proposed Roadway Cross
Sections**

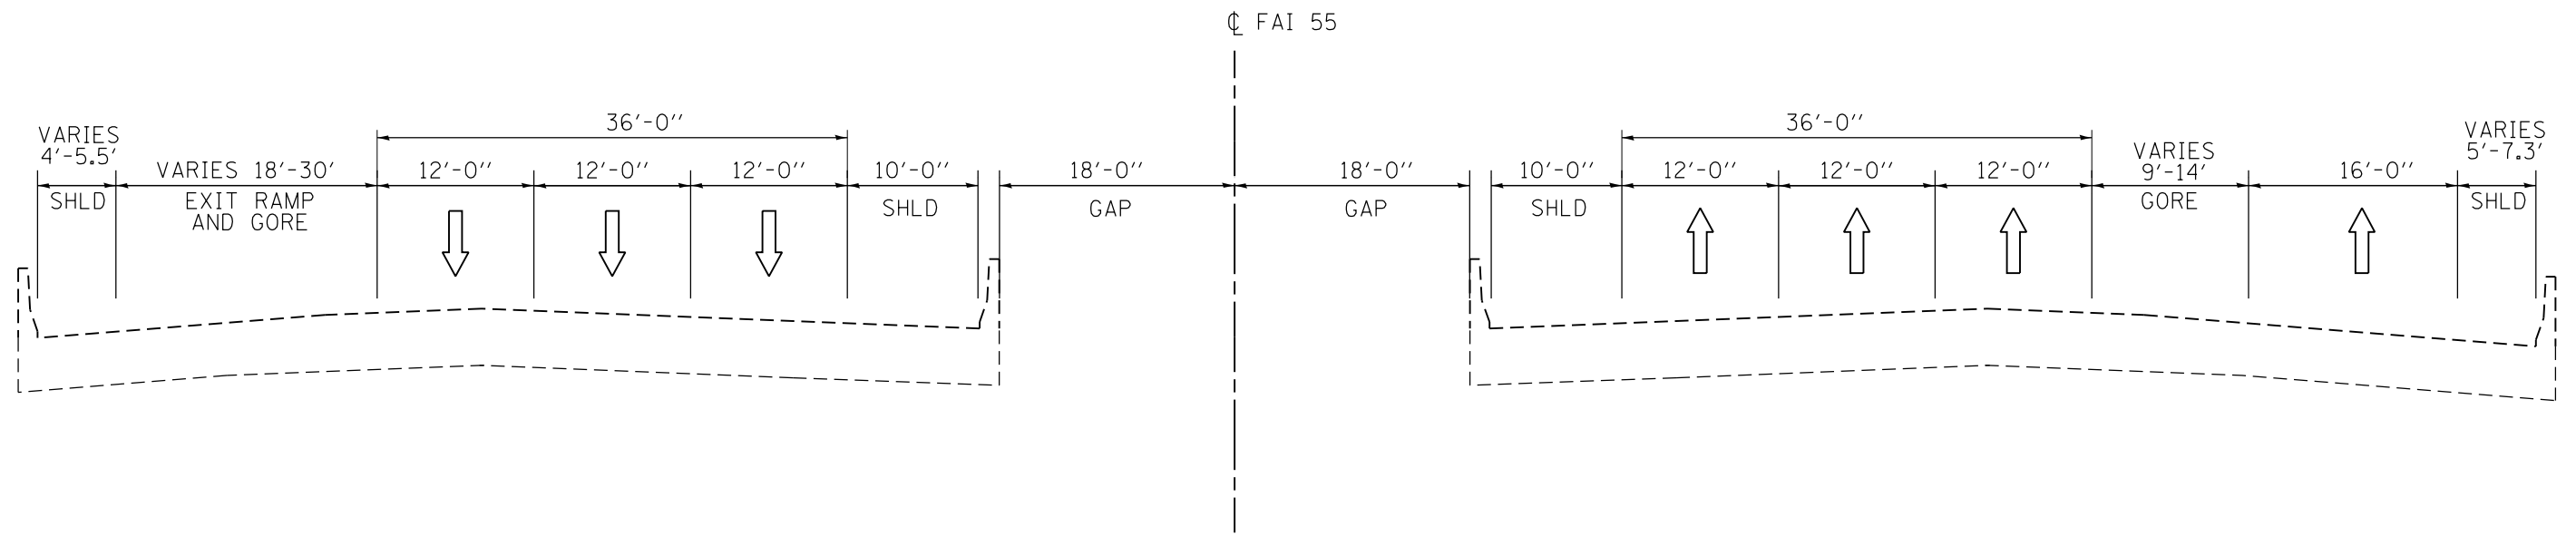

EXISTING I-55 OVER BRC RR TYPICAL SECTION

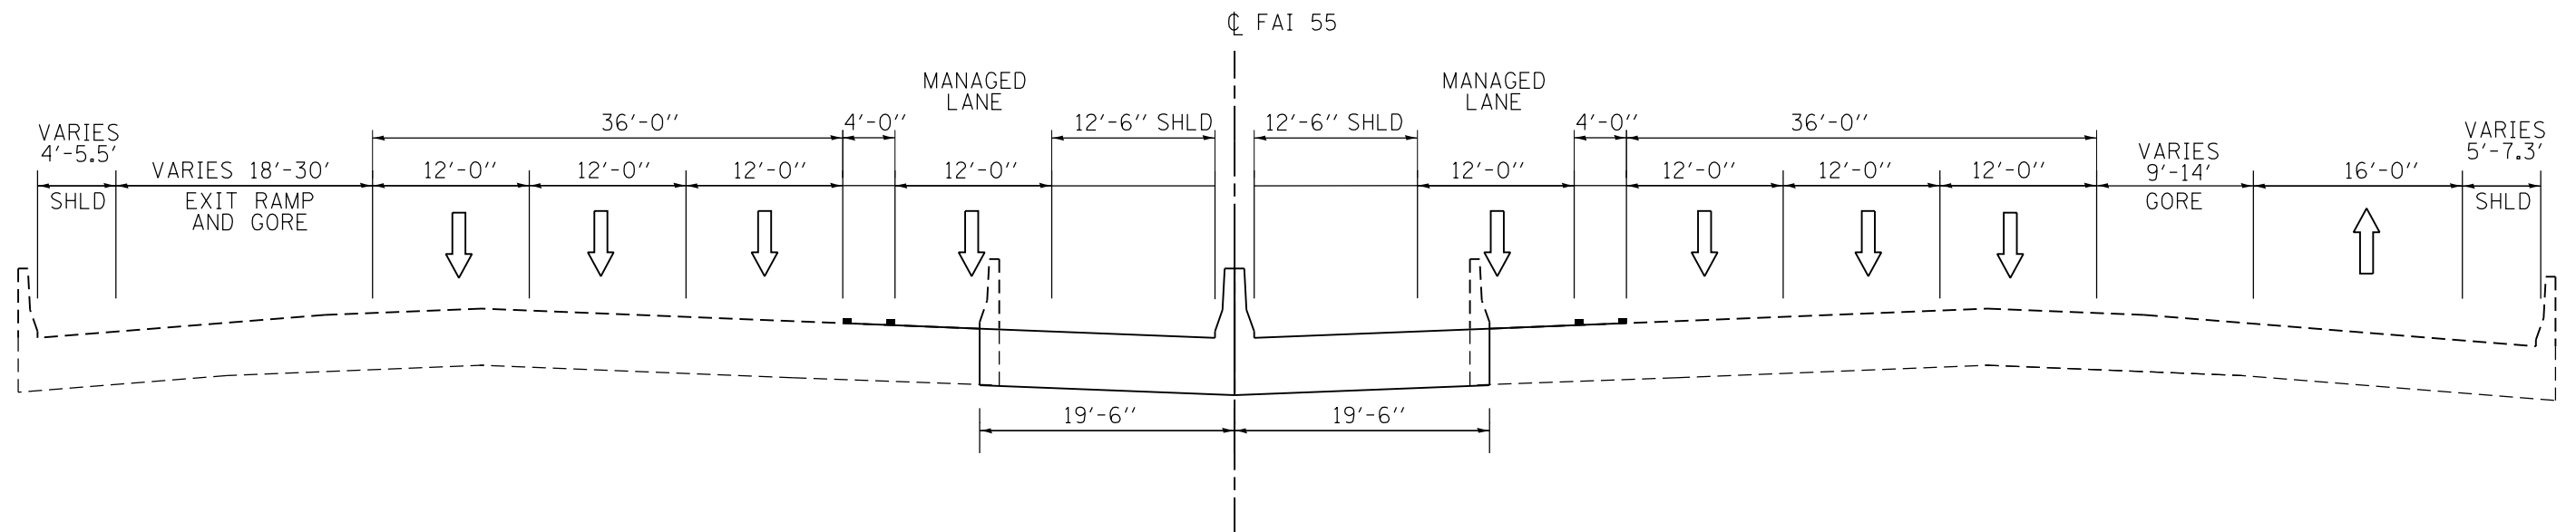

PROPOSED I-55 OVER BRC RR TYPICAL SECTION

FILE NAME = V:\1786\active\1786\0037_1001_1-55\sv1\drawing\mod\1786\typicals\sheets\Cicero Ave and RR Structure.dgn



USER NAME = mjverheyen	DESIGNED - MJV	REVISED -
PLOT SCALE = 13,3300' / in.	DRAWN - STANTEC	REVISED -
PLOT DATE = 10/4/2013	CHECKED -	REVISED -
	DATE - 10/4/2013	REVISED -

STATE OF ILLINOIS
DEPARTMENT OF TRANSPORTATION

ATTACHMENT K TYPICAL SECTIONS	
SCALE:	SHEET 2 OF 2 SHEETS STA. TO STA.

F.A.I. RTE.	SECTION	COUNTY	TOTAL SHEETS	SHEET NO.
55		COOK		
CONTRACT NO.				
ILLINOIS FED. AID PROJECT				


ATTACHMENT L

Abbreviated Existing Plans

FEDERAL AID ROUTE NO.	SECTION	EXPRESSWAYS	TOTAL SHEETS	SHEET NO.

Note:
Bulkheads required to retain earth at fascia girder bearings for existing R.R. Bridge are not a part of these plans.

Creosoted Piles, 15 Ton capacity, for approach slabs. Do not drive approach piles below elev. 627.0. Final cutoff to be by others. (Typical) Est. Length of Piles 30'

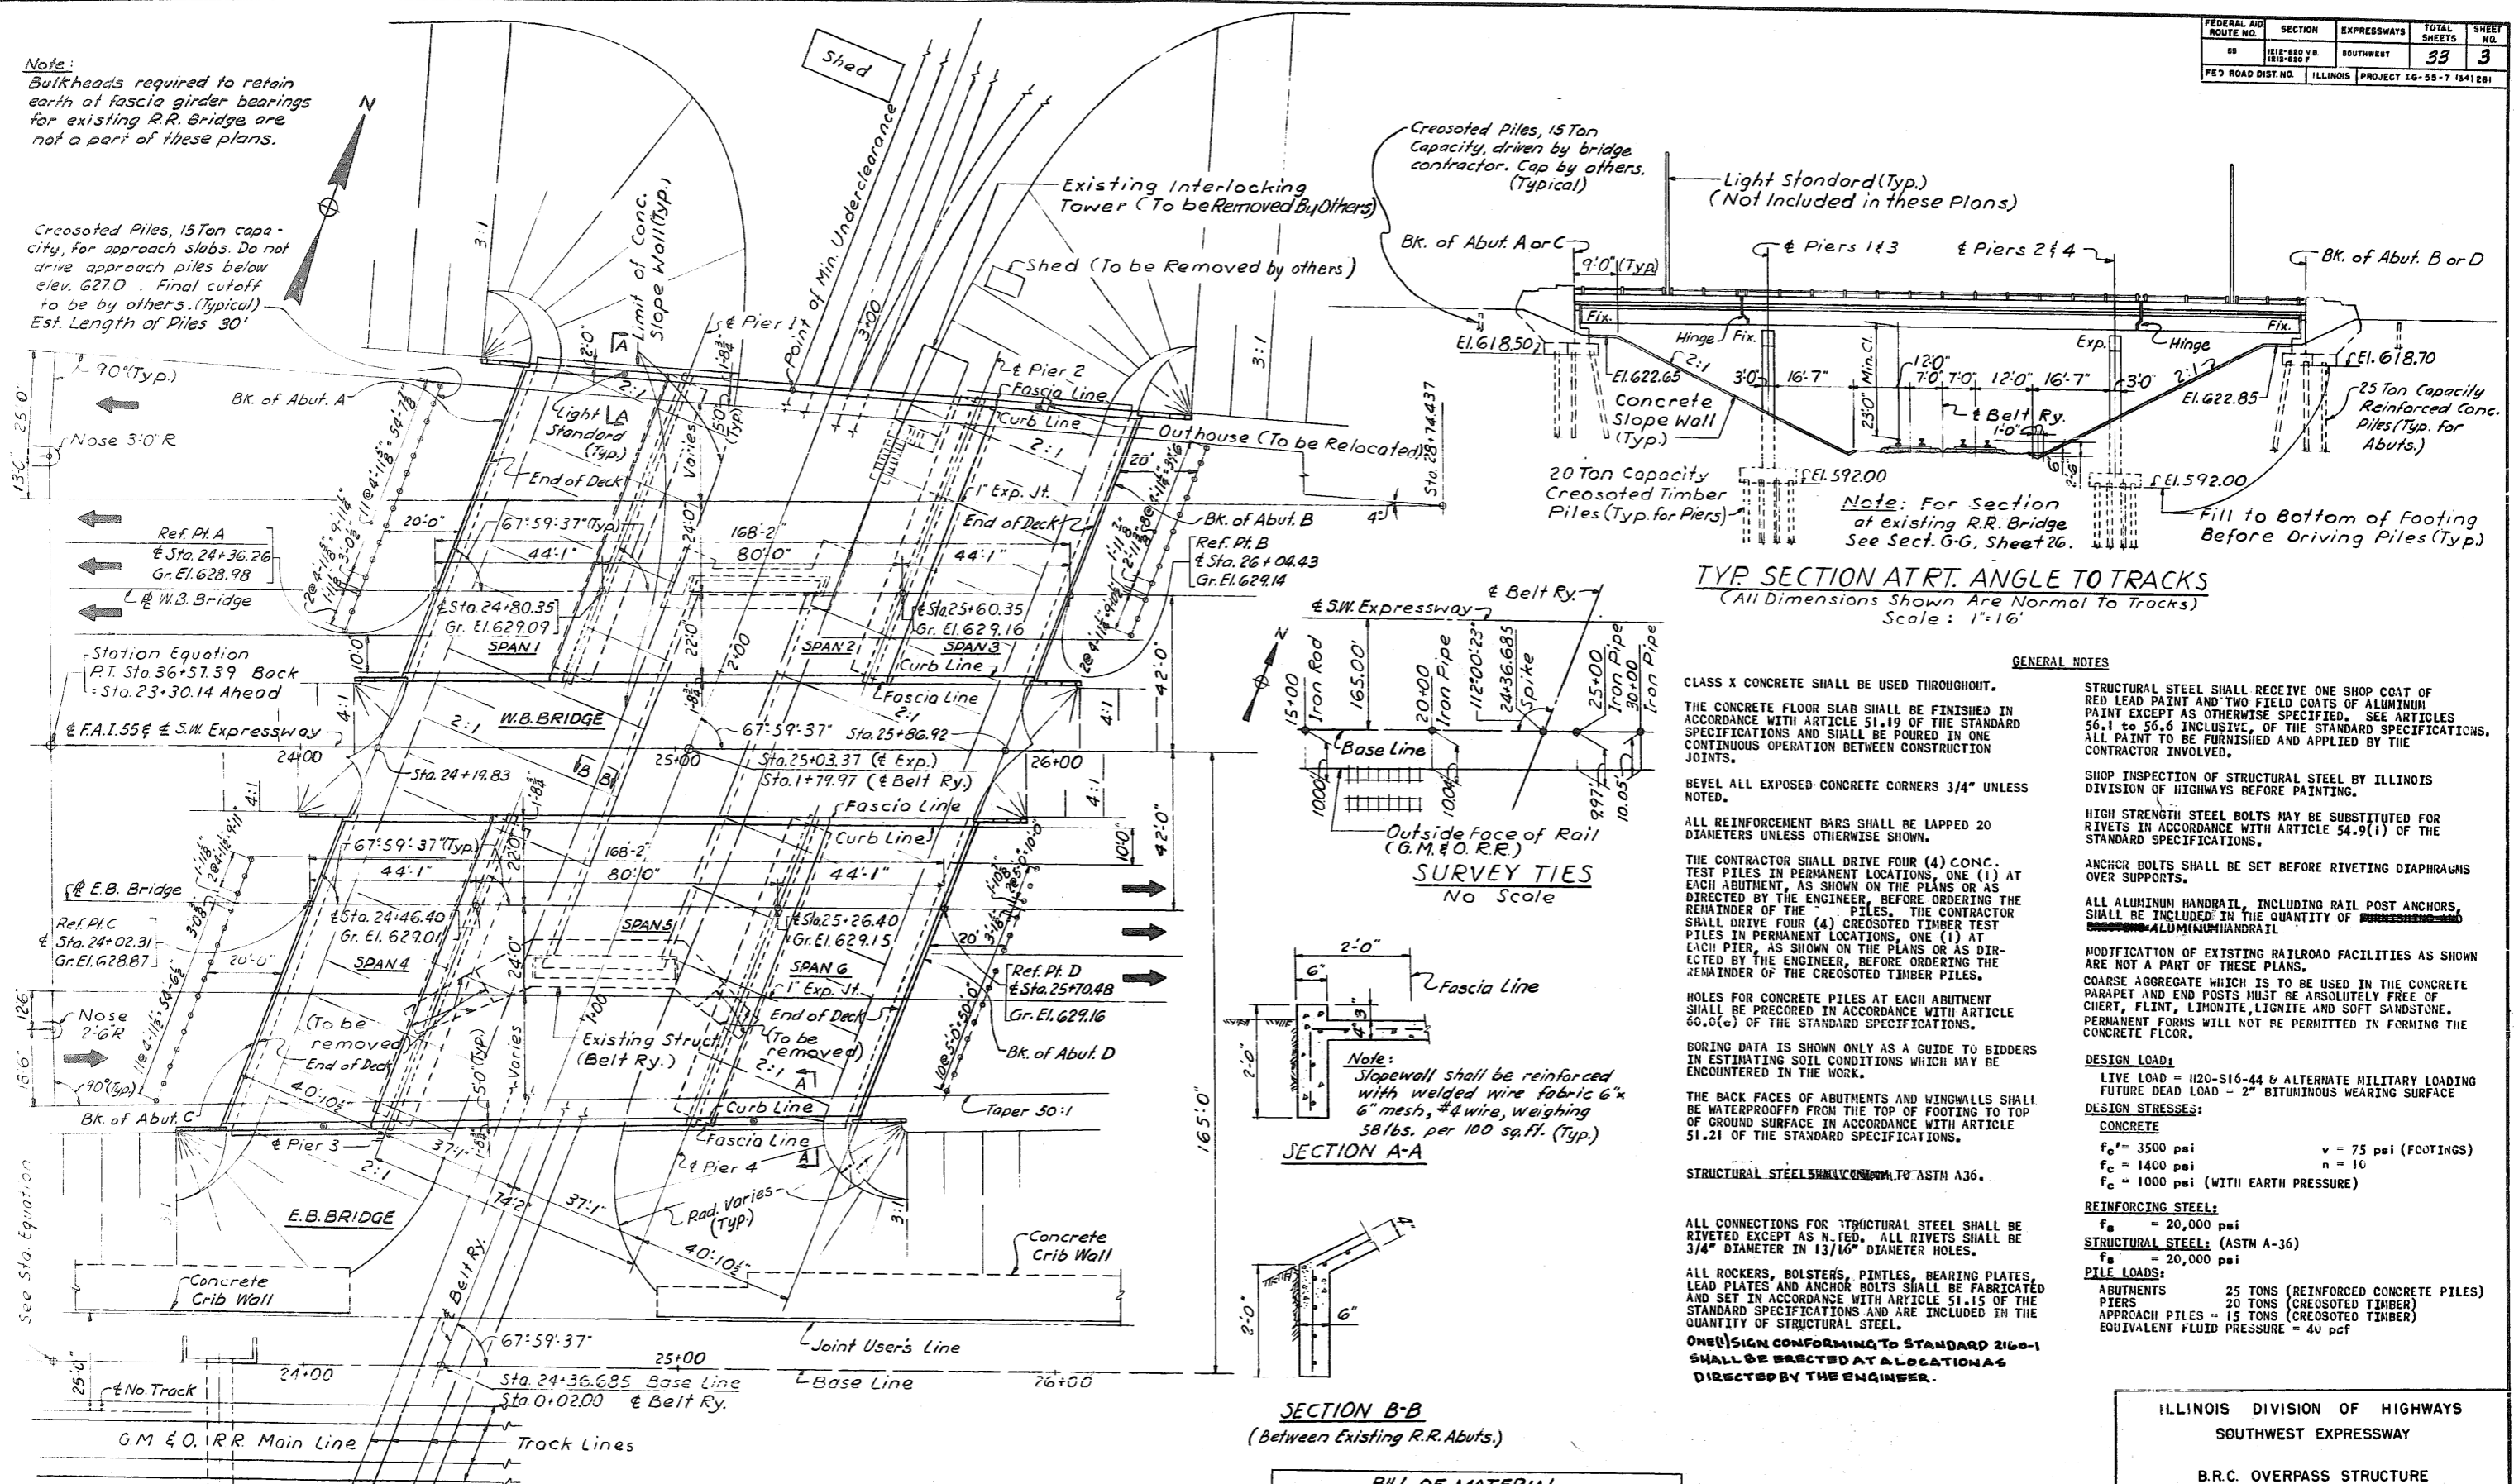

TYP. SECTION AT RT. ANGLE TO TRACKS
(All Dimensions Shown Are Normal To Tracks)
Scale: 1"=16'

GENERAL NOTES

- CLASS X CONCRETE SHALL BE USED THROUGHOUT.
- THE CONCRETE FLOOR SLAB SHALL BE FINISHED IN ACCORDANCE WITH ARTICLE 51.19 OF THE STANDARD SPECIFICATIONS AND SHALL BE POURED IN ONE CONTINUOUS OPERATION BETWEEN CONSTRUCTION JOINTS.
- BEVEL ALL EXPOSED CONCRETE CORNERS 3/4" UNLESS NOTED.
- ALL REINFORCEMENT BARS SHALL BE LAPPED 20 DIAMETERS UNLESS OTHERWISE SHOWN.
- THE CONTRACTOR SHALL DRIVE FOUR (4) CONC. TEST PILES IN PERMANENT LOCATIONS, ONE (1) AT EACH ABUTMENT, AS SHOWN ON THE PLANS OR AS DIRECTED BY THE ENGINEER, BEFORE ORDERING THE REMAINDER OF THE PILES. THE CONTRACTOR SHALL DRIVE FOUR (4) CREOSOTED TIMBER TEST PILES IN PERMANENT LOCATIONS, ONE (1) AT EACH PIER, AS SHOWN ON THE PLANS OR AS DIRECTED BY THE ENGINEER, BEFORE ORDERING THE REMAINDER OF THE CREOSOTED TIMBER PILES.
- HOLES FOR CONCRETE PILES AT EACH ABUTMENT SHALL BE PRECURED IN ACCORDANCE WITH ARTICLE 60.0(c) OF THE STANDARD SPECIFICATIONS.
- BORING DATA IS SHOWN ONLY AS A GUIDE TO BIDDERS IN ESTIMATING SOIL CONDITIONS WHICH MAY BE ENCOUNTERED IN THE WORK.
- THE BACK FACES OF ABUTMENTS AND WINGWALLS SHALL BE WATERPROOFED FROM THE TOP OF FOOTING TO TOP OF GROUND SURFACE IN ACCORDANCE WITH ARTICLE 51.21 OF THE STANDARD SPECIFICATIONS.
- STRUCTURAL STEEL SHALL CONFORM TO ASTM A36.
- ALL CONNECTIONS FOR STRUCTURAL STEEL SHALL BE RIVETED EXCEPT AS NOTED. ALL RIVETS SHALL BE 3/4" DIAMETER IN 13/16" DIAMETER HOLES.
- ALL ROCKERS, BOLSTERS, PINTLES, BEARING PLATES, LEAD PLATES AND ANCHOR BOLTS SHALL BE FABRICATED AND SET IN ACCORDANCE WITH ARTICLE 51.15 OF THE STANDARD SPECIFICATIONS AND ARE INCLUDED IN THE QUANTITY OF STRUCTURAL STEEL.
- ONE SIGN CONFORMING TO STANDARD 216-1 SHALL BE ERRECTED AT A LOCATION AS DIRECTED BY THE ENGINEER.
- STRUCTURAL STEEL SHALL RECEIVE ONE SHOP COAT OF RED LEAD PAINT AND TWO FELD COATS OF ALUMINUM PAINT EXCEPT AS OTHERWISE SPECIFIED. SEE ARTICLES 56.1 TO 56.6 INCLUSIVE, OF THE STANDARD SPECIFICATIONS. ALL PAINT TO BE FURNISHED AND APPLIED BY THE CONTRACTOR INVOLVED.
- SHOP INSPECTION OF STRUCTURAL STEEL BY ILLINOIS DIVISION OF HIGHWAYS BEFORE PAINTING.
- HIGH STRENGTH STEEL BOLTS MAY BE SUBSTITUTED FOR RIVETS IN ACCORDANCE WITH ARTICLE 54.9(i) OF THE STANDARD SPECIFICATIONS.
- ANCHOR BOLTS SHALL BE SET BEFORE RIVETING DIAPHRAGMS OVER SUPPORTS.
- ALL ALUMINUM HANDRAIL, INCLUDING RAIL POST ANCHORS, SHALL BE INCLUDED IN THE QUANTITY OF ~~BRASS~~ ALUMINUM HANDRAIL
- MODIFICATION OF EXISTING RAILROAD FACILITIES AS SHOWN ARE NOT A PART OF THESE PLANS.
- COARSE AGGREGATE WHICH IS TO BE USED IN THE CONCRETE PARAPET AND END POSTS MUST BE ABSOLUTELY FREE OF CHERT, FLINT, LIMONITE, LIGNITE AND SOFT SANDSTONE. PERMANENT FORMS WILL NOT BE PERMITTED IN FORMING THE CONCRETE FLOOR.
- DESIGN LOAD:**
LIVE LOAD = H20-S16-44 & ALTERNATE MILITARY LOADING
FUTURE DEAD LOAD = 2" BITUMINOUS WEARING SURFACE
- DESIGN STRESSES:**
CONCRETE
f_c' = 3500 psi v = 75 psi (FOOTINGS)
f_c = 1400 psi n = 10
f_c = 1000 psi (WITH EARTH PRESSURE)
- REINFORCING STEEL:**
f_s = 20,000 psi
STRUCTURAL STEEL: (ASTM A-36)
f_s = 20,000 psi
- PILE LOADS:**
ABUTMENTS 25 TONS (REINFORCED CONCRETE PILES)
PIERS 20 TONS (CREOSOTED TIMBER)
APPROACH PILES = 15 TONS (CREOSOTED TIMBER)
EQUIVALENT FLUID PRESSURE = 4u pcf

PLAN
Scale: 1"=20'




BILL OF MATERIAL

ITEM	UNIT	QUANTITY
Sloped wall, 4"	Sq. Yds.	3060
Creosoted Piles, 20 1/2 to 38 ft.	Lin. Ft.	1680

ILLINOIS DIVISION OF HIGHWAYS
SOUTHWEST EXPRESSWAY
B.R.C. OVERPASS STRUCTURE
GENERAL PLAN AND ELEVATION
SCALE: AS NOTED DATE: 9-13-63


Rev. 11-18-63: Deleted Creo. Piles up to 20' (240'), Added Creo. Piles 20 1/2 to 38' (1680'). M.C.K.

FEDERAL AID ROUTE NO.	SECTION	EXPRESSWAY	TOTAL SHEETS	SHEET NO.
STA.	TO STA.			
	FED. ROAD DIV. NO. 4 ILLINOIS PROJECT			

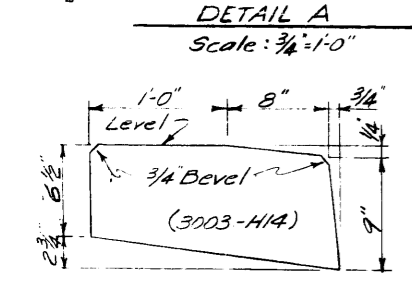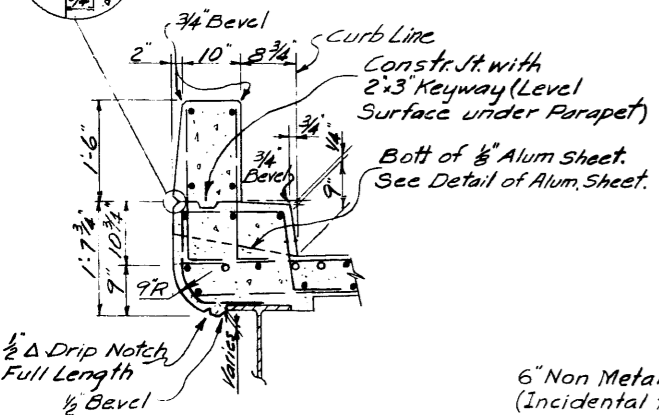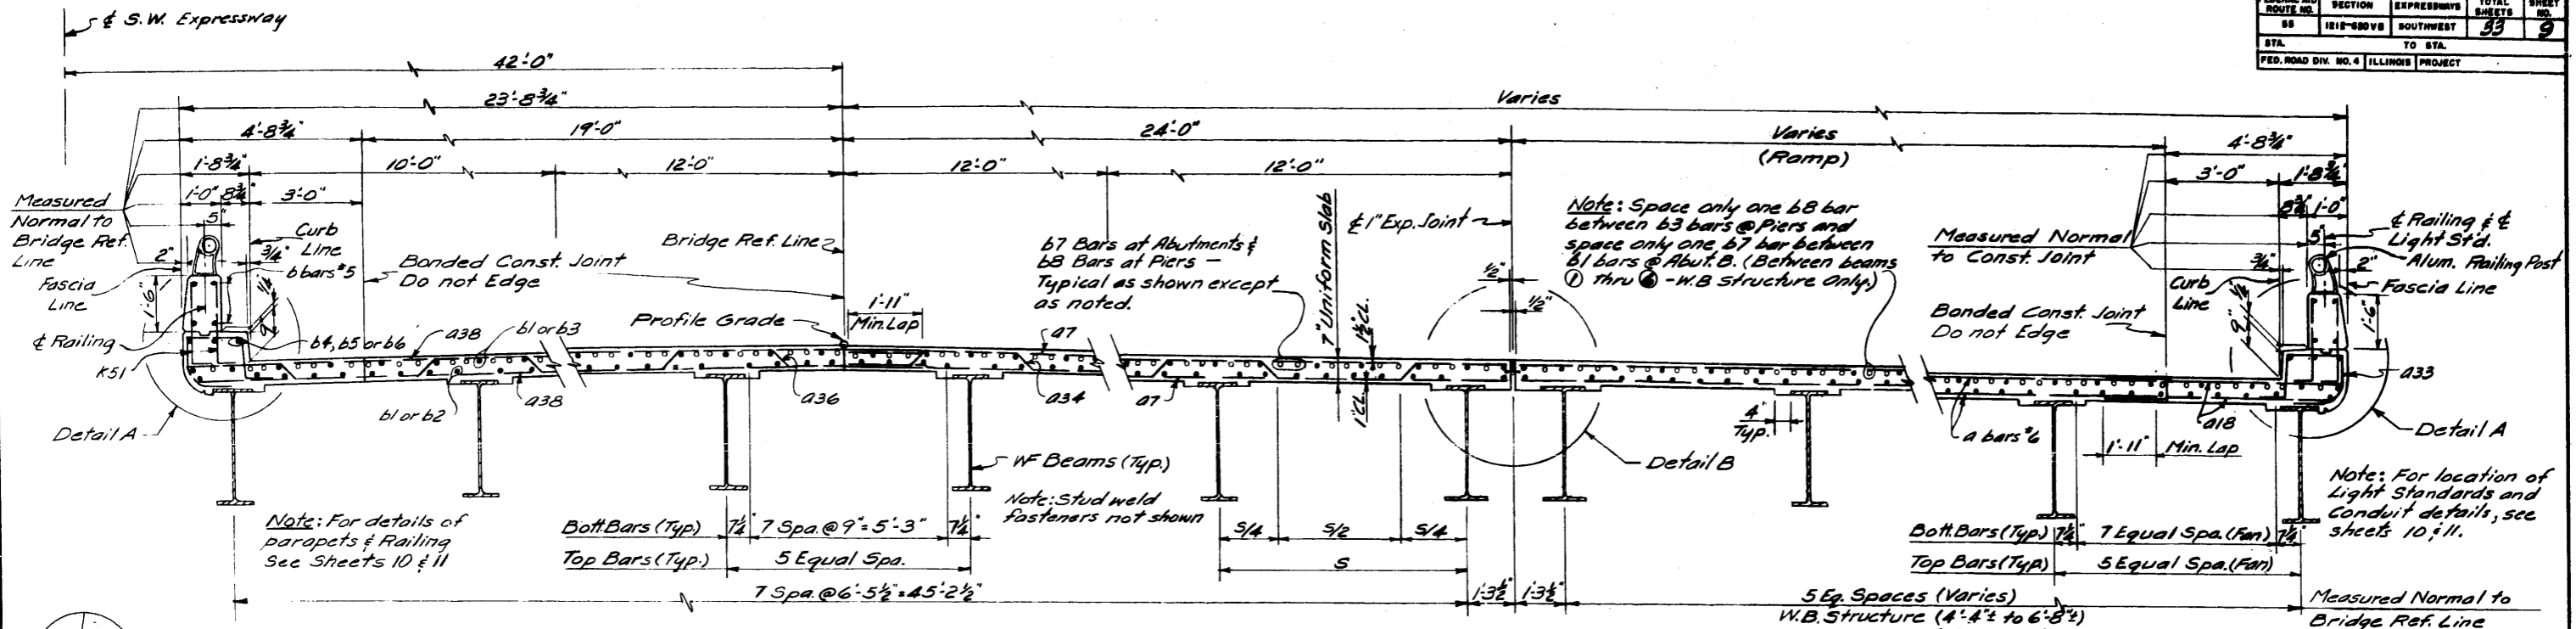


DETAIL OF 1/8" ALUMINUM SHEETS
Scale: 1 1/2" = 1'-0"


DECK CROSS SECTION
W.B. Structure Looking West
E.B. Structure Looking East
Scale: 1/2" = 1'-0"

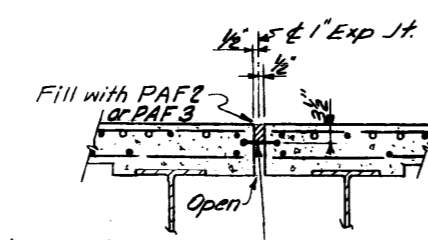

DETAIL B
Scale: 3/4" = 1'-0"


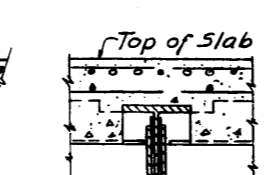


SECTION C-C
Scale: 3/4" = 1'-0"

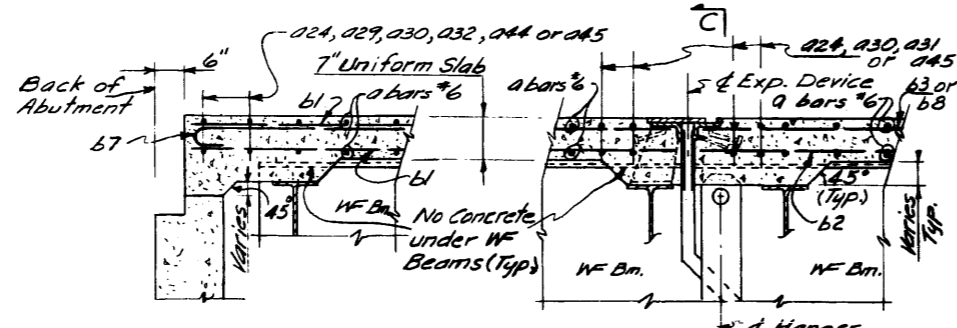

SECTION A-A
Scale: 3/4" = 1'-0"

SECTION B-B
Scale: 3/4" = 1'-0"

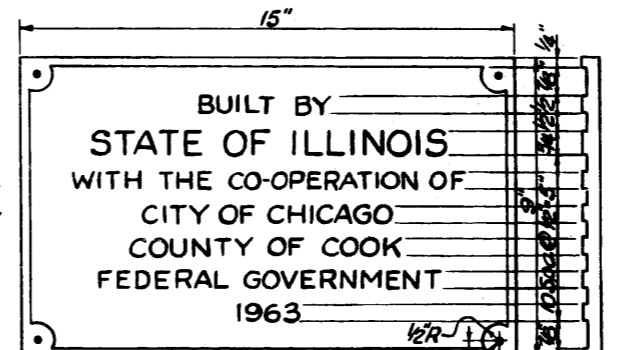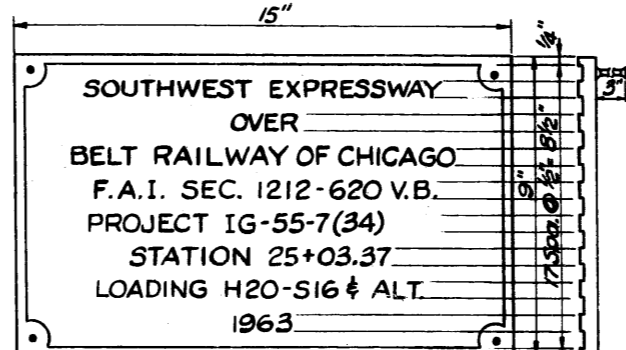

Center of Lug.
NAME PLATES
Notes for Name Plates: The material shall be best quality brass or bronze. Border and lettering shall be raised 1/8", square cut and not tapered. The top surface shall be polished and have a matted background.
The Contractor shall obtain approval of the Engineer before commencement of work and inscription.
Use two name plates, one of each type shown above, for each bridge located on the abutment wingwalls and as directed by the Engineer.

BILL OF MATERIAL			
Description	Unit	EQ.	W.B.
Class X Concrete	Cu. Yds.	358.1	338.4
Protective Coat	Sq. Yds.	1628	1532
Aluminum Handrail	Lin. Ft.	331	325
Reinforcement Bars	Lbs.	92,338	92,654
Conduit, 1 1/2" Dia. Galvanized Steel	Lin. Ft.	11	11
Conduit, 2" Dia. Galvanized Steel	Lin. Ft.	94	94
2" Asbestos Cement Conduit, Type 1	Lin. Ft.	251	245
Cast Iron Junction Boxes	Each	2	2
Name Plates	Each	2	2

ILLINOIS DIVISION OF HIGHWAYS
SOUTHWEST EXPRESSWAY
B.R.C. OVERPASS STRUCTURE
DECK DETAILS
SCALE: AS NOTED DATE: 9-13-63



October 27, 2015

MEMORANDUM

Mr. John Fortmann, Region One Engineer
Illinois Department of Transportation
Region One/District One

Attn: Steven Schilke

RE: Existing S.N. 016-0001
W.B. I-55 over E.B. Joliet Road
Cook County
PTB 158-002/P-91-762-10

The purpose of this technical memo is to summarize the current condition of existing S.N. 016-0001 in addition to geometrics and other factors. A cursory field check was performed to supplement the information contained in IDOT's structure summary report dated February 10, 2015 (see Appendix B). Broad-based recommendations for this structure are provided below.

The structure is a three span steel beam bridge consisting of nine lines of continuous beams (see Photo 1). Span lengths from west to east are $95'-5\frac{7}{16}"$, $84'-11\frac{15}{16}"$ and $87'-5\frac{3}{4}"$. The superstructure is supported by pile bent abutments and reinforced concrete multi-column piers. There is no overlay on the structure.

IDOT rates the deck as being in good condition, which concurs with the findings from the cursory field check. Minor transverse cracks with leaching are visible on a majority of the soffit (see Photo 2). IDOT rates the superstructure as being in good condition, which concurs with the findings from the cursory field check. Minor paint peeling and rusting is visible on bottom flanges of exterior beams. Heavy rusting is visible on beam sections that appear to have been replaced due to impact damage (see Photo 2). IDOT rates the substructure as being in good condition, which concurs with the findings from the cursory field check. Minor to moderate horizontal and vertical cracks with leaching are visible on abutments. Delaminations and map cracking are visible on the pier crashwalls and columns (see Photo 3). No notable defects or differences were observed between the cursory field check and IDOT's structure summary report for: deck geometry, underclearance vert/lat, approach alignment, bridge railing appraisal and approach guardrail items. Moderate longitudinal cracks are visible on the west approach slab. Anchor blocks are damaged along sections of both expansion joints (see Photo 4). Moderate to heavy cracking and vegetation growth is present on both slopewalls (see Photo 5). Some bearing pads on the west abutment exhibit a slight lean (see Photo 6).

Based on the structure summary report and field check, S.N. 016-0001 is suitable for reuse after rehabilitation of the substructure and expansion joints. Both slopewalls should be repaired.



LIN ENGINEERING, LTD.
Consulting Engineers

Springfield, IL Westmont, IL

576 Oakmont Lane
Westmont, Illinois 60559
Telephone: (630) 323-5168
Fax: (630) 323-5174
E-mail: info@lineng.com

Guardrail transitions should be brought up to current IDOT standards.

LIN ENGINEERING, LTD.

A handwritten signature in blue ink that reads "Michael T. Haley". The signature is written in a cursive, flowing style.

Michael T. Haley, PE, SE
Structural Manager

Appendix A – Photos

Appendix B – IDOT Structure Summary Report

Appendix C – PONTIS Report



Photo 1



Photo 2



Photo 3



Photo 4



Photo 5



Photo 6

**Illinois Department of Transportation
Structures Information Management System
Structure Summary Report**

Structure Number: 016-0001 District: 1

Inventory Data	
Facility Carried:	I-55 WB
Feature Crossed:	JOLIET RD EB
Bridge Status:	1 OPEN - NO RESTRICT
Status Remarks:	
Maint County:	016 COOK
Maint Responsibility:	01 I.D.O.T.
Service On/Under:	1 HIGHWAY
Reporting Agency:	1 I.D.O.T. - BUREAU OF MAINTENANCE
Main Span Matl/Type:	4 STEEL CONTINUOUS
Nbr Of Main Spans:	3
Approaches	
Near #1 Matl/Type:	/
Near #2 Matl/Type:	/
Far #1 Matl/Type:	/
Far #2 Matl/Type:	/
Median Width/Type:	0 Ft./0 None
Guardrail Type L/R:	0 None / 0 None
Toll Facility Indicator:	0 No Toll
Latitude:	41.75924676 S Longitude: 87.90791728 S
Deck Structure Type:	A CIP CON NRMALLY FORM
Sidewalks Under Structure:	0 None
Inventory Data	
Bridge Name:	2.1 M SW US 45
Location:	04/1988
Status Date:	16 LYONS
Maint Township:	1 / HIGHWAY
Multi-Level Structure Nbr:	62 D
Skew Angle:	L
Structure Flared:	No
Historical Significance:	No
Border Bridge State:	0
Bdr State SN:	0
Bdr State % Responsibility:	0
Structural Steel Wt:	556860
Substructure Material:	556860
Rated By:	2 IDOT
Inventory Rating:	1.590(57)
Operating Rating:	2.645(95)
Design Load:	01 HS20+MOD
Deck Structure Thickness:	7.5 SD: N FO: N
RR Vertical Underclear:	0 Ft
RR Lateral Underclear:	0 In
RR Crossing 1 Nbr:	0
RR Crossing 1 Nbr:	0
RR Lateral Underclear:	0
RR Crossing 1 Nbr:	0
RR Lateral Underclear:	0
Key Route On Data		
Key Route Nbr:	FEDERAL-AID INTERSTATE	
Station:	0055	
Segment:	04700	
Linked:	Y	
Natl. Hwy System:	On NHS	
Inventory Direction:		
Curr AADT Yr/Count:	2014 / 75950	
Est Truck Percentage:	9	
Number Of Lanes:	3	
One Or Two Way:	1 One-Way	
Bypass Length:	0	
Future AADT Yr/Cnt:	2032 / 78383	
Designated Truck Rte:	CLASS I	
Special Systems:	Yes	
**** Marked Route On Data ****		
Designation	Kind Number	
1 Mainline	1 Interstate Highway	055
1 Mainline		
1 Mainline		

Key Route Under Data		
Key Route Nbr:	FEDERAL-AID URBAN	
Station:	3562	
Segment:	01600	
Linked:	Y	
Natl. Hwy System:	Not on NHS	
Inventory Direction:		
Curr AADT Yr/Count:	2014 / 11750	
Est Truck Percentage:	11	
Number Of Lanes:	2	
One Or Two Way:	1 One-Way	
Bypass Length:	0	
Future AADT Yr/Cnt:	2032 / 6438	
Designated Truck Rte:	NONE	
Special Systems:	No	
**** Marked Route Under Data ****		
Designation	Kind Number	
1 Mainline	8 Other	
1 Mainline		
1 Mainline		

**Illinois Department of Transportation
Structures Information Management System
Structure Summary Report**

Structure Number: 016-0001 District: 1

Data Related to Inspection Information

*** Inspection Intervals ***
 Routine NBIS: 24 MOS Underwater: 0 MOS One Truck At A Time: 0 Combination Type 3S-1: Tons
 Special: N Single Unit Vehicles: Tons Combination Type 3S-2: Tons
 Bridge Posting Level: 5 No Posting Required

Inspection/Appraisal Information

Inspection Date: 02/10/2015 Inspection Temperature: 33Deg. F
 Deck: 7 GOOD CONDITION - SOME MINOR PROBLEMS
 Superstructure: 7 GOOD CONDITION - SOME MINOR PROBLEMS
 Substructure: 7 GOOD CONDITION - SOME MINOR PROBLEMS
 Culvert: N NOT APPLICABLE
 Channel and Protection: N NOT APPLICABLE
 Structural Evaluation: 7 BETTER THAN PRESENT MINIMUM CRITERIA
 Deck Geometry: 7 BETTER THAN PRESENT MINIMUM CRITERIA
 Underclearance-Vert/Lat.: 4 MINIMUM ADEQUACY TO BE LEFT IN PLACE
 Waterway Adequacy: N NOT APPLICABLE
 Approach Roadway Align: 8 EQUAL TO PRESENT DESIRABLE CRITERIA
 Bridge Railing Appraisal: 3 Meets Standards
 Approach Guardrail: 233 Not Acceptable
 Pier Navig Protection: N N/A

Deck Wearing Surf: A BARE DECK NO OVRLAY
 Deck Membrane: F NONE
 Deck Protection: A EPOXY COATED REINF
 Total Deck Thick: 7.5
 Last Paint Date: 06/2003

Underwater Inspection/Appraisal Information

Inspection Date:
 Temperature:
 Inspection Method:
 Appraisal Rating:

Scour Critical Information

Rating:
 Analysis Date:
 Evaluation Method:
 Microfilm Data Recorded: Yes

Construction Information

Year: 1962 Original
 Route: FAI-55
 Section Nbr: 0101-601-HB
 Contract Nbr: 82686
 Fed Aid Pr#: I 0557008272
 Built By: 1 I.D.O.T.
 1996 Reconstructed
 Sta: 1112+69.36 FAI-55
 Sta: 1112+81.01
 0101-601-HB
 82686
 NH1557(187)275
 1 I.D.O.T.

Miscellaneous

Pontis

Today's Date: 08/27/2015

Structure Number: 016-0001 District: 1 (41) Bridge Status: 1 OPEN - NO RESTRICT
 (6) Feature Crossed: JOLIET RD EB (7) Facility Carried: I- 55 WB
 (9) Location: 2.1 M SW US 45 (7A) Bridge Name:
 Element Inspection Date: 02/10/2015
 (90E) Agency Program Manager: MastnySC (90E3) Consultant Program Manager:
 (90E1) Team Leader: SedlacekJL (90E2) Inspector:

Element Insp. Delinquent		Element Insp. Delinquent Reason:								
Elem	Env	% 1	Qty 1	% 2	Qty 2	% 3	Qty 3	% 4	Qty 4	Tot Qty
Reinforced Conc Column or Pile Extension										
205	4	97	954	3	26	0	0	0	0	980
		No deterioration	Minor cracks/spalls	Delams/spalls	Analysis warranted					
Remarks: Few small HPs @ repaired areas										
Reinforced Conc Pier Wall										
210	4	100	4,138	0	8	0	0	0	0	4,146
		No deterioration	Minor cracks/spalls	Delams/spalls	Analysis warranted					
Remarks: Few small HPs @ repaired areas @ columns. Pier 1 column #2,3,5,6&7. Pier 2 col 3&4 FCR map crackd.										
Reinforced Conc Abutment										
215	4	99	1,903	1	20	0	0	0	0	1,923
		No deterioration	Minor cracks/spalls	Delams/spalls	Analysis warranted					
Remarks: Backwalls have vert leach crks										
Reinforced Conc Pier or Abutment Cap										
234	4	98	531	2	13	0	0	0	0	544
		No deterioration	Minor cracks/spalls	Delams/spalls	Analysis warranted					
Remarks: Abut) HL vert cracking										
Elastomeric Bearing										
310	4	93	25	7	2	0	0	0	0	27
		No deterioration	Minor deterioration	Major deterioration						
Remarks: Slight pad lean @ West Abut Brg#1										
Fixed Bearing										
313	4	100	9	0	0	0	0	0	0	9
		No deterioration	Minor deterioration	Advanced corrosion						
Remarks:										
Concrete Bridge Railing										
331	4	100	530	0	0	0	0	0	0	530
		No deterioration	Minor cracks/spalls	Analysis warranted						
Remarks: HL vert crks w/few hor crks @ transitions										

Concrete Deck Protected w/ Coated Bars										
8026	4	99	16,598	1	150	0	0	0	0	16,748
Remarks: WS- HL trans crks w/few random intersecting crks & isol shallow spall; Soffit) HL trans leach crking										
Non-Lead Painted Steel Open Girder										
8118	4	100	24,032	0	0	0	0	0	0	24,032
Remarks:										
Non-Lead Painted Steel Closed Web/Box Girder Ends										
8173	4	100	18	0	0	0	0	0	0	18
Remarks:										
Continuous Seal Neoprene Expansion Joint										
8308	4	96	259	4	12	0	0	0	0	271
Remarks: Misaligned @ staged constr jt; lt leakage @ both										
Approach Pavement										
8323	4	50	1	50	1	0	0	0	0	2
Remarks: Med-wide diag crks @ both; slight "as built" misalign LN3 W Apprch.										



October 27, 2015

MEMORANDUM

Mr. John Fortmann, Region One Engineer
Illinois Department of Transportation
Region One/District One

Attn: Steven Schilke

RE: Existing S.N. 016-0003
I-55 over Wolf Rd. and Flagg Creek
Cook County
PTB 158-002/P-91-762-10

The purpose of this technical memo is to summarize the current condition of existing S.N. 016-0003 in addition to geometrics and other factors. A cursory field check was performed to supplement the information contained in IDOT's structure summary report dated December 2, 2014 (see Appendix B). Broad-based recommendations for this structure are provided below.

The structure is a five span steel beam bridge consisting of twenty lines of continuous beams (see Photo 1). Span lengths from west to east are 40'-4", 67'-6", 63'-3", 67'-6" and 40'-4". The superstructure is supported by pile bent abutments and reinforced multi-column piers. There is no overlay on the structure.

IDOT rates the deck as being in good condition, which concurs with the findings from the cursory field check. Minor transverse cracks with leaching are visible on a majority of the soffit (see Photo 2). IDOT rates the superstructure as being in satisfactory condition, which concurs with the findings from the cursory field check. Minor to moderate paint peeling and rusting is visible (see Photo 3). IDOT rates the substructure as being in good condition, which concurs with the findings from the cursory field check. Minor vertical cracks with leaching are visible on the abutments. Small spalls and delaminations under bearings are visible on the piers (see Photo 4). IDOT rates the underclearance vertical and lateral as being adequate to be left in place, which concurs with the findings from the cursory field check. Scrape marks are visible on beam bottom flanges over Wolf Rd. No notable defects or differences were observed between the cursory field check and IDOT's structure summary report for: deck geometry, approach alignment and bridge railing appraisal items. Large longitudinal cracks, transverse cracks and spalls are visible on both approach slabs (see photo 5). The expansion joint seals appear to be in good condition, however a large amount of debris buildup on the west abutment bearing seats indicates that holes are present. Anchor blocks are missing along sections of the west expansion joint.

Based on the structure summary report and field check, S.N. 016-0003 is suitable for reuse after rehabilitation of the substructure and expansion joints.



LIN ENGINEERING, LTD.
Consulting Engineers

Springfield, IL Westmont, IL

576 Oakmont Lane
Westmont, Illinois 60559
Telephone: (630) 323-5168
Fax: (630) 323-5174
E-mail: info@lineng.com

LIN ENGINEERING, LTD.

A handwritten signature in blue ink that reads "Michael T. Haley". The signature is written in a cursive, flowing style.

Michael T. Haley, PE, SE
Structural Manager

Appendix A – Photos

Appendix B – IDOT Structure Summary Report

Appendix C – PONTIS Report



Photo 1



Photo 2



Photo 3



Photo 4



Photo 5

**Illinois Department of Transportation
Structures Information Management System
Structure Summary Report**

Structure Number: 016-0003 District: 1

Inventory Data	
Facility Carried: I-55 STEVENSON Feature Crossed: WOLF RD & FLAG CR Bridge Remarks: MAX.=59.0. STRUC. STEEL WGT. WAS 902000 Bridge Status: 1 OPEN - NO RESTRICT Status Remarks: Maint County: 016 COOK Maint Responsibility: 01 I.D.O.T. Service On/Under: 1 HIGHWAY Reporting Agency: 1 I.D.O.T. - BUREAU OF MAINTENANCE Main Span Matl/Type: 4 STEEL CONTINUOUS Nbr Of Main Spans: 5 Nbr Of Approach Spans: 0 ***Approaches*** Near #1 Matl/Type: Near #2 Matl/Type: Far #1 Matl/Type: Far #2 Matl/Type: Median Width/Type: Guardrail Type L/R: Toll Facility Indicator: Latitude: Deck Structure Type: A CIP CON NRMALLY FORM Sidewalks Under Structure: 0 None	Bridge Name: 1.5 M W US 45 Location: 902000 Status Date: 04/1988 Maint Township: 16 LYONS 6 / HIGHWAY-WATERWAY / 02 STRINGERMULTI-BEAM/GIRDER Sufficiently Rating: 96.0 HBP Eligible: No Replaced By: Replaces: Last Update Date: 07/05/2012 Parallel Structure: None Multi-Level Structure Nbr: Skew Direction: N Skew Angle: 0 D Structure Flared: No Historical Significance: No Border Bridge State: Bdr State SN: Bdr State % Responsibility: Structural Steel Wt: 117022 Substructure Material: Rated By: 2 IDOT Inventory Rating: 1.815(65) Operating Rating: 2.750(99) Design Load: 02 HS20 Deck Structure Thickness: 7.5 SD: N FO: N RR Vertical Underclear: 0 Ft 0 In Rate Method: 6 Load Rating Date: 05/23/1997 Crossing 1 Nbr: Crossing 1 Nbr: RR Lateral Underclear: 0 Ft 0 In

Key Route On Data	
Key Route Nbr: FEDERAL-AID INTERSTATE Appurtenances Main Route Inventory County: 016 COOK Township/Road Dist 16 LYONS Municipality 2760 INDIAN HEAD PARK Urban Area: 1051 Functional Class: 1 INTERSTATE ** CLEARANCES ** South/East North/West Max Rdwy Width: 68.0 Horizontal: 69.2 Lateral:	Station: 0055 Segment: 00000 Linked: Y Natl. Hwy System: On NHS Inventory Direction: Curr AADT Yr/Count: 2014 / 157800 Est Truck Percentage: 8 Number Of Lanes: 2 Two-Way One Or Two Way: 2 Two-Way Bypass Length: 0 Future AADT Yr/Cnt: 2032 / 174585 Designated Truck Rte: CLASS I Special Systems: Yes

Key Route Under Data	
FEDERAL-AID URBAN Main Route 016 16 LYONS 2760 INDIAN HEAD PARK 1051 1051 4 MINOR ARTERIAL South/East North/West 65.0 65.0	Station: 2689 Segment: 00000 Linked: Y Natl. Hwy System: Not on NHS Inventory Direction: Curr AADT Yr/Count: 2014 / 11300 Est Truck Percentage: 4 Number Of Lanes: 2 One Or Two Way: 2 Two-Way Bypass Length: 0 Future AADT Yr/Cnt: 2032 / 8858 Designated Truck Rte: NONE Special Systems: No

*** Marked Route On Data ***	
Designation Route #1: 1 Mainline Route #2: 1 Mainline Route #3: 1 Mainline	Kind 1 Interstate Highway Number 055

*** Marked Route Under Data ***	
Designation 1 Mainline 1 Mainline 1 Mainline	Kind 8 Other Number 8

**Illinois Department of Transportation
Structures Information Management System
Structure Summary Report**

Structure Number: 016-0003 District: 1

Data Related to Inspection Information

*** Inspection Intervals ***
 Routine NBIS: 24 MOS Underwater: 0 MOS One Truck At A Time: 0 Tons
 Special: N Single Unit Vehicles: 0 Tons
 Bridge Posting Level: 5 No Posting Required

Inspection/Appraisal Information

Inspection Date: 12/02/2014 Inspection Temperature: 32Deg. F
 Deck: 7 GOOD CONDITION - SOME MINOR PROBLEMS
 Superstructure: 6 SATISFACTORY CONDITION - MINOR DETERIORATION
 Substructure: 7 GOOD CONDITION - SOME MINOR PROBLEMS
 Culvert: N NOT APPLICABLE
 Channel and Protection: 7 GOOD CONDITION - SOME MINOR PROBLEMS
 Structural Evaluation: 6 EQUAL TO PRESENT MINIMUM CRITERIA
 Deck Geometry: 9 SUPERIOR TO PRESENT DESIRABLE CRITERIA
 Underclearance-Vert/Lat.: 4 MINIMUM ADEQUACY TO BE LEFT IN PLACE
 Waterway Adequacy: 9 SUPERIOR TO PRESENT DESIRABLE CRITERIA
 Approach Roadway Align: 8 EQUAL TO PRESENT DESIRABLE CRITERIA
 Bridge Railing Appraisal: 3 Meets Standards
 Approach Guardrail: 111 Does Not Exist Does Not Exist
 Pier Navig Protection: N N/A

Deck Wearing Surf: A BARE DECK NO OVRLAY
 Deck Membrane: F NONE
 Deck Protection: A EPOXY COATED REINF
 Total Deck Thick: 7.5
 Last Paint Date: 10/1996
 One Truck At A Time: 0
 Last Paint Type: CJ
 LD SHP GRN&AL FNL
 IRZC/OXIDE ALKYD

Underwater Inspection/Appraisal Information

Inspection Date: 12/02/2011
 Temperature: 40
 Inspection Method: PV Probe
 Appraisal Rating: 7
 Appraisal Method: Visual
 Appraisal Description: GOOD - SMALL CRACKS IN UNDERWATER UNITS

Scour Critical Information

Rating: 8 CALCULATED SCOUR ABOVE FOOTING
 Analysis Date: 09/30/1994
 Evaluation Method: B Rational Analysis
 Microfilm Data Recorded: Yes

Construction Information

Year: 1963 Original
 Route: FAI-55 Reconstructed
 Section Nbr: 0202-602HB Sta: 1140+41.64 FAI-55 Sta: 1140+41.64
 Contract Nbr: 82686 0101R,0102-631R
 Fed Aid Pr#: I 0557064272
 Built By: 1 I.D.O.T. 1 I.D.O.T.

Pontis

Today's Date: 08/27/2015

Structure Number: 016-0003 District: 1 (41) Bridge Status: 1 OPEN - NO RESTRICT
 (6) Feature Crossed: WOLF RD & FLAG CR (7) Facility Carried: I- 55 STEVENSON
 (9) Location: 1.5 M W US 45 (7A) Bridge Name:
 Element Inspection Date: 12/02/2014
 (90E) Agency Program Manager: MastnySC (90E3) Consultant Program Manager:
 (90E1) Team Leader: MastnySC (90E2) Inspector:

Element Insp. Delinquent		Element Insp. Delinquent Reason:								
Elem	Env	% 1	Qty 1	% 2	Qty 2	% 3	Qty 3	% 4	Qty 4	Tot Qty
Lead Painted Steel Open Girder										
107	4	94	51,644	6	3,475	0	0	0	0	55,119
		No corrosion	Paint distress		Rust formation		Section loss		Section failure	
Remarks: Lt scattered rust btm flange										
Reinforced Conc Column or Pile Extension										
205	4	99	5,475	1	30	0	15	0	0	5,520
		No deterioration	Minor cracks/spalls		Delams/spalls		Analysis warranted			
Remarks: Crking w/few HPs & shallow spalls (Col 2 P4)										
Reinforced Conc Pier Wall										
210	4	100	7,670	0	20	0	8	0	0	7,698
		No deterioration	Minor cracks/spalls		Delams/spalls		Analysis warranted			
Remarks: Crking w/few HPs & shallow spalls										
Reinforced Conc Abutment										
215	4	92	550	8	50	0	0	0	0	600
		No deterioration	Minor cracks/spalls		Delams/spalls		Analysis warranted			
Remarks: Abut backwalls have vert crks w/leach										
Reinforced Conc Pier or Abutment Cap										
234	4	96	767	1	8	3	25	0	0	800
		No deterioration	Minor cracks/spalls		Delams/spalls		Analysis warranted			
Remarks: (Pier)Scattered crking w/few surf spalls;map crk & leach @ P2 btwn bms 2 & 3 also @ Bm 10 pier 4; W Face pier 2 ;Abut) Few vert crks										
Preformed Joint Seal										
302	4	100	423	0	0	0	0	0	0	423
		No deterioration	Minor deterioration		Major deterioration					
Remarks:										
Elastomeric Bearing										
310	4	50	20	50	20	0	0	0	0	40
		No deterioration	Minor deterioration		Major deterioration					
Remarks: Lt rust to assemblies @ abuts & longit joint										

Fixed Bearing										
	No deterioration	Minor deterioration	Advanced corrosion							
313	4	50	10	50	10	0	0	0	0	20
Remarks:	@ Pier #3-Lt rust to assemblies									
Concrete Bridge Railing										
331	4	99	832	1	8	0	0	0	0	840
Remarks:	Vert leach crks typ.									
Concrete Deck Protected w/ Coated Bars										
8026	4	96	38,366	4	1,450	0	0	0	0	39,816
Remarks:	Soffit) HL-Nar scattered trans leach crks; haunch crks @ abuts; Deckpounding on bms @ isol loc most near piers; WS) Numerous HL-nar trans crks w/some intersecting long crks									
Lead Painted Steel Closed Web/Box Girder Ends										
8172	4	80	32	20	8	0	0	0	0	40
Remarks:	Lt rust bm ends @ webs & diaphrs									
Continuous Seal Neoprene Expansion Joint										
8308	4	94	135	6	8	0	0	0	0	143
Remarks:	WB LN 3 has small missing section									
Moveable Steel Bearings below continuous decks										
8316	4	97	58	3	2	0	0	0	0	60
Remarks:	@ Pier #1, 2 & 4									
Approach Pavement										
8323	4	0	0	100	4	0	0	0	0	4
Remarks:	Longit & random map/ x-verse crks									
Steel Open Girder										
8406	4	100	180	0	0	0	0	0	0	180
Remarks:	Span #4-Small scrapes/impact damage on most Bms over Wolf Rd									



October 27, 2015

MEMORANDUM

Mr. John Fortmann, Region One Engineer
Illinois Department of Transportation
Region One/District One

Attn: Steven Schilke

RE: Existing S.N. 016-0004
E.B. I-55 over BNSF Railway Separation
Cook County
PTB 158-002/P-91-762-10

The purpose of this technical memo is to summarize the current condition of existing S.N. 016-0004 in addition to geometrics and other factors. A cursory field check was performed to supplement the information contained in IDOT's structure summary report dated April 23, 2014 (see Appendix B). Broad-based recommendations for this structure are provided below.

The structure is a four span continuous steel girder bridge (see Photo 1). Span lengths from west to east are $91'-3\frac{5}{8}"$, $117'-0"$, $117'-0"$ and $91'-3\frac{5}{8}"$. The superstructure is supported by pile bent abutments and reinforced concrete multi-column piers on crashwalls. There is no overlay on the structure.

A BNSF ROW fence prevented access to view the deck soffit, superstructure, substructure and underclearance vert/lat. IDOT rates the deck as being in good condition, which concurs with the findings from the cursory field check. Minor transverse cracks and scattered longitudinal cracks are visible throughout the top of deck (see Photo 2). No notable defects or differences were observed between the cursory field check and IDOT's structure summary report for: deck geometry, approach alignment and bridge railing appraisal items. Anchor blocks are damaged or missing along sections of both expansion joints (see Photos 3 and 4).

Based on the structure summary report and field check, S.N. 016-0004 is suitable for reuse after rehabilitation of the substructure, superstructure and expansion joints.



LIN ENGINEERING, LTD.
Consulting Engineers

Springfield, IL Westmont, IL

576 Oakmont Lane
Westmont, Illinois 60559
Telephone: (630) 323-5168
Fax: (630) 323-5174
E-mail: info@lineng.com

LIN ENGINEERING, LTD.

A handwritten signature in blue ink that reads "Michael T. Haley". The signature is written in a cursive, flowing style.

Michael T. Haley, PE, SE
Structural Manager

Appendix A – Photos

Appendix B – IDOT Structure Summary Report

Appendix C – PONTIS Report



Photo 1



Photo 2



Photo 3



Photo 4

Structure Number: 016-0004 District: 1

Inventory Data	
Facility Carried:	I-55 EB STEVENSON
Feature Crossed:	RR - BNSF
Bridge Remarks:	DESIGN LOAD MS18&ALT
Bridge Status:	1 OPEN - NO RESTRICT
Status Remarks:	PER KRAMARZ
Maint County:	016 COOK
Maint Responsibility:	01 I.D.O.T.
Service On/Under:	1 HIGHWAY
Reporting Agency:	1 I.D.O.T. - BUREAU OF MAINTENANCE
Main Span Matl/Type:	4 STEEL CONTINUOUS
Nbr Of Main Spans:	4
Nbr Of Approach Spans:	0
Approaches	
Near #1 Matl/Type:	/
Near #2 Matl/Type:	/
Far #1 Matl/Type:	/
Far #2 Matl/Type:	/
Median Width/Type:	0 Ft./0 None
Guardrail Type L/R:	0 None / 0 None
Toll Facility Indicator:	0 No Toll
Latitude:	41.76242074 S Longitude: 87.86201295 S
Deck Structure Type:	A CIP CON NRMALLY FORM
Sidewalks Under Structure:	0 None

Key Route On Data	
Key Route Nbr:	FEDERAL-AID INTERSTATE 0055 Station: 2.8400
Appurtenances Main Route:	00000
Inventory County:	016 COOK
Township/Road Dist:	16 LYONS
Municipality:	2645 HODGKINS
Urban Area:	1051
Functional Class:	1 INTERSTATE
** CLEARANCES **	South/East North/West
Max Rdwy Width:	67.8
Horizontal:	67.8
Vertical:	0.0
Laterals:	

Key Route Under Data	
Station:	
Segment:	
Linked:	
Natl. Hwy System:	On NHS
Inventory Direction:	
Curr AADT Yr/Count:	2014 / 64500
Est Truck Percentage:	10
Number Of Lanes:	3
One Or Two Way:	1 One-Way
Bypass Length:	0
Future AADT Yr/Cnt:	2032 / 83945
Designated Truck Rte:	CLASS I
Special Systems:	Yes

Marked Route On Data ****		
Designation	Kind	Number
Route #1:	1 Mainline	055
Route #2:	1 Mainline	
Route #3:	1 Mainline	

Marked Route Under Data ****		
Designation	Kind	Number
Route #1:	1 Interstate Highway	055
Route #2:		
Route #3:		

Railroad Crossing Info	
Crossing 1 Nbr:	
Crossing 1 Name:	
RR Lateral Underclear:	11.1
RR Vertical Underclear:	23 Ft 10 In

Railroad Crossing Info	
Rate Method:	6
Load Rating Date:	01/08/2001
Design Load:	99 UNKNOWN
Design SD:	7.5 SD: N
Design FO:	N
Deck Structure Thickness:	

Sufficiency Rating:	
HBP Eligible:	86.0
Replaces:	No AASHTO Bridge Length: 427.4
Last Update Date:	- Length of Long Span: 99.9
Parallel Structure:	- Bridge Roadway Width: 117.0
Multi-Level Structure Nbr:	02/19/2015 Appr Roadway Width: 76.4
Skew Angle:	Right Deck Width: 79.6
Structure Flared:	Sidewalk Width Right: 0.0
Historical Significance:	Left Sidewalk Width Left: 0.0
Border Bridge State:	Navigation Control: N
Bdr State SN:	Navigation Horiz Clear: 0
Bdr State % Responsibility:	Navigation Vert Clear: 0
Structural Steel Wt:	Culvert Fill Depth: 0.0
Substructure Material:	Number Culvert Cells: 0
Rated By:	0 Culvert Opening Area: 0.0
Inventory Rating:	Culvert Cell Height: 0.00
Operating Rating:	Culvert Cell Width: 0.00

**Illinois Department of Transportation
Structures Information Management System
Structure Summary Report**

Structure Number: 016-0004 District: 1

Data Related to Inspection Information

*** Inspection Intervals ***
 Routine NBIS: 24 MOS Underwater: 0 MOS One Truck At A Time: 0 Combination Type 3S-1: Tons
 Special: N Single Unit Vehicles: Tons Combination Type 3S-2: Tons
 Bridge Posting Level: 5 No Posting Required

Inspection/Appraisal Information

Inspection Date: 04/23/2014 Inspection Temperature: 51Deg. F
 Deck: 7 GOOD CONDITION - SOME MINOR PROBLEMS
 Superstructure: 5 FAIR CONDITION - MINOR SECTION LOSS, CRACKS
 Substructure: 7 GOOD CONDITION - SOME MINOR PROBLEMS
 Culvert: N NOT APPLICABLE
 Channel and Protection: N NOT APPLICABLE
 Structural Evaluation: 5 BETTER THAN ADEQUATE TO BE LEFT IN PLACE
 Deck Geometry: 9 SUPERIOR TO PRESENT DESIRABLE CRITERIA
 Underclearance-Vert/Lat.: 5 BETTER THAN ADEQUATE TO BE LEFT IN PLACE
 Waterway Adequacy: N NOT APPLICABLE
 Approach Roadway Align: 8 EQUAL TO PRESENT DESIRABLE CRITERIA
 Bridge Railing Appraisal: 3 Meets Standards
 Approach Guardrail: N/A N/A
 Pier Navig Protection: N N/A

Deck Wearing Surf: A BARE DECK NO OVERLAY
 Deck Membrane: F NONE
 Deck Protection: A EPOXY COATED REINF
 Total Deck Thick: 7.5
 Last Paint Date: 10/2000

Single Unit Vehicles: Tons
 Combination Type 3S-1: Tons
 Combination Type 3S-2: Tons
 One Truck At A Time: 0
 Last Paint Type: US
 FLD AL EPY & ACRLC
 SHP ZINC&FLD ACRYL

Underwater Inspection/Appraisal Information

Inspection Date:
 Temperature:
 Inspection Method:
 Appraisal Rating:

Scour Critical Information

Rating:
 Analysis Date:
 Evaluation Method:
 Microfilm Data Recorded: Yes

Construction Information

Year: 1964 Original 1999 Reconstructed
 Route: FAI-55 Sta: 166+28.48 FAI55 Sta: 14+626.10
 Section Nbr: 0404-673VB 0404(606VB&676B)
 Contract Nbr: 82979
 Fed Aid Pr#: IG 0557104274 55-7(196)279
 Built By: 1 I.D.O.T. 1 I.D.O.T.

Pontis

Today's Date: 08/27/2015

Structure Number: 016-0004 District: 1 (41) Bridge Status: 1 OPEN - NO RESTRICT
 (6) Feature Crossed: RR - BNSF (7) Facility Carried: I- 55 EB STEVENSON
 (9) Location: 0.3 M E US 45 (7A) Bridge Name:
 Element Inspection Date: 04/23/2014
 (90E) Agency Program Manager: MastrySC (90E3) Consultant Program Manager:
 (90E1) Team Leader: SedlacekJL (90E2) Inspector:

Element Insp. Delinquent		Element Insp. Delinquent Reason:									
Elem	Env	% 1	Qty 1	% 2	Qty 2	% 3	Qty 3	% 4	Qty 4	Tot Qty	
Reinforced Conc Column or Pile Extension											
205	1	100	2,719	0	0	0	0	0	0	2,719	
		No deterioration	Minor cracks/spalls	Delams/spalls	Analysis warranted						
Remarks:											
Reinforced Conc Pier Wall											
210	1	100	14,722	0	0	0	0	0	0	14,722	
		No deterioration	Minor cracks/spalls	Delams/spalls	Analysis warranted						
Remarks: Vert & diag crking @ P#2,P#3											
Reinforced Conc Abutment											
215	1	100	1,953	0	0	0	0	0	0	1,953	
		No deterioration	Minor cracks/spalls	Delams/spalls	Analysis warranted						
Remarks:											
Reinforced Conc Pier or Abutment Cap											
234	1	98	685	2	16	0	0	0	0	701	
		No deterioration	Minor cracks/spalls	Delams/spalls	Analysis warranted						
Remarks: Pier) Few map crk & HPs P#1,P#2; Abut)Edge crks & spalls @ E											
Elastomeric Bearing											
310	4	0	0	100	20	0	0	0	0	20	
		No deterioration	Minor deterioration	Major deterioration							
Remarks: Lt rusting of assemblies @ sections of older steel											
Fixed Bearing											
313	4	0	0	100	10	0	0	0	0	10	
		No deterioration	Minor deterioration	Advanced corrosion							
Remarks:											
Pot Bearing											
314	4	0	0	100	20	0	0	0	0	20	
		No deterioration	Minor deterioration	Advanced corrosion							
Remarks:											

Concrete Bridge Railing										
331	4	0	0	100	855	0	0	0	0	855
		No deterioration	Minor cracks/spalls		Analysis warranted					
Remarks: HL vertical and horizontal crks										
Concrete Deck Protected w/ Coated Bars										
8026	4	93	31,750	7	2,450	0	0	0	0	34,200
Remarks: (Soffit) Trans leach crks; WS) Trans crking; map cracking										
Non-Lead Painted Steel Open Girder										
8118	4	97	52,963	3	1,750	0	0	0	0	54,713
Remarks: Few isol paint peels; Lt-med surf rust throughout										
Non-Lead Painted Steel Closed Web/Box Girder Ends										
8173	4	100	20	0	0	0	0	0	0	20
Remarks: Init sec loss @ bm ends & diaphs @ abuts										
Neoprene Expansion Joint										
8307	4	94	261	6	16	0	0	0	0	277
Remarks: Lt leakage										
Approach Pavement										
8323	4	100	2	0	0	0	0	0	0	2
Remarks:										
Steel Open Girder										
8406	4	0	0	40	4	60	6	0	0	10
Remarks: Few abut bm ends have minor pitting/sec loss that has been painted.										



October 27, 2015

MEMORANDUM

Mr. John Fortmann, Region One Engineer
Illinois Department of Transportation
Region One/District One

Attn: Steven Schilke

RE: Existing S.N. 016-0005
W.B. I-55 over BNSF Railway Separation
Cook County
PTB 158-002/P-91-762-10

The purpose of this technical memo is to summarize the current condition of existing S.N. 016-0005 in addition to geometrics and other factors. A cursory field check was performed to supplement the information contained in IDOT's structure summary report dated April 23, 2014 (see Appendix B). Broad-based recommendations for this structure are provided below.

The structure is a four span continuous steel girder bridge (see Photo 1). Span lengths from west to east are 91'-3½", 117'-0", 117'-0" and 91'-3½". The superstructure is supported by pile bent abutments and reinforced concrete multi-column piers on crashwalls. There is no overlay on the structure.

A BNSF ROW fence prevented access to view the deck soffit, superstructure, substructure and underclearance vert/lat. IDOT rates the deck as being in good condition, which concurs with the findings from the cursory field check. Minor transverse cracks and scattered longitudinal cracks are visible throughout the top of deck (see Photo 2). No notable defects or differences were observed between the cursory field check and IDOT's structure summary report for: deck geometry, approach alignment and bridge railing appraisal items. Anchor blocks are damaged or missing along sections of the west expansion joint (see Photo 3).

Based on the structure summary report and field check, S.N. 016-0005 is suitable for reuse after rehabilitation of the superstructure and expansion joints.



LIN ENGINEERING, LTD.
Consulting Engineers

Springfield, IL Westmont, IL

576 Oakmont Lane
Westmont, Illinois 60559
Telephone: (630) 323-5168
Fax: (630) 323-5174
E-mail: info@lineng.com

LIN ENGINEERING, LTD.

A handwritten signature in blue ink that reads "Michael T. Haley". The signature is written in a cursive, flowing style.

Michael T. Haley, PE, SE
Structural Manager

Appendix A – Photos

Appendix B – IDOT Structure Summary Report

Appendix C – PONTIS Report



Photo 1

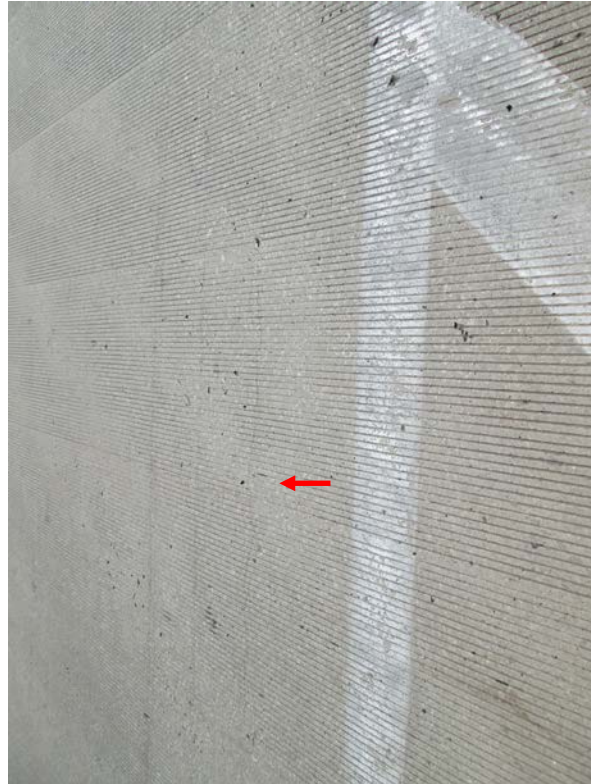


Photo 2



Photo 3

**Illinois Department of Transportation
Structures Information Management System
Structure Summary Report**

Structure Number: 016-0005 District: 1

Inventory Data	
Facility Carried: I-55 WB STEVENSON	Sufficiency Rating: 87.0 Structure Length: 427.4
Feature Crossed: RR - BNSF	HBP Eligible: No AASHTO Bridge Length: 99.9
Bridge Remarks: DESIGN LOAD MS18&ALT	Replaces By: - Length of Long Span: 117.0
Bridge Status: 1 OPEN - NO RESTRICT	Replaces: - Bridge Roadway Width: 96.9
Status Remarks:	02/19/2015 Appr Roadway Width: 96.9
Maint County: 016 COOK	Left Deck Width: 100.1
Maint Responsibility: 01 I.D.O.T.	Sidewalk Width Right: 0.0
Service On/Under: 1 HIGHWAY	Left Sidewalk Width Left: 0.0
Reporting Agency: 1 I.D.O.T. - BUREAU OF MAINTENANCE	Navigation Control: N N/A
Main Span Matl/Type: 4 STEEL CONTINUOUS	Structure Flared: Yes
Nbr Of Main Spans: 4	Historical Significance: No
Approaches	Border Bridge State: 0
Near #1 Matl/Type:	Culvert Fill Depth: 0.0
Near #2 Matl/Type:	Number Culvert Cells: 0
Far #1 Matl/Type:	Bdr State % Responsibility: 0
Far #2 Matl/Type:	Structural Steel Wt: 584000
Median Width/Type:	Substructure Material:
Guardrail Type L/R:	Rated By: 2 IDOT
Toll Facility Indicator: 0 No Toll	Load Rating Date: 05/29/2001
Latitude: 41.76243765	Design Load: 99 UNKNOWN
Deck Structure Type: A CIP CON NRMALLY FORM	Deck Structure Thickness: 7.5 SD: N FC: N
Sidewalks Under Structure: 0 None	RR Lateral Underclear: 15.6
	RR Vertical Underclear: 22 Ft 07 In

Key Route On Data		Key Route Under Data	
Key Route Nbr: FEDERAL-AID INTERSTATE	Station: 0055	Station:	
Appurtenances Main Route	Segment: 00000	Segment:	
Inventory County: 016 COOK	Linked: Y	Linked:	
Township/Road Dist 16 LYONS	Natl. Hwy System: On NHS	Natl. Hwy System:	
Municipality 2645 HODGKINS	Inventory Direction:	Inventory Direction:	
Urban Area: 1051	Curr AADT Yr/Count: 2014 / 68900	Curr AADT Yr/Count:	/
Functional Class: 1 INTERSTATE	Est Truck Percentage: 9	Est Truck Percentage:	
** CLEARANCES ** South/East North/West	Number Of Lanes: 4	Number Of Lanes:	
Max Rdwy Width: 97.0	One Or Two Way: 1 One-Way	One Or Two Way:	
Horizontal: 98.0	Bypass Length: 0	Bypass Length:	
	Future AADT Yr/Cnt: 2032 / 83945	Future AADT Yr/Cnt:	/
	Designated Truck Rte: CLASS I	Designated Truck Rte:	
	Special Systems: Yes	Special Systems:	
Laterals:			
**** Marked Route On Data ****		**** Marked Route Under Data ****	
Designation	Kind	Designation	Kind
Route #1: 1 Mainline	1 Interstate Highway		Number
Route #2: 1 Mainline			055
Route #3: 1 Mainline			

**Illinois Department of Transportation
Structures Information Management System
Structure Summary Report**

Structure Number: 016-0005 District: 1

Data Related to Inspection Information

*** Inspection Intervals ***
 Routine NBIS: 24 MOS Underwater: 0 MOS One Truck At A Time: 0 Tons
 Special: N Single Unit Vehicles: Tons Combination Type 3S-1: Tons
 Bridge Posting Level: 5 No Posting Required

Inspection/Appraisal Information

Inspection Date: 04/23/2014 Inspection Temperature: 51Deg. F
 Deck: 7 GOOD CONDITION - SOME MINOR PROBLEMS
 Superstructure: 5 FAIR CONDITION - MINOR SECTION LOSS, CRACKS
 Substructure: 7 GOOD CONDITION - SOME MINOR PROBLEMS
 Culvert: N NOT APPLICABLE
 Channel and Protection: N NOT APPLICABLE
 Structural Evaluation: 5 BETTER THAN ADEQUATE TO BE LEFT IN PLACE
 Deck Geometry: 9 SUPERIOR TO PRESENT DESIRABLE CRITERIA
 Underclearance-Vert/Lat.: 6 EQUAL TO PRESENT MINIMUM CRITERIA
 Waterway Adequacy: N NOT APPLICABLE
 Approach Roadway Align: 8 EQUAL TO PRESENT DESIRABLE CRITERIA
 Bridge Railing Appraisal: 3 Meets Standards
 Approach Guardrail: N/A N/A
 Pier Navig Protection: N N/A

Deck Wearing Surf: A BARE DECK NO OVRLAY
 Deck Membrane: F NONE
 Deck Protection: A EPOXY COATED REINF
 Total Deck Thick: 7.5
 Last Paint Date: 05/2001

Underwater Inspection/Appraisal Information

Inspection Date:
 Temperature:
 Inspection Method:
 Appraisal Rating:

Scour Critical Information

Rating:
 Analysis Date:
 Evaluation Method:
 Microfilm Data Recorded: Yes

Construction Information

Year: 1964 Original
 Route: FAI-55 2000 Reconstructed
 Section Nbr: 0404-673-VB Sta: 166+28.48 FAI55 Sta: 14+626.10
 Contract Nbr: 82969 0404-676B-R-1
 Fed Aid Pr#: IG 0557104274 55-7(219)277
 Built By: 1 I.D.O.T. 1 I.D.O.T.

Pontis

Today's Date: 08/27/2015

Structure Number: 016-0005 District: 1
 (6) Feature Crossed: RR - BNSF
 (9) Location: 0.3 M E US 45
 Element Inspection Date: 04/23/2014
 (90E) Agency Program Manager: MastnySC
 (90E1) Team Leader: SedlacekJL

(41) Bridge Status: 1 OPEN - NO RESTRICT
 (7) Facility Carried: I- 55 WB STEVENSON
 (7A) Bridge Name:
 (90E3) Consultant Program Manager:
 (90E2) Inspector:

Element Insp. Delinquent		Element Insp. Delinquent Reason:									
Elem	Env	% 1	Qty 1	% 2	Qty 2	% 3	Qty 3	% 4	Qty 4	Tot Qty	
Reinforced Conc Column or Pile Extension											
205	1	100	3,737	0	0	0	0	0	0	3,737	
			No deterioration	Minor cracks/spalls	Delams/spalls	Analysis warranted					
Remarks:											
Reinforced Conc Pier Wall											
210	1	100	16,009	0	0	0	0	0	0	16,009	
			No deterioration	Minor cracks/spalls	Delams/spalls	Analysis warranted					
Remarks:											
Reinforced Conc Abutment											
215	1	100	2,070	0	0	0	0	0	0	2,070	
			No deterioration	Minor cracks/spalls	Delams/spalls	Analysis warranted					
Remarks:											
Reinforced Conc Pier or Abutment Cap											
234	1	100	950	0	0	0	0	0	0	950	
			No deterioration	Minor cracks/spalls	Delams/spalls	Analysis warranted					
Remarks:											
Elastomeric Bearing											
310	4	0	0	100	26	0	0	0	0	26	
			No deterioration	Minor deterioration	Major deterioration						
Remarks: Lt rusting to assemblies @ older steel											
Fixed Bearing											
313	4	0	0	100	26	0	0	0	0	26	
			No deterioration	Minor deterioration	Advanced corrosion						
Remarks:											
Pot Bearing											
314	4	0	0	100	26	0	0	0	0	26	
			No deterioration	Minor deterioration	Advanced corrosion						
Remarks:											

Concrete Bridge Railing										
331	4	0	0	100	842	0	0	0	0	842
		No deterioration	Minor cracks/spalls	Analysis warranted						
Remarks: HL vert and horiz crks										
Concrete Deck Protected w/ Coated Bars										
8026	4	93	40,137	7	3,100	0	0	0	0	43,237
Remarks: Soffit) Trans leach crks; WS) Trans crks; scattered map cracking										
Non-Lead Painted Steel Open Girder										
8118	4	100	67,007	0	0	0	0	0	0	67,007
Remarks: LT-med surf rust throughout old steel; Isol paint peels										
Non-Lead Painted Steel Closed Web/Box Girder Ends										
8173	4	100	26	0	0	0	0	0	0	26
Remarks: Init sec loss @ abuts										
Neoprene Expansion Joint										
8307	4	94	363	6	24	0	0	0	0	387
Remarks: Leakage allowing debris to seat										
Approach Pavement										
8323	4	100	2	0	0	0	0	0	0	2
Remarks:										



October 27, 2015

MEMORANDUM

Mr. John Fortmann, Region One Engineer
Illinois Department of Transportation
Region One/District One

Attn: Steven Schilke

RE: Existing S.N. 016-0006
E.B. I-55 over Santa Fe Drive
Cook County
PTB 158-002/P-91-762-10

The purpose of this technical memo is to summarize the current condition of existing S.N. 016-0006 in addition to geometrics and other factors. A cursory field check was performed to supplement the information contained in IDOT's structure summary report dated August 13, 2014 (see Appendix B). Broad-based recommendations for this structure are provided below.

The structure is a three span steel girder bridge consisting of nine lines of continuous girders (see Photo 1). Span lengths from west to east are 75'-10 $\frac{1}{4}$ "", 97'-1" and 75'-10 $\frac{1}{4}$ ". The superstructure is supported by pile bent abutments and reinforced concrete multi-column piers. There is no overlay on the structure.

IDOT rates the deck as being in good condition, which concurs with the findings from the cursory field check. Minor transverse cracks are visible throughout the top of deck and soffit (see Photo 2). IDOT rates the superstructure as being in fair condition, which concurs with the findings from the cursory field check. Minor section loss is visible at girder ends (see Photo 3). IDOT rates the substructure as being in good condition, which concurs with the findings from the cursory field check. Minor vertical and horizontal cracking is visible on abutment caps, and pier crash walls. No notable defects or differences were observed between the cursory field check and IDOT's structure summary report for: deck geometry, underclearance vert/lat, approach alignment and bridge railing appraisal items. Anchor blocks are damaged along sections of both expansion joints (see Photo 4). Large cracks are visible at the tops of both slopewalls (see Photo 5).

Based on the structure summary report and field check, S.N. 016-0006 is suitable for reuse after rehabilitation of the superstructure and expansion joints. Slope walls should be repaired.



LIN ENGINEERING, LTD.
Consulting Engineers

Springfield, IL Westmont, IL

576 Oakmont Lane
Westmont, Illinois 60559
Telephone: (630) 323-5168
Fax: (630) 323-5174
E-mail: info@lineng.com

LIN ENGINEERING, LTD.

A handwritten signature in blue ink that reads "Michael T. Haley". The signature is written in a cursive, flowing style.

Michael T. Haley, PE, SE
Structural Manager

Appendix A – Photos

Appendix B – IDOT Structure Summary Report

Appendix C – PONTIS Report



Photo 1



Photo 2



Photo 3



Photo 4



Photo 5

**Illinois Department of Transportation
Structures Information Management System
Structure Summary Report**

Structure Number: 016-0006 **District:** 1

		Inventory Data	
Facility Carried:	I-55 EB STEVENSON	Bridge Name:	257.8
Feature Crossed:	SANTA FE DR	Location:	0.4 M E US 45
Bridge Remarks:	DESIGN LOAD MS18&ALT	Status Date:	02/2000
Bridge Status:	1 OPEN - NO RESTRICT	Maint Township:	16 LYONS
Status Remarks:	PER KRAMARZ		
Maint County:	016 COOK		
Maint Responsibility:	01 I.D.O.T.		
Service On/Under:	1 HIGHWAY	4 / HIGHWAY-RAILROAD	
Reporting Agency:	1 I.D.O.T. - BUREAU OF MAINTENANCE		
Main Span Matl/Type:	4 STEEL CONTINUOUS	/ 02 STRINGERMULTI-BEAM/GIRDER	
Nbr Of Main Spans:	3	Nbr Of Approach Spans:	0
Approaches			
Near #1 Matl/Type:	0 Fl./0 None		
Near #2 Matl/Type:	0 None		
Far #1 Matl/Type:	41.76269149		
Far #2 Matl/Type:	0 No Toll		
Median Width/Type:	0 No Toll		
Guardrail Type L/R:	0 No Toll		
Toll Facility Indicator:	0 No Toll		
Latitude:	41.76269149	S Longitude:	87.86009870
Deck Structure Type:	A CIP CON NRMALLY FORM		
Sidewalks Under Structure:	0 None		

		Key Route On Data	
Key Route Nbr:	FEDERAL-AID INTERSTATE	Station:	0055
Appurtenances	Main Route	Segment:	00000
Inventory County:	016 COOK	Linked:	Y
Township/Road Dist	16 LYONS	Natl. Hwy System:	On NHS
Municipality	2645 HODGKINS	Inventory Direction:	
Urban Area:	1051	Curr AADT Yr/Count:	2014 / 68900
Functional Class:	1 INTERSTATE	Est Truck Percentage:	9
** CLEARANCES **	South/East	Number Of Lanes:	3
Max Rdwy Width:	65.3	One Or Two Way:	1 One-Way
Horizontal:	66.5	Bypass Length:	0
		Future AADT Yr/Cnt:	2032 / 83945
		Designated Truck Rte:	CLASS I
		Special Systems:	Yes

		Key Route Under Data	
Key Route Nbr:	FEDERAL-AID URBAN	Station:	2719
Appurtenances	Main Route	Segment:	00000
Inventory County:	016 LYONS	Linked:	Y
Township/Road Dist	16 LYONS	Natl. Hwy System:	On NHS
Municipality	2645 HODGKINS	Inventory Direction:	
Urban Area:	1051	Curr AADT Yr/Count:	2014 / 8500
Functional Class:	5 MAJOR COLLECTOR	Est Truck Percentage:	8
** CLEARANCES **	South/East	Number Of Lanes:	2
Max Rdwy Width:	65.3	One Or Two Way:	2 Two-Way
Horizontal:	66.5	Bypass Length:	0
		Future AADT Yr/Cnt:	2032 / 4738
		Designated Truck Rte:	NONE
		Special Systems:	No

		**** Marked Route On Data ****	
Route #1:	1 Mainline	Designation	Kind
Route #2:	1 Mainline	1 Interstate Highway	Number
Route #3:	1 Mainline	055	055

		**** Marked Route Under Data ****	
Route #1:	1 Mainline	Designation	Kind
Route #2:	1 Mainline	8 Other	Number
Route #3:	1 Mainline		

Illinois Department of Transportation
Structures Information Management System
Structure Summary Report

Structure Number: 016-0006 District: 1

*** Inspection Intervals ***
Routin e NBIS: 24 MOS Underwater: 0 MOS One Truck At A Time: 0 Tons Combination Type 3S-1: Tons Bridge Posting Level: 5 No Posting Required
Special: N Single Unit Vehicles: Tons Combination Type 3S-2: Tons

Data Related to Inspection Information
*** Maximum Allowable Posting Limits ***

Inspection/Apraisal Information
Inspection Date: 08/13/2014 Inspection Temperature: 82Deg. F

Deck: 7 GOOD CONDITION - SOME MINOR PROBLEMS
Superstructure: 5 FAIR CONDITION - MINOR SECTION LOSS, CRACKS
Substructure: 7 GOOD CONDITION - SOME MINOR PROBLEMS
Culvert: N NOT APPLICABLE
Channel and Protection: N NOT APPLICABLE
Structural Evaluation: 5 BETTER THAN ADEQUATE TO BE LEFT IN PLACE
Deck Geometry: 9 SUPERIOR TO PRESENT DESIRABLE CRITERIA
Underclearance-Vert/Lat.: 7 BETTER THAN PRESENT MINIMUM CRITERIA
Waterway Adequacy: N NOT APPLICABLE
Approach Roadway Align: 8 EQUAL TO PRESENT DESIRABLE CRITERIA
Bridge Railing Appraisal: 3 Meets Standards
Approach Guardrail: N/A N/A
Pier Navig Protection: N N/A

Deck Wearing Surf: A BARE DECK NO OVRLAY
Deck Membrane: F NONE
Deck Protection: A EPOXY COATED REINF
Total Deck Thick: 7.5
Last Paint Date: 10/2000

Underwater Inspection/Apraisal Information
Inspection Date:
Temperature:

Inspection Method:
Appraisal Rating:

Scour Critical Information
Evaluation Method:

Rating:
Analysis Date:

Construction Information
Year: 1963 Original 1999 Reconstructed
Route: FAI-55 Sta: 174+00 FAI 55 Sta: 14+861.73
Section Nbr: 0404-674-HB 0404-640R
Contract Nbr: 82379
Fed Aid Pr#: I 0557083274 55-7(196)279
Built By: 1 I.D.O.T. 1 I.D.O.T.

Miscellaneous
Microfilm Data Recorded: Yes

Pontis

Today's Date: 08/27/2015

Structure Number: 016-0006 District: 1 (41) Bridge Status: 1 OPEN - NO RESTRICT
 (6) Feature Crossed: SANTA FE DR (7) Facility Carried: I-55 EB STEVENSON
 (9) Location: 0.4 ME US 45 (7A) Bridge Name:
 Element Inspection Date: 08/13/2014
 (90E) Agency Program Manager: MastnySC (90E3) Consultant Program Manager:
 (90E1) Team Leader: Sedlacek JL (90E2) Inspector:

Element Insp. Delinquent		Element Insp. Delinquent Reason:								
Elem	Env	% 1	Qty 1	% 2	Qty 2	% 3	Qty 3	% 4	Qty 4	Tot Qty
Reinforced Conc Column or Pile Extension										
205	2	98	1,885	2	40	0	0	0	0	1,925
		No deterioration	Minor cracks/spalls	Delams/spalls	Analysis warranted					
Remarks: Isol Vert Crking										
Reinforced Conc Pier Wall										
210	2	100	5,047	0	0	0	0	0	0	5,047
		No deterioration	Minor cracks/spalls	Delams/spalls	Analysis warranted					
Remarks:										
Reinforced Conc Abutment										
215	2	100	1,470	0	0	0	0	0	0	1,470
		No deterioration	Minor cracks/spalls	Delams/spalls	Analysis warranted					
Remarks:										
Reinforced Conc Pier or Abutment Cap										
234	2	97	405	3	14	0	0	0	0	419
		No deterioration	Minor cracks/spalls	Delams/spalls	Analysis warranted					
Remarks: Abut) Minor horiz edge crks										
Elastomeric Bearing										
310	4	70	19	30	8	0	0	0	0	27
		No deterioration	Minor deterioration	Major deterioration						
Remarks: Lt rusting to few assys										
Fixed Bearing										
313	4	100	9	0	0	0	0	0	0	9
		No deterioration	Minor deterioration	Advanced corrosion						
Remarks:										
Concrete Bridge Railing										
331	4	100	516	0	0	0	0	0	0	516
		No deterioration	Minor cracks/spalls	Analysis warranted						
Remarks: HL Vert crks										

Concrete Deck Protected w/ Coated Bars										
8026	4	99	17,140	1	145	0	0	0	0	17,285
Remarks: WS- Trans crks w/isol intersecting; Soffit-Trans leach crks typ.										
Non-Lead Painted Steel Open Girder										
8118	4	99	30,816	1	440	0	0	0	0	31,256
Remarks: Lt-med surf rust throughout old steel										
Non-Lead Painted Steel Closed Web/Box Girder Ends										
8173	4	11	2	44	8	44	8	0	0	18
Remarks: Initial sec loss @ abuts										
Continuous Seal Neoprene Expansion Joint										
8308	4	94	198	6	12	0	0	0	0	210
Remarks: Leakage										
Approach Pavement										
8323	4	100	2	0	0	0	0	0	0	2
Remarks:										



October 27, 2015

MEMORANDUM

Mr. John Fortmann, Region One Engineer
Illinois Department of Transportation
Region One/District One

Attn: Steven Schilke

RE: Existing S.N. 016-0007
W.B. I-55 over Santa Fe Drive
Cook County
PTB 158-002/P-91-762-10

The purpose of this technical memo is to summarize the current condition of existing S.N. 016-0007 in addition to geometrics and other factors. A cursory field check was performed to supplement the information contained in IDOT's structure summary report dated August 13, 2014 (see Appendix B). Broad-based recommendations for this structure are provided below.

The structure is a three span steel girder bridge consisting of eleven lines of continuous girders (see Photo 1). Span lengths from west to east are 75'-10¹/₄", 97'-1" and 75'-10¹/₄". The superstructure is supported by pile bent abutments and reinforced concrete multi-column piers. There is no overlay on the structure.

IDOT rates the deck as being in good condition, which concurs with the findings from the cursory field check. Minor transverse cracks with leaching are visible on a majority of the soffit (see Photo 2). Minor longitudinal and transverse cracks are visible on the top of deck. IDOT rates the superstructure as being in fair condition, which concurs with the findings from the cursory field check. Minor section loss is visible at beam ends (see Photo 3). IDOT rates the substructure as being in good condition, which concurs with the findings from the cursory field check. Moderate vertical and horizontal cracking is visible on abutment seats, and pier crash walls. No notable defects or differences were observed between the cursory field check and IDOT's structure summary report for: deck geometry, underclearance vert/lat, approach alignment and bridge railing appraisal items. Anchor blocks are damaged along sections of both expansion joints (see Photo 4). Moderate diagonal cracks are visible on both approach slabs.

Based on the structure summary report and field check, S.N. 016-0007 is suitable for reuse after rehabilitation of the substructure, superstructure and expansion joints.



LIN ENGINEERING, LTD.
Consulting Engineers

Springfield, IL Westmont, IL

576 Oakmont Lane
Westmont, Illinois 60559
Telephone: (630) 323-5168
Fax: (630) 323-5174
E-mail: info@lineng.com

LIN ENGINEERING, LTD.

A handwritten signature in blue ink that reads "Michael T. Haley". The signature is written in a cursive style.

Michael T. Haley, PE, SE
Structural Manager

Appendix A – Photos

Appendix B – IDOT Structure Summary Report

Appendix C – PONTIS Report



Photo 1



Photo 2



Photo 3



Photo 4

**Illinois Department of Transportation
Structures Information Management System
Structure Summary Report**

Structure Number: 016-0007 District: 1

Inventory Data	
Facility Carried:	I-55 WB STEVENSON
Feature Crossed:	SANTA FE DR
Bridge Remarks:	DESIGN LOAD MS18&ALT
Bridge Status:	1 OPEN - NO RESTRICT
Status Remarks:	
Maint County:	016 COOK
Maint Responsibility:	01 I.D.O.T.
Service On/Under:	1 HIGHWAY
Reporting Agency:	1 I.D.O.T. - BUREAU OF MAINTENANCE
Main Span Matl/Type:	4 STEEL CONTINUOUS
Nbr Of Main Spans:	3
Nbr Of Approach Spans:	0
Approaches	
Near #1 Matl/Type:	/
Near #2 Matl/Type:	/
Far #1 Matl/Type:	/
Far #2 Matl/Type:	/
Median Width/Type:	0 Ft./0 None
Guardrail Type L/R:	0 None / 0 None
Toll Facility Indicator:	0 No Toll
Latitude:	41.76270634
Longitude:	S
Deck Structure Type:	A CIP CON NRMALLY FORM
Sidewalks Under Structure:	0 None
Inventory Rating:	1,100(39)
Operating Rating:	1,835(66)
Design Load:	99 UNKNOWN
Deck Structure Thickness:	7.5 SD: N FO: N
RR Lateral Underclear:	15.5
RR Vertical Underclear:	24 Ft 03 In

Key Route On Data	
Key Route Nbr:	FEDERAL-AID INTERSTATE
Station:	0055
Segment:	3,0200
Main Route:	00000
Linked:	Y
Natl. Hwy System:	On NHS
Township/Road Dist:	16 LYONS
Municipality:	2645 HODGKINS
Urban Area:	1051
Functional Class:	1 INTERSTATE
** CLEARANCES **	South/East North/West
Max Rdwy Width:	75.5
Horizontal:	76.7
Inventory Rating:	2014 / 68900
Est Truck Percentage:	9
Number Of Lanes:	3
One Or Two Way:	1 One-Way
Bypass Length:	0
Future AADT Yr/Cnt:	2032 / 83945
Designated Truck Rte:	CLASS I
Special Systems:	Yes

Key Route Under Data	
Main Route:	FEDERAL-AID URBAN
Station:	2719
Segment:	00000
Linked:	Y
Natl. Hwy System:	On NHS
Township/Road Dist:	16 LYONS
Municipality:	2645 HODGKINS
Urban Area:	1051
Functional Class:	5 MAJOR COLLECTOR
** CLEARANCES **	South/East North/West
Max Rdwy Width:	33.8
Horizontal:	56.0
Inventory Rating:	0.0
Est Truck Percentage:	2032 / 4738
Number Of Lanes:	2
One Or Two Way:	2 Two-Way
Bypass Length:	0
Future AADT Yr/Cnt:	2032 / 4738
Designated Truck Rte:	NONE
Special Systems:	No

**** Marked Route On Data ****		
Designation	Kind	Number
1 Mainline	1 Interstate Highway	055

**** Marked Route Under Data ****		
Designation	Kind	Number
1 Mainline	8 Other	
1 Mainline		
1 Mainline		

**Illinois Department of Transportation
Structures Information Management System
Structure Summary Report**

Structure Number: 016-0007 District: 1

Data Related to Inspection Information

*** Inspection Intervals ***
 Routine NBIS: 24 MOS Underwater: 0 MOS One Truck At A Time: 0 Combination Type 3S-1: Tons
 Special: N Single Unit Vehicles: Tons Combination Type 3S-2: Tons
 Bridge Posting Level: 5 No Posting Required

Inspection/Appraisal Information

Inspection Date: 08/13/2014 Inspection Temperature: 82Deg. F
 Deck: 7 GOOD CONDITION - SOME MINOR PROBLEMS
 Superstructure: 5 FAIR CONDITION - MINOR SECTION LOSS, CRACKS
 Substructure: 7 GOOD CONDITION - SOME MINOR PROBLEMS
 Culvert: N NOT APPLICABLE
 Channel and Protection: N NOT APPLICABLE
 Structural Evaluation: 5 BETTER THAN ADEQUATE TO BE LEFT IN PLACE
 Deck Geometry: 9 SUPERIOR TO PRESENT DESIRABLE CRITERIA
 Underclearance-Vert/Lat.: 7 BETTER THAN PRESENT MINIMUM CRITERIA
 Waterway Adequacy: N NOT APPLICABLE
 Approach Roadway Align: 8 EQUAL TO PRESENT DESIRABLE CRITERIA
 Bridge Railing Appraisal: 3 Meets Standards
 Approach Guardrail: N/A N/A
 Pier Navig Protection: N N/A

Deck Wearing Surf: A BARE DECK NO OVRLAY
 Deck Membrane: F NONE
 Deck Protection: A EPOXY COATED REINF
 Total Deck Thick: 7.5
 Last Paint Date: 05/2001
 Single Unit Vehicles: Tons
 Combination Type 3S-1: Tons
 Combination Type 3S-2: Tons
 One Truck At A Time: 0
 Last Paint Type: US
 FLD AL EPY & ACRLC
 SHP ZINC&FLD ACRYL

Underwater Inspection/Appraisal Information

Inspection Date:
 Temperature:
 Inspection Method:
 Appraisal Rating:

Scour Critical Information

Rating:
 Analysis Date:
 Evaluation Method:
 Microfilm Data Recorded: Yes

Construction Information

Year: 1963 Original 2000 Reconstructed
 Route: FAI-55 Sta: 174+00 FAI55 Sta: 14+861.73
 Section Nbr: 0404-674-HB 0404-676B-R-1
 Contract Nbr: 82969
 Fed Aid Pr#: I 0557083274 55-7(219)277
 Built By: 1 I.D.O.T. 1 I.D.O.T.

Pontis

Today's Date: 08/27/2015

Structure Number: 016-0007 District: 1 (41) Bridge Status: 1 OPEN - NO RESTRICT
 (6) Feature Crossed: SANTA FE DR (7) Facility Carried: I- 55 WB STEVENSON
 (9) Location: 0.4 M E US 45 (7A) Bridge Name:
 Element Inspection Date: 08/13/2014
 (90E) Agency Program Manager: MastnySC (90E3) Consultant Program Manager:
 (90E1) Team Leader: SedlacekJL (90E2) Inspector:

Element Insp. Delinquent		Element Insp. Delinquent Reason:								
Element Description										
Elem	Env	% 1	Qty 1	% 2	Qty 2	% 3	Qty 3	% 4	Qty 4	Tot Qty
Reinforced Conc Column or Pile Extension										
205	2	100	2,501	0	0	0	0	0	0	2,501
		No deterioration	Minor cracks/spalls	Delams/spalls	Analysis warranted					
Remarks:										
Reinforced Conc Pier Wall										
210	2	100	6,505	0	0	0	0	0	0	6,505
		No deterioration	Minor cracks/spalls	Delams/spalls	Analysis warranted					
Remarks:										
Reinforced Conc Abutment										
215	2	95	1,714	5	86	0	0	0	0	1,800
		No deterioration	Minor cracks/spalls	Delams/spalls	Analysis warranted					
Remarks: Backwall) HL vert leach crks										
Reinforced Conc Pier or Abutment Cap										
234	2	96	501	4	20	0	0	0	0	521
		No deterioration	Minor cracks/spalls	Delams/spalls	Analysis warranted					
Remarks: Abut) Scattered Hor edge crks										
Elastomeric Bearing										
310	4	22	8	78	28	0	0	0	0	36
		No deterioration	Minor deterioration	Major deterioration						
Remarks: Lt rust to assemblies.										
Fixed Bearing										
313	4	100	12	0	0	0	0	0	0	12
		No deterioration	Minor deterioration	Advanced corrosion						
Remarks:										
Concrete Bridge Railing										
331	4	100	487	0	0	0	0	0	0	487
		No deterioration	Minor cracks/spalls	Analysis warranted						
Remarks: HL Vert crks										

Concrete Deck Protected w/ Coated Bars										
8026	4	99	20,772	1	254	0	0	0	0	21,026
Remarks: (WS) Trans crking w/soil intersecting long crks; Soffit)Trans leach crks typ.										
Non-Lead Painted Steel Open Girder										
8118	4	99	40,090	1	560	0	0	0	0	40,650
Remarks: Lt-med surf rust.										
Non-Lead Painted Steel Closed Web/Box Girder Ends										
8173	4	33	8	50	12	17	4	0	0	24
Remarks: Init sec loss @ bm ends. Minor Spkld rust @ bott flanges.										
Continuous Seal Neoprene Expansion Joint										
8308	4	99	263	1	4	0	0	0	0	267
Remarks: Leakage. East Neop Jnt- Lane 1 - 4ft damaged.										
Approach Pavement										
8323	4	100	2	0	0	0	0	0	0	2
Remarks:										



October 27, 2015

MEMORANDUM

Mr. John Fortmann, Region One Engineer
Illinois Department of Transportation
Region One/District One

Attn: Steven Schilke

RE: Existing S.N. 016-0008
E.B. I-55 over BNSF Railway Separation
Cook County
PTB 158-002/P-91-762-10

The purpose of this technical memo is to summarize the current condition of existing S.N. 016-0008 in addition to geometrics and other factors. A cursory field check was performed to supplement the information contained in IDOT's structure summary report dated August 12, 2015 (see Appendix B). Broad-based recommendations for this structure are provided below.

The structure is a three span continuous steel girder bridge (see Photo 1). Span lengths from west to east are 70'-6⁷/₈", 106'-11¹/₈" and 70'-6⁷/₈". The superstructure is supported by pile bent abutments and reinforced concrete multi-column piers on crashwalls. There is no overlay on the structure.

A BNSF ROW fence prevented access to view the deck soffit, superstructure, substructure and underclearance vert/lat. IDOT rates the deck as being in good condition, which concurs with the findings from the cursory field check. Minor transverse cracks are visible on a majority of the top of deck. No notable defects or differences were observed between the cursory field check and IDOT's structure summary report for: deck geometry, approach alignment and bridge railing appraisal items. Anchor blocks are damaged or missing along sections of both expansion joints (see Photo 2). A small section of the west approach parapet is spalled with exposed reinforcing bars (see Photo 3).

Based on the structure summary report and field check, S.N. 016-0008 is suitable for reuse after rehabilitation of the substructure, superstructure and expansion joints. The damaged section of approach parapet should be repaired.



LIN ENGINEERING, LTD.
Consulting Engineers

Springfield, IL Westmont, IL

576 Oakmont Lane
Westmont, Illinois 60559
Telephone: (630) 323-5168
Fax: (630) 323-5174
E-mail: info@lineng.com

LIN ENGINEERING, LTD.

A handwritten signature in blue ink that reads "Michael T. Haley". The signature is written in a cursive, flowing style.

Michael T. Haley, PE, SE
Structural Manager

Appendix A – Photos

Appendix B – IDOT Structure Summary Report

Appendix C – PONTIS Report



Photo 1



Photo 2

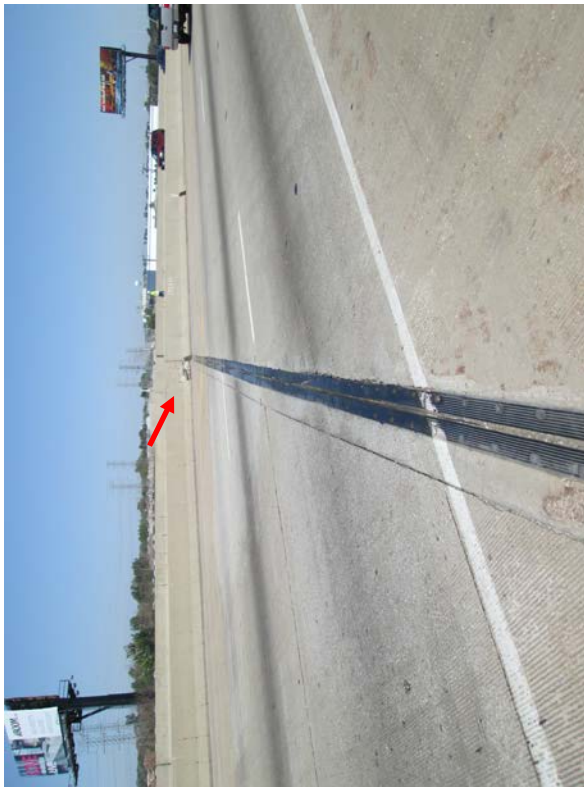


Photo 3

Illinois Department of Transportation
Structures Information Management System
Structure Summary Report

Structure Number: 016-0008 District: 1

Inventory Data	
Facility Carried:	I-55 EB STEVENSON
Feature Crossed:	RR - BNSF
Bridge Remarks:	DESIGN LOAD MS18&ALT
Bridge Status:	1 OPEN - NO RESTRICT
Status Remarks:	PER KRAMARZ
Maint County:	016 COOK
Maint Responsibility:	01 I.D.O.T.
Service On/Under:	1 HIGHWAY
Reporting Agency:	1 I.D.O.T. - BUREAU OF MAINTENANCE
Main Span Matl/Type:	4 STEEL CONTINUOUS
Nbr Of Main Spans:	3
Nbr Of Approach Spans:	0
Approaches	
Near #1 Matl/Type:	/
Near #2 Matl/Type:	/
Far #1 Matl/Type:	/
Far #2 Matl/Type:	/
Median Width/Type:	0 Ft. / 0
Guardrail Type L/R:	0 None / 0
Toll Facility Indicator:	0 No Toll
Latitude:	41.76291793
Longitude:	S
Deck Structure Type:	A CIP CON NRMALLY FORM
Sidewalks Under Structure:	0 None
Bridge Name:	0.6 M E US 45
Location:	02/2000
Status Date:	16 LYONS
Maint Township:	2 / RAILROAD
Sufficiency Rating:	71.0
HBP Eligible:	Yes
Replaces By:	- Length of Long Span: 106.9
Last Update Date:	06/21/2014
Parallel Structure:	Right Deck Width: 68.4
Multi-Level Structure Nbr:	Sidewalk Width Right: 0.0
Skew Direction:	L
Skew Angle:	42 D
Structure Flared:	No
Historical Significance:	No
Border Bridge State:	
Bdr State SN:	
Bdr State % Responsibility:	0
Structural Steel Wt:	862000
Substructure Material:	
Rated By:	2 IDOT
Load Rating Date:	01/11/2001
Design Load:	99 UNKNOWN
Deck Structure Thickness:	7.5 SD: Y FC: N
RR Vertical Underclear:	23 Ft
RR Lateral Underclear:	06 In
RR Crossing 1 Nbr:	
RR Crossing 2 Nbr:	
Key Route On Data	
Key Route Nbr:	FEDERAL-AID INTERSTATE
Station:	0055
Segment:	3,1400
Appurtenances Main Route:	00000
Inventory County:	016 COOK
Township/Road Dist:	16 LYONS
Municipality:	2645 HODGKINS
Urban Area:	1051
Functional Class:	1 INTERSTATE
** CLEARANCES **	South/East North/West
Max Rdwy Width:	65.3
Horizontal:	66.5
Vertical:	0.0
Natl. Hwy System:	On NHS
Inventory Direction:	
Curr AADT Yr/Count:	2014 / 77600
Est Truck Percentage:	8
Number Of Lanes:	3
One Or Two Way:	1 One-Way
Bypass Length:	0
Future AADT Yr/Cnt:	2032 / 83945
Designated Truck Rte:	CLASS I
Special Systems:	Yes
Station:	
Segment:	
Linked:	
Natl. Hwy System:	
Inventory Direction:	
Curr AADT Yr/Count:	/
Est Truck Percentage:	
Number Of Lanes:	
One Or Two Way:	
Bypass Length:	
Future AADT Yr/Cnt:	/
Designated Truck Rte:	
Special Systems:	

**** Marked Route On Data ****		
Designation	Kind	Number
1 Mainline	1 Interstate Highway	055
1 Mainline		
1 Mainline		

Illinois Department of Transportation
Structures Information Management System
Structure Summary Report

Structure Number: 016-0008 District: 1

*** Inspection Intervals ***
Routin e NBIS: 12 MOS Underwater: 0 MOS One Truck At A Time: 0 Tons Bridge Posting Level: 5 No Posting Required
Special: N Single Unit Vehicles: Tons Combination Type 3S-1: Tons Combination Type 3S-2: Tons

Data Related to Inspection Information
*** Maximum Allowable Posting Limits ***

Inspection/Apraisal Information
81Deg. F

Inspection Date: 08/12/2015 Inspection Temperature: 81Deg. F
Deck: 7 GOOD CONDITION - SOME MINOR PROBLEMS
Superstructure: 4 POOR CONDITION - ADVANCED DETERIORATION
Substructure: 7 GOOD CONDITION - SOME MINOR PROBLEMS
Culvert: N NOT APPLICABLE
Channel and Protection: N NOT APPLICABLE
Structural Evaluation: 4 MINIMUM ADEQUACY TO BE LEFT IN PLACE
Deck Geometry: 9 SUPERIOR TO PRESENT DESIRABLE CRITERIA
Underclearance-Vert/Lat.: 7 BETTER THAN PRESENT MINIMUM CRITERIA
Waterway Adequacy: N NOT APPLICABLE
Approach Roadway Align: 8 EQUAL TO PRESENT DESIRABLE CRITERIA
Bridge Railing Appraisal: 3 Meets Standards
Approach Guardrail: N/A N/A
Pier Navig Protection: N N/A

Deck Wearing Surf: A BARE DECK NO OVRLAY
Deck Membrane: F NONE
Deck Protection: A EPOXY COATED REINF
Total Deck Thick: 7.5
Last Paint Date: 10/2000

Underwater Inspection/Apraisal Information

Inspection Date: Inspection Method: Appraisal Rating:

Scour Critical Information
Evaluation Method: Microfilm Data Recorded: Yes

Construction Information

Year: 1964 Original 1999 Reconstructed
Route: FAI-55 Sta: 179+85.65 FAI55 Sta: 15+041.71
Section Nbr: 0404-606-VB 0404-640ETC.
Contract Nbr: 82379
Fed Aid Pr#: IG 0557084274 55-7(196)279
Built By: 1 I.D.O.T. 1 I.D.O.T.

Pontis

Today's Date: 08/27/2015

Structure Number: 016-0008 District: 1 (41) Bridge Status: 1 OPEN - NO RESTRICT
 (6) Feature Crossed: RR - BNSF (7) Facility Carried: I-55 EB STEVENSON
 (9) Location: 0.6 M E US 45 (7A) Bridge Name:
 Element Inspection Date: 08/12/2015
 (90E) Agency Program Manager: AsfourSE (90E3) Consultant Program Manager:
 (90E1) Team Leader: SalaymehTA (90E2) Inspector:

Element Insp. Delinquent		Element Insp. Delinquent Reason:								
Elem	Env	% 1	Qty 1	% 2	Qty 2	% 3	Qty 3	% 4	Qty 4	Tot Qty
Reinforced Conc Column or Pile Extension										
205	2	100	1,442	0	0	0	0	0	0	1,442
		No deterioration	Minor cracks/spalls	Delams/spalls	Analysis warranted					
Remarks:										
Reinforced Conc Pier Wall										
210	2	100	5,177	0	0	0	0	0	0	5,177
		No deterioration	Minor cracks/spalls	Delams/spalls	Analysis warranted					
Remarks: Vert crking below columns; Horiz edge crks @ SE P #2										
Reinforced Conc Abutment										
215	2	100	1,812	0	0	0	0	0	0	1,812
		No deterioration	Minor cracks/spalls	Delams/spalls	Analysis warranted					
Remarks:										
Reinforced Conc Pier or Abutment Cap										
234	2	93	338	7	24	0	0	0	0	362
		No deterioration	Minor cracks/spalls	Delams/spalls	Analysis warranted					
Remarks: Abut- Several epoxy sealed crks; Pier-Few small map crked and spalled areas SE P#2										
Elastomeric Bearing										
310	4	89	24	11	3	0	0	0	0	27
		No deterioration	Minor deterioration	Major deterioration						
Remarks: Initial rusting @ few assemblies										
Fixed Bearing										
313	4	100	9	0	0	0	0	0	0	9
		No deterioration	Minor deterioration	Advanced corrosion						
Remarks:										
Concrete Bridge Railing										
331	4	99	495	0	0	1	6	0	0	501
		No deterioration	Minor cracks/spalls	Analysis warranted						
Remarks: HL vert crks										

Concrete Deck Protected w/ Coated Bars										
8026	4	99	16,970	1	180	0	0	0	0	17,150
Remarks: WS-Trans crks; few intersecting; Soffit- HL trans leach crks										
Non-Lead Painted Steel Open Girder										
8118	4	91	26,706	8	2,200	1	400	0	10	29,316
Remarks: Old steel has Lt-med surf rust; Flaking rust on cross bracing throughout; 10 % Section loss (>1/16") on Lwr Flange Bm 1.										
Non-Lead Painted Steel Closed Web/Box Girder Ends										
8173	4	11	2	72	13	6	.1	11	2	18
Remarks: Initial sect loss @ several bm ends; Bms 4,6 have >10% (or 1/16"); Small Hole Bm 1 @ W Abut End.										
Continuous Seal Neoprene Expansion Joint										
8308	4	93	170	7	12	0	0	0	0	182
Remarks: Leakage										
Approach Pavement										
8323	4	50	1	50	1	0	0	0	0	2
Remarks:										



October 27, 2015

MEMORANDUM

Mr. John Fortmann, Region One Engineer
Illinois Department of Transportation
Region One/District One

Attn: Steven Schilke

RE: Existing S.N. 016-0009
W.B. I-55 over BNSF Railway Separation
Cook County
PTB 158-002/P-91-762-10

The purpose of this technical memo is to summarize the current condition of existing S.N. 016-0009 in addition to geometrics and other factors. A cursory field check was performed to supplement the information contained in IDOT's structure summary report dated August 12, 2015 (see Appendix B). Broad-based recommendations for this structure are provided below.

The structure is a three span continuous steel girder bridge (see Photo 1). Span lengths from west to east are 70'-6⁷/₈", 106'-11¹/₈" and 70'-6⁷/₈". The superstructure is supported by pile bent abutments and reinforced concrete multi-column piers on crashwalls. There is no overlay on the structure.

A BNSF ROW fence prevented access to view the deck soffit, superstructure, substructure and underclearance vert/lat. IDOT rates the deck as being in good condition, which concurs with the findings from the cursory field check. Minor transverse cracks are visible on a majority of the top of deck. No notable defects or differences were observed between the cursory field check and IDOT's structure summary report for: deck geometry, approach alignment and bridge railing appraisal items. Anchor blocks are damaged or missing along sections of both expansion joints (see Photo 2). Moderate diagonal cracks are visible on both approach slabs.

Based on the structure summary report and field check, S.N. 016-0009 is suitable for reuse after rehabilitation of the superstructure and expansion joints.



LIN ENGINEERING, LTD.
Consulting Engineers

Springfield, IL Westmont, IL

576 Oakmont Lane
Westmont, Illinois 60559
Telephone: (630) 323-5168
Fax: (630) 323-5174
E-mail: info@lineng.com

LIN ENGINEERING, LTD.

A handwritten signature in blue ink that reads "Michael T. Haley". The signature is written in a cursive style.

Michael T. Haley, PE, SE
Structural Manager

Appendix A – Photos

Appendix B – IDOT Structure Summary Report

Appendix C – PONTIS Report



Photo 1



Photo 2

Illinois Department of Transportation
Structures Information Management System
Structure Summary Report

Structure Number: 016-0009 District: 1

Inventory Data	
Facility Carried:	I-55 WB STEVENSON
Feature Crossed:	RR - BNSF
Bridge Remarks:	DESIGN LOAD MS18&ALT
Bridge Status:	1 OPEN - NO RESTRICT
Status Remarks:	
Maint County:	016 COOK
Maint Responsibility:	01 I.D.O.T.
Service On/Under:	1 HIGHWAY
Reporting Agency:	1 I.D.O.T. - BUREAU OF MAINTENANCE
Main Span Matl/Type:	4 STEEL CONTINUOUS
Nbr Of Main Spans:	3
Nbr Of Approach Spans:	0
Approaches	
Near #1 Matl/Type:	/
Near #2 Matl/Type:	/
Far #1 Matl/Type:	/
Far #2 Matl/Type:	/
Median Width/Type:	0 Ft. / 0 None
Guardrail Type L/R:	0 None / 0 None
Toll Facility Indicator:	0 No Toll
Latitude:	41.76286597 S Longitude: 87.65878818 S
Deck Structure Type:	A CIP CON NRMILLY FORM
Sidewalks Under Structure:	0 None
Inventory Rating:	1,100(39)
Operating Rating:	1,830(65)
Design Load:	99 UNKNOWN
Deck Structure Thickness:	7.5 SD: Y FO: N
RR Vertical Underclear:	23 Ft 06 In
RR Lateral Underclear:	16.9
RR Crossing 1 Nbr:	
RR Crossing 1 Underclear:	
RR Crossing 2 Nbr:	
RR Crossing 2 Underclear:	
Key Route On Data	
Key Route Nbr:	FEDERAL-AID INTERSTATE
Station:	0055
Segment:	3,1200
Appurtenances:	Main Route
Inventory County:	016 COOK
Linked:	Y
Township/Road Dist:	16 LYONS
Natl. Hwy System:	On NHS
Municipality:	2645 HODGKINS
Inventory Direction:	
Urban Area:	1051
Urban Area:	1051
Functional Class:	1 INTERSTATE
Inventory Direction:	North/West
Est AADT Yr/Count:	2014 / 77600
Est Truck Percentage:	8
Number Of Lanes:	3
One Or Two Way:	1 One-Way
Bypass Length:	0
Future AADT Yr/Cnt:	2032 / 83945
Designated Truck Rte:	CLASS I
Special Systems:	Yes
Laterals:	
Designation:	1 Interstate Highway
Kind:	Number
Route #1:	1 Mainline
Route #2:	1 Mainline
Route #3:	1 Mainline
Number:	055

Key Route Under Data	
Station:	
Segment:	
Linked:	
Natl. Hwy System:	
Inventory Direction:	
Curr AADT Yr/Count:	/
Est Truck Percentage:	
Number Of Lanes:	
One Or Two Way:	
Bypass Length:	
Future AADT Yr/Cnt:	/
Designated Truck Rte:	
Special Systems:	
Designation:	*** Marked Route Under Data ***
Kind:	Number

**Illinois Department of Transportation
Structures Information Management System
Structure Summary Report**

Structure Number: 016-0009 **District: 1**

Data Related to Inspection Information

*** Inspection Intervals *** *** Maximum Allowable Posting Limits ***

Routine NBIS:	12 MOS	Underwater:	0 MOS	One Truck At A Time:	0	Combination Type 3S-1:	Tons	Bridge Posting Level:	5	No Posting Required
Special:	N	Special:	N	Single Unit Vehicles:	Tons	Combination Type 3S-2:	Tons			

Inspection/Appraisal Information

Inspection Date:	08/12/2015	Inspection Temperature:	81Deg. F	Single Unit Vehicles:	0	Actual Posted Limits **	Tons
Deck:	7	GOOD CONDITION - SOME MINOR PROBLEMS		Combination Type 3S-1:	Tons		
Superstructure:	4	POOR CONDITION - ADVANCED DETERIORATION		Combination Type 3S-2:	Tons		
Substructure:	7	GOOD CONDITION - SOME MINOR PROBLEMS		One Truck At A Time:	0		
Culvert:	N	NOT APPLICABLE		Deck Wearing Surf:	A	BARE DECK NO OVRLAY	CU
Channel and Protection:	N	NOT APPLICABLE		Deck Membrane:	F	NONE	LD SHP GRN&AL FNL
Structural Evaluation:	4	MINIMUM ADEQUACY TO BE LEFT IN PLACE		Deck Protection:	A	EPOXY COATED REINF	
Deck Geometry:	9	SUPERIOR TO PRESENT DESIRABLE CRITERIA		Total Deck Thick:	7.5		
Underclearance-Vert/Lat.:	7	BETTER THAN PRESENT MINIMUM CRITERIA		Last Paint Date:	05/2001		
Waterway Adequacy:	N	NOT APPLICABLE					
Approach Roadway Align:	8	EQUAL TO PRESENT DESIRABLE CRITERIA					
Bridge Railing Appraisal:	3	Meets Standards					
Approach Guardrail:	NNN	N/A	N/A				
Pier Navig Protection:	N	N/A	N/A				

Underwater Inspection/Appraisal Information

Inspection Date: Inspection Method: Appraisal Rating:

Temperature: Appraisal Rating:

Scour Critical Information

Rating: Evaluation Method: Microfilm Data Recorded: Yes

Analysis Date:

Construction Information

Year:	1964	Original	2000	Reconstructed	
Route:	FAI-55	Sta: 179+85.65	FAI-55	Sta: 15+041.71	
Section Nbr:	0404-606-VB		0404-676B-R-1		
Contract Nbr:			82969		
Fed Aid Pr#: 1	IG 0557084274		55-7(219)277		
Built By:	I.D.O.T.		1	I.D.O.T.	

Miscellaneous

Pontis

Today's Date: 08/27/2015

Structure Number: 016-0009 District: 1 (41) Bridge Status: 1 OPEN - NO RESTRICT
 (6) Feature Crossed: RR - BNSF (7) Facility Carried: I- 55 WB STEVENSON
 (9) Location: 0.6 M E US 45 (7A) Bridge Name:
 Element Inspection Date: 08/12/2015
 (90E) Agency Program Manager: AsfourSE (90E3) Consultant Program Manager:
 (90E1) Team Leader: SalaymehTA (90E2) Inspector:

Element Insp. Delinquent		N		Element Insp. Delinquent Reason:						
Elem	Env	% 1	Qty 1	% 2	Qty 2	% 3	Qty 3	% 4	Qty 4	Tot Qty
Reinforced Conc Column or Pile Extension										
205	2	100	1,649	0	0	0	0	0	0	1,649
		No deterioration	Minor cracks/spalls	Delams/spalls	Analysis warranted					
Remarks:										
Reinforced Conc Pier Wall										
210	2	100	5,228	0	4	0	0	0	0	5,232
		No deterioration	Minor cracks/spalls	Delams/spalls	Analysis warranted					
Remarks: Pier 1@ Bm#2 East Face - HL horiz leach crks.										
Reinforced Conc Abutment										
215	2	100	1,812	0	0	0	0	0	0	1,812
		No deterioration	Minor cracks/spalls	Delams/spalls	Analysis warranted					
Remarks:										
Reinforced Conc Pier or Abutment Cap										
234	2	100	418	0	0	0	0	0	0	418
		No deterioration	Minor cracks/spalls	Delams/spalls	Analysis warranted					
Remarks:										
Elastomeric Bearing										
310	4	87	26	13	4	0	0	0	0	30
		No deterioration	Minor deterioration	Major deterioration						
Remarks: Initial rusting @ few assemblies										
Fixed Bearing										
313	4	100	10	0	0	0	0	0	0	10
		No deterioration	Minor deterioration	Advanced corrosion						
Remarks:										
Concrete Bridge Railing										
331	4	100	502	0	0	0	0	0	0	502
		No deterioration	Minor cracks/spalls	Analysis warranted						
Remarks: HL vert crking										

Concrete Deck Protected w/ Coated Bars										
8026	4	99	19,259	1	110	0	0	0	0	19,369
Remarks: WS-Trans crks; few intersecting cracks; Soffit- HL trans leach crks. W Abut- Bm#4- small spall.										
Non-Lead Painted Steel Open Girder										
8118	4	89	25,693	8	2,400	2	600	0	60	28,753
Remarks: Lt-med surf rust										
Non-Lead Painted Steel Closed Web/Box Girder Ends										
8173	4	30	6	70	14	0	0	0	0	20
Remarks: Bm Ends painted-Initial sect loss @ bm ends. Pitting @ W Abut Bm#5 stiffeners. E Abut Bm#5 hole in diaph.										
Continuous Seal Neoprene Expansion Joint										
8308	4	94	196	0	0	6	12	0	0	208
Remarks: Leakage. West Neop Jnt 12 ft missing @ Lane 2.										
Approach Pavement										
8323	4	50	1	50	1	0	0	0	0	2
Remarks:										



October 27, 2015

MEMORANDUM

Mr. John Fortmann, Region One Engineer
Illinois Department of Transportation
Region One/District One

Attn: Steven Schilke

RE: Existing S.N. 016-0012
W.B. I-55 over CSXT RR
Cook County
PTB 158-002/P-91-762-10

The purpose of this technical memo is to summarize the current condition of existing S.N. 016-0012 in addition to geometrics and other factors. A cursory field check was performed to supplement the information contained in IDOT's structure summary report dated August 22, 2014 (see Appendix B). Broad-based recommendations for this structure are provided below.

The structure is a four span steel beam bridge consisting of eleven lines of continuous beams (see Photo 1). Span lengths from west to east are 50'-0", 60'-0", 60'-0" and 50'-0". The superstructure is supported by pile bent abutments and reinforced concrete multi-column piers on crashwalls. There is no overlay on the structure.

IDOT rates the deck as being in good condition, which concurs with the findings from the cursory field check. Minor transverse cracks are visible throughout the top of deck and soffit. IDOT rates the superstructure as being in fair condition, which concurs with the findings from the cursory field check. Minor rusting is visible on the top and bottom flanges of all beams. Pitting is visible on some beam ends (see Photo 2). IDOT rates the substructure as being in good condition, which concurs with the findings from the cursory field check. Minor vertical cracking is visible along the abutments and piers. No notable defects or differences were observed between the cursory field check and IDOT's structure summary report for: deck geometry, underclearance vert/lat, approach alignment, and bridge railing appraisal. Minor to moderate longitudinal and transverse cracks are visible on both approach slabs (see Photo 3).

Based on the structure summary report and field check, S.N. 016-0012 is suitable for reuse after rehabilitation of the superstructure. The approach guardrail transitions should be brought up to current IDOT standards.



LIN ENGINEERING, LTD.
Consulting Engineers

Springfield, IL Westmont, IL

576 Oakmont Lane
Westmont, Illinois 60559
Telephone: (630) 323-5168
Fax: (630) 323-5174
E-mail: info@lineng.com

LIN ENGINEERING, LTD.

A handwritten signature in blue ink that reads "Michael T. Haley". The signature is fluid and cursive.

Michael T. Haley, PE, SE
Structural Manager

Appendix A – Photos

Appendix B – IDOT Structure Summary Report

Appendix C – PONTIS Report



Photo 1



Photo 2



Photo 3

**Illinois Department of Transportation
Structures Information Management System
Structure Summary Report**

Structure Number: 016-0012 District: 1

Inventory Data	
Facility Carried: I-55 WB STEVENSON	Bridge Name: 85.0 Structure Length: 224.0
Feature Crossed: RR - CSXT	HBP Eligible: No AASHTO Bridge Length: 99.9
Bridge Remarks: DESIGN LOAD MS18&ALT	Replaces By: - Length of Long Span: 60.0
Bridge Status: 1 OPEN - NO RESTRICT	Replaces: - Bridge Roadway Width: 66.8
Status Remarks:	Last Update Date: 06/21/2014 Appr Roadway Width: 60.0
Maint County: 016 COOK	Left Deck Width: 70.0
Maint Responsibility: 01 I.D.O.T.	Sidewalk Width Right: 0.0
Service On/Under: 1 HIGHWAY	Left Sidewalk Width Left: 0.0
Reporting Agency: 1 I.D.O.T. - BUREAU OF MAINTENANCE	Navigation Control: N N/A
Main Span Matl/Type: 4 STEEL CONTINUOUS	Structure Flared: No Navigation Horiz Clear: 0
Nbr Of Main Spans: 4	Historical Significance: No Navigation Vert Clear: 0
Approaches	Border Bridge State: Culvert Fill Depth: 0.0
Near #1 Matl/Type:	Bdr State SN: Number Culvert Cells: 0
Near #2 Matl/Type:	Bdr State % Responsibility: 0 Culvert Opening Area: 0.0
Far #1 Matl/Type:	Structural Steel Wt: 656000 Culvert Cell Height: 0.00
Far #2 Matl/Type:	Substructure Material: Culvert Cell Width: 0.00
Median Width/Type: 0 Ft. / 0 None	Rated By: 2 IDOT Rate Method: 6
Guardrail Type L/R: 0 None / 0 None	Load Rating Date: 11/14/2001
Toll Facility Indicator: 0 No Toll	Crossing 1 Nbr: Railroad Crossing Info
Latitude: 41.78379522 S Longitude: 87.83048108 S	Crossing 1 Nbr: Crossing 1 Nbr:
Deck Structure Type: A CIP CON NRMLLY FORM	Design Load: 99 UNKNOWN
Sidewalks Under Structure: 0 None	Deck Structure Thickness: 7.5 SD: N FC: N
	RR Vertical Underclear: 23 Ft 00 In

Key Route On Data	
Key Route Nbr: FEDERAL-AID INTERSTATE	Station: 0055
Appurtenances Main Route	Segment: 00000
Inventory County: 016 COOK	Linked: Y
Township/Road Dist 16 LYONS	Natl. Hwy System: On NHS
Municipality 5620 SUMMIT	Inventory Direction:
Urban Area: 1051	Curr AADT Yr/Count: 2014 / 77600
Functional Class: 1 INTERSTATE	Est Truck Percentage: 8
** CLEARANCES ** South/East North/West	Number Of Lanes: 3
Max Rdwy Width: 66.8	One Or Two Way: 1 One-Way
Horizontal: 68.0	Bypass Length: 0
	Future AADT Yr/Cnt: 2032 / 83945
	Designated Truck Rte: CLASS I
	Special Systems: Yes
Laterals:	
Key Route Under Data	
Station:	
Segment:	
Linked:	
Natl. Hwy System:	
Inventory Direction:	
Curr AADT Yr/Count:	/
Est Truck Percentage:	
Number Of Lanes:	
One Or Two Way:	
Bypass Length:	
Future AADT Yr/Cnt:	/
Designated Truck Rte:	
Special Systems:	

**** Marked Route On Data ****		
Designation	Kind	Number
Route #1: 1 Mainline	1 Interstate Highway	055
Route #2: 1 Mainline		
Route #3: 1 Mainline		

**Illinois Department of Transportation
Structures Information Management System
Structure Summary Report**

Structure Number: 016-0012 **District: 1**

Data Related to Inspection Information

*** Inspection Intervals *** *** Maximum Allowable Posting Limits *** Bridge Posting Level:

Routine NBIS: 24 MOS	Underwater: 0 MOS	One Truck At A Time: 0	Combination Type 3S-1: Tons	5	No Posting Required
Special: N	Single Unit Vehicles: Tons	Combination Type 3S-2: Tons			

Inspection/Appraisal Information

Inspection Date: 08/22/2014 Inspection Temperature: 86Deg. F ** Actual Posted Limits **

Deck: 7 GOOD CONDITION - SOME MINOR PROBLEMS Single Unit Vehicles: Tons

Superstructure: 5 FAIR CONDITION - MINOR SECTION LOSS, CRACKS Combination Type 3S-1: Tons

Substructure: 7 GOOD CONDITION - SOME MINOR PROBLEMS Combination Type 3S-2: Tons

Culvert: N NOT APPLICABLE One Truck At A Time: 0

Channel and Protection: N NOT APPLICABLE Last Paint Type: CU

Structural Evaluation: 5 BETTER THAN ADEQUATE TO BE LEFT IN PLACE Deck Wearing Surf: A BARE DECK NO OVRLAY LD SHP GRN&AL FNL

Deck Geometry: 9 SUPERIOR TO PRESENT DESIRABLE CRITERIA Deck Membrane: F NONE

Underclearance-Vert/Lat.: 4 MINIMUM ADEQUACY TO BE LEFT IN PLACE Deck Protection: A EPOXY COATED REINF

Waterway Adequacy: N NOT APPLICABLE Total Deck Thick: 7.5

Approach Roadway Align: 8 EQUAL TO PRESENT DESIRABLE CRITERIA Last Paint Date: 05/2001

Bridge Railing Appraisal: 3 Meets Standards N/A

Approach Guardrail: 23N Not Acceptable Acceptable

Pier Navig Protection: N N/A

Underwater Inspection/Appraisal Information

Inspection Date: Inspection Method: Appraisal Rating:

Temperature: Evaluation Method:

Scour Critical Information

Rating: Evaluation Method: Microfilm Data Recorded: Yes

Analysis Date:

Construction Information

Year: 1963	Original	2000	Reconstructed
Route: FAI-55	Sta: 280+17.71	FAI-55	Sta: 18+539.815
Section Nbr: 0505-607-VB		0404-640,ETC	
Contract Nbr:		82458	
Fed Aid Pr#: IG 0557067276		55-7(176)279	
Built By: 1	I.D.O.T.	1	I.D.O.T.

Pontis

Today's Date: 08/27/2015

Structure Number: 016-0012 District: 1 (41) Bridge Status: 1 OPEN - NO RESTRICT
 (6) Feature Crossed: RR - CSXT (7) Facility Carried: I- 55 WB STEVENSON
 (9) Location: 2.2 M SW ILL 43 (7A) Bridge Name:
 Element Inspection Date: 08/22/2014
 (90E) Agency Program Manager: MastnySC (90E3) Consultant Program Manager:
 (90E1) Team Leader: SedlacekJL (90E2) Inspector:

Element Insp. Delinquent		Element Insp. Delinquent Reason:									
Elem	Env	% 1	Qty 1	% 2	Qty 2	% 3	Qty 3	% 4	Qty 4	Tot Qty	
Reinforced Conc Column or Pile Extension											
205	4	100	2,195	0	10	0	0	0	0	2,205	
		No deterioration	Minor cracks/spalls	Delams/spalls	Analysis warranted						
Remarks: Isol small HPs @ P1 Col2; HL spider cracking											
Reinforced Conc Pier Wall											
210	4	100	4,707	0	0	0	0	0	0	4,707	
		No deterioration	Minor cracks/spalls	Delams/spalls	Analysis warranted						
Remarks: Scattered HL vert crks											
Reinforced Conc Abutment											
215	4	100	1,298	0	0	0	0	0	0	1,298	
		No deterioration	Minor cracks/spalls	Delams/spalls	Analysis warranted						
Remarks: Scattered HL vert leach crks @ Backwalls											
Reinforced Conc Pier or Abutment Cap											
234	4	99	348	1	2	0	0	0	0	350	
		No deterioration	Minor cracks/spalls	Delams/spalls	Analysis warranted						
Remarks: Isol HP under cap @ P1											
Prefomed Joint Seal											
302	4	100	141	0	0	0	0	0	0	141	
		No deterioration	Minor deterioration	Major deterioration							
Remarks: Debris filled											
Elastomeric Bearing											
310	4	91	40	9	4	0	0	0	0	44	
		No deterioration	Minor deterioration	Major deterioration							
Remarks: East Abut- Brgs 6,7 & 9 rusted.											
Fixed Bearing											
313	4	100	11	0	0	0	0	0	0	11	
		No deterioration	Minor deterioration	Advanced corrosion							
Remarks:											

Concrete Bridge Railing										
331	4	100	443	0	0	0	0	0	0	443
		No deterioration	Minor cracks/spalls	Analysis warranted						
Remarks: HL vert leach crks										
Concrete Deck Protected w/ Coated Bars										
8026	4	98	15,222	2	278	0	0	0	0	15,500
Remarks: Wrg Surf- HL-Nar Trans crking; Soffit) Scattered HL trans leach crks										
Non-Lead Painted Steel Open Girder										
8118	4	97	21,072	3	618	0	0	0	0	21,690
Remarks: Med rust along upper flange edges throughout except @ new beams; Old fascias have init-med web/flange rust										
Non-Lead Painted Steel Closed Web/Box Girder Ends										
8173	4	82	18	18	4	0	0	0	0	22
Remarks: Few old beam ends have inactive pitting with init rusting after being repainted										
Approach Pavement										
8323	4	100	2	0	0	0	0	0	0	2
Remarks: Nar-med random crking @ both										



October 27, 2015

MEMORANDUM

Mr. John Fortmann, Region One Engineer
Illinois Department of Transportation
Region One/District One

Attn: Steven Schilke

RE: Existing S.N. 016-0013
E.B. I-55 over CSXT RR
Cook County
PTB 158-002/P-91-762-10

The purpose of this technical memo is to summarize the current condition of existing S.N. 016-0013 in addition to geometrics and other factors. A cursory field check was performed to supplement the information contained in IDOT's structure summary report dated August 22, 2014 (see Appendix B). Broad-based recommendations for this structure are provided below.

The structure is a four span steel girder bridge consisting of eleven lines of continuous girders (see Photo 1). Span lengths from west to east are 50'-0", 60'-0", 60'-0" and 50'-0". The superstructure is supported by pile bent abutments and reinforced concrete multi-column piers on crashwalls. There is no overlay on the structure.

IDOT rates the deck as being in good condition, which concurs with the findings from the cursory field check. Minor transverse cracks with leaching are visible on a majority of the soffit. IDOT rates the superstructure as being in fair condition, which concurs with the findings from the cursory field check. Minor to moderate rusting is visible on the top and bottom flanges of interior beams. Pitting is visible on some beam ends (see Photo 2). IDOT rates the substructure as being in good condition, which concurs with the findings from the cursory field check. Minor vertical cracks and small spalls are visible along the abutments, and piers. No notable defects or differences were observed between the cursory field check and IDOT's structure summary report for: deck geometry, underclearance vert/lat, approach alignment, bridge railing appraisal and approach guardrail items. Minor to moderate longitudinal cracks are visible on both approach slabs (see Photo 3). A few free falling drains don't extend below the bottom flanges of girders. One drain pipe is missing (see Photo 4).

Based on the structure summary report and field check, S.N. 016-0013 is suitable for reuse after rehabilitation of the substructure, superstructure and free-fall drainage. The approach guardrail transitions should be brought up to current IDOT standards.



LIN ENGINEERING, LTD.
Consulting Engineers

Springfield, IL Westmont, IL

576 Oakmont Lane
Westmont, Illinois 60559
Telephone: (630) 323-5168
Fax: (630) 323-5174
E-mail: info@lineng.com

LIN ENGINEERING, LTD.

A handwritten signature in blue ink that reads "Michael T. Haley". The signature is written in a cursive style.

Michael T. Haley, PE, SE
Structural Manager

Appendix A – Photos

Appendix B – IDOT Structure Summary Report

Appendix C – PONTIS Report



Photo 1



Photo 2



Photo 3

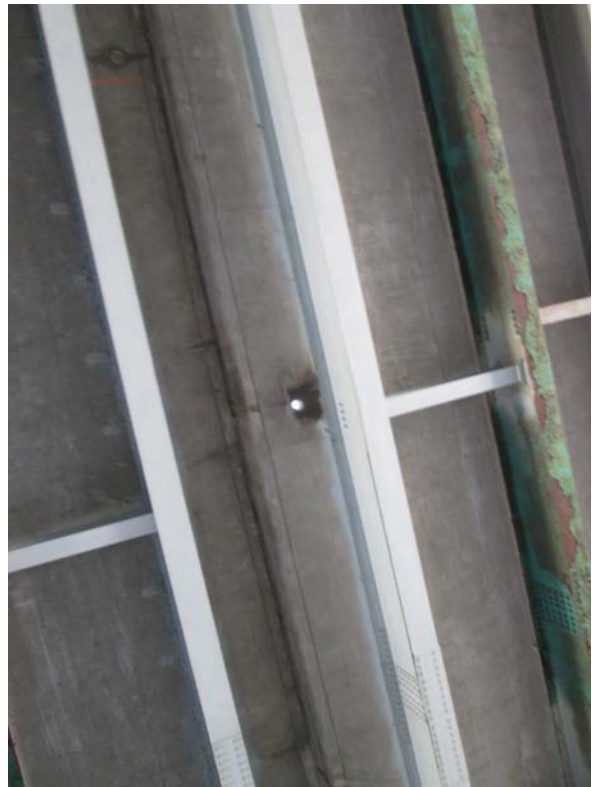


Photo 4

Illinois Department of Transportation
Structures Information Management System
Structure Summary Report

Structure Number: 016-0013 District: 1

Inventory Data	
Facility Carried:	I-55 EB STEVENSON
Feature Crossed:	RR - CSXT
Bridge Remarks:	DESIGN LOAD MS18&ALT
Status Remarks:	1 OPEN - NO RESTRICT
Maint County:	016 COOK
Maint Responsibility:	01 I.D.O.T.
Service On/Under:	1 HIGHWAY
Reporting Agency:	1 I.D.O.T. - BUREAU OF MAINTENANCE
Main Span Matl/Type:	4 STEEL CONTINUOUS
Nbr Of Main Spans:	4
Nbr Of Approach Spans:	0
Approaches	
Near #1 Matl/Type:	/
Near #2 Matl/Type:	/
Far #1 Matl/Type:	/
Far #2 Matl/Type:	/
Median Width/Type:	0 Ft./0 None
Guardrail Type L/R:	0 None / 0 None
Toll Facility Indicator:	0 No Toll
Latitude:	41.78390055 S Longitude: 87.83034600 S
Deck Structure Type:	A CIP CON NRMLLY FORM
Sidewalks Under Structure:	0 None
Inventory Rating:	1.730(62)
Operating Rating:	2.750(99)
Design Load:	99 UNKNOWN
Deck Structure Thickness:	7.5 SD: N FO: N
RR Vertical Underclear:	23 Ft 00 In

Key Route On Data	
Key Route Nbr:	FEDERAL-AID INTERSTATE
Appurtenances Main Route	00000
Inventory County:	016 COOK
Township/Road Dist	16 LYONS
Municipality	5620 SUMMIT
Urban Area:	1051
Functional Class:	1 INTERSTATE
** CLEARANCES **	South/East North/West
Max Rdwy Width:	66.6
Horizontal:	67.8
Vertical:	0.0
Designation	1 Interstate Highway
Kind	Number
Route #1:	1 Mainline
Route #2:	1 Mainline
Route #3:	1 Mainline

Key Route Under Data	


Illinois Department of Transportation
Structures Information Management System
Structure Summary Report

Structure Number: 016-0013 District: 1

Data Related to Inspection Information

*** Inspection Intervals ***
 Routine NBIS: 24 MOS Underwater: 0 MOS One Truck At A Time: 0
 Special: N Single Unit Vehicles: Tons Combination Type 3S-1: Tons
 Bridge Posting Level: 5 No Posting Required

Inspection/Appraisal Information

Inspection Date: 08/22/2014 Inspection Temperature: 86Deg. F
 Deck: 7 GOOD CONDITION - SOME MINOR PROBLEMS
 Superstructure: 5 FAIR CONDITION - MINOR SECTION LOSS, CRACKS
 Substructure: 7 GOOD CONDITION - SOME MINOR PROBLEMS
 Culvert: N NOT APPLICABLE
 Channel and Protection: N NOT APPLICABLE
 Structural Evaluation: 5 BETTER THAN ADEQUATE TO BE LEFT IN PLACE
 Deck Geometry: 9 SUPERIOR TO PRESENT DESIRABLE CRITERIA
 Underclearance-Vert/Lat.: 4 MINIMUM ADEQUACY TO BE LEFT IN PLACE
 Waterway Adequacy: N NOT APPLICABLE
 Approach Roadway Align: 8 EQUAL TO PRESENT DESIRABLE CRITERIA
 Bridge Railing Appraisal: 3 Meets Standards
 Approach Guardrail: 23N Not Acceptable
 Pier Navig Protection: N N/A

Deck Wearing Surf: A BARE DECK NO OVRLAY
 Deck Membrane: F NONE
 Deck Protection: A EPOXY COATED REINF
 Total Deck Thick: 7.5
 Last Paint Date: 05/2001

*** Actual Posted Limits **
 Single Unit Vehicles: Tons
 Combination Type 3S-1: Tons
 Combination Type 3S-2: Tons
 One Truck At A Time: 0
 Last Paint Type: CU
 LD SHP GRN&AL FNL
 FLD AL EPY & ACRLC

Underwater Inspection/Appraisal Information

Inspection Date:
 Temperature:
 Inspection Method:
 Appraisal Rating:

Scour Critical Information

Rating:
 Analysis Date:
 Evaluation Method:
 Microfilm Data Recorded: Yes

Construction Information

Year: 1963 Original 2000 Reconstructed
 Route: FAI-55 Sta: 280+17.71 FAI-55 Sta: 18+539.815
 Section Nbr: 0505-607VB 0404-640,ETC
 Contract Nbr: 82458
 Fed Aid Pr#: IG 0557067276 55-7(196)279
 Built By: 1 I.D.O.T. 1 I.D.O.T.

Pontis

Today's Date: 08/27/2015

Structure Number: 016-0013 District: 1
 (6) Feature Crossed: RR - CSXT
 (9) Location: 2.2 M SW ILL 43
 Element Inspection Date: 08/22/2014
 (90E) Agency Program Manager: MastnySC
 (90E1) Team Leader: SedlacekJL

(41) Bridge Status: 1 OPEN - NO RESTRICT
 (7) Facility Carried: I- 55 EB STEVENSON
 (7A) Bridge Name:
 (90E3) Consultant Program Manager:
 (90E2) Inspector:

Element Insp. Delinquent		Element Insp. Delinquent Reason:									
Elem	Env	% 1	Qty 1	% 2	Qty 2	% 3	Qty 3	% 4	Qty 4	Tot Qty	
Reinforced Conc Column or Pile Extension											
205	4	100	1,830	0	8	0	0	0	0	1,838	
		No deterioration	Minor cracks/spalls	Delams/spalls	Analysis warranted						
Remarks: HL vert crks											
Reinforced Conc Pier Wall											
210	4	100	4,760	0	1	0	0	0	0	4,761	
		No deterioration	Minor cracks/spalls	Delams/spalls	Analysis warranted						
Remarks: Isol HL vert crks.											
Reinforced Conc Abutment											
215	4	100	1,298	0	0	0	0	0	0	1,298	
		No deterioration	Minor cracks/spalls	Delams/spalls	Analysis warranted						
Remarks: Backwall) HL vert leach crks											
Reinforced Conc Pier or Abutment Cap											
234	4	100	349	0	1	0	0	0	0	350	
		No deterioration	Minor cracks/spalls	Delams/spalls	Analysis warranted						
Remarks: Pier) HL vert crks. Pier 3 East Face small spall under Bm#8.											
Preformed Joint Seal											
302	4	100	141	0	0	0	0	0	0	141	
		No deterioration	Minor deterioration	Major deterioration							
Remarks: Debris filled											
Elastomeric Bearing											
310	4	91	40	9	4	0	0	0	0	44	
		No deterioration	Minor deterioration	Major deterioration							
Remarks: Rusting to few assemblies.											
Fixed Bearing											
313	4	100	11	0	0	0	0	0	0	11	
		No deterioration	Minor deterioration	Advanced corrosion							
Remarks:											

Concrete Bridge Railing										
331	4	100	443	0	0	0	0	0	0	443
		No deterioration	Minor cracks/spalls	Analysis warranted						
Remarks: HL vert leach crks										
Concrete Deck Protected w/ Coated Bars										
8026	4	98	15,242	2	258	0	0	0	0	15,500
Remarks: (WS) HL-Nar Trans crking w/some intersecting long crks; Soffit) HL trans leach crks										
Non-Lead Painted Steel Open Girder										
8118	4	98	21,215	2	475	0	0	0	0	21,690
Remarks: Med rust along upper flange edges throughout except @ new bms; Old fascias have initial web/flange rust										
Non-Lead Painted Steel Closed Web/Box Girder Ends										
8173	4	82	18	18	4	0	0	0	0	22
Remarks: Few old bm ends have inactive pitting after repainting. Few ends init. rusting.										
Approach Pavement										
8323	4	100	2	0	0	0	0	0	0	2
Remarks: Nar-med random crks @ both										



October 27, 2015

MEMORANDUM

Mr. John Fortmann, Region One Engineer
Illinois Department of Transportation
Region One/District One

Attn: Steven Schilke

RE: Existing S.N. 016-0014
E.B. I-55 over Chicago Sanitary & Ship Canal
Cook County
PTB 158-002/P-91-762-10

The purpose of this technical memo is to summarize the current condition of existing S.N. 016-0014 in addition to geometrics and other factors. A cursory field check was performed to supplement the information contained in IDOT's structure summary report dated May 15, 2015 (see Appendix B). Broad-based recommendations for this structure are provided below.

The structure is a five span steel beam/girder bridge (see Photo 1). Each end span consists of nine lines of simply supported beams with span lengths of 49'-11¼". The three middle spans consist of nine lines of continuous girders with span lengths from west to east of 176'-0", 240'-6" and 176'-0". The superstructure is supported by pile bent abutments and reinforced concrete multi-column piers. There is no overlay on the structure.

IDOT rates the deck as being in good condition, which concurs with the findings from the cursory field check. Minor transverse cracks with leaching are visible on some section of soffit (see Photo 2). IDOT rates the superstructure as being in fair condition, which concurs with the findings from the cursory field check. Moderate paint peeling and rusting is visible on the old fascia beams. IDOT rates the substructure as being in satisfactory condition, which concurs with the findings from the cursory field check. Moderate cracking, delaminations and spalling is visible on most piers (see Photo 3). No notable defects or differences were observed between the cursory field check and IDOT's structure summary report for: deck geometry, underclearance vert/lat, approach alignment, bridge railing appraisal and approach guardrail items. A few free-falling drains don't extend below the bottom flange of the exterior girder (see Photo 4). Anchor blocks are damaged along sections of the east expansion joint. Moderate diagonal cracks are visible on both approach slabs. One steel end diaphragm is missing nuts (see Photo 5).

Based on the structure summary report and field check, S.N. 016-0014 is suitable for reuse after rehabilitation of the substructure, superstructure, expansion joints and free-fall drainage.



LIN ENGINEERING, LTD.
Consulting Engineers

Springfield, IL Westmont, IL

576 Oakmont Lane
Westmont, Illinois 60559
Telephone: (630) 323-5168
Fax: (630) 323-5174
E-mail: info@lineng.com

LIN ENGINEERING, LTD.

Michael T. Haley, PE, SE
Structural Manager

Appendix A – Photos

Appendix B – IDOT Structure Summary Report

Appendix C – PONTIS Report



Photo 1



Photo 2



Photo 3



Photo 4



Photo 5

Illinois Department of Transportation
Structures Information Management System
Structure Summary Report

Structure Number: 016-0014 District: 1

Inventory Data	
Facility Carried:	I-55 EB STEVENSON
Feature Crossed:	SAN & SHIP CANAL
Bridge Remarks:	DESIGN LOAD MS18&ALT
Bridge Status:	1 OPEN - NO RESTRICT
Status Remarks:	
Maint County:	016 COOK
Maint Responsibility:	01 I.D.O.T.
Service On/Under:	1 HIGHWAY
Reporting Agency:	1 I.D.O.T. - BUREAU OF MAINTENANCE
Main Span Mat/Type:	4 STEEL CONTINUOUS
Nbr Of Main Spans:	5
Nbr Of Approach Spans:	0
Approaches	
Near #1 Mat/Type:	/
Near #2 Mat/Type:	/
Far #1 Mat/Type:	/
Far #2 Mat/Type:	/
Median Width/Type:	0 Ft. / 0 None
Guardrail Type L/R:	0 None / 0 None
Toll Facility Indicator:	0 No Toll
Latitude:	41.79643579
Longitude:	S
Deck Structure Type:	A CIP CON NRMLLY FORM
Sidewalks Under Structure:	0 None
Inventory Rating:	1,235(44)
Operating Rating:	2,055(73)
Design Load:	99 UNKNOWN
Deck Structure Thickness:	7.5 SD: N FC: N
RR Lateral Underclear:	20
RR Vertical Underclear:	20
Rate Method:	6
Load Rating Date:	11/19/2001
Rated By:	2 IDOT
Load Rating Date:	11/19/2001
Design Load:	99 UNKNOWN
Deck Structure Thickness:	7.5 SD: N FC: N
RR Lateral Underclear:	20
RR Vertical Underclear:	20

Key Route On Data	
Key Route Nbr:	FEDERAL-AID INTERSTATE
Station:	0055
Segment:	6,4600
Appurtenances Main Route:	00000
Inventory County:	016 COOK
Township/Road Dist:	16 LYONS
Municipality:	5620 SUMMIT
Urban Area:	1051
Functional Class:	1 INTERSTATE
** CLEARANCES **	South/East North/West
Max Rdwy Width:	72.0
Horizontal:	73.0
Vertical:	0.0
Natl. Hwy System:	On NHS
Inventory Direction:	2014 / 72600
Curr AADT Yr/Count:	9
Est Truck Percentage:	4
Number Of Lanes:	1 One-Way
One Or Two Way:	0
Bypass Length:	2032 / 84409
Future AADT Yr/Cnt:	CLASS I
Designated Truck Rte:	Yes
Special Systems:	Yes

Key Route Under Data	
Key Route Nbr:	MUNICIPAL STREET
Station:	3000
Segment:	0,2300
Appurtenances Main Route:	05620
Inventory County:	16 LYONS
Township/Road Dist:	5620 SUMMIT
Municipality:	1051
Urban Area:	7 LOCAL
Functional Class:	7 LOCAL
** CLEARANCES **	South/East North/West
Max Rdwy Width:	0.0
Horizontal:	36.0
Vertical:	0.0
Natl. Hwy System:	Not on NHS
Inventory Direction:	1998 / 200
Curr AADT Yr/Count:	0
Est Truck Percentage:	2
Number Of Lanes:	2 Two-Way
One Or Two Way:	0
Bypass Length:	2032 / 215
Future AADT Yr/Cnt:	NONE
Designated Truck Rte:	NONE
Special Systems:	No

**** Marked Route On Data ****		
Designation	Kind	Number
1 Mainline	1 Interstate Highway	055
1 Mainline	1 Mainline	
1 Mainline	1 Mainline	

**** Marked Route Under Data ****		
Designation	Kind	Number
1 Mainline	5 Municipal Streets	
1 Mainline	1 Mainline	
1 Mainline	1 Mainline	

Illinois Department of Transportation
Structures Information Management System
Structure Summary Report

Structure Number: 016-0014 District: 1

Data Related to Inspection Information

*** Inspection Intervals ***
 Routine NBIS: 24 MOS Underwater: 60 MOS One Truck At A Time: 0
 Special: N Single Unit Vehicles: Tons Combination Type 3S-1: Tons
 Bridge Posting Level: 5 No Posting Required

***** Maximum Allowable Posting Limits *****

Combination Type 3S-1: Tons
 Combination Type 3S-2: Tons

Inspection/Appraisal Information

Inspection Date: 05/15/2015 Inspection Temperature: 70Deg. F
 Deck: 7 GOOD CONDITION - SOME MINOR PROBLEMS
 Superstructure: 5 FAIR CONDITION - MINOR SECTION LOSS, CRACKS
 Substructure: 6 SATISFACTORY CONDITION - MINOR DETERIORATION
 Culvert: N NOT APPLICABLE
 Channel and Protection: 8 VERY GOOD CONDITION - NO PROBLEMS NOTED
 Structural Evaluation: 5 BETTER THAN ADEQUATE TO BE LEFT IN PLACE
 Deck Geometry: 7 BETTER THAN PRESENT MINIMUM CRITERIA
 Underclearance-Vert/Lat.: 4 MINIMUM ADEQUACY TO BE LEFT IN PLACE
 Waterway Adequacy: 9 SUPERIOR TO PRESENT DESIRABLE CRITERIA
 Approach Roadway Align: 8 EQUAL TO PRESENT DESIRABLE CRITERIA
 Bridge Railing Appraisal: 3 Meets Standards
 Approach Guardrail: 333 Acceptable
 Pier Navig Protection: 2 IN PLACE AND FUNCTIONING

70Deg. F
 Deck Wearing Surf: A BARE DECK NO OVRLAY
 Deck Membrane: F NONE
 Deck Protection: A EPOXY COATED REINF
 Total Deck Thick: 7.5
 Last Paint Date: 10/2000

Single Unit Vehicles: Tons
 Combination Type 3S-1: Tons
 Combination Type 3S-2: Tons
 One Truck At A Time: 0
 Last Paint Type: FS
 LD FLD GRN&AL FNL
 SHP ZINC&FLD ACRYL

Underwater Inspection/Appraisal Information

Inspection Date: 11/10/2011
 Temperature: 45
 Inspection Method: DPSV Diver
 Appraisal Rating: 7
 Probe: GOOD - SMALL CRACKS IN UNDERWATER UNITS
 Sonar: Visual

Scour Critical Information

Rating: 8 CALCULATED SCOUR ABOVE FOOTING
 Analysis Date: 02/01/1993
 Evaluation Method: B Rational Analysis
 Microfilm Data Recorded: Yes

Construction Information

Year: 1964 Original
 Route: FAI-55
 Section Nbr: 0707-616-B
 Contract Nbr: 0404-640,ETC
 Fed Aid Pr#: I 0557081277
 Built By: 1 I.D.O.T.

2000 Reconstructed
 Sta: 346+70 FAI55
 Sta: 20+513.228
 82458
 55-7(196)279
 1 I.D.O.T.

Miscellaneous

Microfilm Data Recorded: Yes

Pontis

Today's Date: 08/27/2015

Structure Number: 016-0014 District: 1 (41) Bridge Status: 1 OPEN - NO RESTRICT
 (6) Feature Crossed: SAN & SHIP CANAL (7) Facility Carried: I-55 EB STEVENSON
 (9) Location: 0.9 M SW ILL 43 (7A) Bridge Name:
 Element Inspection Date: 05/15/2015
 (90E) Agency Program Manager: MastnySC (90E3) Consultant Program Manager:
 (90E1) Team Leader: SedlacekJL (90E2) Inspector:

Element Insp. Delinquent		N		Element Insp. Delinquent Reason:						
Element Description										
Elem	Env	% 1	Qty 1	% 2	Qty 2	% 3	Qty 3	% 4	Qty 4	Tot Qty
Lead Painted Steel Open Girder										
107	4	75	79,315	25	26,439	0	0	0	0	105,754
		No corrosion	Paint distress	Rust formation	Section loss	Section failure				
Remarks: N Fascia & Old S Fascia-med rust w/init sec loss @web, btm flang & stiffeners; Paint peeling & rusting; Span 2 Bm#9 sect loss @gusset plate @Pier 2, half & qtr span.										
Reinforced Conc Column or Pile Extension										
205	2	99	4,682	0	20	0	10	0	0	4,712
		No deterioration	Minor cracks/spalls	Delams/spalls	Analysis warranted					
Remarks: Pier 3 Col 4 has vert crking; Pier 2 Col 4 has a small spall w/exp										
Reinforced Conc Pier Wall										
210	2	100	10,924	0	4	0	0	0	0	10,928
		No deterioration	Minor cracks/spalls	Delams/spalls	Analysis warranted					
Remarks: Minor Delam @ Pier 3										
Reinforced Conc Abutment										
215	2	100	937	0	0	0	0	0	0	937
		No deterioration	Minor cracks/spalls	Delams/spalls	Analysis warranted					
Remarks:										
Reinforced Conc Pier or Abutment Cap										
234	2	93	586	3	20	4	26	0	0	632
		No deterioration	Minor cracks/spalls	Delams/spalls	Analysis warranted					
Remarks: (Piers) Delams, map crking, & minor spalls w/exp rebar. P2 EFace spall w/exp 3'wx6'h; P3 S Nose spall w/exp 3'x1'										
Modular Joints										
303	4	100	103	0	0	0	0	0	0	103
		No deterioration	Minor deterioration	Advanced corrosion	Corrosion is advance					
Remarks:										
Elastomeric Bearing										
310	4	0	0	100	36	0	0	0	0	36
		No deterioration	Minor deterioration	Major deterioration						
Remarks:										

Fixed Bearing										
313	4	0	0	100	9	0	0	0	0	9
		No deterioration	Minor deterioration	Advanced corrosion						
Remarks:										
Pot Bearing										
314	4	0	0	100	9	0	0	0	0	9
		No deterioration	Minor deterioration	Advanced corrosion						
Remarks: @ Pier 2										
Concrete Bridge Railing										
331	4	0	0	100	1,392	0	0	0	0	1,392
		No deterioration	Minor cracks/spalls	Analysis warranted						
Remarks: Slipformed) Vert & Hor crking										
Concrete Deck Protected w/ Coated Bars										
8026	4	97	50,976	3	1,426	0	0	0	0	52,402
Remarks: WS) HL-Nar trans crks w/some intersecting long. Soffit) Few HL trans leach crks										
Non-Lead Painted Steel Open Girder										
8118	4	100	22,090	0	0	0	0	0	0	22,090
Remarks:										
Non-Lead Painted Steel Open Girder Ends										
8176	4	100	72	0	0	0	0	0	0	72
Remarks:										
Continuous Seal Neoprene Expansion Joint										
8308	4	97	307	3	8	0	0	0	0	315
Remarks: Plow damage @ East Abut Jnt										
Moveable Steel Bearings below continuous decks										
8316	4	0	0	100	9	0	0	0	0	9
Remarks:										
Approach Pavement										
8323	4	100	2	0	0	0	0	0	0	2
Remarks: Diag & random crking @ E & W										



October 27, 2015

MEMORANDUM

Mr. John Fortmann, Region One Engineer
Illinois Department of Transportation
Region One/District One

Attn: Steven Schilke

RE: Existing S.N. 016-0015
W.B. I-55 over Chicago Sanitary & Ship Canal
Cook County
PTB 158-002/P-91-762-10

The purpose of this technical memo is to summarize the current condition of existing S.N. 016-0015 in addition to geometrics and other factors. A cursory field check was performed to supplement the information contained in IDOT's structure summary report dated May 15, 2015 (see Appendix B). Broad-based recommendations for this structure are provided below.

The structure is a five span steel beam/girder bridge (see Photo 1). Each end span consists of nine lines of simply supported beams with span lengths of 49'-11¼". The three middle spans consist of nine lines of continuous girders with span lengths from west to east of 176'-0", 240'-6" and 176'-0". The superstructure is supported by pile bent abutments and reinforced concrete multi-column piers. There is no overlay on the structure.

IDOT rates the deck as being in good condition, which concurs with the findings from the cursory field check. Minor transverse cracks are visible on a majority of the top of the deck. IDOT rates the superstructure as being in fair condition, which concurs with the findings from the cursory field check. Moderate paint peeling and rusting is visible on the old fascia beams (see Photo 2). IDOT rates the substructure as being in satisfactory condition, which concurs with the findings from the cursory field check. Minor to moderate cracking, delaminations and spalling is visible on the abutments and piers (see Photo 3). No notable defects or differences were observed between the cursory field check and IDOT's structure summary report for: deck geometry, underclearance vert/lat, approach alignment, bridge railing appraisal and approach guardrail items. Anchor blocks are damaged along sections of both expansion joints (see Photo 4).

Based on the structure summary report and field check, S.N. 016-0015 is suitable for reuse after rehabilitation of the substructure, superstructure and expansion joints.



LIN ENGINEERING, LTD.
Consulting Engineers

Springfield, IL Westmont, IL

576 Oakmont Lane
Westmont, Illinois 60559
Telephone: (630) 323-5168
Fax: (630) 323-5174
E-mail: info@lineng.com

LIN ENGINEERING, LTD.

A handwritten signature in blue ink that reads "Michael T. Haley". The signature is written in a cursive, flowing style.

Michael T. Haley, PE, SE
Structural Manager

Appendix A – Photos

Appendix B – IDOT Structure Summary Report

Appendix C – PONTIS Report



Photo 1



Photo 2



Photo 3

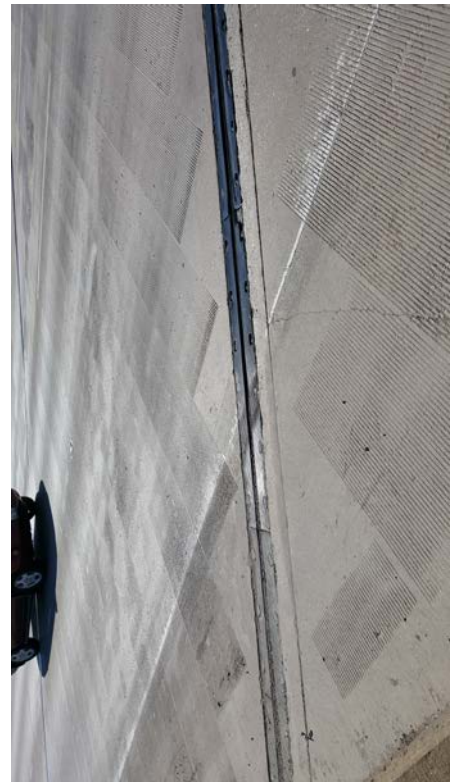


Photo 4

Illinois Department of Transportation
Structures Information Management System
Structure Summary Report

Structure Number: 016-0015 District: 1

Inventory Data	
Facility Carried:	I-55 WB STEVENSON
Feature Crossed:	SAN & SHIP CANAL
Bridge Remarks:	
Status Remarks:	1 OPEN - NO RESTRICT
Maint County:	016 COOK
Maint Responsibility:	01 I.D.O.T.
Service On/Under:	1 HIGHWAY
Reporting Agency:	1 I.D.O.T. - BUREAU OF MAINTENANCE
Main Span Matl/Type:	4 STEEL CONTINUOUS
Nbr Of Main Spans:	5
Nbr Of Approach Spans:	0
Approaches	
Near #1 Matl/Type:	/
Near #2 Matl/Type:	/
Far #1 Matl/Type:	/
Far #2 Matl/Type:	/
Median Width/Type:	0 Ft. / 0 None
Guardrail Type L/R:	0 None / 0 None
Toll Facility Indicator:	0 No Toll
Latitude:	41.78642631 S Longitude: 87.81293776 S
Deck Structure Type:	A CIP CON NRMLLY FORM
Sidewalks Under Structure:	0 None
Bridge Name:	0.9 M SW ILL 43
Location:	
Status Date:	12/2000
Maint Township:	16 LYONS
Inventory Rating:	2
Operating Rating:	S
Design Load:	99 UNKNOWN
Deck Structure Thickness:	7.5 SD: N FO: N
RR Vertical Underclear:	20 Ft 08 In

Key Route On Data	
Key Route Nbr:	FEDERAL-AID INTERSTATE 0055
Station:	6.4800
Segment:	00000
Linked:	Y
Natl. Hwy System:	On NHS
Township/Road Dist:	16 LYONS
Municipality:	5620 SUMMIT
Urban Area:	1051
Functional Class:	1 INTERSTATE
** CLEARANCES **	South/East North/West
Max Rdwy Width:	72.0
Horizontal:	73.0
Vertical:	0.0
Est Truck Percentage:	9
Number Of Lanes:	4
One Or Two Way:	1 One-Way
Bypass Length:	0
Future AADT Yr/Cnt:	2032 / 84409
Designated Truck Rte:	CLASS I
Special Systems:	Yes

Key Route Under Data	
Key Route Nbr:	MUNICIPAL STREET
Station:	3000
Segment:	05620
Linked:	Y
Natl. Hwy System:	Not on NHS
Township/Road Dist:	16 LYONS
Municipality:	5620 SUMMIT
Urban Area:	1051
Functional Class:	7 LOCAL
** CLEARANCES **	South/East North/West
Max Rdwy Width:	0.0
Horizontal:	36.0
Vertical:	0.0
Est Truck Percentage:	0
Number Of Lanes:	2
One Or Two Way:	2 Two-Way
Bypass Length:	0
Future AADT Yr/Cnt:	2032 / 215
Designated Truck Rte:	NONE
Special Systems:	No

Marked Route On Data		
Designation	Kind	Number
1 Mainline	1 Interstate Highway	055
1 Mainline		
1 Mainline		

Marked Route Under Data		
Designation	Kind	Number
1 Mainline	5 Municipal Streets	
1 Mainline		
1 Mainline		

**Illinois Department of Transportation
Structures Information Management System
Structure Summary Report**

Structure Number: 016-0015 District: 1

Data Related to Inspection Information

*** Inspection Intervals ***
 Routine NBIS: 24 MOS Underwater: 60 MOS One Truck At A Time: 0 Combination Type 3S-1: Tons
 Special: N Single Unit Vehicles: Tons Combination Type 3S-2: Tons
 Bridge Posting Level: 5 No Posting Required

Inspection/Appraisal Information

Inspection Date: 05/15/2015 Inspection Temperature: 70Deg. F
 Deck: 7 GOOD CONDITION - SOME MINOR PROBLEMS
 Superstructure: 5 FAIR CONDITION - MINOR SECTION LOSS, CRACKS
 Substructure: 6 SATISFACTORY CONDITION - MINOR DETERIORATION
 Culvert: N NOT APPLICABLE
 Channel and Protection: 8 VERY GOOD CONDITION - NO PROBLEMS NOTED
 Structural Evaluation: 5 BETTER THAN ADEQUATE TO BE LEFT IN PLACE
 Deck Geometry: 7 BETTER THAN PRESENT MINIMUM CRITERIA
 Underclearance-Vert/Lat.: 5 BETTER THAN ADEQUATE TO BE LEFT IN PLACE
 Waterway Adequacy: 9 SUPERIOR TO PRESENT DESIRABLE CRITERIA
 Approach Roadway Align: 8 EQUAL TO PRESENT DESIRABLE CRITERIA
 Bridge Railing Appraisal: 3 Meets Standards
 Approach Guardrail: 333 Acceptable
 Pier Navig Protection: 2 IN PLACE AND FUNCTIONING

Deck Wearing Surf: A BARE DECK NO OVRLAY
 Deck Membrane: F NONE
 Total Deck Thick: 7.5
 Last Paint Date: 10/2000

Deck Protection: A EPOXY COATED REINF
 Last Paint Type: FS
 LD FLD GRN&AL FNL
 SHP ZINC&FLD ACRYL

*** Actual Posted Limits **
 Single Unit Vehicles: Tons
 Combination Type 3S-1: Tons
 Combination Type 3S-2: Tons
 One Truck At A Time: 0

Underwater Inspection/Appraisal Information

Inspection Date: 11/10/2011
 Temperature: 45
 Inspection Method: DPSV Diver
 Appraisal Rating: 7
 Probe: GOOD - SMALL CRACKS IN UNDERWATER UNITS
 Sonar: Visual

Scour Critical Information

Rating: 8 CALCULATED SCOUR ABOVE FOOTING Evaluation Method: B Rational Analysis
 Analysis Date: 02/01/1993
 Microfilm Data Recorded: Yes

Construction Information

Year: 1964 Original
 Route: FAI-55
 Section Nbr: 0707-616-B
 Contract Nbr: 82458
 Fed Aid Pr#: I 0557081277
 Built By: 1 I.D.O.T.
 2000 Reconstructed
 Sta: 346+70 FAI55
 Sta: 20+513.228
 0404-640.ETC
 82458
 55-7(196)279
 1 I.D.O.T.

Miscellaneous

Pontis

Today's Date: 08/27/2015

Structure Number: 016-0015 District: 1 (41) Bridge Status: 1 OPEN - NO RESTRICT
 (6) Feature Crossed: SAN & SHIP CANAL (7) Facility Carried: I- 55 WB STEVENSON
 (9) Location: 0.9 M SW ILL 43 (7A) Bridge Name:
 Element Inspection Date: 05/15/2015
 (90E) Agency Program Manager: MastnySC (90E3) Consultant Program Manager:
 (90E1) Team Leader: Sedlacek, JL (90E2) Inspector:

Element Insp. Delinquent		Element Insp. Delinquent Reason:								
N										
Element Description										
Elem	Env	% 1	Qty 1	% 2	Qty 2	% 3	Qty 3	% 4	Qty 4	Tot Qty
Lead Painted Steel Open Girder										
107	4	74	78,254	26	27,500	0	0	0	0	105,754
		No corrosion	Paint distress	Rust formation	Section loss	Section failure				
Remarks: Original Fascia girders have section loss in splices, webs, flanges & stiffeners @ old drain locs; Numerous small to med holes in gusset plates @ same locs; rusting & scattered peeling elsewhere										
Reinforced Conc Column or Pile Extension										
205	2	99	4,678	1	30	0	0	0	0	4,708
		No deterioration	Minor cracks/spalls	Delams/spalls	Analysis warranted					
Remarks: Pier 2 South Face has delams										
Reinforced Conc Pier Wall										
210	2	100	10,760	0	0	0	0	0	0	10,760
		No deterioration	Minor cracks/spalls	Delams/spalls	Analysis warranted					
Remarks:										
Reinforced Conc Abutment										
215	2	100	898	0	0	0	0	0	0	898
		No deterioration	Minor cracks/spalls	Delams/spalls	Analysis warranted					
Remarks: East Abut-few HL vert leach crks										
Reinforced Conc Pier or Abutment Cap										
234	2	91	579	3	20	6	40	0	0	639
		No deterioration	Minor cracks/spalls	Delams/spalls	Analysis warranted					
Remarks: Pier 2-horiz crking w/few delams WFace spall@Brg#9; P3 Cap-W Corner-large spall w/exp bars 4'x1' @ N.Nose. P4 EFace spalls w/exp @ Brgs 6,7&8										
Preformed Joint Seal										
302	4	0	0	100	705	0	0	0	0	705
		No deterioration	Minor deterioration	Major deterioration						
Remarks:										
Modular Joints										
303	4	100	102	0	0	0	0	0	0	102
		No deterioration	Minor deterioration	Advanced corrosion	Corrosion is advance					
Remarks:										

Elastomeric Bearing										
310	4	0	0	94	34	0	0	6	2	36
		No deterioration	Minor deterioration	Major deterioration						
Remarks: Pier 4 Brg#8 rusted, Brg#6 paint peeling; Pier 3-Brg#5 bolt not tightened										
Fixed Bearing										
313	4	0	0	96	26	4	1	0	0	27
		No deterioration	Minor deterioration	Advanced corrosion						
Remarks: E Abut bmg @ N fascia not bmg properly										
Pot Bearing										
314	4	0	0	100	9	0	0	0	0	9
		No deterioration	Minor deterioration	Advanced corrosion						
Remarks: @ Pier 2										
Concrete Bridge Railing										
331	4	0	0	100	1,396	0	0	0	0	1,396
		No deterioration	Minor cracks/spalls	Analysis warranted						
Remarks: Slipformed) HL Vert & Hor cracks										
Concrete Deck Protected w/ Coated Bars										
8026	4	97	51,572	3	1,500	0	0	0	0	53,072
Remarks: (WS) HL-Nar transv crks w/few intersecting Soffit) Few HL trans leach crks										
Non-Lead Painted Steel Open Girder										
8118	4	100	22,247	0	10	0	0	0	0	22,257
Remarks: Pier 4 Bm Ends rusted										
Non-Lead Painted Steel Open Girder Ends										
8176	4	93	50	7	4	0	0	0	0	54
Remarks: Pier 4 Bm Ends rusted										
Continuous Seal Neoprene Expansion Joint										
8308	4	95	306	0	0	5	16	0	0	322
Remarks: Plow damage w/small missing hold-down sections @ East Aprch Ln 3 (8ft) damaged; West Aprch Ln#2&3 (8ft) damaged										
Moveable Steel Bearings below continuous decks										
8316	4	0	0	100	9	0	0	0	0	9
Remarks:										
Approach Pavement										
8323	4	100	2	0	0	0	0	0	0	2
Remarks: Random & map crking E & W										



October 27, 2015

MEMORANDUM

Mr. John Fortmann, Region One Engineer
Illinois Department of Transportation
Region One/District One

Attn: Steven Schilke

RE: Existing S.N. 016-0020
BNSF West Bridge over I-55
Cook County
PTB 158-002/P-91-762-10

The purpose of this technical memo is to summarize the current condition of existing S.N. 016-0020 in addition to geometrics and other factors. A cursory field check was performed to supplement the information contained in IDOT's structure summary report dated October 18, 2014 (see Appendix B). Broad-based recommendations for this structure are provided below.

The structure is a four span steel girder bridge consisting of eight lines of simply supported girders with a concrete deck covered in ballast (see Photo 1). The overall structure length is 294'-0". The superstructure is supported by pile bent abutments and reinforced concrete solid wall piers.

IDOT rates the superstructure as being in satisfactory condition, which concurs with the findings from the cursory field check. Moderate to heavy paint peeling and rusting is visible on all girders (see Photo 2). IDOT rates the substructure as being in good condition, which concurs with the findings from the cursory field check. Minor cracking is visible on the abutments and piers. IDOT rates the underclearance vertical and lateral as being intolerable requiring a high priority of corrective action, which concurs with the findings from the cursory field check. There are multiple locations with impact damage over E.B. I-55 (see Photo 2). No notable defects or differences were observed between the cursory field check and IDOT's structure summary report for the deck item. The slopewalls exhibit heavy cracking (see Photo 3).

Based on the structure summary report and field check, S.N. 016-0020 is suitable for reuse after rehabilitation of the superstructure. Both slopewalls should be replaced.



LIN ENGINEERING, LTD.
Consulting Engineers

Springfield, IL Westmont, IL

576 Oakmont Lane
Westmont, Illinois 60559
Telephone: (630) 323-5168
Fax: (630) 323-5174
E-mail: info@lineng.com

LIN ENGINEERING, LTD.

A handwritten signature in blue ink that reads "Michael T. Haley". The signature is written in a cursive style.

Michael T. Haley, PE, SE
Structural Manager

Appendix A – Photos

Appendix B – IDOT Structure Summary Report

Appendix C – PONTIS Report



Photo 1



Photo 2



Photo 3

Illinois Department of Transportation
Structures Information Management System
Structure Summary Report

Structure Number: 016-0020 District: 1

Inventory Data	
Facility Carried:	RR - BNSF WEST BR
Feature Crossed:	I-55 STEVENSON
Bridge Name:	1.5 M NE ILL 50
Location:	
Bridge Status:	1 OPEN - NO RESTRICT
Status Date:	04/1988
Status Remarks:	
Maint County:	016 COOK
Maint Township:	83 SOUTH CHICAGO
Maint Responsibility:	16 I.D.O.T. RAILROAD
Service On/Under:	2 RAILROAD 1 / HIGHWAY
Reporting Agency:	1 I.D.O.T. - BUREAU OF MAINTENANCE
Main Span Matl/Type:	3 STEEL / 02 STRINGER/MULTI-BEAM/GIRDER
Nbr Of Main Spans:	4
Nbr Of Approach Spans:	0
Approaches	
Near #1 Matl/Type:	/
Near #2 Matl/Type:	/
Far #1 Matl/Type:	/
Far #2 Matl/Type:	/
Median Width/Type:	0 Ft. / 0 None
Guardrail Type L/R:	0 None / 0 None
Toll Facility Indicator:	0 No Toll
Latitude:	41.82596385 S Longitude: 87.71458529 S
Deck Structure Type:	A CIP CON NRMLLY FORM
Sidewalks Under Structure:	0 None
Inventory Rating:	0
Operating Rating:	S
Design Load:	99 UNKNOWN
Deck Structure Thickness:	8 SD: N FO: Y
RR Lateral Underclear:	0 Ft
RR Vertical Underclear:	0 In

Key Route On Data	
Key Route Nbr:	Station: 0055
Appurtenances	FEDERAL-AID INTERSTATE
Inventory County:	Main Route 00000
Township/Road Dist	016
Municipality	83 SOUTH CHICAGO (CHICAGO)
Urban Area:	1051 CHICAGO
** CLEARANCES **	1051 1051
Functional Class:	1 INTERSTATE
Max Rdwy Width:	South/East North/West
Horizontal:	36.0
	74.0
Vertical:	74.0
Station:	0055
Segment:	11.8900
Linked:	Y
Natl. Hwy System:	On NHS
Inventory Direction:	
Curr AADT Yr/Count:	2014 / 179000
Est Truck Percentage:	6
Number Of Lanes:	6
One Or Two Way:	2 Two-Way
Bypass Length:	0
Future AADT Yr/Cnt:	2032 / 184370
Designated Truck Rte:	CLASS I
Special Systems:	Yes

**** Marked Route Under Data ****		
Designation	Kind	Number
1 Mainline	1 Interstate Highway	055
1 Mainline		
1 Mainline		

**Illinois Department of Transportation
Structures Information Management System
Structure Summary Report**

District: 1

Structure Number: 016-0020

Data Related to Inspection Information
 *** Inspection Intervals ***
 Routine NBIS: 24 MOS Underwater: 0 MOS One Truck At A Time: 0
 Special: N Single Unit Vehicles: 0 Tons Combination Type 3S-1: Tons
 Tons Combination Type 3S-2: Tons
 Bridge Posting Level: N

*** Maximum Allowable Posting Limits ***

Inspection/Appraisal Information

Inspection Date: 10/18/2014 Inspection Temperature: 50Deg. F
 Deck: 6 SATISFACTORY CONDITION - MINOR DETERIORATION
 Superstructure: 6 SATISFACTORY CONDITION - MINOR DETERIORATION
 Substructure: 7 GOOD CONDITION - SOME MINOR PROBLEMS
 Culvert: N NOT APPLICABLE
 Channel and Protection: N NOT APPLICABLE
 Structural Evaluation: *
 Deck Geometry: *
 Underclearance-Vert/Lat.: 3 INTOLERABLE - HIGH PRIORITY FOR CORRECTION
 Waterway Adequacy: N NOT APPLICABLE
 Approach Roadway Align: N NOT APPLICABLE
 Bridge Railing Appraisal: N N/A
 Approach Guardrail: NNN N/A
 Pier Navig Protection: N N/A

Deck Wearing Surf: A BARE DECK NO OVRLAY
 Deck Membrane: F NONE
 Deck Protection: J NONE
 Total Deck Thick: 8.0
 Last Paint Date: 04/1990

Single Unit Vehicles: Tons
 Combination Type 3S-1: Tons
 Combination Type 3S-2: Tons
 One Truck At A Time: 0
 Last Paint Type: JC
 IRZC/OXIDE ALKYD
 LD SHP GRN&AL FNL

** Actual Posted Limits **

Underwater Inspection/Appraisal Information

Inspection Date:
Temperature:

Inspection Method:
Appraisal Rating:

Scour Critical Information

Rating:
Analysis Date:
Evaluation Method:
Microfilm Data Recorded: Yes

Construction Information

Year: 1963 Original
 Route: FAI-55 Reconstructed
 Section Nbr: 1313-622-SB Sta: 92+85
 Contract Nbr:
 Fed Aid Pr#: IIG0557030283
 Built By: 1 I.D.O.T.

Miscellaneous

Pontis

Today's Date: 09/03/2015

Structure Number: 016-0020 District: 1 (41) Bridge Status: 1 OPEN - NO RESTRICT
 (6) Feature Crossed: I- 55 STEVENSON (7) Facility Carried: RR - BNSF WEST BR
 (9) Location: 1.5 M NE ILL 50 (7A) Bridge Name:
 Element Inspection Date: 10/18/2014
 (90E) Agency Program Manager: MastnySC (90E3) Consultant Program Manager:
 (90E1) Team Leader: SedlacekJL (90E2) Inspector:

Element Insp. Delinquent		Element Insp. Delinquent Reason:									
Elem	Env	% 1	Qty 1	% 2	Qty 2	% 3	Qty 3	% 4	Qty 4	Tot Qty	
Lead Painted Steel Open Girder											
107	4	69	22,118	11	3,500	20	6,500	0	0	32,118	
		No corrosion	Paint distress		Rust formation		Section loss		Section failure		
Remarks: Minor pack rust btwn bot fl & cover plates; Peeling to bare metal @ fascias(int & exterior)											
Reinforced Conc Pier Wall											
210	4	98	2,873	2	64	0	0	0	0	2,937	
		No deterioration	Minor cracks/spalls		Delams/spalls		Analysis warranted				
Remarks: Map crks typ; few delams											
Reinforced Conc Abutment											
215	4	100	1,924	0	0	0	0	0	0	1,924	
		No deterioration	Minor cracks/spalls		Delams/spalls		Analysis warranted				
Remarks:											
Reinforced Conc Pier or Abutment Cap											
234	4	98	215	2	4	0	0	0	0	219	
		No deterioration	Minor cracks/spalls		Delams/spalls		Analysis warranted				
Remarks: HL Vert Crking at Pier Cap Ends											
Open Expansion Joint											
304	2	100	175	0	0	0	0	0	0	175	
		No deterioration	Minor deterioration		Advanced corrosion						
Remarks:											
Movable Discontinuous Brg.											
311	4	88	28	13	4	0	0	0	0	32	
		No deterioration	Minor deterioration		Advanced corrosion						
Remarks: Lt rust to assemblies											
Fixed Bearing											
313	4	83	20	17	4	0	0	0	0	24	
		No deterioration	Minor deterioration		Advanced corrosion						
Remarks: Lt rust to assemblies											

Miscellaneous- Bridge Railing										
		No deterioration	Minor cracks/spalls	Major deterioration						
333	2	0	0	100	584	0	0	0	0	584
Remarks: Rusted										
Concrete Deck Protected w/ Thin Overlay										
8018	2	99	10,154	1	124	0	0	0	0	10,278
Remarks: Ballast over conc deck; Isol trans leach crks. At longit joint HL-Med leaching map crks w/ efflor										
Lead Painted Steel Closed Web/Box Girder Ends										
8172	4	79	44	21	12	0	0	0	0	56
Remarks: Lt rust & peeling paint										
Steel Open Girder										
8406	4	0	0	100	4	0	0	0	0	4
Remarks: Bttm flng of W fascia over I55 EB In 2-Deep gouges in Bms 5,6,7,8 over EB Ln 3; I55 WB Gouges in Bms 5,6,7,8 over WB Ln 3;										



October 27, 2015

MEMORANDUM

Mr. John Fortmann, Region One Engineer
Illinois Department of Transportation
Region One/District One

Attn: Steven Schilke

RE: Existing S.N. 016-0021
BNSF East Bridge over I-55
Cook County
PTB 158-002/P-91-762-10

The purpose of this technical memo is to summarize the current condition of existing S.N. 016-0021 in addition to geometrics and other factors. A cursory field check was performed to supplement the information contained in IDOT's structure summary report dated October 18, 2014 (see Appendix B). Broad-based recommendations for this structure are provided below.

The structure is a four span steel through girder bridge consisting of two lines of simply supported girders supporting floor beams and a steel plate deck covered with ballast (see Photo 1). Span lengths from south to north are 46'-9 $\frac{3}{4}$ ", 84'-2", 84'-2" and 46'-9 $\frac{3}{4}$ ". The superstructure is supported by pile bent abutments and reinforced concrete solid wall piers.

IDOT rates the superstructure as being in satisfactory condition, which concurs with the findings from the cursory field check. Moderate to heavy paint peeling and rusting is visible on all girders and floor beams (see Photo 2). IDOT rates the substructure as being in good condition. The findings from the cursory field check don't match IDOT's substructure rating. Large spalls with exposed reinforcement are visible on the north solid wall pier (see Photo 3). IDOT rates the underclearance vertical and lateral as being intolerable requiring a high priority of corrective action. The findings from the cursory field check match IDOT's underclearance rating. Scrape marks are visible on the through girder bottom flanges over W.B. I-55 traffic. A large crack is visible on the south slope wall (see Photo 4).

Based on the structure summary report and field check, S.N. 016-0021 is suitable for reuse after rehabilitation of the substructure. Both slopewalls should be repaired.



LIN ENGINEERING, LTD.
Consulting Engineers

Springfield, IL Westmont, IL

576 Oakmont Lane
Westmont, Illinois 60559
Telephone: (630) 323-5168
Fax: (630) 323-5174
E-mail: info@lineng.com

LIN ENGINEERING, LTD.

A handwritten signature in blue ink that reads "Michael T. Haley". The signature is written in a cursive style.

Michael T. Haley, PE, SE
Structural Manager

Appendix A – Photos

Appendix B – IDOT Structure Summary Report

Appendix C – PONTIS Report



Photo 1



Photo 2



Photo 3



Photo 4

Illinois Department of Transportation
Structures Information Management System
Structure Summary Report

Structure Number: 016-0021 District: 1

Inventory Data

Facility Carried: RR - BNSF EAST BR Bridge Name: SOUTHWEST CHICAGO
 Feature Crossed: I-55 STEVENSON Location: 1.55 M NE ILL 50
 Bridge Remarks: NOTE: 107 IS A STEEL PLATE 3/8" THICK COVERED WITH BALLAST
 Bridge Status: 1 OPEN - NO RESTRICT Status Date: 04/1988
 Status Remarks:
 Maint County: 016 COOK Maint Township: 83 SOUTH CHICAGO
 Maint Responsibility: 16 I.D.O.T. RAILROAD
 Service On/Under: 2 RAILROAD 1 / HIGHWAY
 Reporting Agency: 1 I.D.O.T. - BUREAU OF MAINTENANCE
 Main Span Matl/Type: 3 STEEL / 03 GIRDER AND FLOORBEAM SYSTEM
 Nbr Of Main Spans: 4 Nbr Of Approach Spans: 0
 Approaches
 Near #1 Matl/Type: /
 Near #2 Matl/Type: /
 Far #1 Matl/Type: /
 Far #2 Matl/Type: /
 Median Width/Type: 0 Ft. / 0 None / 0 None
 Guardrail Type L/R: 0 None / 0 None
 Toll Facility Indicator: 0 No Toll
 Latitude: 41.82632484 S Longitude: 87.71345865 S
 Deck Structure Type: 1 STEEL PL (INC ORTH)
 Sidewalks Under Structure: 0 None

Sufficiency Rating: 262.0
 HBP Eligible: No AASHTO Bridge Length: 99.9
 Replaced By: - Length of Long Span: 84.2
 Replaces: - Bridge Roadway Width: 0.0
 Last Update Date: 08/08/2014 Appr Roadway Width: 0.0
 Parallel Structure: None Deck Width: 0.0
 Multi-Level Structure Nbr: None Sidewalk Width Right: 0.0
 Skew Direction: N None Sidewalk Width Left: 0.0
 Skew Angle: 0 D Navigation Control: N N/A
 Structure Flared: No Navigation Horiz Clear: 0
 Historical Significance: No Navigation Vert Clear: 0
 Border Bridge State: Culvert Fill Depth: 0.0
 Bdr State SN: Number Culvert Cells: 0
 Bdr State % Responsibility: 0 Culvert Opening Area: 0.0
 Structural Steel Wt: 894000 Culvert Cell Height: 0.00
 Substructure Material: Culvert Cell Width: 0.00
 Rated By: 2 IDOT Rate Method: N
 Load Rating Date: 04/13/1999 Railroad Crossing Info
 Inventory Rating: 0 Crossing 1 Nbr:
 Operating Rating: 0 Crossing 1 Nbr:
 Design Load: 99 UNKNOWN
 Deck Structure Thickness: 0.4 SD: N FO: Y RR Lateral Underclear: 0.0
 RR Vertical Underclear: 0 Ft 0 In

Key Route On Data

Key Route Nbr: Station: 0055 Station: 11.9600
 Appurtenances Segment: FEDERAL-AID INTERSTATE 00000
 Inventory County: Main Route
 Township/Road Dist: 016
 Municipality: 83 SOUTH CHICAGO (CHICAGO)
 Urban Area: 1051 CHICAGO
 Functional Class: 1051 1051
 ** CLEARANCES ** South/East North/West
 Max Rdwy Width: 36.0
 Horizontal: 54.0
 Bypass Length: 54.0
 Future AADT Yr/Cnt: /
 Designated Truck Rte: /
 Special Systems:

Key Route Under Data

Segment: Station: 11.9600
 Linked: Y
 Natl. Hwy System: On NHS
 Inventory Direction: Inventory Direction:
 Curr AADT Yr/Count: 2014 / 179000
 Est Truck Percentage: 6
 Number Of Lanes: 6
 One Or Two Way: 2 Two-Way
 Bypass Length: 0
 Future AADT Yr/Cnt: 2032 / 184370
 Designated Truck Rte: CLASS I
 Special Systems: Yes

**** Marked Route On Data ****

Designation	Kind	Number
1 Mainline	Interstate Highway	055
1 Mainline		
1 Mainline		

**Illinois Department of Transportation
Structures Information Management System
Structure Summary Report**

District: 1

Structure Number: 016-0021

Data Related to Inspection Information

*** Inspection Intervals ***
 Routine NBIS: 24 MOS Underwater: 0 MOS One Truck At A Time: 0
 Special: N Single Unit Vehicles: Tons Combination Type 3S-1: Tons
 Bridge Posting Level: N

*** Maximum Allowable Posting Limits ***
 Combination Type 3S-2: Tons
 Combination Type 3S-1: Tons

Inspection/Appraisal Information

Inspection Date: 10/18/2014 Inspection Temperature: 51Deg. F
 Deck: N NOT APPLICABLE
 Superstructure: 6 SATISFACTORY CONDITION - MINOR DETERIORATION
 Substructure: 7 GOOD CONDITION - SOME MINOR PROBLEMS
 Culvert: N NOT APPLICABLE
 Channel and Protection: N NOT APPLICABLE
 Structural Evaluation: *
 Deck Geometry: *
 Underclearance-Vert/Lat.: 3 INTOLERABLE - HIGH PRIORITY FOR CORRECTION
 Waterway Adequacy: N NOT APPLICABLE
 Approach Roadway Align: N NOT APPLICABLE
 Bridge Railing Appraisal: N N/A
 Approach Guardrail: NNN N/A
 Pier Navig Protection: N N/A

Deck Wearing Surf: A BARE DECK NO OVRLAY
 Deck Membrane: F NONE
 Deck Protection: J NONE
 Total Deck Thick: 1.0
 Last Paint Date: 04/1990

Single Unit Vehicles: Tons
 Combination Type 3S-1: Tons
 Combination Type 3S-2: Tons
 One Truck At A Time: 0
 Last Paint Type: JC
 IRZC/OXIDE ALKYD
 LD SHP GRN&AL FNL

** Actual Posted Limits **

Underwater Inspection/Appraisal Information

Inspection Date:
Temperature:

Inspection Method:

Appraisal Rating:

Scour Critical Information

Rating:
Analysis Date:

Evaluation Method:
Microfilm Data Recorded:

Miscellaneous

Construction Information

Year: 1963 Original
 Route: FAI-55 Reconstructed
 Section Nbr: 1313-623-SB Sta: 96+68.09
 Contract Nbr: IIG0557031283
 Fed Aid Pr#: IIG0557031283
 Built By: 1 I.D.O.T. Sta:

Pontis

Today's Date: 09/03/2015

Structure Number: 016-0021 District: 1
 (6) Feature Crossed: I- 55 STEVENSON
 (9) Location: 1.55 M NE ILL 50

(41) Bridge Status: 1 OPEN - NO RESTRICT
 (7) Facility Carried: RR - BNSF EAST BR
 (7A) Bridge Name:

Element Inspection Date: 07/29/2015
 (90E) Agency Program Manager: ThompsonDC
 (90E1) Team Leader: ThompsonDC

(90E3) Consultant Program Manager:
 (90E2) Inspector:

Element Insp. Delinquent		Element Insp. Delinquent Reason:									
Elem	Env	% 1	Qty 1	% 2	Qty 2	% 3	Qty 3	% 4	Qty 4	Tot Qty	
Corrugated/Orthotropic/Etc. Deck											
30	2	100	5,624	0	0	0	0	0	0	5,624	
		No deficiencies.	Repaired areas.	Map cracked areas.	Potholes exist.	Adv corr/cracks.					
Remarks: Test											
Lead Painted Steel Open Girder											
107	4	83	8,534	17	1,750	0	0	0	0	10,284	
		No corrosion	Paint distress.	Rust formation	Section loss	Section failure					
Remarks:											
Lead Painted Steel Floor Beam											
152	4	85	16,786	14	2,750	1	225	0	0	19,761	
		No corrosion	Paint distress	Rust formation	Section loss	Section failure					
Remarks:											
Reinforced Conc Pier Wall											
210	4	95	1,527	4	60	1	22	0	0	1,609	
		No deterioration	Minor cracks/spalls	Delams/spalls	Analysis warranted						
Remarks:											
Reinforced Conc Abutment											
215	4	100	780	0	0	0	0	0	0	780	
		No deterioration	Minor cracks/spalls	Delams/spalls	Analysis warranted						
Remarks:											
Reinforced Conc Pier or Abutment Cap											
234	4	92	131	8	12	0	0	0	0	143	
		No deterioration	Minor cracks/spalls	Delams/spalls	Analysis warranted						
Remarks:											
Open Expansion Joint											
304	2	100	116	0	0	0	0	0	0	116	
		No deterioration	Minor deterioration	Advanced corrosion							
Remarks:											

Movable Discontinuous Brg.											
311	4	100	8	0	0	0	0	0	0	0	8
		No deterioration	Minor deterioration		Advanced corrosion						
Remarks:											
Fixed Bearing											
313	4	100	8	0	0	0	0	0	0	0	8
		No deterioration	Minor deterioration		Advanced corrosion						
Remarks:											
Lead Painted Steel Floor Beam Below Deck Joints											
8191	4	87	1,096	13	160	0	0	0	0	0	1,256
Remarks:											
Steel Open Girder											
8406	4	100	9	0	0	0	0	0	0	0	9
Remarks:											



October 27, 2015

MEMORANDUM

Mr. John Fortmann, Region One Engineer
Illinois Department of Transportation
Region One/District One

Attn: Steven Schilke

RE: Existing S.N. 016-0022
E.B. I-55 over Kedzie Ave.
Cook County
PTB 158-002/P-91-762-10

The purpose of this technical memo is to summarize the current condition of existing S.N. 016-0022 in addition to geometrics and other factors. A cursory field check was performed to supplement the information contained in IDOT's structure summary report dated September 2, 2014 (see Appendix B). Broad-based recommendations for this structure are provided below.

The structure is a three span steel beam bridge consisting of nine lines of continuous beams (see Photo 1). Span lengths from west to east are 43'-0", 81'-3" and 43'-0". The superstructure is supported by pile bent abutments and reinforced concrete multi-column piers. There is no overlay on the structure.

IDOT rates the deck as being in good condition, which concurs with the findings from the cursory field check. Minor transverse cracks with leaching are visible over a majority of the soffit (see Photo 2). Hairline longitudinal cracks are visible on the top of deck. IDOT rates the substructure as being in very good condition. The findings from the cursory field check don't match IDOT's substructure rating. Minor vertical cracking is visible on abutment and pier caps. Map cracking and possible delaminations are present at the bases of some columns (see Photo 3). No notable defects or differences were observed between the cursory field check and IDOT's structure summary report for: superstructure, deck geometry, underclearance vert/lat, approach alignment, bridge railing appraisal and approach guardrail items. Moderate diagonal cracking is visible on the approach slabs (see Photo 4). Anchor blocks are missing along sections of the east expansion joint.

Based on the structure summary report and field check, S.N. 016-0022 is suitable for reuse after rehabilitation of the substructure and expansion joints. The approach guardrail transitions should be brought up to current IDOT standards.



LIN ENGINEERING, LTD.
Consulting Engineers

Springfield, IL Westmont, IL

576 Oakmont Lane
Westmont, Illinois 60559
Telephone: (630) 323-5168
Fax: (630) 323-5174
E-mail: info@lineng.com

LIN ENGINEERING, LTD.

A handwritten signature in blue ink that reads "Michael T. Haley". The signature is written in a cursive, flowing style.

Michael T. Haley, PE, SE
Structural Manager

Appendix A – Photos

Appendix B – IDOT Structure Summary Report

Appendix C – PONTIS Report



Photo 1



Photo 2



Photo 3



Photo 4

**Illinois Department of Transportation
Structures Information Management System
Structure Summary Report**

Structure Number: 016-0022 **District:** 1

		Inventory Data	
Facility Carried:	I-55 EB STEVENSON	Bridge Name:	
Feature Crossed:	KEDZIE AVE	Location:	2 M NE ILL 50
Bridge Remarks:		Status Date:	11/1999
Bridge Status:	1 OPEN - NO RESTRICT	Maint Township:	83 SOUTH CHICAGO
Status Remarks:			
Maint County:	016 COOK		
Maint Responsibility:	01 I.D.O.T.		
Service On/Under:	5 SECOND LEVEL INTERCHANGE	1 / HIGHWAY	
Reporting Agency:	1 I.D.O.T. - BUREAU OF MAINTENANCE		
Main Span Matl/Type:	4 STEEL CONTINUOUS	/ 02 STRINGERMULTI-BEAM/GIRDER	
Nbr Of Main Spans:	3	Nbr Of Approach Spans:	0
Approaches			
Near #1 Matl/Type:			
Near #2 Matl/Type:			
Far #1 Matl/Type:			
Far #2 Matl/Type:			
Median Width/Type:	0 Ft./0	None	
Guardrail Type L/R:	0 None	/ 0	None
Toll Facility Indicator:	0	No Toll	
Latitude:	41.82906439	S Longitude:	87.70474075
Deck Structure Type:	A	CIP CON NRMALLY FORM	
Sidewalks Under Structure:	2	Both Sides Not Separate	

		Key Route On Data	
Key Route Nbr:	FEDERAL-AID INTERSTATE	Station:	0055
Appurtenances	Main Route	Segment:	12.5000
Inventory County:	016 COOK	Linked:	Y
Township/Road Dist	83 SOUTH CHICAGO (CHICAGO)	Natl. Hwy System:	On NHS
Municipality	1051 CHICAGO	Inventory Direction:	
Urban Area:	1051	Curr AADT Yr/Count:	2014 / 89500
Functional Class:	1 INTERSTATE	Est Truck Percentage:	6
** CLEARANCES **	South/East	Number Of Lanes:	3
Max Rdwy Width:	58.0	One Or Two Way:	1 One-Way
Horizontal:		Bypass Length:	0
		Future AADT Yr/Cnt:	2032 / 98447
		Designated Truck Rte:	CLASS I
		Special Systems:	Yes
Lateral:			

		Key Route Under Data	
Key Route Nbr:	FEDERAL-AID URBAN	Station:	2831
Appurtenances	Main Route	Segment:	00000
Inventory County:	016 COOK	Linked:	Y
Township/Road Dist	83 SOUTH CHICAGO (CHICAGO)	Natl. Hwy System:	On NHS
Municipality	1051 CHICAGO	Inventory Direction:	
Urban Area:	1051	Curr AADT Yr/Count:	2014 / 19200
Functional Class:	4 MINOR ARTERIAL	Est Truck Percentage:	9
** CLEARANCES **	South/East	Number Of Lanes:	5
Max Rdwy Width:	0.0	One Or Two Way:	2 Two-Way
Horizontal:		Bypass Length:	0
		Future AADT Yr/Cnt:	2032 / 30488
		Designated Truck Rte:	NONE
		Special Systems:	No

		**** Marked Route On Data ****	
Route #1:	1 Mainline	Designation	Kind
Route #2:	1 Mainline	1 Interstate Highway	Number
Route #3:	1 Mainline		055

		**** Marked Route Under Data ****	
Route #1:	1 Mainline	Designation	Kind
Route #2:	1 Mainline	8 Other	Number
Route #3:	1 Mainline		

Illinois Department of Transportation
Structures Information Management System
Structure Summary Report

Structure Number: 016-0022 District: 1

*** Inspection Intervals ***
Routin e NBIS: 24 MOS Underwater: 0 MOS One Truck At A Time: 0 Tons Combination Type 3S-1: Tons Bridge Posting Level: 5 No Posting Required
Special: N Single Unit Vehicles: Tons Combination Type 3S-2: Tons

Data Related to Inspection Information
*** Maximum Allowable Posting Limits ***

Inspection/A appraisal Information
Inspection Date: 09/02/2014 Inspection Temperature: 84Deg. F

Deck: 7 GOOD CONDITION - SOME MINOR PROBLEMS
Superstructure: 8 VERY GOOD CONDITION - NO PROBLEMS NOTED
Substructure: 8 VERY GOOD CONDITION - NO PROBLEMS NOTED
Culvert: N NOT APPLICABLE
Channel and Protection: N NOT APPLICABLE
Structural Evaluation: 8 EQUAL TO PRESENT DESIRABLE CRITERIA
Deck Geometry: 9 SUPERIOR TO PRESENT DESIRABLE CRITERIA
Underclearance-Vert/Lat.: 4 MINIMUM ADEQUACY TO BE LEFT IN PLACE
Waterway Adequacy: N NOT APPLICABLE
Approach Roadway Align: 8 EQUAL TO PRESENT DESIRABLE CRITERIA
Bridge Railing Appraisal: 3 Meets Standards
Approach Guardrail: 233 Not Acceptable Acceptable
Pier Navig Protection: N N/A

Underwater Inspection/A appraisal Information
Inspection Date: Inspection Method: Appraisal Rating:
Temperature:

Scour Critical Information
Evaluation Method: Microfilm Data Recorded: Yes

Construction Information
Year: 1963 Original 1999 Reconstructed
Route: FAI-55 Sta: 125+44 FAI-55 Sta: 30+174.611
Section Nbr: 1314-624-HB 1314-624 HB
Contract Nbr: 82692
Fed Aid Pr#: I 0557032283 IMD-55-7(204)2
Built By: 1 I.D.O.T. 1 I.D.O.T.

Rating: Analysis Date: Evaluation Method: Microfilm Data Recorded: Yes

Pontis

Today's Date: 09/03/2015

Structure Number: 016-0022 District: 1 (41) Bridge Status: 1 OPEN - NO RESTRICT
 (6) Feature Crossed: KEDZIE AVE (7) Facility Carried: I-55 EB STEVENSON
 (9) Location: 2 M NE ILL 50 (7A) Bridge Name:
 Element Inspection Date: 09/02/2014
 (90E) Agency Program Manager: MastnySC (90E3) Consultant Program Manager:
 (90E1) Team Leader: SedlacekJL (90E2) Inspector:

Element Insp. Delinquent		Element Insp. Delinquent Reason:								
Elem	Env	% 1	Qty 1	% 2	Qty 2	% 3	Qty 3	% 4	Qty 4	Tot Qty
Reinforced Conc Column or Pile Extension										
205	3	100	455	0	0	0	0	0	0	455
		No deterioration	Minor cracks/spalls	Delams/spalls	Analysis warranted					
Remarks:										
Reinforced Conc Pier Wall										
210	3	100	1,411	0	0	0	0	0	0	1,411
		No deterioration	Minor cracks/spalls	Delams/spalls	Analysis warranted					
Remarks:										
Reinforced Conc Abutment										
215	3	100	1,164	0	0	0	0	0	0	1,164
		No deterioration	Minor cracks/spalls	Delams/spalls	Analysis warranted					
Remarks: Backwalls- HL vert leach crks typ.										
Reinforced Conc Pier or Abutment Cap										
234	3	100	296	0	0	0	0	0	0	296
		No deterioration	Minor cracks/spalls	Delams/spalls	Analysis warranted					
Remarks: East Abut- HL vert leach crks typ.										
Elastomeric Bearing										
310	4	100	27	0	0	0	0	0	0	27
		No deterioration	Minor deterioration	Major deterioration						
Remarks:										
Fixed Bearing										
313	4	100	9	0	0	0	0	0	0	9
		No deterioration	Minor deterioration	Advanced corrosion						
Remarks: @ Pier 2										
Reinforced Concrete Approach Slab										
321	4	100	1,440	0	0	0	0	0	0	1,440
		No deterioration	Cracks/spalls	Major cracks/spalls	Broken/Unstable					
Remarks: Random HL-Med diag crking. PJS Relief Jnts sunken in.										

Concrete Bridge Railing										
331	4	84	284	16	54	0	0	0	0	338
		No deterioration	Minor cracks/spalls		Analysis warranted					
Remarks: HL vert crks typ.										
Concrete Deck Protected w/ Coated Bars										
8026	4	99	11,751	1	84	0	0	0	0	11,835
Remarks: Wrg Surf- Isol HL trans crks; Soffit- HL trans leach crks										
Non-Lead Painted Steel Open Girder										
8118	4	100	15,648	0	0	0	0	0	0	15,648
Remarks:										
Non-Lead Painted Steel Closed Web/Box Girder Ends										
8173	4	100	18	0	0	0	0	0	0	18
Remarks:										
Continuous Seal Neoprene Expansion Joint										
8308	4	95	143	0	0	5	8	0	0	151
Remarks: East Joint has 8' missing /damaged @ Lanes 2&3.										
Approach Pavement										
8323	4	50	1	50	1	0	0	0	0	2
Remarks: Random HL-Med diag crking. PJS Relief Jnts sunken in.										



October 27, 2015

MEMORANDUM

Mr. John Fortmann, Region One Engineer
Illinois Department of Transportation
Region One/District One

Attn: Steven Schilke

RE: Existing S.N. 016-0023
W.B. I-55 over Kedzie Ave
Cook County
PTB 158-002/P-91-762-10

The purpose of this technical memo is to summarize the current condition of existing S.N. 016-0023 in addition to geometrics and other factors. A cursory field check was performed to supplement the information contained in IDOT's structure summary report dated September 2, 2014 (see Appendix B). Broad-based recommendations for this structure are provided below.

The structure is a three span steel beam bridge consisting of eleven lines of continuous beams (see Photo 1). The span lengths from west to east are 45'-6", 81'-3" and 45'-6". The superstructure is supported by pile bent abutments and reinforced concrete multi-column piers. There is no overlay on the structure.

IDOT rates the deck as being in good condition, which concurs with the findings from the cursory field check. Minor transverse cracks are visible on the top of deck and soffit. IDOT rates the substructure as being in good condition, which concurs with the findings from the cursory field check. Minor vertical cracking and spalling is visible on the abutments and piers. A large crack is visible on the east abutment wingwall (see Photo 2). No notable defects or differences were observed between the cursory field check and IDOT's structure summary report for: superstructure, deck geometry, underclearance vert/lat, approach alignment, bridge railing appraisal and approach guardrail items. A large crack is present on the east slopewall (see Photo 3). Impact damage is visible on the southeast approach parapet (see Photo 4).

Based on the structure summary report and field check, S.N. 016-0023 is suitable for reuse after rehabilitation of the substructure. The approach guardrail transitions should be brought up to current IDOT standards and damaged approach parapets should be replaced. The east slopewall should be repaired.



LIN ENGINEERING, LTD.
Consulting Engineers

Springfield, IL Westmont, IL

576 Oakmont Lane
Westmont, Illinois 60559
Telephone: (630) 323-5168
Fax: (630) 323-5174
E-mail: info@lineng.com

LIN ENGINEERING, LTD.

A handwritten signature in blue ink that reads "Michael T. Haley". The signature is fluid and cursive.

Michael T. Haley, PE, SE
Structural Manager

Appendix A – Photos

Appendix B – IDOT Structure Summary Report

Appendix C – PONTIS Report



Photo 1



Photo 2



Photo 3



Photo 4

**Illinois Department of Transportation
Structures Information Management System
Structure Summary Report**

Structure Number: 016-0023 District: 1

Inventory Data	
Facility Carried:	I-55 WB STEVENSON
Feature Crossed:	3.6 MI SW OF I94
Bridge Status:	1 OPEN - NO RESTRICT
Status Remarks:	016 COOK
Maint County:	01 I.D.O.T.
Service On/Under:	5 SECOND LEVEL INTERCHANGE 1 / HIGHWAY
Reporting Agency:	1 I.D.O.T. - BUREAU OF MAINTENANCE
Main Span Matl/Type:	4 STEEL CONTINUOUS
Nbr Of Main Spans:	3 Nbr Of Approach Spans: 0
Approaches	
Near #1 Matl/Type:	/
Near #2 Matl/Type:	/
Far #1 Matl/Type:	/
Far #2 Matl/Type:	/
Median Width/Type:	0 Ft. / 0 None / 0
Guardrail Type L/R:	0 None / 0
Toll Facility Indicator:	0 No Toll
Latitude:	41.82911422 S Longitude: 87.70457880 S
Deck Structure Type:	A CIP CON NRMALLY FORM
Sidewalks Under Structure:	2 Both Sides Not Separate
Sufficiency Rating:	96.0
HBP Eligible:	No
Replaces:	- Length of Long Span: 81.1
Last Update Date:	06/21/2014
Parallel Structure:	Left Deck Width: 82.0
Multi-Level Structure Nbr:	Sidewalk Width Right: 0.0
Skew Angle:	Left Sidewalk Width Left: 0.0
Structure Flared:	Navigation Control: N
Historical Significance:	No
Border Bridge State:	Navigation Horiz Clear: 0
Bdr State SN:	No
Bdr State % Responsibility:	Navigation Vert Clear: 0
Structural Steel Wt:	580000
Substructure Material:	Culvert Fill Depth: 0.0
Rated By:	2 IDOT
Inventory Rating:	1.795(64)
Operating Rating:	2.750(99)
Design Load:	01 HS20+MOD
Deck Structure Thickness:	7.5 SD: N FO: N
RR Vertical Underclear:	0 Ft 0 In
Rate Method:	6
Load Rating Date:	11/16/2000
Crossing 1 Nbr:	
Crossing 1 Nbr:	
RR Lateral Underclear:	

Key Route On Data	
Key Route Nbr:	FEDERAL-AID INTERSTATE 0055
Station:	12.5100
Segment:	00000
Linked:	Y
Natl. Hwy System:	On NHS
Township/Road Dist:	83 SOUTH CHICAGO (CHICAGO)
Municipality:	1051 CHICAGO
Urban Area:	1051
Functional Class:	1 INTERSTATE
** CLEARANCES **	South/East North/West
Max Rdwy Width:	58.0
Horizontal:	58.0
Vertical:	0.0
Inventory Direction:	2014 / 89500
Curr AADT Yr/Count:	6
Est Truck Percentage:	3
Number Of Lanes:	1 One-Way
One Or Two Way:	0
Bypass Length:	2032 / 99447
Future AADT Yr/Cnt:	CLASS I
Designated Truck Rte:	Yes
Special Systems:	

Key Route Under Data	
Station:	2831
Segment:	00000
Linked:	Y
Natl. Hwy System:	Not on NHS
Inventory Direction:	2014 / 19200
Curr AADT Yr/Count:	9
Est Truck Percentage:	5
Number Of Lanes:	2 Two-Way
One Or Two Way:	0
Bypass Length:	2032 / 30488
Future AADT Yr/Cnt:	NONE
Designated Truck Rte:	
Special Systems:	No

**** Marked Route On Data ****		
Designation	Kind	Number
1 Mainline	1 Interstate Highway	055
1 Mainline		
1 Mainline		

**** Marked Route Under Data ****		
Designation	Kind	Number
1 Mainline	8 Other	
1 Mainline		
1 Mainline		

**Illinois Department of Transportation
Structures Information Management System
Structure Summary Report**

Structure Number: 016-0023 District: 1

Data Related to Inspection Information

*** Inspection Intervals ***
 Routine NBIS: 24 MOS Underwater: 0 MOS One Truck At A Time: 0 Combination Type 3S-1: Tons
 Special: N Single Unit Vehicles: Tons Combination Type 3S-2: Tons
 Bridge Posting Level: 5 No Posting Required

Inspection/Appraisal Information

Inspection Date: 08/02/2014 Inspection Temperature: 84Deg. F
 Deck: 7 GOOD CONDITION - SOME MINOR PROBLEMS
 Superstructure: 8 VERY GOOD CONDITION - NO PROBLEMS NOTED
 Substructure: 7 GOOD CONDITION - SOME MINOR PROBLEMS
 Culvert: N NOT APPLICABLE
 Channel and Protection: N NOT APPLICABLE
 Structural Evaluation: 7 BETTER THAN PRESENT MINIMUM CRITERIA
 Deck Geometry: 9 SUPERIOR TO PRESENT DESIRABLE CRITERIA
 Underclearance-Vert/Lat.: 4 MINIMUM ADEQUACY TO BE LEFT IN PLACE
 Waterway Adequacy: N NOT APPLICABLE
 Approach Roadway Align: 8 EQUAL TO PRESENT DESIRABLE CRITERIA
 Bridge Railing Appraisal: 3 Meets Standards
 Approach Guardrail: 233 Not Acceptable Acceptable
 Pier Navig Protection: N N/A

Deck Wearing Surf: A BARE DECK NO OVRLAY
 Deck Membrane: F NONE
 Deck Protection: A EPOXY COATED REINF
 Total Deck Thick: 7.5
 Last Paint Date: 05/2001

*** Actual Posted Limits ***
 Single Unit Vehicles: Tons
 Combination Type 3S-1: Tons
 Combination Type 3S-2: Tons
 One Truck At A Time: 0
 Last Paint Type: S
 SHP ZINC&FLD ACRYL

Underwater Inspection/Appraisal Information

Inspection Date:
 Temperature:
 Inspection Method:
 Appraisal Rating:

Scour Critical Information

Rating:
 Analysis Date:
 Evaluation Method:
 Microfilm Data Recorded: Yes

Construction Information

Year: 1963 Original 2000 Reconstructed
 Route: FAI-55 Sta: 125+44 FAI-55 Sta: 125+44
 Section Nbr: 1314-624-HB 141562,3,1515.4 ETC
 Contract Nbr: 82989
 Fed Aid Pr#: I 0557032283
 Built By: 1 I.D.O.T. 1 I.D.O.T.

Pontis

Today's Date: 09/03/2015

Structure Number: 016-0023 District: 1 (41) Bridge Status: 1 OPEN - NO RESTRICT
 (6) Feature Crossed: KEDZIE AVE (7) Facility Carried: I- 55 WB STEVENSON
 (9) Location: 2 M NE ILL 50 (7A) Bridge Name: 3.6 MI SW OF I94
 Element Inspection Date: 09/02/2014
 (90E) Agency Program Manager: MastnySC (90E3) Consultant Program Manager:
 (90E1) Team Leader: SedlacekJL (90E2) Inspector:

Element Insp. Delinquent		Element Insp. Delinquent Reason:								
Elem	Env	% 1	Qty 1	% 2	Qty 2	% 3	Qty 3	% 4	Qty 4	Tot Qty
Reinforced Conc Column or Pile Extension										
205	4	100	1,629	0	0	0	0	0	0	1,629
		No deterioration	Minor cracks/spalls	Delams/spalls	Analysis warranted					
Remarks:										
Reinforced Conc Pier Wall										
210	3	99	1,444	1	12	0	0	0	0	1,456
		No deterioration	Minor cracks/spalls	Delams/spalls	Analysis warranted					
Remarks: P1 wall-few small spalls @ Col 3&7. Map crks @ column bases										
Reinforced Conc Abutment										
215	3	100	1,202	0	0	0	0	0	0	1,202
		No deterioration	Minor cracks/spalls	Delams/spalls	Analysis warranted					
Remarks: Backwalls- HL vert leach crks & bkwalls typ.										
Reinforced Conc Pier or Abutment Cap										
234	3	100	356	0	0	0	0	0	0	356
		No deterioration	Minor cracks/spalls	Delams/spalls	Analysis warranted					
Remarks: East Abut- HL vert crks @ steps. West Abut-HL vert leach crks- Backwalls- HL vert leach crk typ.										
Elastomeric Bearing										
310	4	100	33	0	0	0	0	0	0	33
		No deterioration	Minor deterioration	Major deterioration						
Remarks:										
Fixed Bearing										
313	4	100	11	0	0	0	0	0	0	11
		No deterioration	Minor deterioration	Advanced corrosion						
Remarks: @ Pier 2										
Concrete Bridge Railing										
331	4	87	295	13	44	0	0	0	0	339
		No deterioration	Minor cracks/spalls	Analysis warranted						
Remarks: HL vert crks										

Concrete Deck Protected w/ Coated Bars										
8026	4	100	14,039	0	42	0	0	0	0	14,081
Remarks: (WS) HL trans crks; HL random cracking ;Soffit) HL trans leach crks										
Non-Lead Painted Steel Open Girder										
8118	4	100	19,160	0	0	0	0	0	0	19,160
Remarks: Few It collision scrapes Span 1 N End.										
Non-Lead Painted Steel Closed Web/Box Girder Ends										
8173	4	100	22	0	0	0	0	0	0	22
Remarks:										
Continuous Seal Neoprene Expansion Joint										
8308	4	100	179	0	0	0	0	0	0	179
Remarks:										
Approach Pavement										
8323	4	50	1	50	1	0	0	0	0	2
Remarks: Med random crks. East Aprch- 1ft x 1ft pothole in lane 1										



October 27, 2015

MEMORANDUM

Mr. John Fortmann, Region One Engineer
Illinois Department of Transportation
Region One/District One

Attn: Steven Schilke

RE: Existing S.N. 016-0024
E.B. I-55 over California Ave.
Cook County
PTB 158-002/P-91-762-10

The purpose of this technical memo is to summarize the current condition of existing S.N. 016-0024 in addition to geometrics and other factors. A cursory field check was performed to supplement the information contained in IDOT's structure summary report dated September 12, 2014 (see Appendix B). Broad-based recommendations for this structure are provided below.

The structure is a three span steel beam bridge consisting of ten lines of continuous beams (see Photo 1). Span lengths from west to east are 41'-6", 100'-6" and 45'-6". The superstructure is supported by pile bent abutments and reinforced concrete multi-column piers. There is no overlay on the structure.

IDOT rates the deck as being in good condition, which concurs with the findings from the cursory field check. Minor transverse cracks with leaching are visible on a majority of the soffit. Hairline longitudinal cracks are visible on the top of deck. There are a few shallow spalls in the top of deck adjacent to the east expansion joint (see Photo 2). IDOT rates the substructure as being in good condition, which concurs with the findings from the cursory field check. Minor vertical cracking is visible on the abutments and piers. The top of the east pier footing is delaminated (see Photo 3). No notable defects or differences were observed between the cursory field check and IDOT's structure summary report for: superstructure, deck geometry, underclearance vert/lat, approach alignment, bridge railing appraisal and approach guardrail items. Moderate diagonal cracking is visible on the approach slabs (see Photo 4).

Based on the structure summary report and field check, S.N. 016-0024 is suitable for reuse after rehabilitation of the substructure. The approach guardrail transitions should be brought up to current IDOT standards.



LIN ENGINEERING, LTD.
Consulting Engineers

Springfield, IL Westmont, IL

576 Oakmont Lane
Westmont, Illinois 60559
Telephone: (630) 323-5168
Fax: (630) 323-5174
E-mail: info@lineng.com

LIN ENGINEERING, LTD.

A handwritten signature in blue ink that reads "Michael T. Haley". The signature is written in a cursive, flowing style.

Michael T. Haley, PE, SE
Structural Manager

Appendix A – Photos

Appendix B – IDOT Structure Summary Report

Appendix C – PONTIS Report



Photo 1

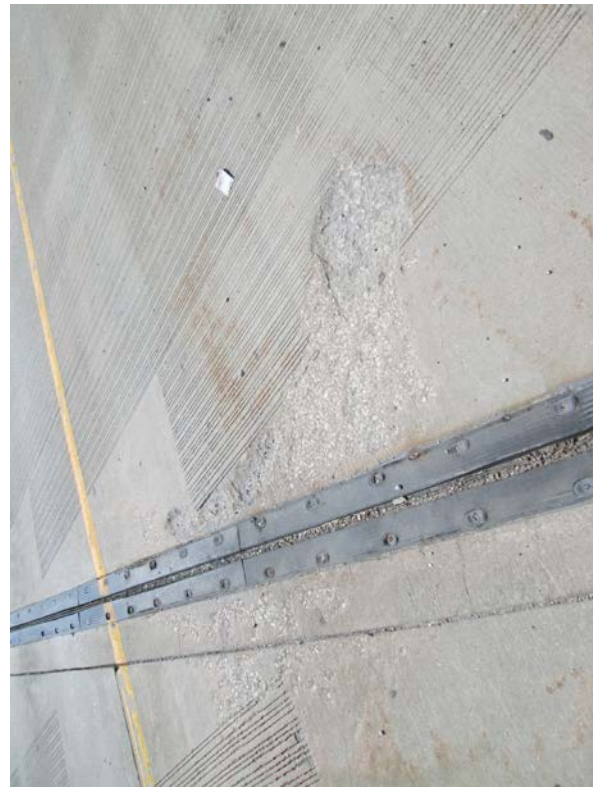


Photo 2



Photo 3



Photo 4

Illinois Department of Transportation
Structures Information Management System
Structure Summary Report

Structure Number: 016-0024 District: 1

Inventory Data	
Facility Carried:	I-55 EB STEVENSON
Feature Crossed:	CALIFORNIA AVE
Bridge Remarks:	DESIGN LOAD MS18&ALT
Bridge Status:	1 OPEN - NO RESTRICT
Status Remarks:	
Maint County:	016 COOK
Maint Responsibility:	01 I.D.O.T.
Service On/Under:	5 SECOND LEVEL INTERCHANGE 1 / HIGHWAY
Reporting Agency:	1 I.D.O.T. - BUREAU OF MAINTENANCE
Main Span Matl/Type:	4 STEEL CONTINUOUS
Nbr Of Main Spans:	3 Nbr Of Approach Spans: 0
Approaches	
Near #1 Matl/Type:	/
Near #2 Matl/Type:	/
Far #1 Matl/Type:	/
Far #2 Matl/Type:	/
Median Width/Type:	0 Ft. / 0 None / 0 None
Guardrail Type L/R:	0 None / 0 None
Toll Facility Indicator:	0 No Toll
Latitude:	41.83212996 S Longitude: 87.69504488 S
Deck Structure Type:	A CIP CON NRMLLY FORM
Sidewalks Under Structure:	2 Both Sides Not Separate

Key Route Under Data	
Key Route Nbr:	FEDERAL-AID INTERSTATE 0055 Station: 13.0400
Appurtenances Main Route	00000
Inventory County:	016 COOK
Township/Road Dist	83 SOUTH CHICAGO (CHICAGO) Natl. Hwy System: On NHS
Municipality	1051 CHICAGO
Urban Area:	1051
Functional Class:	1 INTERSTATE
** CLEARANCES **	South/East North/West
Max Rdwy Width:	77.4
Horizontal:	78.6 0.0
Vertical:	77.4
Laterals:	

Key Route Under Data	
Key Route Nbr:	FEDERAL-AID URBAN 2839 Station: 3.7700
Appurtenances Main Route	00000
Inventory County:	016 COOK
Township/Road Dist	86 WEST CHICAGO (CHICAGO)
Municipality	1051 CHICAGO
Urban Area:	1051
Functional Class:	5 MAJOR COLLECTOR
** CLEARANCES **	South/East North/West
Max Rdwy Width:	72.0
Horizontal:	84.0 0.0
Vertical:	72.0
Laterals:	

Marked Route On Data	
Route #1:	1 Mainline
Route #2:	1 Mainline
Route #3:	1 Mainline

Marked Route Under Data	
Route #1:	1 Mainline
Route #2:	1 Mainline
Route #3:	1 Mainline

**Illinois Department of Transportation
Structures Information Management System
Structure Summary Report**

Structure Number: 016-0024

District: 1

Data Related to Inspection Information

*** Inspection Intervals ***

*** Maximum Allowable Posting Limits ***

Routine NBIS: 24 MOS Underwater: 0 MOS One Truck At A Time: 0 Combination Type 3S-1: Tons
Special: N Single Unit Vehicles: Tons Combination Type 3S-2: Tons

Bridge Posting Level:

5 No Posting Required

Inspection/Appraisal Information

Inspection Date: 09/12/2014 Inspection Temperature: 56Deg. F
Deck: 7 GOOD CONDITION - SOME MINOR PROBLEMS
Superstructure: 8 VERY GOOD CONDITION - NO PROBLEMS NOTED
Substructure: 7 GOOD CONDITION - SOME MINOR PROBLEMS
Culvert: N NOT APPLICABLE
Channel and Protection: N NOT APPLICABLE
Structural Evaluation: 7 BETTER THAN PRESENT MINIMUM CRITERIA
Deck Geometry: 9 SUPERIOR TO PRESENT DESIRABLE CRITERIA
Underclearance-Vert/Lat.: 3 INTOLERABLE - HIGH PRIORITY FOR CORRECTION
Waterway Adequacy: N NOT APPLICABLE
Approach Roadway Align: 8 EQUAL TO PRESENT DESIRABLE CRITERIA
Bridge Railing Appraisal: 3 Meets Standards
Approach Guardrail: 233 Not Acceptable
Pier Navig Protection: N N/A

Deck Wearing Surf: A BARE DECK NO OVRLAY
Deck Membrane: F NONE
Deck Protection: A EPOXY COATED REINF
Total Deck Thick: 7.5
Last Paint Date: 05/2001

Single Unit Vehicles: Tons
Combination Type 3S-1: Tons
Combination Type 3S-2: Tons
One Truck At A Time: 0
Last Paint Type: S
SHP ZINC&FLD ACRYL

** Actual Posted Limits **

Underwater Inspection/Appraisal Information

Inspection Date:
Temperature:

Inspection Method:

Appraisal Rating:

Scour Critical Information

Evaluation Method:

Rating:
Analysis Date: Microfilm Data Recorded: Yes

Construction Information

Year: 1963 Original 1999 Reconstructed
Route: FAI-55 Sta: 154+14.26 FAI-55 Sta: 31+049.329
Section Nbr: 1414-625-HB 1314-638-ETC
Contract Nbr: 82692
Fed Aid Pr#: I 055703284 55-7(199)288
Built By: 1 I.D.O.T. 1 I.D.O.T.

Miscellaneous

Pontis

Today's Date: 09/03/2015

Structure Number: 016-0024 District: 1 (41) Bridge Status: 1 OPEN - NO RESTRICT
 (6) Feature Crossed: CALIFORNIA AVE (7) Facility Carried: I- 55 EB STEVENSON
 (9) Location: 3 M SW DAN RYAN (7A) Bridge Name:
 Element Inspection Date: 09/12/2014
 (90E) Agency Program Manager: MastnySC (90E3) Consultant Program Manager:
 (90E1) Team Leader: SedlacekJL (90E2) Inspector:

Element Insp. Delinquent		Element Insp. Delinquent Reason:								
N										
Element Description										
Elem	Env	% 1	Qty 1	% 2	Qty 2	% 3	Qty 3	% 4	Qty 4	Tot Qty
Reinforced Conc Column or Pile Extension										
205	4	99	1,407	1	12	0	0	0	0	1,419
		No deterioration	Minor cracks/spalls	Delams/spalls	Analysis warranted					
Remarks: Repaired areas crking										
Reinforced Conc Pier Wall										
210	4	100	971	0	0	0	0	0	0	971
		No deterioration	Minor cracks/spalls	Delams/spalls	Analysis warranted					
Remarks:										
Reinforced Conc Abutment										
215	4	98	1,178	2	24	0	0	0	0	1,202
		No deterioration	Minor cracks/spalls	Delams/spalls	Analysis warranted					
Remarks: Vert crks @ backwalls typ.										
Reinforced Conc Pier or Abutment Cap										
234	4	97	342	3	12	0	0	0	0	354
		No deterioration	Minor cracks/spalls	Delams/spalls	Analysis warranted					
Remarks: Piers- Crking @ cantilever ends; Abut Vert crking @ steps typ. W. Abut-Med vert leach crks @ Brg #5.										
Elastomeric Bearing										
310	4	100	30	0	0	0	0	0	0	30
		No deterioration	Minor deterioration	Major deterioration						
Remarks:										
Fixed Bearing										
313	4	100	10	0	0	0	0	0	0	10
		No deterioration	Minor deterioration	Advanced corrosion						
Remarks:										
Concrete Bridge Railing										
331	4	95	359	5	18	0	0	0	0	377
		No deterioration	Minor cracks/spalls	Analysis warranted						
Remarks: HL vert crks										

Concrete Deck Protected w/ Coated Bars										
8026	4	99	15,402	1	220	0	0	0	0	15,622
Remarks: Soffit) Trans leach crks; Few areas <5' c/c WS) HL trans crks w/isol long crks										
Non-Lead Painted Steel Open Girder										
8118	4	100	18,320	0	0	0	0	0	0	18,320
Remarks:										
Non-Lead Painted Steel Closed Web/Box Girder Ends										
8173	4	100	20	0	0	0	0	0	0	20
Remarks:										
Continuous Seal Neoprene Expansion Joint										
8308	4	100	176	0	0	0	0	0	0	176
Remarks:										
Approach Pavement										
8323	4	100	2	0	0	0	0	0	0	2
Remarks:										



October 27, 2015

MEMORANDUM

Mr. John Fortmann, Region One Engineer
Illinois Department of Transportation
Region One/District One

Attn: Steven Schilke

RE: Existing S.N. 016-0025
W.B. I-55 over California Ave.
Cook County
PTB 158-002/P-91-762-10

The purpose of this technical memo is to summarize the current condition of existing S.N. 016-0025 in addition to geometrics and other factors. A cursory field check was performed to supplement the information contained in IDOT's structure summary report dated September 12, 2014 (see Appendix B). Broad-based recommendations for this structure are provided below.

The structure is a three span steel beam bridge consisting of nine lines of continuous beams (see Photo 1). Span lengths from west to east are 41'-6", 100'-6" and 45'-6". The superstructure is supported by pile bent abutments and reinforced concrete multi-column piers. There is no overlay on the structure.

IDOT rates the deck as being in good condition, which concurs with the findings from the cursory field check. Minor longitudinal and transverse cracks are visible on a majority of the top of the deck. IDOT rates the substructure as being in good condition, which concurs with the findings from the cursory field check. Minor vertical cracking is visible on the abutments and pier footings. Some previous column repairs are map cracked (see Photo 2). No notable defects or differences were observed between the cursory field check and IDOT's structure summary report for: superstructure, deck geometry, underclearance vert/lat, approach alignment, bridge railing appraisal and approach guardrail items.

Based on the structure summary report and field check, S.N. 016-0025 is suitable for reuse without rehabilitation. The approach guardrail transitions should be brought up to current IDOT standards.



LIN ENGINEERING, LTD.
Consulting Engineers

Springfield, IL Westmont, IL

576 Oakmont Lane
Westmont, Illinois 60559
Telephone: (630) 323-5168
Fax: (630) 323-5174
E-mail: info@lineng.com

LIN ENGINEERING, LTD.

A handwritten signature in blue ink that reads "Michael T. Haley". The signature is written in a cursive, flowing style.

Michael T. Haley, PE, SE
Structural Manager

Appendix A – Photos

Appendix B – IDOT Structure Summary Report

Appendix C – PONTIS Report



Photo 1



Photo 2

**Illinois Department of Transportation
Structures Information Management System
Structure Summary Report**

Structure Number: 016-0025 District: 1

Facility Carried: I-55 WB STEVENSON	Bridge Name: 3 M SW DAN RYAN	Sufficiency Rating: 96.0	Structure Length: 191.0
Feature Crossed: CALIFORNIA AVE	Location: 3 M SW DAN RYAN	HBP Eligible: No	AASHTO Bridge Length: 99.9
Bridge Remarks:		Replaced By:	Length of Long Span: 100.5
Bridge Status: 1 OPEN - NO RESTRICT	Status Date: 12/2000	Replaces:	Bridge Roadway Width: 66.9
Status Remarks:		Last Update Date: 12/10/2012	Appr Roadway Width: 60.0
Maint County: 016 COOK	Maint Township: 83 SOUTH CHICAGO	Left Deck Width:	70.2
Maint Responsibility: 01 I.D.O.T.		Left Sidewalk Width Right:	0.0
Service On/Under: 5 SECOND LEVEL INTERCHANGE 1 / HIGHWAY		Left Sidewalk Width Left:	0.0
Reporting Agency: 1 I.D.O.T. - BUREAU OF MAINTENANCE		Navigation Control:	N/A
Main Span Matl/Type: 4 STEEL CONTINUOUS	Nbr Of Approach Spans: 0	Navigation Horiz Clear:	0
Nbr Of Main Spans: 3		Navigation Vert Clear:	0
Approaches		Culvert Fill Depth:	0.0
Near #1 Matl/Type: /		Number Culvert Cells:	0
Near #2 Matl/Type: /		Culvert Opening Area:	0.0
Far #1 Matl/Type: /		Structural Steel Wt	792000
Far #2 Matl/Type: /		Substructure Material:	
Median Width/Type: 0 Ft. / 0	Rated By: 2 IDOT	Rate Method:	6
Guardrail Type L/R: 0 None / 0	Inventory Rating: 1.755(63)	Load Rating Date: 11/16/2000	Railroad Crossing Info
Toll Facility Indicator: 0 No Toll	Operating Rating: 2.750(99)	Design Load: 01 HS20+MOD	Crossing 1 Nbr:
Latitude: 41.83218000	S Longitude: 87.68489000	Deck Structure Thickness: 7.5	Crossing 1 Nbr:
Deck Structure Type: A CIP CON NRMLLY FORM		SD: N	RR Lateral Underclear: 0
Sidewalks Under Structure: 2 Both Sides Not Separate		FO: N	RR Vertical Underclear: 0
			Ft 0 In

Key Route On Data		Key Route Under Data	
Key Route Nbr: FEDERAL-AID INTERSTATE 0055	Station: 13.0500	FEDERAL-AID URBAN	Station: 2839
Appurtenances Main Route	Segment: 00000	Main Route	Segment: 00000
Inventory County: 016 COOK	Linked: Y	016	Linked: Y
Township/Road Dist 83 SOUTH CHICAGO (CHICAGO)	Natl. Hwy System: On NHS	86	WEST CHICAGO (CHICAGO)
Municipality 1051 CHICAGO	Inventory Direction:	1051	CHICAGO
Urban Area: 1051	Curr AADT Yr/Count: 2014 / 79950	1051	1051
Functional Class: 1 INTERSTATE	Est Truck Percentage: 7	5	MAJOR COLLECTOR
** CLEARANCES ** South/East North/West	Number Of Lanes: 3	South/East	North/West
Max Rdwy Width: 66.9	One Or Two Way: 1 One-Way	0.0	0.0
Horizontal: 68.1	Bypass Length: 0	84.0	84.0
	Future AADT Yr/Cnt: 2032 / 95069		
Lateral:	Designated Truck Rte: CLASS I		
	Special Systems: Yes		

**** Marked Route On Data ****		**** Marked Route Under Data ****	
Route #1: 1 Mainline	Designation	1	Mainline
Route #2: 1 Mainline	Kind	8	Other
Route #3: 1 Mainline	Number	055	Number

**Illinois Department of Transportation
Structures Information Management System
Structure Summary Report**

Structure Number: 016-0025 **District:** 1

Data Related to Inspection Information

*** Inspection Intervals ***
 Routine NBIS: 24 MOS Underwater: 0 MOS One Truck At A Time: 0
 Special: N Single Unit Vehicles: Tons Combination Type 3S-1: Tons
 Bridge Posting Level: 5 No Posting Required

Inspection/Appraisal Information

Inspection Date: 09/12/2014 Inspection Temperature: 56Deg. F
 Deck: 7 GOOD CONDITION - SOME MINOR PROBLEMS
 Superstructure: 8 VERY GOOD CONDITION - NO PROBLEMS NOTED
 Substructure: 7 GOOD CONDITION - SOME MINOR PROBLEMS
 Culvert: N NOT APPLICABLE
 Channel and Protection: N NOT APPLICABLE
 Structural Evaluation: 7 BETTER THAN PRESENT MINIMUM CRITERIA
 Deck Geometry: 9 SUPERIOR TO PRESENT DESIRABLE CRITERIA
 Underclearance-Vert/Lat.: 4 MINIMUM ADEQUACY TO BE LEFT IN PLACE
 Waterway Adequacy: N NOT APPLICABLE
 Approach Roadway Align: 8 EQUAL TO PRESENT DESIRABLE CRITERIA
 Bridge Railing Appraisal: 3 Meets Standards
 Approach Guardrail: 233 Not Acceptable Acceptable
 Pier Navig Protection: N N/A

Deck Wearing Surf: A BARE DECK NO OVRLAY
 Deck Membrane: F NONE
 Deck Protection: A EPOXY COATED REINF
 Total Deck Thick: 7.5
 Last Paint Date: 05/2001

Underwater Inspection/Appraisal Information

Inspection Date: Inspection Method: Appraisal Rating:
 Temperature: Microfilm Data Recorded: Yes

Scour Critical Information

Rating: Evaluation Method:
 Analysis Date: Microfilm Data Recorded: Yes

Construction Information

Year: 1963 Original 2000 Reconstructed
 Route: FAI-55 Sta: 154+14.26 FAI-55 Sta: 154+14.26
 Section Nbr: 1414-625-HB 1415(.2,.3),1515.4 ETC
 Contract Nbr: 82989
 Fed Aid Pr#: I 0557033284
 Built By: 1 I.D.O.T. 1 I.D.O.T.

Pontis

Today's Date: 09/03/2015

Structure Number: 016-0025 District: 1 (41) Bridge Status: 1 OPEN - NO RESTRICT
 (6) Feature Crossed: CALIFORNIA AVE (7) Facility Carried: I-55 WB STEVENSON
 (9) Location: 3 M SW DAN RYAN (7A) Bridge Name:
 Element Inspection Date: 09/12/2014
 (90E) Agency Program Manager: MastnySC (90E3) Consultant Program Manager:
 (90E1) Team Leader: SedlacekJL (90E2) Inspector:

Element Insp. Delinquent		Element Insp. Delinquent Reason:								
Elem	Env	% 1	Qty 1	% 2	Qty 2	% 3	Qty 3	% 4	Qty 4	Tot Qty
Reinforced Conc Column or Pile Extension										
205	3	98	1,225	2	24	0	0	0	0	1,249
		No deterioration	Minor cracks/spalls	Delams/spalls	Analysis warranted					
Remarks: Crking in repaired areas										
Reinforced Conc Pier Wall										
210	3	100	903	0	0	0	0	0	0	903
		No deterioration	Minor cracks/spalls	Delams/spalls	Analysis warranted					
Remarks:										
Reinforced Conc Abutment										
215	3	99	1,983	1	12	0	0	0	0	1,995
		No deterioration	Minor cracks/spalls	Delams/spalls	Analysis warranted					
Remarks: Vert crks @ backwalls										
Reinforced Conc Pier or Abutment Cap										
234	3	99	294	1	4	0	0	0	0	298
		No deterioration	Minor cracks/spalls	Delams/spalls	Analysis warranted					
Remarks: HL Vert crks @ steps typ. W Abut- Med vert crks @ Brg #2/3										
Elastomeric Bearing										
310	4	100	27	0	0	0	0	0	0	27
		No deterioration	Minor deterioration	Major deterioration						
Remarks:										
Fixed Bearing										
313	4	100	9	0	0	0	0	0	0	9
		No deterioration	Minor deterioration	Advanced corrosion						
Remarks:										
Concrete Bridge Railing										
331	4	94	350	6	22	0	0	0	0	372
		No deterioration	Minor cracks/spalls	Analysis warranted						
Remarks: HL vert crking										

Concrete Deck Protected w/ Coated Bars										
8026	4	100	13,369	0	42	0	0	0	0	13,411
Remarks: Soffit) Trans leach crks; WS) Trans leach crks										
Non-Lead Painted Steel Open Girder										
8118	4	100	16,384	0	0	0	0	0	0	16,384
Remarks:										
Non-Lead Painted Steel Closed Web/Box Girder Ends										
8173	4	100	18	0	0	0	0	0	0	18
Remarks:										
Continuous Seal Neoprene Expansion Joint										
8308	4	100	155	0	0	0	0	0	0	155
Remarks:										
Approach Pavement										
8323	4	100	2	0	0	0	0	0	0	2
Remarks: Crking West Apprch										



October 27, 2015

MEMORANDUM

Mr. John Fortmann, Region One Engineer
Illinois Department of Transportation
Region One/District One

Attn: Steven Schilke

RE: Existing S.N. 016-0026
W.B. I-55 over Western Ave. Viaduct
Cook County
PTB 158-002/P-91-762-10

The purpose of this technical memo is to summarize the current condition of existing S.N. 016-0026 in addition to geometrics and other factors. A cursory field check was performed to supplement the information contained in IDOT's structure summary report dated October 16, 2014 (see Appendix B). Broad-based recommendations for this structure are provided below.

The structure is a twenty-six span steel beam viaduct totaling 2,135 ft. in length (see Photo 1). The superstructure is supported by pile bent abutments and reinforced concrete multi-column piers. There is no overlay on the structure.

IDOT rates the deck as being in good condition, which concurs with the findings from the cursory field check. General discoloration and minor transverse cracks with leaching are visible on a majority of the soffit. IDOT rates the substructure as being in very good condition, which concurs with the findings from the cursory field check. Minor cracking is visible on abutment caps (see Photo 2). IDOT rates the underclearance vertical and lateral as being intolerable requiring a high priority for of corrective action, which concurs with the findings from the cursory field check. The clearance to piers that are adjacent to Western Ave. is less than 8 ft. No notable defects or differences were observed between the cursory field check and IDOT's structure summary report for: superstructure, deck geometry, approach alignment, bridge railing appraisal and approach guardrail items. Anchor blocks are damaged along sections of the west expansion joint. Possible fire damage to the deck soffit and beam ends is visible above the east abutment (see Photo 3).

Based on the structure summary report and field check, S.N. 016-0026 is suitable for reuse after rehabilitation of the expansion joints. The approach guardrail transitions should be brought up to current IDOT standards.



LIN ENGINEERING, LTD.
Consulting Engineers

Springfield, IL Westmont, IL

576 Oakmont Lane
Westmont, Illinois 60559
Telephone: (630) 323-5168
Fax: (630) 323-5174
E-mail: info@lineng.com

LIN ENGINEERING, LTD.

A handwritten signature in blue ink that reads "Michael T. Haley". The signature is fluid and cursive.

Michael T. Haley, PE, SE
Structural Manager

Appendix A – Photos

Appendix B – IDOT Structure Summary Report

Appendix C – PONTIS Report



Photo 1



Photo 2



Photo 3

Illinois Department of Transportation
Structures Information Management System
Structure Summary Report

Structure Number: 016-0026 District: 1

Inventory Data	
Facility Carried:	I-55 WB STEVENSON
Feature Crossed:	WESTERN AVE VIADUCT
Bridge Remarks:	RR LAT.& VER.CL.UNOBTAINABLE: # SPANS ITEM 45 - SPAN 24A & 24 = 27 SPANS
Bridge Status:	1 OPEN - NO RESTRICT
Status Remarks:	
Maint County:	016 COOK
Maint Responsibility:	01 I.D.O.T.
Service On/Under:	1 HIGHWAY
Reporting Agency:	1 I.D.O.T. - BUREAU OF MAINTENANCE
Main Span Matl/Type:	4 STEEL CONTINUOUS
Nbr Of Main Spans:	27
Approaches	
Near #1 Matl/Type:	
Near #2 Matl/Type:	
Far #1 Matl/Type:	
Far #2 Matl/Type:	
Median Width/Type:	0 Ft./0 None
Guardrail Type L/R:	0 None / 0 None
Toll Facility Indicator:	0 No Toll
Latitude:	41.83320471
Longitude:	87.68158120
Deck Structure Type:	A CIP CON NRMALLY FORM
Sidewalks Under Structure:	2 Both Sides Not Separate
Inventory Rating:	1.295(46)
Operating Rating:	2.160(77)
Design Load:	01 HS20+MOD
Deck Structure Thickness:	7.5 SD: N FO: Y
RR Lateral Underclear:	0
RR Vertical Underclear:	0
Rate Method:	6
Load Rating Date:	04/20/2001
Crossing 1 Nbr:	
Crossing 1 Nbr:	

Key Route On Data	
Key Route Nbr:	FEDERAL-AID INTERSTATE
Station:	0055
Segment:	13.3400
Main Route:	00000
Inventory County:	016 COOK
Linked:	Y
Township/Road Dist:	83 SOUTH CHICAGO (CHICAGO)
Natl. Hwy System:	On NHS
Municipality:	1051 CHICAGO
Inventory Direction:	
Urban Area:	1051
Curr AADT Yr/Count:	2014 / 85050
Est Truck Percentage:	6
Number Of Lanes:	3
One Or Two Way:	1 One-Way
Bypass Length:	0
Future AADT Yr/Cnt:	2032 / 95069
Designated Truck Rte:	CLASS I
Special Systems:	Yes
Designation:	1 Interstate Highway
Kind:	055
Number:	

Key Route Under Data	
Key Route Nbr:	FEDERAL-AID PRIMARY
Station:	0370
Segment:	10.7500
Main Route:	00000
Inventory County:	83 SOUTH CHICAGO (CHICAGO)
Natl. Hwy System:	On NHS
Municipality:	1051 CHICAGO
Inventory Direction:	
Urban Area:	1051
Curr AADT Yr/Count:	2014 / 14700
Est Truck Percentage:	13
Number Of Lanes:	4
One Or Two Way:	2 Two-Way
Bypass Length:	0
Future AADT Yr/Cnt:	2032 / 15141
Designated Truck Rte:	NONE
Special Systems:	Yes
Designation:	1 Mainline
Kind:	8 Other
Number:	

Marked Route On Data ***	
Route #1:	1 Mainline
Route #2:	1 Mainline
Route #3:	1 Mainline

Marked Route Under Data ***	
Route #1:	1 Mainline
Route #2:	1 Mainline
Route #3:	1 Mainline

**Illinois Department of Transportation
Structures Information Management System
Structure Summary Report**

Structure Number: 016-0026 District: 1

Data Related to Inspection Information

*** Inspection Intervals ***
 Routine NBIS: 24 MOS Underwater: 0 MOS One Truck At A Time: 0 Combination Type 3S-1: Tons
 Special: N Single Unit Vehicles: Tons Combination Type 3S-2: Tons
 Bridge Posting Level: 5 No Posting Required

Inspection/Appraisal Information

Inspection Date: 10/16/2014 Inspection Temperature: 58Deg. F
 Deck: 7 GOOD CONDITION - SOME MINOR PROBLEMS
 Superstructure: 8 VERY GOOD CONDITION - NO PROBLEMS NOTED
 Substructure: 8 VERY GOOD CONDITION - NO PROBLEMS NOTED
 Culvert: N NOT APPLICABLE
 Channel and Protection: N NOT APPLICABLE
 Structural Evaluation: 8 EQUAL TO PRESENT DESIRABLE CRITERIA
 Deck Geometry: 7 BETTER THAN PRESENT MINIMUM CRITERIA
 Underclearance-Vert/Lat.: 3 INTOLERABLE - HIGH PRIORITY FOR CORRECTION
 Waterway Adequacy: N NOT APPLICABLE
 Approach Roadway Align: 8 EQUAL TO PRESENT DESIRABLE CRITERIA
 Bridge Railing Appraisal: 3 Meets Standards
 Approach Guardrail: 233 Not Acceptable Acceptable
 Pier Navig Protection: N N/A

Deck Wearing Surf: A BARE DECK NO OVRLAY
 Deck Membrane: F NONE
 Deck Protection: A EPOXY COATED REINF
 Total Deck Thick: 7.5
 Last Paint Date: 08/2001

Underwater Inspection/Appraisal Information

Inspection Date: Inspection Method: Appraisal Rating:
 Temperature: Appraisal Rating:

Scour Critical Information

Rating: Evaluation Method: Microfilm Data Recorded: Yes
 Analysis Date: Miscellaneous

Construction Information

Year: 1963 Original 2000 Reconstructed
 Route: FAI-55 Sta: 131+67.77 FAI-55 Sta: 131+67.77
 Section Nbr: 207-1415.2-CF 1415(.2-.3),1515.4
 Contract Nbr: 82989
 Fed Aid Pr#: I-G0557108284
 Built By: 1 I.D.O.T. 1 I.D.O.T.

Pontis

Today's Date: 09/03/2015

Structure Number: 016-0026 District: 1
 (6) Feature Crossed: WESTERN AVE VIADUCT
 (9) Location: 2.5 M SW DAN RYAN
 Element Inspection Date: 10/16/2014
 (90E) Agency Program Manager: MastnySC
 (90E1) Team Leader: SedlacekJL

(41) Bridge Status: 1 OPEN - NO RESTRICT
 (7) Facility Carried: I- 55 WB STEVENSON
 (7A) Bridge Name:
 (90E3) Consultant Program Manager:
 (90E2) Inspector:

Element Insp. Delinquent		Element Insp. Delinquent Reason:								
Elem	Env	% 1	Qty 1	% 2	Qty 2	% 3	Qty 3	% 4	Qty 4	Tot Qty
Reinforced Conc Column or Pile Extension										
205	3	100	22,897	0	0	0	0	0	0	22,897
		No deterioration	Minor cracks/spalls	Delams/spalls	Analysis warranted					
Remarks: Pier 16 Col #1 small spall.										
Reinforced Conc Pier Wall										
210	3	100	17,508	0	0	0	0	0	0	17,508
		No deterioration	Minor cracks/spalls	Delams/spalls	Analysis warranted					
Remarks: Pier 5-vert crks. Pier 18 & 19-med vert leach crks. Pier 20 FCR map crkd.										
Reinforced Conc Abutment										
215	3	100	1,284	0	0	0	0	0	0	1,284
		No deterioration	Minor cracks/spalls	Delams/spalls	Analysis warranted					
Remarks:										
Reinforced Conc Pier or Abutment Cap										
234	3	100	1,953	0	0	0	0	0	0	1,953
		No deterioration	Minor cracks/spalls	Delams/spalls	Analysis warranted					
Remarks: East & West Abut Bkwall-vert leach crks.										
Preformed Joint Seal										
302	4	100	82	0	0	0	0	0	0	82
		No deterioration	Minor deterioration	Major deterioration						
Remarks:										
Modular Joints										
303	4	100	271	0	0	0	0	0	0	271
		No deterioration	Minor deterioration	Advanced corrosion	Corrosion is advance					
Remarks:										
Elastomeric Bearing										
310	4	97	189	0	0	3	6	0	0	195
		No deterioration	Minor deterioration	Major deterioration						
Remarks: Lt Rusting at few assemblies P 22										

Fixed Bearing										
313	4	100	76	0	0	0	0	0	0	76
		No deterioration	Minor deterioration	Advanced corrosion						
Remarks:										
Concrete Bridge Railing										
331	4	100	4,256	0	0	0	0	0	0	4,256
		No deterioration	Minor cracks/spalls	Analysis warranted						
Remarks: HL Vert crks										
Concrete Deck Protected w/ Coated Bars										
8026	4	93	130,915	7	10,310	0	0	0	0	141,225
Remarks: (Soffit) Trans leach crcking w/ few areas <5' c/c WS)Trans crks w/intersect longitudinal										
Non-Lead Painted Steel Open Girder										
8118	4	100	193,188	0	0	0	0	0	0	193,188
Remarks: Noticeable sagging @ Span 2 All Beams										
Non-Lead Painted Steel Closed Web/Box Girder Ends										
8173	4	100	102	0	0	0	0	0	0	102
Remarks:										
Continuous Seal Neoprene Expansion Joint										
8308	4	95	121	0	0	5	6	0	0	127
Remarks: 5' of Hold Down Missing @ West Abut Lane 3										
Approach Pavement										
8323	4	100	2	0	0	0	0	0	0	2
Remarks:										



October 27, 2015

MEMORANDUM

Mr. John Fortmann, Region One Engineer
Illinois Department of Transportation
Region One/District One

Attn: Steven Schilke

RE: Existing S.N. 016-0027
W.B. I-55 over Lock St.
Cook County
PTB 158-002/P-91-762-10

The purpose of this technical memo is to summarize the current condition of existing S.N. 016-0027 in addition to geometrics and other factors. A cursory field check was performed to supplement the information contained in IDOT's structure summary report dated August 22, 2014 (see Appendix B). Broad-based recommendations for this structure are provided below.

The structure is a three span steel beam bridge consisting of nine lines of continuous beams (see Photo 1). Span lengths from west to east are 60'-4½", 69'-1½" and 60'-4½". The superstructure is supported by pile bent abutments and reinforced concrete multi-column piers. There is no overlay on the structure.

IDOT rates the deck as being in good condition, which concurs with the findings from the cursory field check. Minor transverse cracks with leaching are visible on a majority of the soffit (see Photo 2). IDOT rates the superstructure as being in good condition, which concurs with the findings from the cursory field check. Multiple bays on both ends exhibit possible fire damage (see Photo 3). IDOT rates the substructure as being in very good condition, which concurs with the findings from the cursory field check. Minor spalls are visible on the piers (see Photo 4). No notable defects or differences were observed between the cursory field check and IDOT's structure summary report for: deck geometry, underclearance vert/lat, approach alignment and bridge railing appraisal items. Transverse cracks are visible on both approach slabs. The strip seal is damaged along sections of both expansion joints (see Photo 5).

Based on the structure summary report and field check, S.N. 016-0027 is suitable for reuse after rehabilitation of the expansion joints.



LIN ENGINEERING, LTD.
Consulting Engineers

Springfield, IL Westmont, IL

576 Oakmont Lane
Westmont, Illinois 60559
Telephone: (630) 323-5168
Fax: (630) 323-5174
E-mail: info@lineng.com

LIN ENGINEERING, LTD.

A handwritten signature in blue ink that reads "Michael T. Haley". The signature is written in a cursive, flowing style.

Michael T. Haley, PE, SE
Structural Manager

Appendix A – Photos

Appendix B – IDOT Structure Summary Report

Appendix C – PONTIS Report



Photo 1



Photo 2



Photo 3



Photo 4



Photo 5

Illinois Department of Transportation
Structures Information Management System
Structure Summary Report

Structure Number: 016-0027 District: 1

Inventory Data

Facility Carried: I-55 WB STEVENSON
 Feature Crossed: LOCK ST
 Bridge Name: 1.1 M SW 194
 Location: 12/2000
 Status Date: 83 SOUTH CHICAGO
 Maint Township: 1 / HIGHWAY
 Service On/Under: 1 I.D.O.T.
 Reporting Agency: 1 I.D.O.T. - BUREAU OF MAINTENANCE
 Main Span Matl/Type: 4 STEEL CONTINUOUS
 Nbr Of Main Spans: 3 Nbr Of Approach Spans: 0
 Approaches
 Near #1 Matl/Type: /
 Near #2 Matl/Type: /
 Far #1 Matl/Type: /
 Far #2 Matl/Type: /
 Median Width/Type: 0 Ft. / 0 None / 0
 Guardrail Type L/R: 0 None / 0
 Toll Facility Indicator: 0 No Toll
 Latitude: 41.8406881 S Longitude: 87.66141562 S
 Deck Structure Type: A CIP CON NRMALLY FORM
 Sidewalks Under Structure: 2 Both Sides Not Separate

Sufficiency Rating: 98.0 Structure Length: 194.9
 HBP Eligible: No AASHTO Bridge Length: 99.9
 Replaced By: - Length of Long Span: 89.1
 Replaces: - Bridge Roadway Width: 69.2
 Last Update Date: 06/21/2014 Appr Roadway Width: 57.1
 Parallel Structure: Left Deck Width: 72.4
 Multi-Level Structure Nbr: Sidewalk Width Right: 0.0
 Skew Direction: L Left Sidewalk Width Left: 0.0
 Structure Flared: 3 D Navigation Control: N N/A
 Historical Significance: No Navigation Horiz Clear: 0
 Border Bridge State: No Navigation Vert Clear: 0
 Bdr State SN: Culvert Fill Depth: 0.0
 Bdr State % Responsibility: 0 Culvert Opening Area: 0.0
 Structural Steel Wt: 406000 Culvert Cell Height: 0.00
 Substructure Material: Culvert Cell Width: 0.00
 Rated By: 2 IDOT Rate Method: 6
 Inventory Rating: 1.840(66) Load Rating Date: 04/20/2001 Railroad Crossing Info
 Operating Rating: 2.750(99) Crossing 1 Nbr: 0
 Design Load: 01 HS20+MOD Crossing 1 Nbr: 0
 Deck Structure Thickness: 7.5 SD: N FO: N RR Lateral Underclear: 0 Ft 0 In
 RR Vertical Underclear: 0

Key Route Under Data

Key Route Nbr	Station	Segment	Linked	Station	Segment	Linked
FEDERAL-AID INTERSTATE	0055	14.9800	Y	2150	01051	Y
Appurtenances Main Route	00000					
Inventory County:	016 COOK					
Township/Road Dist	83 SOUTH CHICAGO (CHICAGO)	On NHS				Not on NHS
Municipality	1051 CHICAGO					
Urban Area:	1051					
Functional Class:	1 INTERSTATE					
** CLEARANCES **	South/East	North/West				
Max Rdwy Width:	69.2	0.0				
Horizontal:	70.3	0.0				
Inventory Rating:	2014 / 71800					
Est Truck Percentage:	8					
Number Of Lanes:	4					
One Or Two Way:	1 One-Way					
Bypass Length:	0					
Future AADT Yr/Cnt:	2032 / 87087					
Designated Truck Rte:	CLASS I					
Special Systems:	Yes					

*** Marked Route On Data ***

Route #1:	Designation	Kind	Number
1	Mainline	1	Mainline
2	Mainline	1	Mainline
3	Mainline	1	Mainline

*** Marked Route Under Data ***

Route #1:	Designation	Kind	Number
5	Municipal Streets	5	Municipal Streets

Illinois Department of Transportation
Structures Information Management System
Structure Summary Report

Structure Number: 016-0027 District: 1

*** Inspection Intervals ***
Routine NBIS: 24 MOS Underwater: 0 MOS One Truck At A Time: 0 Tons Combination Type 3S-1: Tons Bridge Posting Level: 5 No Posting Required
Special: N Single Unit Vehicles: Tons Combination Type 3S-2: Tons

Data Related to Inspection Information
*** Maximum Allowable Posting Limits ***
Inspection/Apraisal Information
Inspection Date: 08/22/2014 Inspection Temperature: 82Deg. F
Deck: 7 GOOD CONDITION - SOME MINOR PROBLEMS
Superstructure: 7 GOOD CONDITION - SOME MINOR PROBLEMS
Substructure: 8 VERY GOOD CONDITION - NO PROBLEMS NOTED
Culvert: N NOT APPLICABLE
Channel and Protection: N NOT APPLICABLE
Structural Evaluation: 7 BETTER THAN PRESENT MINIMUM CRITERIA
Deck Geometry: 7 BETTER THAN PRESENT MINIMUM CRITERIA
Underclearance-Vert/Lat.: 9 SUPERIOR TO PRESENT DESIRABLE CRITERIA
Waterway Adequacy: N NOT APPLICABLE
Approach Roadway Align: 8 EQUAL TO PRESENT DESIRABLE CRITERIA
Bridge Railing Appraisal: 3 Meets Standards
Approach Guardrail: N/A N/A
Pier Navig Protection: N N/A

*** Actual Posted Limits ***
Single Unit Vehicles: Tons
Combination Type 3S-1: Tons
Combination Type 3S-2: Tons
One Truck At A Time: 0
Deck Wearing Surf: A BARE DECK NO OVRLAY Last Paint Type: U
Deck Membrane: F NONE FLD AL EPY & ACRLC
Deck Protection: A EPOXY COATED REINF
Total Deck Thick: 7.5
Last Paint Date: 07/2001

Underwater Inspection/Apraisal Information
Inspection Method: Appraisal Rating:
Inspection Date:
Temperature:

Scour Critical Information
Evaluation Method:
Rating:
Analysis Date:

Construction Information
Year: 1963 Original 2000 Reconstructed
Route: FAI-55 Sta: 197+53.87 FAI-55 Sta: 197+53.87
Section Nbr: 207-1616.7 1616(.4,.6)R-1,ETC
Contract Nbr: 82992
Fed Aid Pr#: I 0557074285
Built By: 1 I.D.O.T. 1 I.D.O.T.

Miscellaneous
Microfilm Data Recorded: Yes

Pontis

Today's Date: 09/03/2015

Structure Number: 016-0027 District: 1 (41) Bridge Status: 1 OPEN - NO RESTRICT
 (6) Feature Crossed: LOCK ST (7) Facility Carried: I- 55 WB STEVENSON
 (9) Location: 1.1 M SW I94 (7A) Bridge Name:
 Element Inspection Date: 08/22/2014
 (90E) Agency Program Manager: MastnySC (90E3) Consultant Program Manager:
 (90E1) Team Leader: SedlacekJL (90E2) Inspector:

Element Insp. Delinquent		Element Insp. Delinquent Reason:									
Elem	Env	% 1	Qty 1	% 2	Qty 2	% 3	Qty 3	% 4	Qty 4	Tot Qty	
Reinforced Conc Column or Pile Extension											
205	3	100	1,318	0	2	0	0	0	0	1,320	
		No deterioration	Minor cracks/spalls		Delams/spalls		Analysis warranted				
Remarks:											
Reinforced Conc Pier Wall											
210	3	100	1,789	0	1	0	0	0	0	1,790	
		No deterioration	Minor cracks/spalls		Delams/spalls		Analysis warranted				
Remarks: HL cracking crash wall.											
Reinforced Conc Abutment											
215	3	100	866	0	4	0	0	0	0	870	
		No deterioration	Minor cracks/spalls		Delams/spalls		Analysis warranted				
Remarks: Few shallow rebar spalls @ backwalls.											
Reinforced Conc Pier or Abutment Cap											
234	3	100	308	0	0	0	0	0	0	308	
		No deterioration	Minor cracks/spalls		Delams/spalls		Analysis warranted				
Remarks: Shrinkage cracking.											
Preformed Joint Seal											
302	4	100	144	0	0	0	0	0	0	144	
		No deterioration	Minor deterioration		Major deterioration						
Remarks:											
Elastomeric Bearing											
310	4	100	27	0	0	0	0	0	0	27	
		No deterioration	Minor deterioration		Major deterioration						
Remarks:											
Fixed Bearing											
313	4	100	9	0	0	0	0	0	0	9	
		No deterioration	Minor deterioration		Advanced corrosion						
Remarks:											

Concrete Bridge Railing										
331	4	100	383	0	0	0	0	0	0	383
		No deterioration	Minor cracks/spalls	Analysis warranted						
Remarks: HL vert crking										
Concrete Deck Protected w/ Coated Bars										
8026	4	89	12,346	11	1,522	0	0	0	0	13,868
Remarks: Soffit) HL trans leach crcking; WS) HL-nar trans crks w/ longit Sp1 Lns 2 & 3. Haunch										
Non-Lead Painted Steel Open Girder										
8118	4	99	16,640	1	252	0	0	0	0	16,892
Remarks: Fire residue near few interior beam ends										
Non-Lead Painted Steel Closed Web/Box Girder Ends										
8173	4	67	12	33	6	0	0	0	0	18
Remarks: Fire residue @ few interior beam ends										
Approach Pavement										
8323	4	100	2	0	0	0	0	0	0	2
Remarks:										



October 27, 2015

MEMORANDUM

Mr. John Fortmann, Region One Engineer
Illinois Department of Transportation
Region One/District One

Attn: Steven Schilke

RE: Existing S.N. 016-0028
E.B. I-55 over Lock St.
Cook County
PTB 158-002/P-91-762-10

The purpose of this technical memo is to summarize the current condition of existing S.N. 016-0028 in addition to geometrics and other factors. A cursory field check was performed to supplement the information contained in IDOT's structure summary report dated August 22, 2014 (see Appendix B). Broad-based recommendations for this structure are provided below.

The structure is a three span steel beam bridge consisting of ten lines of continuous beams (see Photo 1). Span lengths from west to east are 60'-4", 69'-1" and 60'-4". The superstructure is supported by pile bent abutments and reinforced concrete multi-column piers. There is no overlay on the structure.

IDOT rates the deck as being in satisfactory condition, which concurs with the findings from the cursory field check. Moderate transverse cracks with leaching are visible on a majority of the soffit (see Photo 2). No notable defects or differences were observed between the cursory field check and IDOT's structure summary report for: superstructure, substructure, deck geometry, underclearance vert/lat, approach alignment and bridge railing appraisal items. Multiple bays along the east abutment exhibit possible fire damage (see Photo 3). A few elastomeric bearings on the west abutment are exhibiting rotation with a slight amount of uplift along the inside edges (see Photo 4). Small spalls, large transverse cracks and longitudinal cracks are visible on both approach slabs (see Photo 5).

Based on the structure summary report and field check, S.N. 016-0028 is suitable for reuse without rehabilitation.



LIN ENGINEERING, LTD.
Consulting Engineers

Springfield, IL Westmont, IL

576 Oakmont Lane
Westmont, Illinois 60559
Telephone: (630) 323-5168
Fax: (630) 323-5174
E-mail: info@lineng.com

LIN ENGINEERING, LTD.

A handwritten signature in blue ink that reads "Michael T. Haley". The signature is written in a cursive style.

Michael T. Haley, PE, SE
Structural Manager

Appendix A – Photos

Appendix B – IDOT Structure Summary Report

Appendix C – PONTIS Report



Photo 1



Photo 2



Photo 3



Photo 4



Photo 5

**Illinois Department of Transportation
Structures Information Management System
Structure Summary Report**

Date: 07/28/2015
Page: 1

Structure Number: 016-0028 District: 1

Inventory Data

Facility Carried: I-55 EB STEVENSON
 Feature Crossed: LOCK ST
 Bridge Remarks: DESIGN LOAD MS18SALT
 Bridge Status: 1 OPEN - NO RESTRICT
 Status Remarks: 016 COOK
 Maint County: 01 I.D.O.T.
 Maint Responsibility: 1 HIGHWAY
 Service On/Under: 1 I.D.O.T. - BUREAU OF MAINTENANCE
 Reporting Agency: 4 STEEL CONTINUOUS
 Main Span Matl/Type: 3 Nbr Of Approach Spans: 0
 Approaches
 Near #1 Matl/Type: /
 Near #2 Matl/Type: /
 Far #1 Matl/Type: /
 Far #2 Matl/Type: /
 Median Width/Type: 0 Ft. / 0 None / 0
 Guardrail Type L/R: 0 None / 0
 Toll Facility Indicator: 0 No Toll
 Latitude: 41.84076768 S Longitude: 87.66122146 S
 Deck Structure Type: A CIP CON NRMALLY FORM
 Sidewalks Under Structure: 2 Both Sides Not Separate

Bridge Name: SOUTH CHICAGO
 Location: 1.1 M SW I94
 Status Date: 07/1999
 Maint Township: 83 HIGHWAY
 Inventory Rating: 1,350(48)
 Operating Rating: 2,250(81)
 Design Load: 99 UNKNOWN
 Deck Structure Thickness: 7.5 SD: N FO: N
 RR Lateral Underclear: 0 Ft 0 In

Sufficiency Rating: 98.0 Structure Length: 194.7
 HBP Eligible: No AASHTO Bridge Length: 99.9
 Replaced By: - Length of Long Span: 69.1
 Replaces: - Bridge Roadway Width: 77.5
 Last Update Date: 06/21/2014 Appr Roadway Width: 73.8
 Parallel Structure: Right Deck Width: 80.8
 Multi-Level Structure Nbr: Sidewalk Width Right: 0.0
 Skew Direction: L Left Sidewalk Width Left: 0.0
 Skew Angle: 2 D Navigation Control: N N/A
 Structure Flared: 0 No Navigation Horiz Clear: 0
 Historical Significance: No Navigation Vert Clear: 0
 Border Bridge State: No Culvert Fill Depth: 0.0
 Bdr State SN: Number Culvert Cells: 0
 Bdr State % Responsibility: 0 Culvert Opening Area: 0.0
 Structural Steel Wt: 406000 Culvert Cell Height: 0.00
 Substructure Material: Culvert Cell Width: 0.00
 Rated By: 2 IDOT Rate Method: 6
 Load Rating Date: 10/17/2000 Railroad Crossing Info
 Crossing 1 Nbr: 0
 Crossing 1 Nbr: 0
 RR Lateral Underclear: 0
 RR Vertical Underclear: 0

Key Route On Data

Key Route Nbr	Station	Segment	Linked	Natl. Hwy System	Inventory Direction	Curr AADT Yr/Count	Est Truck Percentage	Number Of Lanes	One Or Two Way	Bypass Length	Future AADT Yr/Cnt	Designated Truck Rte	Special Systems
FEDERAL-AID INTERSTATE	0055												
Main Route	14.9900		Y	On NHS		2014 / 71800	8	4	1 One-Way	0	2032 / 87087	CLASS I	Yes
Appurtenances	00000												
Inventory County	016 COOK												
Township/Road Dist	83 SOUTH CHICAGO (CHICAGO)												
Municipality	1051 CHICAGO												
Urban Area	1051												
Functional Class	1 INTERSTATE												
** CLEARANCES **	South/East	North/West											
Max Rdwy Width	77.5	0.0											
Horizontal	78.7	0.0											
Laterals													

Key Route Under Data

Key Route Nbr	Station	Segment	Linked	Natl. Hwy System	Inventory Direction	Curr AADT Yr/Count	Est Truck Percentage	Number Of Lanes	One Or Two Way	Bypass Length	Future AADT Yr/Cnt	Designated Truck Rte	Special Systems
MUNICIPAL STREET	2150												
Main Route	01051		Y	Not on NHS		1998 / 10	0	2	Two-Way	0	2032 / 12	NONE	No
Appurtenances	01051												
Inventory County	016 COOK												
Township/Road Dist	86 WEST CHICAGO (CHICAGO)												
Municipality	1051 CHICAGO												
Urban Area	1051												
Functional Class	7 LOCAL												
** CLEARANCES **	South/East	North/West											
Max Rdwy Width	30.2	0.0											
Horizontal	69.9	0.0											
Laterals													

Marked Route On Data

Route #	Designation	Kind	Number
1	Mainline	Interstate Highway	055
1	Mainline		
1	Mainline		

Marked Route Under Data

Route #	Designation	Kind	Number
1	Mainline	Municipal Streets	5
1	Mainline		
1	Mainline		

**Illinois Department of Transportation
Structures Information Management System
Structure Summary Report**

Structure Number: 016-0028 District: 1

Data Related to Inspection Information

*** Inspection Intervals ***
 Routine NBIS: 24 MOS Underwater: 0 MOS One Truck At A Time: 0 Tons Combination Type 3S-1: Tons Bridge Posting Level:
 Special: N Single Unit Vehicles: Tons Combination Type 3S-2: Tons 5 No Posting Required

Inspection/Appraisal Information

Inspection Date: 08/22/2014 Inspection Temperature: 82Deg. F
 Deck: 6 SATISFACTORY CONDITION - MINOR DETERIORATION
 Superstructure: 8 VERY GOOD CONDITION - NO PROBLEMS NOTED
 Substructure: 8 VERY GOOD CONDITION - NO PROBLEMS NOTED
 Culvert: N NOT APPLICABLE
 Channel and Protection: N NOT APPLICABLE
 Structural Evaluation: 8 EQUAL TO PRESENT DESIRABLE CRITERIA
 Deck Geometry: 9 SUPERIOR TO PRESENT DESIRABLE CRITERIA
 Underclearance-Vert/Lat.: 6 EQUAL TO PRESENT MINIMUM CRITERIA
 Waterway Adequacy: N NOT APPLICABLE
 Approach Roadway Align: 8 EQUAL TO PRESENT DESIRABLE CRITERIA
 Bridge Railing Appraisal: 3 Meets Standards
 Approach Guardrail: N/A N/A
 Pier Navig Protection: N N/A

Deck Wearing Surf: A BARE DECK NO OVRLAY
 Deck Membrane: F NONE
 Deck Protection: A EPOXY COATED REINF
 Total Deck Thick: 7.5
 Last Paint Date: 07/2001

Underwater Inspection/Appraisal Information

Inspection Date:
 Temperature:
 Inspection Method:
 Appraisal Rating:

Scour Critical Information

Rating:
 Analysis Date:
 Evaluation Method:
 Microfilm Data Recorded: Yes

Construction Information

Year: 1963 Original 1999 Reconstructed
 Route: FAI-55 Sta: 197+53.87 FAI-55 Sta: 34+021.981
 Section Nbr: 207-1616.7 1616(.4, 6)+1717 6-3P
 Contract Nbr: 82981
 Fed Aid Pr#: I 0557074285
 Built By: 1 I.D.O.T. 1 I.D.O.T.

Pontis

Today's Date: 09/03/2015

Structure Number: 016-0028 District: 1 (41) Bridge Status: 1 OPEN - NO RESTRICT
 (6) Feature Crossed: LOCK ST (7) Facility Carried: I- 55 EB STEVENSON
 (9) Location: 1.1 M SW 194 (7A) Bridge Name:
 Element Inspection Date: 08/22/2014
 (90E) Agency Program Manager: MastnySC (90E3) Consultant Program Manager:
 (90E1) Team Leader: SedlacekJL (90E2) Inspector:

Element Insp. Delinquent		Element Insp. Delinquent Reason:									
Elem	Env	% 1	Qty 1	% 2	Qty 2	% 3	Qty 3	% 4	Qty 4	Tot Qty	
Reinforced Conc Column or Pile Extension											
205	3	100	1,285	0	0	0	0	0	0	1,285	
			No deterioration	Minor cracks/spalls	Delams/spalls	Analysis warranted					
Remarks:											
Reinforced Conc Pier Wall											
210	3	100	1,917	0	0	0	0	0	0	1,917	
			No deterioration	Minor cracks/spalls	Delams/spalls	Analysis warranted					
Remarks: HL cracking @ crash wall.											
Reinforced Conc Abutment											
215	3	99	947	1	6	0	0	0	0	953	
			No deterioration	Minor cracks/spalls	Delams/spalls	Analysis warranted					
Remarks: Few shallow rebar spalls @ backwalls.											
Reinforced Conc Pier or Abutment Cap											
234	3	100	331	0	0	0	0	0	0	331	
			No deterioration	Minor cracks/spalls	Delams/spalls	Analysis warranted					
Remarks: Shrinkage cracking.											
Preformed Joint Seal											
302	4	100	161	0	0	0	0	0	0	161	
			No deterioration	Minor deterioration	Major deterioration						
Remarks:											
Elastomeric Bearing											
310	4	100	30	0	0	0	0	0	0	30	
			No deterioration	Minor deterioration	Major deterioration						
Remarks:											
Fixed Bearing											
313	4	100	10	0	0	0	0	0	0	10	
			No deterioration	Minor deterioration	Advanced corrosion						
Remarks:											

Concrete Bridge Railing										
331	4	100	384	0	0	0	0	0	0	384
		No deterioration	Minor cracks/spalls	Analysis warranted						
Remarks: HL vert crks										
Concrete Deck Protected w/ Coated Bars										
8026	4	90	13,648	10	1,588	0	0	0	0	15,236
Remarks: Soffit) HL trans leach crking w/majority < 5' c/c; WS) Trans crking w/intersecting long crks										
Non-Lead Painted Steel Open Girder										
8118	4	99	18,606	1	150	0	0	0	0	18,756
Remarks: Fire residue near interior beam ends.										
Non-Lead Painted Steel Closed Web/Box Girder Ends										
8173	4	80	16	20	4	0	0	0	0	20
Remarks: Fire residue @ few interior ends.										
Approach Pavement										
8323	4	100	2	0	0	0	0	0	0	2
Remarks: Nar Random Crks										



October 27, 2015

MEMORANDUM

Mr. John Fortmann, Region One Engineer
Illinois Department of Transportation
Region One/District One

Attn: Steven Schilke

RE: Existing S.N. 016-0029
E.B. I-55 over Loomis St. and Fuller St.
Cook County
PTB 158-002/P-91-762-10

The purpose of this technical memo is to summarize the current condition of existing S.N. 016-0029 in addition to geometrics and other factors. A cursory field check was performed to supplement the information contained in IDOT's structure summary report dated September 9, 2015 (see Appendix B). Broad-based recommendations for this structure are provided below.

The structure is a six span steel beam bridge consisting of ten lines of continuous beams. (see Photo 1). Span lengths from west to east are 81'-9", 103'-6", 60'-2", 60'-0", 68'-6" and 54'-3". The superstructure is supported by pile bent abutments and reinforced concrete multi-column piers. There is no overlay on the structure.

IDOT rates the deck as being in good condition, which concurs with the findings from the cursory field check. Minor transverse cracks with leaching are visible on a majority of the soffit (see Photo 2). IDOT rates the superstructure as being in very good condition, which concurs with the findings from the cursory field check. A few side retainers are missing (see Photo 3). Additionally, possible fire damage to the beam ends is visible above the east abutment (see Photo 4). IDOT rates the substructure as being in very good condition, which concurs with the findings from the cursory field check. Shallow spalls and minor vertical cracks are visible on the abutments (see Photo 5). No notable defects or differences were observed between the cursory field check and IDOT's structure summary report for: deck geometry, underclearance ver/lat, approach alignment and bridge railing appraisal items. Sections of the west expansion joint seal are missing. Anchor blocks are damaged along sections of the east expansion joint. Large transverse cracks and small spalls are visible on both approach slabs (see Photo 6).

Based on the structure summary report and field check, S.N. 016-0029 is suitable for reuse after rehabilitation of the superstructure and expansion joints.



LIN ENGINEERING, LTD.
Consulting Engineers

Springfield, IL Westmont, IL

576 Oakmont Lane
Westmont, Illinois 60559
Telephone: (630) 323-5168
Fax: (630) 323-5174
E-mail: info@lineng.com

LIN ENGINEERING, LTD.

A handwritten signature in blue ink that reads "Michael T. Haley". The signature is written in a cursive, flowing style.

Michael T. Haley, PE, SE
Structural Manager

Appendix A – Photos

Appendix B – IDOT Structure Summary Report

Appendix C – PONTIS Report



Photo 1



Photo 2



Photo 3



Photo 4



Photo 5



Photo 6

**Illinois Department of Transportation
Structures Information Management System
Structure Summary Report**

Structure Number: 016-0029 District: 1

Facility Carried:	I-55 EB STEVENSON	Bridge Name:		Sufficiency Rating:	98.0	Structure Length:	435.9
Feature Crossed:	LOOMIS & FULLER STS	Location:	0.9 M SW I94	HBP Eligible:	No	AASHTO Bridge Length:	99.9
Bridge Remarks:		Status Date:	11/1999	Replaced By:	-	Length of Long Span:	103.8
Bridge Status:	1 OPEN - NO RESTRICT	Maint Township:	83 SOUTH CHICAGO	Last Update Date:	06/21/2014	Appr Roadway Width:	72.8
Status Remarks:		Maint County:	COOK	Parallel Structure:		Roadway Width:	60.0
Maint County:	016 COOK	Maint Township:	83 SOUTH CHICAGO	Multi-Level Structure Nbr:		Deck Width:	76.1

Key Route On Data

Key Route Nbr:	FEDERAL-AID INTERSTATE	Station:	0055	Segment:	15.1100
Appurtenances Main Route	00000	Linked:	Y		
Inventory County:	016 COOK	Natl. Hwy System:	On NHS		
Township/Road Dist	83 SOUTH CHICAGO (CHICAGO)	Inventory Direction:			
Municipality	1051 CHICAGO	Curr AADT Yr/Count:	2014 / 77650		
Urban Area:	1051	Est Truck Percentage:	7		
Functional Class:	1 INTERSTATE	Number Of Lanes:	3		
** CLEARANCES **	South/East	One Or Two Way:	1 One-Way		
Max Rdwy Width:	72.8	Bypass Length:	0		
Horizontal:	72.8	Future AADT Yr/Cnt:	2032 / 87087		
Designated Truck Rte:	CLASS I	Special Systems:	Yes		

Key Route Under Data

Key Route Nbr:	FEDERAL-AID URBAN	Station:	2862	Segment:	1.5200
Main Route	00000	Linked:	Y		
Inventory County:	83 SOUTH CHICAGO (CHICAGO)	Natl. Hwy System:	Not on NHS		
Township/Road Dist	1051 CHICAGO	Inventory Direction:			
Urban Area:	1051	Curr AADT Yr/Count:	2014 / 5000		
Functional Class:	5 MAJOR COLLECTOR	Est Truck Percentage:	3		
** CLEARANCES **	South/East	Number Of Lanes:	6		
Max Rdwy Width:	60.0	One Or Two Way:	2 Two-Way		
Horizontal:	65.4	Bypass Length:	0		
Designated Truck Rte:	2032 / 87087	Future AADT Yr/Cnt:	2032 / 5150		
Special Systems:	None	Designated Truck Rte:	NONE		

****** Marked Route On Data ******

Route #1:	1 Mainline	Designation	1 Mainline	Kind	8 Other	Number	055
Route #2:	1 Mainline	Designation	1 Mainline	Kind			
Route #3:	1 Mainline	Designation	1 Mainline	Kind			

****** Marked Route Under Data ******

Route #1:	1 Mainline	Designation	1 Mainline	Kind	8 Other	Number	
Route #2:	1 Mainline	Designation	1 Mainline	Kind			
Route #3:	1 Mainline	Designation	1 Mainline	Kind			

Illinois Department of Transportation
Structures Information Management System
Structure Summary Report

Structure Number: 016-0029 District: 1

*** Inspection Intervals ***
Routin e NBIS: 24 MOS Underwater: 0 MOS One Truck At A Time: 0 Tons Combination Type 3S-1: Tons Bridge Posting Level: 5 No Posting Required
Special: N Single Unit Vehicles: Tons Combination Type 3S-2: Tons

Data Related to Inspection Information
*** Maximum Allowable Posting Limits ***

Inspection/Apraisal Information
80Deg. F

Inspection Date: 09/09/2015 Inspection Temperature: 80Deg. F
Deck: 7 GOOD CONDITION - SOME MINOR PROBLEMS
Superstructure: 8 VERY GOOD CONDITION - NO PROBLEMS NOTED
Substructure: 8 VERY GOOD CONDITION - NO PROBLEMS NOTED
Culvert: N NOT APPLICABLE
Channel and Protection: N NOT APPLICABLE
Structural Evaluation: 8 EQUAL TO PRESENT DESIRABLE CRITERIA
Deck Geometry: 9 SUPERIOR TO PRESENT DESIRABLE CRITERIA
Underclearance-Vert/Lat.: 9 SUPERIOR TO PRESENT DESIRABLE CRITERIA
Waterway Adequacy: N NOT APPLICABLE
Approach Roadway Align: 8 EQUAL TO PRESENT DESIRABLE CRITERIA
Bridge Railing Appraisal: 3 Meets Standards
Approach Guardrail: N/A N/A
Pier Navig Protection: N N/A

Deck Wearing Surf: A BARE DECK NO OVRLAY
Deck Membrane: F NONE
Deck Protection: A EPOXY COATED REINF
Total Deck Thick: 7.5
Last Paint Date: 08/2001

Underwater Inspection/Apraisal Information

Inspection Date:
Temperature:
Inspection Method:
Appraisal Rating:

Scour Critical Information
Evaluation Method:

Rating:
Analysis Date:

Construction Information
Reconstructed

Year: 1964 Original 1999 Reconstructed
Route: FAI-55 Sta: 207+40.87 FAI-55 Sta: 207+40.87
Section Nbr: 207-1616.8 1616(.4-.6)+1717.6-3P
Contract Nbr: 82981
Fed Aid Pr#: EAC10557107268
Built By: 1 I.D.O.T. 1 I.D.O.T.

Miscellaneous
Microfilm Data Recorded: Yes

Pontis

Today's Date: 10/08/2015

Structure Number: 016-0029 District: 1 (41) Bridge Status: 1 OPEN - NO RESTRICT
 (6) Feature Crossed: LOOMIS & FULLER STS (7) Facility Carried: I-55 EB STEVENSON
 (9) Location: 0.9 M SW 194 (7A) Bridge Name:
 Element Inspection Date: 09/09/2015
 (90E) Agency Program Manager: MastnySC (90E3) Consultant Program Manager:
 (90E1) Team Leader: AbudanJ (90E2) Inspector:

Element Insp. Delinquent		Element Insp. Delinquent Reason:									
Elem	Env	% 1	Qty 1	% 2	Qty 2	% 3	Qty 3	% 4	Qty 4	Tot Qty	
Reinforced Conc Column or Pile Extension											
205	2	100	4,896	0	0	0	0	0	0	4,896	
		No deterioration	Minor cracks/spalls	Delams/spalls	Analysis warranted						
Remarks:											
Reinforced Conc Pier Wall											
210	2	100	5,058	0	0	0	0	0	0	5,058	
		No deterioration	Minor cracks/spalls	Delams/spalls	Analysis warranted						
Remarks: Note: No Pier 3											
Reinforced Conc Abutment											
215	2	95	165	5	8	0	0	0	0	173	
		No deterioration	Minor cracks/spalls	Delams/spalls	Analysis warranted						
Remarks: Bkwalls- vert leach crks typ w/few isol pop-out spalls @W.											
Reinforced Conc Pier or Abutment Cap											
234	2	100	649	0	0	0	0	0	0	649	
		No deterioration	Minor cracks/spalls	Delams/spalls	Analysis warranted						
Remarks: Pier 4 & 6 Cap South nose- mapckd											
Elastomeric Bearing											
310	4	0	0	100	40	0	0	0	0	40	
		No deterioration	Minor deterioration	Major deterioration							
Remarks:											
Fixed Bearing											
313	4	0	0	100	10	0	0	0	0	10	
		No deterioration	Minor deterioration	Advanced corrosion							
Remarks:											
Pot Bearing											
314	4	0	0	100	20	0	0	0	0	20	
		No deterioration	Minor deterioration	Advanced corrosion							
Remarks:											

Concrete Bridge Railing										
331	4	0	0	100	861	0	0	0	0	861
		No deterioration		Minor cracks/spalls		Analysis warranted				
Remarks:										
Concrete Deck Protected w/ Coated Bars										
8026	4	84	27,494	16	5,300	0	0	0	0	32,794
Remarks: Trans leach crcks. Some spans crks <2ft apart. On top few intersecting and diagonal cracks.										
Non-Lead Painted Steel Open Girder										
8118	4	100	46,432	0	3	0	0	0	0	46,435
Remarks: Few areas-paint peeling @bott flanges.										
Non-Lead Painted Steel Open Girder Ends										
8176	4	80	16	20	4	0	0	0	0	20
Remarks: paint damaged due to a fire by homeless people at the beam ends at east abutment										
Continuous Seal Neoprene Expansion Joint										
8308	4	94	175	0	0	6	12	0	0	187
Remarks: West Abut Ln 3 & 4(Ramp lane) 2 sections missing. E Abut plow damage Ln 4, leaking joint over west abutment.										
Approach Pavement										
8323	4	0	0	100	2	0	0	0	0	2
Remarks: East Apprch- Ln1 wide longit crk										



October 27, 2015

MEMORANDUM

Mr. John Fortmann, Region One Engineer
Illinois Department of Transportation
Region One/District One

Attn: Steven Schilke

RE: Existing S.N. 016-0030
E.B. I-55 over Throop St.
Cook County
PTB 158-002/P-91-762-10

The purpose of this technical memo is to summarize the current condition of existing S.N. 016-0030 in addition to geometrics and other factors. A cursory field check was performed to supplement the information contained in IDOT's structure summary report dated January 15, 2015 (see Appendix B). Broad-based recommendations for this structure are provided below.

The structure is a three span PPC I-beam bridge consisting of nine lines of continuous beams (see Photo 1). Span lengths from west to east are 55'-8", 69'-2" and 55'-8". The superstructure is supported by integral abutments and reinforced concrete multi-column piers. There is no overlay on the structure.

IDOT rates the deck as being in satisfactory condition, which concurs with the findings from the cursory field check. Moderate transverse cracks with leaching are visible on a majority of the soffit. A small spall is visible on the west end of top of deck (see Photo 2). No notable defects or differences were observed between the cursory field check and IDOT's structure summary report for: superstructure, substructure, deck geometry, underclearance vert/lat, approach alignment and bridge railing appraisal items. Small chip spalls due to suspected impact damage are visible on some beam bottom flanges (see Photo 3). Large transverse and longitudinal cracks are visible on both approach slabs. Pressure relief joint seals appear to be sunken in.

Based on the structure summary report and field check, S.N. 016-0030 is suitable for reuse after rehabilitation of the deck.



LIN ENGINEERING, LTD.
Consulting Engineers

Springfield, IL Westmont, IL

576 Oakmont Lane
Westmont, Illinois 60559
Telephone: (630) 323-5168
Fax: (630) 323-5174
E-mail: info@lineng.com

LIN ENGINEERING, LTD.

A handwritten signature in blue ink that reads "Michael T. Haley". The signature is written in a cursive style.

Michael T. Haley, PE, SE
Structural Manager

Appendix A – Photos

Appendix B – IDOT Structure Summary Report

Appendix C – PONTIS Report



Photo 1



Photo 2



Photo 3

Illinois Department of Transportation
Structures Information Management System
Structure Summary Report

Structure Number: 016-0030 District: 1

Inventory Data	
Facility Carried:	I-55 EB STEVENSON
Feature Crossed:	THROOP ST
Bridge Status:	1 OPEN - NO RESTRICT
Status Remarks:	016 COOK
Maint County:	01 I.D.O.T.
Service On/Under:	1 HIGHWAY
Reporting Agency:	1 I.D.O.T. - BUREAU OF MAINTENANCE
Main Span Matl/Type:	6 PRESTRESS CONCRETE CONTINUOUS / 02 STRINGERMULTI-BEAM/GIRDER
Nbr Of Main Spans:	3 Nbr Of Approach Spans: 0
Approaches	
Near #1 Matl/Type:	/
Near #2 Matl/Type:	/
Far #1 Matl/Type:	/
Far #2 Matl/Type:	/
Median Width/Type:	0 Ft. / 0 None
Guardrail Type L/R:	0 None / 0 None
Toll Facility Indicator:	0 No Toll
Latitude:	41.84420918 S Longitude: 87.65357748 S
Deck Structure Type:	A CIP CON NRMALLY FORM
Sidewalks Under Structure:	2 Both Sides Not Separate
Inventory Rating:	1.655(59)
Operating Rating:	2.670(96)
Design Load:	01 HS20+MOD
Deck Structure Thickness:	7.5 SD: N FC: N
RR Vertical Underclear:	0 Ft 0 In
Rate Method:	6
Load Rating Date:	10/17/2000
Rated By:	2 IDOT
Substructure Material:	396000
Substructure Significance:	No
Border Bridge State:	No
Bdr State SN:	
Bdr State % Responsibility:	0
Structural Steel Wt:	396000
Substructure Material:	

Key Route On Data	
Key Route Nbr:	FEDERAL-AID INTERSTATE 0055
Station:	15.4100
Segment:	00000
Inventory County:	016 COOK
Linked:	Y
Township/Road Dist:	83 SOUTH CHICAGO (CHICAGO)
Natl. Hwy System:	On NHS
Municipality:	1051 CHICAGO
Urban Area:	1051
Inventory Direction:	2014 / 77650
Curr AADT Yr/Count:	7
Est Truck Percentage:	3
Number Of Lanes:	1 One-Way
One Or Two Way:	0
Bypass Length:	2032 / 87087
Future AADT Yr/Cnt:	CLASS I
Designated Truck Rte:	Yes
Special Systems:	
Designation:	1 Interstate Highway
Kind:	Number 055
Route #1:	1 Mainline
Route #2:	1 Mainline
Route #3:	1 Mainline

Key Route Under Data	
Key Route Nbr:	MUNICIPAL STREET 2104
Station:	0.1400
Segment:	01051
Inventory County:	83 SOUTH CHICAGO (CHICAGO)
Linked:	Y
Township/Road Dist:	1051 CHICAGO
Municipality:	1051
Urban Area:	1051
Inventory Direction:	1051


**Illinois Department of Transportation
Structures Information Management System
Structure Summary Report**

District: 1

Structure Number: 016-0030

Data Related to Inspection Information

*** Inspection Intervals ***
 Routine NBIS: 24 MOS Underwater: 0 MOS One Truck At A Time: 0
 Special: N Single Unit Vehicles: Tons Combination Type 3S-1: Tons
 Bridge Posting Level: 5 No Posting Required

Inspection/Appraisal Information

Inspection Date: 01/15/2015 Inspection Temperature: 35Deg. F
 Deck: 6 SATISFACTORY CONDITION - MINOR DETERIORATION
 Superstructure: 8 VERY GOOD CONDITION - NO PROBLEMS NOTED
 Substructure: 8 VERY GOOD CONDITION - NO PROBLEMS NOTED
 Culvert: N NOT APPLICABLE
 Channel and Protection: N NOT APPLICABLE
 Structural Evaluation: 8 EQUAL TO PRESENT DESIRABLE CRITERIA
 Deck Geometry: 9 SUPERIOR TO PRESENT DESIRABLE CRITERIA
 Underclearance-Vert/Lat.: 5 BETTER THAN ADEQUATE TO BE LEFT IN PLACE
 Waterway Adequacy: N NOT APPLICABLE
 Approach Roadway Align: 8 EQUAL TO PRESENT DESIRABLE CRITERIA
 Bridge Railing Appraisal: 3 Meets Standards
 Approach Guardrail: N/A N/A
 Pier Navig Protection: N N/A

Deck Wearing Surf: A BARE DECK NO OVRLAY
 Deck Membrane: F NONE
 Deck Protection: A EPOXY COATED REINF
 Total Deck Thick: 7.5
 Last Paint Date:
 Single Unit Vehicles: Tons
 Combination Type 3S-1: Tons
 Combination Type 3S-2: Tons
 One Truck At A Time: 0
 Last Paint Type:

Underwater Inspection/Appraisal Information

Inspection Date:
 Temperature:
 Inspection Method:
 Appraisal Rating:

Scour Critical Information

Rating:
 Analysis Date:
 Evaluation Method:
 Microfilm Data Recorded: Yes

Construction Information

Year: 1963 Original
 Route: FAI-55
 Section Nbr: 207-1616.9
 Contract Nbr: 82981
 Fed Aid Pr#: I 0557075286
 Built By: 1 I.D.O.T.
 Sta: 220+54.47 FAI-55
 Sta: 207-1616.9
 Sta: 134+721.52
 Reconstructed
 ACHPD-IM-55-7
 I.D.O.T. 1

Pontis

Today's Date: 09/03/2015

Structure Number: 016-0030 District: 1 (41) Bridge Status: 1 OPEN - NO RESTRICT
 (6) Feature Crossed: THROOP ST (7) Facility Carried: I- 55 EB STEVENSON
 (9) Location: 0.7 M SW I94 (7A) Bridge Name:
 Element Inspection Date: 01/15/2015
 (90E) Agency Program Manager: MastnySC (90E3) Consultant Program Manager:
 (90E1) Team Leader: SedlacekJL (90E2) Inspector:

Element Insp. Delinquent		Element Insp. Delinquent Reason:								
Elem	Env	% 1	Qty 1	% 2	Qty 2	% 3	Qty 3	% 4	Qty 4	Tot Qty
P/S Conc Open Girder										
109	4	100	1,605	0	0	0	0	0	0	1,605
		No deterioration	Minor cracks/spalls	Delams/spalls	Analysis warranted					
Remarks:										
Reinforced Conc Column or Pile Extension										
205	4	100	620	0	0	0	0	0	0	620
		No deterioration	Minor cracks/spalls	Delams/spalls	Analysis warranted					
Remarks:										
Reinforced Conc Pier Wall										
210	4	100	426	0	0	0	0	0	0	426
		No deterioration	Minor cracks/spalls	Delams/spalls	Analysis warranted					
Remarks:										
Reinforced Conc Abutment										
215	4	100	292	0	0	0	0	0	0	292
		No deterioration	Minor cracks/spalls	Delams/spalls	Analysis warranted					
Remarks: Seepage @ brms										
Reinforced Conc Pier or Abutment Cap										
234	4	100	258	0	0	0	0	0	0	258
		No deterioration	Minor cracks/spalls	Delams/spalls	Analysis warranted					
Remarks:										
Elastomeric Bearing										
310	4	100	18	0	0	0	0	0	0	18
		No deterioration	Minor deterioration	Major deterioration						
Remarks:										
Concrete Bridge Railing										
331	4	100	361	0	0	0	0	0	0	361
		No deterioration	Minor cracks/spalls	Analysis warranted						
Remarks: HL vert crks throughout										

Concrete Deck Protected w/ Coated Bars										
8026	4	87	10,077	13	1,520	0	0	0	0	11,597
Remarks: Soffit) Trans leach crks <5' c/c throughout; Diag Crks @ Int Abuts; WS) HL-Nar trans crking. Small Pothole in Lane 3/Rt Shldr.										
Approach Pavement										
8323	4	100	2	0	0	0	0	0	0	2
Remarks: Random crking. Both Relief PJS Jnts sunken in.										



October 27, 2015

MEMORANDUM

Mr. John Fortmann, Region One Engineer
Illinois Department of Transportation
Region One/District One

Attn: Steven Schilke

RE: Existing S.N. 016-0031
W.B. I-55 over Throop St.
Cook County
PTB 158-002/P-91-762-10

The purpose of this technical memo is to summarize the current condition of existing S.N. 016-0031 in addition to geometrics and other factors. A cursory field check was performed to supplement the information contained in IDOT's structure summary report dated January 15, 2015 (see Appendix B). Broad-based recommendations for this structure are provided below.

The structure is a three span PPC I-beam bridge consisting of ten lines of continuous beams (see Photo 1). Span lengths from west to east are 55'-7", 69'-0" and 55'-7". The superstructure is supported by integral abutments and reinforced concrete multi-column piers. There is no overlay on the structure.

IDOT rates the deck as being in good condition, which concurs with the findings from the cursory field check. Minor transverse cracks with leaching are visible on a majority of the soffit. Diagonal cracks are visible on the soffit above the integral abutment diaphragms (see Photo 2). IDOT rates the substructure as being in very good condition, which concurs with the findings from the cursory field check. Seepage is visible under several beams at the integral abutments (see Photo 3). No notable defects or differences were observed between the cursory field check and IDOT's structure summary report for: superstructure, deck geometry, underclearance vert/lat, approach alignment and bridge railing appraisal items. Diagonal cracks and small spalls along the deck joints are visible on both approach slabs (see Photo 4).

Based on the structure summary report and field check, S.N. 016-0031 is suitable for reuse without rehabilitation.



LIN ENGINEERING, LTD.
Consulting Engineers

Springfield, IL Westmont, IL

576 Oakmont Lane
Westmont, Illinois 60559
Telephone: (630) 323-5168
Fax: (630) 323-5174
E-mail: info@lineng.com

LIN ENGINEERING, LTD.

A handwritten signature in blue ink that reads "Michael T. Haley". The signature is written in a cursive style.

Michael T. Haley, PE, SE
Structural Manager

Appendix A – Photos

Appendix B – IDOT Structure Summary Report

Appendix C – PONTIS Report



Photo 1



Photo 2



Photo 3



Photo 4

Illinois Department of Transportation
Structures Information Management System
Structure Summary Report

Structure Number: 016-0031 District: 1

Inventory Data

Facility Carried: I-55 WB STEVENSON
 Feature Crossed: THROOP ST
 Bridge Name: 0.7 M SW 194
 Location: 12/2000
 Status Date: 83 SOUTH CHICAGO
 Maint Township: 1 / HIGHWAY
 Service On/Under: 1 I.D.O.T.
 Reporting Agency: 1 I.D.O.T. - BUREAU OF MAINTENANCE
 Main Span Matl/Type: 6 PRESTRESS CONCRETE CONTINUOUS / 02 STRINGERMULTI-BEAM/GIRDER
 Nbr Of Main Spans: 3 Nbr Of Approach Spans: 0
 Approaches
 Near #1 Matl/Type: /
 Near #2 Matl/Type: /
 Far #1 Matl/Type: /
 Far #2 Matl/Type: /
 Median Width/Type: 0 Ft. / 0 None / 0 None
 Guardrail Type L/R: 0 None / 0 None
 Toll Facility Indicator: 0 No Toll
 Latitude: 41.8442778 S Longitude: 87.65340565 S
 Deck Structure Type: A CIP CON NRMALLY FORM
 Sidewalks Under Structure: 2 Both Sides Not Separate

Inventory Rating: 1.655(59)
 Operating Rating: 2.670(96)
 Design Load: 01 HS20+MOD
 Deck Structure Thickness: 7.5 SD: N FO: N
 RR Vertical Underclear: 0 Ft 0 In

Rate Method: 6
 Load Rating Date: 04/26/2001
 Crossing 1 Nbr: 0
 Crossing 1 Matl: 0
 RR Lateral Underclear: 0 Ft 0 In

Key Route Under Data

Key Route Nbr	Station	Segment	Linked	Inventory Direction	Cur AADT Yr/Count	Est Truck Percentage	Number Of Lanes	One Or Two Way	Bypass Length	Future AADT Yr/Cnt	Designated Truck Rte	Special Systems
FEDERAL-AID INTERSTATE	0055	15.4200	Y	On NHS	2014 / 77650	7	4	1 One-Way	0	2032 / 87087	CLASS I	Yes
Main Route	0000											
Inventory County:	016 COOK											
Township/Road Dist	83 SOUTH CHICAGO (CHICAGO)											
Municipality	1051 CHICAGO											
Urban Area:	1051											
Functional Class:	1 INTERSTATE											
** CLEARANCES **	South/East	North/West										
Max Rdwy Width:	68.9	70.1										
Horizontal:												

Marked Route On Data

Route #1	Designation	Kind	Number
1	Mainline	1	055
1	Mainline	1	055
1	Mainline	1	055

Marked Route Under Data

Route #1	Designation	Kind	Number
1	Mainline	1	055
1	Mainline	1	055
1	Mainline	1	055

**Illinois Department of Transportation
Structures Information Management System
Structure Summary Report**

Structure Number: 016-0031 **District: 1**

Data Related to Inspection Information

*** Inspection Intervals *** *** Maximum Allowable Posting Limits *** Bridge Posting Level:

Routine NBIS: 24 MOS	Underwater: 0 MOS	One Truck At A Time: 0	Combination Type 3S-1: Tons	5	No Posting Required
Special: N	Single Unit Vehicles: Tons	Combination Type 3S-2: Tons			

Inspection/Appraisal Information

Inspection Date: 01/15/2015 Inspection Temperature: 35Deg. F ** Actual Posted Limits **

Deck: 7 GOOD CONDITION - SOME MINOR PROBLEMS Single Unit Vehicles: Tons

Superstructure: 8 VERY GOOD CONDITION - NO PROBLEMS NOTED Combination Type 3S-1: Tons

Substructure: 8 VERY GOOD CONDITION - NO PROBLEMS NOTED Combination Type 3S-2: Tons

Culvert: N NOT APPLICABLE One Truck At A Time: 0

Channel and Protection: N NOT APPLICABLE Last Paint Type:

Structural Evaluation: 8 EQUAL TO PRESENT DESIRABLE CRITERIA Deck Wearing Surf: A BARE DECK NO OVRLAY

Deck Geometry: 7 BETTER THAN PRESENT MINIMUM CRITERIA Deck Membrane: F NONE

Underclearance-Vert/Lat.: 7 BETTER THAN PRESENT MINIMUM CRITERIA Deck Protection: A EPOXY COATED REINF

Waterway Adequacy: N NOT APPLICABLE Total Deck Thick: 7.5

Approach Roadway Align: 3 EQUAL TO PRESENT DESIRABLE CRITERIA Last Paint Date:

Bridge Railing Appraisal: 8 Meets Standards

Approach Guardrail: NNN N/A N/A

Pier Navig Protection: N N/A N/A

Underwater Inspection/Appraisal Information

Inspection Date: Inspection Method: Appraisal Rating:

Temperature: Evaluation Method:

Scour Critical Information

Rating: Evaluation Method: Microfilm Data Recorded: Yes

Analysis Date:

Construction Information

Year: 1963	Original	2000	Reconstructed
Route: FAI-55	Sta: 220+54.47	FAI-55	Sta: 220+54.47
Section Nbr: 207-1616.9	1616(.4, .6)R-1,ETC		
Contract Nbr:	82992		
Fed Aid Pr#: I 0557075286			
Built By: 1	I.D.O.T.	1	I.D.O.T.

Pontis

Today's Date: 09/03/2015

Structure Number: 016-0031 District: 1 (41) Bridge Status: 1 OPEN - NO RESTRICT
 (6) Feature Crossed: THROOP ST (7) Facility Carried: I- 55 WB STEVENSON
 (9) Location: 0.7 M SW I94 (7A) Bridge Name:
 Element Inspection Date: 01/15/2015
 (90E) Agency Program Manager: MastnySC (90E3) Consultant Program Manager:
 (90E1) Team Leader: SedlacekJL (90E2) Inspector:

Element Insp. Delinquent		Element Insp. Delinquent Reason:									
Elem	Env	% 1	Qty 1	% 2	Qty 2	% 3	Qty 3	% 4	Qty 4	Tot Qty	
P/S Conc Open Girder											
109	4	100	1,780	0	0	0	0	0	0	1,780	
			No deterioration	Minor cracks/spalls	Delams/spalls	Analysis warranted					
Remarks:											
Reinforced Conc Column or Pile Extension											
205	1	100	859	0	0	0	0	0	0	859	
			No deterioration	Minor cracks/spalls	Delams/spalls	Analysis warranted					
Remarks:											
Reinforced Conc Pier Wall											
210	1	100	698	0	0	0	0	0	0	698	
			No deterioration	Minor cracks/spalls	Delams/spalls	Analysis warranted					
Remarks: Few vert crks typ.											
Reinforced Conc Abutment											
215	1	100	525	0	0	0	0	0	0	525	
			No deterioration	Minor cracks/spalls	Delams/spalls	Analysis warranted					
Remarks: Seepage @ bms											
Reinforced Conc Pier or Abutment Cap											
234	1	100	185	0	0	0	0	0	0	185	
			No deterioration	Minor cracks/spalls	Delams/spalls	Analysis warranted					
Remarks:											
Elastomeric Bearing											
310	4	100	20	0	0	0	0	0	0	20	
			No deterioration	Minor deterioration	Major deterioration						
Remarks:											
Concrete Bridge Railing											
331	4	100	360	0	0	0	0	0	0	360	
			No deterioration	Minor cracks/spalls	Analysis warranted						
Remarks: HL vert crks throughout											

Concrete Deck Protected w/ Coated Bars										
8026	4	87	11,270	13	1,730	0	0	0	0	13,000
Remarks: Soffit) Few HL trans crks. Diag Crks @ Int Abuts; WS) Few HL-Nar trans crks										
Approach Pavement										
8323	4	100	2	0	0	0	0	0	0	2
Remarks: Random crking. East Relief PJS Jnt sunken in.										



October 27, 2015

MEMORANDUM

Mr. John Fortmann, Region One Engineer
Illinois Department of Transportation
Region One/District One

Attn: Steven Schilke

RE: Existing S.N. 016-0034
E.B. I-55 over Halsted St.
Cook County
PTB 158-002/P-91-762-10

The purpose of this technical memo is to summarize the current condition of existing S.N. 016-0034 in addition to geometrics and other factors. A cursory field check was performed to supplement the information contained in IDOT's structure summary report dated November 26, 2014 (see Appendix B). Broad-based recommendations for this structure are provided below.

The structure is a 73'-6" long single span PPC I-beam bridge consisting of nine lines of simply supported beams (see Photo 1). The superstructure is supported by closed wall abutments. There is no overlay on the structure.

IDOT rates the substructure as being in good condition, which concurs with the findings from the cursory field check. Map cracking is visible on portions of the abutment walls (see Photo 2). No notable defects or differences were observed between the cursory field check and IDOT's structure summary report for: deck, superstructure, deck geometry, underclearance vert/lat, approach alignment and bridge railing appraisal items. Moderate transverse and longitudinal cracks are visible on both approach slabs. Small spalls are visible on the east approach slab (see Photo 3).

Based on the structure summary report and field check, S.N. 016-0034 is suitable for reuse without rehabilitation.



LIN ENGINEERING, LTD.
Consulting Engineers

Springfield, IL Westmont, IL

576 Oakmont Lane
Westmont, Illinois 60559
Telephone: (630) 323-5168
Fax: (630) 323-5174
E-mail: info@lineng.com

LIN ENGINEERING, LTD.

A handwritten signature in blue ink that reads "Michael T. Haley". The signature is written in a cursive style.

Michael T. Haley, PE, SE
Structural Manager

Appendix A – Photos

Appendix B – IDOT Structure Summary Report

Appendix C – PONTIS Report



Photo 1



Photo 2



Photo 3

Illinois Department of Transportation
Structures Information Management System
Structure Summary Report

Structure Number: 016-0034 District: 1

Inventory Data	
Facility Carried:	I-55 EB STEVENSON
Feature Crossed:	HALSTED ST
Bridge Status:	1 OPEN - NO RESTRICT
Status Remarks:	016 COOK
Maint County:	01 I.D.O.T.
Service On/Under:	1 HIGHWAY
Reporting Agency:	1 I.D.O.T. - BUREAU OF MAINTENANCE
Main Span Matl/Type:	5 PRESTRESS CONCRETE
Nbr Of Main Spans:	1 Nbr Of Approach Spans: 0
Approaches	
Near #1 Matl/Type:	/
Near #2 Matl/Type:	/
Far #1 Matl/Type:	/
Far #2 Matl/Type:	/
Median Width/Type:	0 Ft./0 None
Guardrail Type L/R:	0 None / 0 None
Toll Facility Indicator:	0 No Toll
Latitude:	41.84615302 S Longitude: 87.64532538 S
Deck Structure Type:	A CIP CON NRMALLY FORM
Sidewalks Under Structure:	2 Both Sides Not Separate
Sufficiency Rating:	94.0
HBP Eligible:	No
Replaced By:	- Length of Long Span: 70.0
Replaces:	- Bridge Roadway Width: 71.2
Last Update Date:	06/21/2014
Parallel Structure:	Right Deck Width: 60.4
Multi-Level Structure Nbr:	Sidewalk Width Right: 0.0
Skew Angle:	Left Sidewalk Width Left: 0.0
Structure Flared:	Navigation Control: N/A
Historical Significance:	No
Border Bridge State:	Navigation Horiz Clear: 0
Bdr State SN:	Navigation Vert Clear: 0
Bdr State % Responsibility:	Culvert Fill Depth: 0.0
Structural Steel Wt:	226000
Substructure Material:	Number Culvert Cells: 0
Rated By:	2 IDOT
Inventory Rating:	1,265(45)
Operating Rating:	2,115(76)
Design Load:	01 HS20+MOD
Deck Structure Thickness:	7.5 SD: N FO: N
RR Vertical Underclear:	0 Ft
RR Lateral Underclear:	0 In
Rate Method:	6
Load Rating Date:	05/16/2001
Crossing 1 Nbr:	
Crossing 1 Nbr:	
RR Lateral Underclear:	0 Ft
RR Vertical Underclear:	0 In

Key Route On Data	
Key Route Nbr:	FEDERAL-AID INTERSTATE 0055
Station:	15.9300
Segment:	00000
Linked:	Y
Natl. Hwy System:	On NHS
Township/Road Dist:	83 SOUTH CHICAGO (CHICAGO)
Municipality:	1051 CHICAGO
Urban Area:	1051
Functional Class:	1 INTERSTATE
** CLEARANCES **	South/East North/West
Max Rdwy Width:	54.5
Horizontal:	55.5
Vertical:	0.0
By-pass Length:	0
Future AADT Yr/Cnt:	2032 / 41921
Designated Truck Rte:	CLASS I
Special Systems:	Yes

Key Route Under Data	
Main Route:	FEDERAL-AID URBAN
Station:	37.30
Segment:	00000
Linked:	Y
Natl. Hwy System:	Not on NHS
Township/Road Dist:	83 SOUTH CHICAGO (CHICAGO)
Municipality:	1051 CHICAGO
Urban Area:	1051
Functional Class:	4 MINOR ARTERIAL
** CLEARANCES **	South/East North/West
Max Rdwy Width:	82.0
Horizontal:	82.0
Vertical:	0.0
By-pass Length:	0
Future AADT Yr/Cnt:	2032 / 16171
Designated Truck Rte:	NONE
Special Systems:	No

**** Marked Route On Data ****		
Designation	Kind	Number
1 Mainline	1 Interstate Highway	055

**** Marked Route Under Data ****		
Designation	Kind	Number
1 Mainline	8 Other	

**Illinois Department of Transportation
Structures Information Management System
Structure Summary Report**

Structure Number: 016-0034 **District: 1**

Data Related to Inspection Information

*** Inspection Intervals ***
 Routine NBIS: 24 MOS Underwater: 0 MOS One Truck At A Time: 0 Combination Type 3S-1: Tons Bridge Posting Level:
 Special: N Single Unit Vehicles: Tons Combination Type 3S-2: Tons 5 No Posting Required

Inspection/Appraisal Information

Inspection Date: 11/26/2014 Inspection Temperature: 31Deg. F ** Actual Posted Limits **
 Deck: 7 GOOD CONDITION - SOME MINOR PROBLEMS Single Unit Vehicles: Tons
 Superstructure: 8 VERY GOOD CONDITION - NO PROBLEMS NOTED Combination Type 3S-1: Tons
 Substructure: 7 GOOD CONDITION - SOME MINOR PROBLEMS Combination Type 3S-2: Tons
 Culvert: N NOT APPLICABLE One Truck At A Time: 0
 Channel and Protection: N NOT APPLICABLE Last Paint Type:
 Structural Evaluation: 7 BETTER THAN PRESENT MINIMUM CRITERIA Deck Wearing Surf: A BARE DECK NO OVRLAY
 Deck Geometry: 4 MINIMUM ADEQUACY TO BE LEFT IN PLACE Deck Membrane: F NONE
 Underclearance-Vert/Lat.: 4 MINIMUM ADEQUACY TO BE LEFT IN PLACE Deck Protection: A EPOXY COATED REINF
 Waterway Adequacy: N NOT APPLICABLE Total Deck Thick: 7.5
 Approach Roadway Align: 8 EQUAL TO PRESENT DESIRABLE CRITERIA Last Paint Date:
 Bridge Railing Appraisal: 3 Meets Standards
 Approach Guardrail: NNN N/A N/A
 Pier Navig Protection: N N/A

Underwater Inspection/Appraisal Information

Inspection Date: Inspection Method: Appraisal Rating:

Scour Critical Information

Rating: Evaluation Method: Miscellaneous
 Analysis Date: Microfilm Data Recorded: Yes

Construction Information

Year: 1964 Original 1999 Reconstructed
 Route: FAI-55 Sta: 7+28.82 FAI-55 Sta: 135+425.77
 Section Nbr: 1717.2-1B 1616(.4,.6)+1717.6-3P
 Contract Nbr: 82981 ACHPD-IM-55-7(
 Fed Aid Pr#: I 0557043287 COUNTY AGENCY 1 I.D.O.T.
 Built By: 3

Pontis

Today's Date: 09/03/2015

Structure Number: 016-0034 District: 1
 (6) Feature Crossed: HALSTED ST
 (9) Location: 0.2 M SW I94
 Element Inspection Date: 11/26/2014
 (90E) Agency Program Manager: MastnySC
 (90E1) Team Leader: SedlacekJL

(41) Bridge Status: 1 OPEN - NO RESTRICT
 (7) Facility Carried: I-55 EB STEVENSON
 (7A) Bridge Name:
 (90E3) Consultant Program Manager:
 (90E2) Inspector:

Element Insp. Delinquent		Element Insp. Delinquent Reason:									
Elem	Env	% 1	Qty 1	% 2	Qty 2	% 3	Qty 3	% 4	Qty 4	Tot Qty	
P/S Conc Open Girder											
109	4	100	653	0	0	0	0	0	0	653	
		No deterioration	Minor cracks/spalls	Delams/spalls	Analysis warranted						
Remarks:											
Reinforced Conc Abutment											
215	4	96	2,655	3	85	1	17	0	0	2,757	
		No deterioration	Minor cracks/spalls	Delams/spalls	Analysis warranted						
Remarks: East & West Abuts Map Crkd @ FCR w/few HPs											
Reinforced Conc Pier or Abutment Cap											
234	4	84	127	16	24	0	0	0	0	151	
		No deterioration	Minor cracks/spalls	Delams/spalls	Analysis warranted						
Remarks:											
Elastomeric Bearing											
310	4	100	9	0	0	0	0	0	0	9	
		No deterioration	Minor deterioration	Major deterioration							
Remarks: @ West Abut											
Fixed Bearing											
313	4	100	9	0	0	0	0	0	0	9	
		No deterioration	Minor deterioration	Advanced corrosion							
Remarks: @ East Abut											
Concrete Bridge Railing											
331	4	100	147	0	0	0	0	0	0	147	
		No deterioration	Minor cracks/spalls	Analysis warranted							
Remarks: Spider crking (slipformed).HL to Med Vertical Crks typ.											
Concrete Deck Protected w/ Coated Bars											
8026	4	89	3,955	11	480	0	0	0	0	4,435	
Remarks: Soffit) Few HL trans leach cracks; WS) HL trans crks w/few intersecting longit crks											

P/S Conc Beam Ends Incl Diaphragms Under Deck Joint										
8237	4	100	18	0	0	0	0	0	0	18
Remarks:										
Continuous Seal Neoprene Expansion Joint										
8308	4	100	121	0	0	0	0	0	0	121
Remarks:										
Approach Pavement										
8323	4	100	2	0	0	0	0	0	0	2
Remarks: Random Map & Diag crking @ East & West Apprchs										



October 27, 2015

MEMORANDUM

Mr. John Fortmann, Region One Engineer
Illinois Department of Transportation
Region One/District One

Attn: Steven Schilke

RE: Existing S.N. 016-0035
W.B. I-55 over Halsted St.
Cook County
PTB 158-002/P-91-762-10

The purpose of this technical memo is to summarize the current condition of existing S.N. 016-0035 in addition to geometrics and other factors. A cursory field check was performed to supplement the information contained in IDOT's structure summary report dated November 26, 2014 (see Appendix B). Broad-based recommendations for this structure are provided below.

The structure is a 73'-7½" long single span PPC I-beam bridge consisting of ten lines of simply supported beams (see Photo 1). The superstructure is supported by closed wall abutments. There is no overlay on the structure.

IDOT rates the deck as being in good condition, which concurs with the findings from the cursory field check. Minor longitudinal and transverse cracks are visible on a majority of the top of deck. IDOT rates the substructure as being in good condition, which concurs with the findings from the cursory field check. Map cracking is visible on previously repaired portions of the abutment walls (see Photo 2). IDOT rates the deck geometry as being intolerable with a high priority for replacement. The findings from the cursory field check don't match IDOT's deck geometry rating. The roadway width appears to be adequate for a three lane interstate bridge. No notable defects or differences were observed between the cursory field check and IDOT's structure summary report for: superstructure, underclearance vert/lat, approach alignment and bridge railing appraisal items. Moderate transverse and longitudinal cracks are visible on both approach slabs (see Photo 3). Anchor blocks are damaged along sections of the west expansion joint.

Based on the structure summary report and field check, S.N. 016-0035 is suitable for reuse after rehabilitation of the expansion joints.



LIN ENGINEERING, LTD.
Consulting Engineers

Springfield, IL Westmont, IL

576 Oakmont Lane
Westmont, Illinois 60559
Telephone: (630) 323-5168
Fax: (630) 323-5174
E-mail: info@lineng.com

LIN ENGINEERING, LTD.

A handwritten signature in blue ink that reads "Michael T. Haley". The signature is written in a cursive style.

Michael T. Haley, PE, SE
Structural Manager

Appendix A – Photos

Appendix B – IDOT Structure Summary Report

Appendix C – PONTIS Report



Photo 1



Photo 2



Photo 3

**Illinois Department of Transportation
Structures Information Management System
Structure Summary Report**

Structure Number: 016-0035 District: 1

		Inventory Data	
Facility Carried:	I-55 WB STEVENSON	Bridge Name:	
Feature Crossed:	HALSTED ST	Location:	0.2 M SW I94
Bridge Remarks:		Status Date:	12/2000
Bridge Status:	1 OPEN - NO RESTRICT	Maint Township:	83 SOUTH CHICAGO
Status Remarks:			
Maint County:	016 COOK		
Maint Responsibility:	01 I.D.O.T.		
Service On/Under:	1 HIGHWAY		
Reporting Agency:	1 I.D.O.T. - BUREAU OF MAINTENANCE		
Main Span Matl/Type:	5 PRESTRESS CONCRETE		
Nbr Of Main Spans:	1	Nbr Of Approach Spans:	0
Approaches			
Near #1 Matl/Type:	/		
Near #2 Matl/Type:	/		
Far #1 Matl/Type:	/		
Far #2 Matl/Type:	/		
Median Width/Type:	0 Ft./0 None		
Guardrail Type L/R:	0 None / 0 None	Inventory Rating:	1.265(45)
Toll Facility Indicator:	0 No Toll	Operating Rating:	2.115(76)
Latitude:	41.84621442	S Longitude:	87.64516895
Deck Structure Type:	A CIP CON NRMALLY FORM	Design Load:	01 HS20+MOD
Sidewalks Under Structure:	2 Both Sides Not Separate	Deck Structure Thickness:	7.5 SD: N FO: Y
		RR Vertical Underclear:	0 Ft 0 In

		Key Route Under Data	
Key Route Nbr:	FEDERAL-AID INTERSTATE	Station:	0055
Appurtenances Main Route	00000	Segment:	15.9400
Inventory County:	016 COOK	Linked:	Y
Township/Road Dist	83 SOUTH CHICAGO (CHICAGO)	Natl. Hwy System:	On NHS
Municipality	1051 CHICAGO	Inventory Direction:	
Urban Area:	1051	Curr AADT Yr/Count:	2014 / 128100
Functional Class:	1 INTERSTATE	Est Truck Percentage:	9
** CLEARANCES **	South/East	Number Of Lanes:	5
Max Rdwy Width:	63.3	One Or Two Way:	1 One-Way
Horizontal:	64.5	Bypass Length:	0
		Future AADT Yr/Cnt:	2032 / 83842
		Designated Truck Rte:	CLASS I
Special Systems:	Yes		

		Key Route Under Data	
Key Route Nbr:	FEDERAL-AID URBAN	Station:	3730
Appurtenances Main Route	00000	Segment:	7.4700
Inventory County:	83 SOUTH CHICAGO (CHICAGO)	Linked:	Y
Township/Road Dist	1051 CHICAGO	Natl. Hwy System:	Not on NHS
Municipality	1051	Inventory Direction:	
Urban Area:	1051	Curr AADT Yr/Count:	2014 / 12100
Functional Class:	4 MINOR ARTERIAL	Est Truck Percentage:	13
** CLEARANCES **	South/East	Number Of Lanes:	5
Max Rdwy Width:	82.0	One Or Two Way:	2 Two-Way
Horizontal:	82.0	Bypass Length:	0
		Future AADT Yr/Cnt:	2032 / 16171
		Designated Truck Rte:	NONE
Special Systems:	No		

		**** Marked Route On Data ****	
Route #1:	1 Mainline	Designation	Kind
Route #2:	1 Mainline	1 Interstate Highway	Number
Route #3:	1 Mainline		055

		**** Marked Route Under Data ****	
Route #1:	1 Mainline	Designation	Kind
Route #2:	1 Mainline	8 Other	Number
Route #3:	1 Mainline		

Illinois Department of Transportation
Structures Information Management System
Structure Summary Report

Structure Number: 016-0035 District: 1

*** Inspection Intervals ***

Routine NBIS: 24 MOS Underwater: 0 MOS One Truck At A Time: 0 Tons Combination Type 3S-1: Tons Bridge Posting Level: 5 No Posting Required
Special: N Single Unit Vehicles: Tons Combination Type 3S-2: Tons

*** Maximum Allowable Posting Limits ***

Inspection Date: 11/26/2014 Inspection Temperature: 31Deg. F

Deck: 7 GOOD CONDITION - SOME MINOR PROBLEMS
Superstructure: 8 VERY GOOD CONDITION - NO PROBLEMS NOTED
Substructure: 7 GOOD CONDITION - SOME MINOR PROBLEMS
Culvert: N NOT APPLICABLE
Channel and Protection: N NOT APPLICABLE
Structural Evaluation: 7 BETTER THAN PRESENT MINIMUM CRITERIA
Deck Geometry: 2 INTOLERABLE - HIGH PRIORITY FOR REPLACEMENT
Underclearance-Vert/Lat.: 4 MINIMUM ADEQUACY TO BE LEFT IN PLACE
Waterway Adequacy: N NOT APPLICABLE
Approach Roadway Align: 8 EQUAL TO PRESENT DESIRABLE CRITERIA
Bridge Railing Appraisal: 3 Meets Standards
Approach Guardrail: N/A N/A
Pier Navig Protection: N N/A

Inspection/Appraisal Information

Deck Wearing Surf: A BARE DECK NO OVRLAY
Deck Membrane: F NONE
Deck Protection: A EPOXY COATED REINF
Total Deck Thick: 7.5
Last Paint Date:

Single Unit Vehicles: Tons
Combination Type 3S-1: Tons
Combination Type 3S-2: Tons
One Truck At A Time: 0
Last Paint Type:

*** Actual Posted Limits ***

Inspection Date: Inspection Method: Appraisal Rating:
Temperature: Evaluation Method:

Underwater Inspection/Appraisal Information

Rating: Scour Critical Information Evaluation Method: Microfilm Data Recorded: Yes
Analysis Date:

Construction Information

Year: 1964 Original 2000 Reconstructed
Route: FAI-55 Sta: 7+28.82 FAI-55 Sta: 7+28.82
Section Nbr: 1717.2-1B 1616(.4,.6)R-1 ETC
Contract Nbr: 82992
Fed Aid Pr#: I 0557043287
Built By: 3 COUNTY AGENCY 1 I.D.O.T.

Pontis

Today's Date: 09/03/2015

Structure Number: 016-0035 District: 1 (41) Bridge Status: 1 OPEN - NO RESTRICT
 (6) Feature Crossed: HALSTED ST (7) Facility Carried: I- 55 WB STEVENSON
 (9) Location: 0.2 M SW I94 (7A) Bridge Name:
 Element Inspection Date: 11/26/2014
 (90E) Agency Program Manager: MastnySC (90E3) Consultant Program Manager:
 (90E1) Team Leader: SedlacekJL (90E2) Inspector:

Element Insp. Delinquent		Element Insp. Delinquent Reason:									
Elem	Env	% 1	Qty 1	% 2	Qty 2	% 3	Qty 3	% 4	Qty 4	Tot Qty	
P/S Conc Open Girder											
109	4	100	723	0	0	0	0	0	0	723	
		No deterioration	Minor cracks/spalls	Delams/spalls	Analysis warranted						
Remarks:											
Reinforced Conc Abutment											
215	4	97	3,761	2	90	0	15	0	0	3,866	
		No deterioration	Minor cracks/spalls	Delams/spalls	Analysis warranted						
Remarks: East & West Abuts Map Crkd @ FCR w/few HPs											
Reinforced Conc Pier or Abutment Cap											
234	4	100	190	0	0	0	0	0	0	190	
		No deterioration	Minor cracks/spalls	Delams/spalls	Analysis warranted						
Remarks:											
Elastomeric Bearing											
310	4	100	10	0	0	0	0	0	0	10	
		No deterioration	Minor deterioration	Major deterioration							
Remarks: @ West Abut											
Fixed Bearing											
313	4	100	10	0	0	0	0	0	0	10	
		No deterioration	Minor deterioration	Advanced corrosion							
Remarks: @ East Abut											
Concrete Bridge Railing											
331	4	100	146	0	0	0	0	0	0	146	
		No deterioration	Minor cracks/spalls	Analysis warranted							
Remarks: (Slipformed) HL Vert & Hor crking throughout & spider crking @ random locations.											
Concrete Deck Protected w/ Coated Bars											
8026	4	96	4,759	4	175	0	0	0	0	4,934	
Remarks: Soffit) Few HL trans Leach cracks WS) HL-Nar trans crks w/few intersecting long crks											

P/S Conc Beam Ends Incl Diaphragms Under Deck Joint										
8237	4	100	20	0	0	0	0	0	0	20
Remarks:										
Continuous Seal Neoprene Expansion Joint										
8308	4	91	129	0	0	9	12	0	0	141
Remarks: West Neop Jnt leaking. Missing Hold Down and Damage @ West Abut Lane #3										
Approach Pavement										
8323	4	100	2	0	0	0	0	0	0	2
Remarks: Random Map & Diag crking @ East & West Apprchs										



October 27, 2015

MEMORANDUM

Mr. John Fortmann, Region One Engineer
Illinois Department of Transportation
Region One/District One

Attn: Steven Schilke

RE: Existing S.N. 016-0046
IL 171 S.B. Ramp (First Ave.) over I-55
Cook County
PTB 158-002/P-91-762-10

The purpose of this technical memo is to summarize the current condition of existing S.N. 016-0046 in addition to geometrics and other factors. A cursory field check was performed to supplement the information contained in IDOT's structure summary report. Broad-based recommendations for this structure are provided below.

A cursory field check discovered that this structure is being entirely replaced under Job No. D-91-191-10. The current IDOT structure summary report does not reflect the planned full bridge replacement. The new structure shall be adequate for re-use.

LIN ENGINEERING, LTD.

Michael T. Haley, PE, SE
Structural Manager

Appendix A – IDOT Structure Summary Report

Illinois Department of Transportation
Structures Information Management System
Structure Summary Report

Structure Number: 016-0046 District: 1

Inventory Data

Facility Carried: IL 171 SB RMP I55 EB Bridge Name: Sufficiency Rating: 81.0 Structure Length: 305.9
 Feature Crossed: I-55 STEVENSON Location: 1.4 M SW ILL 43 HBP Eligible: No AASHTO Bridge Length: 99.9
 Bridge Remarks: D DELETED Status Date: 04/2015 Replaces: 016-1512 Bridge Roadway Width: 85.9
 Status Remarks: 016 COOK Maint Township: 16 LYONS Last Update Date: 07/05/2012 App Roadway Width: 36.0
 Maint County: 01 I.D.O.T. Parallel Structure: None Deck Width: 28.0
 Service On/Under: 5 SECOND LEVEL INTERCHANGE 1 / HIGHWAY Multi-Level Structure Nbr: Sidewalk Width Right: 0.0
 Reporting Agency: 1 I.D.O.T. - BUREAU OF MAINTENANCE Skew Angle: 33 D Left Sidewalk Width Left: 0.0
 Main Span Matl/Type: 3 STEEL / 02 STRINGERMULTI-BEAM/GIRDER Structure Flared: No Navigation Horiz Clear: 0
 Nbr Of Main Spans: 5 Nbr Of Approach Spans: 0 Historical Significance: No Navigation Vert Clear: 0
 Approaches Border Bridge State: Culvert Fill Depth: 0.0
 Near #1 Matl/Type: / / Bdr State SN: 0 Number Culvert Cells: 0
 Near #2 Matl/Type: / / Bdr State % Responsibility: 0 Culvert Opening Area: 0.0
 Far #1 Matl/Type: / / Structural Steel Wt: 278000 Culvert Cell Height: 0.00
 Far #2 Matl/Type: / / Substructure Material: Culvert Cell Width: 0.00
 Median Width/Type: 0 Ft. / 0 None Rated By: 2 IDOT Rate Method: 6
 Guardrail Type L/R: 0None / 0 Inventory Rating: 1.445(52) Load Rating Date: 08/18/2009 Railroad Crossing Info
 Toll Facility Indicator: 0 No Toll Operating Rating: 2.415(86) Crossing 1 Nbr: Crossing 1 Nbr:
 Latitude: 41.79232000 S Longitude: 87.82197000 S Design Load: 02 HS20 Crossing 1 Nbr:
 Deck Structure Type: A CIP CON NRMLLY FORM Deck Structure Thickness: 7 SD: Y FO: N RR Lateral Underclear: 0.0
 Sidewalks Under Structure: 0 None RR Vertical Underclear: 0 Ft 0 In

Key Route On Data

Key Route Nbr: FEDERAL-AID INTERSTATE 0055 Station: 04500
 Appurtenances Ramp 06430 Segment: 00000
 Inventory County: 016 COOK Linked: N
 Township/Road Dist 16 LYONS Natl. Hwy System: On NHS
 Municipality 5620 SUMMIT Inventory Direction: 2000 / 9300
 Urban Area: 1051 1051 Curr AADT Yr/Count: 2000 / 9300
 Functional Class: 1 INTERSTATE North/West Est Truck Percentage: 0
 ** CLEARANCES ** South/East Number Of Lanes: 1 One-Way
 Max Rdwy Width: 22.0 0.0 One Or Two Way: 1 One-Way
 Horizontal: 26.0 0.0 Bypass Length: 0
 Future AADT Yr/Cnt: 2032 / 9588
 Designated Truck Rte: NONE
 Special Systems: No

Key Route Under Data

FEDERAL-AID INTERSTATE 0055 Station: 5.8800
 Main Route Segment: 00000
 016 LYONS Linked: Natl. Hwy System: On NHS
 5620 SUMMIT Inventory Direction: 2014 / 132000
 1051 1051 Curr AADT Yr/Count: 2014 / 132000
 1 INTERSTATE North/West Est Truck Percentage: 9
 South/East Number Of Lanes: 7
 36.0 One Or Two Way: 2 Two-Way
 67.0 Bypass Length: 0
 Future AADT Yr/Cnt: 2032 / 135960
 Designated Truck Rte: CLASS I
 Special Systems: Yes

Marked Route On Data ***

Route #	Designation	Kind	Number
Route #1:	1 Mainline	1 Interstate Highway	055
Route #2:	1 Mainline	1 Mainline	
Route #3:	1 Mainline	1 Mainline	

Marked Route Under Data ***

Route #	Designation	Kind	Number
Route #1:	1 Mainline	1 Interstate Highway	055
Route #2:	1 Mainline	1 Mainline	
Route #3:	1 Mainline	1 Mainline	

**Illinois Department of Transportation
Structures Information Management System
Structure Summary Report**

Structure Number: 016-0046 District: 1

Data Related to Inspection Information

*** Inspection Intervals ***
 Routine NBIS: 24 MOS Underwater: 0 MOS One Truck At A Time: 0 Tons Combination Type 3S-1: Tons Bridge Posting Level: 5
 Special: N Single Unit Vehicles: Tons Combination Type 3S-2: Tons No Posting Required

Inspection/Appraisal Information

Inspection Date: 01/10/2014 Inspection Temperature: 40Deg.F
 Deck: 4 POOR CONDITION - ADVANCED DETERIORATION
 Superstructure: 5 FAIR CONDITION - MINOR SECTION LOSS, CRACKS
 Substructure: 6 SATISFACTORY CONDITION - MINOR DETERIORATION
 Culvert: N NOT APPLICABLE
 Channel and Protection: N NOT APPLICABLE
 Structural Evaluation:
 Deck Geometry:
 Underclearance-Vert/Lat.:
 Waterway Adequacy:
 Approach Roadway Align: N NOT APPLICABLE
 Bridge Railing Appraisal: 8 EQUAL TO PRESENT DESIRABLE CRITERIA
 Approach Guardrail: 3 Meets Standards
 Pler Navig Protection: 232 Not Acceptable
 N/A Acceptable Not Acceptable

Deck Wearing Surf: F MICRO SIL CON OVRLY
 Deck Membrane: F NONE
 Deck Protection: J NONE
 Total Deck Thick: 8.5
 Last Paint Date: 11/1994

Single Unit Vehicles: Tons
 Combination Type 3S-1: Tons
 Combination Type 3S-2: Tons
 One Truck At A Time: 0
 Last Paint Type: CH
 LD SHP GRN&AL FNL
 FLD ZINC & VINYL

Underwater Inspection/Appraisal Information

Inspection Date:
 Temperature:
 Inspection Method:
 Appraisal Rating:

Scour Critical Information

Rating:
 Analysis Date:
 Evaluation Method:
 Microfilm Data Recorded: Yes

Construction Information

Year: 1963 Original
 Route: FAI 55
 Section Nbr: 0707-611HB
 Contract Nbr: 82123
 Fed Aid Pr#: I 0557085277
 Built By: 1 I.D.O.T.

1994 Reconstructed
 Sta: 312+55.25 FAU2746
 Sta: 0707-611HB-R
 82123
 1 I.D.O.T.



October 27, 2015

MEMORANDUM

Mr. John Fortmann, Region One Engineer
Illinois Department of Transportation
Region One/District One

Attn: Steven Schilke

RE: Existing S.N. 016-0047
GM&O RR over I-55 Ramp
Cook County
PTB 158-002/P-91-762-10

The purpose of this technical memo is to summarize the current condition of existing S.N. 016-0047 in addition to geometrics and other factors. A cursory field check was performed to supplement the information contained in IDOT's structure summary report. Broad-based recommendations for this structure are provided below.

No bridge matching the description provided for in the current IDOT structure summary report (see Appendix A) was located during a cursory field check. It is possible that this structure no longer exists and that the structure summary report was never removed from official record. S.N. 016-0047 should be removed from the project scope of services.

LIN ENGINEERING, LTD.

Michael T. Haley, PE, SE
Structural Manager

Appendix A – IDOT Structure Summary Report

**Illinois Department of Transportation
Structures Information Management System
Structure Summary Report**

Structure Number: 016-0047 District: 1

Facility Carried:	GM&O RR	Bridge Name:		Sufficiency Rating:		Structure Length:	109.0
Feature Crossed:	I-55 RP TO ASHLAND	Location:	0.14 M W ASHLD P5C	HBP Eligible:	Yes	AASHTO Bridge Length:	99.9
Bridge Status:	1 OPEN - NO RESTRICT	Status Date:	04/1988	Replaces By:	-	Length of Long Span:	68.0
Status Remarks:		Maint Township:		Last Update Date:	07/05/2012	Bridge Roadway Width:	0.0
Maint County:	016 COOK			Parallel Structure:	None	Deck Width:	0.0
Maint Responsibility:	06 RAILROAD			Multi-Level Structure Nbr:		Sidewalk Width Right:	0.0
Service On/Under:	2 RAILROAD	1 / HIGHWAY		Skew Direction:	N	Sidewalk Width Left:	0.0
Reporting Agency:	6 RAILROAD			Skew Angle:	0 D	Navigation Control:	N/A
Main Span Matl/Type:	7 TIMBER	/ 00 OTHER		Structure Flared:	No	Navigation Horiz Clear:	0
Nbr Of Main Spans:	3	Nbr Of Approach Spans: 0		Historical Significance:	No	Navigation Vert Clear:	0
Approaches				Border Bridge State:		Culvert Fill Depth:	0.0
Near #1 Matl/Type:	/	/		Bdr State SN:		Number Culvert Cells:	0
Near #2 Matl/Type:	/	/		Bdr State % Responsibility:		Culvert Opening Area:	0.0
Far #1 Matl/Type:	/	/		Structural Steel Wt:	0	Culvert Cell Height:	0.00
Far #2 Matl/Type:	/	/		Substructure Material:		Culvert Cell Width:	0.00
Median Width/Type:	0 Ft./0	None		Rated By:	N N/A	Rate Method:	N
Guardrail Type L/R:	0None	/ 0		Load Rating Date:	05/25/1985	Railroad Crossing Info	
Toll Facility Indicator:	0 No Toll			Inventory Rating:		Crossing 1 Nbr:	
Latitude:	41.83716000	S Longitude:	87.66958000	Operating Rating:	S	Crossing 1 Nbr:	
Deck Structure Type:	4 Both Sides Separate			Design Load:	02 HS20	RR Lateral Underclear:	0.0
Sidewalks Under Structure:				Deck Structure Thickness:	0 SD:	RR Vertical Underclear:	0 Ft 0 In

Key Route On Data

Key Route Nbr:		Station:	
Appurtenances		Segment:	FEDERAL-AID INTERSTATE
Inventory County:		Linked:	Ramp
Township/Road Dist		Natl. Hwy System:	016
Municipality		Inventory Direction:	83 SOUTH CHICAGO (CHICAGO)
Urban Area:		Curr AADT Yr/Count:	1051 CHICAGO
** CLEARANCES **	South/East	Est Truck Percentage:	1051
	North/West	Number Of Lanes:	1 INTERSTATE
		One Or Two Way:	South/East North/West
		Bypass Length:	0.0
		Future AADT Yr/Cnt:	34.6
		Designated Truck Rte:	
		Special Systems:	

Key Route Under Data

Station:	0055	Station:	0.8300
Segment:		Linked:	Y
Natl. Hwy System:		Inventory Direction:	On NHS
Curr AADT Yr/Count:	2002 /	Est Truck Percentage:	0
Number Of Lanes:	2	One Or Two Way:	Two-Way
Bypass Length:	76	Future AADT Yr/Cnt:	2021 /
Designated Truck Rte:	NONE	Special Systems:	No

***** Marked Route On Data *****

Route #1:	Designation	Kind	Number
Route #2:	1 Mainline	1 Interstate Highway	
Route #3:	1 Mainline	1 Mainline	

***** Marked Route Under Data *****

Designation	Kind	Number
1 Mainline	1 Interstate Highway	
1 Mainline	1 Mainline	

Illinois Department of Transportation
Structures Information Management System
Structure Summary Report

District: 1

Structure Number: 016-0047

Data Related to Inspection Information

*** Inspection Intervals ***
 Routine NBIS: 24 MOS
 Underwater: 0 MOS
 Special: N
 One Truck AT A Time: 0
 Single Unit Vehicles: Tons
 Combination Type 3S-1: Tons
 Combination Type 3S-2: Tons
 Bridge Posting Level: N

Inspection/Appraisal Information

Inspection Date:
 Deg. F
 Inspection Temperature:
 Superstructure:
 Substructure:
 Culvert:
 Channel and Protection:
 Structural Evaluation:
 Deck Geometry:
 Underclearance-Vert/Lat.:
 Waterway Adequacy:
 Approach Roadway Align:
 Bridge Railing Appraisal:
 Approach Guardrail:
 Pier Navig Protection:
 Deg. F
 Inspection Temperature:
 Deck Wearing Surf:
 Deck Membrane:
 Deck Protection:
 Total Deck Thick:
 Last Paint Date:
 Single Unit Vehicles: Tons
 Combination Type 3S-1: Tons
 Combination Type 3S-2: Tons
 One Truck AT A Time:
 Last Paint Type:
 *** Actual Posted Limits ***

Underwater Inspection/Appraisal Information

Inspection Date:
 Temperature:
 Inspection Method:
 Appraisal Rating:

Scour Critical Information

Rating:
 Analysis Date:
 Evaluation Method:
 Microfilm Data Recorded: Yes

Construction Information

Year: 1964 Original
 Route: FAI-55 Sta: 69+92.49
 Section Nbr: 101-681-HB Reconstructed Sta:
 Contract Nbr:
 Fed Aid Pt#: 0000000000000
 Built By: 3 COUNTY AGENCY



October 27, 2015

MEMORANDUM

Mr. John Fortmann, Region One Engineer
Illinois Department of Transportation
Region One/District One

Attn: Steven Schilke

RE: Existing S.N. 016-0316
IL 43 (Harlem Ave.) over I-55
Cook County
PTB 158-002/P-91-762-10

The purpose of this technical memo is to summarize the current condition of existing S.N. 016-0316 in addition to geometrics and other factors. A cursory field check was performed to supplement the information contained in IDOT's structure summary report dated August 22, 2014 (see Appendix B). Broad-based recommendations for this structure are provided below.

The structure is a four span steel beam bridge consisting of twenty-four lines of continuous beams with a hinge in spans 1 and 4 (see Photo 1). Span lengths from south to north are 49'-0", 84'-1½", 84'-1½" and 41'-6". The superstructure is supported by pile bent abutments and reinforced concrete multi-column piers. There is a dense concrete overlay on the structure.

IDOT rates the deck as being in satisfactory condition. The findings from the cursory field check don't match IDOT's deck rating. Moderate transverse cracks with leaching and large spalled areas with exposed rebar are visible on the soffit (see Photo 2). Spalls are also visible on the deck overlay, sidewalks, medians and parapets (see Photo 3). IDOT rates the superstructure as being in fair condition, which concurs with the findings from the cursory field check. Moderate to heavy paint peeling and rusting is visible on the web and flanges of all beams (see Photo 4). IDOT rates the substructure as being in good condition. The findings from the cursory field check don't match IDOT's substructure rating. Minor to heavy spalls, horizontal cracks and vertical cracks are visible on abutments (see Photo 5). A large vertical crack is visible between the abutment and wingwall (see Photo 6). Delaminations, map cracks and spalls are visible on the piers. IDOT rates the underclearance vertical and lateral as being intolerable requiring a high priority of corrective action, which concurs with the findings from the cursory field check. Impact damage and scrape marks are visible on the exterior beams over W.B. I-55 traffic (see Photo 7). No notable defects or differences were observed between the cursory field check and IDOT's structure summary report for: deck geometry, approach alignment, and approach guardrail items. The bridge parapet is missing several sections of steel railing (see Photo 8). Anchor blocks and joint seals are damaged or missing along sections of both expansion



joints (see Photo 9). Anchor bolts are missing on some bearings at both abutments (see Photo 10).

Based on the structure summary report and field check, S.N. 016-0316 is suitable for replacement of the deck and rehabilitation of the substructure and superstructure. The approach guardrails should be brought up to current IDOT standards.

LIN ENGINEERING, LTD.

Michael T. Haley, PE, SE
Structural Manager

Appendix A – Photos

Appendix B – IDOT Structure Summary Report

Appendix C – PONTIS Report



Photo 1



Photo 2



Photo 3



Photo 4



Photo 5



Photo 6



Photo 7



Photo 8



Photo 9



Photo 10

Illinois Department of Transportation
Structures Information Management System
Structure Summary Report

Structure Number: 016-0316 District: 1

Inventory Data

Facility Carried: IL 43 (HARLEM AVE) Bridge Name: Sufficiency Rating: 83.0 Structure Length: 251.1
 Feature Crossed: I-55 STEVENSON Location: 0.47 MI N OF ARCHER HBP Eligible: No AASHTO Bridge Length: 99.9
 Bridge Remarks: Replaced By: - Length of Long Span: 84.0
 Bridge Status: 1 OPEN - NO RESTRICT Status Date: 03/1998
 Status Remarks: PER KRAMARZ MEMO 3-10-98
 Maint County: 016 COOK Maint Township: 34 STICKNEY
 Maint Responsibility: 01 I.D.O.T.
 Service On/Under: 5 SECOND LEVEL INTERCHANGE 1 / HIGHWAY
 Reporting Agency: 1 I.D.O.T. - BUREAU OF MAINTENANCE
 Main Span Matl/Type: 4 STEEL CONTINUOUS / 02 STRINGERMULTI-BEAM/GIRDER
 Nbr Of Main Spans: 4 Nbr Of Approach Spans: 0
 Approaches
 Near #1 Matl/Type: /
 Near #2 Matl/Type: /
 Far #1 Matl/Type: /
 Far #2 Matl/Type: /
 Median Width/Type: 10 Ft. / 2 Mountable, all types
 Guardrail Type L/R: 0 None / 0
 Toll Facility Indicator: 0 No Toll
 Latitude: 41.78906290 S Longitude: 87.80211048 S
 Deck Structure Type: A CIP CON NRMILLY FORM
 Sidewalks Under Structure: 0 None
 Inventory Rating: 1.210(43) Load Rating Date: 12/14/2010 Railroad Crossing Info
 Operating Rating: 2.020(72) Crossing 1 Nbr:
 Design Load: 02 HS20 Crossing 1 Nbr:
 Deck Structure Thickness: 7 SD: N FO: Y RR Lateral Underclear: 0 Ft 0 In
 RR Vertical Underclear: 0

Key Route On Data

Key Route Nbr: FEDERAL-AID PRIMARY 0348 Station: 25.2400
 Appurtenances Main Route 00000
 Inventory County: 016 COOK
 Township/Road Dist 34 STICKNEY
 Municipality 2010 FOREST VIEW
 Urban Area: 1051
 Functional Class: 3 OTHER PRINCIPAL ARTERIAL
 ** CLEARANCES ** South/East North/West
 Max Rdwy Width: 142.0 0.0
 Horizontal: 153.0
 Lateral:
 Designation Kind Number
 1 Mainline 3 State Highway 043
 1 Mainline
 1 Mainline

Key Route Under Data

FEDERAL-AID INTERSTATE 0055 Station: 7.0700
 Main Route 00000
 016
 34 STICKNEY
 2010 FOREST VIEW
 1051 1051
 1 INTERSTATE
 South/East North/West
 36.0
 73.0
 Segment: 00000
 Linked: Y
 Natl. Hwy System: On NHS
 Inventory Direction: FOREST VIEW
 Curr AADT Yr/Count: 2013 / 45600
 Est Truck Percentage: 16
 Number Of Lanes: 9
 One Or Two Way: 2 Two-Way
 Bypass Length: 0
 Future AADT Yr/Cnt: 2032 / 45114
 Designated Truck Rte: CLASS II
 Special Systems: Yes
 Designation Kind Number
 1 Mainline 1 Interstate Highway 055
 1 Mainline
 1 Mainline

*** Marked Route On Data ***

Route #1: 1 Mainline 3 State Highway 043
 Route #2: 1 Mainline
 Route #3: 1 Mainline

*** Marked Route Under Data ***

Designation Kind Number
 1 Mainline
 1 Mainline
 1 Mainline

**Illinois Department of Transportation
Structures Information Management System
Structure Summary Report**

District: 1

Structure Number: 016-0316

Data Related to Inspection Information

*** Inspection Intervals ***

Routine NBIS: 24 MOS Underwater: 0 MOS One Truck At A Time: 0 Combination Type 3S-1: Tons
Special: Y Single Unit Vehicles: Tons Combination Type 3S-2: Tons

Bridge Posting Level: 5 No Posting Required

Inspection/Appraisal Information

Inspection Date: 08/22/2014 Inspection Temperature: 86Deg. F
Deck: 6 SATISFACTORY CONDITION - MINOR DETERIORATION
Superstructure: 5 FAIR CONDITION - MINOR SECTION LOSS, CRACKS
Substructure: 7 GOOD CONDITION - SOME MINOR PROBLEMS
Culvert: N NOT APPLICABLE
Channel and Protection: N NOT APPLICABLE
Structural Evaluation: 5 BETTER THAN ADEQUATE TO BE LEFT IN PLACE
Deck Geometry: 9 SUPERIOR TO PRESENT DESIRABLE CRITERIA
Underclearance-Vert/Lat.: 3 INTOLERABLE - HIGH PRIORITY FOR CORRECTION
Waterway Adequacy: N NOT APPLICABLE
Approach Roadway Align: 8 EQUAL TO PRESENT DESIRABLE CRITERIA
Bridge Railing Appraisal: 3 Meets Standards
Approach Guardrail: 222 Not Acceptable
Pier Navig Protection: N N/A

Deck Wearing Surf: E PLAS DENSE CON OVLY
Deck Membrane: F NONE
Deck Protection: A EPOXY COATED REINF
Total Deck Thick: 9.0
Last Paint Date: 10/1990

Single Unit Vehicles: Tons
Combination Type 3S-1: Tons
Combination Type 3S-2: Tons
One Truck At A Time: 0
Last Paint Type: H
FLD ZINC & VINYL

** Actual Posted Limits **

Underwater Inspection/Appraisal Information

Inspection Date: Inspection Method: Appraisal Rating:

Scour Critical Information

Rating: Evaluation Method: Microfilm Data Recorded: Yes

Construction Information

Year: 1964 Original 1990 Reconstructed
Route: FAI-55 Sta: 500+82.13 FAP-848 Sta: REMARKS
Section Nbr: 207.0708.2A 207.0708.2A-CF
Contract Nbr: 80528
Fed Aid Pr#: I 0557114278
Built By: 3 COUNTY AGENCY 1 I.D.O.T.

Pontis

Today's Date: 09/03/2015

Structure Number: 016-0316 District: 1 (41) Bridge Status: 1 OPEN - NO RESTRICT
 (6) Feature Crossed: I-55 STEVENSON (7) Facility Carried: IL 43 (HARLEM AVE)
 (9) Location: 0.47 MI N OF ARCHER (7A) Bridge Name:
 Element Inspection Date: 08/22/2014
 (90E) Agency Program Manager: LandersJJ (90E3) Consultant Program Manager:
 (90E1) Team Leader: KhalilJS (90E2) Inspector:

Element Insp. Delinquent		Element Insp. Delinquent Reason:									
Element Description											
Elem	Env	% 1	Qty 1	% 2	Qty 2	% 3	Qty 3	% 4	Qty 4	Tot Qty	
Lead Painted Steel Open Girder											
107	4	72	40,679	28	16,000	0	0	0	0	56,679	
		No corrosion	Paint distress	Rust formation	Section loss	Section failure					
Remarks: Scattered areas of paint peeling on diaphragms & surface rust present on beams bottom flanges & webs.											
Reinforced Conc Column or Pile Extension											
205	4	99	2,502	0	0	1	14	0	0	2,516	
		No deterioration	Minor cracks/spalls	Delams/spalls	Analysis warranted						
Remarks: Delamins @ pier#1 column #5 & 6											
Reinforced Conc Pier Wall											
210	4	100	4,131	0	0	0	0	0	0	4,131	
		No deterioration	Minor cracks/spalls	Delams/spalls	Analysis warranted						
Remarks:											
Reinforced Conc Abutment											
215	4	98	1,194	2	24	0	0	0	0	1,218	
		No deterioration	Minor cracks/spalls	Delams/spalls	Analysis warranted						
Remarks: W. Abut (wingwall sw corner meas crack). also NW corner											
Reinforced Conc Pier or Abutment Cap											
234	4	97	744	2	16	1	8	0	0	768	
		No deterioration	Minor cracks/spalls	Delams/spalls	Analysis warranted						
Remarks:											
Preformed Joint Seal											
302	4	0	0	87	495	13	75	0	0	570	
		No deterioration	Minor deterioration	Major deterioration							
Remarks: rubber filling over compressed at N. abutment of SB lanes											
Movable Discontinuous Brg.											
311	4	0	0	100	48	0	0	0	0	48	
		No deterioration	Minor deterioration	Advanced corrosion							
Remarks:											

Fixed Bearing										
313	4	0	0	100	24	0	0	0	0	24
		No deterioration	Minor deterioration		Advanced corrosion					
Remarks:										
Concrete Bridge Railing										
331	4	0	0	73	220	27	80	0	0	300
		No deterioration	Minor cracks/spalls		Analysis warranted					
Remarks: spalls, cracks and delams at bottom of parapets										
Concrete Deck Protected w/ Rigid Overlay										
8022	4	98	38,660	2	900	0	40	0	0	39,600
Remarks: F.D. patches & scattered areas of chloride contamination in soffit. Light transv. cracks in wearing surface. Exposed rebars										
Non-Lead Painted Steel Pin and Hanger										
8162	4	100	48	0	0	0	0	0	0	48
Remarks:										
Lead Painted Steel Closed Web/Box Girder Ends										
8172	4	31	44	69	100	0	0	0	0	144
Remarks: Some surface rust present.										
Continuous Seal Neoprene Expansion Joint										
8308	4	0	0	95	292	5	14	0	0	306
Remarks: Joint worn (possible plow damage) & seal ripped @ various areas. Missing neo. section in SB turning lane & median and NBL 3.										
Moveable Steel Bearings below continuous decks										
8316	4	0	0	100	48	0	0	0	0	48
Remarks:										
Approach Pavement										
8323	4	0	0	100	2	0	0	0	0	2
Remarks: Pot-holes & map cracking thru-out both approach pavt's										



October 27, 2015

MEMORANDUM

Mr. John Fortmann, Region One Engineer
Illinois Department of Transportation
Region One/District One

Attn: Steven Schilke

RE: Existing S.N. 016-0484
S.B. IL 171 (First Ave.) over I-55
Cook County
PTB 158-002/P-91-762-10

The purpose of this technical memo is to summarize the current condition of existing S.N. 016-0484 in addition to geometrics and other factors. A cursory field check was performed to supplement the information contained in IDOT's structure summary report. Broad-based recommendations for this structure are provided below.

No structure summary report exists on the Illinois Bridge Information website. A cursory field check discovered that this structure is being entirely replaced under Job No. D-91-191-10. The new structure shall be adequate for re-use.

LIN ENGINEERING, LTD.

Michael T. Haley, PE, SE
Structural Manager



October 27, 2015

MEMORANDUM

Mr. John Fortmann, Region One Engineer
Illinois Department of Transportation
Region One/District One

Attn: Steven Schilke

RE: Existing S.N. 016-0485
N.B. IL 171 (First Ave.) over I-55
Cook County
PTB 158-002/P-91-762-10

The purpose of this technical memo is to summarize the current condition of existing S.N. 016-0485 in addition to geometrics and other factors. A cursory field check was performed to supplement the information contained in IDOT's structure summary report (see Appendix A). Broad-based recommendations for this structure are provided below.

A cursory field check discovered that this structure is being entirely replaced under Job No. D-91-191-10. The current IDOT structure summary report does not reflect the planned full bridge replacement. The new structure shall be adequate for re-use.

LIN ENGINEERING, LTD.

Michael T. Haley, PE, SE
Structural Manager

Appendix A – IDOT Structure Summary Report

**Illinois Department of Transportation
Structures Information Management System
Structure Summary Report**

Structure Number: 016-0485 District: 1

Inventory Data	
Facility Carried:	IL 171 NB FIRST AVE
Feature Crossed:	I-55 STEVENSON
Bridge Remarks:	VC 7-26-94
Bridge Status:	1 OPEN - NO RESTRICT
Status Remarks:	
Maint County:	016 COOK
Maint Responsibility:	01 I.D.O.T.
Service On/Under:	5 SECOND LEVEL INTERCHANGE 1 / HIGHWAY
Reporting Agency:	1 I.D.O.T. - BUREAU OF MAINTENANCE
Main Span Matl/Type:	4 STEEL CONTINUOUS
Nbr Of Main Spans:	5 Nbr Of Approach Spans: 0
Approaches	
Near #1 Matl/Type:	/
Near #2 Matl/Type:	/
Far #1 Matl/Type:	/
Far #2 Matl/Type:	/
Median Width/Type:	0 Ft./0 None / 0
Guardrail Type L/R:	0 None / 0
Toll Facility Indicator:	0 No Toll
Latitude:	41.79333427 S Longitude: 87.82071291 S
Deck Structure Type:	A CIP CON NRMALLY FORM
Sidewalks Under Structure:	0 None
Sufficiency Rating:	49.0 Structure Length: 293.6
HBP Eligible:	Yes AASHTO Bridge Length: 99.9
Replaced By:	- Length of Long Span: 74.1
Replaces:	016-1511 Bridge Roadway Width: 44.2
Last Update Date:	06/21/2014 Appr Roadway Width: 33.0
Parallel Structure:	Right Deck Width: 50.2
Multi-Level Structure Nbr:	Sidewalk Width Right: 0.0
Skew Direction:	L Left Sidewalk Width Left: 0.0
Skew Angle:	9 D Navigation Control: N N/A
Structure Flared:	No Navigation Horiz Clear: 0
Historical Significance:	No Navigation Vert Clear: 0
Border Bridge State:	Culvert Fill Depth: 0.0
Bdr State SN:	Number Culvert Cells: 0
Bdr State % Responsibility:	0 Culvert Opening Area: 0.0
Structural Steel Wt:	706000 Culvert Cell Height: 0.00
Substructure Material:	Culvert Cell Width: 0.00
Rated By:	2 IDOT Rate Method: 6
Inventory Rating:	1.310(47) Load Rating Date: 07/13/2005 Railroad Crossing Info
Operating Rating:	2.180(78) Crossing 1 Nbr:
Design Load:	02 HS20 Crossing 1 Nbr:
Deck Structure Thickness:	7 SD: Y FC: Y RR Lateral Underclear: 0.0
	RR Vertical Underclear: 0 Ft 0 In

Key Route On Data	
Key Route Nbr:	FEDERAL-AID PRIMARY 0373 Station: 0.0300
Appurtenances Main Route	00000 Segment: 00000
Inventory County:	016 COOK Linked: Y
Township/Road Dist	16 LYONS Natl. Hwy System: On NHS
Municipality	5620 SUMMIT Inventory Direction:
Urban Area:	1051 Curr AADT Yr/Count: 2013 / 21100
** CLEARANCES **	3 OTHER PRINCIPAL ARTERIAL Est Truck Percentage: 14
South/East	North/West Number Of Lanes: 3
Max Rdwy Width:	44.2 One Or Two Way: 1 One-Way
Horizontal:	48.2 Bypass Length: 0
	Future AADT Yr/Cnt: 2032 / 28119
	Designated Truck Rte: NONE
Laterals:	Special Systems: Yes

Key Route Under Data	
Main Route	FEDERAL-AID INTERSTATE 00000 Station: 5.9900
016 LYONS	Segment: 00000
5620 SUMMIT	Linked: Y
1051 1051	Natl. Hwy System: On NHS
1 INTERSTATE	Inventory Direction:
South/East	North/West Curr AADT Yr/Count: 2014 / 132000
36.0	Est Truck Percentage: 9
56.2	Number Of Lanes: 6
	One Or Two Way: 2 Two-Way
	Bypass Length: 0
	Future AADT Yr/Cnt: 2032 / 135960
	Designated Truck Rte: CLASS I
	Special Systems: Yes

**** Marked Route On Data ****		
Designation	Kind	Number
1 Mainline	3 State Highway	171
1 Mainline	1 Mainline	
1 Mainline	1 Mainline	

**** Marked Route Under Data ****		
Designation	Kind	Number
1 Mainline	1 Interstate Highway	055
1 Mainline	1 Mainline	
1 Mainline	1 Mainline	

Illinois Department of Transportation
Structures Information Management System
Structure Summary Report

Structure Number: 016-0485 District: 1

*** Inspection Intervals *** Data Related to Inspection Information

Routine NBIS:	12 MOS	Underwater:	0 MOS	One Truck At A Time:	0	Combination Type 3S-1:	Tons	Bridge Posting Level:	5	No Posting Required
Special:	N	Single Unit Vehicles:	Tons	Combination Type 3S-2:	Tons					

*** Maximum Allowable Posting Limits *** ** Actual Posted Limits **

Inspection Date:	09/08/2014	Inspection Temperature:	78Deg. F	Single Unit Vehicles:	Tons	Combination Type 3S-1:	Tons	Combination Type 3S-2:	Tons	One Truck At A Time:	0	Last Paint Type:	C
Deck:	4	POOR CONDITION - ADVANCED DETERIORATION		Deck Wearing Surf:	F	MICRO SIL CON OVRLY		Deck Membrane:	F	NONE		LD SHP GRN&AL FNL	
Superstructure:	4	POOR CONDITION - ADVANCED DETERIORATION		Deck Protection:	J	NONE		Total Deck Thick:	8.5				
Substructure:	6	SATISFACTORY CONDITION - MINOR DETERIORATION		Last Paint Date:	09/1989								
Culvert:	N	NOT APPLICABLE											
Channel and Protection:	N	NOT APPLICABLE											
Structural Evaluation:	4	MINIMUM ADEQUACY TO BE LEFT IN PLACE											
Deck Geometry:	5	BETTER THAN ADEQUATE TO BE LEFT IN PLACE											
Underclearance-Vert/Lat.:	3	INTOLERABLE - HIGH PRIORITY FOR CORRECTION											
Waterway Adequacy:	N	NOT APPLICABLE											
Approach Roadway Align:	8	EQUAL TO PRESENT DESIRABLE CRITERIA											
Bridge Railing Appraisal:	2	Doesn't Meet Standards											
Approach Guardrail:	332	Acceptable											
Pier Navig Protection:	N	N/A											

Underwater Inspection/Appraisal Information

Inspection Date: Inspection Method: Appraisal Rating:

Scour Critical Information

Rating: Evaluation Method: Microfilm Data Recorded: Yes

Construction Information

Year:	1964	Original	1994	Reconstructed
Route:	FAI-55	Sta: 318+07.25	FAU2744	Sta:
Section Nbr:	0707-608-HB			0606-627UB-BR
Contract Nbr:				82123
Fed Aid Pt#:	I 0557082277			
Built By:	1	I.D.O.T.	1	I.D.O.T.



October 27, 2015

MEMORANDUM

Mr. John Fortmann, Region One Engineer
Illinois Department of Transportation
Region One/District One

Attn: Steven Schilke

RE: Existing S.N. 016-0537
Willow Springs Rd. over I-55
Cook County
PTB 158-002/P-91-762-10

The purpose of this technical memo is to summarize the current condition of existing S.N. 016-0537 in addition to geometrics and other factors. A cursory field check was performed to supplement the information contained in IDOT's structure summary report dated August 29, 2014 (see Appendix B). Broad-based recommendations for this structure are provided below.

The structure is a four span steel beam bridge consisting of twelve lines of continuous beams with a hinge in spans 1 and 4 (see Photo 1). Span lengths from south to north are 34'-6", 67'-6½", 67'-6½" and 36'-0". The superstructure is supported by pile bent abutments and reinforced concrete multi-column piers. There is a concrete overlay on the structure.

IDOT rates the deck as being in satisfactory condition, which concurs with the findings from the cursory field check. Map cracking is visible on a majority of the wearing surface (see Photo 2). Transverse cracks with leaching, general discoloration, and fillet spalls are visible throughout the soffit (see Photo 3). IDOT rates the superstructure as being in satisfactory condition, which concurs with the findings from the cursory field check. Minor to moderate rusting is visible around the pin and hanger connections (see Photo 4). IDOT rates the substructure as being in satisfactory condition, which concurs with the findings from the cursory field check. Minor to moderate cracks, spalls and delaminations are visible on the abutments and piers (see Photo 5). IDOT rates the underclearance vertical and lateral as being intolerable requiring a high priority of corrective action, which concurs with the findings from the cursory field check. Impact damage to the beams is visible above E.B. I-55 traffic lanes (see Photo 6). No notable defects or differences were observed between the cursory field check and IDOT's structure summary report for: deck geometry, approach alignment, bridge railing appraisal and approach guardrail items. Heavy cracking is present on both slopewalls. A visible rotation is present in some bearings on the south abutment (see Photo 7).

Based on the structure summary report and field check, S.N. 016-0537 is suitable for replacement of the deck and rehabilitation of the substructure and superstructure. Slopewalls



LIN ENGINEERING, LTD.
Consulting Engineers

Springfield, IL Westmont, IL

576 Oakmont Lane
Westmont, Illinois 60559
Telephone: (630) 323-5168
Fax: (630) 323-5174
E-mail: info@lineng.com

should be repaired. The approach guardrail ends should be brought up to current IDOT standards.

LIN ENGINEERING, LTD.

A handwritten signature in blue ink that reads "Michael T. Haley". The signature is written in a cursive, flowing style.

Michael T. Haley, PE, SE
Structural Manager

Appendix A – Photos

Appendix B – IDOT Structure Summary Report

Appendix C – PONTIS Report



Photo 1



Photo 2



Photo 3



Photo 4



Photo 5



Photo 6



Photo 7

Structure Number: 016-0537 District: 1

Inventory Data	
Facility Carried: WILLOW SPRINGS RD	Bridge Name: 1 M W US 45
Feature Crossed: I-55 STEVENSON	Location: 04/1988
Bridge Remarks:	Status Date: 16 LYONS
Bridge Status: 1 OPEN - NO RESTRICT	Maint Township: 1 / HIGHWAY
Status Remarks:	Maint County: COOK
Maint County: 016 COOK	Maint Agency: 01 I.D.O.T.
Maint Responsibility: 01 I.D.O.T.	Service On/Under: 1 HIGHWAY
Reporting Agency: 1 I.D.O.T. - BUREAU OF MAINTENANCE	Main Span Matl/Type: 4 STEEL CONTINUOUS
Main Span Matl/Type: 4 STEEL CONTINUOUS	Nbr Of Main Spans: 4
Nbr Of Main Spans: 4	Nbr Of Approach Spans: 0
Approaches	
Near #1 Matl/Type:	
Near #2 Matl/Type:	
Far #1 Matl/Type:	
Far #2 Matl/Type:	
Median Width/Type:	
Guardrail Type L/R:	
Toll Facility Indicator:	
Latitude:	
Deck Structure Type:	
Sidewalks Under Structure:	
Inventory Rating: 1.005(36)	Operating Rating: 1.680(60)
Design Load: 02 HS20	Deck Structure Thickness: 7 SD: N FO: Y
Rate Method: 2 IDOT	Rated By: 2 IDOT
Load Rating Date: 12/04/2008	Rate Method: 6
Crossing 1 Nbr: 0	Crossing 1 Nbr: 0
Crossing 1 Nbr: 0	RR Lateral Underclear: 0
RR Lateral Underclear: 0	RR Vertical Underclear: 0

Key Route On Data	
Key Route Nbr: FEDERAL-AID URBAN	Station: 2697
Appurtenances Main Route	Segment: 00000
Inventory County: 016 COOK	Linked: Y
Township/Road Dist 16 LYONS	Natl. Hwy System: Not on NHS
Municipality 1272 COUNTRYSIDE	Inventory Direction: 2014 / 10300
Urban Area: 1051	Curr AADT Yr/Count: 2
** CLEARANCES **	Est Truck Percentage: 4
South/East	Number Of Lanes: 2 Two-Way
North/West	One Or Two Way: 5
0.0	Bypass Length: 2032 / 11742
58.0	Future AADT Yr/Cnt: NONE
68.0	Designated Truck Rte: NONE
	Special Systems: No
Laterals:	
*** Marked Route On Data ***	
Designation	Kind
1 Mainline	8 Other
1 Mainline	
1 Mainline	

Key Route Under Data	
FEDERAL-AID INTERSTATE	Station: 0055
Main Route	Segment: 00000
016 LYONS	Linked: Y
1272 COUNTRYSIDE	Natl. Hwy System: On NHS
1051	Inventory Direction: 2014 / 148400
1 INTERSTATE	Curr AADT Yr/Count: 8
South/East	Est Truck Percentage: 6
North/West	Number Of Lanes: 2 Two-Way
36.0	One Or Two Way: 0
54.5	Bypass Length: 2032 / 169126
	Future AADT Yr/Cnt: CLASS I
	Designated Truck Rte: Yes
	Special Systems: Yes
*** Marked Route Under Data ***	
Designation	Kind
1 Mainline	1 Interstate Highway
1 Mainline	
1 Mainline	

**Illinois Department of Transportation
Structures Information Management System
Structure Summary Report**

Structure Number: 016-0537 District: 1

Data Related to Inspection Information

*** Inspection Intervals ***
 Routine NBIS: 24 MOS Underwater: 0 MOS One Truck At A Time: 0 Tons Combination Type 3S-1: Tons
 Special: Y Single Unit Vehicles: Tons Combination Type 3S-2: Tons
 Bridge Posting Level: 5 No Posting Required

Inspection/Appraisal Information

Inspection Date: 08/29/2014 Inspection Temperature: 91Deg. F
 Deck: 6 SATISFACTORY CONDITION - MINOR DETERIORATION
 Superstructure: 6 SATISFACTORY CONDITION - MINOR DETERIORATION
 Substructure: 6 SATISFACTORY CONDITION - MINOR DETERIORATION
 Culvert: N NOT APPLICABLE
 Channel and Protection: N NOT APPLICABLE
 Structural Evaluation: 5 EQUAL TO PRESENT MINIMUM CRITERIA
 Deck Geometry: 5 BETTER THAN ADEQUATE TO BE LEFT IN PLACE
 Underclearance-Vert/Lat.: 3 INTOLERABLE - HIGH PRIORITY FOR CORRECTION
 Waterway Adequacy: N NOT APPLICABLE
 Approach Roadway Align: 7 BETTER THAN PRESENT MINIMUM CRITERIA
 Bridge Railing Appraisal: 3 Meets Standards
 Approach Guardrail: 332 Acceptable Not Acceptable
 Pier Navig Protection: N N/A

Deck Wearing Surf: F MICRO SIL CON OVRLY Last Paint Type: A
 Deck Membrane: F NONE LD SHP PRM GRN FNL
 Deck Protection: J NONE
 Total Deck Thick: 9.0
 Last Paint Date: 10/2006

Underwater Inspection/Appraisal Information

Inspection Date:
 Temperature:
 Inspection Method:
 Appraisal Rating:

Scour Critical Information

Rating:
 Analysis Date:
 Evaluation Method:
 Microfilm Data Recorded: Yes

Construction Information

Year: 1963 Original 1990 Reconstructed
 Route: FAI-55 Sta: 1167+51.08 FAU2697 Sta: 78+52.80
 Section Nbr: 0202-604-HB 3066 W&RS&T-3-10BR(84)
 Contract Nbr: 80156
 Fed Aid Pr#: I 0557065272 IX-6003(851)
 Built By: 1 I.D.O.T. 1 I.D.O.T.

Pontis

Today's Date: 08/27/2015

Structure Number: 016-0537 District: 1 (41) Bridge Status: 1 OPEN - NO RESTRICT
 (6) Feature Crossed: I- 55 STEVENSON (7) Facility Carried: WILLOW SPRINGS RD
 (9) Location: 1 M W US 45 (7A) Bridge Name:
 Element Inspection Date: 08/29/2014
 (90E) Agency Program Manager: LandersJJ (90E3) Consultant Program Manager:
 (90E1) Team Leader: KhalilJS (90E2) Inspector:

Element Insp. Delinquent		Element Insp. Delinquent Reason:									
Elem	Env	% 1	Qty 1	% 2	Qty 2	% 3	Qty 3	% 4	Qty 4	Tot Qty	
Reinforced Conc Column or Pile Extension											
205	4	99	1,777	0	0	1	16	0	0	1,793	
		No deterioration	Minor cracks/spalls	Delams/spalls	Analysis warranted						
Remarks: Spall with exposed rebar at base of column 1, pier 3.											
Reinforced Conc Pier Wall											
210	4	96	1,841	0	0	4	70	0	0	1,911	
		No deterioration	Minor cracks/spalls	Delams/spalls	Analysis warranted						
Remarks: delamins and spalls w/exp bars @ piers 1 & 3											
Reinforced Conc Abutment											
215	4	85	659	13	100	2	12	0	0	771	
		No deterioration	Minor cracks/spalls	Delams/spalls	Analysis warranted						
Remarks: Scattered cracks in backwalls.. Spall at east corner, north backwall.											
Reinforced Conc Pier or Abutment Cap											
234	4	88	308	3	12	9	30	0	0	350	
		No deterioration	Minor cracks/spalls	Delams/spalls	Analysis warranted						
Remarks: Small (<2 sf) spalls scattered on pier caps. Vertical cracks at abutments. spall w /exp bars @ pier cap # 2 south face.											
Preformed Joint Seal											
302	3	0	0	100	140	0	0	0	0	140	
		No deterioration	Minor deterioration	Major deterioration							
Remarks:											
Elastomeric Bearing											
310	4	0	0	83	20	17	4	0	0	24	
		No deterioration	Minor deterioration	Major deterioration							
Remarks:											
Fixed Bearing											
313	4	0	0	89	32	11	4	0	0	36	
		No deterioration	Minor deterioration	Advanced corrosion							
Remarks:											

Concrete Bridge Railing										
331	3	0	0	100	418	0	0	0	0	418
		No deterioration	Minor cracks/spalls		Analysis warranted					
Remarks:										
Concrete Deck Protected w/ Rigid Overlay										
8022	3	62	9,115	34	5,000	3	509	0	0	14,624
Remarks: Map cracks throughout wearing surface. Delams in soffit at construction joints. Some fillets spalling especially below sidewalks.										
Non-Lead Painted Steel Open Girder										
8118	4	80	17,542	20	4,523	0	0	0	0	22,065
Remarks: Surface rust on bottom flanges.										
Non-Lead Painted Steel Pin and Hanger										
8162	3	0	0	100	24	0	0	0	0	24
Remarks: Moderate rust on hangers										
Non-Lead Painted Steel Closed Web/Box Girder Ends										
8173	3	33	24	67	48	0	0	0	0	72
Remarks: light surf rust below joints at pins.										
Continuous Seal Neoprene Expansion Joint										
8308	3	77	54	17	12	6	4	0	0	70
Remarks:										
Approach Pavement										
8323	3	100	2	0	0	0	0	0	0	2
Remarks:										
Steel Open Girder										
8406	3	0	0	0	0	100	5	0	0	5
Remarks: Permanent deformations evident in bottom flange of E.Fascia beam over lane 3 SB I-55.										



October 27, 2015

MEMORANDUM

Mr. John Fortmann, Region One Engineer
Illinois Department of Transportation
Region One/District One

Attn: Steven Schilke

RE: Existing S.N. 016-0587
County Line Rd. over I-55
Cook County
PTB 158-002/P-91-762-10

The purpose of this technical memo is to summarize the current condition of existing S.N. 016-0587 in addition to geometrics and other factors. A cursory field check was performed to supplement the information contained in IDOT's structure summary report dated October 17, 2014 (see Appendix B). Broad-based recommendations for this structure are provided below.

The structure is a four span steel beam bridge consisting of fourteen lines of continuous beams (see Photo 1). Span lengths from south to north are 54'-7", 93'-0", 93'-0" and 54'-7". The superstructure is supported by integral abutments and reinforced concrete multi-column piers. There is no overlay on the structure.

IDOT rates the deck as being in very good condition, which concurs with the findings from the cursory field check. Minor transverse cracks with leaching are visible on a majority of the deck soffit. A few diagonal cracks are visible on the top of deck (see Photo 2). IDOT rates the substructure as being in very good condition, which concurs with the findings from the cursory field check. Areas of previous repairs are visible on all piers. IDOT rates the underclearance vertical and lateral as being intolerable requiring a high priority of corrective action. The findings from the cursory field check don't match IDOT's underclearance vertical and lateral rating. There appears to be sufficient clearance under the structure (see Photos 3 & 4). No notable defects or differences were observed between the cursory field check and IDOT's structure summary report for: superstructure, deck geometry, approach alignment, bridge railing appraisal and approach guardrail items. Minor diagonal cracking is visible on both approaches.

Based on the structure summary report and field check, S.N. 016-0587 is suitable for reuse without rehabilitation.



LIN ENGINEERING, LTD.
Consulting Engineers

Springfield, IL Westmont, IL

576 Oakmont Lane
Westmont, Illinois 60559
Telephone: (630) 323-5168
Fax: (630) 323-5174
E-mail: info@lineng.com

LIN ENGINEERING, LTD.

A handwritten signature in blue ink that reads "Michael T. Haley". The signature is written in a cursive style.

Michael T. Haley, PE, SE
Structural Manager

Appendix A – Photos

Appendix B – IDOT Structure Summary Report

Appendix C – PONTIS Report



Photo 1



Photo 2



Photo 3



Photo 4

**Illinois Department of Transportation
Structures Information Management System
Structure Summary Report**

Structure Number: 016-0587 **District: 1**

		Inventory Data	
Facility Carried:	COUNTY LINE RD	Bridge Name:	
Feature Crossed:	I-55 STEVENSON	Location:	2.6 M W US 45
Bridge Remarks:	MAX = 48.0	Status Date:	10/2014
Bridge Status:	1 OPEN - NO RESTRICT	Maint Township:	16 LYONS
Status Remarks:		County:	COUNTY
Maint County:	016 COOK	Service On/Under:	5 SECOND LEVEL INTERCHANGE
Maint Responsibility:	13 I.D.O.T.	Reporting Agency:	1 I.D.O.T. - BUREAU OF MAINTENANCE
Main Span Mat/Type:	4 STEEL CONTINUOUS	Main Span Mat/Type:	4 STEEL CONTINUOUS
Nbr Of Main Spans:	4	Nbr Of Approach Spans:	0
Approaches			
Near #1 Mat/Type:	/		
Near #2 Mat/Type:	/		
Far #1 Mat/Type:	/		
Far #2 Mat/Type:	/		
Median Width/Type:	4 Ft. / 3 Curb		
Guardrail Type L/R:	0 None		
Toll Facility Indicator:	0 No Toll		
Latitude:	41.75822653	S Longitude:	87.91591850
Deck Structure Type:	A CIP CON NRMALLY FORM	Inventory Rating:	0.845(30)
Sidewalks Under Structure:	0 None	Operating Rating:	1.415(50)
		Design Load:	93 HL93
		Deck Structure Thickness:	8 SD: N FC: Y
		RR Vertical Underclear:	0 Ft 0 In

		Key Route On Data	
Key Route Nbr:	FEDERAL-AID URBAN	Station:	2684
Appurtenances	Main Route	Segment:	4.2000
Inventory County:	016 COOK	Linked:	Y
Township/Road Dist	16 LYONS	Natl. Hwy System:	Not on NHS
Municipality	0759 BURR RIDGE	Inventory Direction:	
Urban Area:	1051	Curr AADT Yr/Count:	2014 / 19800
Functional Class:	4 MINOR ARTERIAL	Est Truck Percentage:	5
** CLEARANCES **	South/East	Number Of Lanes:	6
Max Rdwy Width:	0.0	One Or Two Way:	2 Two-Way
Horizontal:	98.0	Bypass Length:	4
		Future AADT Yr/Cnt:	2032 / 25647
		Designated Truck Rte:	NONE
Laterals:		Special Systems:	No

		Key Route Under Data	
Key Route Nbr:	FEDERAL-AID INTERSTATE	Station:	0055
Appurtenances	Main Route	Segment:	0.0000
Inventory County:	016 LYONS	Linked:	Y
Township/Road Dist	16 BURR RIDGE	Natl. Hwy System:	On NHS
Municipality	0759 BURR RIDGE	Inventory Direction:	
Urban Area:	1051	Curr AADT Yr/Count:	2013 / 167800
Functional Class:	1 INTERSTATE	Est Truck Percentage:	7
** CLEARANCES **	South/East	Number Of Lanes:	8
Max Rdwy Width:	0.0	One Or Two Way:	2 Two-Way
Horizontal:	66.5	Bypass Length:	0
		Future AADT Yr/Cnt:	2032 / 186327
		Designated Truck Rte:	CLASS I
Laterals:		Special Systems:	Yes

		**** Marked Route On Data ****	
Route #1:	1 Mainline	Designation	Kind
Route #2:	1 Mainline	1 Mainline	8 Other
Route #3:	1 Mainline	1 Mainline	Number

		**** Marked Route Under Data ****	
Route #1:	1 Mainline	Designation	Kind
Route #2:	1 Mainline	1 Mainline	1 Interstate Highway
Route #3:	1 Mainline	1 Mainline	055 Number

Illinois Department of Transportation
Structures Information Management System
Structure Summary Report

Structure Number: 016-0587 District: 1

*** Inspection Intervals ***
Routine NBIS: 24 MOS Underwater: 0 MOS One Truck At A Time: 0 Tons Combination Type 3S-1: Tons Bridge Posting Level: 5 No Posting Required
Special: N Single Unit Vehicles: Tons Combination Type 3S-2: Tons

Data Related to Inspection Information
*** Maximum Allowable Posting Limits ***

Inspection/Appraisal Information
Inspection Date: 10/17/2014 Inspection Temperature: 40Deg. F
Deck: 8 VERY GOOD CONDITION - NO PROBLEMS NOTED
Superstructure: 8 VERY GOOD CONDITION - NO PROBLEMS NOTED
Substructure: 8 VERY GOOD CONDITION - NO PROBLEMS NOTED
Culvert: N NOT APPLICABLE
Channel and Protection: N NOT APPLICABLE
Structural Evaluation: 6 EQUAL TO PRESENT MINIMUM CRITERIA
Deck Geometry: 9 SUPERIOR TO PRESENT DESIRABLE CRITERIA
Underclearance-Vert/Lat.: 3 INTOLERABLE - HIGH PRIORITY FOR CORRECTION
Waterway Adequacy: N NOT APPLICABLE
Approach Roadway Align: 8 EQUAL TO PRESENT DESIRABLE CRITERIA
Bridge Railing Appraisal: 3 Meets Standards
Approach Guardrail: 333 Acceptable
Pier Navig Protection: N N/A

Deck Wearing Surf: A BARE DECK NO OVRLAY
Deck Membrane: F NONE
Deck Protection: A EPOXY COATED REINF
Total Deck Thick: 8.0
Last Paint Date: 07/2014

Single Unit Vehicles: Tons
Combination Type 3S-1: Tons
Combination Type 3S-2: Tons
One Truck At A Time: 0
Last Paint Type: A
LD SHP PRM GRN FNL

*** Actual Posted Limits ***

Underwater Inspection/Appraisal Information

Inspection Date:
Temperature:
Inspection Method:
Appraisal Rating:

Scour Critical Information
Evaluation Method:
Microfilm Data Recorded: Yes

Construction Information
Year: 1959 Original 2014 Reconstructed
Route: FAI-55 Sta: 1086+08.80 FAI 55
Section Nbr: 22-1HB 22-1HB-R
Contract Nbr: 60K77
Fed Aid Pr#: I 0556002272 NHPP-TE-055(00
Built By: 3 COUNTY AGENCY 1 I.D.O.T.

Rating:
Analysis Date:


Pontis

Today's Date: 08/27/2015

Structure Number: 016-0587 District: 1 (41) Bridge Status: 1 OPEN - NO RESTRICT
 (6) Feature Crossed: I- 55 STEVENSON (7) Facility Carried: COUNTY LINE RD
 (9) Location: 2.6 M W US 45 (7A) Bridge Name:
 Element Inspection Date: 10/17/2014
 (90E) Agency Program Manager: WilsonSM (90E3) Consultant Program Manager:
 (90E1) Team Leader: HarringtonCC (90E2) Inspector:

Element Insp. Delinquent		Element Insp. Delinquent Reason:								
Elem	Env	% 1	Qty 1	% 2	Qty 2	% 3	Qty 3	% 4	Qty 4	Tot Qty
Reinforced Conc Column or Pile Extension										
205	4	100	3,048	0	0	0	0	0	0	3,048
		No deterioration	Minor cracks/spalls	Delams/spalls	Analysis warranted					
Remarks: substructure repairs done CN# 60K77 2014										
Reinforced Conc Pier Wall										
210	4	100	3,063	0	0	0	0	0	0	3,063
		No deterioration	Minor cracks/spalls	Delams/spalls	Analysis warranted					
Remarks: substructure repairs done CN# 60K77 2014										
Reinforced Conc Abutment										
215	4	100	1,030	0	0	0	0	0	0	1,030
		No deterioration	Minor cracks/spalls	Delams/spalls	Analysis warranted					
Remarks: north and south abutments removed and replaced now integral abutments CN# 60K77 2014										
Reinforced Conc Pier or Abutment Cap										
234	4	100	562	0	0	0	0	0	0	562
		No deterioration	Minor cracks/spalls	Delams/spalls	Analysis warranted					
Remarks: new integral abutments and substructure repairs done CN# 60K77 2014										
Elastomeric Bearing										
310	4	100	28	0	0	0	0	0	0	28
		No deterioration	Minor deterioration	Major deterioration						
Remarks: elastomeric bearings at pier 1 and 3 CN# 60K77 2014										
Fixed Bearing										
313	4	100	14	0	0	0	0	0	0	14
		No deterioration	Minor deterioration	Advanced corrosion						
Remarks: salvaged bearings from structure used in CN# 60K77 2014										
Concrete Bridge Railing										
331	4	100	652	0	0	0	0	0	0	652
		No deterioration	Minor cracks/spalls	Analysis warranted						
Remarks: new railing CN# 60K77 2014										

Concrete Deck Protected w/ Coated Bars										
8026	4	100	26,939	0	0	0	0	0	0	26,939
Remarks: new deck CN# 60K77 2014										
Non-Lead Painted Steel Open Girder										
8118	4	100	34,645	0	0	0	0	0	0	34,645
Remarks: new super CN# 60K77										
Approach Pavement										
8323	4	0	0	0	0	100	4	0	0	4
Remarks: new approaches CN# 60K77 2014										



October 27, 2015

MEMORANDUM

Mr. John Fortmann, Region One Engineer
Illinois Department of Transportation
Region One/District One

Attn: Steven Schilke

RE: Existing S.N. 016-0724
Central Ave. over I-55
Cook County
PTB 158-002/P-91-762-10

The purpose of this technical memo is to summarize the current condition of existing S.N. 016-0724 in addition to geometrics and other factors. A cursory field check was performed to supplement the information contained in IDOT's structure summary report dated February 04, 2014 (see Appendix B). Broad-based recommendations for this structure are provided below.

The structure is a multiple span steel girder/beam second level interchange bridge consisting of four main spans and eight approach spans (see Photo 1). The superstructure is supported by pile bent abutments and reinforced concrete multi-column piers. There is no overlay on the structure.

IDOT rates the deck as being in excellent condition. The findings from the cursory field check don't match IDOT's deck rating. Minor transverse cracks with leaching are visible on a majority of the main span soffits (see Photo 2). IDOT rates the superstructure as being in excellent condition. The findings from the cursory field check don't match IDOT's superstructure rating. Minor rusting is visible on the top flanges of some girders. IDOT rates the substructure as being in excellent condition. The findings from the cursory field check don't match IDOT's substructure rating. Minor cracking is visible on some pier caps and columns (see Photo 3). No notable defects or differences were observed between the cursory field check and IDOT's structure summary report for: deck geometry, underclearance vert/lat, approach alignment and bridge railing appraisal items.

Based on the structure summary report and field check, S.N. 016-0724 is suitable for reuse without rehabilitation.



LIN ENGINEERING, LTD.
Consulting Engineers

Springfield, IL Westmont, IL

576 Oakmont Lane
Westmont, Illinois 60559
Telephone: (630) 323-5168
Fax: (630) 323-5174
E-mail: info@lineng.com

LIN ENGINEERING, LTD.

A handwritten signature in blue ink that reads "Michael T. Haley". The signature is written in a cursive style.

Michael T. Haley, PE, SE
Structural Manager

Appendix A – Photos

Appendix B – IDOT Structure Summary Report

Appendix C – PONTIS Report



Photo 1



Photo 2



Photo 3

Structure Number: 016-0724 District: 1

Inventory Data

Facility Carried: CENTRAL AVE & RAMPS Bridge Name: SUFFICIENCY RATING: 96.6 Structure Length: 325.9
 Feature Crossed: I-55 STEVENSON Location: 1.1 M SW IL 50 HBP Eligible: No AASHTO Bridge Length: 99.9
 Bridge Remarks: OLD T.L.=5761' ONE BRIDGE, NOW THREE SEPERATE STRUCTURES. 7-27-88. Replaced By: - Length of Long Span: 89.2
 Bridge Status: 1 OPEN - NO RESTRICT Status Date: 05/2014 Replaces: - Bridge Roadway Width: 73.5
 Status Remarks: Last Update Date: 07/05/2012 Appr Roadway Width: 74.0
 Maint County: 016 COOK Maint Township: 56 CICERO (CICERO) Parallel Structure: None Deck Width: 89.0
 Maint Responsibility: 13 I.D.O.T. COUNTY Multi-Level Structure Nbr: None Sidewalk Width Right: 4.5
 Service On/Under: 1 HIGHWAY 1 / HIGHWAY Skew Direction: R Right Sidewalk Width Left: 4.5
 Reporting Agency: 1 I.D.O.T. - BUREAU OF MAINTENANCE Structure Flared: 21 D No Navigation Control: 0 No
 Main Span Matl/Type: 4 STEEL CONTINUOUS / 02 STRINGERMULTI-BEAM/GIRDER Historical Significance: No Navigation Horiz Clear: 0
 Nbr Of Main Spans: 24 Nbr Of Approach Spans: 0 Border Bridge State: No Navigation Vert Clear: 0
 Approaches Bdr State SN: 0 Culvert Fill Depth: 0.0
 Near #1 Matl/Type: / / Bdr State % Responsibility: 0 Number Culvert Cells: 0
 Near #2 Matl/Type: / / Structural Steel Wt: 6476000 Culvert Opening Area: 0.0
 Far #1 Matl/Type: / / Substructure Material: Crossing 1 Nbr: 0.0
 Far #2 Matl/Type: / / Rated By: 2 IDOT Load Rating Date: 07/13/2005 Railroad Crossing Info
 Median Width/Type: 3 Ft. / 3 Curb / 0 None Inventory Rating: 1.355(48) Crossing 1 Nbr: 0.0
 Guardrail Type L/R: 0 None / 0 Operating Rating: 2.090(75) Crossing 1 Nbr: 0.0
 Toll Facility Indicator: 0 No Toll S Longitude: 87.76280000 S Design Load: 01 HS20+MOD RR Lateral Underclear: 0.0
 Latitude: 41.81077000 Deck Structure Thickness: 7 SD: N FO: N RR Vertical Underclear: 0 Ft 0 In
 Deck Structure Type: A CIP CON NRMALLY FORM
 Sidewalks Under Structure: 0 None

Key Route On Data

Key Route Nbr: FEDERAL-AID URBAN Station: 2797 Station: 1.8300
 Appurtenances Main Route Segment: 00000
 Inventory County: 016 COOK Linked: Y
 Township/Road Dist 34 STICKNEY Natl. Hwy System: Not on NHS
 Municipality 5540 STICKNEY Inventory Direction: 2010 FOREST VIEW
 Urban Area: 1051 Curr AADT Yr/Count: 2014 / 29200
 ** CLEARANCES ** South/East North/West Est Truck Percentage: 8
 Functional Class: 4 MINOR ARTERIAL Number Of Lanes: 6
 Max Rdwy Width: 0.0 One Or Two Way: 2 Two-Way
 Horizontal: 83.0 Bypass Length: 2
 Future AADT Yr/Cnt: 2032 / 10094
 Designated Truck Rte: NONE
 Special Systems: No

Key Route Under Data

Main Route Segment: 00000 Station: 0055 Station: 9.2400
 016 STICKNEY Linked: Y
 34 STICKNEY Natl. Hwy System: On NHS
 2010 FOREST VIEW Inventory Direction: 2014 / 128800
 1051 1051 Curr AADT Yr/Count: 2014 / 128800
 1 INTERSTATE North/West Est Truck Percentage: 10
 South/East North/West Number Of Lanes: 6
 36.0 One Or Two Way: 2 Two-Way
 80.5 Bypass Length: 0
 77.5 Future AADT Yr/Cnt: 2032 / 151925
 Designated Truck Rte: CLASS I
 Special Systems: Yes

***** Marked Route On Data *****

Route #1:	Designation	Kind	Number
1	Mainline	8	Other
2:	1 Mainline		
3:	1 Mainline		

***** Marked Route Under Data *****

Route #1:	Designation	Kind	Number
1	Mainline	1	Interstate Highway
2:	1 Mainline		
3:	1 Mainline		

**Illinois Department of Transportation
Structures Information Management System
Structure Summary Report**

Structure Number: 016-0724 District: 1

Data Related to Inspection Information

*** Inspection Intervals ***
 Routine NBIS: 24 MOS Underwater: 0 MOS One Truck At A Time: 0 Combination Type 3S-1: Tons
 Special: N Single Unit Vehicles: Tons Combination Type 3S-2: Tons
 Bridge Posting Level: 5 No Posting Required

Inspection/Appraisal Information

Inspection Date: 02/04/2014 Inspection Temperature: 25Deg. F
 Deck: 9 EXCELLENT CONDITION
 Superstructure: 9 EXCELLENT CONDITION
 Substructure: 9 EXCELLENT CONDITION
 Culvert: N NOT APPLICABLE
 Channel and Protection: N NOT APPLICABLE
 Structural Evaluation: 9 SUPERIOR TO PRESENT DESIRABLE CRITERIA
 Deck Geometry: 4 MINIMUM ADEQUACY TO BE LEFT IN PLACE
 Underclearance-Vert/Lat.: 6 EQUAL TO PRESENT MINIMUM CRITERIA
 Waterway Adequacy: N NOT APPLICABLE
 Approach Roadway Align: 8 EQUAL TO PRESENT DESIRABLE CRITERIA
 Bridge Railing Appraisal: 3 Meets Standards
 Approach Guardrail: N/A N/A
 Pier Navig Protection: N N/A

Deck Wearing Surf: A BARE DECK NO OVRLAY
 Deck Membrane: F NONE
 Deck Protection: A EPOXY COATED REINF
 Total Deck Thick: 8.0
 Last Paint Date: 06/2013

Single Unit Vehicles: Tons
 Combination Type 3S-1: Tons
 Combination Type 3S-2: Tons
 One Truck At A Time: 0
 Last Paint Type: A
 LD SHP PRM GRN FNL

Underwater Inspection/Appraisal Information

Inspection Date:
 Temperature:
 Inspection Method:
 Appraisal Rating:

Scour Critical Information

Rating:
 Analysis Date:
 Evaluation Method:
 Microfilm Data Recorded: Yes

Construction Information

Year: 1964 Original 2012 Reconstructed
 Route: FAI-55 Sta: 615+75.11 FAI 55
 Section Nbr: 207-1011.1CF Sta: 0711.2R & 1011.1BR
 Contract Nbr: 60999
 Fed Aid Pr#: I 0557041280 SCIM-SCBHI-55-
 Built By: 3 COUNTY AGENCY 1 I.D.O.T.

Pontis

Today's Date: 09/03/2015

Structure Number: 016-0724 District: 1 (41) Bridge Status: 1 OPEN - NO RESTRICT
 (6) Feature Crossed: I- 55 STEVENSON (7) Facility Carried: CENTRAL AVE & RAMPS
 (9) Location: 1.1 M SW IL 50 (7A) Bridge Name:
 Element Inspection Date: 02/04/2014
 (90E) Agency Program Manager: AsfourSE (90E3) Consultant Program Manager:
 (90E1) Team Leader: CowleyJ (90E2) Inspector:

Element Insp. Delinquent		Element Insp. Delinquent Reason:								
Element Description										
Elem	Env	% 1	Qty 1	% 2	Qty 2	% 3	Qty 3	% 4	Qty 4	Tot Qty
Reinforced Conc Column or Pile Extension										
205	4	100	14,300	0	0	0	0	0	0	14,300
		No deterioration	Minor cracks/spalls	Delams/spalls	Analysis warranted					
Remarks:										
Reinforced Conc Pier Wall										
210	4	100	19,300	0	0	0	0	0	0	19,300
		No deterioration	Minor cracks/spalls	Delams/spalls	Analysis warranted					
Remarks:										
Reinforced Conc Abutment										
215	4	100	6,893	0	0	0	0	0	0	6,893
		No deterioration	Minor cracks/spalls	Delams/spalls	Analysis warranted					
Remarks:										
Reinforced Conc Pier or Abutment Cap										
234	4	100	1,263	0	0	0	0	0	0	1,263
		No deterioration	Minor cracks/spalls	Delams/spalls	Analysis warranted					
Remarks:										
Strip Seal Expansion Joint										
300	4	100	350	0	0	0	0	0	0	350
		No leakage	Minor leakage	Major leakage						
Remarks: At Abut 1 & Abut 4										
Modular Joints										
303	4	100	186	0	0	0	0	0	0	186
		No deterioration	Minor deterioration	Advanced corrosion	Corrosion is advance					
Remarks: At ramp abuts										
Fixed Bearing										
313	4	100	22	0	0	0	0	0	0	22
		No deterioration	Minor deterioration	Advanced corrosion						
Remarks:										

Pot Bearing										
314	4	100	128	0	0	0	0	0	0	128
		No deterioration	Minor deterioration	Advanced corrosion						
Remarks:										
Concrete Bridge Railing										
331	4	100	1,513	0	0	0	0	0	0	1,513
		No deterioration	Minor cracks/spalls	Analysis warranted						
Remarks:										
Concrete Deck Protected w/ Coated Bars										
8026	4	100	95,149	0	0	0	0	0	0	95,149
Remarks:										
Non-Lead Painted Steel Open Girder										
8118	4	100	200,888	0	0	0	0	0	0	200,888
Remarks:										
Non-Lead Painted Steel Closed Web/Box Girder Ends										
8173	4	100	76	0	0	0	0	0	0	76
Remarks:										
Approach Pavement										
8323	4	100	4	0	0	0	0	0	0	4
Remarks:										



October 27, 2015

MEMORANDUM

Mr. John Fortmann, Region One Engineer
Illinois Department of Transportation
Region One/District One

Attn: Steven Schilke

RE: Existing S.N. 016-0744
Pulaski Rd. over I-55
Cook County
PTB 158-002/P-91-762-10

The purpose of this technical memo is to summarize the current condition of existing S.N. 016-0744 in addition to geometrics and other factors. A cursory field check was performed to supplement the information contained in IDOT's structure summary report dated October 18, 2014 (see Appendix B). Broad-based recommendations for this structure are provided below.

The structure is a multiple span steel girder/beam second level interchange bridge consisting of four main spans and twenty-six approach ramp spans (see Photo 1). The superstructure is supported by stem abutments and reinforced concrete multi-column piers. There is no overlay on the structure.

IDOT rates the deck as being in satisfactory condition, which concurs with the findings from the cursory field check. Transverse cracks are visible on a majority of the main span soffits (see Photo 2). IDOT rates the superstructure as being in fair condition, which concurs with the findings from the cursory field check. Minor paint peeling and rusting is visible on the bottom flanges of interior girders. Moderate paint peeling is visible on webs of exterior girders. IDOT rates the substructure as being in good condition, which concurs with the findings from the cursory field check. Minor cracking is visible on some pier caps and columns (see Photo 3). No notable defects or differences were observed between the cursory field check and IDOT's structure summary report for: deck geometry, underclearance vert/lat, approach alignment, bridge railing appraisal and approach guardrail items. Expansion joints are in poor condition. Joint seals have failed along the majority of the center section of deck (see Photo 4 and 5).

Based on the structure summary report and field check, S.N. 016-0744 is suitable for reuse after rehabilitation of the superstructure and expansion joints. Approach guardrails should be brought up to current IDOT standards.



LIN ENGINEERING, LTD.
Consulting Engineers

Springfield, IL Westmont, IL

576 Oakmont Lane
Westmont, Illinois 60559
Telephone: (630) 323-5168
Fax: (630) 323-5174
E-mail: info@lineng.com

LIN ENGINEERING, LTD.

A handwritten signature in blue ink that reads "Michael T. Haley". The signature is written in a cursive style.

Michael T. Haley, PE, SE
Structural Manager

Appendix A – Photos

Appendix B – IDOT Structure Summary Report

Appendix C – PONTIS Report



Photo 1



Photo 2



Photo 3



Photo 4



Photo 5

**Illinois Department of Transportation
Structures Information Management System
Structure Summary Report**

Structure Number: 016-0744 District: 1

Inventory Data	
Facility Carried:	PULASKI RD & RAMPS
Feature Crossed:	I-55 STEVENSON
Bridge Remarks:	MAX=28.0. APPROACH SPANS ARE THE RAMPS TO/FROM I-55 WHICH ARE INCLUDED HERE.
Bridge Status:	1 OPEN - NO RESTRICT
Status Remarks:	016 COOK
Maint County:	14 I.D.O.T.
Service On/Under:	5 SECOND LEVEL INTERCHANGE
Reporting Agency:	1 I.D.O.T. - BUREAU OF MAINTENANCE
Main Span Matl/Type:	4 STEEL CONTINUOUS
Nbr Of Main Spans:	4 Nbr Of Approach Spans: 26
Approaches	
Near #1 Matl/Type:	4 STEEL CONTINUOUS
Near #2 Matl/Type:	4 STEEL CONTINUOUS
Far #1 Matl/Type:	4 STEEL CONTINUOUS
Far #2 Matl/Type:	4 Fl./3 Curb
Median Width/Type:	0None / 0
Guardrail Type L/R:	0 No Toll
Toll Facility Indicator:	41.82358612 S Longitude: 87.72406731
Latitude:	
Deck Structure Type:	A CIP CON NRMALLY FORM
Sidewalks Under Structure:	0 None

Key Route On Data	
Key Route Nbr:	FEDERAL-AID URBAN 2812 Station: 17.4800
Appurtenances Main Route:	00000
Inventory County:	016 COOK
Township/Road Dist:	86 WEST CHICAGO (CHICAGO) Natl. Hwy System: Not on NHS
Municipality:	1051 CHICAGO
Urban Area:	1051
Functional Class:	4 MINOR ARTERIAL
** CLEARANCES **	South/East North/West
Max Rdwy Width:	0.0 31.0
Horizontal:	31.0
Vertical:	0
Laterals:	0

Key Route Under Data	
FEDERAL-AID INTERSTATE	0055 Station: 11.4100
Main Route	00000
016	SOUTH CHICAGO (CHICAGO)
83	CHICAGO
1051	1051
1	INTERSTATE
South/East	North/West
36.0	75.8
75.8	

Marked Route On Data		
Designation	Kind	Number
1 Mainline	8 Other	
Route #2: 1 Mainline		
Route #3: 1 Mainline		

Marked Route Under Data		
Designation	Kind	Number
1 Mainline	1 Interstate Highway	055
1 Mainline		

Illinois Department of Transportation
Structures Information Management System
Structure Summary Report

Structure Number: 016-0744 District: 1

*** Inspection Intervals ***
Routin e NBIS: 24 MOS Underwater: 0 MOS One Truck At A Time: 0 Tons Combination Type 3S-1: Tons Bridge Posting Level: 5 No Posting Required
Special: N Single Unit Vehicles: Tons Combination Type 3S-2: Tons

Data Related to Inspection Information
*** Maximum Allowable Posting Limits ***

Inspection Date: 10/18/2014 Inspection Temperature: 51Deg. F
Deck: 6 SATISFACTORY CONDITION - MINOR DETERIORATION
Superstructure: 5 FAIR CONDITION - MINOR SECTION LOSS, CRACKS
Substructure: 7 GOOD CONDITION - SOME MINOR PROBLEMS
Culvert: N NOT APPLICABLE
Channel and Protection: N NOT APPLICABLE
Structural Evaluation: 5 BETTER THAN ADEQUATE TO BE LEFT IN PLACE
Deck Geometry: 2 INTOLERABLE - HIGH PRIORITY FOR REPLACEMENT
Underclearance-Vert/Lat.: 6 EQUAL TO PRESENT MINIMUM CRITERIA
Waterway Adequacy: N NOT APPLICABLE
Approach Roadway Align: 8 EQUAL TO PRESENT DESIRABLE CRITERIA
Bridge Railing Appraisal: 3 Meets Standards
Approach Guardrail: 232 Not Acceptable Acceptable Not Acceptable
Pier Navig Protection: N N/A

Deck Wearing Surf: A BARE DECK NO OVRLAY
Deck Membrane: F NONE
Deck Protection: A EPOXY COATED REINF
Total Deck Thick: 7.5
Last Paint Date: 07/1996

Single Unit Vehicles: Tons
Combination Type 3S-1: Tons
Combination Type 3S-2: Tons
One Truck At A Time: 0
Last Paint Type: BJ
LD SHP PRM AL FNL
IRZC/OXIDE ALKYD

*** Actual Posted Limits ***
Underwater Inspection/Appraisal Information

Inspection Date: Inspection Method: Appraisal Rating:

Scour Critical Information
Evaluation Method: Microfilm Data Recorded: Yes

Rating: Analysis Date: Construction Information

Year: 1963 Original 1997 Reconstructed
Route: FAI-55 Sta: FAI-55
Section Nbr: 1213-621-HB Sta: 2829.1HB-R(89)
Contract Nbr: 80712
Fed Aid Pr#: I 0557036282
Built By: 0 UNKNOWN 1 I.D.O.T.

Pontis

Today's Date: 09/03/2015

Structure Number: 016-0744 District: 1 (41) Bridge Status: 1 OPEN - NO RESTRICT
 (6) Feature Crossed: I-55 STEVENSON (7) Facility Carried: PULASKI RD & RAMPS
 (9) Location: 0.92 M S OF 31ST ST (7A) Bridge Name:
 Element Inspection Date: 10/18/2014
 (90E) Agency Program Manager: MastnySC (90E3) Consultant Program Manager:
 (90E1) Team Leader: SedlacekJL (90E2) Inspector:

Element Insp. Delinquent		Element Insp. Delinquent Reason:									
Element Description											
Elem	Env	% 1	Qty 1	% 2	Qty 2	% 3	Qty 3	% 4	Qty 4	Tot Qty	
Reinforced Conc Column or Pile Extension											
205	4	96	14,871	3	456	1	120	0	0	15,447	
		No deterioration	Minor cracks/spalls		Delams/spalls	Analysis warranted					
Remarks: Isolated lt map crcking & leach areas											
Reinforced Conc Pier Wall											
210	4	98	14,847	2	250	0	45	0	0	15,142	
		No deterioration	Minor cracks/spalls		Delams/spalls	Analysis warranted					
Remarks:											
Reinforced Conc Abutment											
215	4	81	1,206	9	130	10	145	0	0	1,481	
		No deterioration	Minor cracks/spalls		Delams/spalls	Analysis warranted					
Remarks: Lt vert crking w/ isolated leaching; backwall lt vert crking w/ isolated leaching											
Reinforced Conc Pier or Abutment Cap											
234	4	93	1,176	5	60	2	26	0	0	1,262	
		No deterioration	Minor cracks/spalls		Delams/spalls	Analysis warranted					
Remarks: Scattered lt vert crcking; map crcking pier cap @ C-1 & C-2											
Pourable Joint Seal											
301	4	0	0	33	140	24	100	43	180	420	
		No deterioration	Minor leakage		Leakage problems						
Remarks: Missing @ median area west side											
Preformed Joint Seal											
302	4	0	0	45	140	39	120	16	50	310	
		No deterioration	Minor deterioration		Major deterioration						
Remarks: Leakage											
Elastomeric Bearing											
310	4	89	217	9	22	2	6	0	0	245	
		No deterioration	Minor deterioration		Major deterioration						
Remarks: Side retainer missing from brgs on E end of 1st pier N of I-55											

Fixed Bearing										
313	4	97	122	2	2	2	2	0	0	126
		No deterioration	Minor deterioration	Advanced corrosion						
Remarks:										
Concrete Bridge Railing										
331	4	92	3,446	4	142	5	174	0	0	3,762
		No deterioration	Minor cracks/spalls	Analysis warranted						
Remarks: Ramp B has collision spalls; scattered vert crking										
Concrete Deck Protected w/ Coated Bars										
8026	4	75	84,781	25	28,268	0	24	0	0	113,073
Remarks: Lt haunch crking; wearing surface transv crcking; median has lg crcking										
Sidewalk (SF)										
8058	4	100	962	0	0	0	0	0	0	962
Remarks:										
Non-Lead Painted Steel Open Girder										
8118	4	95	191,881	5	10,098	0	0	0	0	201,979
Remarks: Minor section loss @ bm ends & diaph under jts; paint failing on btm fl's; paint peeling widespread w/surf rust										
Non-Lead Painted Steel Closed Web/Box Girder Ends										
8173	4	77	230	23	70	0	0	0	0	300
Remarks: Minor section loss (inactive) @ bm ends. Esp. P# C8										
Neoprene Expansion Joint										
8307	4	31	491	22	350	47	734	0	0	1,575
Remarks: Neo block dam & missing @: SB Pulaski longit jt in rt turn ln I-55 to Pulaski; in diag exp jt rt turn ln from SB I-55; rt turn ln from Pulaski to SB I-55										
Approach Pavement										
8323	4	75	3	25	1	0	0	0	0	4
Remarks:										



October 27, 2015

MEMORANDUM

Mr. John Fortmann, Region One Engineer
Illinois Department of Transportation
Region One/District One

Attn: Steven Schilke

RE: Existing S.N. 016-0968
W.B. I-55 over Loomis St. and Fuller St.
Cook County
PTB 158-002/P-91-762-10

The purpose of this technical memo is to summarize the current condition of existing S.N. 016-0968 in addition to geometrics and other factors. A cursory field check was performed to supplement the information contained in IDOT's structure summary report dated September 9, 2015 (see Appendix B). Broad-based recommendations for this structure are provided below.

The structure is a seven span steel beam bridge consisting of nine lines of continuous beams (see Photo 1). Span lengths from west to east are 84'-8", 100'-0", 76'-2", 76'-8", 74'-2", 68'-6" and 55'-3". The superstructure is supported by pile bent abutments and reinforced concrete multi-column piers. There is no overlay on the structure.

IDOT rates the deck as being in good condition, which concurs with the findings from the cursory field check. Transverse cracks with leaching are visible on a majority of the soffit (see Photo 2). IDOT rates the superstructure as being in very good condition, which concurs with the findings from the cursory field check. Possible fire damage to the beam ends is visible above the both abutments (see Photo 3). IDOT rates the substructure as being in very good condition, which concurs with the findings from the cursory field check. Minor vertical cracks are visible on the abutments. Map cracking is visible on several pier columns (see Photo 4). No notable defects or differences were observed between the cursory field check and IDOT's structure summary report for: deck geometry, underclearance ver/lat, approach alignment and bridge railing appraisal items. Anchor blocks are damaged along sections of the west expansion joint. Minor transverse cracks, diagonal cracks, and small spalls adjacent to the expansion joints are visible on both approach slabs (see Photo 5).

Based on the structure summary report and field check, S.N. 016-0968 is suitable for reuse after rehabilitation of the expansion joints.



LIN ENGINEERING, LTD.
Consulting Engineers

Springfield, IL Westmont, IL

576 Oakmont Lane
Westmont, Illinois 60559
Telephone: (630) 323-5168
Fax: (630) 323-5174
E-mail: info@lineng.com

LIN ENGINEERING, LTD.

A handwritten signature in blue ink that reads "Michael T. Haley". The signature is written in a cursive, flowing style.

Michael T. Haley, PE, SE
Structural Manager

Appendix A – Photos

Appendix B – IDOT Structure Summary Report

Appendix C – PONTIS Report



Photo 1



Photo 2



Photo 3



Photo 4



Photo 5

**Illinois Department of Transportation
Structures Information Management System
Structure Summary Report**

Structure Number: 016-0968 District: 1

Inventory Data																										
Facility Carried: I-55 WB STEVENSON	Bridge Name: LOOMIS & FULLER STS																									
Feature Crossed: LOOMIS & FULLER STS	Location: 0.9 M SW I-94																									
Bridge Remarks: 1 OPEN - NO RESTRICT	Status Date: 12/2000																									
Status Remarks: 016 COOK	Maint Township: 83 SOUTH CHICAGO																									
Maint Responsibility: 01 I.D.O.T.																										
Service On/Under: 1 HIGHWAY	1 / HIGHWAY																									
Reporting Agency: 1 I.D.O.T. - BUREAU OF MAINTENANCE																										
Main Span Matl/Type: 4 STEEL CONTINUOUS	/ 02 STRINGERMULTI-BEAM/GIRDER																									
Nbr Of Main Spans: 7	Nbr Of Approach Spans: 0																									
Approaches																										
Near #1 Matl/Type:	/																									
Near #2 Matl/Type:	/																									
Far #1 Matl/Type:	/																									
Far #2 Matl/Type:	/																									
Median Width/Type:	0 Ft. / 0 None																									
Guardrail Type L/R:	0 None / 1																									
Toll Facility Indicator:	0 No Toll																									
Latitude:	41.84221757 S Longitude: 87.65827977 S																									
Deck Structure Type:	A CIP CON NRMLLY FORM																									
Sidewalks Under Structure:	2 Both Sides Not Separate																									
<table border="0"> <tr> <td>Inventory Rating:</td> <td>1.570(56)</td> <td>Load Rating Date:</td> <td>04/27/2001</td> <td>Railroad Crossing Info</td> </tr> <tr> <td>Operating Rating:</td> <td>2.615(94)</td> <td>Design Load:</td> <td>01 HS20+MOD</td> <td>Crossing 1 Nbr:</td> </tr> <tr> <td>Deck Structure Thickness:</td> <td>7.5 SD: N</td> <td>FO: N</td> <td>RR Lateral Underclear:</td> <td>0</td> </tr> <tr> <td></td> <td></td> <td></td> <td>RR Vertical Underclear:</td> <td>0</td> </tr> <tr> <td></td> <td></td> <td></td> <td></td> <td>Ft 0 In</td> </tr>

Key Route On Data			
Key Route Nbr:	FEDERAL-AID INTERSTATE 0055	Station:	15.1400
Appurtenances	Main Route 00000	Segment:	00000
Inventory County:	016 COOK	Linked:	Y
Township/Road Dist	83 SOUTH CHICAGO (CHICAGO)	Natl. Hwy System:	On NHS
Municipality	1051 CHICAGO	Inventory Direction:	
Urban Area:	1051	Curr AADT Yr/Count:	2014 / 77650
Functional Class:	1 INTERSTATE	Est Truck Percentage:	7
** CLEARANCES **	South/East	Number Of Lanes:	3
Max Rdwy Width:	68.9	One Or Two Way:	1 One-Way
Horizontal:	68.9	Bypass Length:	0
		Future AADT Yr/Cnt:	2032 / 87087
Vertical:		Designated Truck Rte:	CLASS I
Special Systems:	Yes		

Key Route Under Data			
Key Route Nbr:	FEDERAL-AID URBAN 2862	Station:	1.5000
Appurtenances	Main Route 00000	Segment:	00000
Inventory County:	016 COOK	Linked:	Y
Township/Road Dist	83 SOUTH CHICAGO (CHICAGO)	Natl. Hwy System:	Not on NHS
Municipality	1051 CHICAGO	Inventory Direction:	
Urban Area:	1051	Curr AADT Yr/Count:	2014 / 6600
Functional Class:	5 MAJOR COLLECTOR	Est Truck Percentage:	4
** CLEARANCES **	South/East	Number Of Lanes:	6
Max Rdwy Width:	65.4	One Or Two Way:	2 Two-Way
Horizontal:	65.4	Bypass Length:	0
		Future AADT Yr/Cnt:	2032 / 6798
Vertical:		Designated Truck Rte:	NONE
Special Systems:	No		

Marked Route On Data ***					
Route #1:	1 Mainline	Designation	8 Other	Number	055
Route #2:	1 Mainline				
Route #3:	1 Mainline				

**Illinois Department of Transportation
Structures Information Management System
Structure Summary Report**

Structure Number: 016-0968 District: 1

Data Related to Inspection Information

*** Inspection Intervals ***
 Routine NBIS: 24 MOS Underwater: 0 MOS One Truck At A Time: 0 Tons Combination Type 3S-1: Tons
 Special: N Single Unit Vehicles: Tons Combination Type 3S-2: Tons
 Bridge Posting Level: 5 No Posting Required

Inspection/Appraisal Information

Inspection Date: 09/09/2015 Inspection Temperature: 80Deg. F
 Deck: 7 GOOD CONDITION - SOME MINOR PROBLEMS
 Superstructure: 8 VERY GOOD CONDITION - NO PROBLEMS NOTED
 Substructure: 8 VERY GOOD CONDITION - NO PROBLEMS NOTED
 Culvert: N NOT APPLICABLE
 Channel and Protection: N NOT APPLICABLE
 Structural Evaluation: 8 EQUAL TO PRESENT DESIRABLE CRITERIA
 Deck Geometry: 9 SUPERIOR TO PRESENT DESIRABLE CRITERIA
 Underclearance-Vert/Lat.: 9 SUPERIOR TO PRESENT DESIRABLE CRITERIA
 Waterway Adequacy: N NOT APPLICABLE
 Approach Roadway Align: 8 EQUAL TO PRESENT DESIRABLE CRITERIA
 Bridge Railing Appraisal: 3 Meets Standards
 Approach Guardrail: N/A N/A
 Pier Navig Protection: N N/A

Deck Wearing Surf: A BARE DECK NO OVRLAY
 Deck Membrane: F NONE
 Deck Protection: A EPOXY COATED REINF
 Total Deck Thick: 7.5
 Last Paint Date: 08/2001
 One Truck At A Time: 0
 Last Paint Type: S
 SHP ZINC&FLD ACRYL

Underwater Inspection/Appraisal Information

Inspection Date:
 Temperature:
 Inspection Method:
 Appraisal Rating:

Scour Critical Information

Rating:
 Analysis Date:
 Evaluation Method:
 Microfilm Data Recorded: Yes

Construction Information

Year: 1964 Original 2000 Reconstructed
 Route: FAI-55 Sta: 207+40.87 FAI 55
 Section Nbr: 207-1616.8 (1616(.4&.6)R-1ETC&1717.6
 Contract Nbr: 82992
 Fed Aid Pr#: EAC10557107286
 Built By: 1 I.D.O.T. 1 I.D.O.T.

Pontis

Today's Date: 10/08/2015

Structure Number: 016-0968 District: 1 (41) Bridge Status: 1 OPEN - NO RESTRICT
 (6) Feature Crossed: LOOMIS & FULLER STS (7) Facility Carried: I-55 WB STEVENSON
 (9) Location: 0.9 M SW I-94 (7A) Bridge Name:
 Element Inspection Date: 09/09/2015
 (90E) Agency Program Manager: MastnySC (90E3) Consultant Program Manager:
 (90E1) Team Leader: AbudanJ (90E2) Inspector:

Element Insp. Delinquent		N		Element Insp. Delinquent Reason:						
Element Description										
Elem	Env	% 1	Qty 1	% 2	Qty 2	% 3	Qty 3	% 4	Qty 4	Tot Qty
Reinforced Conc Column or Pile Extension										
205	4	100	4,799	0	0	0	0	0	0	4,799
			No deterioration	Minor cracks/spalls	Delams/spalls	Analysis warranted				
Remarks:										
Reinforced Conc Pier Wall										
210	4	100	6,175	0	0	0	0	0	0	6,175
			No deterioration	Minor cracks/spalls	Delams/spalls	Analysis warranted				
Remarks:										
Reinforced Conc Abutment										
215	4	100	797	0	0	0	0	0	0	797
			No deterioration	Minor cracks/spalls	Delams/spalls	Analysis warranted				
Remarks: Backwall)HL vert crks										
Reinforced Conc Pier or Abutment Cap										
234	4	100	690	0	0	0	0	0	0	690
			No deterioration	Minor cracks/spalls	Delams/spalls	Analysis warranted				
Remarks:										
Elastomeric Bearing										
310	4	100	63	0	0	0	0	0	0	63
			No deterioration	Minor deterioration	Major deterioration					
Remarks:										
Fixed Bearing										
313	4	100	9	0	0	0	0	0	0	9
			No deterioration	Minor deterioration	Advanced corrosion					
Remarks:										
Concrete Bridge Railing										
331	4	100	1,084	0	0	0	0	0	0	1,084
			No deterioration	Minor cracks/spalls	Analysis warranted					
Remarks: HL vert crks										

Concrete Deck Protected w/ Coated Bars										
8026	4	94	36,651	6	2,450	0	0	0	0	39,101
Remarks: Soffit) trans leach crcking; WS)HL-Nar trans crks w/isol intersecting long crks.										
Non-Lead Painted Steel Open Girder										
8118	4	100	47,907	0	0	0	0	0	0	47,907
Remarks:										
Non-Lead Painted Steel Open Girder Ends										
8176	4	100	18	0	0	0	0	0	0	18
Remarks: Homeless Fire Residue @ W Abut										
Continuous Seal Neoprene Expansion Joint										
8308	4	100	175	0	0	0	0	0	0	175
Remarks: Leaking @ Both Abuts										
Approach Pavement										
8323	4	100	2	0	0	0	0	0	0	2
Remarks: Random crks; Diag @ W Abut										



October 27, 2015

MEMORANDUM

Mr. John Fortmann, Region One Engineer
Illinois Department of Transportation
Region One/District One

Attn: Steven Schilke

RE: Existing S.N. 016-1009
Damen Ave. over I-55
Cook County
PTB 158-002/P-91-762-10

The purpose of this technical memo is to summarize the current condition of existing S.N. 016-1009 in addition to geometrics and other factors. A cursory field check was performed to supplement the information contained in IDOT's structure summary report dated July 18, 2015 (see Appendix B). Broad-based recommendations for this structure are provided below.

The structure is a multiple span steel girder/beam second level interchange bridge consisting of four main spans and forty-four approach ramp spans (see Photo 1). The superstructure is supported by pile bent abutments and reinforced concrete hammerhead piers. There is no overlay on the structure.

IDOT rates the deck as being in good condition. The findings from the cursory field check don't match IDOT's deck rating. Transverse cracks are visible on a majority of the main span soffits. Map cracking is visible on a majority of the main span section of deck (see Photo 2). IDOT rates the substructure as being in good condition, which concurs with the findings from the cursory field check. Minor cracking is visible on the cantilever arms of some hammerhead piers (see Photo 3). No notable defects or differences were observed between the cursory field check and IDOT's structure summary report for: superstructure, deck geometry, underclearance vert/lat, approach alignment, bridge railing appraisal and approach guardrail items. Impact damage is visible along a few sections of concrete bridge parapet (see Photo 4).

Based on the structure summary report and field check, S.N. 016-1009 is suitable for reuse after rehabilitation of the bridge parapet and expansion joints.



LIN ENGINEERING, LTD.
Consulting Engineers

Springfield, IL Westmont, IL

576 Oakmont Lane
Westmont, Illinois 60559
Telephone: (630) 323-5168
Fax: (630) 323-5174
E-mail: info@lineng.com

LIN ENGINEERING, LTD.

A handwritten signature in blue ink that reads "Michael T. Haley". The signature is written in a cursive, flowing style.

Michael T. Haley, PE, SE
Structural Manager

Appendix A – Photos

Appendix B – IDOT Structure Summary Report

Appendix C – PONTIS Report



Photo 1



Photo 2



Photo 3



Photo 4

**Illinois Department of Transportation
Structures Information Management System
Structure Summary Report**

Structure Number: 016-1009 District: 1

		Inventory Data	
Facility Carried:	DAMEN AVE & 4 RAMPS	Bridge Name:	
Feature Crossed:	I-55 STEVENSON	Location:	1.9 M SW I-90,94
Bridge Remarks:	ITEMS 46 & 49 INCLUDES RAMPS.	Status Date:	05/2001
Bridge Status:	1 OPEN - NO RESTRICT	Maint Township:	83 SOUTH CHICAGO
Status Remarks:		Municipality:	
Maint County:	016 COOK	Service On/Under:	1 / HIGHWAY
Maint Responsibility:	14 I.D.O.T.	Reporting Agency:	1 I.D.O.T. - BUREAU OF MAINTENANCE
Main Span Matl/Type:	4 STEEL CONTINUOUS	Nbr Of Main Spans:	4
Nbr Of Main Spans:	4	Nbr Of Approach Spans:	44
Approaches			
Near #1 Matl/Type:	4 STEEL CONTINUOUS		
Near #2 Matl/Type:	4 STEEL CONTINUOUS		
Far #1 Matl/Type:	4 STEEL CONTINUOUS		
Far #2 Matl/Type:	4 STEEL CONTINUOUS		
Median Width/Type:	4 Ft. / 3 Curb		
Guardrail Type L/R:	0 None / 0		
Toll Facility Indicator:	0 No Toll		
Latitude:	41.83729004	S Longitude:	87.67545092
Deck Structure Type:	A CIP CON NRMALLY FORM		
Sidewalks Under Structure:	0 None		

		Key Route On Data	
Key Route Nbr:	FEDERAL-AID URBAN	Station:	2850
Appurtenances Main Route	00000	Segment:	10.0100
Inventory County:	016 COOK	Linked:	Y
Township/Road Dist	83 SOUTH CHICAGO (CHICAGO)	Natl. Hwy System:	On NHS
Municipality	1051 CHICAGO	Inventory Direction:	
Urban Area:	1051	Curr AADT Yr/Count:	2014 / 24100
Functional Class:	5 MAJOR COLLECTOR	Est Truck Percentage:	15
** CLEARANCES **	South/East	Number Of Lanes:	6
Max Rdwy Width:	0.0	One Or Two Way:	2 Two-Way
Horizontal:	44.0	Bypass Length:	0
		Future AADT Yr/Cnt:	2032 / 15759
		Designated Truck Rte:	NONE
Laterals:		Special Systems:	No

		Key Route Under Data	
Key Route Nbr:	FEDERAL-AID INTERSTATE	Station:	0055
Main Route	00000	Segment:	14.2600
016		Linked:	Y
83	SOUTH CHICAGO (CHICAGO)	Natl. Hwy System:	On NHS
1051	CHICAGO	Inventory Direction:	
1051	1051	Curr AADT Yr/Count:	2014 / 129700
1	INTERSTATE	Est Truck Percentage:	8
South/East	North/West	Number Of Lanes:	9
36.0		One Or Two Way:	2 Two-Way
54.0		Bypass Length:	0
		Future AADT Yr/Cnt:	2032 / 169641
		Designated Truck Rte:	CLASS I
		Special Systems:	Yes

		**** Marked Route On Data ****	
Designation	Kind	Number	
1 Mainline	8 Other		
1 Mainline			
1 Mainline			

		**** Marked Route Under Data ****	
Designation	Kind	Number	
1 Mainline	1 Interstate Highway	055	
1 Mainline			
1 Mainline			

**Illinois Department of Transportation
Structures Information Management System
Structure Summary Report**

Structure Number: 016-1009 District: 1

Data Related to Inspection Information

*** Inspection Intervals ***
 Routine NBIS: 24 MOS Underwater: 0 MOS One Truck At A Time: 0 Tons Combination Type 3S-1: Tons Bridge Posting Level:
 Special: N Single Unit Vehicles: Tons Combination Type 3S-2: Tons 5 No Posting Required

Inspection/Appraisal Information

Inspection Date: 07/18/2015 Inspection Temperature: 82Deg. F
 Deck: 7 GOOD CONDITION - SOME MINOR PROBLEMS
 Superstructure: 8 VERY GOOD CONDITION - NO PROBLEMS NOTED
 Substructure: 7 GOOD CONDITION - SOME MINOR PROBLEMS
 Culvert: N NOT APPLICABLE
 Channel and Protection: N NOT APPLICABLE
 Structural Evaluation: 7 BETTER THAN PRESENT MINIMUM CRITERIA
 Deck Geometry: 7 BETTER THAN PRESENT MINIMUM CRITERIA
 Underclearance-Vert/Lat.: 6 EQUAL TO PRESENT MINIMUM CRITERIA
 Waterway Adequacy: N NOT APPLICABLE
 Approach Roadway Align: 8 EQUAL TO PRESENT DESIRABLE CRITERIA
 Bridge Railing Appraisal: 3 Meets Standards
 Approach Guardrail: 333 Acceptable
 Pier Navig Protection: N N/A

Deck Wearing Surf: A BARE DECK NO OVRLAY
 Deck Membrane: F NONE
 Deck Protection: A EPOXY COATED REINF
 Total Deck Thick: 7.5
 Last Paint Date: 05/2001

Underwater Inspection/Appraisal Information

Inspection Date:
 Temperature:
 Inspection Method:
 Appraisal Rating:

Scour Critical Information

Rating:
 Analysis Date:
 Evaluation Method:
 Microfilm Data Recorded: Yes

Construction Information

Year: 1963 Original 2000 Reconstructed
 Route: FAI-55 Sta: 156+36.1 FAI 55
 Section Nbr: 207-1515.2
 Contract Nbr: 1515(2,4)JR-1&(1516.2&1616
 Fed Aid Pr#: I 0557111285 82990
 Built By: 3 COUNTY AGENCY 1 I.D.O.T.

Pontis

Today's Date: 09/03/2015

Structure Number: 016-1009 District: 1 (41) Bridge Status: 1 OPEN - NO RESTRICT
 (6) Feature Crossed: I- 55 STEVENSON (7) Facility Carried: DAMEN AVE & 4 RAMPS
 (9) Location: 1.9 M SW I-90,94 (7A) Bridge Name:
 Element Inspection Date: 07/18/2015
 (90E) Agency Program Manager: AsfourSE (90E3) Consultant Program Manager:
 (90E1) Team Leader: SalaymehTA (90E2) Inspector:

Element Insp. Delinquent		Element Insp. Delinquent Reason:									
Elem	Env	% 1	Qty 1	% 2	Qty 2	% 3	Qty 3	% 4	Qty 4	Tot Qty	
Reinforced Conc Column or Pile Extension											
205	4	100	8,337	0	0	0	0	0	0	8,337	
		No deterioration	Minor cracks/spalls	Delams/spalls	Analysis warranted						
Remarks:											
Reinforced Conc Pier Wall											
210	4	100	47,814	0	0	0	0	0	0	47,814	
		No deterioration	Minor cracks/spalls	Delams/spalls	Analysis warranted						
Remarks:											
Reinforced Conc Abutment											
215	4	100	263	0	0	0	0	0	0	263	
		No deterioration	Minor cracks/spalls	Delams/spalls	Analysis warranted						
Remarks: Ramps 1&2											
Reinforced Conc Pier or Abutment Cap											
234	4	99	2,002	1	20	0	0	0	0	2,022	
		No deterioration	Minor cracks/spalls	Delams/spalls	Analysis warranted						
Remarks: LT cantilever crking Piers 9N & 8S											
Strip Seal Expansion Joint											
300	4	0	0	100	208	0	0	0	0	208	
		No leakage	Minor leakage	Major leakage							
Remarks: minor defect and minor leakage											
Modular Joints											
303	4	100	326	0	0	0	0	0	0	326	
		No deterioration	Minor deterioration	Advanced corrosion	Corrosion is advance						
Remarks:											
Elastomeric Bearing											
310	4	0	0	100	177	0	0	0	0	177	
		No deterioration	Minor deterioration	Major deterioration							
Remarks: minor deterioration											

Fixed Bearing										
313	4	0	0	100	46	0	0	0	0	46
		No deterioration		Minor deterioration	Advanced corrosion					
Remarks: minor surface rust										
Pot Bearing										
314	4	0	0	100	108	0	0	0	0	108
		No deterioration		Minor deterioration	Advanced corrosion					
Remarks: minor deterioration										
Concrete Bridge Railing										
331	4	0	0	98	7,072	2	120	0	0	7,192
		No deterioration		Minor cracks/spalls	Analysis warranted					
Remarks: HL Vert Crks throughout w/few map cracked areas										
Concrete Deck Protected w/ Coated Bars										
8026	4	99	192,433	1	2,080	0	0	0	0	194,513
Remarks: Lt trans leach crking										
Non-Lead Painted Steel Open Girder										
8118	4	100	315,946	0	500	0	0	0	0	316,446
Remarks: Bms 1 & 2 top of btm fl Bay 1 side paint peeling										
Non-Lead Painted Steel Floor Beam										
8129	4	100	10,824	0	0	0	0	0	0	10,824
Remarks:										
Non-Lead Painted Steel Closed Web/Box Girder Ends										
8173	4	100	111	0	0	0	0	0	0	111
Remarks:										
Continuous Seal Neoprene Expansion Joint										
8308	4	84	54	16	10	0	0	0	0	64
Remarks: Lt plow damage to hold-downs on West Ramps										
Approach Pavement										
8323	4	100	2	0	0	0	0	0	0	2
Remarks: Ramps 1&2										



November 6, 2015

MEMORANDUM

Mr. John Fortmann, Region One Engineer
Illinois Department of Transportation
Region One/District One

Attn: Steven Schilke

RE: Existing S.N. 016-1046
E.B. I-55 Ramp to S.B. I-94/E.B. I-90
Cook County
PTB 158-002/P-91-762-10

The purpose of this technical memo is to summarize the current condition of existing S.N. 016-1046 in addition to geometrics and other factors. A cursory field check was performed to supplement the information contained in IDOT's structure summary report dated July 24, 2015 (see Appendix B). Broad-based recommendations for this structure are provided below.

The structure is a fourteen span continuous steel girder bridge totaling 1,625.4 ft. in length (see Photo 1). The superstructure is supported by a stem abutment, reinforced concrete hammerhead and multi-column piers. There is no overlay on the structure.

We were unable to gain access to view the top of deck and approaches. IDOT rates the deck as being in satisfactory condition, which concurs with the findings from the cursory field check. Transverse cracks with leaching are visible on the majority of the soffit. Longitudinal cracks with leaching are visible on some spans (see Photo 2). IDOT rates the superstructure as being in good condition, which concurs with the findings from the cursory field check. Minor to moderate paint peeling and rusting is visible on some beams (see Photo 3). IDOT rates the substructure as being in satisfactory condition, which concurs with the findings from the cursory field check. Moderate cracking is visible on the abutment and piers (see Photo 4). IDOT rates the underclearance vertical and lateral as being not applicable. The findings from the cursory field check don't match IDOT's underclearance vertical and lateral rating. This ramp goes over the E.B. I-55 Ramp to N.B. I-94/W.B. I-90. The clearance appears to be adequate. No notable defects or differences were observed between the cursory field check and IDOT's structure summary report for: deck geometry, approach alignment and bridge railing appraisal items.

Based on the structure summary report and field check, S.N. 016-1046 is suitable for reuse after rehabilitation of the substructure. Sand module impact attenuators should be brought up to current IDOT standards.



LIN ENGINEERING, LTD.
Consulting Engineers

Springfield, IL Westmont, IL

576 Oakmont Lane
Westmont, Illinois 60559
Telephone: (630) 323-5168
Fax: (630) 323-5174
E-mail: info@lineng.com

LIN ENGINEERING, LTD.

A handwritten signature in blue ink that reads "Michael T. Haley". The signature is written in a cursive, flowing style.

Michael T. Haley, PE, SE
Structural Manager

Appendix A – Photos

Appendix B – IDOT Structure Summary Report

Appendix C – PONTIS Report



Photo 1



Photo 2



Photo 3



Photo 4

**Illinois Department of Transportation
Structures Information Management System
Structure Summary Report**

Structure Number: 016-1046 District: 1

Facility Carried: I-55 EB RMP RYAN SB	Bridge Name: 55 EB RMP TO SB RYAN	Sufficiency Rating: 96.6	Structure Length: 1625.4
Feature Crossed: DRY LAND	Location: AT I-94	HBP Eligible: No	AASHTO Bridge Length: 99.9
Bridge Remarks:		Replaces By:	Length of Long Span: 135.9
Bridge Status: 1 OPEN - NO RESTRICT	Status Date: 03/1998	Last Update Date: 10/31/2013	Bridge Roadway Width: 26.0
Status Remarks: AS PER EFK, 03/10/98		Parallel Structure: None	App Roadway Width: 26.0
Maint County: 016 COOK	Maint Township: 83 SOUTH CHICAGO	Multi-Level Structure Nbr:	Deck Width: 29.2
Maint Responsibility: 01 I.D.O.T.		Skew Direction: L	Sidewalk Width Right: 0.0
Service On/Under: 1 HIGHWAY	Other: 9 / OTHER	Navigation Control: D	Sidewalk Width Left: 0.0
Reporting Agency: 1 I.D.O.T. - BUREAU OF MAINTENANCE		Structure Flared: No	Navigation Horiz Clear: N/A
Main Span Matl/Type: 4 STEEL CONTINUOUS	Stringer: 02 STRINGERMULTI-BEAM/GIRDER	Historical Significance: No	Navigation Vert Clear: 0
Nbr Of Main Spans: 17	Nbr Of Approach Spans: 0	Border Bridge State: No	Culvert Fill Depth: 0.0
Approaches		Bdr State SN:	Number Culvert Cells: 0
Near #1 Matl/Type:		Bdr State % Responsibility:	Culvert Opening Area: 0.0
Near #2 Matl/Type:		Structural Steel Wt: 1100000	Culvert Cell Height: 0.00
Far #1 Matl/Type:		Substructure Material:	Culvert Cell Width: 0.00
Far #2 Matl/Type:			
Median Width/Type:		Rated By: 2 IDOT	Rate Method: 6
Guardrail Type L/R: 0 None / 0		Inventory Rating: 1.570(56)	Load Rating Date: 11/16/1998
Toll Facility Indicator: 0 No Toll		Operating Rating: 2.620(94)	Crossing 1 Nbr:
Latitude: 41.84643183	S Longitude: 87.64303156	Design Load: 02 HS20	Crossing 1 Nbr:
Deck Structure Type: A CIP CON NRMALLY FORM		Deck Structure Thickness: 9 SD: N	RR Lateral Underclear: 0.0
Sidewalks Under Structure: 0 None			RR Vertical Underclear: 0 Ft 0 In

Key Route On Data

Key Route Nbr: FEDERAL-AID INTERSTATE	Station: 0094	Segment: 0.2300
Appurtenances: Ramp	Inventory County: 016 COOK	Linked: Y
Township/Road Dist: 83 SOUTH CHICAGO (CHICAGO)	Natl. Hwy System: On NHS	
Municipality: 1051 CHICAGO	Inventory Direction:	
Urban Area: 1051	Curr AADT Yr/Count: 2000 / 14500	
Functional Class: 1 INTERSTATE	Est Truck Percentage: 0	
** CLEARANCES **	Number Of Lanes: 1	
Max Rdwy Width: 26.0	One Or Two Way: 1 One-Way	
Horizontal: 26.0	Bypass Length: 3	
	Future AADT Yr/Cnt: 2032 / 14944	
	Designated Truck Rte: NONE	
Lateral:	Special Systems: No	

Key Route Under Data

Station:	
Segment:	
Linked:	
Natl. Hwy System:	
Inventory Direction:	/
Curr AADT Yr/Count:	
Est Truck Percentage:	
Number Of Lanes:	
One Or Two Way:	
Bypass Length:	
Future AADT Yr/Cnt:	/
Designated Truck Rte:	
Special Systems:	

***** Marked Route On Data *****

Designation	Kind	Number
1 Mainline	1 Interstate Highway	
1 Mainline		
1 Mainline		

***** Marked Route Under Data *****

Designation	Kind	Number
--------------------	-------------	---------------

Illinois Department of Transportation
Structures Information Management System
Structure Summary Report

Structure Number: 016-1046 District: 1

Data Related to Inspection Information

*** Inspection Intervals ***
 Routine NBIS: 24 MOS Underwater: 0 MOS One Truck At A Time: 0 Tons
 Special: N Single Unit Vehicles: Tons Combination Type 3S-1: Tons
 Bridge Posting Level: 5 No Posting Required

Inspection/Appraisal Information

Inspection Date: 07/24/2015 Inspection Temperature: 75Deg. F
 Deck: SATISFACTORY CONDITION - MINOR DETERIORATION
 Superstructure: GOOD CONDITION - SOME MINOR PROBLEMS
 Substructure: SATISFACTORY CONDITION - MINOR DETERIORATION
 Culvert: NOT APPLICABLE
 Channel and Protection: NOT APPLICABLE
 Structural Evaluation: EQUAL TO PRESENT MINIMUM CRITERIA
 Deck Geometry: EQUAL TO PRESENT DESIRABLE CRITERIA
 Underclearance-Vert/Lat.: NOT APPLICABLE
 Waterway Adequacy: NOT APPLICABLE
 Approach Roadway Align: EQUAL TO PRESENT DESIRABLE CRITERIA
 Bridge Railing Appraisal: Meets Standards
 Approach Guardrail: N/A
 Pier Navig Protection: N/A

*** Maximum Allowable Posting Limits ***
 Single Unit Vehicles: Tons
 Combination Type 3S-1: Tons
 Combination Type 3S-2: Tons
 One Truck At A Time: 0
 Deck Wearing Surf: A BARE DECK NO OVRLAY
 Deck Membrane: F NONE
 Deck Protection: A EPOXY COATED REINF
 Total Deck Thick: 9.0
 Last Paint Date: 08/2013

Underwater Inspection/Appraisal Information

Inspection Date:
 Temperature:
 Inspection Method:
 Appraisal Rating:

Scour Critical Information

Rating:
 Analysis Date:
 Evaluation Method:
 Microfilm Data Recorded: Yes

Construction Information

Year: 1964 Original 1997 Reconstructed
 Route: FAI-55 Sta: 21+19 FAI55 Sta: 20+535.399
 Section Nbr: 1717.6-1P SW-1717.6-1P
 Contract Nbr: 82449
 Fed Aid Pr#: I 0557049287 ACNH-55-7(193
 Built By: 4 CITY 1 I.D.O.T.

Pontis

Today's Date: 11/05/2015

Structure Number: 016-1046 District: 1 (41) Bridge Status: 1 OPEN - NO RESTRICT
 (6) Feature Crossed: DRY LAND (7) Facility Carried: I- 55 EB RMP RYAN SB
 (9) Location: AT I-94 (7A) Bridge Name: 55 EB RMP TO SB RYAN
 Element Inspection Date: 07/24/2015
 (90E) Agency Program Manager: WilsonSM (90E3) Consultant Program Manager:
 (90E1) Team Leader: MastnySC (90E2) Inspector:

Element Insp. Delinquent 0 Element Insp. Delinquent Reason:

Element Description										
Elem	Env	% 1	Qty 1	% 2	Qty 2	% 3	Qty 3	% 4	Qty 4	Tot Qty
Lead Painted Steel Open Girder										
107	4	100	9,545	0	0	0	0	0	0	9,545
			No corrosion	Paint distress	Rust formation	Section loss	Section failure			
Remarks: Bm Ends & Fascias Painted. Spans 15-17 have moderate rust w/paint peels throughout (worst @ N Fascia)										
Reinforced Conc Column or Pile Extension										
205	4	100	8,503	0	0	0	12	0	0	8,515
			No deterioration	Minor cracks/spalls	Delams/spalls	Analysis warranted				
Remarks: Piers 51-53 (older) have few med vert crks w/isol HPs & shallow rebar spalls										
Reinforced Conc Pier Wall										
210	4	100	1,720	0	0	0	0	0	0	1,720
			No deterioration	Minor cracks/spalls	Delams/spalls	Analysis warranted				
Remarks:										
Reinforced Conc Abutment										
215	4	100	620	0	0	0	0	0	0	620
			No deterioration	Minor cracks/spalls	Delams/spalls	Analysis warranted				
Remarks: Backwall and stem have few HL vert crks										
Reinforced Conc Pier or Abutment Cap										
234	4	100	476	0	0	0	0	0	0	476
			No deterioration	Minor cracks/spalls	Delams/spalls	Analysis warranted				
Remarks: Piers 51-53 (older) have map crking & delams to underside of cap & few isol shallow rebar spalls										
Strip Seal Expansion Joint										
300	4	0	0	100	78	0	0	0	0	78
			No leakage	Minor leakage	Major leakage					
Remarks: @Pier 57, P53, P5										
Modular Joints										
303	4	100	58	0	0	0	0	0	0	58
			No deterioration	Minor deterioration	Advanced corrosion	Corrosion is advance				
Remarks: @West Abut, P62										

Elastomeric Bearing										
310	4	0	0	100	30	0	0	0	0	30
		No deterioration	Minor deterioration		Major deterioration					
Remarks:										
Fixed Bearing										
313	4	0	0	100	35	0	0	0	0	35
		No deterioration	Minor deterioration		Advanced corrosion					
Remarks:										
Pot Bearing										
314	4	0	0	100	30	0	0	0	0	30
		No deterioration	Minor deterioration		Advanced corrosion					
Remarks:										
Concrete Bridge Railing										
331	4	0	0	100	2,880	0	0	0	0	2,880
		No deterioration	Minor cracks/spalls		Analysis warranted					
Remarks: Typ vert HL Leach crks throughout. Slipformed										
Concrete Deck Protected w/ Rigid Overlay										
8022	4	97	13,863	3	430	0	0	0	0	14,293
Remarks: Spans 11-17 Soffit) Many areas of intersecting long/transv. crks esp. Sp 15-17										
Concrete Deck Protected w/ Coated Bars										
8026	4	100	27,766	0	0	0	0	0	0	27,766
Remarks: (WS) HL-nar trans crking; Soffit) HL trans leach crks spans 1-10										
Non-Lead Painted Steel Open Girder										
8118	4	100	74,000	0	0	0	0	0	0	74,000
Remarks: Paint peel exposing primer on bottom flange of N Fascia (Spans 11-14)										
Non-Lead Painted Steel Open Girder Ends										
8176	4	100	40	0	0	0	0	0	0	40
Remarks:										
Approach Pavement										
8323	4	100	1	0	0	0	0	0	0	1
Remarks: Med trans crks w appr										



October 27, 2015

MEMORANDUM

Mr. John Fortmann, Region One Engineer
Illinois Department of Transportation
Region One/District One

Attn: Steven Schilke

RE: Existing S.N. 016-1058
E.B. I-55 over Western Ave. Viaduct
Cook County
PTB 158-002/P-91-762-10

The purpose of this technical memo is to summarize the current condition of existing S.N. 016-1058 in addition to geometrics and other factors. A cursory field check was performed to supplement the information contained in IDOT's structure summary report dated October 16, 2014 (see Appendix B). Broad-based recommendations for this structure are provided below.

The structure is a twenty-seven span steel beam viaduct totaling 2,135.0 ft. in length (see Photo 1). The superstructure is supported by pile bent abutments and reinforced concrete multi-column piers. There is no overlay on the structure.

IDOT rates the deck as being in good condition, which concurs with the findings from the cursory field check. Minor transverse cracks with leaching are visible on a majority of the soffit. Longitudinal cracks are visible on the end span soffits (see Photo 2). IDOT rates the substructure as being in very good condition, which concurs with the findings from the cursory field check. Minor cracking is visible on abutment caps. IDOT rates the underclearance vertical and lateral as being intolerable requiring a high priority for of corrective action, which concurs with the findings from the cursory field check. The clearances to piers that are adjacent to Western Ave. appear to be less than 8 ft. No notable defects or differences were observed between the cursory field check and IDOT's structure summary report for: superstructure, deck geometry, approach alignment and bridge railing appraisal items. Preformed joint seals are damaged along a small section of the east expansion joint. Gasoline is being stored on top of the east abutment (see Photo 3). Additionally, possible fire damage to the deck soffit and beam ends is visible above the east abutment (see Photo 4).

Based on the structure summary report and field check, S.N. 016-1058 is suitable for reuse after rehabilitation of the expansion joints.



LIN ENGINEERING, LTD.
Consulting Engineers

Springfield, IL Westmont, IL

576 Oakmont Lane
Westmont, Illinois 60559
Telephone: (630) 323-5168
Fax: (630) 323-5174
E-mail: info@lineng.com

LIN ENGINEERING, LTD.

A handwritten signature in blue ink that reads "Michael T. Haley". The signature is written in a cursive style with a long, sweeping tail on the letter 'y'.

Michael T. Haley, PE, SE
Structural Manager

Appendix A – Photos

Appendix B – IDOT Structure Summary Report

Appendix C – PONTIS Report



Photo 1



Photo 2



Photo 3



Photo 4

**Illinois Department of Transportation
Structures Information Management System
Structure Summary Report**

Structure Number: 016-1058 **District:** 1

Facility Carried: I-55 EB STEVENSON	Bridge Name: WESTERN AVE VIADUCT	Sufficiency Rating: 87.0	Structure Length: 2135.0
Feature Crossed: WESTERN AVE VIADUCT	Location: 2.5 M SW DAN RYAN	HBP Eligible: No	AASHTO Bridge Length: 99.9
Bridge Remarks: # SPANS ITEM 45, 24 A & 24 = 27 SPANS.		Replaced By:	Length of Long Span: 117.6
Bridge Status: 1 OPEN - NO RESTRICT	Status Date: 07/1999	Replaces:	Bridge Roadway Width: 68.9
Status Remarks:		Last Update Date: 06/21/2014	Appr Roadway Width: 88.0
Maint County: 016 COOK	Maint Township: 83 SOUTH CHICAGO	Right Deck Width:	Deck Width: 72.2
Maint Responsibility: 01 I.D.O.T.		Multi-Level Structure Nbr:	Sidewalk Width Right: 0.0
Service On/Under: 1 HIGHWAY	1 / HIGHWAY	Skew Direction: L	Sidewalk Width Left: 0.0
Reporting Agency: 1 I.D.O.T. - BUREAU OF MAINTENANCE		Navigation Control:	Navigation Horiz Clear: N N/A
Main Span Matl/Type: 4 STEEL CONTINUOUS	/ 02 STRINGERMULTI-BEAM/GIRDER	Historical Significance: No	Navigation Vert Clear: 0
Nbr Of Main Spans: 27	Nbr Of Approach Spans: 0	Border Bridge State: No	Culvert Fill Depth: 0.0
Approaches		Bdr State SN:	Number Culvert Cells: 0
Near #1 Matl/Type:	/	Bdr State % Responsibility:	Culvert Opening Area: 0.0
Near #2 Matl/Type:	/	Structural Steel Wt: 7200000	Culvert Cell Height: 0.00
Far #1 Matl/Type:	/	Substructure Material:	Culvert Cell Width: 0.00
Far #2 Matl/Type:	/	Rated By: 2 IDOT	Rate Method: 6
Median Width/Type: 0 Ft./0	None / 0	Inventory Rating: 1.335(48)	Load Rating Date: 11/20/2000
Guardrail Type L/R: 0 None	No Toll	Operating Rating: 2.225(80)	Railroad Crossing Info
Toll Facility Indicator: 0	No Toll	Design Load: 01 HS20+MOD	Crossing 1 Nbr:
Latitude: 41.83316317	S Longitude: 87.69172361	Deck Structure Thickness: 7.5 SD: N	Crossing 1 Nbr:
Deck Structure Type: A CIP CON NRMALLY FORM		RR Vertical Underclear: 0	RR Lateral Underclear: 0.0
Sidewalks Under Structure: 2 Both Sides Not Separate			Ft 0 In

Key Route On Data

Key Route Nbr: FEDERAL-AID INTERSTATE	Station: 0055	13.3300
Appurtenances Main Route: 00000	Segment:	
Inventory County: 016 COOK	Linked: Y	
Township/Road Dist: 83 SOUTH CHICAGO (CHICAGO)	Natl. Hwy System: On NHS	
Municipality: 1051 CHICAGO	Inventory Direction:	
Urban Area: 1051	Curr AADT Yr/Count: 2014 / 85050	
Functional Class: 1 INTERSTATE	Est Truck Percentage: 6	
** CLEARANCES ** South/East	Number Of Lanes: 5	
Max Rdwy Width: 68.9	One Or Two Way: 1 One-Way	
Horizontal: 70.1	Bypass Length: 0	
	Future AADT Yr/Cnt: 2032 / 95069	
Designated Truck Rte: CLASS I	Special Systems: Yes	

Key Route Under Data

FEDERAL-AID PRIMARY	Station: 0370	10.6900
Main Route	Segment:	
016	Linked: Y	
86 WEST CHICAGO (CHICAGO)	Natl. Hwy System: On NHS	
1051 CHICAGO	Inventory Direction:	
1051 1051	Curr AADT Yr/Count: 2014 / 14700	
3 OTHER PRINCIPAL ARTERIAL	Est Truck Percentage: 13	
South/East North/West	Number Of Lanes: 4	
48.0	One Or Two Way: 2 Two-Way	
70.0	Bypass Length: 0	
	Future AADT Yr/Cnt: 2032 / 15141	
Designated Truck Rte: NONE	Special Systems: Yes	

****** Marked Route On Data ******

Designation	Kind	Number
1 Mainline	1 Interstate Highway	055
1 Mainline		
1 Mainline		

****** Marked Route Under Data ******

Designation	Kind	Number
1 Mainline	8 Other	
1 Mainline		
1 Mainline		

Illinois Department of Transportation
Structures Information Management System
Structure Summary Report

Structure Number: 016-1058 District: 1

*** Inspection Intervals *** Data Related to Inspection Information

Routine NBIS: 24 MOS Underwater: 0 MOS One Truck At A Time: 0 Tons Bridge Posting Level: 5 No Posting Required
Special: N Single Unit Vehicles: 0 Tons Combination Type 3S-1: Tons
Combination Type 3S-2: Tons

*** Maximum Allowable Posting Limits ***

Inspection Date: 10/16/2014 Inspection Temperature: 58Deg. F

Deck: 7 GOOD CONDITION - SOME MINOR PROBLEMS
Superstructure: 8 VERY GOOD CONDITION - NO PROBLEMS NOTED
Substructure: 8 VERY GOOD CONDITION - NO PROBLEMS NOTED
Culvert: N NOT APPLICABLE
Channel and Protection: N NOT APPLICABLE
Structural Evaluation: 8 EQUAL TO PRESENT DESIRABLE CRITERIA
Deck Geometry: 4 MINIMUM ADEQUACY TO BE LEFT IN PLACE
Underclearance-Vert/Lat.: 3 INTOLERABLE - HIGH PRIORITY FOR CORRECTION
Waterway Adequacy: N NOT APPLICABLE
Approach Roadway Align: 8 EQUAL TO PRESENT DESIRABLE CRITERIA
Bridge Railing Appraisal: 3 Meets Standards
Approach Guardrail: N/A N/A
Pier Navig Protection: N N/A

Deck Wearing Surf: A BARE DECK NO OVRLAY
Deck Membrane: F NONE
Deck Protection: A EPOXY COATED REINF
Total Deck Thick: 7.5
Last Paint Date: 08/2001

Single Unit Vehicles: Tons
Combination Type 3S-1: Tons
Combination Type 3S-2: Tons
One Truck At A Time: 0
Last Paint Type: S
SHP ZINC&FLD ACRYL

*** Actual Posted Limits ***

Inspection Date: Inspection Method: Appraisal Rating:
Temperature: Underwater Inspection/Appraisal Information

Scour Critical Information

Rating: Evaluation Method: Microfilm Data Recorded: Yes
Analysis Date:

Construction Information

Year: 1963 Original 1999 Reconstructed
Route: FAI-55 Sta: 131+67.77 FAI-55 Sta: 131+67.77
Section Nbr: 207-1415.2-CF 1997-073BR
Contract Nbr: 82692
Fed Aid Pr#: IIG0557108284
Built By: 3 COUNTY AGENCY 1 I.D.O.T.

Pontis

Today's Date: 09/03/2015

Structure Number: 016-1058 District: 1 (41) Bridge Status: 1 OPEN - NO RESTRICT
 (6) Feature Crossed: WESTERN AVE VIADUCT (7) Facility Carried: I-55 EB STEVENSON
 (9) Location: 2.5 M SW DAN RYAN (7A) Bridge Name:
 Element Inspection Date: 10/16/2014
 (90E) Agency Program Manager: MastnySC (90E3) Consultant Program Manager:
 (90E1) Team Leader: Sedlacek, J.L. (90E2) Inspector:

Element Insp. Delinquent		Element Insp. Delinquent Reason								
N										
Element Description										
Elem	Env	% 1	Qty 1	% 2	Qty 2	% 3	Qty 3	% 4	Qty 4	Tot Qty
Reinforced Conc Column or Pile Extension										
205	4	100	31,385	0	0	0	0	0	0	31,385
			No deterioration	Minor cracks/spalls	Delams/spalls	Analysis warranted				
Remarks: Pier 19 -FCR map crkd @ col										
Reinforced Conc Pier Wall										
210	4	100	14,728	0	0	0	0	0	0	14,728
			No deterioration	Minor cracks/spalls	Delams/spalls	Analysis warranted				
Remarks: Pier 18 med vert leach crks. Pier 19-FCR map crkd. Pier 20-FCR map crkd.										
Reinforced Conc Abutment										
215	4	100	1,228	0	0	0	0	0	0	1,228
			No deterioration	Minor cracks/spalls	Delams/spalls	Analysis warranted				
Remarks: East & West Abut Bkwall-vert leach crks.										
Reinforced Conc Pier or Abutment Cap										
234	4	100	2,029	0	0	0	0	0	0	2,029
			No deterioration	Minor cracks/spalls	Delams/spalls	Analysis warranted				
Remarks:										
Preformed Joint Seal										
302	4	92	92	0	0	8	8	0	0	100
			No deterioration	Minor deterioration	Major deterioration					
Remarks: Lt leakage @ E Abut										
Modular Joints										
303	4	100	309	0	0	0	0	0	0	309
			No deterioration	Minor deterioration	Advanced corrosion	Corrosion is advance				
Remarks:										
Elastomeric Bearing										
310	4	97	244	0	0	3	8	0	0	252
			No deterioration	Minor deterioration	Major deterioration					
Remarks: Lt init rust to few bearing assemblies @ E Abut and Pier 22										

Fixed Bearing										
313	4	100	86	0	0	0	0	0	0	86
		No deterioration	Minor deterioration	Advanced corrosion						
Remarks:										
Concrete Bridge Railing										
331	4	100	4,260	0	0	0	0	0	0	4,260
		No deterioration	Minor cracks/spalls	Analysis warranted						
Remarks: HL vert cracking typ.										
Concrete Deck Protected w/ Coated Bars										
8026	4	93	150,183	7	11,860	0	0	0	0	162,043
Remarks: Trans leach crking w/few intersecting longitudinal crks Soffit) HL Trans leach crks w/few areas < 5' c/c										
Non-Lead Painted Steel Open Girder										
8118	4	100	184,734	0	0	0	0	0	0	184,734
Remarks:										
Non-Lead Painted Steel Closed Web/Box Girder Ends										
8173	4	100	116	0	0	0	0	0	0	116
Remarks:										
Continuous Seal Neoprene Expansion Joint										
8308	4	100	147	0	0	0	0	0	0	147
Remarks:										
Approach Pavement										
8323	4	100	2	0	0	0	0	0	0	2
Remarks: Random cracking.										



October 27, 2015

MEMORANDUM

Mr. John Fortmann, Region One Engineer
Illinois Department of Transportation
Region One/District One

Attn: Steven Schilke

RE: Existing S.N. 016-1059
E.B. I-55 Ramp to N.B. I-94/W.B. I-90
Cook County
PTB 158-002/P-91-762-10

The purpose of this technical memo is to summarize the current condition of existing S.N. 016-1059 in addition to geometrics and other factors. A cursory field check was performed to supplement the information contained in IDOT's structure summary report dated May 27, 2015 (see Appendix B). Broad-based recommendations for this structure are provided below.

The structure is a fourteen span continuous steel girder third level interchange bridge totaling 1,174.0 ft. in length (see Photo 1). The superstructure is supported by a pile bent abutment and reinforced concrete multi-column piers. There is no overlay on the structure.

We were unable to gain access to view the top of deck. IDOT rates the deck as being in good condition. The findings from the cursory field check don't match IDOT's deck rating. Transverse cracks with leaching are visible on a majority of the soffit. Longitudinal cracks with leaching are visible on some sections of the soffit (see Photo 2). Possible delaminations are visible in the soffit over E.B. I-55 traffic. IDOT rates the superstructure as being in satisfactory condition, which concurs with the findings from the cursory field check. Scattered paint peeling and rust are visible on the majority of girders. IDOT rates the substructure as being in good condition, which concurs with the findings from the cursory field check. A few minor spalls and cracks are visible on the pier caps and columns. Large cracks are visible on some previously repaired areas (See Photo 3). IDOT rates the deck geometry as being intolerable and requiring a high priority of corrective action, which concurs with the findings from the cursory field check. Vertical clearance to I-94 is less than 15 ft. IDOT rates the underclearance vertical and lateral as being intolerable requiring a high priority of corrective action, which concurs with the findings from the cursory field check. Vertical clearance to the W.B. I-55 ramp is less than 15ft. Minor scrape marks are visible on the exterior beam bottom flange (see Photo 4). No notable defects or differences were observed between our cursory field check and IDOT's structure summary report for: approach alignment, bridge railing appraisal and approach guardrail items. Large longitudinal cracks and a spall in the approach parapet are visible on the west approach slab (see Photo 5).



LIN ENGINEERING, LTD.
Consulting Engineers

Springfield, IL Westmont, IL

576 Oakmont Lane
Westmont, Illinois 60559
Telephone: (630) 323-5168
Fax: (630) 323-5174
E-mail: info@lineng.com

Based on the structure summary report and field check, S.N. 016-1059 is suitable for reuse after rehabilitation of the substructure.

LIN ENGINEERING, LTD.

Michael T. Haley, PE, SE
Structural Manager

Appendix A – Photos

Appendix B – IDOT Structure Summary Report

Appendix C – PONTIS Report



Photo 1



Photo 2



Photo 3



Photo 4



Photo 5

**Illinois Department of Transportation
Structures Information Management System
Structure Summary Report**

Structure Number: 016-1059 **District:** 1

Facility Carried:	I-55 EB TO RYAN NB	Bridge Name:	55EB RMP TO 90,94NB	Sufficiency Rating:	81.2	Structure Length:	1174.0
Feature Crossed:	I-55 STEVENSON	Location:	0.1 M E I-94	HBP Eligible:	No	AASHTO Bridge Length:	99.9
Bridge Remarks:		Status Date:	04/1988	Replaced By:	-	Length of Long Span:	80.0
Bridge Status:	1 OPEN - NO RESTRICT	Maint Township:	83 COOK	Last Update Date:	07/05/2012	Bridge Roadway Width:	25.9
Status Remarks:		Maint County:	016 COOK	Parallel Structure:	Left	Deck Width:	29.1
Maint Responsibility:	01 I.D.O.T.	Service On/Under:	6 THIRD LEVEL INTERCHANGE	Multi-Level Structure Nbr:		Sidewalk Width Right:	0.0
Reporting Agency:	1 I.D.O.T. - BUREAU OF MAINTENANCE	Main Span Mat/Type:	4 STEEL CONTINUOUS	Skew Direction:	R	Sidewalk Width Left:	0.0
Nbr Of Main Spans:	14	Nbr Of Approach Spans:	0	Structure Flared:	No	Navigation Control:	N
Near #1 Mat/Type:	/	Near #2 Mat/Type:	/	Historical Significance:	No	Navigation Horiz Clear:	0
Far #1 Mat/Type:	/	Far #2 Mat/Type:	/	Border Bridge State:	No	Navigation Vert Clear:	0
Median Width/Type:	0 Ft. / 0	Guardrail Type L/R:	0 None / 0	Bdr State SN:		Culvert Fill Depth:	0.0
Toll Facility Indicator:	0 No Toll	Latitude:	41.84788457	Bdr State % Responsibility:		Number Culvert Cells:	0
Inventory Rating:	None	S Longitude:	87.64232718	Structural Steel Wt:	1200000	Culvert Cell Height:	0.00
Operating Rating:	S	Deck Structure Thickness:	7.5	Substructure Material:		Culvert Cell Width:	0.00
Design Load:	99 UNKNOWN	Rated By:	2 IDOT	Rate Method:	6	Rate Method:	6
Deck Structure Type:	A CIP CON NRMALLY FORM	Inventory Rating:	1.065(38)	Load Rating Date:	11/18/1998	Railroad Crossing Info	
Sidewalks Under Structure:	0 None	Operating Rating:	1.775(63)	Design Load:	99 UNKNOWN	Crossing 1 Nbr:	
		Deck Structure Thickness:	7.5	SD:	N	Crossing 1 Nbr:	
		RR Vertical Underclear:	0	FO:	Y	RR Lateral Underclear:	0.0

Key Route On Data	Key Route Under Data
Key Route Nbr: FEDERAL-AID INTERSTATE 0094	Station: 0055
Appurtenances: Ramp 27860	Segment: 00000
Inventory County: 016 COOK	Linked: Y
Township/Road Dist: 83 SOUTH CHICAGO (CHICAGO)	Natl. Hwy System: On NHS
Municipality: 1051 CHICAGO	Inventory Direction: SOUTH CHICAGO (CHICAGO)
Urban Area: 1051	Inventory Direction: CHICAGO
Functional Class: 1 INTERSTATE	Curr AADT Yr/Count: 2002 / 41900
** CLEARANCES **	Est Truck Percentage: 0
Max Rdwy Width: 25.9	Number Of Lanes: 1
Horizontal: 26.0	One Or Two Way: 1 One-Way
	Bypass Length: 3
	Future AADT Yr/Cnt: 2032 / 43157
	Designated Truck Rte: NONE
	Special Systems: No

**** Marked Route On Data ****	**** Marked Route Under Data ****
Designation	Designation
Kind	Kind
Number	Number
Route #1: 1 Mainline	1 Mainline
Route #2: 1 Mainline	1 Mainline
Route #3: 1 Mainline	1 Mainline
	1 Interstate Highway
	055

Illinois Department of Transportation
Structures Information Management System
Structure Summary Report

Structure Number: 016-1059 District: 1

Data Related to Inspection Information

*** Inspection Intervals ***
 Routine NBIS: 24 MOS Underwater: 0 MOS One Truck At A Time: 0 Tons Combination Type 3S-1: Tons
 Special: N Single Unit Vehicles: Tons Combination Type 3S-2: Tons
 Bridge Posting Level: 5 No Posting Required

Inspection/Appraisal Information

Inspection Date: 05/27/2015 Inspection Temperature: 75Deg. F
 Deck: 7 GOOD CONDITION - SOME MINOR PROBLEMS
 Superstructure: 6 SATISFACTORY CONDITION - MINOR DETERIORATION
 Substructure: 7 GOOD CONDITION - SOME MINOR PROBLEMS
 Culvert: N NOT APPLICABLE
 Channel and Protection: N NOT APPLICABLE
 Structural Evaluation: 6 EQUAL TO PRESENT MINIMUM CRITERIA
 Deck Geometry: 3 INTOLERABLE - HIGH PRIORITY FOR CORRECTION
 Underclearance-Vert/Lat.: 3 INTOLERABLE - HIGH PRIORITY FOR CORRECTION
 Waterway Adequacy: N NOT APPLICABLE
 Approach Roadway Align: 8 EQUAL TO PRESENT DESIRABLE CRITERIA
 Bridge Railing Appraisal: 3 Meets Standards
 Approach Guardrail: 333 Acceptable
 Pier Navig Protection: N N/A

*** Maximum Allowable Posting Limits ***
 Single Unit Vehicles: 75Deg. F
 Combination Type 3S-1: Tons
 Combination Type 3S-2: Tons
 One Truck At A Time: 0
 Last Paint Type: S
 SHP ZINC&FLD ACRYL

*** Actual Posted Limits ***
 Single Unit Vehicles: Tons
 Combination Type 3S-1: Tons
 Combination Type 3S-2: Tons
 One Truck At A Time: 0
 Last Paint Type: S
 SHP ZINC&FLD ACRYL

Underwater Inspection/Appraisal Information

Inspection Date:
 Temperature:
 Inspection Method:
 Appraisal Rating:

Scour Critical Information

Rating:
 Analysis Date:
 Evaluation Method:
 Microfilm Data Recorded: Yes

Construction Information

Year: 1964 Original
 Route: FAI-55 Reconstructed
 Section Nbr: 1717.6-1P Sta:
 Contract Nbr:
 Fed Aid Pr#: I 0557049287
 Built By: 4 CITY

Pontis

Today's Date: 09/03/2015

Structure Number: 016-1059 District: 1 (41) Bridge Status: 1 OPEN - NO RESTRICT
 (6) Feature Crossed: I- 55 STEVENSON (7) Facility Carried: I- 55 EB TO RYAN NB
 (9) Location: 0.1 M E I-94 (7A) Bridge Name: 55EB RMP TO 90,94NB
 Element Inspection Date: 05/27/2015
 (90E) Agency Program Manager: MastrySC (90E3) Consultant Program Manager:
 (90E1) Team Leader: SedlacekJL (90E2) Inspector:

Element Insp. Delinquent		Element Insp. Delinquent Reason:								
Element Description										
Elem	Env	% 1	Qty 1	% 2	Qty 2	% 3	Qty 3	% 4	Qty 4	Tot Qty
Lead Painted Steel Open Girder										
107	4	87	30,700	13	4,400	0	0	0	0	35,100
		No corrosion	Paint distress	Rust formation	Section loss	Section failure				
Remarks: Lt surf rust@ Bott flanges & webs; Paint is peeling and flaking @ Bott flanges & webs. Lat Bracing rusted @ Spans 12 & 13										
Reinforced Conc Column or Pile Extension										
205	4	99	5,235	1	60	0	5	0	0	5,300
		No deterioration	Minor cracks/spalls	Delams/spalls	Analysis warranted					
Remarks: Vert crking. P34 NFace Col#1 spall w/exp 2ftx2ft, Col#2 spall w/exp @ base; P36 Col HL map crks @ FCR										
Reinforced Conc Abutment										
215	4	100	287	0	0	0	0	0	0	287
		No deterioration	Minor cracks/spalls	Delams/spalls	Analysis warranted					
Remarks: Homeless debris @ West Abut										
Reinforced Conc Pier or Abutment Cap										
234	4	100	449	0	0	0	0	0	0	449
		No deterioration	Minor cracks/spalls	Delams/spalls	Analysis warranted					
Remarks: P35 Cap-delam & sm spalls under Bm#5										
Strip Seal Expansion Joint										
300	4	100	142	0	0	0	0	0	0	142
		No leakage	Minor leakage	Major leakage						
Remarks: New Strip Seal @ P43 to P45										
Preformed Joint Seal										
302	4	100	26	0	0	0	0	0	0	26
		No deterioration	Minor deterioration	Major deterioration						
Remarks: PJS @ P33										
Elastomeric Bearing										
310	4	100	86	0	0	0	0	0	0	86
		No deterioration	Minor deterioration	Major deterioration						
Remarks:										

Fixed Bearing										
313	4	100	5	0	0	0	0	0	0	5
		No deterioration	Minor deterioration	Advanced corrosion						
Remarks:										
Concrete Bridge Railing										
331	4	96	1,930	4	80	0	0	0	0	2,010
		No deterioration	Minor cracks/spalls	Analysis warranted						
Remarks: Repaired area above I-55 NB East Rail; HL Vert Cracking. Map Cracking Outside Face of N Rail Near W Abut.										
Concrete Deck Protected w/ Coated Bars										
8026	4	96	30,335	4	1,245	0	0	0	0	31,580
Remarks: Transverse leach cracking throughout majority; WS has few mapcracked areas										
Non-Lead Painted Steel Open Girder										
8118	4	98	18,930	2	350	0	0	0	0	19,280
Remarks: Paint peels scattered										
Non-Lead Painted Steel Open Girder Ends										
8176	4	79	64	21	17	0	0	0	0	81
Remarks: Bm Ends rusted @ Spans 6,7 &8										
Continuous Seal Neoprene Expansion Joint										
8308	4	100	30	0	0	0	0	0	0	30
Remarks: Neop Jnt @ West Abut										
Approach Pavement										
8323	4	100	1	0	0	0	0	0	0	1
Remarks: @ SW Approach										



November 9, 2015

MEMORANDUM

Mr. John Fortmann, Region One Engineer
Illinois Department of Transportation
Region One/District One

Attn: Steven Schilke

RE: Existing S.N. 016-1083
W.B. I-55 over Ashland Ave. Viaduct
Cook County
PTB 158-002/P-91-762-10

The purpose of this technical memo is to summarize the current condition of existing S.N. 016-1083 in addition to geometrics and other factors. A cursory field check was performed to supplement the information contained in IDOT's structure summary report dated August 4, 2015 (see Appendix B). Broad-based recommendations for this structure are provided below.

The structure is a twenty-nine span continuous steel beam bridge totaling 2,456.8 ft. in length (see Photo 1). The superstructure is supported by a vaulted abutment and reinforced concrete multi-column piers. There is no overlay on the structure.

IDOT rates the deck as being in good condition, which concurs with the findings from the cursory field check. Minor transverse cracks with leaching are visible on a majority of the soffit (see Photo 2). IDOT rates the substructure as being in very good condition, which concurs with the findings from the cursory field check. Minor cracks and shallow spalls are visible on the abutment and piers (see Photo 3). IDOT rates the underclearance vertical and lateral as being intolerable requiring a high priority of corrective action, which concurs with the findings from the cursory field check. No notable defects or differences were observed between the cursory field check and IDOT's structure summary report for: superstructure, deck geometry, approach alignment, bridge railing appraisal and approach guardrail items. Anchor blocks are damaged along sections of the west expansion joint (see Photo 4).

Based on the structure summary report and field check, S.N. 016-1083 is suitable for reuse after rehabilitation of the expansion joints.



LIN ENGINEERING, LTD.
Consulting Engineers

Springfield, IL Westmont, IL

576 Oakmont Lane
Westmont, Illinois 60559
Telephone: (630) 323-5168
Fax: (630) 323-5174
E-mail: info@lineng.com

LIN ENGINEERING, LTD.

A handwritten signature in blue ink that reads "Michael T. Haley". The signature is written in a cursive, flowing style.

Michael T. Haley, PE, SE
Structural Manager

Appendix A – Photos

Appendix B – IDOT Structure Summary Report

Appendix C – PONTIS Report



Photo 1

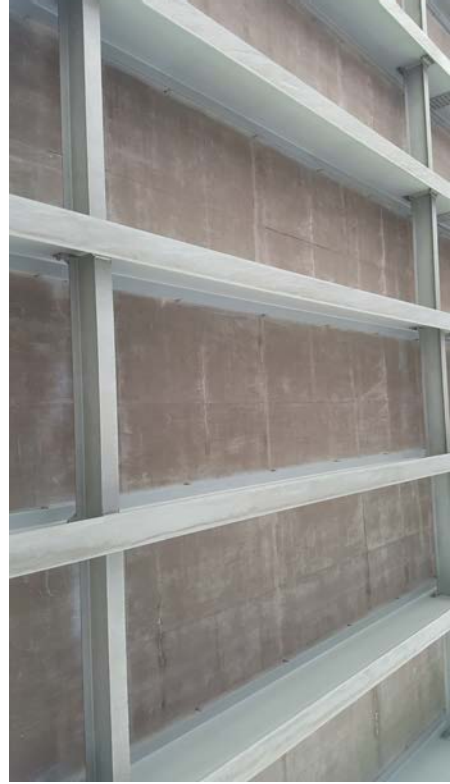


Photo 2



Photo 3



Photo 4

Illinois Department of Transportation
Structures Information Management System
Structure Summary Report

Structure Number: 016-1083 District: 1

Inventory Data	
Facility Carried:	I-55 WB ELEVATED
Feature Crossed:	ASHLAND AVE VIADUCT
Bridge Remarks:	(34A)SKEW IS L BUT ANGLES NOT AVAILABLE
Bridge Status:	1 OPEN - NO RESTRICT
Status Remarks:	
Maint County:	016 COOK
Maint Township:	83 SOUTH CHICAGO
Service On/Under:	01 I.D.O.T.
Reporting Agency:	1 HIGHWAY
Main Span Matl/Type:	4 STEEL CONTINUOUS
Nbr Of Main Spans:	29
Approaches	
Near #1 Matl/Type:	5 PRESTRESS CONCRETE
Near #2 Matl/Type:	
Far #1 Matl/Type:	
Far #2 Matl/Type:	
Median Width/Type:	0 Ft. / 0 None
Guardrail Type L/R:	0 None / 0 None
Toll Facility Indicator:	0 No Toll
Latitude:	41.83706565
Deck Structure Type:	A CIP CON NRM LLY FORM
Sidewalks Under Structure:	2 Both Sides Not Separate
Inventory Rating:	1.240(44)
Operating Rating:	2.000(72)
Design Load:	02 HS20
Deck Structure Thickness:	7.5 SD: N FO: Y
RR Lateral Underclear:	23 Ft
RR Vertical Underclear:	03 Ft
RR Crossing 1 Nbr:	0
RR Crossing 1 Nbr:	0
RR Lateral Underclear:	23 Ft
RR Vertical Underclear:	03 Ft
Rate Method:	6
Load Rating Date:	04/23/2002
Rate Method:	6
Railroad Crossing Info	

Key Route Under Data	
Key Route Nbr:	FEDERAL-AID INTERSTATE
Station:	0055
Segment:	14.3300
Appurtenances Main Route	00000
Inventory County:	016 COOK
Township/Road Dist	83 SOUTH CHICAGO (CHICAGO)
Natl. Hwy System:	On NHS
Municipality	1051 CHICAGO
Urban Area:	1051
Inventory Direction:	2014 / 64850
Urban Area:	1051
Inventory Direction:	2014 / 64850
Functional Class:	1 INTERSTATE
Inventory Direction:	2014 / 64850
** CLEARANCES **	South/East
Est Truck Percentage:	9
Number Of Lanes:	3
One Or Two Way:	1 One-Way
Max Rdwy Width:	59.0
Horizontal:	60.2
Bypass Length:	0
Future AADT Yr/Cnt:	2032 / 73027
Designated Truck Rte:	CLASS I
Special Systems:	Yes
Laterals:	

Key Route Under Data	
Key Route Nbr:	FEDERAL-AID URBAN
Station:	2853
Segment:	16.2000
Appurtenances Main Route	00000
Inventory County:	016 COOK
Township/Road Dist	83 SOUTH CHICAGO (CHICAGO)
Natl. Hwy System:	On NHS
Municipality	1051 CHICAGO
Urban Area:	1051
Inventory Direction:	2014 / 20000
Urban Area:	1051
Inventory Direction:	2014 / 20000
Functional Class:	4 MINOR ARTERIAL
Est Truck Percentage:	9
Number Of Lanes:	7
One Or Two Way:	2 Two-Way
Max Rdwy Width:	72.0
Horizontal:	72.0
Bypass Length:	0.0
Future AADT Yr/Cnt:	2032 / 26265
Designated Truck Rte:	NONE
Special Systems:	No
Laterals:	

*** Marked Route On Data ***	
Route #1:	1 Mainline
Route #2:	1 Interstate Highway
Route #3:	1 Mainline
Designation	Kind
1 Mainline	055

*** Marked Route Under Data ***	
Route #1:	1 Mainline
Route #2:	1 Mainline
Route #3:	1 Mainline
Designation	Kind
1 Mainline	8 Other

**Illinois Department of Transportation
Structures Information Management System
Structure Summary Report**

Structure Number: 016-1083 District: 1

Data Related to Inspection Information

*** Inspection Intervals ***
 Routine NBIS: 24 MOS Underwater: 0 MOS One Truck At A Time: 0 Tons Combination Type 3S-1: Tons
 Special: N Single Unit Vehicles: Tons Combination Type 3S-2: Tons
 Bridge Posting Level: 5 No Posting Required

Inspection/Appraisal Information

Inspection Date: 08/04/2015 Inspection Temperature: 85Deg. F
 Deck: 7 GOOD CONDITION - SOME MINOR PROBLEMS
 Superstructure: 8 VERY GOOD CONDITION - NO PROBLEMS NOTED
 Substructure: 8 VERY GOOD CONDITION - NO PROBLEMS NOTED
 Culvert: N NOT APPLICABLE
 Channel and Protection: N NOT APPLICABLE
 Structural Evaluation: 8 EQUAL TO PRESENT DESIRABLE CRITERIA
 Deck Geometry: 7 BETTER THAN PRESENT MINIMUM CRITERIA
 Underclearance-Vert/Lat.: 3 INTOLERABLE - HIGH PRIORITY FOR CORRECTION
 Waterway Adequacy: N NOT APPLICABLE
 Approach Roadway Align: 8 EQUAL TO PRESENT DESIRABLE CRITERIA
 Bridge Railing Appraisal: 3 Meets Standards
 Approach Guardrail: 333 Acceptable
 Pier Navig Protection: N N/A

Deck Wearing Surf: A BARE DECK NO OVRLAY
 Deck Membrane: F NONE
 Deck Protection: A EPOXY COATED REINF
 Total Deck Thick: 7.5
 Last Paint Date: 10/2001

*** Actual Posted Limits **
 Single Unit Vehicles: Tons
 Combination Type 3S-1: Tons
 Combination Type 3S-2: Tons
 One Truck At A Time: 0
 Last Paint Type: U
 FLD AL EPY & ACRLC

Underwater Inspection/Appraisal Information

Inspection Date:
 Temperature:
 Inspection Method:
 Appraisal Rating:

Scour Critical Information

Rating:
 Analysis Date:
 Evaluation Method:
 Microfilm Data Recorded: Yes

Construction Information

Year: 1963 Original
 Route: FAI-55 Reconstructed
 Section Nbr: 207-1515.2-CF
 Contract Nbr: 1516.2-B
 Fed Aid Pr#: I 0557111285
 Built By: 3 COUNTY AGENCY 1 I.D.O.T.

Pontis

Today's Date: 10/08/2015

Structure Number: 016-1083 District: 1 (41) Bridge Status: 1 OPEN - NO RESTRICT
 (6) Feature Crossed: ASHLAND AVE VIADUCT (7) Facility Carried: I- 55 WB ELEVATED
 (9) Location: 2.6 M SW I-90,94 (7A) Bridge Name: 1.3-2.6 MI SW OF I94
 Element Inspection Date: 08/04/2015
 (90E) Agency Program Manager: AsfourSE (90E3) Consultant Program Manager:
 (90E1) Team Leader: Cowley.J (90E2) Inspector:

Element Insp. Delinquent		N		Element Insp. Delinquent Reason:						
Elem	Env	% 1	Qty 1	% 2	Qty 2	% 3	Qty 3	% 4	Qty 4	Tot Qty
P/S Conc Open Girder										
109	4	100	350	0	0	0	0	0	0	350
		No deterioration	Minor cracks/spalls	Delams/spalls	Analysis warranted					
Remarks:										
Reinforced Conc Column or Pile Extension										
205	3	99	50,016	1	700	0	20	0	0	50,736
		No deterioration	Minor cracks/spalls	Delams/spalls	Analysis warranted					
Remarks: (Pier 32 not included, calc on 016-1085), HL vert, horiz or map crks										
Reinforced Conc Pier Wall										
210	3	100	20,825	0	0	0	10	0	0	20,835
		No deterioration	Minor cracks/spalls	Delams/spalls	Analysis warranted					
Remarks: (Pier 32 not included, calc on 016-1085); HL vert crks; Note- WB Lns- no Pier 18, P20 or P30										
Reinforced Conc Abutment										
215	4	100	1,140	0	0	0	0	0	0	1,140
		No deterioration	Minor cracks/spalls	Delams/spalls	Analysis warranted					
Remarks: West Abut- South Retaining Wall - HL map crks										
Reinforced Conc Pier or Abutment Cap										
234	4	100	2,672	0	0	0	0	0	0	2,672
		No deterioration	Minor cracks/spalls	Delams/spalls	Analysis warranted					
Remarks:										
Modular Joints										
303	4	97	367	0	0	3	10	0	0	377
		No deterioration	Minor deterioration	Advanced corrosion	Corrosion is advance					
Remarks: (Pier 32 not included, calc on 016-1085); Mod Jnts @ P6, P12, P19 & P32; CS3 @ P19 damaged gland near rt shoulder										
Elastomeric Bearing										
310	4	0	0	100	255	0	0	0	0	255
		No deterioration	Minor deterioration	Major deterioration						
Remarks:										

Fixed Bearing										
313	4	0	0	100	70	0	0	0	0	70
		No deterioration	Minor deterioration		Advanced corrosion					
Remarks:										
Reinforced Concrete Approach Slab										
321	4	94	2,921	6	180	0	0	0	0	3,101
		No deterioration	Cracks/spalls	Major cracks/spalls		Broken/Unstable				
Remarks: @ West End; HL to wide x-verse crks.										
Concrete Bridge Railing										
331	4	0	0	98	4,724	2	90	0	0	4,814
		No deterioration	Minor cracks/spalls	Analysis warranted						
Remarks: Light vertical cracking (typ inside & outside face).										
Concrete Deck Protected w/ Coated Bars										
8026	4	96	174,962	4	6,350	0	0	0	0	181,312
Remarks: Dk Soffit- HL-wide scattered trans leach crks in soffit.										
Non-Lead Painted Steel Open Girder										
8118	4	100	249,227	0	0	0	0	0	0	249,227
Remarks:										
Non-Lead Painted Steel Closed Web/Box Girder Ends										
8173	4	100	96	0	0	0	0	0	0	96
Remarks: (West row only @ pier 32)										
Continuous Seal Neoprene Expansion Joint										
8308	4	51	31	33	20	0	0	16	10	61
Remarks: West Abut worn blocks missing blocks in both shoulders										
Approach Pavement										
8323	4	100	1	0	0	0	0	0	0	1
Remarks: HL to wide x-verse crks. West Relief Jnt 36 ft missing.										



November 9, 2015

MEMORANDUM

Mr. John Fortmann, Region One Engineer
Illinois Department of Transportation
Region One/District One

Attn: Steven Schilke

RE: Existing S.N. 016-1084
E.B. I-55 over Ashland Ave. Viaduct
Cook County
PTB 158-002/P-91-762-10

The purpose of this technical memo is to summarize the current condition of existing S.N. 016-1084 in addition to geometrics and other factors. A cursory field check was performed to supplement the information contained in IDOT's structure summary report dated August 4, 2015 (see Appendix B). Broad-based recommendations for this structure are provided below.

The structure is a twenty-nine span continuous steel beam bridge totaling 2,510.2 ft. in length (see Photo 1). The superstructure is supported by a vaulted abutment and reinforced concrete multi-column piers. There is no overlay on the structure.

IDOT rates the deck as being in good condition, which concurs with the findings from the cursory field check. Minor transverse cracks with leaching are visible on a majority of the soffit (see Photo 2). IDOT rates the substructure as being in very good condition. The findings from the cursory field check don't match IDOT's substructure rating. A few minor cracks, and spalls with exposed rebar are visible on the piers and abutment. Severe map cracks are visible on one column (See Photo 3). IDOT rates the underclearance vertical and lateral as being intolerable requiring a high priority of corrective action, which concurs with the findings from the cursory field check. No notable defects or differences were observed between the cursory field check and IDOT's structure summary report for: superstructure, deck geometry, approach alignment and bridge railing appraisal items. Large transverse and diagonal cracks are visible on the west approach slab. Anchor blocks are damaged along sections of the west expansion joint (see Photo 4).

Based on the structure summary report and field check, S.N. 016-1084 is suitable for reuse after rehabilitation of the expansion joints.



LIN ENGINEERING, LTD.
Consulting Engineers

Springfield, IL Westmont, IL

576 Oakmont Lane
Westmont, Illinois 60559
Telephone: (630) 323-5168
Fax: (630) 323-5174
E-mail: info@lineng.com

LIN ENGINEERING, LTD.

A handwritten signature in blue ink that reads "Michael T. Haley". The signature is written in a cursive, flowing style.

Michael T. Haley, PE, SE
Structural Manager

Appendix A – Photos

Appendix B – IDOT Structure Summary Report

Appendix C – PONTIS Report



Photo 1



Photo 2



Photo 3

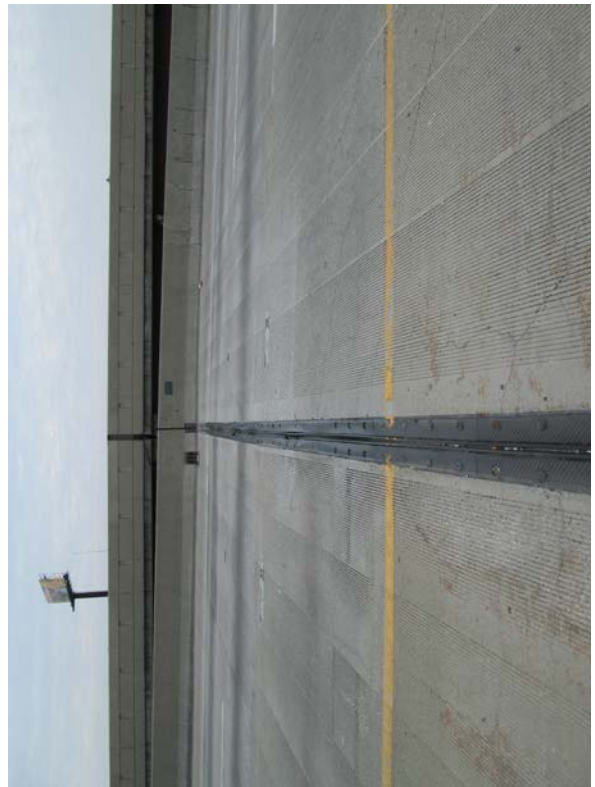


Photo 4

**Illinois Department of Transportation
Structures Information Management System
Structure Summary Report**

Structure Number: 016-1084 District: 1

Inventory Data	
Facility Carried:	I-55 EB ELEVATED
Feature Crossed:	ASHLAND AVE VIADUCT
Bridge Remarks:	(34A)SKEW IS L BUT ANGLES NOT AVAILABLE
Bridge Status:	1 OPEN - NO RESTRICT
Status Remarks:	
Maint County:	016 COOK
Maint Responsibility:	01 I.D.O.T.
Service On/Under:	1 HIGHWAY
Reporting Agency:	1 I.D.O.T. - BUREAU OF MAINTENANCE
Main Span Matl/Type:	4 STEEL CONTINUOUS
Nbr Of Main Spans:	29
Approaches	
Near #1 Matl/Type:	5 PRESTRESS CONCRETE
Near #2 Matl/Type:	/
Far #1 Matl/Type:	/
Far #2 Matl/Type:	/
Median Width/Type:	0 Ft./0 None
Guardrail Type L/R:	0 None / 0 None
Toll Facility Indicator:	0 No Toll
Latitude:	41.83708215
Longitude:	S
Deck Structure Type:	A CIP CON NRMALLY FORM
Sidewalks Under Structure:	2 Both Sides Not Separate
Inventory Rating:	1.155(41)
Operating Rating:	1.925(69)
Design Load:	02 HS20
Deck Structure Thickness:	7.5 SD: N FC: Y
RR Vertical Underclear:	0 Ft 0 In

Key Route On Data	
Key Route Nbr:	FEDERAL-AID INTERSTATE
Station:	0055
Segment:	14.3200
Main Route:	00000
Linked:	Y
Natl. Hwy System:	On NHS
Township/Road Dist:	83 SOUTH CHICAGO (CHICAGO)
Municipality:	1051 CHICAGO
Urban Area:	1051
Inventory Direction:	2014 / 64850
Functional Class:	1 INTERSTATE
** CLEARANCES **	South/East North/West
Est Truck Percentage:	9
Number Of Lanes:	3
One Or Two Way:	1 One-Way
Bypass Length:	0
Future AADT Yr/Cnt:	2032 / 73027
Designated Truck Rte:	CLASS I
Special Systems:	Yes

Key Route Under Data	
Key Route Nbr:	FEDERAL-AID URBAN
Station:	2853
Segment:	16.2400
Main Route:	00000
Linked:	Y
Natl. Hwy System:	On NHS
Township/Road Dist:	83 SOUTH CHICAGO (CHICAGO)
Municipality:	1051 CHICAGO
Urban Area:	1051
Inventory Direction:	2014 / 20000
Functional Class:	4 MINOR ARTERIAL
** CLEARANCES **	South/East North/West
Est Truck Percentage:	9
Number Of Lanes:	7
One Or Two Way:	2 Two-Way
Bypass Length:	0
Future AADT Yr/Cnt:	2032 / 26265
Designated Truck Rte:	NONE
Special Systems:	No

**** Marked Route On Data ****		
Designation	Kind	Number
1 Mainline	1 Interstate Highway	055

**** Marked Route Under Data ****		
Designation	Kind	Number
1 Mainline	8 Other	
1 Mainline	1 Mainline	
1 Mainline	1 Mainline	

Illinois Department of Transportation
Structures Information Management System
Structure Summary Report

Structure Number: 016-1084 District: 1

*** Inspection Intervals ***
Routine NBIS: 24 MOS Underwater: 0 MOS One Truck At A Time: 0 Tons Combination Type 3S-1: Tons Bridge Posting Level: 5 No Posting Required
Special: N Single Unit Vehicles: Tons Combination Type 3S-2: Tons

Data Related to Inspection Information
*** Maximum Allowable Posting Limits ***
*** Actual Posted Limits ***

Inspection Date: 08/04/2015 Inspection Temperature: 85Deg. F
Deck: 7 GOOD CONDITION - SOME MINOR PROBLEMS
Superstructure: 8 VERY GOOD CONDITION - NO PROBLEMS NOTED
Substructure: 8 VERY GOOD CONDITION - NO PROBLEMS NOTED
Culvert: N NOT APPLICABLE
Channel and Protection: N NOT APPLICABLE
Structural Evaluation: 8 EQUAL TO PRESENT DESIRABLE CRITERIA
Deck Geometry: 9 SUPERIOR TO PRESENT DESIRABLE CRITERIA
Underclearance-Vert/Lat.: 3 INTOLERABLE - HIGH PRIORITY FOR CORRECTION
Waterway Adequacy: N NOT APPLICABLE
Approach Roadway Align: 8 EQUAL TO PRESENT DESIRABLE CRITERIA
Bridge Railing Appraisal: 3 Meets Standards
Approach Guardrail: N/A N/A
Pier Navig Protection: N N/A

Deck Wearing Surf: A BARE DECK NO OVRLAY
Deck Membrane: F NONE
Deck Protection: A EPOXY COATED REINF
Total Deck Thick: 7.5
Last Paint Date: 10/2001

Single Unit Vehicles: Tons
Combination Type 3S-1: Tons
Combination Type 3S-2: Tons
One Truck At A Time: 0
Last Paint Type: U
FLD AL EPY & ACRLC

Underwater Inspection/Appraisal Information
Inspection Date:
Temperature:
Inspection Method:
Appraisal Rating:

Scour Critical Information
Evaluation Method:
Microfilm Data Recorded: Yes

Construction Information
Year: 1963 Original 2000 Reconstructed
Route: FAI-55 Sta: 166+00 FAI-55 Sta: 33+325
Section Nbr: 207-1516.2-CF 1515.2,1516.2
Contract Nbr: 82980
Fed Aid Pr#: I 0557111285 HPD-ACHPD-IM-5
Built By: 3 COUNTY AGENCY 1 I.D.O.T.

Miscellaneous

Pontis

Today's Date: 10/08/2015

Structure Number: 016-1084 District: 1 (41) Bridge Status: 1 OPEN - NO RESTRICT
 (6) Feature Crossed: ASHLAND AVE VIADUCT (7) Facility Carried: I- 55 EB ELEVATED
 (9) Location: 2.6 M SW I-90,94 (7A) Bridge Name:
 Element Inspection Date: 08/04/2015
 (90E) Agency Program Manager: AsfourSE (90E3) Consultant Program Manager:
 (90E1) Team Leader: CowleyJ (90E2) Inspector:

Element Insp. Delinquent		Element Insp. Delinquent Reason:									
Elem	Env	% 1	Qty 1	% 2	Qty 2	% 3	Qty 3	% 4	Qty 4	Tot Qty	
P/S Conc Open Girder											
109	4	100	354	0	0	0	0	0	0	354	
			No deterioration	Minor cracks/spalls	Delams/spalls	Analysis warranted					
Remarks:											
Reinforced Conc Column or Pile Extension											
205	4	100	68,687	0	120	0	0	0	0	68,807	
			No deterioration	Minor cracks/spalls	Delams/spalls	Analysis warranted					
Remarks: (Pier 32 not included, calc on 016-1086); Pier 6 Col#8 severe map crks; HL Map crks typ.											
Reinforced Conc Pier Wall											
210	4	100	27,524	0	0	0	10	0	0	27,534	
			No deterioration	Minor cracks/spalls	Delams/spalls	Analysis warranted					
Remarks: (Pier 32 not included, calc on 016-1086) Spalling on crashwall in CTA area. HL vert crks typ.											
Reinforced Conc Abutment											
215	4	100	1,178	0	0	0	0	0	0	1,178	
			No deterioration	Minor cracks/spalls	Delams/spalls	Analysis warranted					
Remarks: HL vert crks typ.											
Reinforced Conc Pier or Abutment Cap											
234	4	99	3,115	1	25	0	0	0	0	3,140	
			No deterioration	Minor cracks/spalls	Delams/spalls	Analysis warranted					
Remarks: map cracking in N end of pier 19											
Modular Joints											
303	4	100	385	0	0	0	0	0	0	385	
			No deterioration	Minor deterioration	Advanced corrosion	Corrosion is advance					
Remarks: (Pier 32 not included, calc on 016-1086)											
Elastomeric Bearing											
310	4	0	0	100	323	0	0	0	0	323	
			No deterioration	Minor deterioration	Major deterioration						
Remarks:											

Fixed Bearing										
313	4	0	0	100	52	0	0	0	0	52
		No deterioration	Minor deterioration		Advanced corrosion					
Remarks:										
Reinforced Concrete Approach Slab										
321	4	100	3,238	0	0	0	0	0	0	3,238
		No deterioration	Cracks/spalls	Major cracks/spalls		Broken/Unstable				
Remarks: HL -wide x-verse crks typ. near West Abut Exp Jnt (West End)										
Concrete Bridge Railing										
331	4	0	0	98	4,907	2	80	0	0	4,987
		No deterioration	Minor cracks/spalls	Analysis warranted						
Remarks: Light vert crking @ inside & outside face typ.										
Concrete Deck Protected w/ Coated Bars										
8026	4	97	190,863	3	5,750	0	0	0	0	196,613
Remarks: Dk Soffit- HL-wide trans leach crks in soffit.										
Non-Lead Painted Steel Open Girder										
8118	4	100	270,046	0	0	0	0	0	0	270,046
Remarks:										
Non-Lead Painted Steel Closed Web/Box Girder Ends										
8173	4	100	104	0	0	0	0	0	0	104
Remarks: (West row only @ pier32)										
Continuous Seal Neoprene Expansion Joint										
8308	4	38	24	63	40	0	0	0	0	64
Remarks: @ West Abut seal torn in all 3 lanes blocks worn and broken										
Approach Pavement										
8323	4	100	1	0	0	0	0	0	0	1
Remarks: @ West End- HL -wide x-verse crks typ.										



November 6, 2015

MEMORANDUM

Mr. John Fortmann, Region One Engineer
Illinois Department of Transportation
Region One/District One

Attn: Steven Schilke

RE: Existing S.N. 016-1085
W.B. I-55 over South Branch Chicago River
Cook County
PTB 158-002/P-91-762-10

The purpose of this technical memo is to summarize the current condition of existing S.N. 016-1085 in addition to geometrics and other factors. A cursory field check was performed to supplement the information contained in IDOT's structure summary report dated August 5, 2015 (see Appendix B). Broad-based recommendations for this structure are provided below.

The structure is a four span steel beam bridge consisting of nine lines of continuous beams (see Photo 1). Span lengths from west to east are 85'-3", 106'-5", 106'-5" and 87'-1". The superstructure is supported by pile bent abutments and reinforced concrete multi-column piers. There is no overlay on the structure.

IDOT rates the deck as being in good condition, which concurs with the findings from the cursory field check. Minor transverse cracks with leaching are visible on a majority of the soffit (see Photo 2). IDOT rates the substructure as being in good condition, which concurs with the findings from the cursory field check. Minor horizontal cracks are visible on the pier columns (see Photo 3). No notable defects or differences were observed between the cursory field check and IDOT's structure summary report for: superstructure, deck geometry, waterway adequacy, approach alignment, and bridge railing appraisal items. Anchor blocks are damaged along sections of the east expansion joint (see Photo 4).

Based on the structure summary report and field check, S.N. 016-1085 is suitable for reuse after rehabilitation of the substructure and expansion joints.



LIN ENGINEERING, LTD.
Consulting Engineers

Springfield, IL Westmont, IL

576 Oakmont Lane
Westmont, Illinois 60559
Telephone: (630) 323-5168
Fax: (630) 323-5174
E-mail: info@lineng.com

LIN ENGINEERING, LTD.

A handwritten signature in blue ink that reads "Michael T. Haley". The signature is written in a cursive style.

Michael T. Haley, PE, SE
Structural Manager

Appendix A – Photos

Appendix B – IDOT Structure Summary Report

Appendix C – PONTIS Report



Photo 1



Photo 2



Photo 3



Photo 4

**Illinois Department of Transportation
Structures Information Management System
Structure Summary Report**

Date: 10/27/2015
Page: 1

Structure Number: 016-1085 **District: 1**

Inventory Data	
Facility Carried:	I-55 WB ELEVATED
Feature Crossed:	S BR CHICAGO RIVER
Bridge Remarks:	1 OPEN - NO RESTRICT
Status Remarks:	016 COOK
Maint County:	01 I.D.O.T.
Service On/Under:	1 HIGHWAY
Reporting Agency:	1 I.D.O.T. - BUREAU OF MAINTENANCE
Main Span Matl/Type:	4 STEEL CONTINUOUS
Nbr Of Main Spans:	4
Approaches	
Near #1 Matl/Type:	0 None
Near #2 Matl/Type:	0 None
Far #1 Matl/Type:	0 None
Far #2 Matl/Type:	0 None
Median Width/Type:	0 Ft. / 0
Guardrail Type L/R:	0 None / 0 None
Toll Facility Indicator:	0 No Toll
Latitude:	41.8995218 S Longitude: 87.66349501
Deck Structure Type:	A CIP CON NRMALLY FORM
Sidewalks Under Structure:	0 None
Sufficiency Rating:	93.0
HBP Eligible:	No
Replaces:	-
Last Update Date:	06/21/2014
Parallel Structure:	Left
Multi-Level Structure Nbr:	1
Skew Angle:	15 D
Structure Flared:	No
Historical Significance:	No
Border Bridge State:	
Bdr State SN:	
Bdr State % Responsibility:	0
Structural Steel Wt:	1700000
Substructure Material:	
Rated By:	2 IDOT
Inventory Rating:	1.575(56)
Operating Rating:	2.625(94)
Design Load:	01 HS20+MOD
Deck Structure Thickness:	7.5 SD: N FO: N
RR Vertical Underclear:	0
RR Lateral Underclear:	0
RR Vertical Underclear:	0
RR Lateral Underclear:	0
Structure Length:	387.1
AASHTO Bridge Length:	99.9
Length of Long Span:	106.4
Bridge Roadway Width:	72.8
Appr Roadway Width:	88.0
Deck Width:	76.1
Sidewalk Width Right:	0.0
Sidewalk Width Left:	0.0
Navigation Control:	1
Navigation Horiz Clear:	90
Navigation Vert Clear:	31
Culvert Fill Depth:	0.0
Number Culvert Cells:	0
Culvert Opening Area:	0.0
Culvert Cell Height:	0.00
Culvert Cell Width:	0.00
Rate Method:	6
Load Rating Date:	12/14/2005
Crossing 1 Nbr:	
Crossing 1 Nbr:	
RR Lateral Underclear:	0
RR Vertical Underclear:	0

Key Route On Data		Key Route Under Data	
Key Route Nbr:	FEDERAL-AID INTERSTATE	Station:	
Appurtenances	Main Route	Segment:	
Inventory County:	016 COOK	Linked:	
Township/Road Dist	83 SOUTH CHICAGO (CHICAGO)	Natl. Hwy System:	
Municipality	1051 CHICAGO	Inventory Direction:	
Urban Area:	1051	Curr AADT Yr/Count:	/
Functional Class:	1 INTERSTATE	Est Truck Percentage:	
** CLEARANCES **	South/East	Number Of Lanes:	
Max Rdwy Width:	72.8	One Or Two Way:	
Horizontal:	74.0	Bypass Length:	
Future AADT Yr/Cnt:	2032 / 87087	Future AADT Yr/Cnt:	/
Designated Truck Rte:	CLASS I	Designated Truck Rte:	
Special Systems:	Yes	Special Systems:	
South/East	North/West	South/East	North/West

*** Marked Route On Data ***				*** Marked Route Under Data ***			
Route #	Designation	Kind	Number	Designation	Kind	Number	
Route #1:	1 Mainline	1 Interstate Highway	055				
Route #2:	1 Mainline						
Route #3:	1 Mainline						

**Illinois Department of Transportation
Structures Information Management System
Structure Summary Report**

Structure Number: 016-1085 District: 1

Data Related to Inspection Information

*** Inspection Intervals ***
 Routine NBIS: 24 MOS Underwater: 60 MOS One Truck At A Time: 0
 Special: N Single Unit Vehicles: Tons Combination Type 3S-1: Tons
 Bridge Posting Level: 5 No Posting Required

Inspection/Appraisal Information

Inspection Date: 08/05/2015 Inspection Temperature: 84Deg. F
 Deck: 7 GOOD CONDITION - SOME MINOR PROBLEMS
 Superstructure: 8 VERY GOOD CONDITION - NO PROBLEMS NOTED
 Substructure: 7 GOOD CONDITION - SOME MINOR PROBLEMS
 Culvert: N NOT APPLICABLE
 Channel and Protection: 8 VERY GOOD CONDITION - NO PROBLEMS NOTED
 Structural Evaluation: 7 BETTER THAN PRESENT MINIMUM CRITERIA
 Deck Geometry: 9 SUPERIOR TO PRESENT DESIRABLE CRITERIA
 Underclearance-Vert/Lat.: N NOT APPLICABLE
 Waterway Adequacy: 8 EQUAL TO PRESENT DESIRABLE CRITERIA
 Approach Roadway Align: 8 EQUAL TO PRESENT DESIRABLE CRITERIA
 Bridge Railing Appraisal: 3 Meets Standards
 Approach Guardrail: N/A N/A
 Pier Navig Protection: 2 IN PLACE AND FUNCTIONING

84Deg. F
 Single Unit Vehicles: Tons
 Combination Type 3S-1: Tons
 Combination Type 3S-2: Tons
 One Truck At A Time: 0
 Last Paint Type: S
 SHP ZINC&FLD ACRYL
 Deck Wearing Surf: A BARE DECK NO OVRLAY
 Deck Membrane: F NONE
 Deck Protection: A EPOXY COATED REINF
 Total Deck Thick: 7.5
 Last Paint Date: 07/2001

Underwater Inspection/Appraisal Information

Inspection Date: 10/12/2011
 Temperature: 75
 Inspection Method: DPSV Diver
 Appraisal Rating: 7
 Probe: Sonar
 Visual: GOOD - SMALL CRACKS IN UNDERWATER UNITS

Scour Critical Information

Rating: 8 CALCULATED SCOUR ABOVE FOOTING
 Analysis Date: 10/05/1995
 Evaluation Method: B Rational Analysis
 Microfilm Data Recorded: Yes

Construction Information

Year: 1963 Original
 Route: FAI-55 Reconstructed
 Section Nbr: 207-1616.6 Sta: 188+57.19 FAI-55 Sta: 166+00
 Contract Nbr: 1516.2-B
 Fed Aid Pr#: I 0557073285 82990
 Built By: 3 COUNTY AGENCY 1 I.D.O.T.

Pontis

Today's Date: 10/08/2015

Structure Number: 016-1085 District: 1 (41) Bridge Status: 1 OPEN - NO RESTRICT
 (6) Feature Crossed: S BR CHICAGO RIVER (7) Facility Carried: I-55 WB ELEVATED
 (9) Location: 1.1 M SW I-94 (7A) Bridge Name:
 Element Inspection Date: 08/05/2015
 (90E) Agency Program Manager: AsfourSE (90E3) Consultant Program Manager:
 (90E1) Team Leader: CowleyJ (90E2) Inspector:

Element Insp. Delinquent		Element Insp. Delinquent Reason:									
Elem	Env	% 1	Qty 1	% 2	Qty 2	% 3	Qty 3	% 4	Qty 4	Tot Qty	
Reinforced Conc Column or Pile Extension											
205	4	100	5,862	0	0	0	12	0	0	5,874	
		No deterioration	Minor cracks/spalls	Delams/spalls	Analysis warranted						
Remarks: Few small spalls											
Reinforced Conc Pier Wall											
210	4	100	5,409	0	0	0	0	0	0	5,409	
		No deterioration	Minor cracks/spalls	Delams/spalls	Analysis warranted						
Remarks: P33 West Face-map crks btwn Col 1&2											
Reinforced Conc Abutment											
215	4	100	865	0	0	0	0	0	0	865	
		No deterioration	Minor cracks/spalls	Delams/spalls	Analysis warranted						
Remarks: East Abut											
Reinforced Conc Pier or Abutment Cap											
234	4	100	416	0	0	0	0	0	0	416	
		No deterioration	Minor cracks/spalls	Delams/spalls	Analysis warranted						
Remarks:											
Modular Joints											
303	4	100	74	0	0	0	0	0	0	74	
		No deterioration	Minor deterioration	Advanced corrosion	Corrosion is advance						
Remarks: @Pier 32 adjacent to 016-1084											
Elastomeric Bearing											
310	4	0	0	100	36	0	0	0	0	36	
		No deterioration	Minor deterioration	Major deterioration							
Remarks:											
Fixed Bearing											
313	4	0	0	100	9	0	0	0	0	9	
		No deterioration	Minor deterioration	Advanced corrosion							
Remarks:											

Concrete Bridge Railing										
331	4	0	0	90	694	10	80	0	0	774
		No deterioration	Minor cracks/spalls		Analysis warranted					
Remarks: HL-wide Vertical cracking typical thru-out.										
Concrete Deck Protected w/ Coated Bars										
8026	4	88	24,617	12	3,250	0	0	0	0	27,867
Remarks: Soffit-Scattered leach crks. Dk Surface-Numerous trans crks & medium crking w/intersecting crks.										
Non-Lead Painted Steel Open Girder										
8118	4	100	33,806	0	0	0	0	0	0	33,806
Remarks:										
Non-Lead Painted Steel Closed Web/Box Girder Ends										
8173	4	100	18	0	0	0	0	0	0	18
Remarks:										
Neoprene Expansion Joint										
8307	4	100	74	0	0	0	0	0	0	74
Remarks: @ East Abut										
Approach Pavement										
8323	4	0	0	100	1	0	0	0	0	1
Remarks: HL - Med x-verse cracking @ East Apprch										



November 6, 2015

MEMORANDUM

Mr. John Fortmann, Region One Engineer
Illinois Department of Transportation
Region One/District One

Attn: Steven Schilke

RE: Existing S.N. 016-1086
E.B. I-55 over South Branch Chicago River
Cook County
PTB 158-002/P-91-762-10

The purpose of this technical memo is to summarize the current condition of existing S.N. 016-1086 in addition to geometrics and other factors. A cursory field check was performed to supplement the information contained in IDOT's structure summary report dated August 5, 2015 (see Appendix B). Broad-based recommendations for this structure are provided below.

The structure is a four span steel beam bridge consisting of ten lines of continuous beams (see Photo 1). Span lengths from west to east are 85'-3", 106'-5", 106'-5" and 87'-1". The superstructure is supported by a pile bent abutment and reinforced concrete multi-column piers. There is no overlay on the structure.

IDOT rates the deck as being in good condition, which concurs with the findings from the cursory field check. Moderate transverse cracks with leaching are visible on some sections of the soffit (see Photo 2). IDOT rates the superstructure as being in good condition, which concurs with the findings from the cursory field check. Possible fire damage to the beam ends is visible above the east abutment (see Photo 3). IDOT rates the substructure as being in good condition, which concurs with the findings from the cursory field check. Minor spalls are visible on pier walls located in the river (see Photo 4). No notable defects or differences were observed between the cursory field check and IDOT's structure summary report for: deck geometry, waterway adequacy, approach alignment and bridge railing appraisal items. Anchor blocks are damaged along sections of the east expansion joint (see Photo 5). Moderate transverse and longitudinal cracks are visible on the east approach slab. Some elastomeric bearings have shifted at the abutments (see Photo 6).

Based on the structure summary report and field check, S.N. 016-1086 is suitable for reuse after rehabilitation of the substructure and expansion joints.



LIN ENGINEERING, LTD.
Consulting Engineers

Springfield, IL Westmont, IL

576 Oakmont Lane
Westmont, Illinois 60559
Telephone: (630) 323-5168
Fax: (630) 323-5174
E-mail: info@lineng.com

LIN ENGINEERING, LTD.

A handwritten signature in blue ink that reads "Michael T. Haley". The signature is written in a cursive style.

Michael T. Haley, PE, SE
Structural Manager

Appendix A – Photos

Appendix B – IDOT Structure Summary Report

Appendix C – PONTIS Report



Photo 1



Photo 2



Photo 3



Photo 4



Photo 5



Photo 6

Illinois Department of Transportation
Structures Information Management System
Structure Summary Report

Structure Number: 016-1086 District: 1

Inventory Data	
Facility Carried:	I-55 EB ELEVATED
Feature Crossed:	S BR CHICAGO RIVER
Bridge Status:	1 OPEN - NO RESTRICT
Status Remarks:	016 COOK
Maint County:	01 I.D.O.T.
Service On/Under:	1 HIGHWAY
Reporting Agency:	1 I.D.O.T. - BUREAU OF MAINTENANCE
Main Span Matl/Type:	4 STEEL CONTINUOUS
Nbr Of Main Spans:	4
Approaches	
Near #1 Matl/Type:	/
Near #2 Matl/Type:	/
Far #1 Matl/Type:	/
Far #2 Matl/Type:	/
Median Width/Type:	0 Ft. / 0 None
Guardrail Type L/R:	0 None / 0 None
Toll Facility Indicator:	0 No Toll
Latitude:	41.82941538 S Longitude: 87.66368151 S
Deck Structure Type:	A CIP CON NRMALLY FORM
Sidewalks Under Structure:	0 None
Bridge Name:	1.1 M SW I-94
Location:	07/1999
Status Date:	83 SOUTH CHICAGO
Maint Township:	5 / WATERWAY
Inventory Rating:	1.725(62)
Operating Rating:	2.750(99)
Design Load:	01 HS20+MOD
Deck Structure Thickness:	7.5 SD: N FC: N
RR Vertical Underclear:	22 Ft 02 In
RR Lateral Underclear:	18.8 In
Rate Method:	6
Load Rating Date:	12/01/2000
Rated By:	2 IDOT
Key Route On Data	
Key Route Nbr:	FEDERAL-AID INTERSTATE 0055
Station:	14.8600
Appurtenances Main Route:	00000
Inventory County:	016 COOK
Township/Road Dist:	83 SOUTH CHICAGO (CHICAGO) Natl. Hwy System: On NHS
Municipality:	1051 CHICAGO
Urban Area:	1051
Functional Class:	1 INTERSTATE
** CLEARANCES **	South/East North/West
Max Rdwy Width:	68.9
Horizontal:	70.1
Vertical:	0.0
Inventory Rating:	1.725(62)
Operating Rating:	2.750(99)
Design Load:	01 HS20+MOD
Deck Structure Thickness:	7.5 SD: N FC: N
RR Vertical Underclear:	22 Ft 02 In
RR Lateral Underclear:	18.8 In
Rate Method:	6
Load Rating Date:	12/01/2000
Rated By:	2 IDOT

Key Route Under Data	
Station:	14.8600
Segment:	00000
Linked:	Y
Natl. Hwy System:	On NHS
Inventory Direction:	South/East North/West
Curr AADT Yr/Count:	2014 / 71800
Est Truck Percentage:	8
Number Of Lanes:	3
One Or Two Way:	1 One-Way
Bypass Length:	0
Future AADT Yr/Cnt:	2032 / 87087
Designated Truck Rte:	CLASS I
Special Systems:	Yes

Marked Route On Data		
Designation	Kind	Number
1 Mainline	1 Interstate Highway	055

Marked Route Under Data		
Designation	Kind	Number
1 Mainline	1 Interstate Highway	055

Illinois Department of Transportation
Structures Information Management System
Structure Summary Report

Structure Number: 016-1086 District: 1

Data Related to Inspection Information

*** Inspection Intervals ***
 Routine NBIS: 24 MOS Underwater: 60 MOS One Truck At A Time: 0
 Special: N Single Unit Vehicles: Tons Combination Type 3S-1: Tons
 Bridge Posting Level: 5 No Posting Required

Inspection/Appraisal Information

Inspection Date: 08/05/2015 Inspection Temperature: 84Deg. F
 Deck: 7 GOOD CONDITION - SOME MINOR PROBLEMS
 Superstructure: 7 GOOD CONDITION - SOME MINOR PROBLEMS
 Substructure: 7 GOOD CONDITION - SOME MINOR PROBLEMS
 Culvert: N NOT APPLICABLE
 Channel and Protection: 8 VERY GOOD CONDITION - NO PROBLEMS NOTED
 Structural Evaluation: 7 BETTER THAN PRESENT MINIMUM CRITERIA
 Deck Geometry: 9 SUPERIOR TO PRESENT DESIRABLE CRITERIA
 Underclearance-Vert/Lat.: N NOT APPLICABLE
 Waterway Adequacy: 8 EQUAL TO PRESENT DESIRABLE CRITERIA
 Approach Roadway Align: 8 EQUAL TO PRESENT DESIRABLE CRITERIA
 Bridge Railing Appraisal: 3 Meets Standards
 Approach Guardrail: N/A N/A
 Pier Navig Protection: 2 IN PLACE AND FUNCTIONING

*** Maximum Allowable Posting Limits ***
 Combination Type 3S-1: Tons
 Combination Type 3S-2: Tons
 Single Truck At A Time: 0
 Deck Wearing Surf: A BARE DECK NO OVRLAY
 Deck Membrane: F NONE
 Deck Protection: A EPOXY COATED REINF
 Total Deck Thick: 7.5
 Last Paint Date: 07/2001
 Single Unit Vehicles: Tons
 Combination Type 3S-1: Tons
 Combination Type 3S-2: Tons
 One Truck At A Time: 0
 Last Paint Type: S
 SHP ZINC&FLD ACRYL

Underwater Inspection/Appraisal Information

Inspection Date: 10/12/2011
 Temperature: 75
 Inspection Method: DPSV Diver
 Appraisal Rating: 7
 Probe: GOOD - SMALL CRACKS IN UNDERWATER UNITS
 Sonar: Visual

Scour Critical Information

Rating: 8 CALCULATED SCOUR ABOVE FOOTING
 Analysis Date: 10/05/1995
 Evaluation Method: B Rational Analysis
 Microfilm Data Recorded: Yes

Construction Information

Year: 1963 Original
 Route: FAI-55 Reconstructed
 Section Nbr: 207-1616.6
 Contract Nbr: 82980
 Fed Aid Pr#: I 0557073285
 Built By: 3 COUNTY AGENCY
 Sta: 188+57.19 FAI-55
 Sta: 33+764.979
 1616.6 CF
 82980
 HPD-ACHPD-IM-5
 1 I.D.O.T.

Pontis

Today's Date: 10/08/2015

Structure Number: 016-1086 District: 1 (41) Bridge Status: 1 OPEN - NO RESTRICT
 (6) Feature Crossed: S BR CHICAGO RIVER (7) Facility Carried: I- 55 EB ELEVATED
 (9) Location: 1.1 M SW I-94 (7A) Bridge Name:
 Element Inspection Date: 08/05/2015
 (90E) Agency Program Manager: AsfourSE (90E3) Consultant Program Manager:
 (90E1) Team Leader: CowleyJ (90E2) Inspector:

Element Insp. Delinquent		N		Element Insp. Delinquent Reason:						
Element Description										
Elem	Env	% 1	Qty 1	% 2	Qty 2	% 3	Qty 3	% 4	Qty 4	Tot Qty
Reinforced Conc Column or Pile Extension										
205	3	100	5,557	0	0	0	20	0	0	5,577
		No deterioration	Minor cracks/spalls	Delams/spalls	Analysis warranted					
Remarks: Few small spalls @ Pier 33 & P34 (from collisions).										
Reinforced Conc Pier Wall										
210	3	100	10,830	0	10	0	0	0	0	10,840
		No deterioration	Minor cracks/spalls	Delams/spalls	Analysis warranted					
Remarks: Pier 34 N end e face										
Reinforced Conc Abutment										
215	3	91	481	9	48	0	0	0	0	529
		No deterioration	Minor cracks/spalls	Delams/spalls	Analysis warranted					
Remarks: Shallow backwall & haunch spalls @ East Abutment near fire damaged beams #6,7&8.										
Reinforced Conc Pier or Abutment Cap										
234	3	100	392	0	0	0	0	0	0	392
		No deterioration	Minor cracks/spalls	Delams/spalls	Analysis warranted					
Remarks:										
Modular Joints										
303	4	100	78	0	0	0	0	0	0	78
		No deterioration	Minor deterioration	Advanced corrosion	Corrosion is advance					
Remarks: @P32 adjacent to 016-1084										
Elastomeric Bearing										
310	4	93	37	0	0	8	3	0	0	40
		No deterioration	Minor deterioration	Mejor deterioration						
Remarks: Fire damage to beam 6,7 & 8 at East Abutment.										
Fixed Bearing										
313	4	100	10	0	0	0	0	0	0	10
		No deterioration	Minor deterioration	Advanced corrosion						
Remarks:										

Concrete Bridge Railing										
331	4	0	0	87	674	13	100	0	0	774
		No deterioration	Minor cracks/spalls		Analysis warranted					
Remarks: Vertical cracking typical thru-out										
Concrete Deck Protected w/ Coated Bars										
8026	4	91	26,781	9	2,525	0	0	0	0	29,306
Remarks: Dk Soffit-Scattered leach crks. Dk Surface-HL-med transverse crks (All lanes). CS2 near east abut										
Non-Lead Painted Steel Open Girder										
8118	4	96	38,258	4	1,500	0	0	0	0	39,758
Remarks: Minor fire damage at East abut, Bms 6,7&8 (though paint intact) mostly soot covered. end diaphragms have some paint loss										
Non-Lead Painted Steel Closed Web/Box Girder Ends										
8173	4	85	17	15	3	0	0	0	0	20
Remarks: Fire damage to Bm# 6,7&8, diaphragms on either side, @East Abutment.										
Continuous Seal Neoprene Expansion Joint										
8308	4	0	0	100	78	0	0	0	0	78
Remarks: East Abut gland torn sealant around blocks worn off										
Approach Pavement										
8323	4	100	1	0	0	0	0	0	0	1
Remarks: East Apprch- HL-med x-verse crks typ.										



October 27, 2015

MEMORANDUM

Mr. John Fortmann, Region One Engineer
Illinois Department of Transportation
Region One/District One

Attn: Steven Schilke

RE: Existing S.N. 016-2021
I-55 over CN Spur
Cook County
PTB 158-002/P-91-762-10

The purpose of this technical memo is to summarize the current condition of existing S.N. 016-2021 in addition to geometrics and other factors. A cursory field check was performed to supplement the information contained in IDOT's structure summary report dated July 7, 2014 (see Appendix B). Broad-based recommendations for this structure are provided below.

The structure is single cell reinforced concrete culvert with a clear height of 22.00 ft. and a clear width of 20.10 ft. (see Photo 1).

A large fence prevented access to the culvert during the cursory field check. During the cursory field check it was noted that the CN Spur has been abandoned and no longer connects to any main line track. S.N. 016-2021 no longer serves a purpose and should be entirely removed.

LIN ENGINEERING, LTD.

Michael T. Haley, PE, SE
Structural Manager

Appendix A – Photos

Appendix B – IDOT Structure Summary Report

Appendix C – PONTIS Report



Photo 1

Structure Number: 016-2021 District: 1

Inventory Data	
Facility Carried:	I-55 STEVENSON
Feature Crossed:	RR - CN SPUR
Bridge Status:	1 OPEN - NO RESTRICT
Status Remarks:	016 COOK
Maint County:	01 I.D.O.T.
Service On/Under:	1 HIGHWAY
Reporting Agency:	1 I.D.O.T. - BUREAU OF MAINTENANCE
Main Span Matl/Type:	1 CONCRETE
Nbr Of Main Spans:	1
Approaches	
Near #1 Matl/Type:	/
Near #2 Matl/Type:	/
Far #1 Matl/Type:	/
Far #2 Matl/Type:	/
Median Width/Type:	20 Ft. / 1 Open Median
Guardrail Type L/R:	0None / 0
Toll Facility Indicator:	0 No Toll
Latitude:	41.79652099
Deck Structure Type:	S Longitude:
Sidewalks Under Structure:	0 None
Key Route On Data	
Key Route Nbr:	FEDERAL-AID INTERSTATE
Appurtenances Main Route	0055 Station: 6.7500
Inventory County:	016 COOK
Township/Road Dist	16 LYONS
Municipality	5620 SUMMIT
Urban Area:	1051
Functional Class:	1 INTERSTATE
** CLEARANCES **	South/East North/West
Max Rdwy Width:	0.0
Horizontal:	112.0
Vertical:	0.0
Designated Truck Rte:	CLASS I
Special Systems:	Yes
Designation	Interstate Highway
Kind	1
Number	055

Key Route Under Data	
Station:	
Segment:	
Linked:	
Natl. Hwy System:	
Inventory Direction:	
Curr AADT Yr/Count:	/
Est Truck Percentage:	
Number Of Lanes:	
One Or Two Way:	
Bypass Length:	
Future AADT Yr/Cnt:	/
Designated Truck Rte:	
Special Systems:	
Designation	North/West
Kind	South/East
Number	

Illinois Department of Transportation
Structures Information Management System
Structure Summary Report

Structure Number: 016-2021 District: 1

*** Inspection Intervals ***
Routine NBIS: 24 MOS Underwater: 0 MOS Special: N
One Truck At A Time: 0
Single Unit Vehicles: Tons
Combination Type 3S-1: Tons
Combination Type 3S-2: Tons
Bridge Posting Level: 5 No Posting Required

Data Related to Inspection Information
*** Maximum Allowable Posting Limits ***
Inspection/Apraisal Information

Inspection Date: 07/07/2014 Inspection Temperature: 88Deg. F
Deck: N NOT APPLICABLE
Superstructure: N NOT APPLICABLE
Substructure: N NOT APPLICABLE
Culvert: 6 SATISFACTORY CONDITION - MINOR DETERIORATION
Channel and Protection: N NOT APPLICABLE
Structural Evaluation: 6 EQUAL TO PRESENT MINIMUM CRITERIA
Deck Geometry: 9 SUPERIOR TO PRESENT DESIRABLE CRITERIA
Underclearance-Vert/Lat.: 4 MINIMUM ADEQUACY TO BE LEFT IN PLACE
Waterway Adequacy: N NOT APPLICABLE
Approach Roadway Align: 8 EQUAL TO PRESENT DESIRABLE CRITERIA
Bridge Railing Appraisal: N/A
Approach Guardrail: N3N Acceptable N/A
Pier Navig Protection: N N/A

Deck Wearing Surf: N N/A - NO DECK
Deck Membrane: N N/A
Deck Protection: N N/A
Total Deck Thick: 0.0
Last Paint Date:

Single Unit Vehicles: Tons
Combination Type 3S-1: Tons
Combination Type 3S-2: Tons
One Truck At A Time: 0
Last Paint Type:

** Actual Posted Limits **

Underwater Inspection/Appraisal Information

Inspection Date:
Temperature:
Inspection Method:
Appraisal Rating:

Scour Critical Information
Evaluation Method:
Microfilm Data Recorded: Yes

Construction Information

Year: 1964 Original Reconstructed
Route: I-55 Sta:
Section Nbr: 0707-612VB
Contract Nbr:
Fed Aid Pr#: 00000000000000
Built By: 0 UNKNOWN

Pontis

Today's Date: 08/27/2015

Structure Number: 016-2021 District: 1 (41) Bridge Status: 1 OPEN - NO RESTRICT
 (6) Feature Crossed: RR - CN SPUR (7) Facility Carried: I- 55 STEVENSON
 (9) Location: 0.5 M W IL 43 (7A) Bridge Name:
 Element Inspection Date: 07/07/2014
 (90E) Agency Program Manager: MastnySC (90E3) Consultant Program Manager:
 (90E1) Team Leader: Sedlacek, J.L. (90E2) Inspector:

Element Insp. Delinquent		Element Insp. Delinquent Reason:									
Elem	Env	% 1	Qty 1	% 2	Qty 2	% 3	Qty 3	% 4	Qty 4	Tot Qty	
Reinforced Conc Abutment											
215	4	81	1,192	15	220	4	64	0	0	1,476	
		No deterioration	Minor cracks/spalls	Delams/spalls	Analysis warranted						
Remarks: WWs leaning @ NE, SE & SW; Wings have crking w/shallow spalls w/ exp rebar											
Concrete Culvert											
241	4	90	374	0	0	10	40	0	0	414	
		No deterioration	Minor deterioration	Moderate deteriorati	Major deterioration						
Remarks: Inside each end spalling w/ exp rebar; Numerous vert leach crks; Top has numerous trans leach crks beneath roadway											
Culvert Settlement											
8460	4	0	0	100	4	0	0	0	0	4	
Remarks: @NE, NW, SE & SW wingwalls											



October 27, 2015

MEMORANDUM

Mr. John Fortmann, Region One Engineer
Illinois Department of Transportation
Region One/District One

Attn: Steven Schilke

RE: Existing S.N. 016-2665
US 12/20/45 (La Grange Rd.) over I-55
Cook County
PTB 158-002/P-91-762-10

The purpose of this technical memo is to summarize the current condition of existing S.N. 016-2665 in addition to geometrics and other factors. A cursory field check was performed to supplement the information contained in IDOT's structure summary report dated November 20, 2014 (see Appendix B). Broad-based recommendations for this structure are provided below.

The structure is a two span steel girder bridge consisting of twelve lines of continuous girders (see Photo 1). Both spans are 137'-11" in length. The superstructure is supported by vaulted abutments and a reinforced concrete multi-column pier. There is no overlay on the structure.

IDOT rates the deck as being in good condition, which concurs with the findings from the cursory field check. Minor transverse cracks are visible on a majority of top of deck. IDOT rates the superstructure as being in good condition, which concurs with the findings from the cursory field check. Moderate paint peeling and rusting is visible on the girder bottom flanges (see Photo 2). IDOT rates the substructure as being in good condition, which concurs with the findings from the cursory field check. Minor vertical cracking with leaching is visible on abutments (see Photo3). IDOT rates the underclearance vertical and lateral as being intolerable requiring a high priority of corrective action, which concurs with the findings from the cursory field check. Impact damage is visible on the east exterior girder over W.B. I-55 traffic (see Photo 4). No notable defects or differences were observed between the cursory field check and IDOT's structure summary report for: deck geometry, approach alignment, bridge railing appraisal and approach guardrail items. Anchor blocks are damaged or missing along sections of both expansion joints. Minor to moderate longitudinal and diagonal cracks are visible on both approach slabs (see Photo 5).

Based on the structure summary report and field check, S.N. 016-2665 is suitable for reuse after rehabilitation of the superstructure and expansion joints. The approach guardrail ends should be brought up to current IDOT standards.



LIN ENGINEERING, LTD.
Consulting Engineers

Springfield, IL Westmont, IL

576 Oakmont Lane
Westmont, Illinois 60559
Telephone: (630) 323-5168
Fax: (630) 323-5174
E-mail: info@lineng.com

LIN ENGINEERING, LTD.

A handwritten signature in blue ink that reads "Michael T. Haley". The signature is fluid and cursive.

Michael T. Haley, PE, SE
Structural Manager

Appendix A – Photos

Appendix B – IDOT Structure Summary Report

Appendix C – PONTIS Report



Photo 1



Photo 2



Photo 3

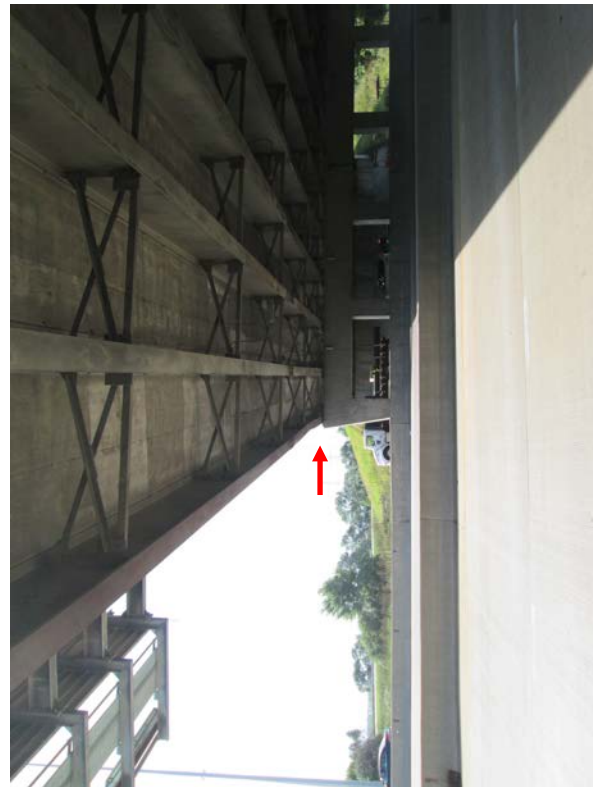


Photo 4



Photo 5

**Illinois Department of Transportation
Structures Information Management System
Structure Summary Report**

Structure Number: 016-2665 District: 1

Inventory Data

Facility Carried: US 12,20,45 LAGRANGE
 Feature Crossed: I-55 STEVENSON
 Bridge Remarks: 1 OPEN - NO RESTRICT
 Status Remarks: BRIDGE OPENED AUTOMATICALLY BY KEY ROUTE ON UPDATE TRANSACTION
 Maint County: 016 COOK
 Maint Township: 16 LYONS
 Maint Responsibility: 01 I.D.O.T.
 Service On/Under: 5 SECOND LEVEL INTERCHANGE 1 / HIGHWAY
 Reporting Agency: 1 I.D.O.T. - BUREAU OF MAINTENANCE
 Main Span Matl/Type: 4 STEEL CONTINUOUS / 02 STRINGERMULTI-BEAM/GIRDER
 Nbr Of Main Spans: 2 Nbr Of Approach Spans: 2
 Approaches
 Near #1 Matl/Type:
 Near #2 Matl/Type:
 Far #1 Matl/Type:
 Far #2 Matl/Type:
 Median Width/Type: 4 Ft. / 3 Curb / 0
 Guardrail Type L/R: 0 None / 0
 Toll Facility Indicator: 0 No Toll
 Latitude: 41.76167491 S Longitude: 87.86747868 S
 Deck Structure Type: A CIP CON NRMALLY FORM
 Sidewalks Under Structure: 0 None

Sufficiency Rating: 96.0 Structure Length: 325.5
 HBP Eligible: No AASHTO Bridge Length: 99.9
 Replaced By: - Length of Long Span: 137.8
 Replaces: 016-0340 Bridge Roadway Width: 95.6
 Last Update Date: 07/05/2012 Appr Roadway Width: 94.6
 Parallel Structure: None Deck Width: 101.9
 Multi-Level Structure Nbr:
 Skew Direction: R Right Sidewalk Width Right: 0.0
 Skew Angle: 8 D Navigation Control: 0 No
 Structure Flared: No Navigation Horiz Clear: 0
 Historical Significance: No Navigation Vert Clear: 0
 Border Bridge State: Culvert Fill Depth: 0.0
 Bdr State SN: Number Culvert Cells: 0
 Bdr State % Responsibility: 0 Culvert Opening Area: 0.0
 Structural Steel Wt: 838430 Culvert Cell Height: 0.00
 Substructure Material: Culvert Cell Width: 0.00
 Rated By: 2 IDOT Rate Method: 6
 Inventory Rating: 1.130(40) Load Rating Date: 01/07/2008 Railroad Crossing Info
 Operating Rating: 1.885(67) Crossing 1 Nbr:
 Design Load: Deck Structure Thickness: 7.7 SD: N FC: Y RR Lateral Underclear: 0.0
 RR Vertical Underclear: 0 Ft 0 In

Key Route On Data

Key Route Nbr:	FEDERAL-AID PRIMARY	Station:	28.1700
Appurtenances Main Route	00000	Segment:	Y
Inventory County:	016 COOK	Linked:	Y
Township/Road Dist	16 LYONS	Natl. Hwy System:	On NHS
Municipality	2645 HODGKINS	Inventory Direction:	
Urban Area:	1051	Curr AADT Yr/Count:	2013 / 76200
Functional Class:	3 OTHER PRINCIPAL ARTERIAL	Est Truck Percentage:	8
** CLEARANCES **	South/East	Number Of Lanes:	4
Max Rdwy Width:	95.6	One Or Two Way:	2 Two-Way
Horizontal:	47.8	Bypass Length:	0
		Future AADT Yr/Cnt:	2032 / 76529
		Designated Truck Rte:	CLASS II
Special Systems:		Special Systems:	Yes

Key Route Under Data

Key Route Nbr:	FEDERAL-AID INTERSTATE	Station:	2.5700
Main Route	00000	Segment:	Y
Inventory County:	16 LYONS	Linked:	Y
Township/Road Dist	1272 COUNTRYSIDE	Natl. Hwy System:	On NHS
Municipality	1051	Inventory Direction:	
Urban Area:	1	Curr AADT Yr/Count:	2014 / 131800
Functional Class:	1 INTERSTATE	Est Truck Percentage:	9
** CLEARANCES **	South/East	Number Of Lanes:	6
Max Rdwy Width:	36.0	One Or Two Way:	2 Two-Way
Horizontal:	50.0	Bypass Length:	0
		Future AADT Yr/Cnt:	2032 / 171598
		Designated Truck Rte:	CLASS I
Special Systems:		Special Systems:	Yes

****** Marked Route On Data ******

Route #:	Designation	Kind	Number
1	Mainline	1	012
2	U.S. Highways	2	020
3	U.S. Highways	2	045

****** Marked Route Under Data ******

Route #:	Designation	Kind	Number
1	Mainline	1	055
2	U.S. Highways	2	020
3	U.S. Highways	2	045

Illinois Department of Transportation
Structures Information Management System
Structure Summary Report

Structure Number: 016-2665 District: 1

Data Related to Inspection Information

*** Inspection Intervals ***
 Routine NBIS: 24 MOS Underwater: 0 MOS One Truck At A Time: 0 Tons Combination Type 3S-1: Tons
 Special: N Single Unit Vehicles: Tons Combination Type 3S-2: Tons
 Bridge Posting Level: 5 No Posting Required

Inspection/Appraisal Information

Inspection Date: 11/20/2014 Inspection Temperature: 43Deg. F
 Deck: 7 GOOD CONDITION - SOME MINOR PROBLEMS
 Superstructure: 7 GOOD CONDITION - SOME MINOR PROBLEMS
 Substructure: 7 GOOD CONDITION - SOME MINOR PROBLEMS
 Culvert: N NOT APPLICABLE
 Channel and Protection: N NOT APPLICABLE
 Structural Evaluation: 7 BETTER THAN PRESENT MINIMUM CRITERIA
 Deck Geometry: 9 SUPERIOR TO PRESENT DESIRABLE CRITERIA
 Underclearance-Vert/Lat.: 3 INTOLERABLE - HIGH PRIORITY FOR CORRECTION
 Waterway Adequacy: N NOT APPLICABLE
 Approach Roadway Align: 8 EQUAL TO PRESENT DESIRABLE CRITERIA
 Bridge Railing Appraisal: 3 Meets Standards
 Approach Guardrail: 332 Acceptable Not Acceptable
 Pier Navig Protection: N N/A

Deck Wearing Surf: A BARE DECK NO OVRLAY
 Deck Membrane: F NONE
 Deck Protection: A EPOXY COATED REINF
 Total Deck Thick: 7.7
 Last Paint Date: 05/1996

Underwater Inspection/Appraisal Information

Inspection Date: Inspection Method: Appraisal Rating:
 Temperature:

Scour Critical Information

Rating: Evaluation Method: Microfilm Data Recorded: Yes
 Analysis Date:

Construction Information

Year: 1995 Original Reconstructed
 Route: FAP330 Sta: 9+487.034
 Section Nbr: 0203-632 HB-K-1
 Contract Nbr: 82184
 Fed Aid Pr#: 1 I.D.O.T.
 Built By:

Pontis

Today's Date: 08/27/2015

Structure Number: 016-2665 District: 1 (41) Bridge Status: 1 OPEN - NO RESTRICT
 (6) Feature Crossed: I- 55 STEVENSON (7) Facility Carried: US 12,20,45 LAGRANGE
 (9) Location: 5 M SW IL 43 (7A) Bridge Name:
 Element Inspection Date: 11/20/2014
 (90E) Agency Program Manager: LandersJJ (90E3) Consultant Program Manager:
 (90E1) Team Leader: KhalilJS (90E2) Inspector:

Element Insp. Delinquent		Element Insp. Delinquent Reason:									
Elem	Env	% 1	Qty 1	% 2	Qty 2	% 3	Qty 3	% 4	Qty 4	Tot Qty	
Reinforced Conc Column or Pile Extension											
205	4	100	503	0	0	0	0	0	0	503	
		No deterioration	Minor cracks/spalls	Delams/spalls	Analysis warranted						
Remarks:											
Reinforced Conc Pier Wall											
210	4	100	1,268	0	0	0	0	0	0	1,268	
		No deterioration	Minor cracks/spalls	Delams/spalls	Analysis warranted						
Remarks:											
Reinforced Conc Abutment											
215	4	100	3,539	0	0	0	0	0	0	3,539	
		No deterioration	Minor cracks/spalls	Delams/spalls	Analysis warranted						
Remarks: Superficial cracking with no rust stains @ both abutments.											
Reinforced Conc Pier or Abutment Cap											
234	4	100	404	0	0	0	0	0	0	404	
		No deterioration	Minor cracks/spalls	Delams/spalls	Analysis warranted						
Remarks:											
Elastomeric Bearing											
310	4	0	0	0	0	100	24	0	0	24	
		No deterioration	Minor deterioration	Major deterioration							
Remarks: Bottom & top plates and retainer angles have surface rust present @ abutments.											
Fixed Bearing											
313	4	0	0	100	12	0	0	0	0	12	
		No deterioration	Minor deterioration	Advanced corrosion							
Remarks:											
Reinforced Concrete Approach Slab											
321	4	85	4,055	0	0	15	715	0	0	4,770	
		No deterioration	Cracks/spalls	Major cracks/spalls	Broken/Unstable						
Remarks: S. approach in SBL 2 & 3 have measurable cracks (2/16"). N. approach have minor cracking thru-out NB & SB Lanes. Estimated at 15%											

Concrete Bridge Railing										
331	4	0	0	100	649	0	0	0	0	649
		No deterioration		Minor cracks/spalls	Analysis warranted					
Remarks:										
Concrete Deck Protected w/ Coated Bars										
8026	4	95	26,887	5	1,415	0	0	0	0	28,302
Remarks: Very minor transv. cracks in wearing surface at random areas (estimated @ 5%).										
Non-Lead Painted Steel Open Girder										
8118	4	92	38,829	8	3,376	0	0	0	0	42,205
Remarks: Paint chalking & peeling @ S. & N. Fascia and interior beams on bottom flanges and webs (estimated @ 8%).										
Non-Lead Painted Steel Closed Web/Box Girder Ends										
8173	4	100	24	0	0	0	0	0	0	24
Remarks:										
Continuous Seal Neoprene Expansion Joint										
8308	4	0	0	97	196	3	7	0	0	203
Remarks: North joint in NBL 3 loose 4' section & South joint in SBL 1 & 2 loose 3' section. Remaining joint worn and evidence of leakage.										



October 27, 2015

MEMORANDUM

Mr. John Fortmann, Region One Engineer
Illinois Department of Transportation
Region One/District One

Attn: Steven Schilke

RE: Existing S.N. 016-2678
I-294 Ramps over I-55
Cook County
PTB 158-002/P-91-762-10

The purpose of this technical memo is to summarize the current condition of existing S.N. 016-2678 in addition to geometrics and other factors. A cursory field check was performed to supplement the information contained in IDOT's structure summary report dated July 24, 2014 (see Appendix B). Broad-based recommendations for this structure are provided below.

The structure is a two span steel girder bridge consisting of eight lines of continuous curved girders (see Photo 1). Span lengths along the tangent from south to north are 119'-1¹⁵/₁₆" and 99'-1⁷/₈". The superstructure is supported by vaulted abutments and a reinforced concrete multi-column pier. There is no overlay on the structure.

IDOT rates the deck as being in good condition, which concurs with the findings from the cursory field check. Minor transverse cracks with leaching are visible on a majority of the soffit (see Photo 2). IDOT rates the substructure as being in very good condition, which concurs with the findings from the cursory field check. Minor full height cracking is visible on the abutments (see Photo 3). IDOT rates the underclearance vertical and lateral as being intolerable requiring a high priority of corrective action. The findings from the cursory field check don't match IDOT's underclearance rating. The underclearance appears to meet the minimum requirements to be left in place as is. No notable defects or differences were observed between our cursory field check and IDOT's structure summary report for: superstructure, deck geometry, approach alignment, bridge railing appraisal and approach guardrail items.

Based on the structure summary report and field check, S.N. 016-2678 is suitable for reuse without rehabilitation. The approach guardrail transitions should be brought up to current IDOT standards.



LIN ENGINEERING, LTD.
Consulting Engineers

Springfield, IL Westmont, IL

576 Oakmont Lane
Westmont, Illinois 60559
Telephone: (630) 323-5168
Fax: (630) 323-5174
E-mail: info@lineng.com

LIN ENGINEERING, LTD.

A handwritten signature in blue ink that reads "Michael T. Haley". The signature is written in a cursive, flowing style.

Michael T. Haley, PE, SE
Structural Manager

Appendix A – Photos

Appendix B – IDOT Structure Summary Report

Appendix C – PONTIS Report



Photo 1



Photo 2



Photo 3

**Illinois Department of Transportation
Structures Information Management System
Structure Summary Report**

Structure Number: 016-2678 District: 1

Inventory Data	
Facility Carried:	I-294 RAMPS I-55
Feature Crossed:	I-55 STEVENSON
Bridge Remarks:	
Bridge Status:	1 OPEN - NO RESTRICT
Status Remarks:	BRIDGE OPENED AUTOMATICALLY BY KEY ROUTE ON UPDATE TRANSACTION
Maint County:	016 COOK
Maint Responsibility:	01 I.D.O.T.
Service On/Under:	5 SECOND LEVEL INTERCHANGE 1 / HIGHWAY
Reporting Agency:	1 I.D.O.T. - BUREAU OF MAINTENANCE
Main Span Matl/Type:	4 STEEL CONTINUOUS
Nbr Of Main Spans:	2 Nbr Of Approach Spans: 2
Approaches	
Near #1 Matl/Type:	5 PRESTRESS CONCRETE
Near #2 Matl/Type:	/
Far #1 Matl/Type:	5 PRESTRESS CONCRETE
Far #2 Matl/Type:	/
Median Width/Type:	0 Ft./0 None
Guardrail Type L/R:	0 None / 0 None
Toll Facility Indicator:	0 No Toll
Latitude:	41.75921052 S Longitude: 87.90219193 S
Deck Structure Type:	A CIP CON NRMLLY FORM
Sidewalks Under Structure:	0 None

Inventory Data		
Bridge Name:	Location:	1.8 M W US 45 P10
Sufficiency Rating:	96.0	Structure Length: 295.4
HBP Eligible:	No	AASHTO Bridge Length: 99.9
Replaced By:	-	Length of Long Span: 117.5
Last Update Date:	07/05/2012	Appr Roadway Width: 56.0
Parallel Structure:	None	Deck Width: 61.4
Multi-Level Structure Nbr:	0	Sidewalk Width Right: 0.0
Skew Direction:	L	Sidewalk Width Left: 0.0
Skew Angle:	20 D	Navigation Control: N
Structure Flared:	No	Navigation Horiz Clear: 0
Historical Significance:	No	Navigation Vert Clear: 0
Border Bridge State:		Culvert Fill Depth: 0.0
Bdr State SN:		Number Culvert Cells: 0
Bdr State % Responsibility:	590000	Culvert Opening Area: 0.0
Structural Steel Wt:		Culvert Cell Height: 0.00
Substructure Material:		Culvert Cell Width: 0.00
Rated By:	2 IDOT	Rate Method: 6
Load Rating Date:	02/24/2003	Load Rating Date: 02/24/2003
Design Load:	02 HS20	Crossing 1 Nbr: 1
Deck Structure Thickness:	7.5 SD: N	Crossing 1 Nbr: 1
RR Vertical Underclear:	0	RR Lateral Underclear: 0.0
		RR Vertical Underclear: 0
		Ft 0 In

Key Route On Data		Key Route Under Data	
Key Route Nbr:	FEDERAL-AID INTERSTATE	Station:	0055
Appurtenances:	Ramp	Segment:	00000
Inventory County:	016 COOK	Linked:	Y
Township/Road Dist:	16 LYONS	Natl. Hwy System:	On NHS
Municipality:	2760 INDIAN HEAD PARK	Inventory Direction:	INDIAN HEAD PARK
Urban Area:	1051	Curr AADT Yr/Count:	2014 / 152300
Functional Class:	1 INTERSTATE	Est Truck Percentage:	8
** CLEARANCES **	South/East	Number Of Lanes:	7
Max Rdwy Width:	28.0	One Or Two Way:	2 Two-Way
Horizontal:	29.2	Bypass Length:	0
		Future AADT Yr/Cnt:	2032 / 170465
		Designated Truck Rte:	CLASS 1
		Special Systems:	Yes

*** Marked Route On Data ***			*** Marked Route Under Data ***		
Route #1:	1 Mainline	Designation	1 Mainline	Kind	Number
Route #2:	1 Mainline		1 Mainline	Interstate Highway	055
Route #3:	1 Mainline		1 Mainline		

Illinois Department of Transportation
Structures Information Management System
Structure Summary Report

Structure Number: 016-2678 District: 1

*** Inspection Intervals ***

Routine NBIS: 24 MOS Underwater: 0 MOS Special: N
 One Truck At A Time: 0 Tons
 Combination Type 3S-1: Tons
 Combination Type 3S-2: Tons
 Bridge Posting Level: 5 No Posting Required

*** Maximum Allowable Posting Limits ***

Inspection Date: 07/24/2014 Inspection Temperature: 74Deg. F

Deck: 7 GOOD CONDITION - SOME MINOR PROBLEMS
 Superstructure: 8 VERY GOOD CONDITION - NO PROBLEMS NOTED
 Substructure: 8 VERY GOOD CONDITION - NO PROBLEMS NOTED
 Culvert: N NOT APPLICABLE
 Channel and Protection: N NOT APPLICABLE
 Structural Evaluation: 8 EQUAL TO PRESENT DESIRABLE CRITERIA
 Deck Geometry: 9 SUPERIOR TO PRESENT DESIRABLE CRITERIA
 Underclearance-Vert/Lat.: 3 INTOLERABLE - HIGH PRIORITY FOR CORRECTION
 Waterway Adequacy: N NOT APPLICABLE
 Approach Roadway Align: 8 EQUAL TO PRESENT DESIRABLE CRITERIA
 Bridge Railing Appraisal: 3 Meets Standards
 Approach Guardrail: 233 Not Acceptable Acceptable
 Pier Navig Protection: N N/A

Inspection/Appraisal Information

Deck Wearing Surf: A BARE DECK NO OVRLAY
 Deck Membrane: F NONE
 Deck Protection: A EPOXY COATED REINF
 Total Deck Thick: 7.5
 Last Paint Date: 06/2003
 Single Unit Vehicles: Tons
 Combination Type 3S-1: Tons
 Combination Type 3S-2: Tons
 One Truck At A Time: 0
 Last Paint Type: S
 SHP ZINC&FLD ACRYL

*** Actual Posted Limits ***

Inspection Date: Inspection Method: Appraisal Rating:
 Temperature: Evaluation Method:

Scour Critical Information

Rating: Evaluation Method:
 Analysis Date: Microfilm Data Recorded: No

Construction Information

Year: 2002 Original Reconstructed
 Route: FAI 55 Sta: 70+05.02
 Section Nbr: 0101-681-H
 Contract Nbr: 60277
 Fed Aid Pr#: 1 I.D.O.T.
 Built By: 1

Miscellaneous

Microfilm Data Recorded: No

Pontis

Today's Date: 08/27/2015

Structure Number: 016-2678 District: 1 (41) Bridge Status: 1 OPEN - NO RESTRICT
 (6) Feature Crossed: I-55 STEVENSON (7) Facility Carried: I-294 RAMPS I-55
 (9) Location: 1.8 M W US 45 P10 (7A) Bridge Name:
 Element Inspection Date: 07/24/2014
 (90E) Agency Program Manager: MastnySC (90E3) Consultant Program Manager:
 (90E1) Team Leader: SedlacekJL (90E2) Inspector:

Element Insp. Delinquent		N		Element Insp. Delinquent Reason:							
Element Description											
Elem	Env	% 1	Qty 1	% 2	Qty 2	% 3	Qty 3	% 4	Qty 4	Tot Qty	
P/S Conc Open Girder											
109	4	100	451	0	0	0	0	0	0	451	
		No deterioration	Minor cracks/spalls	Delams/spalls	Analysis warranted						
Remarks: Access Door @ NW Retaining Wall.											
Reinforced Conc Column or Pile Extension											
205	4	100	564	0	0	0	0	0	0	564	
		No deterioration	Minor cracks/spalls	Delams/spalls	Analysis warranted						
Remarks:											
Reinforced Conc Pier Wall											
210	4	100	1,080	0	0	0	0	0	0	1,080	
		No deterioration	Minor cracks/spalls	Delams/spalls	Analysis warranted						
Remarks: Vert leach crks @ Crash Wall											
Reinforced Conc Abutment											
215	4	100	3,410	0	0	0	0	0	0	3,410	
		No deterioration	Minor cracks/spalls	Delams/spalls	Analysis warranted						
Remarks: Stem- HL vert & horiz crks; Bkwall- Isol HL vert crks											
Reinforced Conc Pier or Abutment Cap											
234	4	100	331	0	0	0	0	0	0	331	
		No deterioration	Minor cracks/spalls	Delams/spalls	Analysis warranted						
Remarks:											
Elastomeric Bearing											
310	4	100	16	0	0	0	0	0	0	16	
		No deterioration	Minor deterioration	Major deterioration							
Remarks:											
Fixed Bearing											
313	4	100	8	0	0	0	0	0	0	8	
		No deterioration	Minor deterioration	Advanced corrosion							
Remarks:											

Concrete Bridge Railing										
331	4	89	539	11	64	0	0	0	0	603
		No deterioration	Minor cracks/spalls	Analysis warranted						
Remarks: HL vert leach crks w/HL hor crks @ transitions										
Concrete Deck Protected w/ Coated Bars										
8026	4	100	18,315	0	0	0	0	0	0	18,315
Remarks: (WS) HL trans crks; Soffit Isol HL trans leach crks										
Non-Lead Painted Steel Open Girder										
8118	4	100	24,895	0	0	0	0	0	0	24,895
Remarks:										
Non-Lead Painted Steel Closed Web/Box Girder Ends										
8173	4	100	16	0	0	0	0	0	0	16
Remarks:										
Continuous Seal Neoprene Expansion Joint										
8308	4	100	130	0	0	0	0	0	0	130
Remarks: Leakage @ both										
Approach Pavement										
8323	4	100	2	0	0	0	0	0	0	2
Remarks: Both Approches- Nar-med diag crking										



October 27, 2015

MEMORANDUM

Mr. John Fortmann, Region One Engineer
Illinois Department of Transportation
Region One/District One

Attn: Steven Schilke

RE: Existing S.N. 016-2695
E.B. I-55 Ramp to N.B. I-94 over Throop St.
Cook County
PTB 158-002/P-91-762-10

The purpose of this technical memo is to summarize the current condition of existing S.N. 016-2695 in addition to geometrics and other factors. A cursory field check was performed to supplement the information contained in IDOT's structure summary report dated August 26, 2014 (see Appendix B). Broad-based recommendations for this structure are provided below.

The structure is a three span PPC I-Beam bridge consisting of four lines of continuous beams (see Photo 1). Span lengths from west to east are 55'-7", 69'-1" and 55'-7". The superstructure is supported by integral abutments and reinforced concrete multi-column piers. There is no overlay on the structure.

Traffic conditions prevented access to view the top of deck. IDOT rates the deck as being in good condition, which concurs with the findings from the cursory field check. Minor transverse cracks with leaching are visible on a majority of the soffit (see Photo 2). IDOT rates the deck geometry as being intolerable and requiring a high priority of replacement. The findings from the cursory field check don't match IDOT's deck geometry rating. The ramp roadway width appears to be more than 16 ft. IDOT rates the underclearance vertical and lateral as being intolerable and requiring a high priority of corrective action, which concurs with the findings from the cursory field check. Small chip spalls due to suspected impact damage are visible on some beam bottom flanges (see Photos 2 and 3). No notable defects or differences were observed between the cursory field check and IDOT's structure summary report for: superstructure, substructure, approach alignment and bridge railing appraisal items. Moderate longitudinal cracks are visible on both approach slabs.

Based on the structure summary report and field check, S.N. 016-2695 is suitable for reuse without rehabilitation.



LIN ENGINEERING, LTD.
Consulting Engineers

Springfield, IL Westmont, IL

576 Oakmont Lane
Westmont, Illinois 60559
Telephone: (630) 323-5168
Fax: (630) 323-5174
E-mail: info@lineng.com

LIN ENGINEERING, LTD.

A handwritten signature in blue ink that reads "Michael T. Haley". The signature is written in a cursive, flowing style.

Michael T. Haley, PE, SE
Structural Manager

Appendix A – Photos

Appendix B – IDOT Structure Summary Report

Appendix C – PONTIS Report



Photo 1



Photo 2



Photo 3

Illinois Department of Transportation
Structures Information Management System
Structure Summary Report

Structure Number: 016-2695 District: 1

Inventory Data	
Facility Carried:	I-55 EB TO I-94 NB
Feature Crossed:	THROOP ST
Bridge Remarks:	
Status Remarks:	1 OPEN - NO RESTRICT
Maint County:	016 COOK
Maint Responsibility:	01 I.D.O.T.
Service On/Under:	1 HIGHWAY
Reporting Agency:	1 I.D.O.T. - BUREAU OF MAINTENANCE
Main Span Matl/Type:	6 PRESTRESS CONCRETE CONTINUOUS / 02 STRINGERMULTI-BEAM/GIRDER
Nbr Of Main Spans:	3
Nbr Of Approach Spans:	0
Near #1 Matl/Type:	/
Near #2 Matl/Type:	/
Far #1 Matl/Type:	/
Far #2 Matl/Type:	/
Median Width/Type:	0 Ft. / 0 None
Guardrail Type L/R:	0 None / 0 None
Toll Facility Indicator:	0 No Toll
Latitude:	41.84360943
Longitude:	S
Deck Structure Type:	A CIP CON NRMALLY FORM
Sidewalks Under Structure:	0 None
Bridge Name:	0.7 MI. SW I-90,94
Location:	
Status Date:	06/2000
Inventory Rating:	1,490(53)
Operating Rating:	2,395(86)
Design Load:	
Deck Structure Thickness:	9.4 SD: N FO: Y
RR Lateral Underclear:	0
RR Vertical Underclear:	0
Rate Method:	6
Load Rating Date:	10/23/2000
Rated By:	2 IDOT
Designation:	1 Mainline
Kind:	5 Municipal Streets
Number:	1

Key Route On Data	
Key Route Nbr:	FEDERAL-AID INTERSTATE
Station:	0094
Segment:	01000
Linked:	Y
Inventory County:	016 COOK
Township/Road Dist:	83 SOUTH CHICAGO (CHICAGO)
Natl. Hwy System:	On NHS
Municipality:	1051 CHICAGO
Urban Area:	1051
Inventory Direction:	North/West
Functional Class:	1 INTERSTATE
Curr AADT Yr/Count:	2002 / 41900
Est Truck Percentage:	0
Number Of Lanes:	2
One Or Two Way:	1 One-Way
Bypass Length:	0
Future AADT Yr/Cnt:	2032 / 43157
Designated Truck Rte:	NONE
Special Systems:	No
Designation:	1 Mainline
Kind:	1 Interstate Highway
Number:	1

Key Route Under Data	
Key Route Nbr:	MUNICIPAL STREET
Station:	2104
Segment:	01051
Linked:	Y
Inventory County:	83 SOUTH CHICAGO (CHICAGO)
Township/Road Dist:	1051 CHICAGO
Urban Area:	1051
Inventory Direction:	North/West
Functional Class:	7 LOCAL
Curr AADT Yr/Count:	1998 / 300
Est Truck Percentage:	0
Number Of Lanes:	2
One Or Two Way:	2 Two-Way
Bypass Length:	0
Future AADT Yr/Cnt:	2032 / 164
Designated Truck Rte:	NONE
Special Systems:	No
Designation:	1 Mainline
Kind:	5 Municipal Streets
Number:	1

Marked Route On Data	
Key Route Nbr:	FEDERAL-AID INTERSTATE
Station:	0094
Segment:	01000
Linked:	Y
Inventory County:	016 COOK
Township/Road Dist:	83 SOUTH CHICAGO (CHICAGO)
Natl. Hwy System:	On NHS
Municipality:	1051 CHICAGO
Urban Area:	1051
Inventory Direction:	North/West
Functional Class:	1 INTERSTATE
Curr AADT Yr/Count:	2002 / 41900
Est Truck Percentage:	0
Number Of Lanes:	2
One Or Two Way:	1 One-Way
Bypass Length:	0
Future AADT Yr/Cnt:	2032 / 43157
Designated Truck Rte:	NONE
Special Systems:	No
Designation:	1 Mainline
Kind:	1 Interstate Highway
Number:	1

**Illinois Department of Transportation
Structures Information Management System
Structure Summary Report**

District: 1

Structure Number: 016-2695

Data Related to Inspection Information

*** Inspection Intervals ***
 Routine NBIS: 24 MOS Underwater: 0 MOS One Truck At A Time: 0
 Special: N Single Unit Vehicles: Tons Combination Type 3S-1: Tons
 Tons Combination Type 3S-2: Tons
 Bridge Posting Level: 5 No Posting Required

Inspection/Appraisal Information

Inspection Date: 08/26/2014 Inspection Temperature: 85Deg. F
 Deck: 7 GOOD CONDITION - SOME MINOR PROBLEMS
 Superstructure: 7 GOOD CONDITION - SOME MINOR PROBLEMS
 Substructure: 8 VERY GOOD CONDITION - NO PROBLEMS NOTED
 Culvert: N NOT APPLICABLE
 Channel and Protection: N NOT APPLICABLE
 Structural Evaluation: 7 BETTER THAN PRESENT MINIMUM CRITERIA
 Deck Geometry: 2 INTOLERABLE - HIGH PRIORITY FOR REPLACEMENT
 Underclearance-Vert/Lat.: 3 INTOLERABLE - HIGH PRIORITY FOR CORRECTION
 Waterway Adequacy: N NOT APPLICABLE
 Approach Roadway Align: 8 EQUAL TO PRESENT DESIRABLE CRITERIA
 Bridge Railing Appraisal: 3 Meets Standards
 Approach Guardrail: N/A N/A
 Pier Navig Protection: N N/A

Deck Wearing Surf: A BARE DECK NO OVRLAY
 Deck Membrane: F NONE
 Deck Protection: A EPOXY COATED REINF
 Total Deck Thick: 9.3
 Last Paint Date:

*** Actual Posted Limits ***
 Single Unit Vehicles: Tons
 Combination Type 3S-1: Tons
 Combination Type 3S-2: Tons
 One Truck At A Time: 0
 Last Paint Type:

Underwater Inspection/Appraisal Information

Inspection Date:
 Temperature:
 Inspection Method:
 Appraisal Rating:

Scour Critical Information

Rating:
 Analysis Date:
 Evaluation Method:
 Microfilm Data Recorded: No

Construction Information

Year: 1999 Original
 Route: FAI 55 Sta: 140+275.91 Reconstructed
 Section Nbr: 207-1616.9
 Contract Nbr: 82981
 Fed Aid Pr#: ACHPD-IM-55-7
 Built By: 1 I.D.O.T.

Pontis

Today's Date: 09/03/2015

Structure Number: 016-2695 District: 1 (41) Bridge Status: 1 OPEN - NO RESTRICT
 (6) Feature Crossed: THROOP ST (7) Facility Carried: I-55 EB TO I-94 NB
 (9) Location: 0.7 Mi. SW I-90,94 (7A) Bridge Name:
 Element Inspection Date: 08/26/2014
 (90E) Agency Program Manager: MastnySC (90E3) Consultant Program Manager:
 (90E1) Team Leader: SedlacekJL (90E2) Inspector:

Element Insp. Delinquent		Element Insp. Delinquent Reason:									
Elem	Env	% 1	Qty 1	% 2	Qty 2	% 3	Qty 3	% 4	Qty 4	Tot Qty	
P/S Conc Open Girder											
109	4	100	713	0	1	0	0	0	0	714	
			No deterioration	Minor cracks/spalls	Delams/spalls	Analysis warranted					
Remarks: Small chip spall Bm2, Span 2 over SB Lanes.											
Reinforced Conc Column or Pile Extension											
205	3	100	593	0	0	0	0	0	0	593	
			No deterioration	Minor cracks/spalls	Delams/spalls	Analysis warranted					
Remarks:											
Reinforced Conc Pier Wall											
210	3	100	465	0	0	0	0	0	0	465	
			No deterioration	Minor cracks/spalls	Delams/spalls	Analysis warranted					
Remarks:											
Reinforced Conc Abutment											
215	3	100	387	0	0	0	0	0	0	387	
			No deterioration	Minor cracks/spalls	Delams/spalls	Analysis warranted					
Remarks: Integral Abutments- Few hl vert crks @ East & West Abuts											
Reinforced Conc Pier or Abutment Cap											
234	3	100	116	0	0	0	0	0	0	116	
			No deterioration	Minor cracks/spalls	Delams/spalls	Analysis warranted					
Remarks:											
Elastomeric Bearing											
310	4	100	4	0	0	0	0	0	0	4	
			No deterioration	Minor deterioration	Major deterioration						
Remarks: @ Pier 2											
Concrete Bridge Railing											
331	4	99	359	1	2	0	0	0	0	361	
			No deterioration	Minor cracks/spalls	Analysis warranted						
Remarks: HL vert crks; Small spall along N Rail @ section interface.											

Concrete Deck Protected w/ Coated Bars										
8026	4	97	5,099	3	164	0	0	0	0	5,263
Remarks: (WS) Few HL-Nar trans & long crks; Nar diag crking @ corners Soffit) Several HL leach crks @ < 5' c/c										
Approach Pavement										
8323	4	100	2	0	0	0	0	0	0	2
Remarks: Med diagonal and random crks										



October 27, 2015

MEMORANDUM

Mr. John Fortmann, Region One Engineer
Illinois Department of Transportation
Region One/District One

Attn: Steven Schilke

RE: Existing S.N. 016-2696
E.B. I-55 Ramp to N.B. I-94 over Archer Ave.
Cook County
PTB 158-002/P-91-762-10

The purpose of this technical memo is to summarize the current condition of existing S.N. 016-2696 in addition to geometrics and other factors. A cursory field check was performed to supplement the information contained in IDOT's structure summary report dated January 15, 2015 (see Appendix B). Broad-based recommendations for this structure are provided below.

The structure is a four span steel girder bridge consisting of five lines of continuous girders (see Photo 1). Span lengths from west to east are 192'-10", 214'-3", 214'-3" and 165'-4" along the local tangent. The superstructure is supported by closed wall abutments, reinforced concrete hammerhead and straddle piers. There is no overlay on the structure.

Traffic conditions prevented access to view the top of deck. IDOT rates the deck as being in good condition, which concurs with the findings from the cursory field check. Minor transverse cracks with leaching are visible on a majority of the soffit. IDOT rates the substructure as being in very good condition, which concurs with the findings from the cursory field check. Minor vertical cracking is visible on portions of the abutment walls. Minor flexural cracks are visible on the straddle cap (see Photo 2). IDOT rates the deck geometry as being intolerable and requiring a high priority of replacement. The findings from the cursory field check don't match IDOT's deck geometry rating. The ramp roadway width appears to be more than 16 ft. IDOT rates the underclearance vertical and lateral as being intolerable and requiring a high priority of corrective action, which concurs with the findings from the cursory field check. The clearance to the piers appears to be less than 6 ft. No notable defects or differences were observed between the cursory field check and IDOT's structure summary report for: superstructure, approach alignment and bridge railing appraisal items. Moderate longitudinal cracks are visible on both approach slabs.

Based on the structure summary report and field check, S.N. 016-2696 is suitable for reuse without rehabilitation.



LIN ENGINEERING, LTD.
Consulting Engineers

Springfield, IL Westmont, IL

576 Oakmont Lane
Westmont, Illinois 60559
Telephone: (630) 323-5168
Fax: (630) 323-5174
E-mail: info@lineng.com

LIN ENGINEERING, LTD.

A handwritten signature in blue ink that reads "Michael T. Haley". The signature is written in a cursive, flowing style.

Michael T. Haley, PE, SE
Structural Manager

Appendix A – Photos

Appendix B – IDOT Structure Summary Report

Appendix C – PONTIS Report



Photo 1

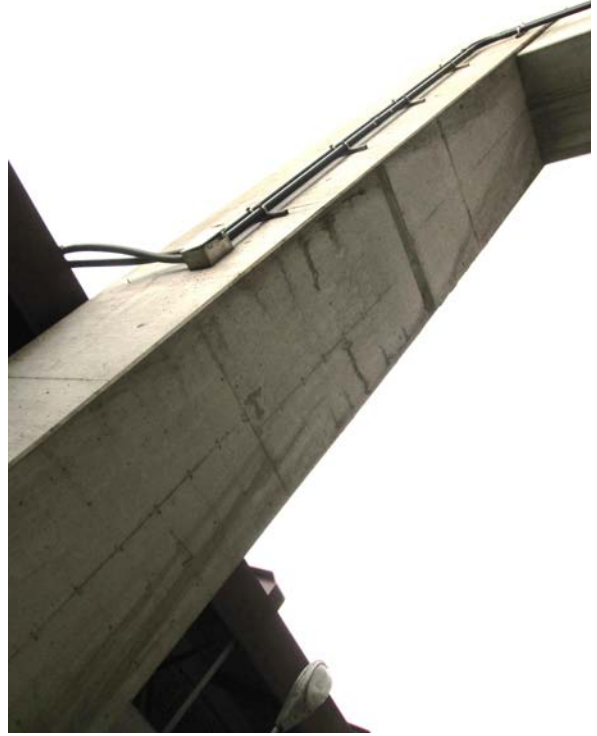


Photo 2

**Illinois Department of Transportation
Structures Information Management System
Structure Summary Report**

Structure Number: 016-2696 District: 1

Inventory Data

Facility Carried: I-55 EB TO I-94 NB Bridge Name: SOUTHWEST CHICAGO
 Feature Crossed: ARCHER AVE & QUARRY Location: 0.3 M SW I-90,94
 Bridge Status: 1 OPEN - NO RESTRICT Status Date: 12/2000
 Status Remarks: MAINT TOWNSHIP: 83 SOUTH CHICAGO
 Maint County: 016 COOK
 Maint Responsibility: 01 I.D.O.T.
 Service On/Under: 1 HIGHWAY 1 / HIGHWAY
 Reporting Agency: 1 I.D.O.T. - BUREAU OF MAINTENANCE
 Main Span Matl/Type: 4 STEEL CONTINUOUS / 02 STRINGER/MULTI-BEAM/GIRDER
 Nbr Of Main Spans: 4 Nbr Of Approach Spans: 0
 Approaches
 Near #1 Matl/Type: /
 Near #2 Matl/Type: /
 Far #1 Matl/Type: /
 Far #2 Matl/Type: /
 Median Width/Type: 0 Ft./0 None / 0
 Guardrail Type L/R: 0 None / 0
 Toll Facility Indicator: 0 No Toll
 Latitude: 41.84537705 S Longitude: 87.64764748 S
 Deck Structure Type: A CIP CON NRMALLY FORM
 Sidewalks Under Structure: 0 None

Key Route On Data

Key Route Nbr:	FEDERAL-AID INTERSTATE	Station:	0094	0.5100
Appurtenances	Ramp	Segment:	27860	Y
Inventory County:	016 COOK	Linked:		
Township/Road Dist	83 SOUTH CHICAGO (CHICAGO)	Natl. Hwy System:	On NHS	
Municipality	1051 CHICAGO	Inventory Direction:		
Urban Area:	1051	Curr AADT Yr/Count:	2002 / 41900	
Functional Class:	1 INTERSTATE	Est Truck Percentage:	0	
** CLEARANCES **	South/East	Number Of Lanes:	2	
Max Rdwy Width:	25.9	One Or Two Way:	1 One-Way	
Horizontal:	27.1	Bypass Length:	0	
		Future AADT Yr/Cnt:	2032 / 43157	
		Designated Truck Rte:	NONE	
		Special Systems:	No	

Key Route Under Data

Key Route Nbr:	FEDERAL-AID URBAN	Station:	3785	2.5400
Main Route	Segment:	00000		
016	Linked:		Y	
83	SOUTH CHICAGO (CHICAGO)	Natl. Hwy System:	Not on NHS	
1051	CHICAGO	Inventory Direction:		
1051	1051	Curr AADT Yr/Count:	2014 / 14000	
5	MAJOR COLLECTOR	Est Truck Percentage:	7	
South/East	North/West	Number Of Lanes:	2	
0.0		One Or Two Way:	2 Two-Way	
0.0		Bypass Length:	0	
		Future AADT Yr/Cnt:	2032 / 10506	
		Designated Truck Rte:	NONE	
		Special Systems:	No	

Marked Route On Data

Route #:	Designation	Kind	Number
1	Mainline	1	Mainline
2	Mainline	1	Mainline
3	Mainline	1	Mainline

Marked Route Under Data

Route #:	Designation	Kind	Number
1	Mainline	8	Other
2	Mainline	1	Mainline
3	Mainline	1	Mainline

**Illinois Department of Transportation
Structures Information Management System
Structure Summary Report**

District: 1

Structure Number: 016-2696

Data Related to Inspection Information

*** Inspection Intervals ***
 Routine NBIS: 24 MOS Underwater: 0 MOS One Truck At A Time: 0
 Special: N Single Unit Vehicles: Tons Combination Type 3S-1: Tons
 Bridge Posting Level: 5 No Posting Required

Inspection/Appraisal Information

Inspection Date: 01/15/2015 Inspection Temperature: 35Deg. F
 Deck: 7 GOOD CONDITION - SOME MINOR PROBLEMS
 Superstructure: 8 VERY GOOD CONDITION - NO PROBLEMS NOTED
 Substructure: 8 VERY GOOD CONDITION - NO PROBLEMS NOTED
 Culvert: N NOT APPLICABLE
 Channel and Protection: N NOT APPLICABLE
 Structural Evaluation: 8 EQUAL TO PRESENT DESIRABLE CRITERIA
 Deck Geometry: 2 INTOLERABLE - HIGH PRIORITY FOR REPLACEMENT
 Underclearance-Vert/Lat.: 3 INTOLERABLE - HIGH PRIORITY FOR CORRECTION
 Waterway Adequacy: N NOT APPLICABLE
 Approach Roadway Align: 8 EQUAL TO PRESENT DESIRABLE CRITERIA
 Bridge Railing Appraisal: 3 Meets Standards
 Approach Guardrail: N/A N/A
 Pier Navig Protection: N N/A

*** Actual Posted Limits ***
 Single Unit Vehicles: Tons
 Combination Type 3S-1: Tons
 Combination Type 3S-2: Tons
 One Truck At A Time: 0
 Last Paint Type: US
 Deck Wearing Surf: A BARE DECK NO OVRLAY
 Deck Membrane: F NONE
 Deck Protection: A EPOXY COATED REINF
 Total Deck Thick: 9.1
 Last Paint Date: 08/2001
 SHP ZINC&FLD ACRYL

Underwater Inspection/Appraisal Information

Inspection Date:
 Temperature:
 Inspection Method:
 Appraisal Rating:

Scour Critical Information

Rating:
 Analysis Date:
 Evaluation Method:
 Microfilm Data Recorded: No

Construction Information

Year: 1999 Original
 Route: FAI 55 Sta: 140+577.75 Reconstructed
 Section Nbr:
 Contract Nbr: 82981
 Fed Aid Pr#: ACHPD-IM-55-7(
 Built By: 1 I.D.O.T.

Pontis

Today's Date: 09/03/2015

Structure Number: 016-2696 District: 1 (41) Bridge Status: 1 OPEN - NO RESTRICT
 (6) Feature Crossed: ARCHER AVE & QUARRY (7) Facility Carried: I- 55 EB TO I-94 NB
 (9) Location: 0.3 M SW I-90,94 (7A) Bridge Name:
 Element Inspection Date: 01/15/2015
 (90E) Agency Program Manager: MastnySC (90E3) Consultant Program Manager:
 (90E1) Team Leader: SedlacekJL (90E2) Inspector:

Element Insp. Delinquent		Element Insp. Delinquent Reason:									
Elem	Env	% 1	Qty 1	% 2	Qty 2	% 3	Qty 3	% 4	Qty 4	Tot Qty	
Reinforced Conc Column or Pile Extension											
205	4	100	2,057	0	0	0	0	0	0	2,057	
			No deterioration	Minor cracks/spalls	Delams/spalls	Analysis warranted					
Remarks: Pier 1- Col #1 HL-Med horiz Crks											
Reinforced Conc Abutment											
215	4	100	3,258	0	0	0	0	0	0	3,258	
			No deterioration	Minor cracks/spalls	Delams/spalls	Analysis warranted					
Remarks: East Abut- Med vert crks under Bm#5											
Reinforced Conc Pier or Abutment Cap											
234	4	100	175	0	0	0	0	0	0	175	
			No deterioration	Minor cracks/spalls	Delams/spalls	Analysis warranted					
Remarks:											
Modular Joints											
303	4	100	56	0	0	0	0	0	0	56	
			No deterioration	Minor deterioration	Advanced corrosion	Corrosion is advance					
Remarks: West & East Joints-Steel Edge Bm- minor wear & rust (mostly @ left shldr)											
Fixed Bearing											
313	4	100	5	0	0	0	0	0	0	5	
			No deterioration	Minor deterioration	Advanced corrosion						
Remarks:											
Pot Bearing											
314	4	100	20	0	0	0	0	0	0	20	
			No deterioration	Minor deterioration	Advanced corrosion						
Remarks:											
Concrete Bridge Railing											
331	4	100	1,561	0	0	0	0	0	0	1,561	
			No deterioration	Minor cracks/spalls	Analysis warranted						
Remarks: It vert crotking											

Concrete Deck Protected w/ Coated Bars										
8026	4	92	20,861	8	1,750	0	0	0	0	22,611
Remarks: Soffit: Lt transv crking w/minor leaching. Conc Dk W.S. Lt trans crking w/isolated fine spalls. Wrg Surf map crkd thru-out deck										
Non-Lead Painted Steel Open Girder										
8118	4	100	85,508	0	0	0	0	0	0	85,508
Remarks:										
Non-Lead Painted Steel Closed Web/Box Girder Ends										
8173	4	100	10	0	0	0	0	0	0	10
Remarks:										
Approach Pavement										
8323	4	100	2	0	0	0	0	0	0	2
Remarks: Few HL-Med longitudinal crks @ West Apprch										



October 27, 2015

MEMORANDUM

Mr. John Fortmann, Region One Engineer
Illinois Department of Transportation
Region One/District One

Attn: Steven Schilke

RE: Existing S.N. 016-2697
E.B. I-55 Ramp to N.B. I-94 over Halsted St.
Cook County
PTB 158-002/P-91-762-10

The purpose of this technical memo is to summarize the current condition of existing S.N. 016-2697 in addition to geometrics and other factors. A cursory field check was performed to supplement the information contained in IDOT's structure summary report dated November 26, 2014 (see Appendix B). Broad-based recommendations for this structure are provided below.

The structure is a 72'-5" long single span PPC I-beam bridge consisting of five lines of simply supported beams (see Photo 1). The superstructure is supported by closed wall abutments. There is no overlay on the structure.

Traffic conditions prevented access to view the top of deck and approaches. IDOT rates the substructure as being in very good condition, which concurs with the findings from the cursory field check. Minor vertical cracks are visible on the abutment walls (see Photo 2). No notable defects or differences were observed between the cursory field check and IDOT's structure summary report for: deck, superstructure, deck geometry, underclearance vert/lat, approach alignment, bridge railing appraisal and approach guardrail items.

Based on the structure summary report and field check, S.N. 016-2697 is suitable for reuse without rehabilitation.



LIN ENGINEERING, LTD.
Consulting Engineers

Springfield, IL Westmont, IL

576 Oakmont Lane
Westmont, Illinois 60559
Telephone: (630) 323-5168
Fax: (630) 323-5174
E-mail: info@lineng.com

LIN ENGINEERING, LTD.

A handwritten signature in blue ink that reads "Michael T. Haley". The signature is written in a cursive style.

Michael T. Haley, PE, SE
Structural Manager

Appendix A – Photos

Appendix B – IDOT Structure Summary Report

Appendix C – PONTIS Report



Photo 1



Photo 2

Illinois Department of Transportation
Structures Information Management System
Structure Summary Report

Structure Number: 016-2697 District: 1

Inventory Data

Facility Carried: I-55 EB TO I-94 NB
 Feature Crossed: HALSTED ST
 Bridge Name: SOUTH SIDE OF I-55
 Location: SOUTH SIDE OF I-55
 Status Date: 02/2000
 Maint Township: 83 SOUTH CHICAGO
 Status: 1 OPEN - NO RESTRICT
 AS PER KRAMARZ
 016 COOK
 01 I.D.O.T.
 Service On/Under: 1 HIGHWAY 1 / HIGHWAY
 Reporting Agency: 1 I.D.O.T. - BUREAU OF MAINTENANCE
 Main Span Matl/Type: 5 PRESTRESS CONCRETE / 02 STRINGER/MULTI-BEAM/GIRDER
 Nbr Of Main Spans: 1 Nbr Of Approach Spans: 0
 Approaches
 Near #1 Matl/Type: /
 Near #2 Matl/Type: /
 Far #1 Matl/Type: /
 Far #2 Matl/Type: /
 Median Width/Type: 0 Fl./0 None / 0
 Guardrail Type L/R: 0 None / 0
 Toll Facility Indicator: 0 No Toll
 Latitude: 41.84599514 S Longitude: 87.64469048 S
 Deck Structure Type: A CIP CON NRMALLY FORM
 Sidewalks Under Structure: 0 None

Key Route On Data

Key Route Nbr: FEDERAL-AID INTERSTATE 0094 Station: 07100
 Appurtenances Ramp 27860 Segment: 016
 Inventory County: 016 COOK Linked: Y
 Township/Road Dist 83 SOUTH CHICAGO (CHICAGO) Natl. Hwy System: On NHS
 Municipality 1051 CHICAGO Inventory Direction:
 Urban Area: 1051 Curr AADT Yr/Count: 2002 / 41900
 Functional Class: 1 INTERSTATE Est Truck Percentage: 0
 ** CLEARANCES ** South/East North/West Number Of Lanes: 1 One-Way
 Max Rdwy Width: 25.9 Bypass Length: 0
 Horizontal: 27.1 Future AADT Yr/Cnt: 2032 / 43157
 Designated Truck Rte: NONE
 Special Systems: No

Key Route Under Data

FEDERAL-AID URBAN Station: 3730 Station: 7.5400
 Main Route Segment: 00000
 016 Linked: Y
 83 SOUTH CHICAGO (CHICAGO) Natl. Hwy System: Not on NHS
 CHICAGO Inventory Direction:
 1051 1051 Curr AADT Yr/Count: 2014 / 12100
 4 MINOR ARTERIAL Est Truck Percentage: 13
 South/East North/West Number Of Lanes: 4
 0.0 One Or Two Way: 2 Two-Way
 66.0 Bypass Length: 0
 Future AADT Yr/Cnt: 2032 / 16171
 Designated Truck Rte: NONE
 Special Systems: No

****** Marked Route On Data ******

Route #	Designation	Kind	Number
1	Mainline	1	Mainline
2	Mainline	1	Mainline
3	Mainline	1	Mainline

****** Marked Route Under Data ******

Route #	Designation	Kind	Number
1	Mainline	8	Other
2	Mainline	1	Mainline
3	Mainline	1	Mainline

**Illinois Department of Transportation
Structures Information Management System
Structure Summary Report**

Date: 07/28/2015
Page: 2

Structure Number: 016-2697 District: 1

Data Related to Inspection Information

*** Inspection Intervals ***
 Routine NBIS: 24 MOS Underwater: 0 MOS One Truck At A Time: 0
 Special: N Single Unit Vehicles: Tons Combination Type 3S-1: Tons
 Bridge Posting Level: 5 No Posting Required

Inspection/Appraisal Information

Inspection Date: 11/26/2014 Inspection Temperature: 31Deg. F
 Deck: 8 VERY GOOD CONDITION - NO PROBLEMS NOTED
 Superstructure: 8 VERY GOOD CONDITION - NO PROBLEMS NOTED
 Substructure: 8 VERY GOOD CONDITION - NO PROBLEMS NOTED
 Culvert: N NOT APPLICABLE
 Channel and Protection: N NOT APPLICABLE
 Structural Evaluation: 8 EQUAL TO PRESENT DESIRABLE CRITERIA
 Deck Geometry: 8 EQUAL TO PRESENT DESIRABLE CRITERIA
 Underclearance-Vert/Lat.: 9 SUPERIOR TO PRESENT DESIRABLE CRITERIA
 Waterway Adequacy: N NOT APPLICABLE
 Approach Roadway Align: 8 EQUAL TO PRESENT DESIRABLE CRITERIA
 Bridge Railing Appraisal: 3 Meets Standards
 Approach Guardrail: 233 Not Acceptable
 Pier Navig Protection: N N/A

Deck Wearing Surf: A BARE DECK NO OVRLAY
 Deck Membrane: F NONE
 Deck Protection: A EPOXY COATED REINF
 Total Deck Thick: 9.4
 Last Paint Date:

*** Actual Posted Limits ***
 Single Unit Vehicles: Tons
 Combination Type 3S-1: Tons
 Combination Type 3S-2: Tons
 One Truck At A Time: 0
 Last Paint Type:

Underwater Inspection/Appraisal Information

Inspection Date:
 Temperature:
 Inspection Method:
 Appraisal Rating:

Scour Critical Information

Rating:
 Analysis Date:
 Evaluation Method:
 Microfilm Data Recorded: No

Construction Information

Year: 1997 Original
 Route: FAI 55 Sta: 134+407.80
 Section Nbr: 1616(9,10)HB:0616(.9,.10) Reconstructed
 Contract Nbr: 82449
 Fed Aid Pr#: ACNHI-55-7(193)
 Built By: 1 I.D.O.T.

Pontis

Today's Date: 09/03/2015

Structure Number: 016-2697 District: 1 (41) Bridge Status: 1 OPEN - NO RESTRICT
 (6) Feature Crossed: HALSTED ST (7) Facility Carried: I- 55 EB TO I-94 NB
 (9) Location: SOUTH SIDE OF I-55 (7A) Bridge Name:
 Element Inspection Date: 11/26/2014
 (90E) Agency Program Manager: MastnySC (90E3) Consultant Program Manager:
 (90E1) Team Leader: SedlacekJL (90E2) Inspector:

Element Insp. Delinquent		Element Insp. Delinquent Reason:									
Element Description											
Elem	Env	% 1	Qty 1	% 2	Qty 2	% 3	Qty 3	% 4	Qty 4	Tot Qty	
P/S Conc Open Girder											
109	4	100	362	0	0	0	0	0	0	0	362
			No deterioration	Minor cracks/spalls	Delams/spalls	Analysis warranted					
Remarks:											
Reinforced Conc Abutment											
215	4	71	850	29	350	0	0	0	0	0	1,200
			No deterioration	Minor cracks/spalls	Delams/spalls	Analysis warranted					
Remarks: HL to Med map crks in FCR areas. @ Bott of Abut: East Abut-6ft x 4ft; West Abut-7ftx 5ft											
Reinforced Conc Pier or Abutment Cap											
234	4	100	61	0	0	0	0	0	0	0	61
			No deterioration	Minor cracks/spalls	Delams/spalls	Analysis warranted					
Remarks:											
Preformed Joint Seal											
302	4	100	62	0	0	0	0	0	0	0	62
			No deterioration	Minor deterioration	Major deterioration						
Remarks:											
Elastomeric Bearing											
310	4	100	5	0	0	0	0	0	0	0	5
			No deterioration	Minor deterioration	Major deterioration						
Remarks: @ West Abut											
Fixed Bearing											
313	4	100	5	0	0	0	0	0	0	0	5
			No deterioration	Minor deterioration	Advanced corrosion						
Remarks: @ East Abut.											
Concrete Bridge Railing											
331	4	83	119	17	25	0	0	0	0	0	144
			No deterioration	Minor cracks/spalls	Analysis warranted						
Remarks: Vert crcking & many scrapes											

Concrete Deck Protected w/ Coated Bars										
8026	4	93	1,958	7	150	0	0	0	0	2,108
Remarks: HL transv crking										
P/S Conc Beam Ends Incl Diaphragms Under Deck Joint										
8237	4	100	10	0	0	0	0	0	0	10
Remarks:										
Approach Pavement										
8323	4	100	2	0	0	0	0	0	0	2
Remarks:										



October 27, 2015

MEMORANDUM

Mr. John Fortmann, Region One Engineer
Illinois Department of Transportation
Region One/District One

Attn: Steven Schilke

RE: Existing S.N. 016-2698
E.B. I-55 Ramp to S.B. I-94 over Halsted St.
Cook County
PTB 158-002/P-91-762-10

The purpose of this technical memo is to summarize the current condition of existing S.N. 016-2698 in addition to geometrics and other factors. A cursory field check was performed to supplement the information contained in IDOT's structure summary report dated November 26, 2014 (see Appendix B). Broad-based recommendations for this structure are provided below.

The structure is a 72'-6" long single span PPC I-beam bridge consisting of five lines of simply supported beams (see Photo 1). The superstructure is supported by closed wall abutments. There is no overlay on the structure.

Traffic conditions prevented access to view the top of deck. IDOT rates the substructure as being in very good condition, which concurs with the findings from the cursory field check. Minor hairline transverse and vertical cracks are visible on the abutment walls (see Photo 2). No notable defects or differences were observed between the cursory field check and IDOT's structure summary report for: deck, superstructure, deck geometry, underclearance vert/lat, approach alignment, bridge railing appraisal and approach guardrail items.

Based on the structure summary report and field check, S.N. 016-2698 is suitable for reuse without rehabilitation. The approach guardrail end should be brought up to current IDOT standards.



LIN ENGINEERING, LTD.
Consulting Engineers

Springfield, IL Westmont, IL

576 Oakmont Lane
Westmont, Illinois 60559
Telephone: (630) 323-5168
Fax: (630) 323-5174
E-mail: info@lineng.com

LIN ENGINEERING, LTD.

A handwritten signature in blue ink that reads "Michael T. Haley". The signature is written in a cursive, flowing style.

Michael T. Haley, PE, SE
Structural Manager

Appendix A – Photos

Appendix B – IDOT Structure Summary Report

Appendix C – PONTIS Report



Photo 1



Photo 2

**Illinois Department of Transportation
Structures Information Management System
Structure Summary Report**

Structure Number: 016-2698 District: 1

Inventory Data

Facility Carried: I-55 EB TO I-94 SB
 Feature Crossed: HALSTED ST
 Bridge Name: SOUTH SIDE OF I-55
 Location: SOUTH SIDE OF I-55
 Status Date: 07/1998
 Status: 1 OPEN - NO RESTRICT
 Status Remarks: INSPECTED 02/27/98
 Maint County: 016 COOK
 Maint Township: 83 SOUTH CHICAGO
 Maint Responsibility: 01 I.D.O.T.
 Service On/Under: 1 HIGHWAY 1 / HIGHWAY
 Reporting Agency: 1 I.D.O.T. - BUREAU OF MAINTENANCE
 Main Span Matl/Type: 5 PRESTRESS CONCRETE / 02 STRINGER/MULTI-BEAM/GIRDER
 Nbr Of Main Spans: 1 Nbr Of Approach Spans: 0
 Approaches
 Near #1 Matl/Type: /
 Near #2 Matl/Type: /
 Far #1 Matl/Type: /
 Far #2 Matl/Type: /
 Median Width/Type: 0 Ft. / 0 None
 Guardrail Type L/R: 0 None / 0 None
 Toll Facility Indicator: 0 No Toll
 Latitude: 41.84632989 S Longitude: 87.64412008 S
 Deck Structure Type: A CIP CON NRMALLY FORM
 Sidewalks Under Structure: 0 None

Key Route On Data

Key Route Nbr:	FEDERAL-AID INTERSTATE	Station:	0094	Segment:	01600
Appurtenances	Ramp	27750		Linked:	Y
Inventory County:	016 COOK			Natl. Hwy System:	On NHS
Township/Road Dist	83 SOUTH CHICAGO (CHICAGO)			Inventory Direction:	
Municipality	1051 CHICAGO			Curr AADT Yr/Count:	2000 / 14500
Urban Area:	1051			Est Truck Percentage:	0
Functional Class:	1 INTERSTATE			Number Of Lanes:	1
** CLEARANCES **	South/East	North/West		One Or Two Way:	1 One-Way
Max Rdwy Width:	25.9	0.0		Bypass Length:	0
Horizontal:	27.1	0.0		Future AADT Yr/Cnt:	2032 / 14944
Designated Truck Rte:	NONE	NONE		Special Systems:	No

Key Route Under Data

Key Route Nbr:	FEDERAL-AID URBAN	Station:	3730	Segment:	7.5500
Main Route	00000			Linked:	Y
Inventory County:	83 SOUTH CHICAGO (CHICAGO)			Natl. Hwy System:	Not on NHS
Municipality	1051 CHICAGO			Inventory Direction:	
Urban Area:	1051			Curr AADT Yr/Count:	2014 / 12100
Functional Class:	4 MINOR ARTERIAL			Est Truck Percentage:	13
** CLEARANCES **	South/East	North/West		Number Of Lanes:	4
Max Rdwy Width:	0.0	0.0		One Or Two Way:	2 Two-Way
Horizontal:	51.0	0.0		Bypass Length:	0
Designated Truck Rte:	NONE	NONE		Future AADT Yr/Cnt:	2032 / 16171
Special Systems:	No	No		Designated Truck Rte:	NONE

Marked Route On Data

Designation	Kind	Number
1 Mainline	1 Interstate Highway	1
1 Mainline	1 Mainline	1
1 Mainline	1 Mainline	1

Marked Route Under Data

Designation	Kind	Number
1 Mainline	8 Other	8
1 Mainline	1 Mainline	1
1 Mainline	1 Mainline	1

Inventory Data

Sufficiency Rating: 100.0 Structure Length: 75.9
 HBP Eligible: No AASHTO Bridge Length: 68.3
 Replaced By: - Length of Long Span: 70.0
 Replaces: - Bridge Roadway Width: 25.9
 Last Update Date: 03/28/2013 App Roadway Width: 25.9
 Parallel Structure: None Deck Width: 29.2
 Multi-Level Structure Nbr: Sidewalk Width Right: 0.0
 Skew Angle: L Left Sidewalk Width Left: 0.0
 Structure Flared: 16 D Navigation Control: N N/A
 Historical Significance: No Navigation Horiz Clear: 0
 Border Bridge State: No Navigation Vert Clear: 0
 Bdr State SN: Culvert Fill Depth: 0.0
 Bdr State % Responsibility: 0 Culvert Opening Area: 0.0
 Structural Steel Wt: 0 Culvert Cell Height: 0.00
 Substructure Material: Culvert Cell Width: 0.00
 Rated By: 2 IDOT Rate Method: 6
 Inventory Rating: 1.295(46) Load Rating Date: 10/02/1998 Railroad Crossing Info
 Operating Rating: 2.255(81) Crossing 1 Nbr:
 Design Load: Deck Structure Thickness: 7.5 SD: N FO: N RR Lateral Underclear: 0.0
 Deck Structure Thickness: 7.5 SD: N FO: N RR Vertical Underclear: 0 Ft 0 In

**Illinois Department of Transportation
Structures Information Management System
Structure Summary Report**

District: 1

Structure Number: 016-2698

Data Related to Inspection Information

*** Inspection Intervals ***
 Routine NBIS: 24 MOS Underwater: 0 MOS One Truck At A Time: 0
 Special: N Single Unit Vehicles: Tons Combination Type 3S-1: Tons
 Tons Combination Type 3S-2: Tons
 Bridge Posting Level: 5 No Posting Required

Inspection/Appraisal Information

Inspection Date: 11/26/2014 Inspection Temperature: 31Deg. F
 Deck: 7 GOOD CONDITION - SOME MINOR PROBLEMS
 Superstructure: 8 VERY GOOD CONDITION - NO PROBLEMS NOTED
 Substructure: 8 VERY GOOD CONDITION - NO PROBLEMS NOTED
 Culvert: N NOT APPLICABLE
 Channel and Protection: N NOT APPLICABLE
 Structural Evaluation: 8 EQUAL TO PRESENT DESIRABLE CRITERIA
 Deck Geometry: 8 EQUAL TO PRESENT DESIRABLE CRITERIA
 Underclearance-Vert/Lat.: 9 SUPERIOR TO PRESENT DESIRABLE CRITERIA
 Waterway Adequacy: N NOT APPLICABLE
 Approach Roadway Align: 8 EQUAL TO PRESENT DESIRABLE CRITERIA
 Bridge Railing Appraisal: 3 Meets Standards
 Approach Guardrail: 233 Not Acceptable
 Pier Navig Protection: N N/A

Deck Wearing Surf: A BARE DECK NO OVRLAY
 Deck Membrane: F NONE
 Deck Protection: A EPOXY COATED REINF
 Total Deck Thick: 7.5
 Last Paint Date:

*** Actual Posted Limits ***
 Single Unit Vehicles: Tons
 Combination Type 3S-1: Tons
 Combination Type 3S-2: Tons
 One Truck At A Time: 0
 Last Paint Type:

Underwater Inspection/Appraisal Information

Inspection Date:
 Temperature:
 Inspection Method:
 Appraisal Rating:

Scour Critical Information

Rating:
 Analysis Date:
 Evaluation Method:
 Microfilm Data Recorded: No

Construction Information

Year: 1997 Original
 Route: FAI 55 Sta: 134+407.80
 Section Nbr: 1616(.9..10)HB(.1616(.9.. Sta:
 Contract Nbr: 82449
 Fed Aid Pr#: ACNHI-55-7(193
 Built By: 1 I.D.O.T.

Miscellaneous

Pontis

Today's Date: 09/03/2015

Structure Number: 016-2698 District: 1 (41) Bridge Status: 1 OPEN - NO RESTRICT
 (6) Feature Crossed: HALSTED ST (7) Facility Carried: I- 55 EB TO I-94 SB
 (9) Location: SOUTH SIDE OF I-55 (7A) Bridge Name:
 Element Inspection Date: 11/26/2014
 (90E) Agency Program Manager: MastnySC (90E3) Consultant Program Manager:
 (90E1) Team Leader: SedlacekJL (90E2) Inspector:

Element Insp. Delinquent		Element Insp. Delinquent Reason:									
Elem	Env	% 1	Qty 1	% 2	Qty 2	% 3	Qty 3	% 4	Qty 4	Tot Qty	
P/S Conc Open Girder											
109	4	100	362	0	0	0	0	0	0	362	
		No deterioration	Minor cracks/spalls	Delams/spalls	Analysis warranted						
Remarks:											
Reinforced Conc Abutment											
215	4	67	800	33	400	0	0	0	0	1,200	
		No deterioration	Minor cracks/spalls	Delams/spalls	Analysis warranted						
Remarks: HL to Med Shrinkage crcks in FCR areas; Vertical leach crks @ bottom of Abut wall.											
Reinforced Conc Pier or Abutment Cap											
234	4	100	61	0	0	0	0	0	0	61	
		No deterioration	Minor cracks/spalls	Delams/spalls	Analysis warranted						
Remarks:											
Preformed Joint Seal											
302	4	100	62	0	0	0	0	0	0	62	
		No deterioration	Minor deterioration	Major deterioration							
Remarks:											
Elastomeric Bearing											
310	4	100	5	0	0	0	0	0	0	5	
		No deterioration	Minor deterioration	Major deterioration							
Remarks: @ West Abut											
Fixed Bearing											
313	4	100	5	0	0	0	0	0	0	5	
		No deterioration	Minor deterioration	Advanced corrosion							
Remarks: @ East Abut											
Concrete Bridge Railing											
331	4	49	70	51	74	0	0	0	0	144	
		No deterioration	Minor cracks/spalls	Analysis warranted							
Remarks: Vert crcking; scrapes & chipping due to collision damage											

Concrete Deck Protected w/ Coated Bars										
8026	4	85	1,793	15	315	0	0	0	0	2,108
Remarks: HL transv leach crking										
P/S Conc Beam Ends Incl Diaphragms Under Deck Joint										
8237	4	100	10	0	0	0	0	0	0	10
Remarks:										
Approach Pavement										
8323	4	100	2	0	0	0	0	0	0	2
Remarks: longit crking										



October 27, 2015

MEMORANDUM

Mr. John Fortmann, Region One Engineer
Illinois Department of Transportation
Region One/District One

Attn: Steven Schilke

RE: Existing S.N. 016-2699
S.B. I-94 Ramp to W.B. I-55 over Halsted St.
Cook County
PTB 158-002/P-91-762-10

The purpose of this technical memo is to summarize the current condition of existing S.N. 016-2699 in addition to geometrics and other factors. A cursory field check was performed to supplement the information contained in IDOT's structure summary report dated November 26, 2014 (see Appendix B). Broad-based recommendations for this structure are provided below.

The structure is a 74'-4" long single span steel girder bridge consisting of eight lines of simply supported beams (see Photo 1). The superstructure is supported by closed wall abutments. There is no overlay on the structure.

Traffic conditions prevented access to the top of deck and approaches. IDOT rates the substructure as being in very good condition, which concurs with the findings from the cursory field check. Minor horizontal and vertical cracks are visible on the abutment walls. IDOT rates the underclearance vertical and lateral as being not applicable. The findings from the cursory field check don't match IDOT's underclearance vertical and lateral rating. Halsted St. passes below the structure; the clearance appears to be adequate. No notable defects or differences were observed between the cursory field check and IDOT's structure summary report for: deck, superstructure, deck geometry, approach alignment, bridge railing appraisal and approach guardrail items.

Based on the structure summary report and field check, S.N. 016-2699 is suitable for reuse after rehabilitation of the expansion joints.



LIN ENGINEERING, LTD.
Consulting Engineers

Springfield, IL Westmont, IL

576 Oakmont Lane
Westmont, Illinois 60559
Telephone: (630) 323-5168
Fax: (630) 323-5174
E-mail: info@lineng.com

LIN ENGINEERING, LTD.

A handwritten signature in blue ink that reads "Michael T. Haley". The signature is written in a cursive, flowing style.

Michael T. Haley, PE, SE
Structural Manager

Appendix A – Photos

Appendix B – IDOT Structure Summary Report

Appendix C – PONTIS Report



Photo 1

Illinois Department of Transportation
Structures Information Management System
Structure Summary Report

Structure Number: 016-2699 District: 1

Inventory Data	
Facility Carried:	I-94 SB TO I-55 WB
Feature Crossed:	HALSTED ST
Bridge Status:	1 OPEN - NO RESTRICT
Status Remarks:	016 COOK
Maint County:	01 I.D.O.T.
Service On/Under:	1 HIGHWAY
Reporting Agency:	1 I.D.O.T. - BUREAU OF MAINTENANCE
Main Span Matl/Type:	3 STEEL
Nbr Of Main Spans:	1
Nbr Of Approach Spans:	0
Approaches	
Near #1 Matl/Type:	/
Near #2 Matl/Type:	/
Far #1 Matl/Type:	/
Far #2 Matl/Type:	/
Median Width/Type:	0 Ft./0 None
Guardrail Type L/R:	0 None
Toll Facility Indicator:	0 No Toll
Latitude:	41.84731144 S Longitude: 87.64418228 S
Deck Structure Type:	A CIP CON NRMALLY FORM
Sidewalks Under Structure:	0 None
Inventory Rating:	2.535(91)
Operating Rating:	2.750(99)
Design Load:	
Deck Structure Thickness:	9.3 SD: N FO: N
RR Lateral Underclear:	0 Ft
RR Vertical Underclear:	0 In

Key Route On Data	
Key Route Nbr:	FEDERAL-AID INTERSTATE 0094 Station: 0.7800
Appurtenances	Ramp 27650 Segment: Y
Inventory County:	016 COOK
Township/Road Dist	83 SOUTH CHICAGO (CHICAGO) Natl. Hwy System: On NHS
Municipality	1051 CHICAGO
Urban Area:	1051
Functional Class:	1 INTERSTATE
** CLEARANCES **	South/East North/West
Max Rdwy Width:	33.5
Horizontal:	34.7
Vertical:	0.0
Designated Truck Rte:	2032 / 49440
Designated Truck Rte:	NONE
Special Systems:	No

Key Route Under Data	
Station:	
Segment:	
Linked:	
Natl. Hwy System:	
Inventory Direction:	
Curr AADT Yr/Count:	/
Est Truck Percentage:	
Number Of Lanes:	
One Or Two Way:	
Bypass Length:	
Future AADT Yr/Cnt:	/
Designated Truck Rte:	
Special Systems:	

**** Marked Route On Data ****		
Designation	Kind	Number
Route #1:	1 Mainline	
Route #2:	1 Mainline	
Route #3:	1 Mainline	

Illinois Department of Transportation
Structures Information Management System
Structure Summary Report

Structure Number: 016-2699 District: 1

*** Inspection Intervals ***
 Routine NBIS: 24 MOS Underwater: 0 MOS One Truck At A Time: 0 Tons Combination Type 3S-1: Tons Bridge Posting Level:
 Special: N Single Unit Vehicles: Tons Combination Type 3S-2: Tons

*** Maximum Allowable Posting Limits ***
 Bridge Posting Level: 5 No Posting Required

Inspection/Appraisal Information

Inspection Date: 11/26/2014 Inspection Temperature: 31Deg. F
 Deck: 7 GOOD CONDITION - SOME MINOR PROBLEMS
 Superstructure: 8 VERY GOOD CONDITION - NO PROBLEMS NOTED
 Substructure: 8 VERY GOOD CONDITION - NO PROBLEMS NOTED
 Culvert: N NOT APPLICABLE
 Channel and Protection: N NOT APPLICABLE
 Structural Evaluation: 8 EQUAL TO PRESENT DESIRABLE CRITERIA
 Deck Geometry: 9 SUPERIOR TO PRESENT DESIRABLE CRITERIA
 Underclearance-Vert/Lat.: N NOT APPLICABLE
 Waterway Adequacy: N NOT APPLICABLE
 Approach Roadway Align: 8 EQUAL TO PRESENT DESIRABLE CRITERIA
 Bridge Railing Appraisal: 3 Meets Standards
 Approach Guardrail: 111 Does Not Exist Does Not Exist
 Pier Navig Protection: N N/A

Deck Wearing Surf: A BARE DECK NO OVRLAY
 Deck Membrane: F NONE
 Deck Protection: A EPOXY COATED REINF
 Total Deck Thick: 9.4
 Last Paint Date: 08/2002

Single Unit Vehicles: Tons
 Combination Type 3S-1: Tons
 Combination Type 3S-2: Tons
 One Truck At A Time: 0
 Last Paint Type: S
 SHP ZINC&FLD ACRYL

Underwater Inspection/Appraisal Information

Inspection Date:
 Temperature:
 Inspection Method:
 Appraisal Rating:

Scour Critical Information

Rating:
 Analysis Date:
 Evaluation Method:
 Microfilm Data Recorded: No

Construction Information

Year: 2000 Original Reconstructed
 Route: FAI 55 Sta: 60+254.65
 Section Nbr: (1616(.4,.6))R-1ETC
 Contract Nbr: 82992
 Fed Aid Pr#: IMD-55-7(2172)
 Built By: 1 I.D.O.T.

Pontis

Today's Date: 09/03/2015

Structure Number: 016-2699 District: 1 (41) Bridge Status: 1 OPEN - NO RESTRICT
 (6) Feature Crossed: HALSTED ST (7) Facility Carried: I- 94 SB TO I-55 WB
 (9) Location: NORTH SIDE OF I-55 (7A) Bridge Name:
 Element Inspection Date: 11/26/2014
 (90E) Agency Program Manager: MastnySC (90E3) Consultant Program Manager:
 (90E1) Team Leader: SedlacekJL (90E2) Inspector:

Element Insp. Delinquent		Element Insp. Delinquent Reason:								
Element Description										
Elem	Env	% 1	Qty 1	% 2	Qty 2	% 3	Qty 3	% 4	Qty 4	Tot Qty
Reinforced Conc Abutment										
215	3	92	1,680	8	150	0	0	0	0	1,830
		No deterioration	Minor cracks/spalls	Delams/spalls	Analysis warranted					
Remarks: Shrinkage crcks in FCR areas. HI vert crcks typ.										
Reinforced Conc Pier or Abutment Cap										
234	3	100	82	0	0	0	0	0	0	82
		No deterioration	Minor cracks/spalls	Delams/spalls	Analysis warranted					
Remarks:										
Elastomeric Bearing										
310	4	100	8	0	0	0	0	0	0	8
		No deterioration	Minor deterioration	Major deterioration						
Remarks: @ East Abut										
Concrete Bridge Railing										
331	4	100	149	0	0	0	0	0	0	149
		No deterioration	Minor cracks/spalls	Analysis warranted						
Remarks: HL vert crcks										
Concrete Deck Protected w/ Coated Bars										
8026	4	95	2,591	5	140	0	0	0	0	2,731
Remarks: (WS) Isol Trans crcks; Soffit) Isol HL trans leach crcks										
Non-Lead Painted Steel Open Girder										
8118	4	100	5,504	0	0	0	0	0	0	5,504
Remarks:										
Continuous Seal Neoprene Expansion Joint										
8308	4	95	72	5	4	0	0	0	0	76
Remarks: Lt Damage @ West Jnt-Lane 1										

Moveable Steel Bearings below continuous decks										
8316	4	100	8	0	0	0	0	0	0	8
Remarks: @ W. Abut										
Approach Pavement										
8323	4	100	2	0	0	0	0	0	0	2
Remarks: Few random crks										



October 27, 2015

MEMORANDUM

Mr. John Fortmann, Region One Engineer
Illinois Department of Transportation
Region One/District One

Attn: Steven Schilke

RE: Existing S.N. 016-2702
E.B. I-55 over Archer Ave.
Cook County
PTB 158-002/P-91-762-10

The purpose of this technical memo is to summarize the current condition of existing S.N. 016-2702 in addition to geometrics and other factors. A cursory field check was performed to supplement the information contained in IDOT's structure summary report dated May 4, 2015 (see Appendix B). Broad-based recommendations for this structure are provided below.

The structure is a four span steel girder bridge consisting of ten lines of continuous girders (see Photo 1). Span lengths from west to east are 121'-5", 147'-8", 147'-8" and 134'-6". The superstructure is supported by closed wall abutments and reinforced concrete multi-column piers. There is no overlay on the structure.

IDOT rates the deck as being in good condition, which concurs with the findings from the cursory field check. Minor transverse cracks with leaching are visible on sections of the soffit (see Photo 2). IDOT rates the substructure as being in very good condition, which concurs with the findings from the cursory field check. Minor vertical cracking is visible on portions of the abutment walls (see Photo 3). No notable defects or differences were observed between the cursory field check and IDOT's structure summary report for: superstructure, deck geometry, underclearance vert/lat, approach alignment and bridge railing appraisal items. Moderate transverse and longitudinal cracks are visible on both approach slabs. Small spalls are visible on the east approach slab (see Photo 4). The joint seal is missing along sections of the west expansion joint.

Based on the structure summary report and field check, S.N. 016-2702 is suitable for reuse after rehabilitation of the expansion joints.



LIN ENGINEERING, LTD.
Consulting Engineers

Springfield, IL Westmont, IL

576 Oakmont Lane
Westmont, Illinois 60559
Telephone: (630) 323-5168
Fax: (630) 323-5174
E-mail: info@lineng.com

LIN ENGINEERING, LTD.

A handwritten signature in blue ink that reads "Michael T. Haley". The signature is written in a cursive style.

Michael T. Haley, PE, SE
Structural Manager

Appendix A – Photos

Appendix B – IDOT Structure Summary Report

Appendix C – PONTIS Report



Photo 1



Photo 2



Photo 3



Photo 4

Illinois Department of Transportation
Structures Information Management System
Structure Summary Report

Structure Number: 016-2702 District: 1

Facility Carried:	I-55 EB STEVENSON	Bridge Name:		Sufficiency Rating:	91.0	Structure Length:	556.7
Feature Crossed:	ARCHER AV & QUARRY ST	Location:	0.3 M SW I-94	HBP Eligible:	No	AASHTO Bridge Length:	99.9
Bridge Status:	1 OPEN - NO RESTRICT	Status Date:	02/2000	Replaces By:	-	Length of Long Span:	147.6
Status Remarks:	PER KRAMARZ	Maint Township:	83 SOUTH CHICAGO	Replaces:	016-0032	Bridge Roadway Width:	57.6
Maint County:	016 COOK			Last Update Date:	08/20/2014	Appr Roadway Width:	72.0
Maint Responsibility:	01 I.D.O.T.			Parallel Structure:	Right	Deck Width:	60.9
Service On/Under:	1 HIGHWAY	1 / HIGHWAY		Multi-Level Structure Nbr:		Sidewalk Width Right:	0.0
Reporting Agency:	1 I.D.O.T. - BUREAU OF MAINTENANCE			Skew Angle:	0 D	Sidewalk Width Left:	0.0
Main Span Matl/Type:	4 STEEL CONTINUOUS	/ 02 STRINGER/MULTI-BEAM/GIRDER		Structure Flared:	No	Navigation Horiz Clear:	N/A
Nbr Of Main Spans:	4	Nbr Of Approach Spans:	0	Historical Significance:	No	Navigation Vert Clear:	0
Approaches				Border Bridge State:		Culvert Fill Depth:	0.0
Near #1 Matl/Type:	/	/		Bdr State SN:		Number Culvert Cells:	0
Near #2 Matl/Type:	/	/		Bdr State % Responsibility:		Culvert Opening Area:	0.0
Far #1 Matl/Type:	/	/		Structural Steel Wt:	0	Culvert Cell Height:	0.00
Far #2 Matl/Type:	/	/		Substructure Material:		Culvert Cell Width:	0.00
Median Width/Type:	0 Fl./0	None		Rated By:	2 IDOT	Rate Method:	6
Guardrail Type L/R:	0 None	/ 0		Inventory Rating:	1.495(53)	Load Rating Date:	10/24/2000
Toll Facility Indicator:	0 No Toll			Operating Rating:	2.495(89)	Crossing 1 Nbr:	
Latitude:	41.84538192	S Longitude:	87.6466892	Design Load:	S	Crossing 1 Nbr:	
Deck Structure Type:	A CIP CON NRMALLY FORM			Deck Structure Thickness:	7.5	SD:	N
Sidewalks Under Structure:	0 None					FO:	N
						RR Lateral Underclear:	0
						RR Vertical Underclear:	0
							Ft 0 In

Key Route On Data		Key Route Under Data	
Key Route Nbr:	FEDERAL-AID INTERSTATE 0055	Station:	15.6400
Appurtenances	Main Route 00000	Segment:	00000
Inventory County:	016 COOK	Linked:	Y
Township/Road Dist	83 SOUTH CHICAGO (CHICAGO)	Natl. Hwy System:	On NHS
Municipality	1051 CHICAGO	Inventory Direction:	
Urban Area:	1051	Curr AADT Yr/Count:	2014 / 64050
Functional Class:	1 INTERSTATE	Est Truck Percentage:	9
** CLEARANCES **	South/East	Number Of Lanes:	3
Max Rdwy Width:	57.6	One Or Two Way:	1 One-Way
Horizontal:	58.8	Bypass Length:	0
		Future AADT Yr/Cnt:	2032 / 87087
		Designated Truck Rte:	CLASS I
		Special Systems:	Yes

**** Marked Route On Data ****		**** Marked Route Under Data ****	
Route #1:	1 Mainline	Designation	Kind
Route #2:	1 Mainline	1 Mainline	8 Other
Route #3:	1 Mainline	1 Mainline	1 Mainline

**Illinois Department of Transportation
Structures Information Management System
Structure Summary Report**

District: 1

Structure Number: 016-2702

Data Related to Inspection Information

*** Inspection Intervals ***
 Routine NBIS: 24 MOS Underwater: 0 MOS One Truck At A Time: 0
 Special: N Single Unit Vehicles: Tons Combination Type 3S-1: Tons
 Tons Combination Type 3S-2: Tons
 Bridge Posting Level: 5 No Posting Required

Inspection/Appraisal Information

Inspection Date: 05/04/2015 Inspection Temperature: 72Deg. F
 Deck: 7 GOOD CONDITION - SOME MINOR PROBLEMS
 Superstructure: 8 VERY GOOD CONDITION - NO PROBLEMS NOTED
 Substructure: 8 VERY GOOD CONDITION - NO PROBLEMS NOTED
 Culvert: N NOT APPLICABLE
 Channel and Protection: N NOT APPLICABLE
 Structural Evaluation: 8 EQUAL TO PRESENT DESIRABLE CRITERIA
 Deck Geometry: 7 BETTER THAN PRESENT MINIMUM CRITERIA
 Underclearance-Vert/Lat.: 4 MINIMUM ADEQUACY TO BE LEFT IN PLACE
 Waterway Adequacy: N NOT APPLICABLE
 Approach Roadway Align: 8 EQUAL TO PRESENT DESIRABLE CRITERIA
 Bridge Railing Appraisal: 3 Meets Standards
 Approach Guardrail: N/A N/A
 Pier Navig Protection: N N/A

Deck Wearing Surf: A BARE DECK NO OVRLAY
 Deck Membrane: F NONE
 Deck Protection: A EPOXY COATED REINF
 Total Deck Thick: 7.5
 Last Paint Date: 08/2001

Underwater Inspection/Appraisal Information

Inspection Date: Inspection Method: Appraisal Rating:

Scour Critical Information

Rating: Evaluation Method: Microfilm Data Recorded: No

Construction Information

Year: 1999 Original
 Route: FAI 55 Reconstructed
 Section Nbr: 1616.10 Sta: 35+075
 Contract Nbr: 82981
 Fed Aid Pr#: ACHPD-IM-55-7
 Built By: 1 I.D.O.T.

Miscellaneous

Pontis

Today's Date: 09/03/2015

Structure Number: 016-2702 District: 1 (41) Bridge Status: 1 OPEN - NO RESTRICT
 (6) Feature Crossed: ARCHER AV & QUARRY ST (7) Facility Carried: I- 55 EB STEVENSON
 (9) Location: 0.3 M SW I-94 (7A) Bridge Name:
 Element Inspection Date: 05/04/2015
 (90E) Agency Program Manager: MastnySC (90E3) Consultant Program Manager:
 (90E1) Team Leader: SedlacekJL (90E2) Inspector:

Element Insp. Delinquent		Element Insp. Delinquent Reason:									
Elem	Env	% 1	Qty 1	% 2	Qty 2	% 3	Qty 3	% 4	Qty 4	Tot Qty	
Reinforced Conc Column or Pile Extension											
205	3	100	2,598	0	0	0	0	0	0	2,598	
			No deterioration	Minor cracks/spalls	Delams/spalls	Analysis warranted					
Remarks:											
Reinforced Conc Abutment											
215	3	100	3,964	0	0	0	0	0	0	3,964	
			No deterioration	Minor cracks/spalls	Delams/spalls	Analysis warranted					
Remarks:											
Reinforced Conc Pier or Abutment Cap											
234	3	100	309	0	0	0	0	0	0	309	
			No deterioration	Minor cracks/spalls	Delams/spalls	Analysis warranted					
Remarks:											
Fixed Bearing											
313	4	100	10	0	0	0	0	0	0	10	
			No deterioration	Minor deterioration	Advanced corrosion						
Remarks:											
Pot Bearing											
314	4	100	40	0	0	0	0	0	0	40	
			No deterioration	Minor deterioration	Advanced corrosion						
Remarks:											
Concrete Bridge Railing											
331	4	100	1,110	0	0	0	0	0	0	1,110	
			No deterioration	Minor cracks/spalls	Analysis warranted						
Remarks: HL to Narrow vert crks typ thru-out											
Concrete Deck Protected w/ Coated Bars											
8026	4	94	32,393	6	2,150	0	0	0	0	34,543	
Remarks: Soffitt: HL trans crking. W.S. HL to narrow trans crking; Several map cracked areas											

Non-Lead Painted Steel Open Girder										
8118	4	100	86,013	0	0	0	0	0	0	86,013
Remarks:										
Non-Lead Painted Steel Open Girder Ends										
8176	4	100	20	0	0	0	0	0	0	20
Remarks:										
Continuous Seal Neoprene Expansion Joint										
8308	4	100	122	0	0	0	0	0	0	122
Remarks:										
Approach Pavement										
8323	4	100	2	0	0	0	0	0	0	2
Remarks:										



October 27, 2015

MEMORANDUM

Mr. John Fortmann, Region One Engineer
Illinois Department of Transportation
Region One/District One

Attn: Steven Schilke

RE: Existing S.N. 016-2703
W.B. I-55 over Archer Ave.
Cook County
PTB 158-002/P-91-762-10

The purpose of this technical memo is to summarize the current condition of existing S.N. 016-2703 in addition to geometrics and other factors. A cursory field check was performed to supplement the information contained in IDOT's structure summary report dated May 4, 2015 (see Appendix B). Broad-based recommendations for this structure are provided below.

The structure is a five span steel girder bridge consisting of thirteen lines of curved continuous girders (see Photo 1). Span lengths from west to east are 129'-4", 128'-3", 108'-6", 109'-4" and 139'-3". The superstructure is supported by closed wall abutments and reinforced concrete multi-column piers. There is no overlay on the structure.

IDOT rates the deck as being in good condition, which concurs with the findings from the cursory field check. Minor longitudinal and transverse cracks are visible on a majority of the top of deck (see Photo 2). IDOT rates the substructure as being in good condition, which concurs with the findings from the cursory field check. Minor vertical cracking and map cracking is visible on portions of the abutment walls (see Photo 3). No notable defects or differences were observed between the cursory field check and IDOT's structure summary report for: superstructure, deck geometry, underclearance vert/lat, approach alignment and bridge railing appraisal items. Moderate longitudinal and transverse cracks are visible on both approach slabs. Anchor blocks are missing along sections of the west expansion joint (see Photo 4).

Based on the structure summary report and field check, S.N. 016-2703 is suitable for reuse after rehabilitation of the expansion joints.



LIN ENGINEERING, LTD.
Consulting Engineers

Springfield, IL Westmont, IL

576 Oakmont Lane
Westmont, Illinois 60559
Telephone: (630) 323-5168
Fax: (630) 323-5174
E-mail: info@lineng.com

LIN ENGINEERING, LTD.

A handwritten signature in blue ink that reads "Michael T. Haley". The signature is written in a cursive, flowing style.

Michael T. Haley, PE, SE
Structural Manager

Appendix A – Photos

Appendix B – IDOT Structure Summary Report

Appendix C – PONTIS Report



Photo 1

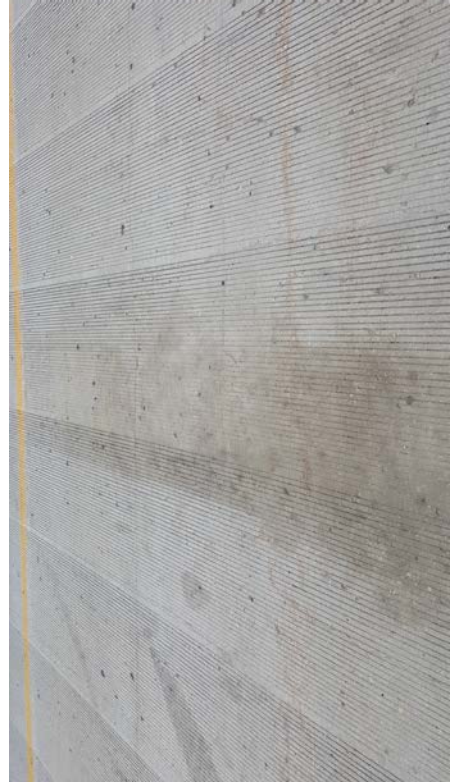


Photo 2



Photo 3

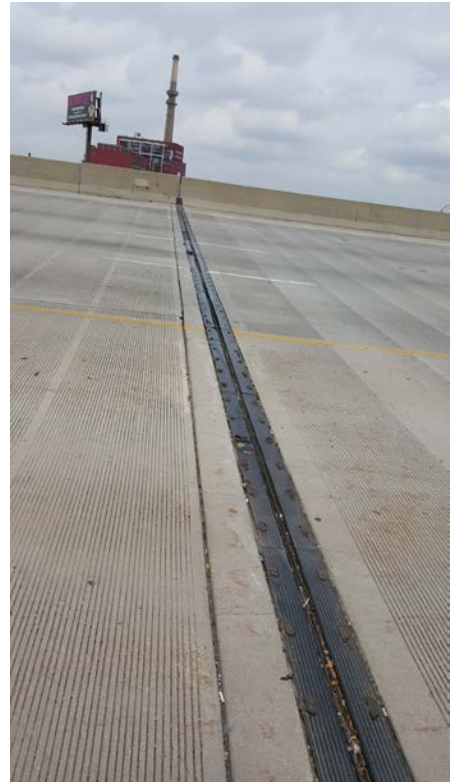


Photo 4

Illinois Department of Transportation
Structures Information Management System
Structure Summary Report

Structure Number: 016-2703 District: 1

Inventory Data	
Facility Carried:	I-55 WB STEVENSON
Feature Crossed:	ARCHER AV & QUARRY ST
Bridge Status:	1 OPEN - NO RESTRICT
Status Remarks:	016 COOK
Maint County:	01 I.D.O.T.
Service On/Under:	1 HIGHWAY
Reporting Agency:	1 I.D.O.T. - BUREAU OF MAINTENANCE
Main Span Matl/Type:	4 STEEL CONTINUOUS
Nbr Of Main Spans:	5 Nbr Of Approach Spans: 0
Approaches	
Near #1 Matl/Type:	/
Near #2 Matl/Type:	/
Far #1 Matl/Type:	/
Far #2 Matl/Type:	/
Median Width/Type:	0 Ft./0 None
Guardrail Type L/R:	0 None / 0 None
Toll Facility Indicator:	0 No Toll
Latitude:	41.84536586 S Longitude: 87.64984723 S
Deck Structure Type:	A CIP CON NRMALLY FORM
Sidewalks Under Structure:	0 None
Inventory Rating:	1,345(48)
Operating Rating:	2,240(80)
Design Load:	
Deck Structure Thickness:	7.5 SD: N FO: N
RR Vertical Underclear:	0 Ft 0 In

Key Route On Data	
Key Route Nbr:	FEDERAL-AID INTERSTATE 0055 Station: 15.6300
Appurtenances Main Route	00000
Inventory County:	016 COOK
Township/Road Dist	83 SOUTH CHICAGO (CHICAGO) Natl. Hwy System: On NHS
Municipality	1051 CHICAGO
Urban Area:	1051
Functional Class:	1 INTERSTATE
** CLEARANCES **	South/East North/West
Max Rdwy Width:	80.7
Horizontal:	81.9
Vertical:	0.0
Inventory Rating:	2014 / 64050
Est Truck Percentage:	9
Number Of Lanes:	4
One Or Two Way:	1 One-Way
Bypass Length:	0
Future AADT Yr/Cnt:	2032 / 87087
Designated Truck Rte:	CLASS I
Special Systems:	Yes

Key Route Under Data	
Main Route	FEDERAL-AID URBAN 00000 Station: 3785
Segment:	00000
Linked:	Y
Natl. Hwy System:	SOUTH CHICAGO (CHICAGO)
Inventory Direction:	CHICAGO
Curr AADT Yr/Count:	1051 1051
Est Truck Percentage:	5 MAJOR COLLECTOR
Number Of Lanes:	South/East North/West
One Or Two Way:	0.0
Bypass Length:	78.3
Future AADT Yr/Cnt:	2032 / 87087
Designated Truck Rte:	CLASS I
Special Systems:	Yes

**** Marked Route On Data ****		
Designation	Kind	Number
1 Mainline	1 Interstate Highway	055
1 Mainline		
1 Mainline		

**** Marked Route Under Data ****		
Designation	Kind	Number
1 Mainline	8 Other	
1 Mainline		
1 Mainline		

Illinois Department of Transportation
Structures Information Management System
Structure Summary Report

Structure Number: 016-2703 District: 1

*** Inspection Intervals ***
 Routine NBIS: 24 MOS Underwater: 0 MOS One Truck At A Time: 0 Tons Combination Type 3S-1: Tons
 Special: N Single Unit Vehicles: Tons Combination Type 3S-2: Tons
 Bridge Posting Level: 5 No Posting Required

Data Related to Inspection Information
 *** Maximum Allowable Posting Limits ***

Inspection Date: 05/04/2015 Inspection Temperature: 72Deg. F
 Deck: 7 GOOD CONDITION - SOME MINOR PROBLEMS
 Superstructure: 8 VERY GOOD CONDITION - NO PROBLEMS NOTED
 Substructure: 7 GOOD CONDITION - SOME MINOR PROBLEMS
 Culvert: N NOT APPLICABLE
 Channel and Protection: N NOT APPLICABLE
 Structural Evaluation: 7 BETTER THAN PRESENT MINIMUM CRITERIA
 Deck Geometry: 9 SUPERIOR TO PRESENT DESIRABLE CRITERIA
 Underclearance-Vert/Lat.: 4 MINIMUM ADEQUACY TO BE LEFT IN PLACE
 Waterway Adequacy: N NOT APPLICABLE
 Approach Roadway Align: 3 EQUAL TO PRESENT DESIRABLE CRITERIA
 Bridge Railing Appraisal: 8 Meets Standards
 Approach Guardrail: N/A N/A
 Pier Navig Protection: N N/A

Inspection/Appraisal Information
 Deck Wearing Surf: A BARE DECK NO OVRLAY
 Deck Membrane: F NONE
 Deck Protection: A EPOXY COATED REINF
 Total Deck Thick: 7.5
 Last Paint Date: 08/2001

*** Actual Posted Limits ***
 Single Unit Vehicles: Tons
 Combination Type 3S-1: Tons
 Combination Type 3S-2: Tons
 One Truck At A Time: 0
 Last Paint Type: S
 SHP ZINC&FLD ACRYL

Underwater Inspection/Appraisal Information

Inspection Date:
 Temperature:
 Inspection Method:
 Appraisal Rating:

Scour Critical Information
 Evaluation Method:

Rating:
 Analysis Date: Microfilm Data Recorded: No

Construction Information
 Sta: 235+172.95 Reconstructed Sta:

Year: 2000 Original
 Route: FAI 55
 Section Nbr:
 Contract Nbr: 82992
 Fed Aid Pr#: 1 I.D.O.T.
 Built By:

Miscellaneous

Microfilm Data Recorded: No

Pontis

Today's Date: 09/03/2015

Structure Number: 016-2703 District: 1 (41) Bridge Status: 1 OPEN - NO RESTRICT
 (6) Feature Crossed: ARCHER AV & QUARRY ST (7) Facility Carried: I- 55 WB STEVENSON
 (9) Location: 0.3 M SW I-94 (7A) Bridge Name:
 Element Inspection Date: 05/04/2015
 (90E) Agency Program Manager: MastnySC (90E3) Consultant Program Manager:
 (90E1) Team Leader: SedlacekJL (90E2) Inspector:

Element Insp. Delinquent		Element Insp. Delinquent Reason:									
Elem	Env	% 1	Qty 1	% 2	Qty 2	% 3	Qty 3	% 4	Qty 4	Tot Qty	
Reinforced Conc Column or Pile Extension											
205	3	100	5,582	0	0	0	0	0	0	5,582	
		No deterioration	Minor cracks/spalls	Delams/spalls	Analysis warranted						
Remarks:											
Reinforced Conc Abutment											
215	4	98	7,604	2	186	0	0	0	0	7,790	
		No deterioration	Minor cracks/spalls	Delams/spalls	Analysis warranted						
Remarks: Lt vert crking E & W Abuts											
Reinforced Conc Pier or Abutment Cap											
234	4	99	655	1	8	0	0	0	0	663	
		No deterioration	Minor cracks/spalls	Delams/spalls	Analysis warranted						
Remarks: Minor Cracking.											
Modular Joints											
303	4	100	83	0	0	0	0	0	0	83	
		No deterioration	Minor deterioration	Advanced corrosion	Corrosion is advance						
Remarks:											
Fixed Bearing											
313	4	100	13	0	0	0	0	0	0	13	
		No deterioration	Minor deterioration	Advanced corrosion							
Remarks:											
Pot Bearing											
314	4	100	78	0	0	0	0	0	0	78	
		No deterioration	Minor deterioration	Advanced corrosion							
Remarks:											
Concrete Bridge Railing											
331	4	100	1,229	0	0	0	0	0	0	1,229	
		No deterioration	Minor cracks/spalls	Analysis warranted							
Remarks: HL to Narrow vert crks typ thru-out											

Concrete Deck Protected w/ Coated Bars										
8026	4	96	49,616	4	1,980	0	0	0	0	51,596
Remarks: Soffitt: HL trans crking. W.S. HL to narrow trans crking w/map cracked areas										
Non-Lead Painted Steel Open Girder										
8118	4	100	115,017	0	0	0	0	0	0	115,017
Remarks: Few isolated paint peels										
Non-Lead Painted Steel Open Girder Ends										
8176	4	100	26	0	0	0	0	0	0	26
Remarks:										
Continuous Seal Neoprene Expansion Joint										
8308	4	90	75	10	8	0	0	0	0	83
Remarks: Missing hold downs @ W Abut										
Approach Pavement										
8323	4	50	1	50	1	0	0	0	0	2
Remarks: Med-wide longit crks @ E										



October 27, 2015

MEMORANDUM

Mr. John Fortmann, Region One Engineer
Illinois Department of Transportation
Region One/District One

Attn: Steven Schilke

RE: Existing S.N. 016-2704
I-55 over Des Plaines River
Cook County
PTB 158-002/P-91-762-10

The purpose of this technical memo is to summarize the current condition of existing S.N. 016-2704 in addition to geometrics and other factors. A cursory field check was performed to supplement the information contained in IDOT's structure summary report dated May 26, 2015 (see Appendix B). Broad-based recommendations for this structure are provided below.

The structure is a five span steel girder bridge consisting of nineteen lines of curved continuous girders with a total length of 702.6 ft. (see Photo 1). The superstructure is supported by closed wall abutments and reinforced concrete multi-column piers. There is no overlay on the structure.

IDOT rates the deck as being in good condition, which concurs with the findings from the cursory field check. Minor transverse cracks with leaching are visible on a majority of the soffit (see Photo 2). IDOT rates the substructure as being in very good condition, which concurs with the findings from the cursory field check. Minor cracking is visible on abutment walls and pier columns. IDOT rates the underclearance vertical and lateral as being intolerable requiring a high priority for of corrective action. The findings from the cursory field check don't match IDOT's underclearance rating. There appears to be sufficient clearance underneath the structure to be left in place as is (see Photo 3). No notable defects or differences were observed between the cursory field check and IDOT's structure summary report for: superstructure, deck geometry, approach alignment, bridge railing appraisal and approach guardrail items. A few anchor bolts at the abutments are bent (see Photo 4). Some free-falling drains don't extend below the bottom flange of the exterior girder near the west abutment (see Photo 5). Minor transverse and longitudinal cracks are visible on both approach slabs.

Based on the structure summary report and field check, S.N. 016-2704 is suitable for reuse after rehabilitation of free-fall drainage.



LIN ENGINEERING, LTD.
Consulting Engineers

Springfield, IL Westmont, IL

576 Oakmont Lane
Westmont, Illinois 60559
Telephone: (630) 323-5168
Fax: (630) 323-5174
E-mail: info@lineng.com

LIN ENGINEERING, LTD.

A handwritten signature in blue ink that reads "Michael T. Haley". The signature is written in a cursive, flowing style.

Michael T. Haley, PE, SE
Structural Manager

Appendix A – Photos

Appendix B – IDOT Structure Summary Report

Appendix C – PONTIS Report



Photo 1



Photo 2



Photo 3



Photo 4



Photo 5

**Illinois Department of Transportation
Structures Information Management System
Structure Summary Report**

Structure Number: 016-2704 District: 1

Inventory Data	
Facility Carried:	I-55 STEVENSON
Feature Crossed:	DES PLAINES RIVER
Bridge Remarks:	ALSO RPLCS 016-0011
Bridge Status:	1 OPEN - NO RESTRICT
Status Remarks:	
Maint County:	016 COOK
Maint Responsibility:	01 I.D.O.T.
Service On/Under:	1 HIGHWAY
Reporting Agency:	1 I.D.O.T. - BUREAU OF MAINTENANCE
Main Span Matl/Type:	4 STEEL CONTINUOUS
Nbr Of Main Spans:	5
Nbr Of Approach Spans:	0
Approaches	
Near #1 Matl/Type:	/
Near #2 Matl/Type:	/
Far #1 Matl/Type:	/
Far #2 Matl/Type:	/
Median Width/Type:	0 Ft./0 None
Guardrail Type L/R:	0 None / 0 None
Toll Facility Indicator:	0 No Toll
Latitude:	41.76357722
Longitude:	S
Deck Structure Type:	A CIP CON NRMALLY FORM
Sidewalks Under Structure:	0 None
Inventory Rating:	2
Operating Rating:	S
Design Load:	7.5 SD: N FC: Y
Deck Structure Thickness:	7.5 SD: N FC: Y
Rated By:	2 IDOT
Load Rating Date:	06/12/2000
Rate Method:	6
Inventory Rating:	1.275(45)
Operating Rating:	2.130(76)
Design Load:	7.5 SD: N FC: Y
Deck Structure Thickness:	7.5 SD: N FC: Y
RR Vertical Underclear:	0
RR Lateral Underclear:	0
RR Crossing 1 Nbr:	0
RR Crossing 2 Nbr:	0
Key Route On Data	
Key Route Nbr:	FEDERAL-AID INTERSTATE
Station:	0055
Segment:	3.3900
Linked:	Y
Natl. Hwy System:	On NHS
Inventory Direction:	
Curr AADT Yr/Count:	2014 / 155200
Est Truck Percentage:	8
Number Of Lanes:	6
One Or Two Way:	2 Two-Way
Bypass Length:	0
Future AADT Yr/Cnt:	2032 / 167890
Designated Truck Rte:	CLASS I
Special Systems:	Yes
Designation:	1 Interstate Highway
Kind:	1
Number:	055

Key Route Under Data	
Key Route Nbr:	FEDERAL-AID URBAN
Station:	1692
Segment:	1.2800
Linked:	Y
Natl. Hwy System:	Not on NHS
Inventory Direction:	
Curr AADT Yr/Count:	2014 / 1700
Est Truck Percentage:	18
Number Of Lanes:	2
One Or Two Way:	2 Two-Way
Bypass Length:	0
Future AADT Yr/Cnt:	2032 / 2069
Designated Truck Rte:	NONE
Special Systems:	No
Designation:	8 Other
Kind:	8
Number:	

**** Marked Route On Data ****	
Route #1:	1 Mainline
Route #2:	1 Mainline
Route #3:	1 Mainline

**** Marked Route Under Data ****	
Route #1:	1 Mainline
Route #2:	1 Mainline
Route #3:	1 Mainline

Illinois Department of Transportation
Structures Information Management System
Structure Summary Report

Structure Number: 016-2704 District: 1

*** Inspection Intervals ***
Routin e NBIS: 24 MOS Underwater: 0 MOS One Truck At A Time: 0 Tons Combination Type 3S-1: Tons Bridge Posting Level: 5 No Posting Required
Special: N Single Unit Vehicles: Tons Combination Type 3S-2: Tons

Data Related to Inspection Information
*** Maximum Allowable Posting Limits ***

Inspection Date: 05/26/2015 Inspection Temperature: 70Deg. F
Deck: 7 GOOD CONDITION - SOME MINOR PROBLEMS
Superstructure: 8 VERY GOOD CONDITION - NO PROBLEMS NOTED
Substructure: 8 VERY GOOD CONDITION - NO PROBLEMS NOTED
Culvert: N NOT APPLICABLE
Channel and Protection: 8 VERY GOOD CONDITION - NO PROBLEMS NOTED
Structural Evaluation: 8 EQUAL TO PRESENT DESIRABLE CRITERIA
Deck Geometry: 9 SUPERIOR TO PRESENT DESIRABLE CRITERIA
Underclearance-Vert/Lat.: 3 INTOLERABLE - HIGH PRIORITY FOR CORRECTION
Waterway Adequacy: 8 EQUAL TO PRESENT DESIRABLE CRITERIA
Approach Roadway Align: 8 Meets Standards
Bridge Railing Appraisal: 3 Meets Standards
Approach Guardrail: 333 Acceptable
Pier Navig Protection: N N/A

Inspection/Appraisal Information
70Deg. F
Deck Wearing Surf: A BARE DECK NO OVRLAY
Deck Membrane: F NONE
Deck Protection: A EPOXY COATED REINF
Total Deck Thick: 7.5
Last Paint Date: 08/2001

Single Unit Vehicles: Tons
Combination Type 3S-1: Tons
Combination Type 3S-2: Tons
One Truck At A Time: 0
Last Paint Type: S
SHP ZINC&FLD ACRYL

*** Actual Posted Limits ***

Inspection Date:
Temperature:

Inspection Method:
Appraisal Rating:

Underwater Inspection/Appraisal Information

Rating: 8 CALCULATED SCOUR ABOVE FOOTING
Analysis Date: 08/02/2001
Evaluation Method: B Rational Analysis
Microfilm Data Recorded: No

Scour Critical Information

Year: 2000 Original
Route: FAI 55 Sta: 15+455.08 FAI 55 Reconstructed
Section Nbr: 0404-676B Sta: 0404-640R&0101(JR-1)
Contract Nbr: 82969 82379
Fed Aid Pr#: 55-7(219)277
Built By: 1 I.D.O.T. 1 I.D.O.T.

Construction Information

Year: 2000 Original
Route: FAI 55 Sta: 15+455.08 FAI 55 Reconstructed
Section Nbr: 0404-676B Sta: 0404-640R&0101(JR-1)
Contract Nbr: 82969 82379
Fed Aid Pr#: 55-7(219)277
Built By: 1 I.D.O.T. 1 I.D.O.T.

Miscellaneous

Microfilm Data Recorded: No

Pontis

Today's Date: 08/27/2015

Structure Number: 016-2704 District: 1 (41) Bridge Status: 1 OPEN - NO RESTRICT
 (6) Feature Crossed: DES PLAINES RIVER (7) Facility Carried: I- 55 STEVENSON
 (9) Location: 0.9 M E OF US 45 (7A) Bridge Name:
 Element Inspection Date: 05/26/2015
 (90E) Agency Program Manager: MastnySC (90E3) Consultant Program Manager:
 (90E1) Team Leader: SedlacekJL (90E2) Inspector:

Element Insp. Delinquent		Element Insp. Delinquent Reason:									
Element Description											
Elem	Env	% 1	Qty 1	% 2	Qty 2	% 3	Qty 3	% 4	Qty 4	Tot Qty	
Reinforced Conc Column or Pile Extension.											
205	1	100	63,872	0	0	0	0	0	0	63,872	
			No deterioration	Minor cracks/spalls	Delams/spalls	Analysis warranted					
Remarks:											
Reinforced Conc Pier Wall											
210	1	100	31,884	0	0	0	0	0	0	31,884	
			No deterioration	Minor cracks/spalls	Delams/spalls	Analysis warranted					
Remarks:											
Reinforced Conc Abutment											
215	1	100	5,365	0	0	0	0	0	0	5,365	
			No deterioration	Minor cracks/spalls	Delams/spalls	Analysis warranted					
Remarks: East & West Abut Bkwall - HL to med vert crks typ.											
Reinforced Conc Pier or Abutment Cap											
234	1	100	1,650	0	0	0	0	0	0	1,650	
			No deterioration	Minor cracks/spalls	Delams/spalls	Analysis warranted					
Remarks: HL-Med diag & vert crks typ; HL leach cracks in pier cantilever sections											
Modular Joints											
303	4	100	565	0	0	0	0	0	0	565	
			No deterioration	Minor deterioration	Advanced corrosion	Corrosion is advance					
Remarks:											
Fixed Bearing											
313	1	0	0	100	18	0	0	0	0	18	
			No deterioration	Minor deterioration	Advanced corrosion						
Remarks:											
Pot Bearing											
314	4	0	0	100	90	0	0	0	0	90	
			No deterioration	Minor deterioration	Advanced corrosion						
Remarks: Brg Plate Bolts @ angle (typ.)											

Concrete Bridge Railing										
331	4	0	0	100	2,846	0	0	0	0	2,846
		No deterioration		Minor cracks/spalls	Analysis warranted					
Remarks: HI-Med vert crking typ.										
Concrete Deck Protected w/ Coated Bars										
8026	4	99	97,900	1	1,000	0	0	0	0	98,900
Remarks: HL-Med x-verse, diag & longit crks typ. esp. in Bays 1-10 (I-55 NB lanes)										
Non-Lead Painted Steel Open Girder										
8118	4	100	174,236	0	0	0	0	0	0	174,236
Remarks:										
Non-Lead Painted Steel Open Girder Ends										
8176	4	100	36	0	0	0	0	0	0	36
Remarks:										
Approach Pavement										
8323	4	100	4	0	0	0	0	0	0	4
Remarks: East & West Apprch- HL-Med diag crks typ. East Apprch- WB Lanes pothole @Ln#2 3'x3'										



October 27, 2015

MEMORANDUM

Mr. John Fortmann, Region One Engineer
Illinois Department of Transportation
Region One/District One

Attn: Steven Schilke

RE: Existing S.N. 016-9820
S.B. I-294 over I-55
Cook County
PTB 158-002/P-91-762-10

The purpose of this technical memo is to summarize the current condition of existing S.N. 016-9820 in addition to geometrics and other factors. A cursory field check was performed to supplement the information contained in IDOT's structure summary report dated June 6, 2014 (see Appendix B). Broad-based recommendations for this structure are provided below.

The structure is a four span steel girder bridge consisting of twelve lines of simply supported plate girders and built up girders (see Photo 1). Span lengths from south to north are 98'-0", 156'-1", 139'-4" and 102'-0". The superstructure is supported by pile bent abutments and reinforced concrete multi-column piers. The structure summary reports states that the deck has a bituminous overlay. A bituminous overlay was not present during our cursory field check. It is possible that the structure has a concrete overlay instead.

IDOT rates the deck as being in good condition. The findings from the cursory field check don't match IDOT's deck rating. The interior span soffits are hidden from view by shielding and should be assumed to be in poor condition. Minor transverse cracks with leaching are visible on a majority of the exterior span soffits. Numerous spalls, previous repairs and asphalt patches are visible on the top of deck (see Photo 2). IDOT rates the superstructure as being in good condition, which concurs with the findings from the cursory field check. Minor rusting is visible along the bottom flanges of built up girders, some of these flanges appear to be warped (see Photo 3). A few abutment fixed bearing anchor bolts are bent. IDOT rates the substructure as being in fair condition. The findings from the cursory field check don't match IDOT's substructure rating. Moderate cracking is visible on abutment caps (see Photo 4). A small loss of bearing area is visible on some abutment seats (see Photo 5). Moderate map cracking and a significant amount of previous concrete repair work is visible on the pier columns and caps (see Photo 6). Some of these previous repairs appear to be failing. IDOT rates the underclearance vertical and lateral as being intolerable requiring a high priority of corrective action, which concurs with the findings from the cursory field check. Clearance along the inside shoulders of I-55 appears to be less than 4 ft. No notable defects or differences were observed between the



cursory field check and IDOT's structure summary report for: deck geometry, approach alignment, bridge railing appraisal and approach guardrail items. Numerous spalls, previous repairs and asphalt patches are visible on the approach slabs.

Based on the structure summary report and field check, S.N. 016-9820 is suitable for replacement of the deck and rehabilitation of the substructure and superstructure. The approach guardrails should be brought up to current IDOT standards. However, in order to continue the widened bus lane along the inside shoulder of I-55 it may be necessary to fully replace the structure due to lack of adequate horizontal clearance.

LIN ENGINEERING, LTD.

A handwritten signature in blue ink that reads "Michael T. Haley". The signature is written in a cursive, flowing style.

Michael T. Haley, PE, SE
Structural Manager

Appendix A – Photos

Appendix B – IDOT Structure Summary Report



Photo 1

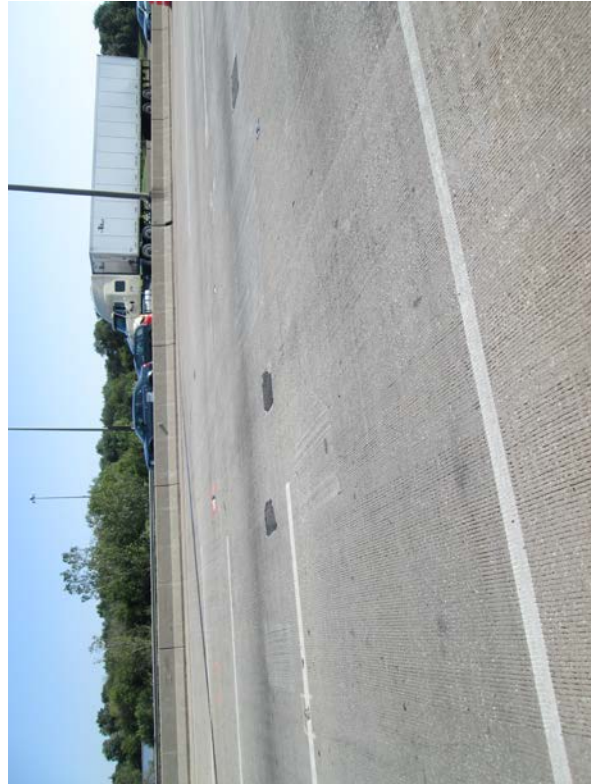


Photo 2



Photo 3



Photo 4



Photo 5



Photo 6

<p>Inventory Data</p> <p>Facility Carried: I-294 SB Feature Crossed: I55 Bridge Status: 1 OPEN - NO RESTRICT Status Remarks: 016 COOK Maint County: 02 ILL. TOLLWAY COMMISSION Service On/Under: 5 SECOND LEVEL INTERCHANGE Reporting Agency: 8 ILLINOIS TOLLWAY AUTHORITY Main Span Matl/Type: 3 STEEL Nbr Of Main Spans: 6 Nbr Of Approach Spans: 0 ***Approaches*** Near #1 Matl/Type: Near #2 Matl/Type: Far #1 Matl/Type: Far #2 Matl/Type: Median Width/Type: Guardrail Type L/R: Toll Facility Indicator: Latitude: Deck Structure Type: A CIP CON NRMALLY FORM Sidewalks Under Structure: 0 None</p>	<p>Bridge Name: I294 AT I55 P10 Location: I294 AT I55 P10 Status Date: 04/1988 Maint Township: 16 LYONS 1 / HIGHWAY / 02 STRINGERMULTI-BEAM/GIRDER / / / /</p>	<p>Sufficiency Rating: 78.3 Structure Length: 498.0 HBP Eligible: Yes AASHTO Bridge Length: 99.9 Replaced By: - Length of Long Span: 156.0 - Bridge Roadway Width: 54.3 07/05/2012 Appr Roadway Width: 52.0 Right Deck Width: 70.0 Sidewalk Width Right: 0.0 Left Sidewalk Width Left: 0.0 Navigation Control: N N/A No Navigation Horiz Clear: 0 No Navigation Vert Clear: 0 Culvert Fill Depth: 0.0 Number Culvert Cells: 0 Bdr State % Responsibility: 0 Culvert Opening Area: 0.0 Structural Steel Wt: 0 Culvert Cell Height: 0.00 Substructure Material: Culvert Cell Width: 0.00 Rated By: 3 Consultant Rate Method: 6 1,920(69) Load Rating Date: 03/02/2011 Railroad Crossing Info 2,750(99) Operating Rating: Crossing 1 Nbr: Design Load: 99 UNKNOWN Crossing 1 Nbr: 0 SD: N FO: Y RR Lateral Underclear: 0.0 Deck Structure Thickness: RR Vertical Underclear: 0 Ft 0 In</p>
--	---	--

<p>Key Route On Data</p> <p>Key Route Nbr: FEDERAL-AID INTERSTATE 0294 Station: 29-5000 Appurtenances Main Route 00000 Inventory County: 016 COOK Township/Road Dist 16 LYONS Municipality 1272 COUNTRYSIDE Urban Area: 1051 Functional Class: 1 INTERSTATE ** CLEARANCES ** South/East North/West Max Rdwy Width: 54.3 Horizontal: 55.8</p>	<p>Inventory Rating: None / 0 Operating Rating: S 87.89285071 None On NHS 2013 / 65550 16 3 1 One-Way 1 2032 / 59586 CLASS I Yes</p>
Key Route Under Data	
<p>FEDERAL-AID INTERSTATE 0055 Station: 1.2500 Main Route 00000 016 LYONS 16 LYONS INDIAN HEAD PARK 1051 1051 1 INTERSTATE South/East North/West 0.0 53.8</p>	<p>Segment: 00000 Linked: Y Natl. Hwy System: On NHS Inventory Direction: INVENTORY DIRECTION Curr AADT Yr/Count: 2014 / 148400 Est Truck Percentage: 8 Number Of Lanes: 4 One Or Two Way: 2 Two-Way Bypass Length: 0 Future AADT Yr/Cnt: 2032 / 84563 Designated Truck Rte: CLASS I Special Systems: Yes</p>
**** Marked Route On Data ****	
<p>Designation Route #1: 1 Mainline Route #2: 1 Mainline Route #3: 1 Mainline</p>	<p>Kind Number 1 Interstate Highway 294 1 Interstate Highway 294</p>

Illinois Department of Transportation
Structures Information Management System
Structure Summary Report

Structure Number: 016-9820 District: 1

*** Inspection Intervals ***
Routin e NBIS: 24 MOS Underwater: 0 MOS One Truck At A Time: 0 Tons Combination Type 3S-1: Tons Bridge Posting Level: 5 No Posting Required
Special: N Single Unit Vehicles: Tons Combination Type 3S-2: Tons

Data Related to Inspection Information
*** Maximum Allowable Posting Limits ***

Inspection/Apraisal Information
Inspection Date: 06/06/2014 Inspection Temperature: 80Deg. F
*** Actual Posted Limits **

Deck: 7 GOOD CONDITION - SOME MINOR PROBLEMS Single Unit Vehicles: Tons
Superstructure: 7 GOOD CONDITION - SOME MINOR PROBLEMS Combination Type 3S-1: Tons
Substructure: 5 FAIR CONDITION - MINOR SECTION LOSS, CRACKS Combination Type 3S-2: Tons
Culvert: N NOT APPLICABLE NOT APPLICABLE One Truck At A Time: 0
Channel and Protection: N NOT APPLICABLE NOT APPLICABLE Last Paint Type:
Structural Evaluation: 5 BETTER THAN ADEQUATE TO BE LEFT IN PLACE Deck Wearing Surf: G BITUMINOUS OVERLAY
Deck Geometry: 6 EQUAL TO PRESENT MINIMUM CRITERIA Deck Membrane: A WATERPROOF MEM SYST
Underclearance-Vert/Lat.: 3 INTOLERABLE - HIGH PRIORITY FOR CORRECTION Deck Protection: J NONE
Waterway Adequacy: N NOT APPLICABLE Total Deck Thick: 0.0
Approach Roadway Align: 8 EQUAL TO PRESENT DESIRABLE CRITERIA Last Paint Date:
Bridge Railing Appraisal: 3 Meets Standards
Approach Guardrail: 22N Not Acceptable Not Acceptable N/A
Pier Navig Protection: N N/A

Underwater Inspection/Apraisal Information

Inspection Date:
Temperature:

Inspection Method:
Appraisal Rating:

Scour Critical Information
Evaluation Method:

Rating:
Analysis Date:

Construction Information
Year: 1958 Original Reconstructed
Route: Sta: 1397+11.79 Sta:
Section Nbr:
Contract Nbr:
Fed Aid Pr#: 00000000000000
Built By: 2 OTHER STATE AGENCY

Microfilm Data Recorded: No

Miscellaneous



October 27, 2015

MEMORANDUM

Mr. John Fortmann, Region One Engineer
Illinois Department of Transportation
Region One/District One

Attn: Steven Schilke

RE: Existing S.N. 016-9821
N.B. I-294 over I-55
Cook County
PTB 158-002/P-91-762-10

The purpose of this technical memo is to summarize the current condition of existing S.N. 016-9821 in addition to geometrics and other factors. A cursory field check was performed to supplement the information contained in IDOT's structure summary report dated June 6, 2014 (see Appendix B). Broad-based recommendations for this structure are provided below.

The structure is a four span steel girder bridge consisting of fourteen lines of simply supported plate girders and built up girders (see Photo 1). Span lengths from south to north are 102'-0", 139'-4", 156'-1" and 98'-0". The superstructure is supported by pile bent abutments and reinforced concrete multi-column piers. The structure summary reports states that the deck has a bituminous overlay. A bituminous overlay was not present during our cursory field check. It is possible that the structure has a concrete overlay instead.

IDOT rates the deck as being in good condition. The findings from the cursory field check don't match IDOT's deck rating. The interior span soffits are hidden from view by shielding and should be assumed to be in poor condition. Minor transverse cracks with leaching are visible on a majority of the exterior span soffits. Numerous spalls, previous repairs and asphalt patches are visible on the top of deck (see Photo 2). IDOT rates the superstructure as being in satisfactory condition, which concurs with the findings from the cursory field check. Minor rusting is visible along the bottom flanges of some built up girders. About half of the abutment fixed bearing anchor bolts are loose or bent (see Photo 3). IDOT rates the substructure as being in satisfactory condition, which concurs with the findings from the cursory field check. Minor spalling is visible on some abutment seats (see Photo 3). Moderate map cracking and a significant amount of previous concrete repair work is visible on the pier columns and caps (see Photo 4). Some of these previous repairs appear to be failing. IDOT rates the underclearance vertical and lateral as being intolerable requiring a high priority of corrective action, which concurs with the findings from the cursory field check. Clearance along the inside shoulders of I-55 appears to be less than 4 ft. No notable defects or differences were observed between the cursory field check and IDOT's structure summary report for: deck, geometry, approach alignment, bridge railing



appraisal and approach guardrail items.

Based on the structure summary report and field check, S.N. 016-9821 is suitable for replacement of the deck and rehabilitation of the substructure and superstructure. The approach guardrails should be brought up to current IDOT standards. However, in order to continue the widened bus lane along the inside shoulder of I-55 it may be necessary to fully replace the structure due to lack of adequate horizontal clearance.

LIN ENGINEERING, LTD.

Michael T. Haley, PE, SE
Structural Manager

Appendix A – Photos

Appendix B – IDOT Structure Summary Report



Photo 1



Photo 2



Photo 3



Photo 4

Illinois Department of Transportation
Structures Information Management System
Structure Summary Report

Structure Number: 016-9821 District: 1

Inventory Data	
Facility Carried:	I-294 NB
Feature Crossed:	I 55
Bridge Remarks:	
Bridge Status:	1 OPEN - NO RESTRICT
Status Remarks:	
Maint County:	016 COOK
Maint Responsibility:	02 ILL. TOLLWAY COMMISSION
Service On/Under:	5 SECOND LEVEL INTERCHANGE
Reporting Agency:	8 ILLINOIS TOLLWAY AUTHORITY
Main Span Matl/Type:	3 STEEL
Nbr Of Main Spans:	6
Nbr Of Approach Spans:	0
Approaches	
Near #1 Matl/Type:	/
Near #2 Matl/Type:	/
Far #1 Matl/Type:	/
Far #2 Matl/Type:	/
Median Width/Type:	0 Ft./0 None
Guardrail Type L/R:	0None / 0
Toll Facility Indicator:	6 Toll Road
Latitude:	41.76071070 S Longitude: 87.89269717 S
Deck Structure Type:	A CIP CON NRMALLY FORM
Sidewalks Under Structure:	0 None
Sufficiency Rating:	89.8
HBP Eligible:	No
Replaces By:	-
Replaces:	-
Last Update Date:	07/05/2012
Parallel Structure:	Left Deck Width:
Multi-Level Structure Nbr:	Sidewalk Width Right:
Skew Direction:	Left Sidewalk Width Left:
Structure Flared:	Navigation Control:
Historical Significance:	No
Border Bridge State:	Navigation Horiz Clear:
Bdr State SN:	No
Bdr State % Responsibility:	Navigation Vert Clear:
Structural Steel Wt:	Culvert Fill Depth:
Substructure Material:	Number Culvert Cells:
Rated By: 3 Consultant	0
Load Rating Date: 03/02/2011	Culvert Cell Height:
Operating Rating: 2.750(99)	0
Design Load: 99 UNKNOWN	Culvert Cell Width:
Deck Structure Thickness:	0
Inventory Rating:	Rate Method:
Operating Rating:	6

Key Route On Data	
Key Route Nbr:	FEDERAL-AID INTERSTATE 0294
Station:	29.5100
Segment:	00000
Linked:	Y
Natl. Hwy System:	On NHS
Inventory Direction:	COUNTRYSIDE
Curr AADT Yr/Count:	2013 / 65550
Est Truck Percentage:	16
Number Of Lanes:	3
One Or Two Way:	1 One-Way
Bypass Length:	1
Future AADT Yr/Cnt:	2032 / 59586
Designated Truck Rte:	CLASS I
Special Systems:	Yes
Designation:	1 Interstate Highway
Kind:	Number
1 Mainline	294
1 Mainline	
1 Mainline	

Key Route Under Data	
Key Route Nbr:	FEDERAL-AID INTERSTATE 0055
Station:	1.2700
Segment:	00000
Linked:	Y
Natl. Hwy System:	On NHS
Inventory Direction:	INDIAN HEAD PARK
Curr AADT Yr/Count:	2014 / 148400
Est Truck Percentage:	8
Number Of Lanes:	4
One Or Two Way:	2 Two-Way
Bypass Length:	0
Future AADT Yr/Cnt:	2032 / 84563
Designated Truck Rte:	CLASS I
Special Systems:	Yes
Designation:	1 Interstate Highway
Kind:	Number
1 Mainline	055
1 Mainline	
1 Mainline	

**** Marked Route On Data ****	
Designation:	1 Mainline
Kind:	Number
1 Interstate Highway	294
1 Mainline	
1 Mainline	

**** Marked Route Under Data ****	
Designation:	1 Mainline
Kind:	Number
1 Interstate Highway	055
1 Mainline	
1 Mainline	

**Illinois Department of Transportation
Structures Information Management System
Structure Summary Report**

Structure Number: 016-9821 District: 1

Data Related to Inspection Information

*** Inspection Intervals ***
 Routine NBIS: 24 MOS Underwater: 0 MOS One Truck At A Time: 0 Combination Type 3S-1: Tons
 Special: N Single Unit Vehicles: Tons Combination Type 3S-2: Tons
 Bridge Posting Level: 5 No Posting Required

Inspection/Appraisal Information

Inspection Date: 06/06/2014 Inspection Temperature: 80Deg. F
 Deck: 7 GOOD CONDITION - SOME MINOR PROBLEMS
 Superstructure: 6 SATISFACTORY CONDITION - MINOR DETERIORATION
 Substructure: 6 SATISFACTORY CONDITION - MINOR DETERIORATION
 Culvert: N NOT APPLICABLE
 Channel and Protection: N NOT APPLICABLE
 Structural Evaluation: 6 EQUAL TO PRESENT MINIMUM CRITERIA
 Deck Geometry: 6 EQUAL TO PRESENT MINIMUM CRITERIA
 Underclearance-Vert/Lat.: 3 INTOLERABLE - HIGH PRIORITY FOR CORRECTION
 Waterway Adequacy: N NOT APPLICABLE
 Approach Roadway Align: 8 EQUAL TO PRESENT DESIRABLE CRITERIA
 Bridge Railing Appraisal: 3 Meets Standards
 Approach Guardrail: 22N Not Acceptable
 Pier Navig Protection: N N/A

Deck Wearing Surf: G BITUMINOUS OVERLAY
 Deck Membrane: A WATERPROOF MEM SYST
 Deck Protection: J NONE
 Total Deck Thick: 0.0
 Last Paint Date:
 Single Unit Vehicles: Tons
 Combination Type 3S-1: Tons
 Combination Type 3S-2: Tons
 One Truck At A Time: 0
 Last Paint Type:

Underwater Inspection/Appraisal Information

Inspection Date:
 Temperature:
 Inspection Method:
 Appraisal Rating:

Scour Critical Information

Rating:
 Analysis Date:
 Evaluation Method:
 Microfilm Data Recorded: No

Construction Information

Year: 1958 Original
 Route: Sta: 1397+11.79 Reconstructed
 Section Nbr:
 Contract Nbr:
 Fed Aid Pr#: 00000000000000
 Built By: 2 OTHER STATE AGENCY

Miscellaneous



October 27, 2015

MEMORANDUM

Mr. John Fortmann, Region One Engineer
Illinois Department of Transportation
Region One/District One

Attn: Steven Schilke

RE: Existing S.N. 022-0003
I-55 over Madison St.
DuPage County
PTB 158-002/P-91-762-10

The purpose of this technical memo is to summarize the current condition of existing S.N. 022-0003 in addition to geometrics and other factors. A cursory field check was performed to supplement the information contained in IDOT's structure summary report dated November 21, 2013 (see Appendix B). Broad-based recommendations for this structure are provided below.

The structure is a three span PPC I-beam bridge consisting of twenty-two lines of continuous beams (see Photo 1). Span lengths from west to east are 57'-6 1/2", 49'-4" and 57'-6 1/2". The superstructure is supported by pile bent abutments and reinforced concrete multi-column piers. There is no overlay on the structure.

IDOT rates the deck as being in good condition, which concurs with the findings from the cursory field check. Minor transverse cracks with leaching are visible on a majority of the soffit (see Photo 2). IDOT rates the superstructure as being in satisfactory condition, which concurs with the findings from the cursory field check. Stirrup bars are exposed up to half the perimeter of bottom flanges at a few beam ends over the fixed piers. Beam ends at both the north and south abutments are spalled exposing prestressing strands (see Photo 3). IDOT rates the substructure as being in satisfactory condition. The findings from the cursory field check don't match IDOT's substructure rating. Significant spalling with probable section loss is visible on pier caps (see Photo 4). Minor cracking and spalling is visible on columns and abutments. No notable defects or differences were observed between the cursory field check and IDOT's structure summary report for: deck geometry, underclearance vert/lat, approach alignment, bridge railing appraisal and approach guardrail items. Anchor blocks are damaged or missing along sections of both expansion joints (see Photo 5). Large pot holes in the asphalt shoulders are present where shoulders and approach slabs meet (see Photo 6). Minor to moderate diagonal cracks are visible on both approaches.

Based on the structure summary report and field check, S.N. 022-0003 is suitable for reuse after rehabilitation of the substructure, superstructure and expansion joints. The approach guardrail



LIN ENGINEERING, LTD.
Consulting Engineers

Springfield, IL Westmont, IL

576 Oakmont Lane
Westmont, Illinois 60559
Telephone: (630) 323-5168
Fax: (630) 323-5174
E-mail: info@lineng.com

transitions should be brought up to current IDOT standards.

LIN ENGINEERING, LTD.

A handwritten signature in blue ink that reads "Michael T. Haley". The signature is written in a cursive, flowing style.

Michael T. Haley, PE, SE
Structural Manager

Appendix A – Photos

Appendix B – IDOT Structure Summary Report

Appendix C – PONTIS Report



Photo 1



Photo 2



Photo 3



Photo 4



Photo 5



Photo 6

Illinois Department of Transportation
Structures Information Management System
Structure Summary Report

Structure Number: 022-0003 District: 1

Inventory Data	
Facility Carried:	I-55
Feature Crossed:	MADISON ST
Bridge Status:	MAX=64' ORIGINALLY TWO STRUCTURES.
Status Remarks:	1 OPEN - NO RESTRICT
Maint County:	022 DUPAGE
Maint Responsibility:	01 I.D.O.T.
Service On/Under:	1 HIGHWAY
Reporting Agency:	1 I.D.O.T. - BUREAU OF MAINTENANCE
Main Span Matl/Type:	6 PRESTRESS CONCRETE CONTINUOUS / 02 STRINGERMULTI-BEAM/GIRDER
Nbr Of Main Spans:	3
Approaches	
Near #1 Matl/Type:	3 Ft. / 4 Wall
Near #2 Matl/Type:	0 None
Far #1 Matl/Type:	41.74726236 S Longitude:
Far #2 Matl/Type:	0 None
Median Width/Type:	0 No Toll
Guardrail Type L/R:	0 No Toll
Toll Facility Indicator:	0 None
Latitude:	41.74726236 S Longitude:
Deck Structure Type:	A CIP CON NRMALLY FORM
Sidewalks Under Structure:	0 None
Inventory Data	
Sufficiency Rating:	96.0
HBP Eligible:	No
Replaced By:	-
Last Update Date:	07/05/2012
Parallell Structure:	None
Multi-Level Structure Nbr:	0
Skew Direction:	L
Skew Angle:	42 D
Structure Flared:	No
Historical Significance:	No
Border Bridge State:	IL
Bdr State SN:	0
Bdr State % Responsibility:	0
Structural Steel Wt:	0
Substructure Material:	0
Rated By:	2 IDOT
Inventory Rating:	1.635(58)
Operating Rating:	2.635(94)
Design Load:	01 HS20+MOD
Deck Structure Thickness:	7.5 SD: N FC: N
RR Vertical Underclear:	0
RR Lateral Underclear:	0
RR Crossing 1 Nbr:	0
RR Crossing 2 Nbr:	0
Key Route On Data		
Key Route Nbr:	FEDERAL-AID INTERSTATE	
Station:	0055	
Segment:	5.6900	
Main Route:	00000	
Linked:	Y	
Natl. Hwy System:	On NHS	
Inventory Direction:	022 DUPAGE	
Current AADT Yr/Count:	6240 WILLOWBROOK	
Est Truck Percentage:	1051	
Number Of Lanes:	1 INTERSTATE	
One Or Two Way:	North/West	
Bypass Length:	68.3	
Future AADT Yr/Cnt:	2032 / 194950	
Designated Truck Rte:	CLASS I	
Special Systems:	Yes	
Key Route Under Data		
Key Route Nbr:	FEDERAL-AID URBAN	
Station:	2674	
Segment:	4.8900	
Main Route:	00000	
Linked:	Y	
Natl. Hwy System:	Not on NHS	
Inventory Direction:	003 DOWNERS GROVE	
Current AADT Yr/Count:	1051 1051	
Est Truck Percentage:	5 MAJOR COLLECTOR	
Number Of Lanes:	South/East North/West	
One Or Two Way:	25.5	
Bypass Length:	33.0	
Future AADT Yr/Cnt:	2032 / 2785	
Designated Truck Rte:	NONE	
Special Systems:	No	
**** Marked Route On Data ****		
Designation	Kind	Number
Route #1:	1 Mainline	055
Route #2:	1 Mainline	055
Route #3:	1 Mainline	055

Illinois Department of Transportation
Structures Information Management System
Structure Summary Report

Structure Number: 022-0003 District: 1

*** Inspection Intervals *** Data Related to Inspection Information

Routine NBIS: 24 MOS Underwater: 0 MOS One Truck At A Time: 0 Tons Bridge Posting Level: 5 No Posting Required
Special: N Single Unit Vehicles: Tons Combination Type 3S-1: Tons Combination Type 3S-2: Tons

Inspection/Appraisal Information

Inspection Date: 11/21/2013 Inspection Temperature: 50Deg. F
Deck: 7 GOOD CONDITION - SOME MINOR PROBLEMS
Superstructure: 6 SATISFACTORY CONDITION - MINOR DETERIORATION
Substructure: 6 SATISFACTORY CONDITION - MINOR DETERIORATION
Culvert: N NOT APPLICABLE
Channel and Protection: N NOT APPLICABLE
Structural Evaluation: 6 EQUAL TO PRESENT MINIMUM CRITERIA
Deck Geometry: 9 SUPERIOR TO PRESENT DESIRABLE CRITERIA
Underclearance-Vert/Lat.: 4 MINIMUM ADEQUACY TO BE LEFT IN PLACE
Waterway Adequacy: N NOT APPLICABLE
Approach Roadway Align: 8 EQUAL TO PRESENT DESIRABLE CRITERIA
Bridge Railing Appraisal: 3 Meets Standards
Approach Guardrail: 233 Not Acceptable Acceptable
Pier Navig Protection: N N/A

Deck Wearing Surf: A BARE DECK NO OVRLAY
Deck Membrane: F NONE
Deck Protection: A EPOXY COATED REINF
Total Deck Thick: 7.5
Last Paint Date:

*** Actual Posted Limits **
Single Unit Vehicles: Tons
Combination Type 3S-1: Tons
Combination Type 3S-2: Tons
One Truck At A Time: 0
Last Paint Type:

Underwater Inspection/Appraisal Information

Inspection Date:
Temperature:
Inspection Method:
Appraisal Rating:

Scour Critical Information

Rating:
Analysis Date:
Evaluation Method:
Microfilm Data Recorded: Yes

Construction Information

Year: 1959 Original 1996 Reconstructed
Route: FAI-55 Sta: 1023+92.08 FAI-55 Sta: 1023+92.08
Section Nbr: 22-1HB-1 22-1HB-1
Contract Nbr: 82453
Fed Aid Pr#: I 0036005000 NHI556(197)270
Built By: 1 I.D.O.T. 1 I.D.O.T.

Pontis

Today's Date: 08/27/2015

Structure Number: 022-0003 District: 1 (41) Bridge Status: 1 OPEN - NO RESTRICT
 (6) Feature Crossed: MADISON ST (7) Facility Carried: I-55
 (9) Location: 0.6 M NE OF IL 83 (7A) Bridge Name:
 Element Inspection Date: 11/21/2013
 (90E) Agency Program Manager: SEDLACEKJL (90E3) Consultant Program Manager:
 (90E1) Team Leader: (90E2) Inspector:

Element Insp. Delinquent		Element Insp. Delinquent Reason:								
Element Description										
Elem	Env	% 1	Qty 1	% 2	Qty 2	% 3	Qty 3	% 4	Qty 4	Tot Qty
P/S Conc Open Girder										
109	4	99	3,580	0	0	1	50	0	0	3,630
		No deterioration	Minor cracks/spalls		Delams/spalls		Analysis warranted			
Remarks: Span 2 Bott Flange spalls w/exp strands @ Bm#19, 20 & 21. Span 2 Top Flange spall ed @ Bm#7										
Reinforced Conc Column or Pile Extension										
205	3	94	3,298	0	6	6	220	0	0	3,524
		No deterioration	Minor cracks/spalls		Delams/spalls		Analysis warranted			
Remarks: Few areas of med vert crking w/delams. Pier 1 & 2 sm spalls w/exp rebar										
Reinforced Conc Pier Wall										
210	3	96	2,159	0	0	4	80	0	0	2,239
		No deterioration	Minor cracks/spalls		Delams/spalls		Analysis warranted			
Remarks:										
Reinforced Conc Abutment										
215	3	97	2,252	0	0	3	62	0	0	2,314
		No deterioration	Minor cracks/spalls		Delams/spalls		Analysis warranted			
Remarks: Backwall) Some It spalling @ hor const jt.; Wings) Nar Vert crks										
Reinforced Conc Pier or Abutment Cap										
234	3	52	394	5	40	42	320	0	0	754
		No deterioration	Minor cracks/spalls		Delams/spalls		Analysis warranted			
Remarks: Pier 1 & 2 spalls, exp rebar & delam@undersides. FCR failing in some areas.										
Elastomeric Bearing										
310	4	0	0	100	88	0	0	0	0	88
		No deterioration	Minor deterioration		Major deterioration					
Remarks: Many assemblies have initial rust; N Fascia Brng @W Abut lipping up										
Concrete Bridge Railing										
331	4	0	0	100	672	0	0	0	0	672
		No deterioration	Minor cracks/spalls		Analysis warranted					
Remarks: HL vert crks typ.										

Concrete Deck Protected w/ Coated Bars										
8026	4	96	23,259	4	850	0	0	0	0	24,109
Remarks: (WS) Nar transv & random crking, esp SB lanes; Soffit HL-Nar trans leach crks										
P/S Conc Beam Ends Incl Diaphragms Under Deck Joint										
8237	4	0	0	0	0	100	44	0	0	44
Remarks: Most ends have minor crks & small spalls w/exp strands & stirrups @ Span 2 Brms #4, 7&14										
Neoprene Expansion Joint										
8307	4	0	0	0	0	89	332	11	42	374
Remarks: Plow damaged; leaks @both Abuts; Sections missing I55N WAbut-Ln1 (6ft), EAbut-Ln1 (6ft), Ln2 (6ft), Ln3 (12ft); I55S WAbut-Ln3 (6ft), EAbut-Ln2 (6ft)										
Approach Pavement										
8323	4	100	4	0	0	0	0	0	0	4
Remarks: Nar-med diag crks @ all										



October 27, 2015

MEMORANDUM

Mr. John Fortmann, Region One Engineer
Illinois Department of Transportation
Region One/District One

Attn: Steven Schilke

RE: Existing S.N. 022-0050
S.B. IL 83 over I-55
DuPage County
PTB 158-002/P-91-762-10

The purpose of this technical memo is to summarize the current condition of existing S.N. 022-0050 in addition to geometrics and other factors. A cursory field check was performed to supplement the information contained in IDOT's structure summary report dated January 15, 2015 (see Appendix B). Broad-based recommendations for this structure are provided below.

The structure is a four span steel beam bridge consisting of nine lines of continuous beams (see Photo 1). Span lengths from south to north are 91'-3", 77'-1", 77'-1" and 91'-3". The superstructure is supported by pile bent abutments and reinforced concrete multi-column piers. There is no overlay on the structure.

IDOT rates the deck as being in good condition, which concurs with the findings from the cursory field check. Minor transverse cracking is visible on a majority of the top of deck. IDOT rates the superstructure as being in good condition, which concurs with the findings from the cursory field check. Minor rusting is visible on bottom flanges of most beams (see Photo 2). IDOT rates the substructure as being in good condition, which concurs with the findings from the cursory field check. Minor cracking is visible on pier caps and crashwalls (see Photo 3). No notable defects or differences were observed between the cursory field check and IDOT's structure summary report for: deck geometry, underclearance vert/lat, approach alignment, bridge railing appraisal and approach guardrail items.

Based on the structure summary report and field check, S.N. 022-0050 is suitable for reuse without rehabilitation. The approach guardrail transitions should be brought up to current IDOT standards.



LIN ENGINEERING, LTD.
Consulting Engineers

Springfield, IL Westmont, IL

576 Oakmont Lane
Westmont, Illinois 60559
Telephone: (630) 323-5168
Fax: (630) 323-5174
E-mail: info@lineng.com

LIN ENGINEERING, LTD.

A handwritten signature in blue ink that reads "Michael T. Haley". The signature is written in a cursive, flowing style.

Michael T. Haley, PE, SE
Structural Manager

Appendix A – Photos

Appendix B – IDOT Structure Summary Report

Appendix C – PONTIS Report



Photo 1

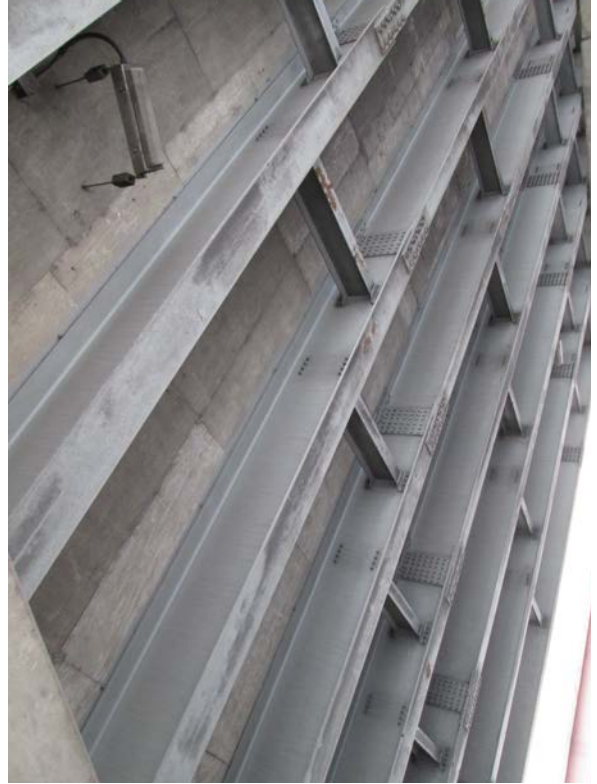


Photo 2



Photo 3

Illinois Department of Transportation
Structures Information Management System
Structure Summary Report

Structure Number: 022-0050 District: 1

Inventory Data	
Facility Carried:	IL 83 SB
Feature Crossed:	I-55
Bridge Remarks:	
Bridge Status:	1 OPEN - NO RESTRICT
Status Remarks:	
Maint County:	022 DUPAGE
Maint Responsibility:	01 I.D.O.T.
Service On/Under:	5 SECOND LEVEL INTERCHANGE 1 / HIGHWAY
Reporting Agency:	1 I.D.O.T. - BUREAU OF MAINTENANCE
Main Span Matl/Type:	4 STEEL CONTINUOUS
Nbr Of Main Spans:	4 Nbr Of Approach Spans: 0
Approaches	
Near #1 Matl/Type:	/
Near #2 Matl/Type:	/
Far #1 Matl/Type:	/
Far #2 Matl/Type:	/
Median Width/Type:	0 Ft. / 0 None / 0
Guardrail Type L/R:	0 None / 0
Toll Facility Indicator:	0 No Toll
Latitude:	41.74191000 S Longitude: 87.94453000 S
Deck Structure Type:	A CIP CON NRMALLY FORM
Sidewalks Under Structure:	0 None
Sufficiency Rating:	99.0
HBP Eligible:	No
Replaced By:	- Length of Long Span: 92.3
Replaces:	- Bridge Roadway Width: 58.1
Last Update Date:	06/21/2014
Parallel Structure:	Left Deck Width: 61.4
Multi-Level Structure Nbr:	Sidewalk Width Right: 0.0
Skew Angle:	27 D Right Sidewalk Width Left: 0.0
Structure Flared:	Navigation Control: N
Historical Significance:	Yes Navigation Horiz Clear: 0
Border Bridge State:	No Navigation Vert Clear: 0
Bdr State SN:	Culvert Fill Depth: 0.0
Bdr State % Responsibility:	0 Culvert Opening Cells: 0
Structural Steel Wt:	639722 Culvert Cell Height: 0.00
Substructure Material:	Culvert Cell Width: 0.00
Rated By:	2 IDOT
Load Rating Date:	06/05/2002
Operating Rating:	2.750(99)
Design Load:	02 HS20
Deck Structure Thickness:	7.5 SD: N FO: N
RR Vertical Underclear:	0 Ft 0 In
Inventory Rating:	1.650(59)
Operating Rating:	2.750(99)
Design Load:	02 HS20
Deck Structure Thickness:	7.5 SD: N FO: N
RR Vertical Underclear:	0 Ft 0 In

Key Route On Data	
Key Route Nbr:	FEDERAL-AID PRIMARY 0344 Station: 17.5900
Appurtenances Main Route	00000
Inventory County:	022 DUPAGE
Township/Road Dist	03 DOWNERS GROVE
Municipality	0000
Urban Area:	1051
Functional Class:	3 OTHER PRINCIPAL ARTERIAL
** CLEARANCES **	South/East North/West
Max Rdwy Width:	58.1
Horizontal:	59.3
Vertical:	0.0
Natl. Hwy System:	On NHS
Inventory Direction:	2013 / 23650
Curr AADT Yr/Count:	13
Est Truck Percentage:	3
Number Of Lanes:	1 One-Way
One Or Two Way:	0
Bypass Length:	2032 / 26235
Future AADT Yr/Cnt:	CLASS II
Designated Truck Rte:	Yes
Special Systems:	Yes

Key Route Under Data	
Key Route Nbr:	FEDERAL-AID INTERSTATE 0055 Station: 5.0600
Appurtenances Main Route	00000
Inventory County:	033 DOWNERS GROVE
Township/Road Dist	1051 1051
Municipality	1 INTERSTATE
Urban Area:	65.5
Functional Class:	1 One-Way
** CLEARANCES **	South/East North/West
Max Rdwy Width:	65.5
Horizontal:	65.5
Vertical:	0
Natl. Hwy System:	On NHS
Inventory Direction:	2014 / 135100
Curr AADT Yr/Count:	12
Est Truck Percentage:	10
Number Of Lanes:	2 Two-Way
One Or Two Way:	0
Bypass Length:	2021 / 179820
Future AADT Yr/Cnt:	CLASS I
Designated Truck Rte:	Yes
Special Systems:	Yes

**** Marked Route On Data ****		
Designation	Kind	Number
1 Mainline	3 State Highway	083
1 Mainline		
1 Mainline		

**** Marked Route Under Data ****		
Designation	Kind	Number
1 Mainline	1 Interstate Highway	055
1 Mainline		
1 Mainline		

**Illinois Department of Transportation
Structures Information Management System
Structure Summary Report**

Structure Number: 022-0050 District: 1

Data Related to Inspection Information

*** Inspection Intervals ***
 Routine NBIS: 24 MOS Underwater: 0 MOS One Truck At A Time: 0 Tons
 Special: N Single Unit Vehicles: 0 Tons
 *** Maximum Allowable Posting Limits ***
 Bridge Posting Level: 5 No Posting Required

Inspection/Appraisal Information

Inspection Date: 01/15/2015 Inspection Temperature: 19Deg. F
 Deck: 7 GOOD CONDITION - SOME MINOR PROBLEMS
 Superstructure: 7 GOOD CONDITION - SOME MINOR PROBLEMS
 Substructure: 7 GOOD CONDITION - SOME MINOR PROBLEMS
 Culvert: N NOT APPLICABLE
 Channel and Protection: N NOT APPLICABLE
 Structural Evaluation: 7 BETTER THAN PRESENT MINIMUM CRITERIA
 Deck Geometry: 9 SUPERIOR TO PRESENT DESIRABLE CRITERIA
 Underclearance-Vert/Lat.: 5 BETTER THAN ADEQUATE TO BE LEFT IN PLACE
 Waterway Adequacy: N NOT APPLICABLE
 Approach Roadway Align: 8 EQUAL TO PRESENT DESIRABLE CRITERIA
 Bridge Railing Appraisal: 3 Meets Standards
 Approach Guardrail: 233 Not Acceptable
 Pier Navig Protection: N N/A

Deck Wearing Surf: A BARE DECK NO OVRLAY
 Deck Membrane: F NONE
 Deck Protection: A EPOXY COATED REINF
 Total Deck Thick: 7.5
 Last Paint Date: 05/2002

Single Unit Vehicles: Tons
 Combination Type 3S-1: Tons
 Combination Type 3S-2: Tons
 One Truck At A Time: 0
 Last Paint Type: S
 SHP ZINC&FLD ACRYL

** Actual Posted Limits **

Underwater Inspection/Appraisal Information

Inspection Date: Inspection Method: Appraisal Rating:
 Temperature: Evaluation Method:

Scour Critical Information

Rating: Evaluation Method: Microfilm Data Recorded: Yes
 Analysis Date:

Construction Information

Year: 1959 Original 2001 Reconstructed
 Route: FAI-55 Sta: 989+99.25 IL RT83 Sta: 4+265.44
 Section Nbr: 22-1HB-2 22-1HB-2-R
 Contract Nbr: 60276
 Fed Aid Pr#: I 0556005271
 Built By: 1 I.D.O.T. 1 I.D.O.T.

Pontis

Today's Date: 08/27/2015

Structure Number: 022-0050 District: 1 (41) Bridge Status: 1 OPEN - NO RESTRICT
 (6) Feature Crossed: I- 55 (7) Facility Carried: IL 83 SB
 (9) Location: 1.2 MI NW COOK CO (7A) Bridge Name:
 Element Inspection Date: 01/15/2015
 (90E) Agency Program Manager: MastnySC (90E3) Consultant Program Manager:
 (90E1) Team Leader: MastnySC (90E2) Inspector:

Element Insp. Delinquent		Element Insp. Delinquent Reason:									
Element Description											
Elem	Env	% 1	Qty 1	% 2	Qty 2	% 3	Qty 3	% 4	Qty 4	Tot Qty	
Reinforced Conc Column or Pile Extension											
205	4	100	1,516	0	0	0	0	0	0	1,516	
		No deterioration	Minor cracks/spalls	Delams/spalls	Analysis warranted						
Remarks:											
Reinforced Conc Pier Wall											
210	4	97	1,814	3	50	0	0	0	0	1,864	
		No deterioration	Minor cracks/spalls	Delams/spalls	Analysis warranted						
Remarks:											
Reinforced Conc Abutment											
215	4	100	931	0	0	0	0	0	0	931	
		No deterioration	Minor cracks/spalls	Delams/spalls	Analysis warranted						
Remarks:											
Reinforced Conc Pier or Abutment Cap											
234	4	97	345	3	10	0	0	0	0	355	
		No deterioration	Minor cracks/spalls	Delams/spalls	Analysis warranted						
Remarks:											
Elastomeric Bearing											
310	4	100	36	0	0	0	0	0	0	36	
		No deterioration	Minor deterioration	Major deterioration							
Remarks:											
Fixed Bearing											
313	4	100	9	0	0	0	0	0	0	9	
		No deterioration	Minor deterioration	Advanced corrosion							
Remarks:											
Concrete Bridge Railing											
331	4	100	338	0	0	0	0	0	0	338	
		No deterioration	Minor cracks/spalls	Analysis warranted							
Remarks:											

Concrete Deck Protected w/ Coated Bars										
8026	4	97	20,923	0	0	3	600	0	0	21,523
Remarks:										
Non-Lead Painted Steel Open Girder										
8118	4	100	32,551	0	0	0	0	0	0	32,551
Remarks:										
Non-Lead Painted Steel Closed Web/Box Girder Ends										
8173	4	100	18	0	0	0	0	0	0	18
Remarks:										
Continuous Seal Neoprene Expansion Joint										
8308	4	0	0	87	122	13	18	0	0	140
Remarks:										
Approach Pavement										
8323	4	100	2	0	0	0	0	0	0	2
Remarks:										



October 27, 2015

MEMORANDUM

Mr. John Fortmann, Region One Engineer
Illinois Department of Transportation
Region One/District One

Attn: Steven Schilke

RE: Existing S.N. 022-0051
N.B. IL 83 over I-55
Dupage County
PTB 158-002/P-91-762-10

The purpose of this technical memo is to summarize the current condition of existing S.N. 022-0051 in addition to geometrics and other factors. A cursory field check was performed to supplement the information contained in IDOT's structure summary report dated January 15, 2015 (see Appendix B). Broad-based recommendations for this structure are provided below.

The structure is a four span steel beam bridge consisting of nine lines of continuous beams (see Photo 1). Span lengths from south to north are 91'-3", 77'-1", 77'-1" and 91'-3". The superstructure is supported by pile bent abutments and reinforced concrete multi-column piers. There is no overlay on the structure.

IDOT rates the deck as being in good condition. The findings from the cursory field check don't match IDOT's deck rating. Transverse cracks weren't visible on the deck soffit. IDOT rates the superstructure as being in good condition, which concurs with the findings from the cursory field check. Minor rusting is visible on the bottom flanges of most beams (see Photo 2). IDOT rates the substructure as being in good condition, which concurs with the findings from the cursory field check. Minor cracking is visible on the abutments and piers. No notable defects or differences were observed between the cursory field check and IDOT's structure summary report for: deck geometry, underclearance vert/lat, approach alignment, bridge railing appraisal and approach guardrail items. Anchor blocks are missing along sections of the north expansion joint (see Photo 3).

Based on the structure summary report and field check, S.N. 022-0051 is suitable for reuse after rehabilitation of the expansion joints. The approach guardrail transitions should be brought up to current IDOT standards.



LIN ENGINEERING, LTD.
Consulting Engineers

Springfield, IL Westmont, IL

576 Oakmont Lane
Westmont, Illinois 60559
Telephone: (630) 323-5168
Fax: (630) 323-5174
E-mail: info@lineng.com

LIN ENGINEERING, LTD.

A handwritten signature in blue ink that reads "Michael T. Haley". The signature is written in a cursive style.

Michael T. Haley, PE, SE
Structural Manager

Appendix A – Photos

Appendix B – IDOT Structure Summary Report

Appendix C – PONTIS Report



Photo 1

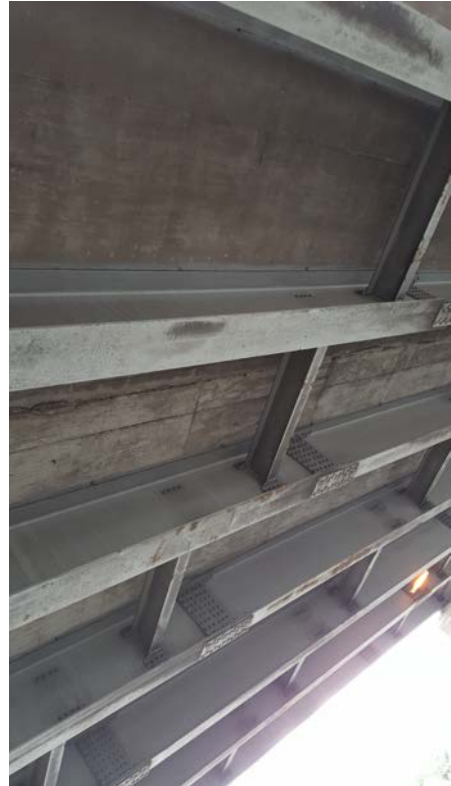


Photo 2



Photo 3

**Illinois Department of Transportation
Structures Information Management System
Structure Summary Report**

Structure Number: 022-0051 District: 1

Inventory Data	
Facility Carried:	IL 83 NB
Feature Crossed:	I-55
Bridge Remarks:	
Bridge Status:	1 OPEN - NO RESTRICT
Status Remarks:	
Maint County:	022 DUPAGE
Maint Responsibility:	01 I.D.O.T.
Service On/Under:	5 SECOND LEVEL INTERCHANGE 1 / HIGHWAY
Reporting Agency:	1 I.D.O.T. - BUREAU OF MAINTENANCE
Main Span Matl/Type:	4 STEEL CONTINUOUS
Nbr Of Main Spans:	4 Nbr Of Approach Spans: 0
Approaches	
Near #1 Matl/Type:	/
Near #2 Matl/Type:	/
Far #1 Matl/Type:	/
Far #2 Matl/Type:	/
Median Width/Type:	0 Ft./0 None / 0 None
Guardrail Type L/R:	0 None / 0 None
Toll Facility Indicator:	0 No Toll
Latitude:	41.74177134 S Longitude: 87.94452502 S
Deck Structure Type:	A CIP CON NRMALLY FORM
Sidewalks Under Structure:	0 None
Sufficiency Rating:	99.0 Structure Length: 342.6
HBP Eligible:	No AASHTO Bridge Length: 99.9
Replaced By:	- Length of Long Span: 92.3
Replaces:	- Bridge Roadway Width: 58.1
Last Update Date:	06/21/2014 Appr Roadway Width: 51.8
Parallel Structure:	Right Deck Width: 61.4
Multi-Level Structure Nbr:	Sidewalk Width Right: 0.0
Skew Direction:	Right Sidewalk Width Left: 0.0
Skew Angle:	Navigation Control: N N/A
Structure Flared:	Navigation Horiz Clear: 0
Historical Significance:	Navigation Vert Clear: 0
Border Bridge State:	Culvert Fill Depth: 0.0
Bdr State SN:	Number Culvert Cells: 0
Bdr State % Responsibility:	0 Culvert Opening Area: 0.0
Structural Steel Wt:	Culvert Cell Height: 0.00
Substructure Material:	Culvert Cell Width: 0.00
Rated By:	2 IDOT Rate Method: 6
Inventory Rating:	1.650(59) Load Rating Date: 06/05/2002 Railroad Crossing Info
Operating Rating:	2.750(99) Crossing 1 Nbr:
Design Load:	02 HS20 Crossing 1 Nbr:
Deck Structure Thickness:	7.5 SD: N FO: N RR Lateral Underclear: 0.0
	RR Vertical Underclear: 0 Ft 0 In

Key Route On Data

Key Route Nbr:	FEDERAL-AID PRIMARY	Station:	0344	17.6000
Appurtenances	Main Route	Segment:	00000	
Inventory County:	022 DUPAGE	Linked:	Y	
Township/Road Dist	03 DOWNERS GROVE	Natl. Hwy System:	On NHS	
Municipality	0000	Inventory Direction:		
Urban Area:	1051	Curr AADT Yr/Count:	2013 / 16400	
Functional Class:	3 OTHER PRINCIPAL ARTERIAL	Est Truck Percentage:	9	
** CLEARANCES **	South/East	Number Of Lanes:	3	
Max Rdwy Width:	58.1	One Or Two Way:	1 One-Way	
Horizontal:	59.3	Bypass Length:	0	
		Future AADT Yr/Cnt:	2032 / 26235	
		Designated Truck Rte:	CLASS II	
Laterals:		Special Systems:	Yes	

Key Route Under Data

FEDERAL-AID INTERSTATE	Station:	0055	5.0800
Main Route	Segment:	00000	
022	Linked:	Y	
003 DOWNERS GROVE	Natl. Hwy System:	On NHS	
0000	Inventory Direction:		
1051 1051	Curr AADT Yr/Count:	2014 / 135100	
1 INTERSTATE	Est Truck Percentage:	12	
South/East	Number Of Lanes:	10	
65.5	One Or Two Way:	2 Two-Way	
65.5	Bypass Length:	0	
	Future AADT Yr/Cnt:	2021 / 179820	
	Designated Truck Rte:	CLASS I	
	Special Systems:	Yes	

****** Marked Route On Data ******

Designation	Kind	Number
1 Mainline	3 State Highway	083
1 Mainline		
1 Mainline		

****** Marked Route Under Data ******

Designation	Kind	Number
1 Mainline	1 Interstate Highway	055
1 Mainline		
1 Mainline		

**Illinois Department of Transportation
Structures Information Management System
Structure Summary Report**

Structure Number: 022-0051 District: 1

Data Related to Inspection Information

*** Inspection Intervals ***
 Routine NBIS: 24 MOS Underwater: 0 MOS One Truck At A Time: 0 Combination Type 3S-1: Tons
 Special: N Single Unit Vehicles: Tons Combination Type 3S-2: Tons
 Bridge Posting Level: 5 No Posting Required

Inspection/Appraisal Information

Inspection Date: 01/15/2015 Inspection Temperature: 19Deg. F
 Deck: 7 GOOD CONDITION - SOME MINOR PROBLEMS
 Superstructure: 7 GOOD CONDITION - SOME MINOR PROBLEMS
 Substructure: 7 GOOD CONDITION - SOME MINOR PROBLEMS
 Culvert: N NOT APPLICABLE
 Channel and Protection: N NOT APPLICABLE
 Structural Evaluation: 7 BETTER THAN PRESENT MINIMUM CRITERIA
 Deck Geometry: 9 SUPERIOR TO PRESENT DESIRABLE CRITERIA
 Underclearance-Vert/Lat.: 5 BETTER THAN ADEQUATE TO BE LEFT IN PLACE
 Waterway Adequacy: N NOT APPLICABLE
 Approach Roadway Align: 8 EQUAL TO PRESENT DESIRABLE CRITERIA
 Bridge Railing Appraisal: 3 Meets Standards
 Approach Guardrail: 233 Not Acceptable
 Pier Navig Protection: N N/A

Deck Wearing Surf: A BARE DECK NO OVRLAY
 Deck Membrane: F NONE
 Deck Protection: A EPOXY COATED REINF
 Total Deck Thick: 7.5
 Last Paint Date: 05/2002

*** Actual Posted Limits ***
 Single Unit Vehicles: Tons
 Combination Type 3S-1: Tons
 Combination Type 3S-2: Tons
 One Truck At A Time: 0
 Last Paint Type: S
 SHP ZINC&FLD ACRYL

Underwater Inspection/Appraisal Information

Inspection Date:
 Temperature:
 Inspection Method:
 Appraisal Rating:

Scour Critical Information

Rating:
 Analysis Date:
 Evaluation Method:
 Microfilm Data Recorded: Yes

Construction Information

Year: 1959 Original
 Route: FAI-55
 Section Nbr: 22-1HB-2
 Contract Nbr: 60276
 Fed Aid Pr#: I 0556005271
 Built By: 1 I.D.O.T.
 2001 Reconstructed
 Sta: 989+98.25 IL RT83
 Sta: 4+265.433
 22-1HB-2-R
 60276
 1 I.D.O.T.

Pontis

Today's Date: 08/27/2015

Structure Number: 022-0051 District: 1 (41) Bridge Status: 1 OPEN - NO RESTRICT
 (6) Feature Crossed: I- 55 (7) Facility Carried: IL 83 NB
 (9) Location: 1.2 M NW OF COOK CO (7A) Bridge Name:
 Element Inspection Date: 01/15/2015
 (90E) Agency Program Manager: MastnySC (90E3) Consultant Program Manager:
 (90E1) Team Leader: MastnySC (90E2) Inspector:

Element Insp. Delinquent		Element Insp. Delinquent Reason:									
Element Description											
Elem	Env	% 1	Qty 1	% 2	Qty 2	% 3	Qty 3	% 4	Qty 4	Tot Qty	
Reinforced Conc Column or Pile Extension											
205	4	100	1,540	0	0	0	0	0	0	0	1,540
			No deterioration	Minor cracks/spalls	Delams/spalls	Analysis warranted					
Remarks:											
Reinforced Conc Pier Wall											
210	4	98	1,834	2	30	0	0	0	0	0	1,864
			No deterioration	Minor cracks/spalls	Delams/spalls	Analysis warranted					
Remarks:											
Reinforced Conc Abutment											
215	4	100	932	0	0	0	0	0	0	0	932
			No deterioration	Minor cracks/spalls	Delams/spalls	Analysis warranted					
Remarks:											
Reinforced Conc Pier or Abutment Cap											
234	4	97	344	3	12	0	0	0	0	0	356
			No deterioration	Minor cracks/spalls	Delams/spalls	Analysis warranted					
Remarks:											
Elastomeric Bearing											
310	4	100	36	0	0	0	0	0	0	0	36
			No deterioration	Minor deterioration	Major deterioration						
Remarks:											
Fixed Bearing											
313	4	100	9	0	0	0	0	0	0	0	9
			No deterioration	Minor deterioration	Advanced corrosion						
Remarks:											
Concrete Bridge Railing											
331	4	100	338	0	0	0	0	0	0	0	338
			No deterioration	Minor cracks/spalls	Analysis warranted						
Remarks:											

Concrete Deck Protected w/ Coated Bars										
8026	4	97	20,923	0	0	3	600	0	0	21,523
Remarks:										
Non-Lead Painted Steel Open Girder										
8118	4	100	32,551	0	0	0	0	0	0	32,551
Remarks:										
Non-Lead Painted Steel Closed Web/Box Girder Ends										
8173	4	100	18	0	0	0	0	0	0	18
Remarks:										
Continuous Seal Neoprene Expansion Joint										
8308	4	74	104	0	0	26	36	0	0	140
Remarks:										
Approach Pavement										
8323	4	100	2	0	0	0	0	0	0	2
Remarks:										



October 27, 2015

MEMORANDUM

Mr. John Fortmann, Region One Engineer
Illinois Department of Transportation
Region One/District One

Attn: Steven Schilke

RE: Existing S.N. 022-0072
Cass Ave. over I-55
DuPage County
PTB 158-002/P-91-762-10

The purpose of this technical memo is to summarize the current condition of existing S.N. 022-0072 in addition to geometrics and other factors. A cursory field check was performed to supplement the information contained in IDOT's structure summary report dated October 22, 2013 (see Appendix B). Broad-based recommendations for this structure are provided below.

The structure is a four span steel beam bridge consisting of twenty-two lines of continuous beams (see Photo 1). Span lengths from south to north are 45'-8", 87'-11", 87'-11" and 45'-8". The superstructure is supported by pile bent abutments and reinforced concrete multi-column piers. There is no overlay on the structure.

IDOT rates the deck as being in good condition, which concurs with the findings from the cursory field check. Minor transverse cracks with leaching are visible on a majority of the soffit. IDOT rates the superstructure as being in satisfactory condition, which concurs with the findings from the cursory field check. Moderate paint peeling and rusting is visible on the web and flanges of all beams (see Photo 2). Initial section loss may be present at beam ends (see Photo 3). IDOT rates the substructure as being in good condition, which concurs with the findings from the cursory field check. Minor to moderate cracking and spalling is visible along both abutments and piers (see Photo 4). No notable defects or differences were observed between the cursory field check and IDOT's structure summary report for: deck geometry, underclearance vert/lat, approach alignment, bridge railing appraisal and approach guardrail items. Moderate cracks are visible on the north slopewall.

Based on the structure summary report and field check, S.N. 022-0072 is suitable for reuse after rehabilitation of the substructure and expansion joints. The approach guardrail transitions should be brought up to current IDOT standards. The north slopewall should be repaired.



LIN ENGINEERING, LTD.
Consulting Engineers

Springfield, IL Westmont, IL

576 Oakmont Lane
Westmont, Illinois 60559
Telephone: (630) 323-5168
Fax: (630) 323-5174
E-mail: info@lineng.com

LIN ENGINEERING, LTD.

A handwritten signature in blue ink that reads "Michael T. Haley". The signature is fluid and cursive.

Michael T. Haley, PE, SE
Structural Manager

Appendix A – Photos

Appendix B – IDOT Structure Summary Report

Appendix C – PONTIS Report



Photo 1



Photo 2



Photo 3



Photo 4

Illinois Department of Transportation
Structures Information Management System
Structure Summary Report

Structure Number: 022-0072 District: 1

Facility Carried: CASS AVE
 Feature Crossed: I-55
 Bridge Remarks: MAX=46.0
 Bridge Status: 1 OPEN - NO RESTRICT
 Status Remarks: 022 DUPAGE
 Maint County: 13 I.D.O.T.
 Maint Responsibility: 5 SECOND LEVEL INTERCHANGE 1 / HIGHWAY
 Service On/Under: 1 I.D.O.T. - BUREAU OF MAINTENANCE
 Reporting Agency: 4 STEEL CONTINUOUS
 Main Span Matl/Type: 4 Nbr Of Approach Spans: 0
 Nbr Of Main Spans: 4
 Approaches
 Near #1 Matl/Type:
 Near #2 Matl/Type:
 Far #1 Matl/Type:
 Far #2 Matl/Type:
 Median Width/Type: 16 Ft. / 3 Curb / 0
 Guardrail Type L/R: 0 None / 0
 Toll Facility Indicator: 0 No Toll
 Latitude: 41.73151182 S Longitude: 87.97285233 S
 Deck Structure Type: A CIP CON NRMALLY FORM
 Sidewalks Under Structure: 0 None

Inventory Data

Bridge Name: DOWNERS GROVE
 Location: 1.7 M W I L 83
 Status Date: 02/2002
 SUFFICIENCY RATING: 99.0
 HBP Eligible: No AASHTO Bridge Length: 272.0
 Replaced By: - Length of Long Span: 87.9
 Replaces: - Bridge Roadway Width: 108.4
 Last Update Date: 07/05/2012 Appr Roadway Width: 75.0
 Parallel Structure: None Deck Width: 111.4
 Multi-Level Structure Nbr: Sidewalk Width Right: 0.0
 Skew Angle: R Right Sidewalk Width Left: 0.0
 Structure Flared: 19 D Navigation Control: N N/A
 Historical Significance: No Navigation Horiz Clear: 0
 Border Bridge State: No Navigation Vert Clear: 0
 Bdr State SN: Culvert Fill Depth: 0.0
 Bdr State % Responsibility: 0 Culvert Opening Area: 0.0
 Structural Steel Wt: 1290400 Culvert Cell Height: 0.00
 Substructure Material: Culvert Cell Width: 0.00
 Rated By: 2 IDOT Rate Method: 6
 Inventory Rating: 1,300(46) Load Rating Date: 05/03/2002 Railroad Crossing Info
 Operating Rating: 2,165(77) Crossing 1 Nbr:
 Design Load: 02 HS20 Crossing 1 Nbr:
 Deck Structure Thickness: 7.5 SD: N FO: N RR Lateral Underclear: 0.0
 RR Vertical Underclear: 0 Ft 0 In

Key Route On Data

Key Route Nbr: FEDERAL-AID URBAN 2650 Station: 6,4300
 Appurtenances Main Route 00000 Segment: 022
 Inventory County: 022 DUPAGE Linked: Y
 Township/Road Dist 03 DOWNERS GROVE Natl. Hwy System: Not on NHS
 Municipality 1397 DARIEN Inventory Direction:
 Urban Area: 1051 Curr AADT Yr/Count: 2012 / 9100
 Functional Class: 4 MINOR ARTERIAL Est Truck Percentage: 3
 ** CLEARANCES ** South/East North/West Number Of Lanes: 6
 Max Rdwy Width: 0.0 One Or Two Way: 2 Two-Way
 Horizontal: 109.0 Bypass Length: 0
 Future AADT Yr/Cnt: 2032 / 9023
 Designated Truck Rte: NONE
 Special Systems: No

Key Route Under Data

FEDERAL-AID INTERSTATE 0055 Station: 3,4600
 Main Route 00000 Segment:
 022 Linked: Y
 03 DOWNERS GROVE Natl. Hwy System: On NHS
 1397 DARIEN Inventory Direction:
 1051 1051 Curr AADT Yr/Count: 2014 / 150400
 1 INTERSTATE Est Truck Percentage: 11
 South/East North/West Number Of Lanes: 8
 0.0 One Or Two Way: 2 Two-Way
 79.8 Bypass Length: 0
 Future AADT Yr/Cnt: 2032 / 185592
 Designated Truck Rte: CLASS I
 Special Systems: Yes

*** Marked Route On Data ***

Designation	Kind	Number
1 Mainline	8 Other	
1 Mainline		
1 Mainline		

*** Marked Route Under Data ***

Designation	Kind	Number
1 Mainline	1 Interstate Highway	055
1 Mainline		
1 Mainline		

Illinois Department of Transportation
Structures Information Management System
Structure Summary Report

Structure Number: 022-0072 District: 1

*** Inspection Intervals ***

Routine NBIS: 24 MOS Underwater: 0 MOS One Truck At A Time: 0 Tons Bridge Posting Level: 5 No Posting Required
Special: N Single Unit Vehicles: Tons Combination Type 3S-1: Tons Combination Type 3S-2: Tons

*** Maximum Allowable Posting Limits ***

Inspection Date: 10/22/2013 Inspection Temperature: 40Deg. F

Deck: 7 GOOD CONDITION - SOME MINOR PROBLEMS
Superstructure: 6 SATISFACTORY CONDITION - MINOR DETERIORATION
Substructure: 7 GOOD CONDITION - SOME MINOR PROBLEMS
Culvert: N NOT APPLICABLE
Channel and Protection: N NOT APPLICABLE
Structural Evaluation: 6 EQUAL TO PRESENT MINIMUM CRITERIA
Deck Geometry: 9 SUPERIOR TO PRESENT DESIRABLE CRITERIA
Underclearance-Vert/Lat.: 5 BETTER THAN ADEQUATE TO BE LEFT IN PLACE
Waterway Adequacy: N NOT APPLICABLE
Approach Roadway Align: 8 EQUAL TO PRESENT DESIRABLE CRITERIA
Bridge Railing Appraisal: 3 Meets Standards
Approach Guardrail: 233 Not Acceptable Acceptable
Pier Navig Protection: N N/A

Deck Wearing Surf: A BARE DECK NO OVRLAY
Deck Membrane: F NONE
Deck Protection: A EPOXY COATED REINF
Total Deck Thick: 7.5
Last Paint Date: 10/2003

Single Unit Vehicles: Tons
Combination Type 3S-1: Tons
Combination Type 3S-2: Tons
One Truck At A Time: 0
Last Paint Type: Z

*** Actual Posted Limits ***

Inspection/Appraisal Information

Inspection Date: Inspection Method: Appraisal Rating:
Temperature:

Underwater Inspection/Appraisal Information

Scour Critical Information

Rating: Evaluation Method: Microfilm Data Recorded: Yes

Construction Information

Year: 1960 Original 2000 Reconstructed
Route: FAI-55 Sta: 903+35.51 FAI-55 Sta:
Section Nbr: 22-1HB-4 22-1HB-4-R
Contract Nbr: 60278
Fed Aid Pr#: I 0556003269
Built By: 1 I.D.O.T. 1 I.D.O.T.

Pontis

Today's Date: 08/27/2015

Structure Number: 022-0072 District: 1
 (6) Feature Crossed: I- 55
 (9) Location: 1.7 M W IL 83
 Element Inspection Date: 10/22/2013
 (90E) Agency Program Manager: SEDLACEKJL
 (90E1) Team Leader:

(41) Bridge Status: 1 OPEN - NO RESTRICT
 (7) Facility Carried: CASS AVE
 (7A) Bridge Name:
 (90E3) Consultant Program Manager:
 (90E2) Inspector:

Element Insp. Delinquent		Element Insp. Delinquent Reason:								
Element Description										
Elem	Env	% 1	Qty 1	% 2	Qty 2	% 3	Qty 3	% 4	Qty 4	Tot Qty
Lead Painted Steel Open Girder										
107	4	36	20,000	64	35,160	0	0	0	0	55,160
		No corrosion	Paint distress		Rust formation	Section loss		Section failure		
Remarks: Med rust on btm flanges & webs. Minor rust at top flanges.										
Reinforced Conc Column or Pile Extension										
205	4	98	2,148	0	0	2	50	0	0	2,198
		No deterioration	Minor cracks/spalls		Delams/spalls	Analysis warranted				
Remarks: Spalls w/ exposed rebar @Pier 1 & 3. FCR failing.										
Reinforced Conc Pier Wall										
210	4	95	3,512	0	0	5	200	0	0	3,712
		No deterioration	Minor cracks/spalls		Delams/spalls	Analysis warranted				
Remarks: Spalls w/ exposed rebar @Pier 1 & 3										
Reinforced Conc Abutment										
215	4	100	1,188	0	0	0	0	0	0	1,188
		No deterioration	Minor cracks/spalls		Delams/spalls	Analysis warranted				
Remarks: North & South Bkwall-HL vert leach crks.										
Reinforced Conc Pier or Abutment Cap										
234	4	99	588	1	4	0	0	0	0	592
		No deterioration	Minor cracks/spalls		Delams/spalls	Analysis warranted				
Remarks: Lt cracking										
Preformed Joint Seal										
302	4	0	0	78	362	22	100	0	0	462
		No deterioration	Minor deterioration		Major deterioration					
Remarks: Both Jnts leaking										
Elastomeric Bearing										
310	4	0	0	100	88	0	0	0	0	88
		No deterioration	Minor deterioration		Major deterioration					
Remarks:										

Fixed Bearing										
313	4	0	0	100	66	0	0	0	0	66
		No deterioration		Minor deterioration		Advanced corrosion				
Remarks:										
Concrete Bridge Railing										
331	4	0	0	94	508	6	30	0	0	538
		No deterioration		Minor cracks/spalls		Analysis warranted				
Remarks: HL-Med vert cracking										
Concrete Deck Protected w/ Coated Bars										
8026	4	90	26,765	10	3,120	0	0	0	0	29,885
Remarks: Lt trans leach crking										
Lead Painted Steel Closed Web/Box Girder Ends										
8172	4	47	62	53	70	0	0	0	0	132
Remarks: Lt rusting @ N&S Abuts, Pier 1 & 3 Bm Ends.										
Approach Pavement										
8323	4	100	4	0	0	0	0	0	0	4
Remarks:										



October 27, 2015

MEMORANDUM

Mr. John Fortmann, Region One Engineer
Illinois Department of Transportation
Region One/District One

Attn: Steven Schilke

RE: Existing S.N. 022-0088
Woodward Ave. over I-55
DuPage County
PTB 158-002/P-91-762-10

The purpose of this technical memo is to summarize the current condition of existing S.N. 022-0088 in addition to geometrics and other factors. A cursory field check was performed to supplement the information contained in IDOT's structure summary report dated July 7, 2015 (see Appendix B). Broad-based recommendations for this structure are provided below.

The structure is a two span steel girder bridge consisting of eleven lines of continuous girders (see Photo 1). Span lengths from south to north are 137'-11" and 161'-2". The superstructure is supported by sand filled vaulted abutments and a reinforced concrete multi-column pier. There is no overlay on the structure.

IDOT rates the deck as being in good condition, which concurs with the findings from the cursory field check. Minor transverse cracks are visible on a majority of the top of deck. IDOT rates the superstructure as being in satisfactory condition, which concurs with the findings from the cursory field check. Minor to moderate paint peeling and rusting is visible on the bottom flanges of all girders (see Photo 2). IDOT rates the substructure as being in good condition, which concurs with the findings from the cursory field check. Minor spalls are visible along the abutment stem (see Photo 3). IDOT rates the approach guardrail transitions as not meeting current standards, which concurs with the findings from the cursory field check. The northeast approach guardrail exhibits impact damage. No notable defects or differences were observed between the cursory field check and IDOT's structure summary report for: deck geometry, underclearance vert/lat, approach alignment and bridge railing appraisal items. Large longitudinal and diagonal cracks are visible on both approach slabs (see Photo 4). Expansion joint Anchor blocks are damaged at the bridge parapets and median (see Photo 5).

Based on the structure summary report and field check, S.N. 022-0088 is suitable for reuse after rehabilitation of the substructure and expansion joints. The approach guardrail transitions should be repaired and brought up to current IDOT standards.



LIN ENGINEERING, LTD.
Consulting Engineers

Springfield, IL Westmont, IL

576 Oakmont Lane
Westmont, Illinois 60559
Telephone: (630) 323-5168
Fax: (630) 323-5174
E-mail: info@lineng.com

LIN ENGINEERING, LTD.

A handwritten signature in blue ink that reads "Michael T. Haley". The signature is written in a cursive, flowing style.

Michael T. Haley, PE, SE
Structural Manager

Appendix A – Photos

Appendix B – IDOT Structure Summary Report

Appendix C – PONTIS Report



Photo 1



Photo 2



Photo 3



Photo 4



Photo 5

**Illinois Department of Transportation
Structures Information Management System
Structure Summary Report**

Structure Number: 022-0088 District: 1

Inventory Data	
Facility Carried:	WOODWARD AVE
Feature Crossed:	I-55
Bridge Remarks:	SAND FILLED VAULTED ABUTMENTS - TREATED AS APPROACH PAVEMENT SMM.
Status Remarks:	1 OPEN - NO RESTRICT
Status Date:	12/1998
Status Remarks:	PER KRAMARZ MEMO 3-26-98
Maint County:	022 DUPAGE
Maint Responsibility:	19 I.D.O.T.
Service On/Under:	1 HIGHWAY
Reporting Agency:	1 I.D.O.T. - BUREAU OF MAINTENANCE
Main Span Matl/Type:	4 STEEL CONTINUOUS
Nbr Of Main Spans:	2
Nbr Of Approach Spans:	0
Approaches	
Near #1 Matl/Type:	/
Near #2 Matl/Type:	/
Far #1 Matl/Type:	/
Far #2 Matl/Type:	/
Median Width/Type:	10 Ft. / 3 Curb
Guardrail Type L/R:	0 None / 0 None
Toll Facility Indicator:	0 No Toll
Latitude:	41.7073671
Longitude:	S
Deck Structure Type:	A CIP CON NRMLLY FORM
Sidewalks Under Structure:	0 None
Inventory Rating:	1.105(39)
Operating Rating:	1.845(66)
Design Load:	02 HS20
Deck Structure Thickness:	7.5 SD: N
RR Lateral Underclear:	0
RR Vertical Underclear:	0
Rate Method:	6
Load Rating Date:	02/28/2000
Crossing 1 Nbr:	
Crossing 1 Nbr:	
RR Lateral Underclear:	0
RR Vertical Underclear:	0

Key Route On Data	
Key Route Nbr:	FEDERAL-AID URBAN
Station:	2593
Segment:	00000
Linked:	Y
Natl. Hwy System:	Not on NHS
Inventory Direction:	
Curr AADT Yr/Count:	2012 / 9200
Est Truck Percentage:	8
Number Of Lanes:	4
One Or Two Way:	2 Two-Way
Bypass Length:	0
Future AADT Yr/Cnt:	2032 / 9915
Designated Truck Rte:	NONE
Special Systems:	No
Key Route Under Data	
Key Route Nbr:	FEDERAL-AID INTERSTATE
Station:	0055
Segment:	00000
Linked:	Y
Natl. Hwy System:	On NHS
Inventory Direction:	
Curr AADT Yr/Count:	2014 / 114900
Est Truck Percentage:	11
Number Of Lanes:	10
One Or Two Way:	2 Two-Way
Bypass Length:	0
Future AADT Yr/Cnt:	2021 / 174825
Designated Truck Rte:	CLASS I
Special Systems:	Yes

**** Marked Route On Data ****		
Designation	Kind	Number
1 Mainline	8 Other	
1 Mainline		
1 Mainline		

**** Marked Route Under Data ****		
Designation	Kind	Number
1 Mainline	1 Interstate Highway	055
1 Mainline		
1 Mainline		

**Illinois Department of Transportation
Structures Information Management System
Structure Summary Report**

Structure Number: 022-0088 **District: 1**

Data Related to Inspection Information

*** Inspection Intervals ***
 Routine NBIS: 24 MOS Underwater: 0 MOS One Truck At A Time: 0 Combination Type 3S-1: Tons Bridge Posting Level:
 Special: N Single Unit Vehicles: Tons Combination Type 3S-2: Tons 5 No Posting Required

Inspection/Appraisal Information

Inspection Date: 07/07/2015 Inspection Temperature: 68Deg. F *** Actual Posted Limits **
 Deck: 7 GOOD CONDITION - SOME MINOR PROBLEMS Single Unit Vehicles: Tons
 Superstructure: 6 SATISFACTORY CONDITION - MINOR DETERIORATION Combination Type 3S-1: Tons
 Substructure: 7 GOOD CONDITION - SOME MINOR PROBLEMS Combination Type 3S-2: Tons
 Culvert: N NOT APPLICABLE One Truck At A Time: 0
 Channel and Protection: N NOT APPLICABLE Last Paint Type: GQ
 Structural Evaluation: 6 EQUAL TO PRESENT MINIMUM CRITERIA Deck Wearing Surf: A BARE DECK NO OVRLAY SHP ZINC & VINYL
 Deck Geometry: 4 MINIMUM ADEQUACY TO BE LEFT IN PLACE Deck Membrane: F NONE OTHER COATED REINF
 Underclearance-Vert/Lat.: 6 EQUAL TO PRESENT MINIMUM CRITERIA Deck Protection: C OTHER COATED REINF
 Waterway Adequacy: N NOT APPLICABLE Total Deck Thick: 7.5
 Approach Roadway Align: 8 EQUAL TO PRESENT DESIRABLE CRITERIA Last Paint Date: 10/1998
 Bridge Railing Appraisal: 3 Meets Standards Acceptable
 Approach Guardrail: 233 Not Acceptable Acceptable
 Pier Navig Protection: N N/A

Underwater Inspection/Appraisal Information

Inspection Date: Inspection Method: Appraisal Rating:
 Temperature: Evaluation Method:

Scour Critical Information

Rating: Evaluation Method: Microfilm Data Recorded: Yes
 Analysis Date:

Construction Information

Year: 1959 Original 1998 Reconstructed Sta: 9+999.406
 Route: FAI-3 Sta: 738+35.69 I-355 95-00034-00-PV 83305
 Section Nbr: 22-2HB-2 Contract Nbr: I 0036008000 5 FEDERAL AGENCY
 Fed Aid Pr#: I 0036008000 Built By: 0 UNKNOWN

Pontis

Today's Date: 08/27/2015

Structure Number: 022-0088 District: 1 (41) Bridge Status: 1 OPEN - NO RESTRICT
 (6) Feature Crossed: I- 55 (7) Facility Carried: WOODWARD AVE
 (9) Location: 1.1 M SW LEMONT RD (7A) Bridge Name:
 Element Inspection Date: 07/07/2015
 (90E) Agency Program Manager: AsfourSE (90E3) Consultant Program Manager:
 (90E1) Team Leader: SalaymehTA (90E2) Inspector:

Element Insp. Delinquent		Element Insp. Delinquent Reason:									
Elem	Env	% 1	Qty 1	% 2	Qty 2	% 3	Qty 3	% 4	Qty 4	Tot Qty	
Reinforced Conc Column or Pile Extension											
205	4	100	604	0	3	0	0	0	0	607	
		No deterioration	Minor cracks/spalls	Delams/spalls	Analysis warranted						
Remarks: Honeycombing @ base of Col #6											
Reinforced Conc Pier Wall											
210	4	100	922	0	0	0	0	0	0	922	
		No deterioration	Minor cracks/spalls	Delams/spalls	Analysis warranted						
Remarks:											
Reinforced Conc Abutment											
215	4	99	1,231	1	8	0	0	0	0	1,239	
		No deterioration	Minor cracks/spalls	Delams/spalls	Analysis warranted						
Remarks: Stem Crking @ widening; HL vert crking; Backwall) HL-Nar vert crking											
Reinforced Conc Pier or Abutment Cap											
234	4	98	238	2	4	0	0	0	0	242	
		No deterioration	Minor cracks/spalls	Delams/spalls	Analysis warranted						
Remarks: HI vert crks @ Col #6											
Elastomeric Bearing											
310	4	0	0	100	22	0	0	0	0	22	
		No deterioration	Minor deterioration	Major deterioration							
Remarks: Lt-med surf rust to bearing assemblies @ Abts; Brg#2 @ W. abt lipping up @ seat											
Fixed Bearing											
313	4	0	0	100	11	0	0	0	0	11	
		No deterioration	Minor deterioration	Advanced corrosion							
Remarks:											
Reinforced Concrete Approach Slab											
321	2	98	2,990	2	60	0	0	0	0	3,050	
		No deterioration	Cracks/spalls	Major cracks/spalls	Broken/Unstable						
Remarks: NE wide longit crks, HL-med diag crks. NW wide longit crks. SE wide longit crks, not aligned w/rdway. SW wide longit crks.											

Concrete Bridge Railing										
	No deterioration	Minor cracks/spalls	Analysis warranted							
331	2	0	0	100	897	0	0	0	0	897
Remarks: HL Vert Crks, map crks typ.										
Concrete Deck Protected w/ Coated Bars										
8026	2	94	22,779	6	1,400	0	0	0	0	24,179
Remarks: WS: Lt Transv. Crks; Soffit Lt trans leach crks										
Non-Lead Painted Steel Open Girder										
8118	4	100	71,396	0	20	0	0	0	0	71,416
Remarks: Lt surf rust to bottom flanges @ Bms #5,6,7,8 &9 (original steel)										
Non-Lead Painted Steel Closed Web/Box Girder Ends										
8173	2	55	12	45	10	0	0	0	0	22
Remarks: Lt surf rust to bm ends @ Bms #5,6,7,8 &9 (original steel); Isol paint peel @ Bm ends of East Abut										
Continuous Seal Neoprene Expansion Joint										
8308	2	94	154	6	10	0	0	0	0	164
Remarks:										
Approach Pavement										
8323	2	0	0	100	2	0	0	0	0	2
Remarks: Appr pavement North & South end has med map, longit & diag crks. All approaches have med diag & map crks & wide longit crks.										



October 27, 2015

MEMORANDUM

Mr. John Fortmann, Region One Engineer
Illinois Department of Transportation
Region One/District One

Attn: Steven Schilke

RE: Existing S.N. 022-0089
Clarendon Hills Rd. over I-55
DuPage County
PTB 158-002/P-91-762-10

The purpose of this technical memo is to summarize the current condition of existing S.N. 022-0089 in addition to geometrics and other factors. A cursory field check was performed to supplement the information contained in IDOT's structure summary report dated April 22, 2015 (see Appendix B). Broad-based recommendations for this structure are provided below.

The structure is a four span PPC I-Beam bridge (see Photo 1). Spans 1 and 4 contain seven lines of simply supported beams while spans 2 and 3 contain eight lines of continuous beams. Span lengths from south to north are 49'-9", 74'-9", 74'-9" and 49'-9". The superstructure is supported by pile bent abutments and reinforced concrete multi-column piers. There is no overlay on the structure.

IDOT rates the superstructure as being in poor condition, which concurs with the findings from the cursory field check. Stirrup bars are exposed the full perimeter of bottom flanges at a few beam ends in the continuous unit with some strands exposed inside the exterior perimeter of strands (see Photo 2). The ends of the beams at both the north and south abutments are spalled. Some beam end spalls at the south abutment extend through the bearing line (see Photo 3). Minor to severe corrosion is visible on the abutment fixed bearings. Some bottom flanges are spalled off facing the direction of traffic over W.B. I-55 (see Photo 4), due to suspected impact damage. IDOT rates the substructure as being in satisfactory condition, which concurs with the findings from the cursory field check. Moderate spalls with exposed rebar are visible along the bottom of cap and top of columns at the south pier. No notable defects or differences were observed between the cursory field check and IDOT's structure summary report for: deck, deck geometry, underclearance vert/lat, approach alignment, bridge railing appraisal and approach guardrail items. Large cracks and undermining are visible on north and south slopewalls (see Photo 5).

Based on the structure summary report and field check, S.N. 022-0089 is suitable for reuse after rehabilitation of the substructure, superstructure and expansion joints. Both slope walls should be



LIN ENGINEERING, LTD.
Consulting Engineers

Springfield, IL Westmont, IL

576 Oakmont Lane
Westmont, Illinois 60559
Telephone: (630) 323-5168
Fax: (630) 323-5174
E-mail: info@lineng.com

replaced and approach guardrail transitions should be brought up to current IDOT standards.

LIN ENGINEERING, LTD.

Michael T. Haley, PE, SE
Structural Manager

Appendix A – Photos

Appendix B – IDOT Structure Summary Report

Appendix C – PONTIS Report



Photo 1



Photo 2



Photo 3



Photo 4



Photo 5

Structure Number: 022-0089 District: 1

Inventory Data	
Facility Carried:	CLARENDON HILLS RD
Feature Crossed:	I-55
Bridge Remarks:	DESIGN LOAD MS18
Bridge Status:	1 OPEN - NO RESTRICT
Status Remarks:	
Maint County:	022 DUPAGE
Maint Responsibility:	13 I.D.O.T.
Service On/Under:	1 HIGHWAY
Reporting Agency:	1 I.D.O.T. - BUREAU OF MAINTENANCE
Main Span Matl/Type:	5 PRESTRESS CONCRETE
Nbr Of Main Spans:	4
Approaches	
Near #1 Matl/Type:	/
Near #2 Matl/Type:	/
Far #1 Matl/Type:	/
Far #2 Matl/Type:	/
Median Width/Type:	0 Ft. / 0 None
Guardrail Type L/R:	0 None / 0 None
Toll Facility Indicator:	0 No Toll
Latitude:	41.73784000
Longitude:	S
Deck Structure Type:	A CIP CON NRMLLY FORM
Sidewalks Under Structure:	0 None
Inventory Rating:	1,700(61)
Operating Rating:	2,840(102)
Design Load:	02 HS20
Deck Structure Thickness:	7.5 SD: Y FC: N
RR Vertical Underclear:	0 Ft 0 In
Rate Method:	2 IDOT
Load Rating Date:	09/04/2014
Rated By:	6

Key Route On Data

Key Route Nbr:	FEDERAL-AID URBAN	Station:	2663	3,4400
Appurtenances:	Main Route	Segment:	00000	
Inventory County:	022 DUPAGE	Linked:	Y	
Township/Road Dist	03 DOWNERS GROVE	Natl. Hwy System:	Not on NHS	
Municipality	0000	Inventory Direction:		
Urban Area:	1051	Curr AADT Yr/Count:	2012 / 3350	
Functional Class:	5 MAJOR COLLECTOR	Est Truck Percentage:	1	
** CLEARANCES **	South/East	Number Of Lanes:	2	
Max Rdwy Width:	35.4	One Or Two Way:	2 Two-Way	
Horizontal:	36.6	Bypass Length:	0	
		Future AADT Yr/Cnt:	2032 / 7241	
		Designated Truck Rte:	NONE	
		Special Systems:	No	

Key Route Under Data

Key Route Nbr:	FEDERAL-AID INTERSTATE	Station:	0055	4,5200
Appurtenances:	Main Route	Segment:	00000	
Inventory County:	022 DOWNERS GROVE	Linked:	Y	
Township/Road Dist	03 DOWNERS GROVE	Natl. Hwy System:	On NHS	
Municipality	0000	Inventory Direction:		
Urban Area:	1051	Curr AADT Yr/Count:	2014 / 152700	
Functional Class:	1 INTERSTATE	Est Truck Percentage:	11	
** CLEARANCES **	South/East	Number Of Lanes:	6	
Max Rdwy Width:	64.1	One Or Two Way:	2 Two-Way	
Horizontal:	64.0	Bypass Length:	0	
		Future AADT Yr/Cnt:	2032 / 187598	
		Designated Truck Rte:	CLASS I	
		Special Systems:	Yes	

***** Marked Route On Data *****

Route #1:	Designation	Kind	Number
1	Mainline	8 Other	
1	Mainline		
1	Mainline		

***** Marked Route Under Data *****

Route #1:	Designation	Kind	Number
1	Mainline	1 Interstate Highway	055
1	Mainline		
1	Mainline		

Illinois Department of Transportation
Structures Information Management System
Structure Summary Report

Structure Number: 022-0089 District: 1

*** Inspection Intervals ***
 Routine NBIS: 12 MOS Underwater: 0 MOS One Truck At A Time: 0 Tons Combination Type 3S-1: Tons Bridge Posting Level: 5 No Posting Required
 Special: N Single Unit Vehicles: Tons Combination Type 3S-2: Tons

Data Related to Inspection Information
 *** Maximum Allowable Posting Limits ***

Inspection/Apraisal Information

Inspection Date: 04/22/2015 Inspection Temperature: 48Deg. F
 Deck: 7 GOOD CONDITION - SOME MINOR PROBLEMS
 Superstructure: 4 POOR CONDITION - ADVANCED DETERIORATION
 Substructure: 6 SATISFACTORY CONDITION - MINOR DETERIORATION
 Culvert: N NOT APPLICABLE
 Channel and Protection: N NOT APPLICABLE
 Structural Evaluation: 4 MINIMUM ADEQUACY TO BE LEFT IN PLACE
 Deck Geometry: 5 BETTER THAN ADEQUATE TO BE LEFT IN PLACE
 Underclearance-Vert/Lat.: 4 MINIMUM ADEQUACY TO BE LEFT IN PLACE
 Waterway Adequacy: N NOT APPLICABLE
 Approach Roadway Align: 6 EQUAL TO PRESENT MINIMUM CRITERIA
 Bridge Railing Appraisal: 3 Meets Standards
 Approach Guardrail: 233 Not Acceptable Acceptable
 Pier Navig Protection: N N/A

Underwater Inspection/Apraisal Information

Inspection Date:
Temperature:
Inspection Method:
Appraisal Rating:

Scour Critical Information

Rating:
Analysis Date:
Evaluation Method:
Microfilm Data Recorded: Yes

Construction Information

Year: 1960 Original 2002 Reconstructed
 Route: FAI-55 Sta: 960+74.92 FAI-55 Sta: 10+000.00
 Section Nbr: 22-1HB-3 97-03121-00-BR
 Contract Nbr: 83383
 Fed Aid Pr#: I 0556004270
 Built By: 1 I.D.O.T. 1 I.D.O.T.

Pontis

Today's Date: 08/25/2015

Structure Number: 022-0089 District: 1 (41) Bridge Status: 1 OPEN - NO RESTRICT
 (6) Feature Crossed: I- 55 (7) Facility Carried: CLARENDON HILLS RD
 (9) Location: 0.5 M W IL 83 (7A) Bridge Name:
 Element Inspection Date: 04/22/2015
 (90E) Agency Program Manager: MastnySC (90E3) Consultant Program Manager:
 (90E1) Team Leader: SedlacekJL (90E2) Inspector:

Element Insp. Delinquent		Element Insp. Delinquent Reason:								
Element Description										
Elem	Env	% 1	Qty 1	% 2	Qty 2	% 3	Qty 3	% 4	Qty 4	Tot Qty
P/S Conc Open Girder										
109	4	98	1,845	1	28	0	9	0	0	1,882
		No deterioration	Minor cracks/spalls	Delams/spalls	Analysis warranted					
Remarks: All interior lr fl's @ P2 exhibiting hp's along w/few spalls exposing rusted reinf & strands, impact spill bm 7 sp2 no exposure										
Reinforced Conc Column or Pile Extension										
205	4	99	1,694	0	0	1	18	0	0	1,712
		No deterioration	Minor cracks/spalls	Delams/spalls	Analysis warranted					
Remarks: P3 columns exhibiting unsound map cracked areas @ tops w/most col repairs exhibiting hl map cracks										
Reinforced Conc Pier Wall										
210	4	100	1,881	0	0	0	0	0	0	1,881
		No deterioration	Minor cracks/spalls	Delams/spalls	Analysis warranted					
Remarks: HL-isol narrow vert cracks										
Reinforced Conc Abutment										
215	4	100	685	0	0	0	0	0	0	685
		No deterioration	Minor cracks/spalls	Delams/spalls	Analysis warranted					
Remarks: Backwalls: hl vert cracks										
Reinforced Conc Pier or Abutment Cap										
234	4	97	211	0	0	3	6	0	0	217
		No deterioration	Minor cracks/spalls	Delams/spalls	Analysis warranted					
Remarks: Piers: P3 cap underside spalls w/exp btwn Col #1&2 and Col #4&5. Numer locations all piers w/hl-narrow horiz edge cracks. Abts:hl-narrow horiz cracks @ S abt.										
Preformed Joint Seal										
302	4	0	0	100	85	0	0	0	0	85
		No deterioration	Minor deterioration	Major deterioration						
Remarks: @N & S Abut, Leak										
Movable Discontinuous Brg.										
311	4	0	0	100	30	0	0	0	0	30
		No deterioration	Minor deterioration	Advanced corrosion						
Remarks: Lt surface edge rusting										

Fixed Bearing										
313	4	53	16	47	14	0	0	0	0	30
		No deterioration	Minor deterioration	Advanced corrosion						
Remarks: Fascia brngs @ abuts have lt rust to assemblies										
Concrete Bridge Railing										
331	4	100	498	0	0	0	0	0	0	498
		No deterioration	Minor cracks/spalls	Analysis warranted						
Remarks:										
Concrete Deck Protected w/ Coated Bars										
8026	4	99	9,510	1	125	0	0	0	0	9,635
Remarks: HL trans crking to ws and soffit.										
P/S Conc Beam Ends Incl Diaphragms Under Deck Joint										
8237	4	0	0	98	43	0	0	2	1	44
Remarks: All interior ends exhibiting hp's to bottom fl's w/many having small spalls @ very ends(beyond bearings)										
Continuous Seal Neoprene Expansion Joint										
8308	4	0	0	100	85	0	0	0	0	85
Remarks: @Pier 1 & 3, Leak										
Approach Pavement										
8323	4	100	2	0	0	0	0	0	0	2
Remarks: N & S exhibiting hl-narrow random cracks that were sealed and have re-cracked										



October 27, 2015

MEMORANDUM

Mr. John Fortmann, Region One Engineer
Illinois Department of Transportation
Region One/District One

Attn: Steven Schilke

RE: Existing S.N. 022-2006
N.B. I-55. Ramp to N.B. I-355 over I-55
DuPage County
PTB 158-002/P-91-762-10

The purpose of this technical memo is to summarize the current condition of existing S.N. 022-2006 in addition to geometrics and other factors. A cursory field check was performed to supplement the information contained in IDOT's structure summary report dated April 16, 2014 (see Appendix B). Broad-based recommendations for this structure are provided below.

The structure is a two span steel girder bridge consisting of five lines of curved continuous girders. (see Photo 1). Span lengths from south to north are 179'-10¹/₂" and 173'-7⁵/₈". The superstructure is supported by vaulted abutments and a reinforced concrete multi-column pier. There is no overlay on the structure.

IDOT rates the superstructure as being in very good condition. The findings from the cursory field check don't match IDOT's superstructure rating. Minor rusting is visible along the bottom flanges of girders (see Photo 2). Paint is beginning to crack on the girders in some locations. IDOT rates the substructure as being in very good condition, which concurs with the findings from the cursory field check. Minor map cracking is visible on abutment caps and pier columns (see Photo 3). IDOT rates the underclearance vertical and lateral as intolerable requiring a high priority for corrective action, which concurs with the findings from the cursory field check. Clearances along the inside shoulders of I-55 appear to be less than 4 ft. No notable defects or differences were observed between the cursory field check and IDOT's structure summary report for: deck, deck geometry, approach alignment, bridge railing appraisal and approach guardrail items. A large spall is visible on the east bridge parapet (see Photo 4). The top of the south slopewall is beginning to delaminate/spall (see Photo 5). Moderate diagonal cracks are visible on both approach slabs (see Photo 6).

Based on the structure summary report and field check, S.N. 022-2006 is suitable for reuse without rehabilitation. The south slopewall and east parapet should be repaired.



LIN ENGINEERING, LTD.
Consulting Engineers

Springfield, IL Westmont, IL

576 Oakmont Lane
Westmont, Illinois 60559
Telephone: (630) 323-5168
Fax: (630) 323-5174
E-mail: info@lineng.com

LIN ENGINEERING, LTD.

A handwritten signature in blue ink that reads "Michael T. Haley". The signature is written in a cursive, flowing style.

Michael T. Haley, PE, SE
Structural Manager

Appendix A – Photos

Appendix B – IDOT Structure Summary Report

Appendix C – PONTIS Report



Photo 1



Photo 2



Photo 3



Photo 4



Photo 5



Photo 6

Illinois Department of Transportation
Structures Information Management System
Structure Summary Report

Structure Number: 022-2006 District: 1

Inventory Data	
Facility Carried:	I-55 NB TO I-355 NB
Feature Crossed:	I-55
Bridge Remarks:	
Bridge Status:	1 OPEN - NO RESTRICT
Status Remarks:	STATUS CHANGED BY TWH PER 3-17-2009 AUDIT REPORT
Maint County:	022 DUPAGE
Maint Township:	03 DOWNS GROVE
Maint I.D.O.T.:	1 / HIGHWAY
Service On/Under:	21 ILL. TOLLWAY COMMISSION
Reporting Agency:	8 ILLINOIS TOLLWAY AUTHORITY
Main Span Mat/Type:	4 STEEL CONTINUOUS
Nbr Of Main Spans:	2 Nbr Of Approach Spans: 0
Approaches	
Near #1 Mat/Type:	/
Near #2 Mat/Type:	/
Far #1 Mat/Type:	/
Far #2 Mat/Type:	/
Median Width/Type:	0 Ft. / 0 None
Guardrail Type L/R:	0None / 0 None
Toll Facility Indicator:	6 Toll Road
Latitude:	41.70556896 S Longitude: 88.02826648 S
Deck Structure Type:	A CIP CON NRMLLY FORM
Sidewalks Under Structure:	0 None
Inventory Rating:	1,280(46)
Operating Rating:	2,250(81)
Design Load:	02 HS20
Deck Structure Thickness:	8 SD: N FC: Y
RR Vertical Underclear:	0 Ft
RR Lateral Underclear:	0 Ft
RR Crossing 1 Nbr:	0
RR Crossing 1 Underclear:	0 In

Key Route On Data	
Key Route Nbr:	FEDERAL-AID INTERSTATE 0055
Station:	1,0700
Segment:	35020
Appurtenances:	Ramp
Inventory County:	099 WILL
Township/Road Dist:	04 DUPAGE
Municipality:	0000
Urban Area:	1051
Functional Class:	1 INTERSTATE
** CLEARANCES **	South/East North/West
Max Rdwy Width:	36.0
Horizontal:	40.0
Vertical:	40.0
Natl. Hwy System:	On NHS
Inventory Direction:	2013 / 16800
Curr AADT Yr/Count:	0
Est Truck Percentage:	1
Number Of Lanes:	1 One-Way
One Or Two Way:	0
Bypass Length:	2032 / 87567
Future AADT Yr/Cnt:	NONE
Designated Truck Rte:	NONE
Special Systems:	No

Key Route Under Data	
Key Route Nbr:	FEDERAL-AID INTERSTATE 0055
Station:	0,0700
Segment:	00000
Appurtenances:	Main Route
Inventory County:	022
Township/Road Dist:	03 DOWNS GROVE
Municipality:	6350 WOODRIDGE
Urban Area:	1051
Functional Class:	1 INTERSTATE
** CLEARANCES **	South/East North/West
Max Rdwy Width:	36.0
Horizontal:	40.0
Vertical:	40.0
Natl. Hwy System:	On NHS
Inventory Direction:	2014 / 106500
Curr AADT Yr/Count:	12
Est Truck Percentage:	6
Number Of Lanes:	2 Two-Way
One Or Two Way:	0
Bypass Length:	2032 / 163424
Future AADT Yr/Cnt:	CLASS I
Designated Truck Rte:	Yes
Special Systems:	Yes

**** Marked Route On Data ****		
Designation	Kind	Number
1 Mainline	1 Interstate Highway	055
1 Mainline	1 Mainline	
1 Mainline	1 Mainline	

Illinois Department of Transportation
Structures Information Management System
Structure Summary Report

Structure Number: 022-2006 District: 1

*** Inspection Intervals ***
Routin e NBIS: 24 MOS Underwater: 0 MOS Special: N
*** Maximum Allowable Posting Limits ***
Bridge Posting Level: 5 No Posting Required

Inspection Date: 04/16/2014 Inspection Temperature: 55Deg. F
Deck: 8 VERY GOOD CONDITION - NO PROBLEMS NOTED
Superstructure: 8 VERY GOOD CONDITION - NO PROBLEMS NOTED
Substructure: 8 VERY GOOD CONDITION - NO PROBLEMS NOTED
Culvert: N NOT APPLICABLE
Channel and Protection: N NOT APPLICABLE
Structural Evaluation: 8 EQUAL TO PRESENT DESIRABLE CRITERIA
Deck Geometry: 6 EQUAL TO PRESENT MINIMUM CRITERIA
Underclearance-Vert/Lat.: 3 INTOLERABLE - HIGH PRIORITY FOR CORRECTION
Waterway Adequacy: N NOT APPLICABLE
Approach Roadway Align: 8 EQUAL TO PRESENT DESIRABLE CRITERIA
Bridge Railing Appraisal: 3 Meets Standards
Approach Guardrail: 333 Acceptable
Pier Navig Protection: N N/A

Inspection/Appraisal Information
Single Unit Vehicles: 55Deg. F
Combination Type 3S-1: 0 Tons
Combination Type 3S-2: 0 Tons

Deck Wearing Surf: A BARE DECK NO OVRLAY
Deck Membrane: F NONE
Deck Protection: A EPOXY COATED REINF
Total Deck Thick: 8.0
Last Paint Date: 06/2007

Single Unit Vehicles: Tons
Combination Type 3S-1: Tons
Combination Type 3S-2: Tons
One Truck At A Time: 0
Last Paint Type: S
SHP ZINC&FLD ACRYL

*** Actual Posted Limits ***




Scour Critical Information
Evaluation Method: Microfilm Data Recorded: No

Rating: No
Analysis Date: 07/27/2015

Construction Information
Year: 2007 Original Reconstructed
Route: Sta: 57+36 Sta:
Section Nbr:
Contract Nbr: 105771
Fed Aid Pr#: OTHER STATE AGENCY
Built By: 2




Pontis

Today's Date: 08/27/2015

Structure Number: 022-2006 District: 1
 (6) Feature Crossed: I-55
 (9) Location: 1 M W OF LEMONT RD
 Element Inspection Date: 01/15/2014
 (90E) Agency Program Manager: MastnySC
 (90E1) Team Leader: SedlacekJL

(41) Bridge Status: 1 OPEN - NO RESTRICT
 (7) Facility Carried: I-55 NB TO I-355 NB
 (7A) Bridge Name:
 (90E3) Consultant Program Manager:
 (90E2) Inspector:

Element Insp. Delinquent		Element Insp. Delinquent Reason:								
Element Description										
Elem	Env	% 1	Qty 1	% 2	Qty 2	% 3	Qty 3	% 4	Qty 4	Tot Qty
Strip Seal Expansion Joint										
300	4	100	80	0	0	0	0	0	0	80
			No leakage	Minor leakage		Major leakage				
Remarks:										
Concrete Bridge Railing										
331	4	99	701	1	10	0	0	0	0	711
			No deterioration	Minor cracks/spalls		Analysis warranted				
Remarks: Vert Cracking w/collision scrapes/shallow spalls (E Side).										
Concrete Deck Protected w/ Coated Bars										
8026	4	99	13,288	1	140	0	0	0	0	13,428
Remarks: HL Trans cracking; Shallow Bird Baths in WS Span 1										



October 27, 2015

MEMORANDUM

Mr. John Fortmann, Region One Engineer
Illinois Department of Transportation
Region One/District One

Attn: Steven Schilke

RE: Existing S.N. 099-0336
S.B. I-355 over I-55
Will County
PTB 158-002/P-91-762-10

The purpose of this technical memo is to summarize the current condition of existing S.N. 099-0336 in addition to geometrics and other factors. A cursory field check was performed to supplement the information contained in IDOT's structure summary report dated April 15, 2014 (see Appendix B). Broad-based recommendations for this structure are provided below.

The structure is a two span steel girder bridge totaling 356.7 ft. in length consisting of eight lines of continuous girders (see Photo 1). The superstructure is supported by vaulted abutments and a reinforced concrete multi-column pier. There is no overlay on the structure.

IDOT rates the deck as being in good condition, which concurs with the findings from the cursory field check. Minor longitudinal and diagonal cracks are visible on the top of deck near the expansion joints. Minor transverse cracks with leaching are visible on a majority of the deck soffit (see Photo 2). IDOT rates the substructure as being in very good condition. The findings from the cursory field check don't match IDOT's substructure rating. Minor spalls and rust stains are visible at the base of earwalls (see Photo 3). Vertical cracks and horizontal bearing seat cracks are visible on the abutments (see Photo 4). Minor vertical cracks are visible on the pier. No notable defects or differences were observed between the cursory field check and IDOT's structure summary report for: superstructure, deck geometry, underclearance vert/lat, approach alignment, bridge railing appraisal and approach guardrail appraisal items.

Based on the structure summary report and field check, S.N. 099-0336 is suitable for reuse after rehabilitation of the substructure.



LIN ENGINEERING, LTD.
Consulting Engineers

Springfield, IL Westmont, IL

576 Oakmont Lane
Westmont, Illinois 60559
Telephone: (630) 323-5168
Fax: (630) 323-5174
E-mail: info@lineng.com

LIN ENGINEERING, LTD.

A handwritten signature in blue ink that reads "Michael T. Haley". The signature is written in a cursive, flowing style.

Michael T. Haley, PE, SE
Structural Manager

Appendix A – Photos

Appendix B – IDOT Structure Summary Report



Photo 1



Photo 2



Photo 3



Photo 4

Illinois Department of Transportation
Structures Information Management System
Structure Summary Report

Structure Number: 099-0336 District: 1

Inventory Data	
Facility Carried:	I-355 SB
Feature Crossed:	I-55
Bridge Remarks:	1.3M S OF BOUGHTON
Bridge Status:	1 OPEN - NO RESTRICT
Status Remarks:	04/2010
Maint County:	099 WILL
Maint Responsibility:	02 ILL. TOLLWAY COMMISSION
Service On/Under:	5 SECOND LEVEL INTERCHANGE
Reporting Agency:	8 ILLINOIS TOLLWAY AUTHORITY
Main Span Matl/Type:	4 STEEL CONTINUOUS
Nbr Of Main Spans:	2
Nbr Of Approach Spans:	0
Approaches	
Near #1 Matl/Type:	/
Near #2 Matl/Type:	/
Far #1 Matl/Type:	/
Far #2 Matl/Type:	/
Median Width/Type:	0 Ft./0 None
Guardrail Type L/R:	0None / 0 None
Toll Facility Indicator:	6 Toll Road
Latitude:	41.70389564
Deck Structure Type:	A CIP CON NRMLLY FORM
Sidewalks Under Structure:	0 None
Bridge Name:	
Location:	1.3M S OF BOUGHTON
Status Date:	04/2010
Maint Township:	04 DUPAGE
Service On/Under:	1 / HIGHWAY

Key Route On Data	
Key Route Nbr:	FEDERAL-AID INTERSTATE
Station:	0355
Segment:	1.6900
Main Route:	00000
Inventory County:	099 WILL
Linked:	Y
Township/Road Dist:	04 DUPAGE
Natl. Hwy System:	On NHS
Municipality:	3185 LEMONT
Inventory Direction:	
Urban Area:	1051
Curr AADT Yr/Count:	2013 / 34850
Est Truck Percentage:	13
Number Of Lanes:	4
One Or Two Way:	1 One-Way
Bypass Length:	0
Future AADT Yr/Cnt:	2032 / 43784
Designated Truck Rte:	CLASS I
Special Systems:	Yes

**** Marked Route On Data ****		
Designation	Kind	Number
1 Mainline	1 Interstate Highway	355
Route #2:	1 Mainline	
Route #3:	1 Mainline	

Key Route Under Data	
Key Route Nbr:	FEDERAL-AID INTERSTATE
Station:	0055
Segment:	35.9100
Main Route:	00000
Inventory County:	099 WILL
Linked:	Y
Township/Road Dist:	04 DUPAGE
Natl. Hwy System:	On NHS
Municipality:	6350 WOODRIDGE
Urban Area:	1051
Curr AADT Yr/Count:	2014 / 106500
Est Truck Percentage:	13
Number Of Lanes:	10
One Or Two Way:	2 Two-Way
Bypass Length:	0
Future AADT Yr/Cnt:	2032 / 176744
Designated Truck Rte:	CLASS I
Special Systems:	Yes

**** Marked Route Under Data ****		
Designation	Kind	Number
1 Mainline	1 Interstate Highway	055
Route #2:	1 Mainline	
Route #3:	1 Mainline	

Illinois Department of Transportation
Structures Information Management System
Structure Summary Report

Structure Number: 099-0336 District: 1

Data Related to Inspection Information

*** Inspection Intervals ***
 Routine NBIS: 24 MOS Underwater: 0 MOS Single Unit Vehicles: 0 Tons Combination Type 3S-1: Tons Bridge Posting Level:
 Special: N Tons Single Unit Vehicles: 0 Tons Combination Type 3S-2: Tons Tons 5 No Posting Required

Inspection/Appraisal Information

Inspection Date: 04/15/2014 Inspection Temperature: 40Deg. F
 Deck: 7 GOOD CONDITION - SOME MINOR PROBLEMS
 Superstructure: 8 VERY GOOD CONDITION - NO PROBLEMS NOTED
 Substructure: 8 VERY GOOD CONDITION - NO PROBLEMS NOTED
 Culvert: N NOT APPLICABLE
 Channel and Protection: N NOT APPLICABLE
 Structural Evaluation: 8 EQUAL TO PRESENT DESIRABLE CRITERIA
 Deck Geometry: 9 SUPERIOR TO PRESENT DESIRABLE CRITERIA
 Underclearance-Vert/Lat.: 6 EQUAL TO PRESENT MINIMUM CRITERIA
 Waterway Adequacy: N NOT APPLICABLE
 Approach Roadway Align: 8 EQUAL TO PRESENT DESIRABLE CRITERIA
 Bridge Railing Appraisal: 3 Meets Standards
 Approach Guardrail: 333 Acceptable
 Pier Navig Protection: N N/A

Deck Wearing Surf: N N/A - NO DECK
 Deck Membrane: N N/A
 Deck Protection: N N/A
 Total Deck Thick: 0.0
 Last Paint Date:

Underwater Inspection/Appraisal Information

Inspection Date:
 Temperature:
 Inspection Method:
 Appraisal Rating:

Scour Critical Information

Rating:
 Analysis Date:
 Evaluation Method:
 Microfilm Data Recorded: No

Construction Information

Year: 2007 Original
 Route: Reconstructed
 Section Nbr:
 Contract Nbr:
 Fed Aid Pr#: 2 OTHER STATE AGENCY
 Built By: 2 OTHER STATE AGENCY

Miscellaneous

Microfilm Data Recorded: No



October 27, 2015

MEMORANDUM

Mr. John Fortmann, Region One Engineer
Illinois Department of Transportation
Region One/District One

Attn: Steven Schilke

RE: Existing S.N. 099-9944
N.B. I-355 over I-55
Will County
PTB 158-002/P-91-762-10

The purpose of this technical memo is to summarize the current condition of existing S.N. 099-9944 in addition to geometrics and other factors. A cursory field check was performed to supplement the information contained in IDOT's structure summary report dated April 15, 2014 (see Appendix B). Broad-based recommendations for this structure are provided below.

The structure is a two span steel girder bridge totaling 360.0 ft. in length consisting of ten lines of continuous girders (see Photo 1). The superstructure is supported by vaulted abutments and a reinforced concrete multi-column pier. There is no overlay on the structure.

IDOT rates the deck as being in good condition. The findings from the cursory field check don't match IDOT's deck rating. Minor transverse cracks are visible throughout the top of deck and soffit. Small 1 in. deep spalls are visible on the top of deck (see Photo 2). IDOT rates the substructure as being in good condition, which concurs with the findings from the cursory field check. Map cracking is visible on the face of abutments (see Photo 3). IDOT rates the underclearance vertical and lateral as meeting the minimum tolerable limits to be left in place as is, which concurs with the findings from the cursory field check. Clearance along the inside shoulders of I-55 appear to be less than 5 ft. No notable defects or differences were observed between the cursory field check and IDOT's structure summary report for: superstructure, deck geometry, approach alignment, bridge railing appraisal and approach guardrail items. An anchor bolt nut is loose on the east exterior girder at the north abutment bearing (see Photo 4). Moderate diagonal cracks are visible on both approach slabs.

Based on the structure summary report and field check, S.N. 099-9944 is suitable for reuse after rehabilitation of the deck.



LIN ENGINEERING, LTD.
Consulting Engineers

Springfield, IL Westmont, IL

576 Oakmont Lane
Westmont, Illinois 60559
Telephone: (630) 323-5168
Fax: (630) 323-5174
E-mail: info@lineng.com

LIN ENGINEERING, LTD.

A handwritten signature in blue ink that reads "Michael T. Haley". The signature is written in a cursive style.

Michael T. Haley, PE, SE
Structural Manager

Appendix A – Photos

Appendix B – IDOT Structure Summary Report



Photo 1



Photo 2



Photo 3



Photo 4

**Illinois Department of Transportation
Structures Information Management System
Structure Summary Report**

Structure Number: 099-9944 District: 1

		Inventory Data	
Facility Carried:	I-355 NB	Bridge Name:	Sufficiency Rating:
Feature Crossed:	I-55	Location:	92.3 Structure Length:
Bridge Remarks:		Status Date:	No AASHTO Bridge Length:
Status Remarks:	1 OPEN - NO RESTRICT	10/1999	- Length of Long Span:
Maint County:	099 WILL	Maint Township:	- Bridge Roadway Width:
Service On/Under:	BRIDGE OPENED AUTOMATICALLY BY KEY ROUTE ON UPDATE TRANSACTION		04/10/2014 Appr Roadway Width:
Maint Responsibility:	02 ILL. TOLLWAY COMMISSION		Left Deck Width:
Reporting Agency:	5 SECOND LEVEL INTERCHANGE	1 / HIGHWAY	Sidewalk Width Right:
Main Span Matl/Type:	3 STEEL	/ 02 STRINGERMULTI-BEAM/GIRDER	Left Sidewalk Width Left:
Nbr Of Main Spans:	2	Nbr Of Approach Spans:	Navigation Control:
Approaches			No
Near #1 Matl/Type:			Navigation Horiz Clear:
Near #2 Matl/Type:			No
Far #1 Matl/Type:			Culvert Fill Depth:
Far #2 Matl/Type:			Number Culvert Cells:
Median Width/Type:	2 Ft. / 4 Wall		0
Guardrail Type L/R:	0None		Culvert Opening Area:
Toll Facility Indicator:	6 Toll Road		0
Latitude:	41.70422464		Culvert Cell Height:
Deck Structure Type:	A CIP CON NRMLLY FORM		0
Sidewalks Under Structure:	0 None		Culvert Cell Width:
			0.00
			Rate Method:
			Consultant
			Rated By: 3
			1.080(38)
			Load Rating Date: 03/02/2011
			1.910(68)
			Crossing 1 Nbr:
			Design Load: 99
			UNKNOWN
			Crossing 1 Nbr:
			0 SD: N
			FO: N
			RR Lateral Underclear:
			RR Vertical Underclear:
			0
			Ft 0
			In
			RR Road Crossing Info

Key Route On Data

Key Route Nbr:	FEDERAL-AID INTERSTATE	Station:	1.6800
Appurtenances	Main Route	Segment:	00000
Inventory County:	099 WILL	Linked:	Y
Township/Road Dist	04 DUPAGE	Natl. Hwy System:	On NHS
Municipality	3185 LEMONT	Inventory Direction:	
Urban Area:	1051	Curr AADT Yr/Count:	2013 / 34850
Functional Class:	1 INTERSTATE	Est Truck Percentage:	13
** CLEARANCES **	South/East	Number Of Lanes:	4
Max Rdwy Width:	0.0	One Or Two Way:	1 One-Way
Horizontal:	48.0	Bypass Length:	1
		Future AADT Yr/Cnt:	2032 / 43784
		Designated Truck Rte:	CLASS I
		Special Systems:	Yes

Key Route Under Data

Key Route Nbr:	FEDERAL-AID INTERSTATE	Station:	35.9000
Appurtenances	Main Route	Segment:	00000
Inventory County:	099 WILL	Linked:	Y
Township/Road Dist	04 DUPAGE	Natl. Hwy System:	On NHS
Municipality	6350 WOODRIDGE	Inventory Direction:	
Urban Area:	1051	Curr AADT Yr/Count:	2014 / 106500
Functional Class:	1 INTERSTATE	Est Truck Percentage:	13
** CLEARANCES **	South/East	Number Of Lanes:	10
Max Rdwy Width:	0.0	One Or Two Way:	2 Two-Way
Horizontal:	160.0	Bypass Length:	0
		Future AADT Yr/Cnt:	2032 / 176744
		Designated Truck Rte:	CLASS I
		Special Systems:	Yes

****** Marked Route On Data ******

Route #1:	Designation	Kind	Number
1	Mainline	1 Interstate Highway	355
Route #2:	1 Mainline		
Route #3:	1 Mainline		

****** Marked Route Under Data ******

Route #1:	Designation	Kind	Number
1	Mainline	1 Interstate Highway	055
Route #2:	1 Mainline		
Route #3:	1 Mainline		

Illinois Department of Transportation
Structures Information Management System
Structure Summary Report

Structure Number: 099-9944 District: 1

*** Inspection Intervals *** Data Related to Inspection Information

Routine NBIS: 24 MOS Underwater: 0 MOS One Truck At A Time: 0 Tons Bridge Posting Level: 5 No Posting Required
Special: N Single Unit Vehicles: Tons Combination Type 3S-1: Tons Combination Type 3S-2: Tons

*** Maximum Allowable Posting Limits ***

Inspection Date: 04/15/2014 Inspection Temperature: 40Deg. F

Deck: 7 GOOD CONDITION - SOME MINOR PROBLEMS
Superstructure: 7 GOOD CONDITION - SOME MINOR PROBLEMS
Substructure: 7 GOOD CONDITION - SOME MINOR PROBLEMS
Culvert: N NOT APPLICABLE
Channel and Protection: N NOT APPLICABLE
Structural Evaluation: 7 BETTER THAN PRESENT MINIMUM CRITERIA
Deck Geometry: 4 MINIMUM ADEQUACY TO BE LEFT IN PLACE
Underclearance-Vert/Lat.: 4 MINIMUM ADEQUACY TO BE LEFT IN PLACE
Waterway Adequacy: N NOT APPLICABLE
Approach Roadway Align: 8 EQUAL TO PRESENT DESIRABLE CRITERIA
Bridge Railing Appraisal: 3 Meets Standards
Approach Guardrail: 333 Acceptable
Pier Navig Protection: N N/A

Inspection/Apraisal Information

Deck Wearing Surf: N N/A - NO DECK
Deck Membrane: N N/A
Deck Protection: N N/A
Total Deck Thick: 0.0
Last Paint Date:

Single Unit Vehicles: Tons
Combination Type 3S-1: Tons
Combination Type 3S-2: Tons
One Truck At A Time: 0
Last Paint Type:

*** Actual Posted Limits ***

Inspection Date: Inspection Method: Appraisal Rating:
Temperature: Inspection Method: Appraisal Rating:

Underwater Inspection/Apraisal Information

Rating: Scour Critical Information Evaluation Method: Miscellaneous
Analysis Date: Microfilm Data Recorded: No

Construction Information

Year: 1989 Original Reconstructed
Route: Sta:
Section Nbr: Sta:
Contract Nbr:
Fed Aid Pr#: 2 OTHER STATE AGENCY
Built By: 2 OTHER STATE AGENCY

O'Holleran, John

From: Baldauf, John E. <John.Baldauf@Illinois.gov>
Sent: Tuesday, July 26, 2016 2:45 PM
To: O'Holleran, John
Cc: Schilke, Steven E; Smith, Corey J.
Subject: FW: RR Structures | I-55 Managed Lanes
Attachments: CO-11285.0.pdf; CO-11286.0.pdf; CO-11283.0.pdf; CO-11284.0.pdf

Follow Up Flag: Follow up
Flag Status: Flagged

FYI – we also requested a cost estimate from our RR Unit for flagging and any other associated costs with the proposed railroad work.

John Baldauf, P.E.

Project Manager

Illinois Department of Transportation

Bureau of Programming | Major Projects Unit
201 West Center Court | Schaumburg, IL 60196-1096
Phone: 847.705.4103 | john.baldauf@illinois.gov

 Please consider the environment before printing this email.

From: Stoddard, Keith W.
Sent: Tuesday, July 26, 2016 2:26 PM
To: Baldauf, John E.
Cc: Schilke, Steven E; Smith, Corey J.; Broviak, Pamela A.; Rayyan, Issam Y
Subject: RE: RR Structures | I-55 Managed Lanes

John

Based on the title commitments we received in December 2015, attached, additional documents I reviewed and the location of the improvements shown in your exhibits it is my opinion that additional ROW/Easements will not be needed at the Railroads mentioned directly below.

B&O RR-The State has Fee Simple interest per Document # 19024366-, Commitment 11284.0, Current Owner-People of the State of Illinois, Department of Transportation (from 12-29-15 email)

Sincerely,

Keith W. Stoddard PLS

Chief of Plats and Plans

Illinois Department of Transportation
District 1, Bureau of Land Acquisition
201 West Center Ct.
Schaumburg, IL 60196-1096
847-705-4771 (Office)
847-705-4218 (Fax)
keith.stoddard@illinois.gov

From: Baldauf, John E.
Sent: Monday, July 25, 2016 11:39 AM
To: Stoddard, Keith W.
Cc: Schilke, Steven E; Smith, Corey J.; Broviak, Pamela A.; Rayyan, Issam Y
Subject: RE: RR Structures | I-55 Managed Lanes

Keith,

We are nearing completion of Phase I and at this time we are only proposing work to I-55 over the BRC Railroad (full bridge replacement), B&O Railroad (widening – sub & superstructure), and GM&O Railroad (widening – superstructure only). All widening will occur in the I-55 median (see attached location maps).

Based on the information provided it is our understanding the State has existing easement and/or fee simple rights at the subject locations and no additional ROW will be necessary. Please confirm and/or let us know if you need anything additional from us.

Thank you,

John Baldauf, P.E.
Project Manager

Illinois Department of Transportation
Bureau of Programming | Major Projects Unit
201 West Center Court | Schaumburg, IL 60196-1096
Phone: 847.705.4103 | john.baldauf@illinois.gov

 Please consider the environment before printing this email.

From: Stoddard, Keith W.
Sent: Thursday, December 17, 2015 2:08 PM
To: Baldauf, John E.; Schilke, Steven E
Cc: Smith, Corey J.
Subject: RE: RR Structures | I-55 Managed Lanes

John

We have received 3 of the 4 commitments.

- GM&O RR- The State has easements rights-Commitment 11283.0, Current Owner- Illinois Central Railroad Company, see Item 9, Schedule B Easements Rights to Cook County Highway Department
- B&O RR-The State has Fee Simple interest per Document # 19024366-, Have not received commitment yet.
- BRC RR-Unable to find conveyance document, may need ROW-Commitment 11285, Current Owner-The State of Illinois, in Trust for the People of the State of Illinois
- CSXT RR-Need ROW-Commitment 11286, Current Owner-Baltimore and Ohio Chicago Terminal Railroad

Sincerely,

Keith W. Stoddard PLS
Chief of Plats and Plans
Illinois Department of Transportation
District 1, Bureau of Land Acquisition
201 West Center Ct.
Schaumburg, IL 60196-1096
847-705-4771 (Office)

847-705-4218 (Fax)
keith.stoddard@illinois.gov

From: Baldauf, John E.
Sent: Tuesday, November 10, 2015 4:43 PM
To: Stoddard, Keith W.; Schilke, Steven E
Cc: Smith, Corey J.
Subject: RE: RR Structures | I-55 Managed Lanes

Good Afternoon Keith,

Just a friendly follow up regarding the status of the order, we wanted to check if you have received anything yet.

Thank you,

John Baldauf, P.E.
Project Manager

Illinois Department of Transportation
Bureau of Programming | Major Projects Unit
201 West Center Court | Schaumburg, IL 60196-1096
Phone: 847.705.4103 | john.baldauf@illinois.gov

 Please consider the environment before printing this email.

From: Stoddard, Keith W.
Sent: Tuesday, October 13, 2015 9:16 AM
To: Baldauf, John E.; Schilke, Steven E
Cc: Smith, Corey J.
Subject: RE: RR Structures | I-55 Managed Lanes

John

The commitment were ordered on September 28th, I do not expect to receive them until the week of October 26th.

Sincerely,

Keith W. Stoddard PLS
Chief of Plats and Plans
Illinois Department of Transportation
District 1, Bureau of Land Acquisition
201 West Center Ct.
Schaumburg, IL 60196-1096
847-705-4771 (Office)
847-705-4218 (Fax)
keith.stoddard@illinois.gov

From: Baldauf, John E.
Sent: Tuesday, October 13, 2015 9:11 AM
To: Stoddard, Keith W.; Schilke, Steven E
Cc: Smith, Corey J.
Subject: RE: RR Structures | I-55 Managed Lanes

Good Morning Keith,

I know you mentioned it might take 4 weeks to obtain this documentation, but we just wanted to follow up with you to see if you received any information or updates yet.

Thank Keith!

John Baldauf, P.E.

Illinois Department of Transportation

Bureau of Programming | Project and Environmental Studies
201 West Center Court | Schaumburg, IL 60196-1096
Phone: 847.705.4103 | john.baldauf@illinois.gov

 Please consider the environment before printing this email.

From: Stoddard, Keith W.
Sent: Monday, September 28, 2015 11:48 AM
To: Schilke, Steven E
Cc: Smith, Corey J.; Baldauf, John E.
Subject: RE: RR Structures | I-55 Managed Lanes

I ordered them priority so I expect to receive them in 4 weeks.

Sincerely,

Keith W. Stoddard PLS
Chief of Plats and Plans
Illinois Department of Transportation
District 1, Bureau of Land Acquisition
201 West Center Ct.
Schaumburg, IL 60196-1096
847-705-4771 (Office)
847-705-4218 (Fax)
keith.stoddard@illinois.gov

From: Schilke, Steven E
Sent: Monday, September 28, 2015 11:40 AM
To: Stoddard, Keith W.
Cc: Smith, Corey J.; Baldauf, John E.
Subject: Re: RR Structures | I-55 Managed Lanes

So you have a timeframe when we can
Expect them?

On Sep 28, 2015, at 11:39 AM, Stoddard, Keith W. <Keith.Stoddard@Illinois.gov> wrote:

Title Commitments have been ordered

Sincerely,

Keith W. Stoddard PLS
Chief of Plats and Plans

Illinois Department of Transportation
District 1, Bureau of Land Acquisition
201 West Center Ct.
Schaumburg, IL 60196-1096
847-705-4771 (Office)
847-705-4218 (Fax)
keith.stoddard@illinois.gov

From: Stoddard, Keith W.
Sent: Monday, September 28, 2015 10:47 AM
To: Schilke, Steven E
Cc: Smith, Corey J.; Baldauf, John E.
Subject: RE: RR Structures | I-55 Managed Lanes

Steve

As a follow up to our conversation this morning my opinion based on the documentation I was able to find in our archives is as follows:

- GM&O RR- The State has easements rights
- B&O RR-The State has Fee Simple interest per Document # 19024366
- BRC RR-Unable to find conveyance document, may need ROW
- CSXT RR-Need ROW

I will be ordering Title Commitments at all 4 crossings with the priority being the BRC RR crossing. For your use I have included the documentation I found for each RR.

Sincerely,

Keith W. Stoddard PLS
Chief of Plats and Plans
Illinois Department of Transportation
District 1, Bureau of Land Acquisition
201 West Center Ct.
Schaumburg, IL 60196-1096
847-705-4771 (Office)
847-705-4218 (Fax)
keith.stoddard@illinois.gov

From: Baldauf, John E.
Sent: Friday, September 25, 2015 9:28 AM
To: Stoddard, Keith W.
Cc: Schilke, Steven E; Smith, Corey J.
Subject: RR Structures | I-55 Managed Lanes
Importance: High

Keith,

As discussed, please provide information regarding ROW rights & ownership at the following I-55 structures over railroads (location maps attached):

I-55 Managed Lane Bridges			
Location	Feature Crossed	SN	Scope

1	RR BRC (I-55 EB)	016-0018	Replacement
	RR BRC (I-55 WB)	016-0019	Replacement
2	CSXT Railroad Bridge (I-55 WB)	016-0012	Widening and rehabilitation
	CSXT Railroad Bridge (I-55 EB)	016-0013	Widening and rehabilitation
3	B&O RR/Western Ave (I-55 EB)	016-1058	Widening and rehabilitation
	B&O RR/Western Ave (I-55 WB)	016-0026	Widening and rehabilitation
4	GM&O RR/Ashland Ave (I-55 EB)	016-1084	Widening and rehabilitation
	GM&O RR/Ashland Ave (I-55 WB)	016-1083	Widening and rehabilitation

Thank you,

John Baldauf, P.E.

Illinois Department of Transportation

Bureau of Programming | Project and Environmental Studies

201 West Center Court | Schaumburg, IL 60196-1096

Phone: 847.705.4103 | john.baldauf@illinois.gov

PRIVILEGED & CONFIDENTIALITY NOTICE: This email transmission (and /or the documents accompanying such) may contain legally privileged/confidential information. Such information is intended only for the use of the individual or entity above. If you are not the named or intended recipient, you are hereby notified that any disclosure, copying, distribution, or the taking of any action in reliance on the contents of such information is strictly prohibited. If you have received this transmission in error, please immediately notify the sender by telephone to arrange for the secure return of the document.



Please consider the environment before printing this email.

Prepared For:

Illinois Department of Transportation 1
201 West Center Court
Schaumburg, IL 60196-1096

Effective Date of Commitment: December 01, 2015

Job:	R-90-999-90	WTG#:	I1-2015CO-11283.0
:		Effective Date:	December 01, 2015
County:	Cook	Section:	31
Section:	I-55 RR Bridges	Township:	39N
Parcel:		Range:	14E

Tax Parcel Number(s):
17-31-204-053(pt); 17-31-204-046(pt); 17-31-502-028(pt)

Job R-90-999-90

County Cook
Section I-55 RR Bridges
Parcel

A.L.T.A. COMMITMENT FORM

Schedule A

WTG Number: I1-2015CO-11283.0

Effective Date: December 01, 2015

1. Policy or Policies to be issued: 2006 ALTA Owner's
Proposed Amount of Insurance: \$1,000.00
Proposed Insured: The People of the State of Illinois
Department of Transportation
2. The estate or interest in the land described or referred to in this commitment is a Fee Simple and title hereto is at the effective date hereof vested in:

Illinois Central Railroad Company
3. The land referred to in this commitment is described as follows:

See Attached Page 2 of Schedule A

ISSUED BY:

Wheatland Title Guaranty Company
105 W. Veterans Parkway
Yorkville, Illinois 60560

Agent for:
Fidelity National Title Insurance Company



Job R-90-999-90

County Cook
Section I-55 RR Bridges
Parcel

WTG Number: I1-2015CO-11283.0

A.L.T.A. COMMITMENT FORM

Schedule A Continued

LEGAL DESCRIPTION

THAT PART OF BLOCK 2 IN CANAL TRUSTEE'S SUBDIVISION OF THE EAST ONE HALF OF SECTION 31, TOWNSHIP 39 NORTH, RANGE 14, EAST OF THE THIRD PRINCIPAL MERIDIAN, BOUND AND DESCRIBED AS FOLLOWS: COMMENCING IN THE WEST LINE OF SAID BLOCK 2, BEING THE EAST LINE OF SOUTH WOOD STREET, 341.0 FEET SOUTH OF THE NORTHWEST CORNER OF BLOCK 2 AFORESAID; THENCE EAST PARALLEL WITH THE NORTH LINE OF SAID BLOCK 2, BEING THE SOUTH LINE OF WEST 31ST STREET, TO THE INTERSECTION WITH A LINE 41.0 FEET NORTHWESTERLY OF AND PARALLEL WITH THE CENTER LINE BETWEEN MAIN TRACKS OF THE GULF MOBILE AND OHIO RAILROAD, FOR A POINT OF BEGINNING; THENCE NORTHEASTERLY ON SAID PARALLEL LINE TO THE INTERSECTION WITH THE NORTH LINE OF BLOCK 2 AFORESAID; THENCE EAST IN SAID NORTH LINE TO THE INTERSECTION WITH THE NORTHEASTERLY LINE OF BLOCK 2 AFORESAID, BEING THE SOUTHWESTERLY LINE OF SOUTH ROBINSON STREET; THENCE SOUTHEASTERLY IN SAID NORTHEASTERLY LINE TO THE NORTHEAST CORNER OF LOT 1 IN STINSON'S RESUBDIVISION OF THE SOUTHWESTERLY ONE HALF OF LOT 37, ALL OF LOTS 38, 39, AND 45 TO 77 INCLUSIVE, IN STINSON'S SUBDIVISION OF BLOCKS 1, 2, AND 10, IN CANAL TRUSTEE'S SUBDIVISION AFOREMENTIONED; THENCE SOUTHWESTERLY ALONG THE NORTHWESTERLY LINE OF LOTS 1 TO 12 INCLUSIVE OF STINSON'S RESUBDIVISION AFORESAID, TO THE NORTHWESTERLY CORNER OF LOT 12 AFORESAID; THENCE WEST TO A POINT IN A LINE 110.0 FEET NORTHWESTERLY OF AND PARALLEL WITH SAID NORTHWESTERLY LINE OF LOTS 1 TO 12, SAID POINT BEING 370.0 FEET NORTHEASTERLY OF THE WEST LINE OF BLOCK 2 AFORESAID (AS MEASURED IN SAID 110.0 FEET PARALLEL LINE); THENCE SOUTHWESTERLY IN SAID PARALLEL LINE TO THE

ISSUED BY:
Wheatland Title Guaranty Company
105 W. Veterans Parkway
Yorkville, Illinois 60560

Agent for:
Fidelity National Title Insurance Company

12/14/2015

Job R-90-999-90

County Cook

Section I-55 RR Bridges

Parcel

INTERSECTION WITH THE AFOREMENTIONED LINE 341.0 FEET SOUTH OF AND PARALLEL WITH THE NORTH LINE OF SAID BLOCK 2; THENCE WEST TO POINT OF BEGINNING. SITUATED IN THE COUNTY OF COOK AND IN THE STATE OF ILLINOIS.

PERMANENT TAX NUMBER(S): 17-31-204-053(pt); 17-31-204-046(pt); 17-31-502-028(pt)

ISSUED BY:
Wheatland Title Guaranty Company
105 W. Veterans Parkway
Yorkville, Illinois 60560

Agent for:
Fidelity National Title Insurance Company

WTG Number: I1-2015CO-11283.0

A.L.T.A. COMMITMENT FORM

Schedule B Exceptions

The policy or policies to be issued will contain exceptions to the following unless the same are disposed of to the satisfaction of the Company:

GENERAL EXCEPTIONS:

1. Rights or claims of parties in possession not shown by the public records.
2. Any encroachment, encumbrance, violation, variation, or adverse circumstance affecting the Title that would be disclosed by an accurate and complete land survey of the Land.
3. Easements, or claims of easements, not shown by the public records.
4. Any lien, or right to a lien, for services, labor, or material heretofore or hereafter furnished, imposed by law and not shown by the public records.
5. Taxes or special assessments which are not shown as existing liens by the public records.
6. Loss or damage by reason of there being recorded in the public records, any deeds, mortgages, lis pendens, liens or other title encumbrances subsequent to the Commitment date and prior to the effective date of the final Policy.

SPECIAL EXCEPTIONS:

1. The lien of taxes for the year 2015 and thereafter.

Taxes for the property in question are EXEMPT.

PERMANENT TAX NUMBER: 17-31-204-053(pt)

Taxes for the property in question are not currently being assessed nor taxed by the County of Cook. Due to this we reserve the right to raise any additional exceptions that may be deemed necessary.

PERMANENT TAX NUMBER: 17-31-204-046(pt)

ISSUED BY:
Wheatland Title Guaranty Company
105 W. Veterans Parkway
Yorkville, Illinois 60560

Agent for:
Fidelity National Title Insurance Company

WTG Number: I1-2015CO-11283.0

Taxes for the property in question are not currently being assessed nor taxed by the County of Cook. Due to this we reserve the right to raise any additional exceptions that may be deemed necessary.

PERMANENT TAX NUMBER: 17-31-502-028(pt)

2. Rights of parties in possession, encroachments, overlaps, overhangs, unrecorded easements, deficiency in quantity of ground, farm drainage systems, tile systems or irrigation systems which would be disclosed by an accurate survey and inspection of the premises.
3. Rights of the Public, the State and the Municipality in and to that part of the land, if any, taken or used for road purposes.
4. Confirmed Special Assessments, if any, not certified to by the Company.
5. Financing Statements, if any, not certified to by the Company.
6. For information purposes only, the taxes are assessed to the following:

For Parcel: 17-31-204-053(pt)

City of Chicago

30 N. LaSalle Ste 3700

Chicago, Il 60602

For Parcel: 17-31-204-046(pt)

No name available

For Parcel: 17-31-502-028(pt)

No name available

7. Conveyances within the past five years: None.
8. Contiguous property owned by record title holder: None.

PLEASE CONTACT OUR OFFICE REGARDING CONTIGUOUS PROPERTY AS THE SUBJECT PROPERTY IS OWNED BY A RAILROAD COMPANY.

9. A Grant and Plat of Easement dated January 13, 1964 and recorded February 10, 1964 as Document No. 19044004 made by Gulf, Mobile & Ohio Railroad to County of Cook, Department of Highways recorded in the Cook County Recorder's Office.

10. A Memorandum of Easement dated June 28, 1984 and recorded August 7, 1984

ISSUED BY:

Wheatland Title Guaranty Company

105 W. Veterans Parkway

Yorkville, Illinois 60560

Agent for:

Fidelity National Title Insurance Company

WTG Number: I1-2015CO-11283.0

as Document No. 27203243 made by Illinois Central Gulf Railroad Company to MC Telecommunications Corporation recorded in the Cook County Recorder's Office.

11. A Memorandum of Easement dated October 22, 1984 and recorded January 29, 1985 as Document No. 27422665 made by Illinois Central Gulf Railroad Company to GTE Sprint Communication Corporation recorded in the Cook County Recorder's Office.

12. Upon a conveyance or mortgage of said property in question, we should be furnished with a certified copy of proper resolutions passed by the proper parties authorizing the execution of the documents of conveyance or mortgage.

13. We are unable to locate the original deed to the railroad and therefore cannot determine if the railroad was conveyed fee title, a conditional conveyance with a possibility of reverter or a right of way only. We should be informed of the type of estate or interest to be acquired as our commitment and subsequent policy may be subject to any potential interests that may arise as a result of the above. Due to the above, this commitment is subject to such further exceptions, if any, as may be deemed necessary.

14. Note: This tax parcel number covers more than the property in question.

15. An Order Establishing a Freeway recorded July 17, 1961 as document 18218786, made by State of Illinois, Department of Public Works and Buildings.

16. A Route Location Decision recorded July 17, 1961 as document 18218787, made by State of Illinois, Department of Public Works and Buildings.

- End Schedule B -

Please refer all inquiries to John D. Ammons at (630) 892-2323

ISSUED BY:
Wheatland Title Guaranty Company
105 W. Veterans Parkway
Yorkville, Illinois 60560

Agent for:
Fidelity National Title Insurance Company

WTG Number: II-2015CO-11283.0

MINUTES OF CONDEMNATION

In order that we may guarantee title after completion of any proceedings for condemnation in exercise of the proposed insured's right of eminent domain, we note the following.

- I. Upon the filing of complaint a proper Lis Pendens Notice should be recorded in the appropriate Recorder's office.
- II. Our Policy, when issued, will be subject to direct attack upon any decrees and or judgments entered in the proceedings.
- III. The following persons are necessary parties to any such proceedings.
 - A. All parties acquiring rights in the premises subsequent to the date of the report and prior to a complete Lis Pendens.
 - B. Any person other than those herein named known to the Plaintiff or the Plaintiff's attorney to have or claim an interest in the premises.
 - C. If it is known that any of the necessary parties named herein are deceased, their heirs or devisees should be made parties by name, if known, and if unknown, then by the name and description of Unknown Heirs and Devisees of such deceased person or persons.
 - D. If it is not known or cannot be ascertained whether any of said necessary parties be living or dead, then such parties should be made parties by name, also such parties should be their heirs or devisees, should be made parties to the proceedings as UNKNOWN OWNERS.
 - E. All persons in possession of any part of the premises in question and all persons whose rights would be disclosed by an inspection of the premises.
 - F. All parties claiming by through or under lease agreements whether oral or written, for premises.
 - G. All parties claiming by or through or under installment contracts for deed or like agreements.

WTG Number: I1-2015CO-11283.0

MINUTES OF CONDEMNATION CONTINUED

IV. The following persons are noted of record and are necessary parties to any proceedings:

H. The Plaintiff is:

The People of the State of Illinois, Department of Transportation

I. The Defendants are:

1. Illinois Central Railroad Company
2. City of Chicago

J. Any parties named above who have executed all necessary documents for the Grant of Easement and Right of Way after payment of agreed consideration theretofore need not be joined as party defendants for our policy to be issued.

END MINUTES OF CONDEMNATION

Please refer all inquiries to John D. Ammons at (630) 892-2323

Prepared For:

Illinois Department of Transportation 1
201 West Center Court
Schaumburg, IL 60196-1096

Effective Date of Commitment: November 27, 2015

Job:	R-90-999-90	WTG#:	I1-2015CO-11284.0
:		Effective Date:	November 27, 2015
County:	Cook	Section:	36
Section:	I-55 RR Bridges	Township:	39N
Parcel:		Range:	13E

Tax Parcel Number(s):
No PIN assigned

Job R-90-999-90

County Cook
Section I-55 RR Bridges
Parcel

A.L.T.A. COMMITMENT FORM

Schedule A

WTG Number: I1-2015CO-11284.0

Effective Date: November 27, 2015

- 1. Policy or Policies to be issued: 2006 ALTA Owner's
Proposed Amount of Insurance: \$1,000.00
Proposed Insured: The People of the State of Illinois
Department of Transportation

- 2. The estate or interest in the land described or referred to in this commitment is a Fee Simple and title hereto is at the effective date hereof vested in:

The People of the State of Illinois, Department of Transportation

- 3. The land referred to in this commitment is described as follows:

See Attached Page 2 of Schedule A

ISSUED BY:

Wheatland Title Guaranty Company
105 W. Veterans Parkway
Yorkville, Illinois 60560



Agent for:
Fidelity National Title Insurance Company

Job R-90-999-90

County Cook
Section I-55 RR Bridges
Parcel

WTG Number: I1-2015CO-11284.0

A.L.T.A. COMMITMENT FORM

Schedule A Continued

LEGAL DESCRIPTION

ALL THAT PART OF THE FOLLOWING DESCRIBED PARCEL LYING EAST OF THE WEST LINE OF VACATED CAMPBELL AVENUE (EXTENDED) AND EAST OF THE EAST LINE OF LOT 22 (EXTENDED SOUTH) IN BLOCK 7 IN STEEL AND BUCHANANA SUBDIVISION (ALSO KNOWN AS MANCHESTER) OF THAT PART OF THE EAST 1/2 OF THE NORTHEAST 1/4 OF SECTION 36, TOWNSHIP 39 NORTH, RANGE 13, EAST OF THE THIRD PRINCIPAL MERIDIAN, IN COOK COUNTY, ILLINOIS, LYING NORTH OF ILLINOIS AND MICHIGAN CANAL, COOK COUNTY, ILLINOIS, TO WIT:

THAT PART OF THE ILLINOIS AND MICHIGAN CANAL AND THE 90 FOOT RESERVE STRIPS ON EITHER SIDE OF SAID CANAL FALLING WITHIN THE NORTHEAST QUARTER OF SECTION 36, TOWNSHIP 39 NORTH, RANGE 13, EAST OF THE THIRD PRINCIPAL MERIDIAN, IN COOK COUNTY, ILLINOIS, EXCEPT THAT PART LYING WEST OF A LINE DESCRIBED AS FOLLOWS: COMMENCING AT A POINT ON THE SOUTHERLY LINE OF THE SOUTHERLY CANAL RESERVE OF THE ILLINOIS AND MICHIGAN CANAL, WHICH IS 617.29 FEET (AS MEASURED ALONG SAID LINE) SOUTH WESTERLY OF THE INTERSECTION OF SAID SOUTHERLY LINE WITH THE WEST LINE OF CAMPBELL AVENUE AS DEDICATED SEPTEMBER 1, 1904 (NOW VACATED) PRODUCED NORTH; THENCE NORTH ALONG A LINE PERPENDICULAR TO THE SOUTH LINE OF THE NORTH EAST QUARTER OF SAID SECTION 36, 301.68 FEET TO THE NORTHERLY LINE OF THE NORTHERLY CANAL RESERVE OF THE ILLINOIS AND MICHIGAN CANAL.

SITUATED IN THE COUNTY OF COOK AND IN THE STATE OF ILLINOIS.

ISSUED BY:
Wheatland Title Guaranty Company
105 W. Veterans Parkway
Yorkville, Illinois 60560

Agent for:
Fidelity National Title Insurance Company

12/22/2015

Job R-90-999-90

County Cook

Section I-55 RR Bridges

Parcel

PERMANENT TAX NUMBER(S): No PIN assigned

ISSUED BY:
Wheatland Title Guaranty Company
105 W. Veterans Parkway
Yorkville, Illinois 60560

Agent for:
Fidelity National Title Insurance Company

WTG Number: I1-2015CO-11284.0

A.L.T.A. COMMITMENT FORM

Schedule B Exceptions

The policy or policies to be issued will contain exceptions to the following unless the same are disposed of to the satisfaction of the Company:

GENERAL EXCEPTIONS:

1. Rights or claims of parties in possession not shown by the public records.
2. Any encroachment, encumbrance, violation, variation, or adverse circumstance affecting the Title that would be disclosed by an accurate and complete land survey of the Land.
3. Easements, or claims of easements, not shown by the public records.
4. Any lien, or right to a lien, for services, labor, or material heretofore or hereafter furnished, imposed by law and not shown by the public records.
5. Taxes or special assessments which are not shown as existing liens by the public records.
6. Loss or damage by reason of there being recorded in the public records, any deeds, mortgages, lis pendens, liens or other title encumbrances subsequent to the Commitment date and prior to the effective date of the final Policy.

SPECIAL EXCEPTIONS:

1. The lien of taxes for the year 2015 and thereafter.

Taxes for the property in question are not currently being assessed nor taxed by the County of Cook. Due to this we reserve the right to raise any additional exceptions that may be deemed necessary.

PERMANENT TAX NUMBER: No PIN assigned

2. Rights of parties in possession, encroachments, overlaps, overhangs, unrecorded easements, deficiency in quantity of ground, farm drainage systems, tile systems or irrigation systems which would be disclosed by an accurate survey and inspection of the premises.

ISSUED BY:
Wheatland Title Guaranty Company
105 W. Veterans Parkway
Yorkville, Illinois 60560

Agent for:
Fidelity National Title Insurance Company

WTG Number: I1-2015CO-11284.0

3. Rights of the Public, the State and the Municipality in and to that part of the land, if any, taken or used for road purposes.
4. Confirmed Special Assessments, if any, not certified to by the Company.
5. Financing Statements, if any, not certified to by the Company.
6. For information purposes only, the taxes are assessed to the following:
For Parcel(s): No PIN assigned
7. Conveyances within the past five years: None.
8. Contiguous property owned by record title holder: None.

PLEASE CONTACT OUR OFFICE REGARDING CONTIGUOUS PROPERTY AS THE SUBJECT PROPERTY IS OWNED BY THE STATE OF ILLINOIS.

9. Terms, conditions and reservations restricting the use and conveyance of the subject property set forth in Federal legislation.
10. An Order Establishing a Freeway made by the State of Illinois Department of Public Works and Buildings recorded July 17, 1961 as document 18218786.
11. A Route Location Decision made by the State of Illinois Department of Public Works and Buildings recorded July 17, 1961 as document 18218787.
12. Possible interest by use, lease, occupation or otherwise of Norfolk Southern Railway Company and CSX Transportation Company (both as successors to Consolidated Rail Corporation), Baltimore & Ohio Chicago Terminal Railroad Company and the Indiana Harbor Belt Railroad Company.
13. We cannot determine if other railroads may use of or have leases in the subject property. We reserve the right to revise our commitment should information become available disclosing the names of other railroads having rights to, or the use of, the railroad lines lying within the subject property.
14. Existing unrecorded leases, if any, and all rights thereof and all acts done or suffered thereunder by any lessee or by any party claiming by, through or under said lease or lessees.

- End Schedule B -

Please refer all inquiries to John D. Ammons at (630) 892-2323

ISSUED BY:
Wheatland Title Guaranty Company
105 W. Veterans Parkway
Yorkville, Illinois 60560

Agent for:
Fidelity National Title Insurance Company

WTG Number: I1-2015CO-11284.0

MINUTES OF CONDEMNATION

In order that we may guarantee title after completion of any proceedings for condemnation in exercise of the proposed insured's right of eminent domain, we note the following.

- I. Upon the filing of complaint a proper Lis Pendens Notice should be recorded in the appropriate Recorder's office.
- II. Our Policy, when issued, will be subject to direct attack upon any decrees and or judgments entered in the proceedings.
- III. The following persons are necessary parties to any such proceedings.
 - A. All parties acquiring rights in the premises subsequent to the date of the report and prior to a complete Lis Pendens.
 - B. Any person other than those herein named known to the Plaintiff or the Plaintiff's attorney to have or claim an interest in the premises.
 - C. If it is known that any of the necessary parties named herein are deceased, their heirs or devisees should be made parties by name, if known, and if unknown, then by the name and description of Unknown Heirs and Devisees of such deceased person or persons.
 - D. If it is not known or cannot be ascertained whether any of said necessary parties be living or dead, then such parties should be made parties by name, also such parties should be their heirs or devisees, should be made parties to the proceedings as UNKNOWN OWNERS.
 - E. All persons in possession of any part of the premises in question and all persons whose rights would be disclosed by an inspection of the premises.
 - F. All parties claiming by through or under lease agreements whether oral or written, for premises.
 - G. All parties claiming by or through or under installment contracts for deed or like agreements.

WTG Number: 11-2015CO-11284.0

MINUTES OF CONDEMNATION CONTINUED

IV. The following persons are noted of record and are necessary parties to any proceedings:

H. The Plaintiff is:

The People of the State of Illinois, Department of Transportation

I. The Defendants are:

1. Note: the owner of the subject property is The State of Illinois
2. Norfolk Southern Railway Company
3. CSX Transportation Company
4. Baltimore & Ohio Chicago Terminal Railroad Company
5. Indiana Harbor Belt Railroad Company

J. Any parties named above who have executed all necessary documents for the Grant of Easement and Right of Way after payment of agreed consideration theretofore need not be joined as party defendants for our policy to be issued.

END MINUTES OF CONDEMNATION

Please refer all inquiries to John D. Ammons at (630) 892-2323

Prepared For:

Illinois Department of Transportation 1
201 West Center Court
Schaumburg, IL 60196-1096

Effective Date of Commitment: December 01, 2015

Job:	R-90-999-90	WTG#:	I1-2015CO-11285.0
:		Effective Date:	December 01, 2015
County:	Cook	Section:	3
Section:	I-55 RR Bridges	Township:	38N
Parcel:		Range:	13E

Tax Parcel Number(s):
No PIN assigned

Job R-90-999-90

County Cook
Section I-55 RR Bridges
Parcel

A.L.T.A. COMMITMENT FORM

Schedule A

WTG Number: I1-2015CO-11285.0
Effective Date: December 01, 2015

1. Policy or Policies to be issued: 2006 ALTA Owner's
Proposed Amount of Insurance: \$1,000.00
Proposed Insured: The People of the State of Illinois
Department of Transportation

2. The estate or interest in the land described or referred to in this commitment is a Fee Simple and title hereto is at the effective date hereof vested in:


The State of Illinois, in Trust for the People of the State of Illinois

3. The land referred to in this commitment is described as follows:

See Attached Page 2 of Schedule A

ISSUED BY:

Wheatland Title Guaranty Company
105 W. Veterans Parkway
Yorkville, Illinois 60560

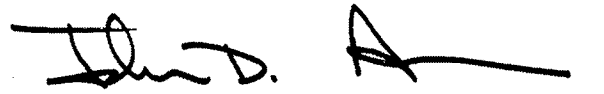

Agent for:
Fidelity National Title Insurance Company

12/15/2015

Job R-90-999-90

County Cook
Section I-55 RR Bridges
Parcel

WTG Number: I1-2015CO-11285.0

A.L.T.A. COMMITMENT FORM

Schedule A Continued

LEGAL DESCRIPTION

THAT PART OF THE ILLINOIS AND MICHIGAN CANAL AND THE 90 FOOT WIDE STRIPS LYING ON EITHER SIDE THEREOF LOCATED IN SECTION 3, IN TOWNSHIP 38 NORTH, RANGE 13, EAST OF THE THIRD PRINCIPAL MERIDIAN IN COOK COUNTY, ILLINOIS. LYING NORTH OF THE NORTH LINE OF THE RIGHT OF WAY OF THE GULF MOBILE & OHIO RAILROAD (N/K/A ILLINOIS CENTRAL RAILROAD COMPANY)

PERMANENT TAX NUMBER(S): No PIN assigned

ISSUED BY:
Wheatland Title Guaranty Company
105 W. Veterans Parkway
Yorkville, Illinois 60560

Agent for:
Fidelity National Title Insurance Company

WTG Number: I1-2015CO-11285.0

A.L.T.A. COMMITMENT FORM

Schedule B Exceptions

The policy or policies to be issued will contain exceptions to the following unless the same are disposed of to the satisfaction of the Company:

GENERAL EXCEPTIONS:

1. Rights or claims of parties in possession not shown by the public records.
2. Any encroachment, encumbrance, violation, variation, or adverse circumstance affecting the Title that would be disclosed by an accurate and complete land survey of the Land.
3. Easements, or claims of easements, not shown by the public records.
4. Any lien, or right to a lien, for services, labor, or material heretofore or hereafter furnished, imposed by law and not shown by the public records.
5. Taxes or special assessments which are not shown as existing liens by the public records.
6. Loss or damage by reason of there being recorded in the public records, any deeds, mortgages, lis pendens, liens or other title encumbrances subsequent to the Commitment date and prior to the effective date of the final Policy.

SPECIAL EXCEPTIONS:

1. The lien of taxes for the year 2015 and thereafter.

Taxes for the property in question are not currently being assessed nor taxed by the County of Cook. Due to this we reserve the right to raise any additional exceptions that may be deemed necessary.

PERMANENT TAX NUMBER: No PIN assigned

2. Rights of parties in possession, encroachments, overlaps, overhangs, unrecorded easements, deficiency in quantity of ground, farm drainage systems, tile systems or irrigation systems which would be disclosed by an accurate survey and inspection of the premises.

ISSUED BY:
Wheatland Title Guaranty Company
105 W. Veterans Parkway
Yorkville, Illinois 60560

Agent for:
Fidelity National Title Insurance Company

WTG Number: I1-2015CO-11285.0

3. Rights of the Public, the State and the Municipality in and to that part of the land, if any, taken or used for road purposes.
4. Confirmed Special Assessments, if any, not certified to by the Company.
5. Financing Statements, if any, not certified to by the Company.
6. For information purposes only, the taxes are assessed to the following:
For Parcel(s): No PIN assigned
7. Conveyances within the past five years: None.
8. Contiguous property owned by record title holder: None.
9. Right, title and interest of the Belt Railway Company of Chicago and the Chicago & Western Indiana Railroad Company in and to the subject property. We do not find a recorded conveyance or easement to or in favor of the Chicago & Western Indiana Railroad Company or Belt Railway Company of Chicago or its predecessors.
10. Terms, conditions and reservations restricting the use and conveyance of the subject property set forth in Federal legislation.
11. Possible reversionary rights in and to The United States of America. We note that legislation establishing rights in the State of Illinois require that the property be used and maintained for highway, park, recreational or other public purpose.
12. An Order Establishing a Freeway made by the State of Illinois Department of Public Works and Buildings recorded July 17, 1961 as document 18218786.
13. A Route Location Decision made by the State of Illinois Department of Public Works and Buildings recorded July 17, 1961 as document 18218787.

- End Schedule B -

Please refer all inquiries to John D. Ammons at (630) 892-2323

ISSUED BY:
Wheatland Title Guaranty Company
105 W. Veterans Parkway
Yorkville, Illinois 60560

Agent for:
Fidelity National Title Insurance Company

WTG Number: I1-2015CO-11285.0

MINUTES OF CONDEMNATION

In order that we may guarantee title after completion of any proceedings for condemnation in exercise of the proposed insured's right of eminent domain, we note the following.

- I. Upon the filing of complaint a proper Lis Pendens Notice should be recorded in the appropriate Recorder's office.
- II. Our Policy, when issued, will be subject to direct attack upon any decrees and or judgments entered in the proceedings.
- III. The following persons are necessary parties to any such proceedings.
 - A. All parties acquiring rights in the premises subsequent to the date of the report and prior to a complete Lis Pendens.
 - B. Any person other than those herein named known to the Plaintiff or the Plaintiff's attorney to have or claim an interest in the premises.
 - C. If it is known that any of the necessary parties named herein are deceased, their heirs or devisees should be made parties by name, if known, and if unknown, then by the name and description of Unknown Heirs and Devisees of such deceased person or persons.
 - D. If it is not known or cannot be ascertained whether any of said necessary parties be living or dead, then such parties should be made parties by name, also such parties should be their heirs or devisees, should be made parties to the proceedings as UNKNOWN OWNERS.
 - E. All persons in possession of any part of the premises in question and all persons whose rights would be disclosed by an inspection of the premises.
 - F. All parties claiming by through or under lease agreements whether oral or written, for premises.
 - G. All parties claiming by or through or under installment contracts for deed or like agreements.

WTG Number: I1-2015CO-11285.0

MINUTES OF CONDEMNATION CONTINUED

IV. The following persons are noted of record and are necessary parties to any proceedings:

H. The Plaintiff is:

The People of the State of Illinois, Department of Transportation

I. The Defendants are:

1. Note: the owner of the subject property is The State of Illinois
2. Belt Railway Company of Chicago
3. Chicago & Western Indiana Railroad Company

J. Any parties named above who have executed all necessary documents for the Grant of Easement and Right of Way after payment of agreed consideration theretofore need not be joined as party defendants for our policy to be issued.

END MINUTES OF CONDEMNATION

Please refer all inquiries to John D. Ammons at (630) 892-2323

12/15/2015

Prepared For:

**Illinois Department of Transportation 1
201 West Center Court
Schaumburg, IL 60196-1096**

Effective Date of Commitment: December 01, 2015

Job:	R-90-999-90	WTG#:	I1-2015CO-11286.0
:		Effective Date:	December 01, 2015
County:	Cook	Section:	14
Section:	I-55 RR Bridges	Township:	38N
Parcel:		Range:	12E

**Tax Parcel Number(s):
18-14-501-001(pt); 18-14-501-004(pt)**

12/15/2015

Job R-90-999-90

County Cook
Section I-55 RR Bridges
Parcel

A.L.T.A. COMMITMENT FORM

Schedule A

WTG Number: I1-2015CO-11286.0

Effective Date: December 01, 2015

1. Policy or Policies to be issued: 2006 ALTA Owner's
Proposed Amount of Insurance: \$1,000.00
Proposed Insured: The People of the State of Illinois
Department of Transportation

2. The estate or interest in the land described or referred to in this commitment is a Fee Simple and title hereto is at the effective date hereof vested in:


Baltimore and Ohio Chicago Terminal Railroad

3. The land referred to in this commitment is described as follows:

See Attached Page 2 of Schedule A

ISSUED BY:

Wheatland Title Guaranty Company
105 W. Veterans Parkway
Yorkville, Illinois 60560



Agent for:
Fidelity National Title Insurance Company

12/15/2015

Job R-90-999-90

County Cook
Section I-55 RR Bridges
Parcel

WTG Number: I1-2015CO-11286.0

A.L.T.A. COMMITMENT FORM

Schedule A Continued

LEGAL DESCRIPTION

ALL THAT PART OF THE FORMER CHICAGO AND CALUMET TERMINAL RAILWAY COMPANY RIGHT OF WAY, 100 FEET IN WIDTH, RUNNING IN A GENERAL NORTHWESTERLY/SOUTHEASTERLY DIRECTION THROUGH THE SOUTH 1/2 OF THE WEST 1/2 OF THE NORTHEAST 1/4, OF SECTION 14, TOWNSHIP 38 NORTH, RANGE 12 EAST OF THE THIRD PRINCIPAL MERIDIAN, COOK COUNTY, ILLINOIS, BEING THAT LAND CONVEYED TO SAID CHICAGO AND CALUMET TERMINAL RAILWAY COMPANY BY DEED RECORDED AS DOCUMENT 1155432. SITUATED IN THE COUNTY OF COOK, IN THE STATE OF ILLINOIS.

PERMANENT TAX NUMBER(S): 18-14-501-001(pt); 18-14-501-004(pt)

ISSUED BY:
Wheatland Title Guaranty Company
105 W. Veterans Parkway
Yorkville, Illinois 60560

Agent for:
Fidelity National Title Insurance Company

WTG Number: I1-2015CO-11286.0

A.L.T.A. COMMITMENT FORM

Schedule B Exceptions

The policy or policies to be issued will contain exceptions to the following unless the same are disposed of to the satisfaction of the Company:

GENERAL EXCEPTIONS:

1. Rights or claims of parties in possession not shown by the public records.
2. Any encroachment, encumbrance, violation, variation, or adverse circumstance affecting the Title that would be disclosed by an accurate and complete land survey of the Land.
3. Easements, or claims of easements, not shown by the public records.
4. Any lien, or right to a lien, for services, labor, or material heretofore or hereafter furnished, imposed by law and not shown by the public records.
5. Taxes or special assessments which are not shown as existing liens by the public records.
6. Loss or damage by reason of there being recorded in the public records, any deeds, mortgages, lis pendens, liens or other title encumbrances subsequent to the Commitment date and prior to the effective date of the final Policy.

SPECIAL EXCEPTIONS:

1. The lien of taxes for the year 2015 and thereafter.

Taxes for the property in question are not currently being assessed nor taxed by the County of Cook. Due to this we reserve the right to raise any additional exceptions that may be deemed necessary.

PERMANENT TAX NUMBER: 18-14-501-001(pt)

Taxes for the property in question are not currently being assessed nor taxed by the County of Cook. Due to this we reserve the right to raise any additional exceptions that may be deemed necessary.

ISSUED BY:
Wheatland Title Guaranty Company
105 W. Veterans Parkway
Yorkville, Illinois 60560

Agent for:
Fidelity National Title Insurance Company

WTG Number: I1-2015CO-11286.0

PERMANENT TAX NUMBER: 18-14-501-004(pt)

2. Rights of parties in possession, encroachments, overlaps, overhangs, unrecorded easements, deficiency in quantity of ground, farm drainage systems, tile systems or irrigation systems which would be disclosed by an accurate survey and inspection of the premises.
3. Rights of the Public, the State and the Municipality in and to that part of the land, if any, taken or used for road purposes.
4. Confirmed Special Assessments, if any, not certified to by the Company.
5. Financing Statements, if any, not certified to by the Company.
6. For information purposes only, the taxes are assessed to the following:

For Parcel(s): 18-14-501-001(pt); 18-14-501-004(pt)
No name available
7. Conveyances within the past five years: None.
8. Contiguous property owned by record title holder: None.

PLEASE CONTACT OUR OFFICE REGARDING CONTIGUOUS PROPERTY AS THE SUBJECT PROPERTY IS OWNED BY A RAILROAD COMPANY.

9. An Order Establishing a Freeway recorded July 17, 1961 as document 18218786, made by State of Illinois, Department of Public Works and Buildings.
10. An Route Location Decision recorded July 17, 1961 as document 18218787, made by State of Illinois, Department of Public Works and Buildings.
11. Any and all rights of the United States of America, the State of Illinois, the municipality and the public in and to that part of the subject property lying within the bed of the Desplaines River, and the rights, if any, of the adjoining property owners in and to the free and unobstructed flow of the water thereof.
12. Upon a conveyance or mortgage of said property in question, we should be furnished with a certified copy of proper resolutions passed by the proper parties authorizing the execution of the documents of conveyance or mortgage.
13. Note: This tax parcel number covers more than the property in question.

ISSUED BY:
Wheatland Title Guaranty Company
105 W. Veterans Parkway
Yorkville, Illinois 60560

Agent for:
Fidelity National Title Insurance Company

12/15/2015

WTG Number: I1-2015CO-11286.0

- End Schedule B -

Please refer all inquiries to John D. Ammons at (630) 892-2323

ISSUED BY:
Wheatland Title Guaranty Company
105 W. Veterans Parkway
Yorkville, Illinois 60560

Agent for:
Fidelity National Title Insurance Company

WTG Number: I1-2015CO-11286.0

MINUTES OF CONDEMNATION

In order that we may guarantee title after completion of any proceedings for condemnation in exercise of the proposed insured's right of eminent domain, we note the following.

- I. Upon the filing of complaint a proper Lis Pendens Notice should be recorded in the appropriate Recorder's office.
- II. Our Policy, when issued, will be subject to direct attack upon any decrees and or judgments entered in the proceedings.
- III. The following persons are necessary parties to any such proceedings.
 - A. All parties acquiring rights in the premises subsequent to the date of the report and prior to a complete Lis Pendens.
 - B. Any person other than those herein named known to the Plaintiff or the Plaintiff's attorney to have or claim an interest in the premises.
 - C. If it is known that any of the necessary parties named herein are deceased, their heirs or devisees should be made parties by name, if known, and if unknown, then by the name and description of Unknown Heirs and Devisees of such deceased person or persons.
 - D. If it is not known or cannot be ascertained whether any of said necessary parties be living or dead, then such parties should be made parties by name, also such parties should be their heirs or devisees, should be made parties to the proceedings as UNKNOWN OWNERS.
 - E. All persons in possession of any part of the premises in question and all persons whose rights would be disclosed by an inspection of the premises.
 - F. All parties claiming by through or under lease agreements whether oral or written, for premises.
 - G. All parties claiming by or through or under installment contracts for deed or like agreements.

WTG Number: I1-2015CO-11286.0

MINUTES OF CONDEMNATION CONTINUED

IV. The following persons are noted of record and are necessary parties to any proceedings:

H. The Plaintiff is:

The People of the State of Illinois, Department of Transportation

I. The Defendants are:

1. Baltimore and Ohio Chicago Terminal Railroad

J. Any parties named above who have executed all necessary documents for the Grant of Easement and Right of Way after payment of agreed consideration theretofore need not be joined as party defendants for our policy to be issued.

END MINUTES OF CONDEMNATION

Please refer all inquiries to John D. Ammons at (630) 892-2323

From: [Baldauf, John E.](#)
To: [O'Holleran, John](#)
Cc: [Schilke, Steven E](#); [Smith, Corey J.](#)
Subject: FW: RR Structures | I-55 Managed Lanes
Date: Wednesday, July 27, 2016 7:41:42 AM

John O.,

Please incorporate into the cost estimate.

Thank you,

John Baldauf, P.E.

Project Manager

Illinois Department of Transportation

Bureau of Programming | Major Projects Unit
201 West Center Court | Schaumburg, IL 60196-1096
Phone: 847.705.4103 | john.baldauf@illinois.gov



Please consider the environment before printing this email.

From: Rabadi, Andy E
Sent: Tuesday, July 26, 2016 2:59 PM
To: Baldauf, John E.
Cc: Schilke, Steven E; Smith, Corey J.
Subject: RE: RR Structures | I-55 Managed Lanes

RR flagging costs depend on the number of days the contractor is anticipated to work on the RR ROW. As a rough estimate, I anticipate that we will need \$250K for flaggers, engineering review and construction inspection for each location.

Andy Rabadi
Senior Railroad Engineer
(847) 705-4256

From: Baldauf, John E.
Sent: Tuesday, July 26, 2016 2:39 PM
To: Rabadi, Andy E
Cc: Schilke, Steven E; Smith, Corey J.
Subject: FW: RR Structures | I-55 Managed Lanes

Andy,

Please see **below** in regards to **proposed work** over three railroads (BRC, B&O, & GM&O) along the I-55 managed lane corridor. Please see attached for location maps.

Could you provide a cost estimate for railroad flagging and other associated railroad costs for the scope of work at these locations?

Thank you,

John Baldauf, P.E.

Project Manager

Illinois Department of Transportation

Bureau of Programming | Major Projects Unit
201 West Center Court | Schaumburg, IL 60196-1096
Phone: 847.705.4103 | john.baldauf@illinois.gov



Please consider the environment before printing this email.

From: Stoddard, Keith W.
Sent: Tuesday, July 26, 2016 2:26 PM
To: Baldauf, John E.
Cc: Schilke, Steven E; Smith, Corey J.; Broviak, Pamela A.; Rayyan, Issam Y
Subject: RE: RR Structures | I-55 Managed Lanes

John

Based on the title commitments we received in December 2015, attached, additional documents reviewed and the location of the improvements shown in your exhibits it is my opinion that additional ROW/Easements will not be needed at the Railroads mentioned directly below.

B&O RR-The State has Fee Simple interest per Document # 19024366-, Commitment 11284.0, Current Owner-People of the State of Illinois, Department of Transportation (from 12-29-15 email)

Sincerely,

Keith W. Stoddard PLS
Chief of Plats and Plans
Illinois Department of Transportation
District 1, Bureau of Land Acquisition
201 West Center Ct.
Schaumburg, IL 60196-1096
847-705-4771 (Office)
847-705-4218 (Fax)
keith.stoddard@illinois.gov

From: Baldauf, John E.
Sent: Monday, July 25, 2016 11:39 AM
To: Stoddard, Keith W.
Cc: Schilke, Steven E; Smith, Corey J.; Broviak, Pamela A.; Rayyan, Issam Y
Subject: RE: RR Structures | I-55 Managed Lanes

Keith,



We are nearing completion of Phase I and at this time we are only proposing work to I-55 over the BRC Railroad (full bridge replacement), B&O Railroad (widening – sub & superstructure), and GM&O Railroad (widening – superstructure only). All widening will occur in the I-55 median (see attached location maps).

Based on the information provided it is our understanding the State has existing easement and/or fee simple rights at the subject locations and no additional ROW will be necessary. Please confirm and/or let us know if you need anything additional from us.

Thank you,

John Baldauf, P.E.

Project Manager

Illinois Department of Transportation

Bureau of Programming | Major Projects Unit
201 West Center Court | Schaumburg, IL 60196-1096
Phone: 847.705.4103 | john.baldauf@illinois.gov



Please consider the environment before printing this email.

From: Stoddard, Keith W.
Sent: Thursday, December 17, 2015 2:08 PM
To: Baldauf, John E.; Schilke, Steven E
Cc: Smith, Corey J.
Subject: RE: RR Structures | I-55 Managed Lanes

John

We have received 3 of the 4 commitments.

- GM&O RR- The State has easements rights-Commitment 11283.0, Current Owner- Illinois Central Railroad Company, see Item 9, Schedule B Easements Rights to Cook County Highway Department
- B&O RR-The State has Fee Simple interest per Document # 19024366-, Have not received commitment yet.
- BRC RR-Unable to find conveyance document, may need ROW-Commitment 11285, Current Owner-The State of Illinois, in Trust for the People of the State of Illinois
- CSXT RR-Need ROW-Commitment 11286, Current Owner-Baltimore and Ohio Chicago Terminal Railroad

Sincerely,

Keith W. Stoddard PLS
Chief of Plats and Plans
Illinois Department of Transportation
District 1, Bureau of Land Acquisition

201 West Center Ct.
Schaumburg, IL 60196-1096
847-705-4771 (Office)
847-705-4218 (Fax)
keith.stoddard@illinois.gov

From: Baldauf, John E.
Sent: Tuesday, November 10, 2015 4:43 PM
To: Stoddard, Keith W.; Schilke, Steven E
Cc: Smith, Corey J.
Subject: RE: RR Structures | I-55 Managed Lanes

Good Afternoon Keith,

Just a friendly follow up regarding the status of the order, we wanted to check if you have received anything yet.

Thank you,

John Baldauf, P.E.
Project Manager

Illinois Department of Transportation
Bureau of Programming | Major Projects Unit
201 West Center Court | Schaumburg, IL 60196-1096
Phone: 847.705.4103 | john.baldauf@illinois.gov



Please consider the environment before printing this email.

From: Stoddard, Keith W.
Sent: Tuesday, October 13, 2015 9:16 AM
To: Baldauf, John E.; Schilke, Steven E
Cc: Smith, Corey J.
Subject: RE: RR Structures | I-55 Managed Lanes

John

The commitment were ordered on September 28th , I do not expect to receive them until the week of October 26th .

Sincerely,

Keith W. Stoddard PLS
Chief of Plats and Plans
Illinois Department of Transportation
District 1, Bureau of Land Acquisition
201 West Center Ct.
Schaumburg, IL 60196-1096

847-705-4771 (Office)
847-705-4218 (Fax)
keith.stoddard@illinois.gov

From: Baldauf, John E.
Sent: Tuesday, October 13, 2015 9:11 AM
To: Stoddard, Keith W.; Schilke, Steven E
Cc: Smith, Corey J.
Subject: RE: RR Structures | I-55 Managed Lanes

Good Morning Keith,

I know you mentioned it might take 4 weeks to obtain this documentation, but we just wanted to follow up with you to see if you received any information or updates yet.

Thank Keith!

John Baldauf, P.E.

Illinois Department of Transportation

Bureau of Programming | Project and Environmental Studies
201 West Center Court | Schaumburg, IL 60196-1096
Phone: 847.705.4103 | john.baldauf@illinois.gov



Please consider the environment before printing this email.

From: Stoddard, Keith W.
Sent: Monday, September 28, 2015 11:48 AM
To: Schilke, Steven E
Cc: Smith, Corey J.; Baldauf, John E.
Subject: RE: RR Structures | I-55 Managed Lanes

I ordered them priority so I expect to receive them in 4 weeks.

Sincerely,

Keith W. Stoddard PLS
Chief of Plats and Plans
Illinois Department of Transportation
District 1, Bureau of Land Acquisition
201 West Center Ct.
Schaumburg, IL 60196-1096
847-705-4771 (Office)
847-705-4218 (Fax)
keith.stoddard@illinois.gov

From: Schilke, Steven E
Sent: Monday, September 28, 2015 11:40 AM
To: Stoddard, Keith W.

Cc: Smith, Corey J.; Baldauf, John E.
Subject: Re: RR Structures | I-55 Managed Lanes

So you have a timeframe when we can
Expect them?

On Sep 28, 2015, at 11:39 AM, Stoddard, Keith W. <Keith.Stoddard@Illinois.gov> wrote:

Title Commitments have been ordered

Sincerely,

Keith W. Stoddard PLS
Chief of Plats and Plans
Illinois Department of Transportation
District 1, Bureau of Land Acquisition
201 West Center Ct.
Schaumburg, IL 60196-1096
847-705-4771 (Office)
847-705-4218 (Fax)
keith.stoddard@illinois.gov

From: Stoddard, Keith W.
Sent: Monday, September 28, 2015 10:47 AM
To: Schilke, Steven E
Cc: Smith, Corey J.; Baldauf, John E.
Subject: RE: RR Structures | I-55 Managed Lanes

Steve

As a follow up to our conversation this morning my opinion based on the
documentation I was able to find in our archives is as follows:

- GM&O RR- The State has easements rights
- B&O RR-The State has Fee Simple interest per Document # 19024366
- BRC RR-Unable to find conveyance document, may need ROW
- CSXT RR-Need ROW

I will be ordering Title Commitments at all 4 crossings with the priority being the BRC
RR crossing. For your use I have included the documentation I found for each RR.

Sincerely,

Keith W. Stoddard PLS
Chief of Plats and Plans

Illinois Department of Transportation
District 1, Bureau of Land Acquisition
201 West Center Ct.
Schaumburg, IL 60196-1096
847-705-4771 (Office)
847-705-4218 (Fax)
keith.stoddard@illinois.gov

From: Baldauf, John E.
Sent: Friday, September 25, 2015 9:28 AM
To: Stoddard, Keith W.
Cc: Schilke, Steven E; Smith, Corey J.
Subject: RR Structures | I-55 Managed Lanes
Importance: High

Keith,

As discussed, please provide information regarding ROW rights & ownership at the following I-55 structures over railroads (location maps attached):

I-55 Managed Lane Bridges			
Location	Feature Crossed	SN	Scope
1	RR BRC (I-55 EB)	016-0018	Replacement
	RR BRC (I-55 WB)	016-0019	Replacement
2	CSXT Railroad Bridge (I-55 WB)	016-0012	Widening and rehabilitation
	CSXT Railroad Bridge (I-55 EB)	016-0013	Widening and rehabilitation
3	B&O RR/Western Ave (I-55 EB)	016-1058	Widening and rehabilitation
	B&O RR/Western Ave (I-55 WB)	016-0026	Widening and rehabilitation
4	GM&O RR/Ashland Ave (I-55 EB)	016-1084	Widening and rehabilitation
	GM&O RR/Ashland Ave (I-55 WB)	016-1083	Widening and rehabilitation

Thank you,

John Baldauf, P.E.

Illinois Department of Transportation
Bureau of Programming | Project and Environmental Studies
201 West Center Court | Schaumburg, IL 60196-1096

Phone: 847.705.4103 | john.baldauf@illinois.gov

PRIVILEGED & CONFIDENTIALITY NOTICE: This email transmission (and /or the documents accompanying such) may contain legally privileged/confidential information. Such information is intended only for the use of the individual or entity above. If you are not the named or intended recipient, you are hereby notified that any disclosure, copying, distribution, or the taking of any action in reliance on the contents of such information is strictly prohibited. If you have received this transmission in error, please immediately notify the sender by telephone to arrange for the secure return of the document.



Please consider the environment before printing this email.